
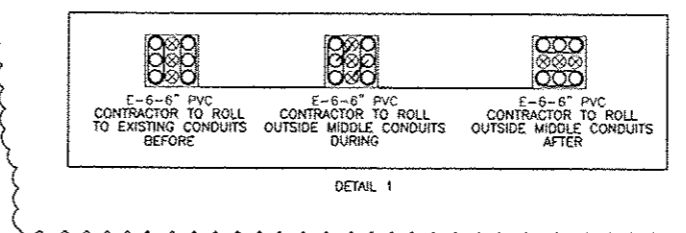
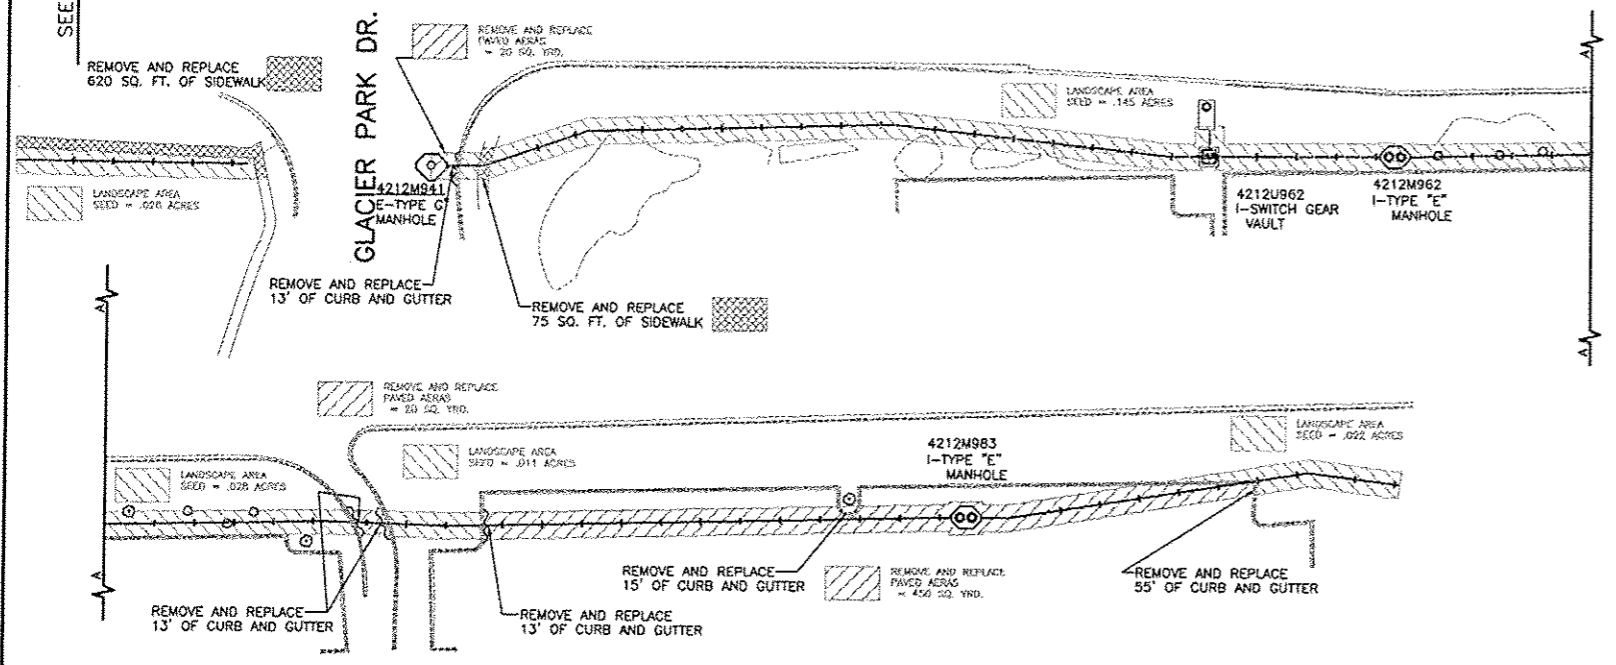


F.A. RTE. 338/IL 59	SECTION 2011-050	COUNTY DUPAGE	TOTAL SHEETS 0	SHEET NO. 3
STA.		TO STA.		
FED. ROAD DIST. NO.		ILLINOIS CONTRACT 60P42		

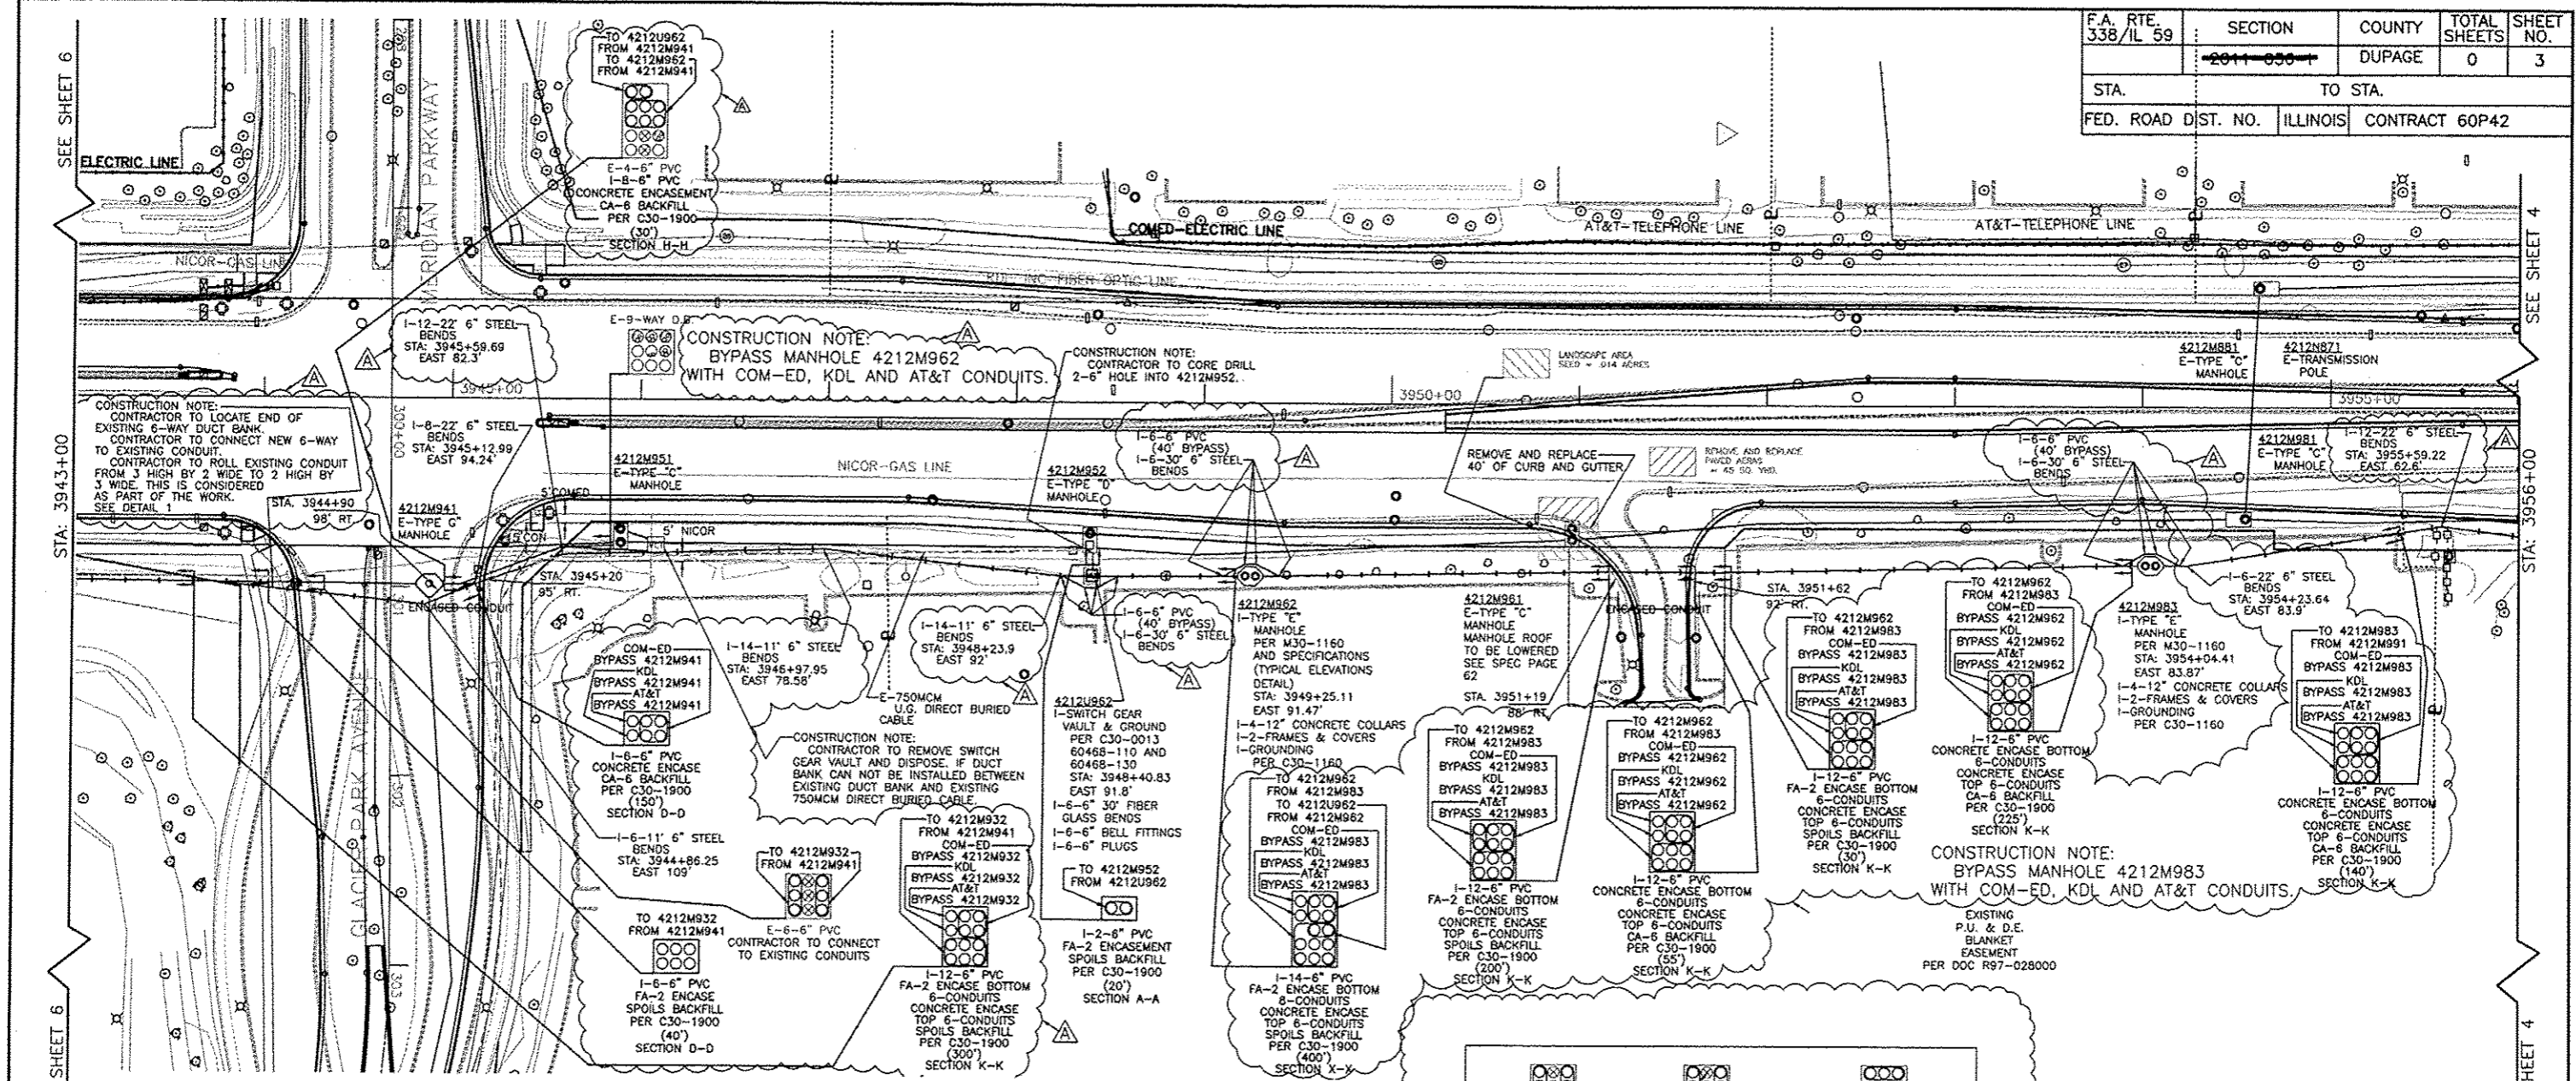

LEGEND

EXISTING	INSTALL

CALL JULIE 48 HRS. PRIOR TO CONSTRUCTION
1-800-892-0123 OR CALL 811

NOTES:
1. THE PROJECT ENGINEER FOR THIS JOB IS BRIAN CHAMBERLAIN AT (630)430-8853.
2. THE PROJECT COORDINATOR FOR THIS PROJECT IS PAUL MICHALOWSKI AT (630)305-5227.
3. CONTRACTOR IS RESPONSIBLE FOR MANHOLE PHOTOS TAKEN OF ALL CLEARLY MARKED CABLE AND ALL WALLS OF MANHOLES. PHOTOS WILL BE GIVEN TO THE GIS GROUP WITH THE AS-BUILTS.

ADDENDUM A 7-16-12

ROUTE 59

LOCATION MAP

DESIGN REVISION DATES

PROJECT TITLE ROUTE 59 ROAD IMPROVEMENTS			
PROJECT DESCRIPTION TO RELOCATE AND INSTALL NEW DUCTBANK AND 34KV FEEDERS			
DRAWN BY BCC	DRAWING DATE 5-11-12	APP # 4211,4212,4223	SCALE 1 = 40
DESIGNED BY DL	DESIGNED DATE N/A	APPROVED BY N/A	PROJECT # EU-12
CHECKED BY PSM	CHECKED DATE N/A	DATE FILED 0606468001CS.DWG	SHEET # 5 OF 63
Naperville Department of Public Utilities Electric Division			60468