


F.A. RTE. 338/IL 59	SECTION 2011-036	COUNTY DUPAGE	TOTAL SHEETS 0	SHEET NO. 3
STA.		TO STA.		
FED. ROAD DIST. NO.		ILLINOIS CONTRACT 60P42		

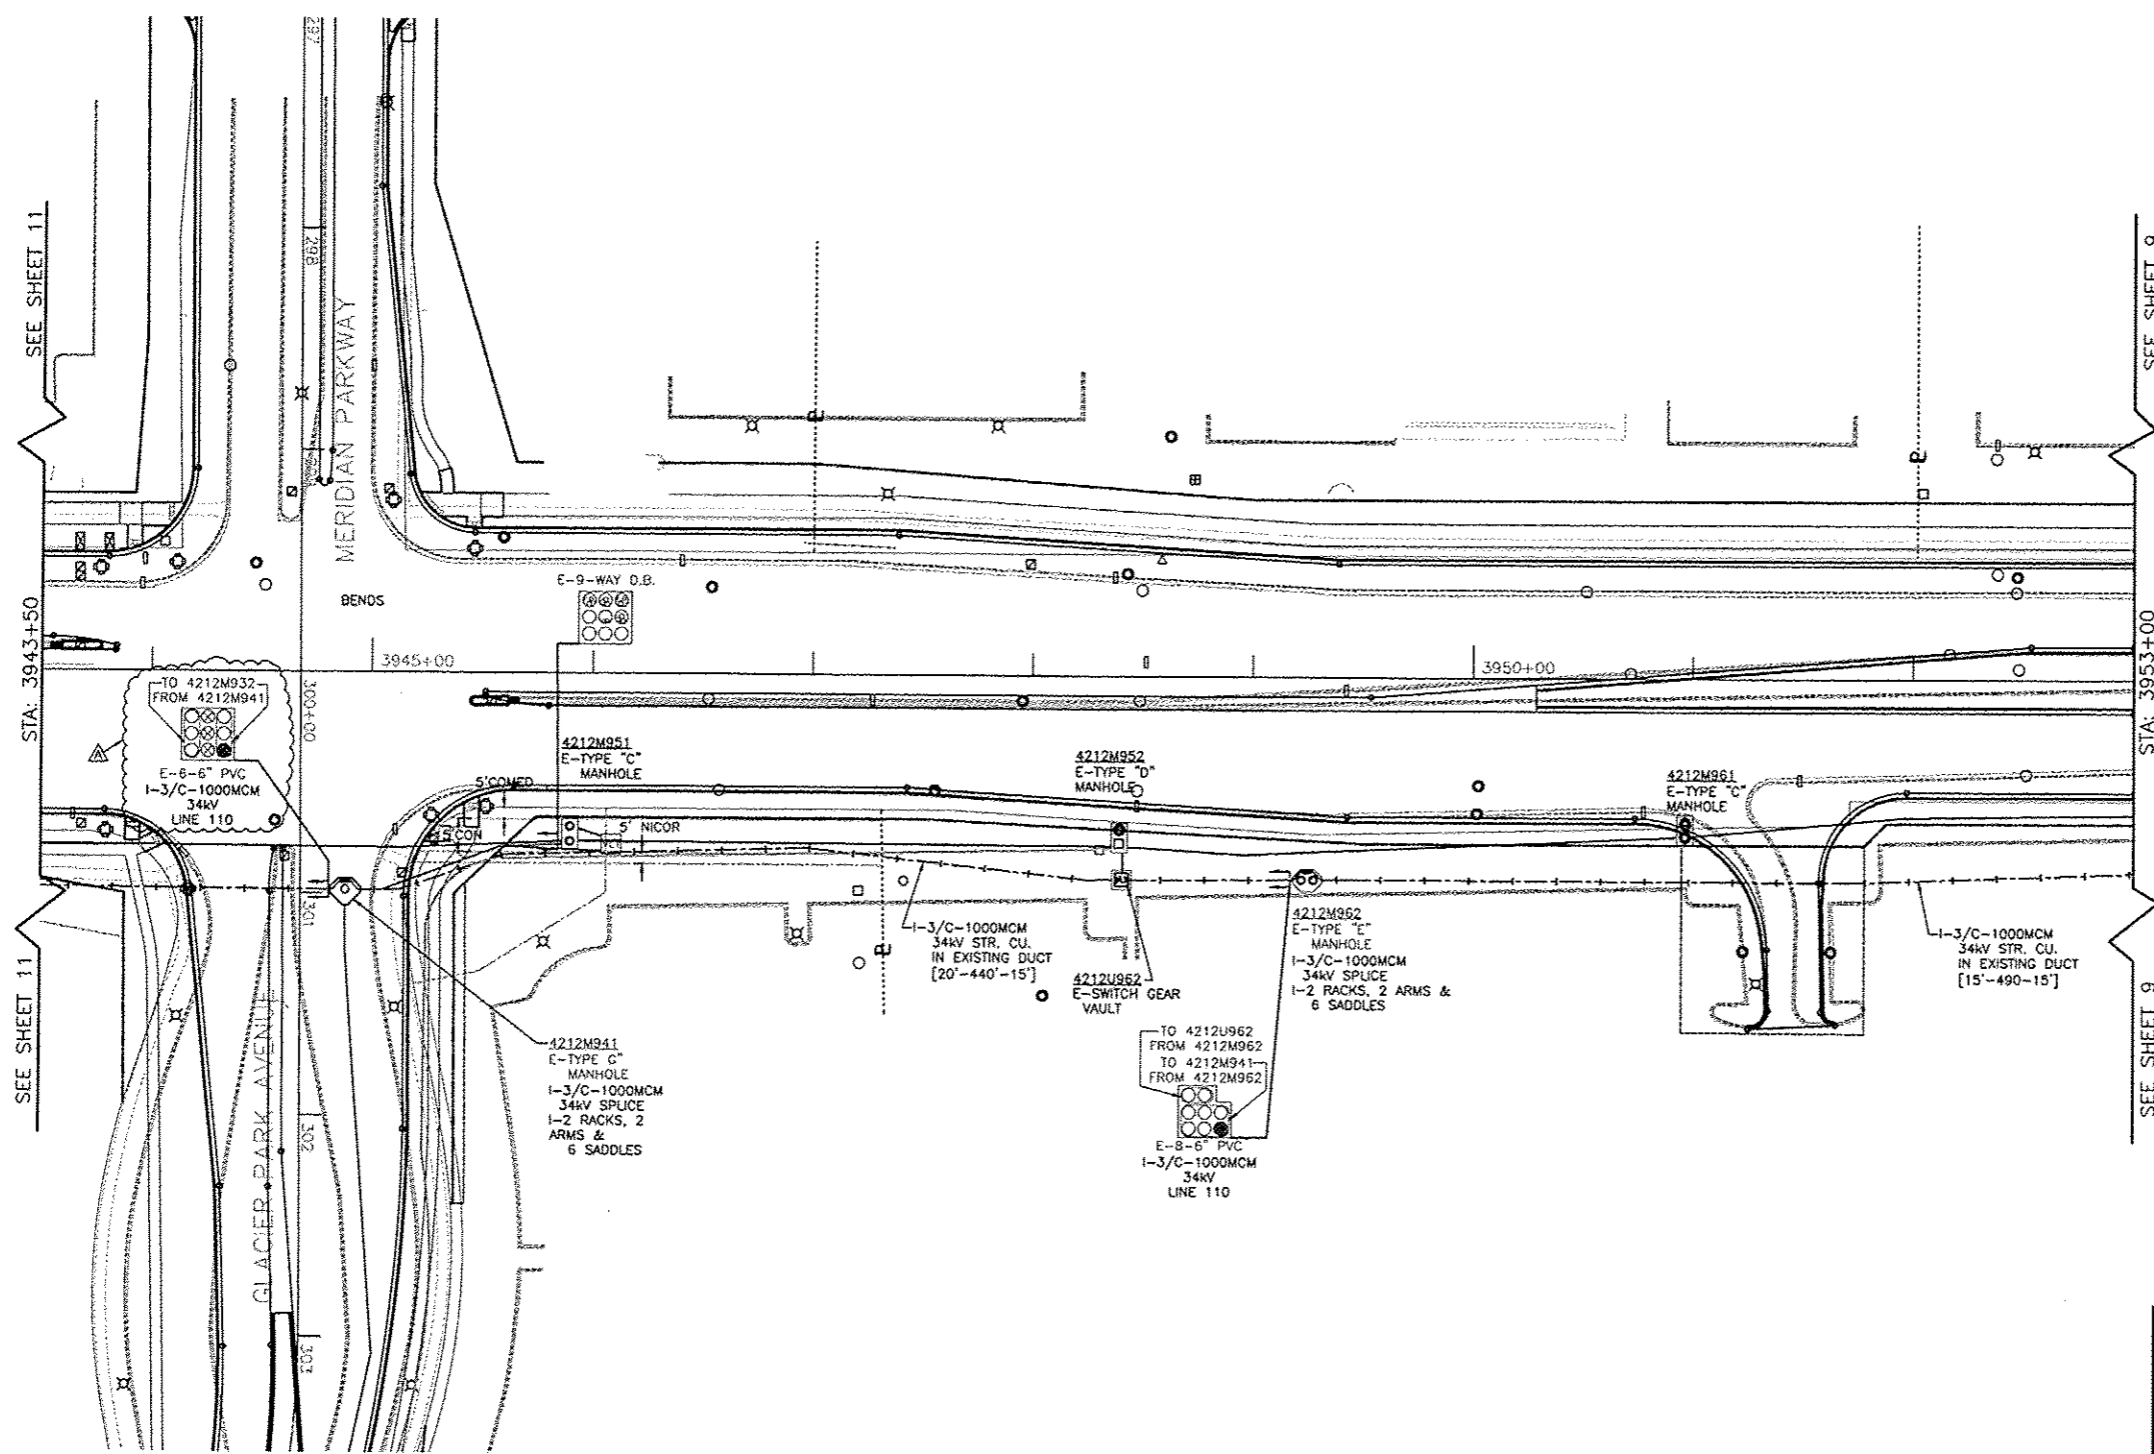

LEGEND

- EXISTING UNDERGROUND**
- E-SW. VAULT
 - E-SW. MOD.
 - E-TRANSFORMER
 - E-TYPE "A" MANHOLE
 - E-TYPE "C" MANHOLE
 - E-TYPE "C" DOUBLE OPENING MANHOLE
 - E-TYPE "D" MANHOLE
 - E-TYPE "E" MANHOLE
 - E-CONDUIT
 - E-TYPE "E" DOUBLE OPENING MANHOLE
 - E-TYPE "G" DOUBLE OPENING MANHOLE
- INSTALL UNDERGROUND**
- E-DISTRIBUTION/TRANSMISSION POLE
 - E-3/C-1000MCM 34kV STR. CU. W/JKT.
 - 1-3/C-1000MCM 34kV STR. CU. W/JKT.
 - 1-SPLICE PER MFR. OR SPECS. PER C30-0460

CALL JULIE 48 HRS. PRIOR TO CONSTRUCTION
1-800-892-0123 OR CALL 811

NOTES:

- THE PROJECT ENGINEER FOR THIS JOB IS BRIAN CHAMBERLAIN AT (630)420-6653.
- THE PROJECT COORDINATOR FOR THIS PROJECT IS PAUL LICHALOWSKI AT (630)300-8227.
- CONTRACTOR IS RESPONSIBLE FOR MANHOLE PHOTOS TAKEN OF ALL CLEARLY MARKED CABLE AND ALL WALLS OF MANHOLES. PHOTOS WILL BE GIVEN TO THE GIS GROUP WITH THE AS-BUILTS.

TE 59	MERIDIAN	GLACIER PK	ADDENDUM A 7-16-12	
LOCATION MAP			DESIGN REVISION DATES	
PROJECT TITLE ROUTE 59 ROAD IMPROVEMENTS				
PROJECT DESCRIPTION TO RELOCATE AND INSTALL NEW DUCTBANK AND 34kV FEEDERS.				
ENGINEER BCC	DRAWING DATE 5-11-12	APP # 4211,4212,4223	SCALE 1 = 40	
ON DESIGN BY DL	DRAWN BY PSM	DATE JOB AGREEMENT # N/A	PROJECT # EU-12	
CHECKED BY 	APPROVED BY 	DWG FILE 0060648001C10.DWG	SHEET # 10 OF 63	
Naperville Department of Public Utilities Electric Division				60468