


F.A. RTE. 338/IL 59	SECTION 204-036	COUNTY DUPAGE	TOTAL SHEETS 0	SHEET NO. 3
STA.		TO STA.		
FED. ROAD DIST. NO.	ILLINOIS	CONTRACT 60P42		

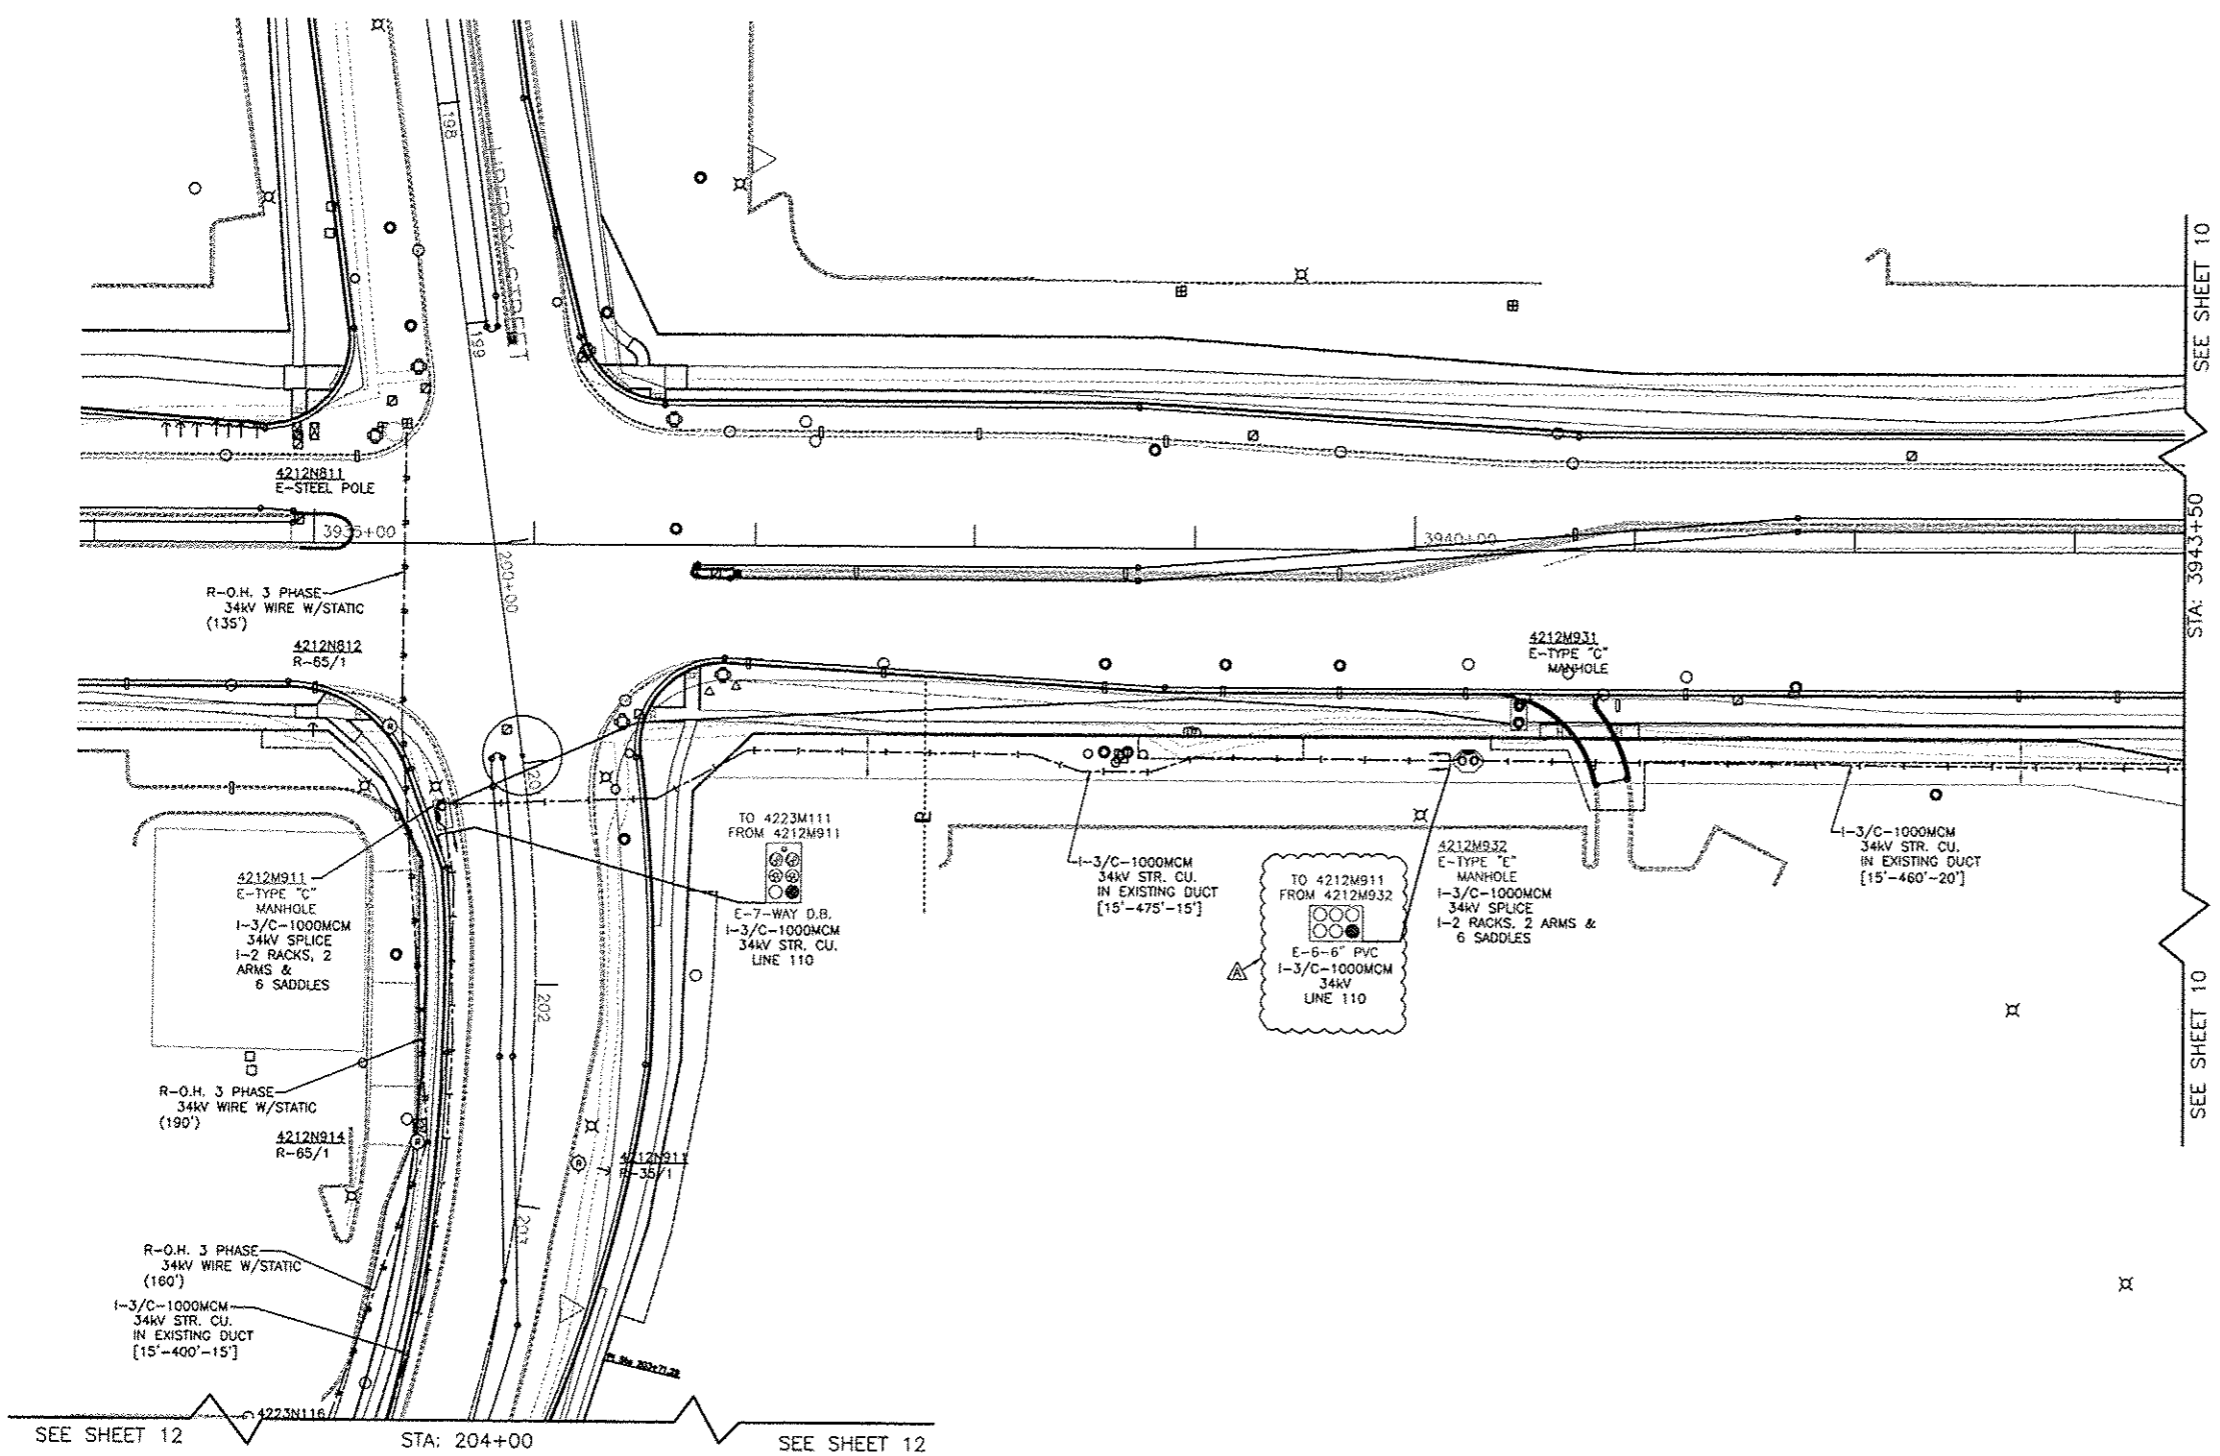

**LEGEND**

- EXISTING UNDERGROUND**
- E-SW. VAULT
  - E-SW. MOD.
  - E-TRANSFORMER
  - E-TYPE "A" MANHOLE
  - E-TYPE "C" MANHOLE
  - E-TYPE "C" DOUBLE OPENING MANHOLE
  - E-TYPE "D" MANHOLE
  - E-TYPE "E" MANHOLE
  - E-CONDUIT
  - E-TYPE "E" DOUBLE OPENING MANHOLE
  - E-TYPE "C" DOUBLE OPENING MANHOLE
- OVERHEAD**
- E-DISTRIBUTION/TRANSMISSION POLE
  - E-3/C-1000MCM 34KV STR. CU. W/JKT.
- INSTALL UNDERGROUND**
- I-3/C-1000MCM 34KV STR. CU. W/JKT.
  - I-SPLICE PER MFR. OR SPECS. PER C30-0460
- REMOVE OVERHEAD**
- R-DISTRIBUTION/TRANSMISSION POLE 65/1 THRU 65/3 POLES
  - R-3/C-1000MCM 34KV STR. CU. W/JKT.
  - R-O.H. 3 PHASE 34KV WIRE W/STATIC

**CALL JULIE 48 HRS. PRIOR TO CONSTRUCTION**  
1 - 800 - 892 - 0123 OR CALL 811

**NOTES:**  
 1. THE PROJECT ENGINEER FOR THIS JOB IS BRIAN CHAMBERLAIN AT (630)420-8853.  
 2. THE PROJECT COORDINATOR FOR THIS PROJECT IS PAUL WACHLOWSKI AT (630)305-8227.  
 3. CONTRACTOR IS RESPONSIBLE FOR MANHOLE PHOTOS TAKEN OF ALL CLEARLY MARKED CABLE AND ALL WALLS OF MANHOLES. PHOTOS WILL BE GIVEN TO THE GSE GROUP WITH THE AS-BUILTS.

	ADDENDUM A 7-16-12
	DESIGN REVISION DATES
<b>PROJECT TITLE</b> ROUTE 59 ROAD IMPROVEMENTS	
<b>PROJECT DESCRIPTION</b> TO RELOCATE AND INSTALL NEW DUCTBANK AND 34KV FEEDERS	
<b>DESIGNER</b> BCC	<b>DATE</b> 5-11-12
<b>DESIGN NO.</b> 4211, 4212, 4223	<b>SCALE</b> 1 = 40
<b>DATE DESIGNED BY</b> DL	<b>DATE CHECKED BY</b> PSM
<b>DATE DESIGNED BY</b> N/A	<b>DATE CHECKED BY</b> EU-12
<b>CHECKED BY</b> 0060648001C11.DWG	<b>DATE</b> 11 OF 63

Naperville Department of Public Utilities Electric Division