

STATE OF ILLINOIS
DEPARTMENT OF TRANSPORTATION

DIVISION OF HIGHWAYS

**PROPOSED
HIGHWAY PLANS**

~~FAP ROUTE 316 (IL 26) & FAP ROUTE 573 (US 30)~~

SECTION D2 BRIDGE PAINTING 2013-1

BRIDGE PAINTING

~~OGLE / WHITESIDE COUNTY~~

C-92-140-12

R 8E

R 7E

T 21N

T 20N



T 23N

INDEX OF SHEETS

1. Cover Sheet, Index Sheet, Standards
2. Summary of Quantities, General Notes
3. Traffic Control Plan for Location No. 1
- 4.- 6. District Standards 41.1
7. District Standard 44.1
- 8.- 14. Existing Bridge Plans for Location 1 and 2-

STANDARDS


- 701001-02 Off-Road Operations, 2L, 2W, More than 4.5 m (15') Away
- 701006-03 OFF-Road Operations, 2L, 2W, 15' (5.5 m) TO 24' (600 mm) from pavement edge
- 701101-02 Off-Road Operations, Multilane, 4.5 m (15') to 600 mm (24") From Pavement Edge
- 701201-04 Lane Closure, 2L, 2W, Day Only, for speeds > 45 mph
- 701301-04 Lane Closure, 2L, 2W, Short Time Operations
- 701400-05 Approach to Lane Closure, Freeway/Expressway
- 701401-06 Lane Closure, Freeway/Expressway
- 701402-09 Lane Closure, Freeway/Expressway, with Barrier
- 701411-08 Lane Closure, Multilane, at Entrance or Exit Ramp, for Speeds > 45 mph
- 701426-04 Lane Closure, Multilane, Intermittent or Moving Operation for Speeds > 45 mph
- 701901-02 Traffic Control Devices
- 704001-07 Temporary Concrete Barrier
- 720011-01 Metal Posts for Signs, Markers & Delineators
- 728001-01 Telescoping Steel Sign Support
- 729001-01 Applications for Types A & B Metal Posts (For Signs and Markers)

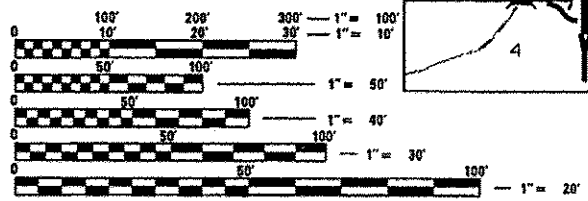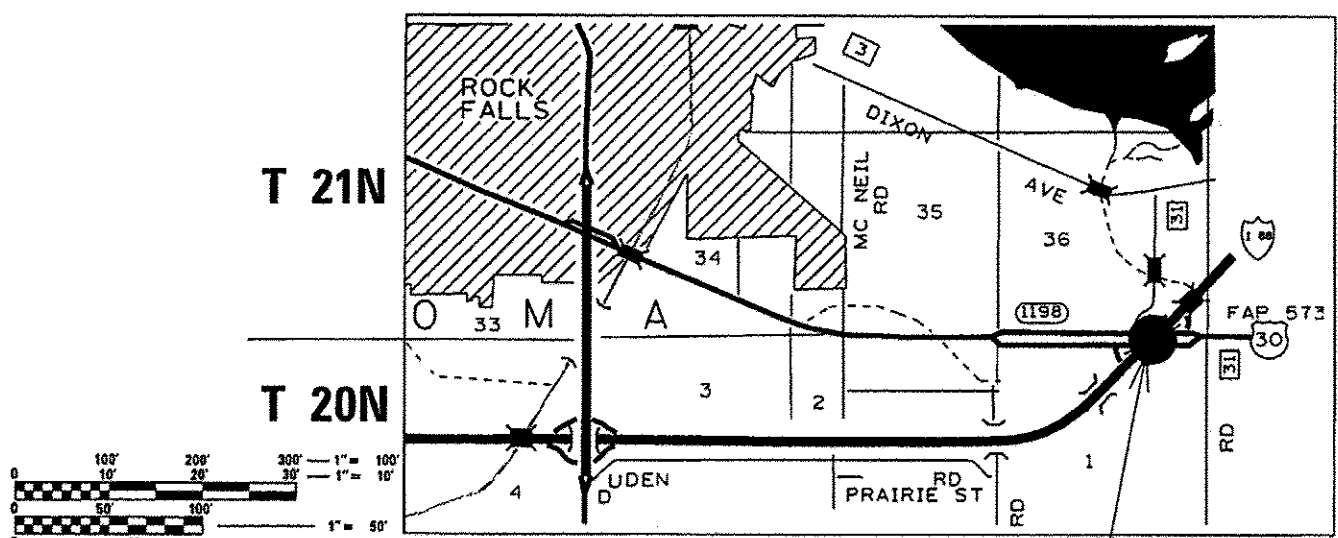

FULL SIZE PLANS HAVE BEEN PREPARED USING STANDARD ENGINEERING SCALES. REDUCED SIZED PLANS WILL NOT CONFORM TO STANDARD SCALES. IN MAKING MEASUREMENTS ON REDUCED PLANS, THE ABOVE SCALES MAY BE USED.


J.U.L.I.E.
JOINT UTILITY LOCATION INFORMATION FOR EXCAVATION
1-800-892-0123
OR 811

SN: 098-0091
LOCATION No. 1

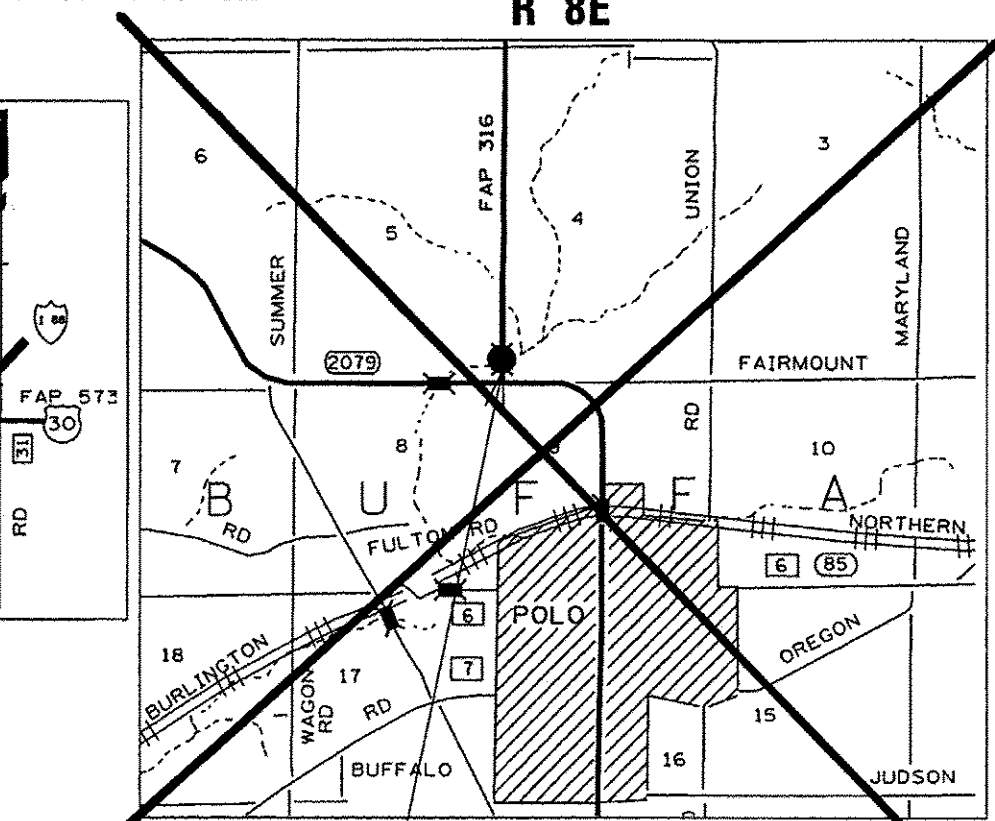

~~SN: 071-0069~~
~~LOCATION No. 1~~

F.A. RTE.	SECTION	COUNTY	TOTAL SHEETS	SHEET NO.
Whiteside	74	Whiteside	14	1
FAP 573		CONTRACT NO. 64H98		

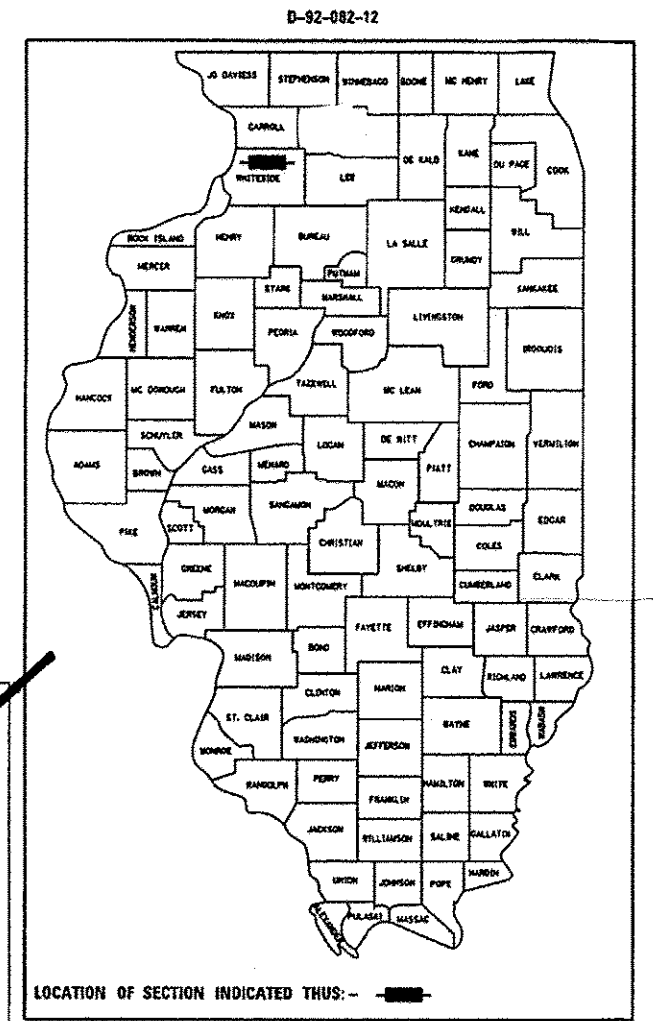

LOCATION OF SECTION INDICATED THUS: - [black rectangle] -

STATE OF ILLINOIS
DEPARTMENT OF TRANSPORTATION
DIVISION OF HIGHWAYS

SUBMITTED August 14, 2012
Ed S. Shekhtman
DEPUTY DIRECTOR OF HIGHWAYS, REGION ENGINEER

October 5, 2012
John D. Baranelli P.E.
ENGINEER OF DESIGN AND ENVIRONMENT

October 5, 2012
William R. Frey
DIRECTOR OF HIGHWAYS, CHIEF ENGINEER

PRINTED BY THE AUTHORITY
OF THE STATE OF ILLINOIS

District 2 Bridge Maintenance Engineer - Mahmoud Etemadi 815/284-5393
COLONA TOWNSHIP, SECTION 36
MONTMORENCY TOWNSHIP, SECTION 1
BUFFALO TOWNSHIP, SECTION 4, 5
CONTRACT NO. 64H98