


AS-BUILT PLANS S.N. 057-0128

FOR INFORMATION ONLY

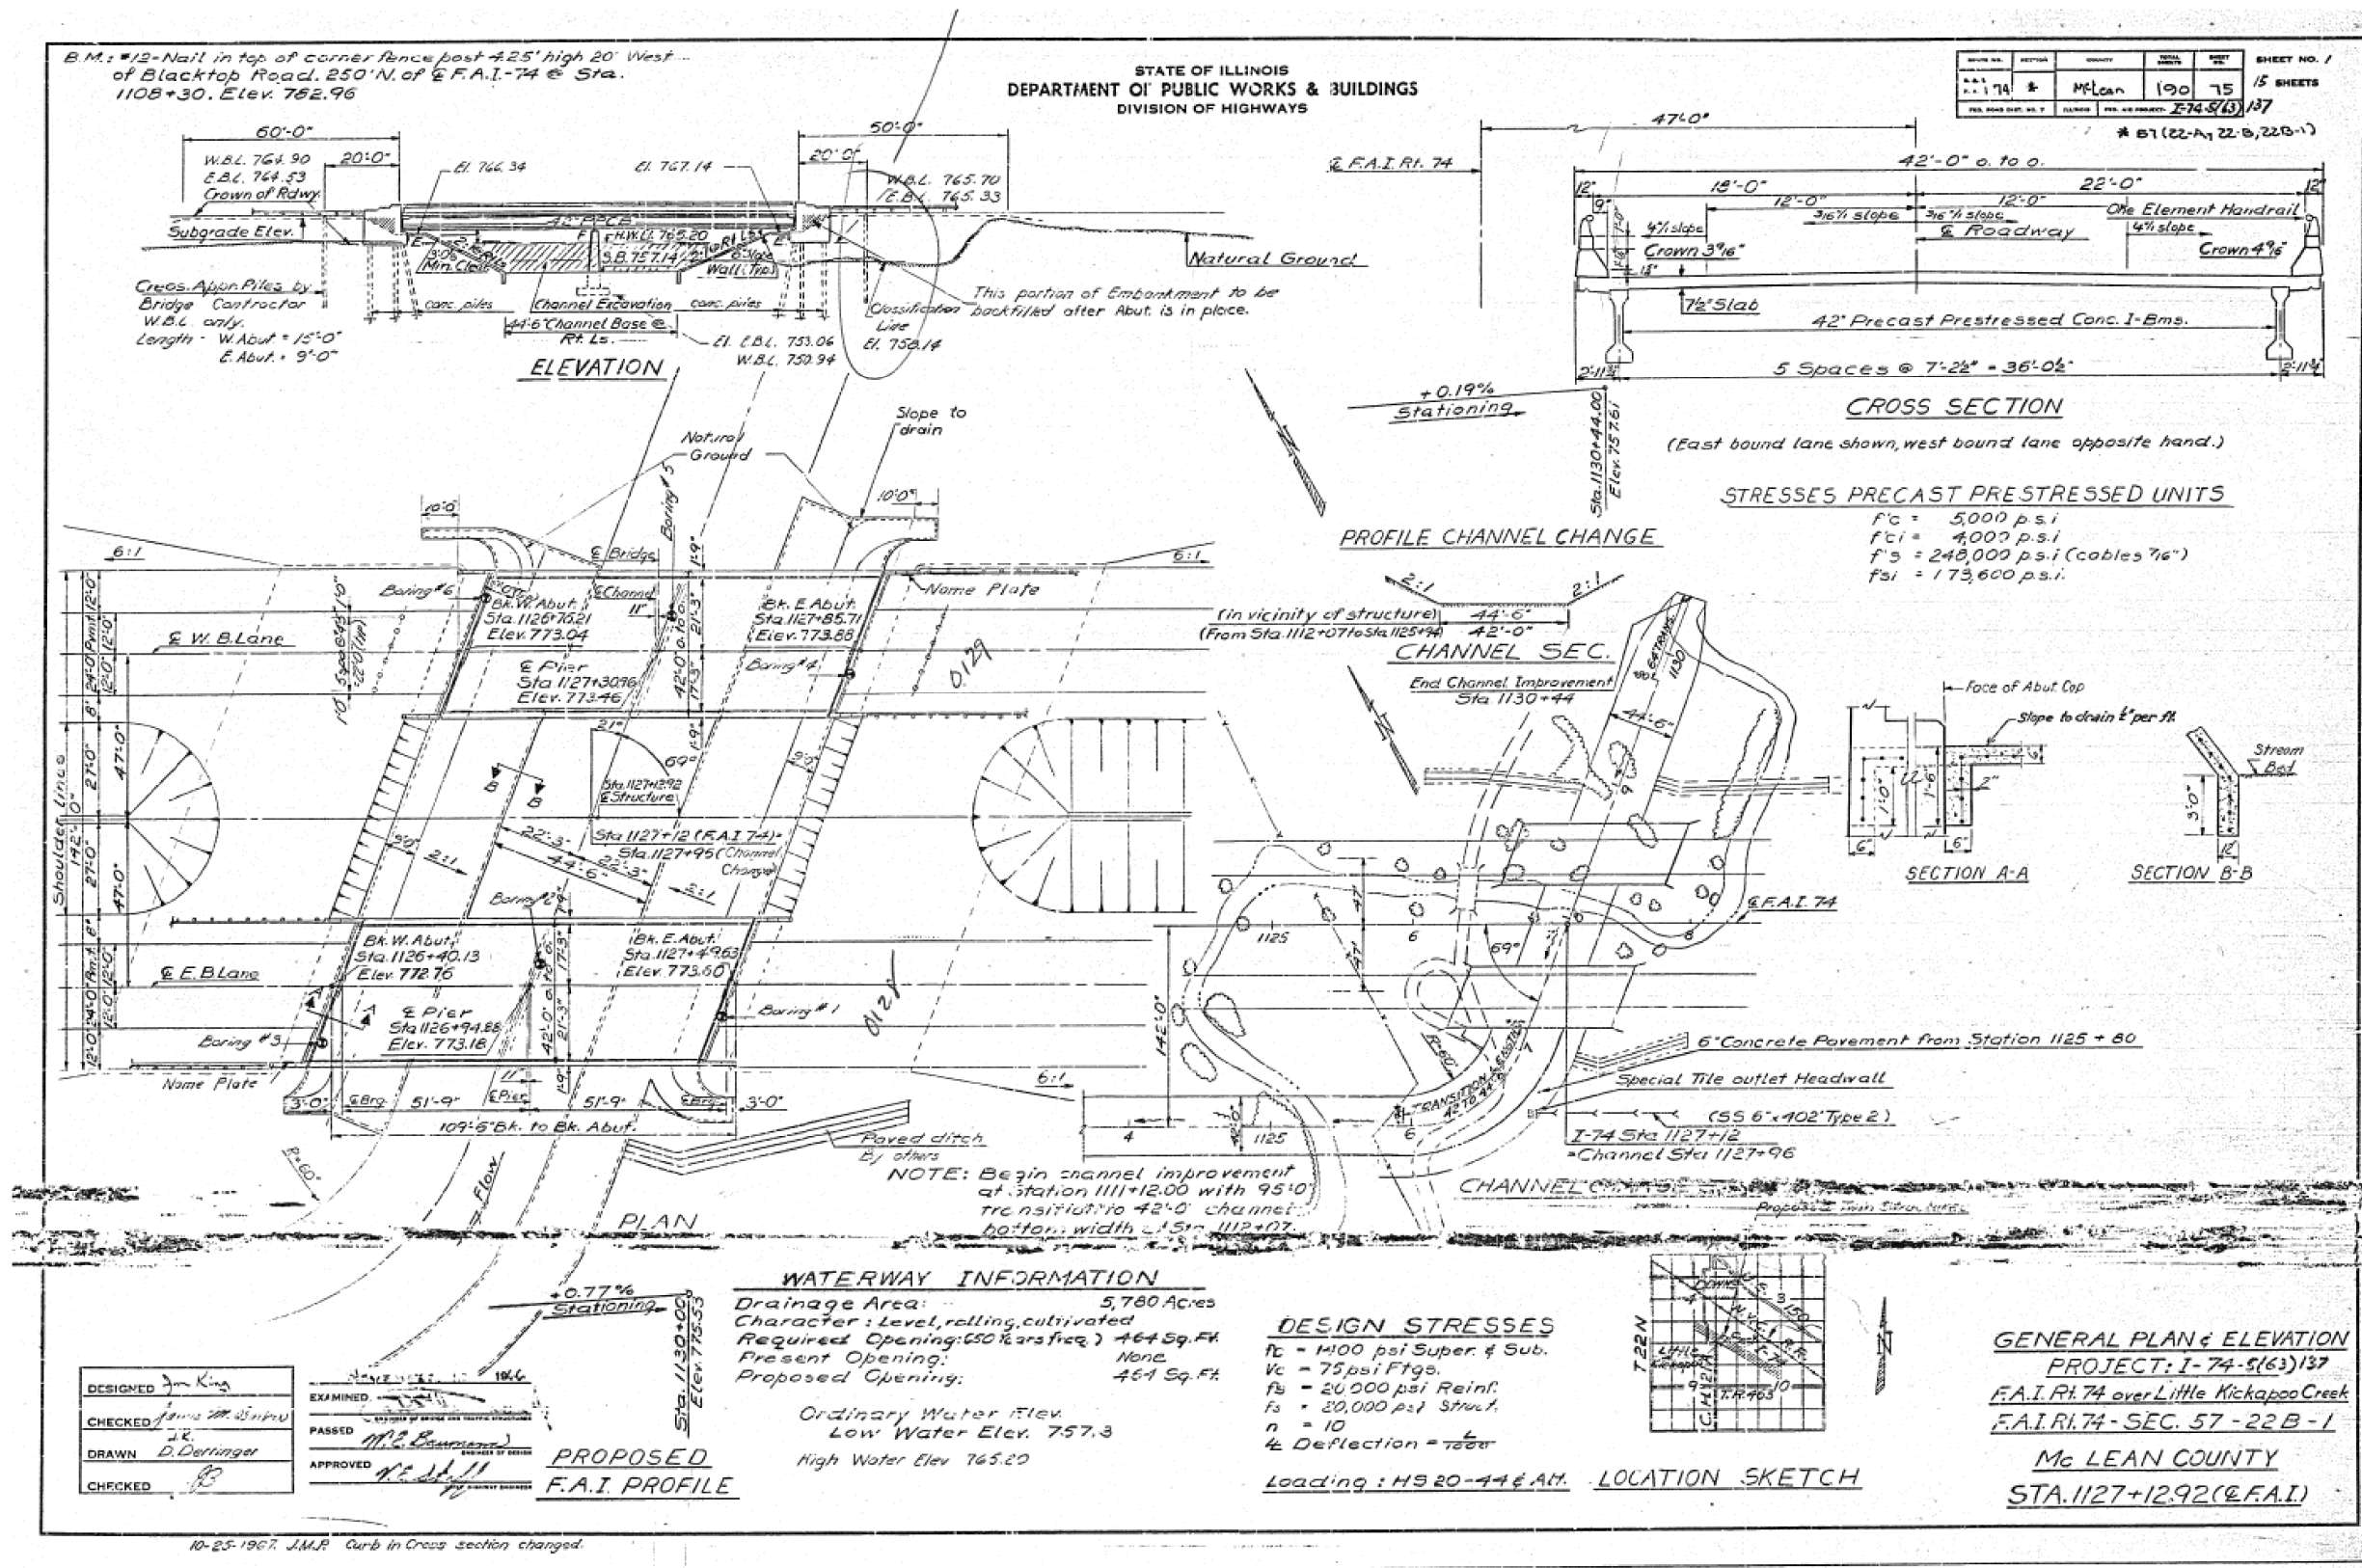

FILE NAME =	USER NAME = piersonbr	DESIGNED - TJB	REVISED - 8/8/11	STATE OF ILLINOIS DEPARTMENT OF TRANSPORTATION	AS-BUILT PLANS S.N. 057-0128 FOR INFORMATION ONLY	F.A.I. RTE.	SECTION	COUNTY	TOTAL SHEETS	SHEET NO.	
et:\pw\work\p1dot\piersonbr\d0184863\05	0648-shr-Structure-plans.dgn	DRAWN - JJB	REVISED - 8/10/11			74	(57-23,57-24)RS-1	MCLEAN	175	87	
	PLOT SCALE = 48.0000' / in.	CHECKED -	REVISED -			CONTRACT NO. 70648		ILLINOIS FED. AID PROJECT			
	PLOT DATE = 8/25/2011	DATE -	REVISED -			SCALE:	SHEET NO. 13 OF 14 SHEETS	STA.	TO STA.		