


AS-BUILT PLANS - S.N. 057-0132 FOR INFORMATION ONLY

STATE OF ILLINOIS
DEPARTMENT OF PUBLIC WORKS & BUILDINGS
DIVISION OF HIGHWAYS

ROUTE NO.	SECTION	COUNTY	TOTAL SHEETS	SHEET NO.	SHEET NO. 3
FA I-74	57-23HBI	Mc LEAN	53	25	SHEETS 12
FED. ROAD DIST. NO. 7	ILLINOIS	FED. AID PROJECT			

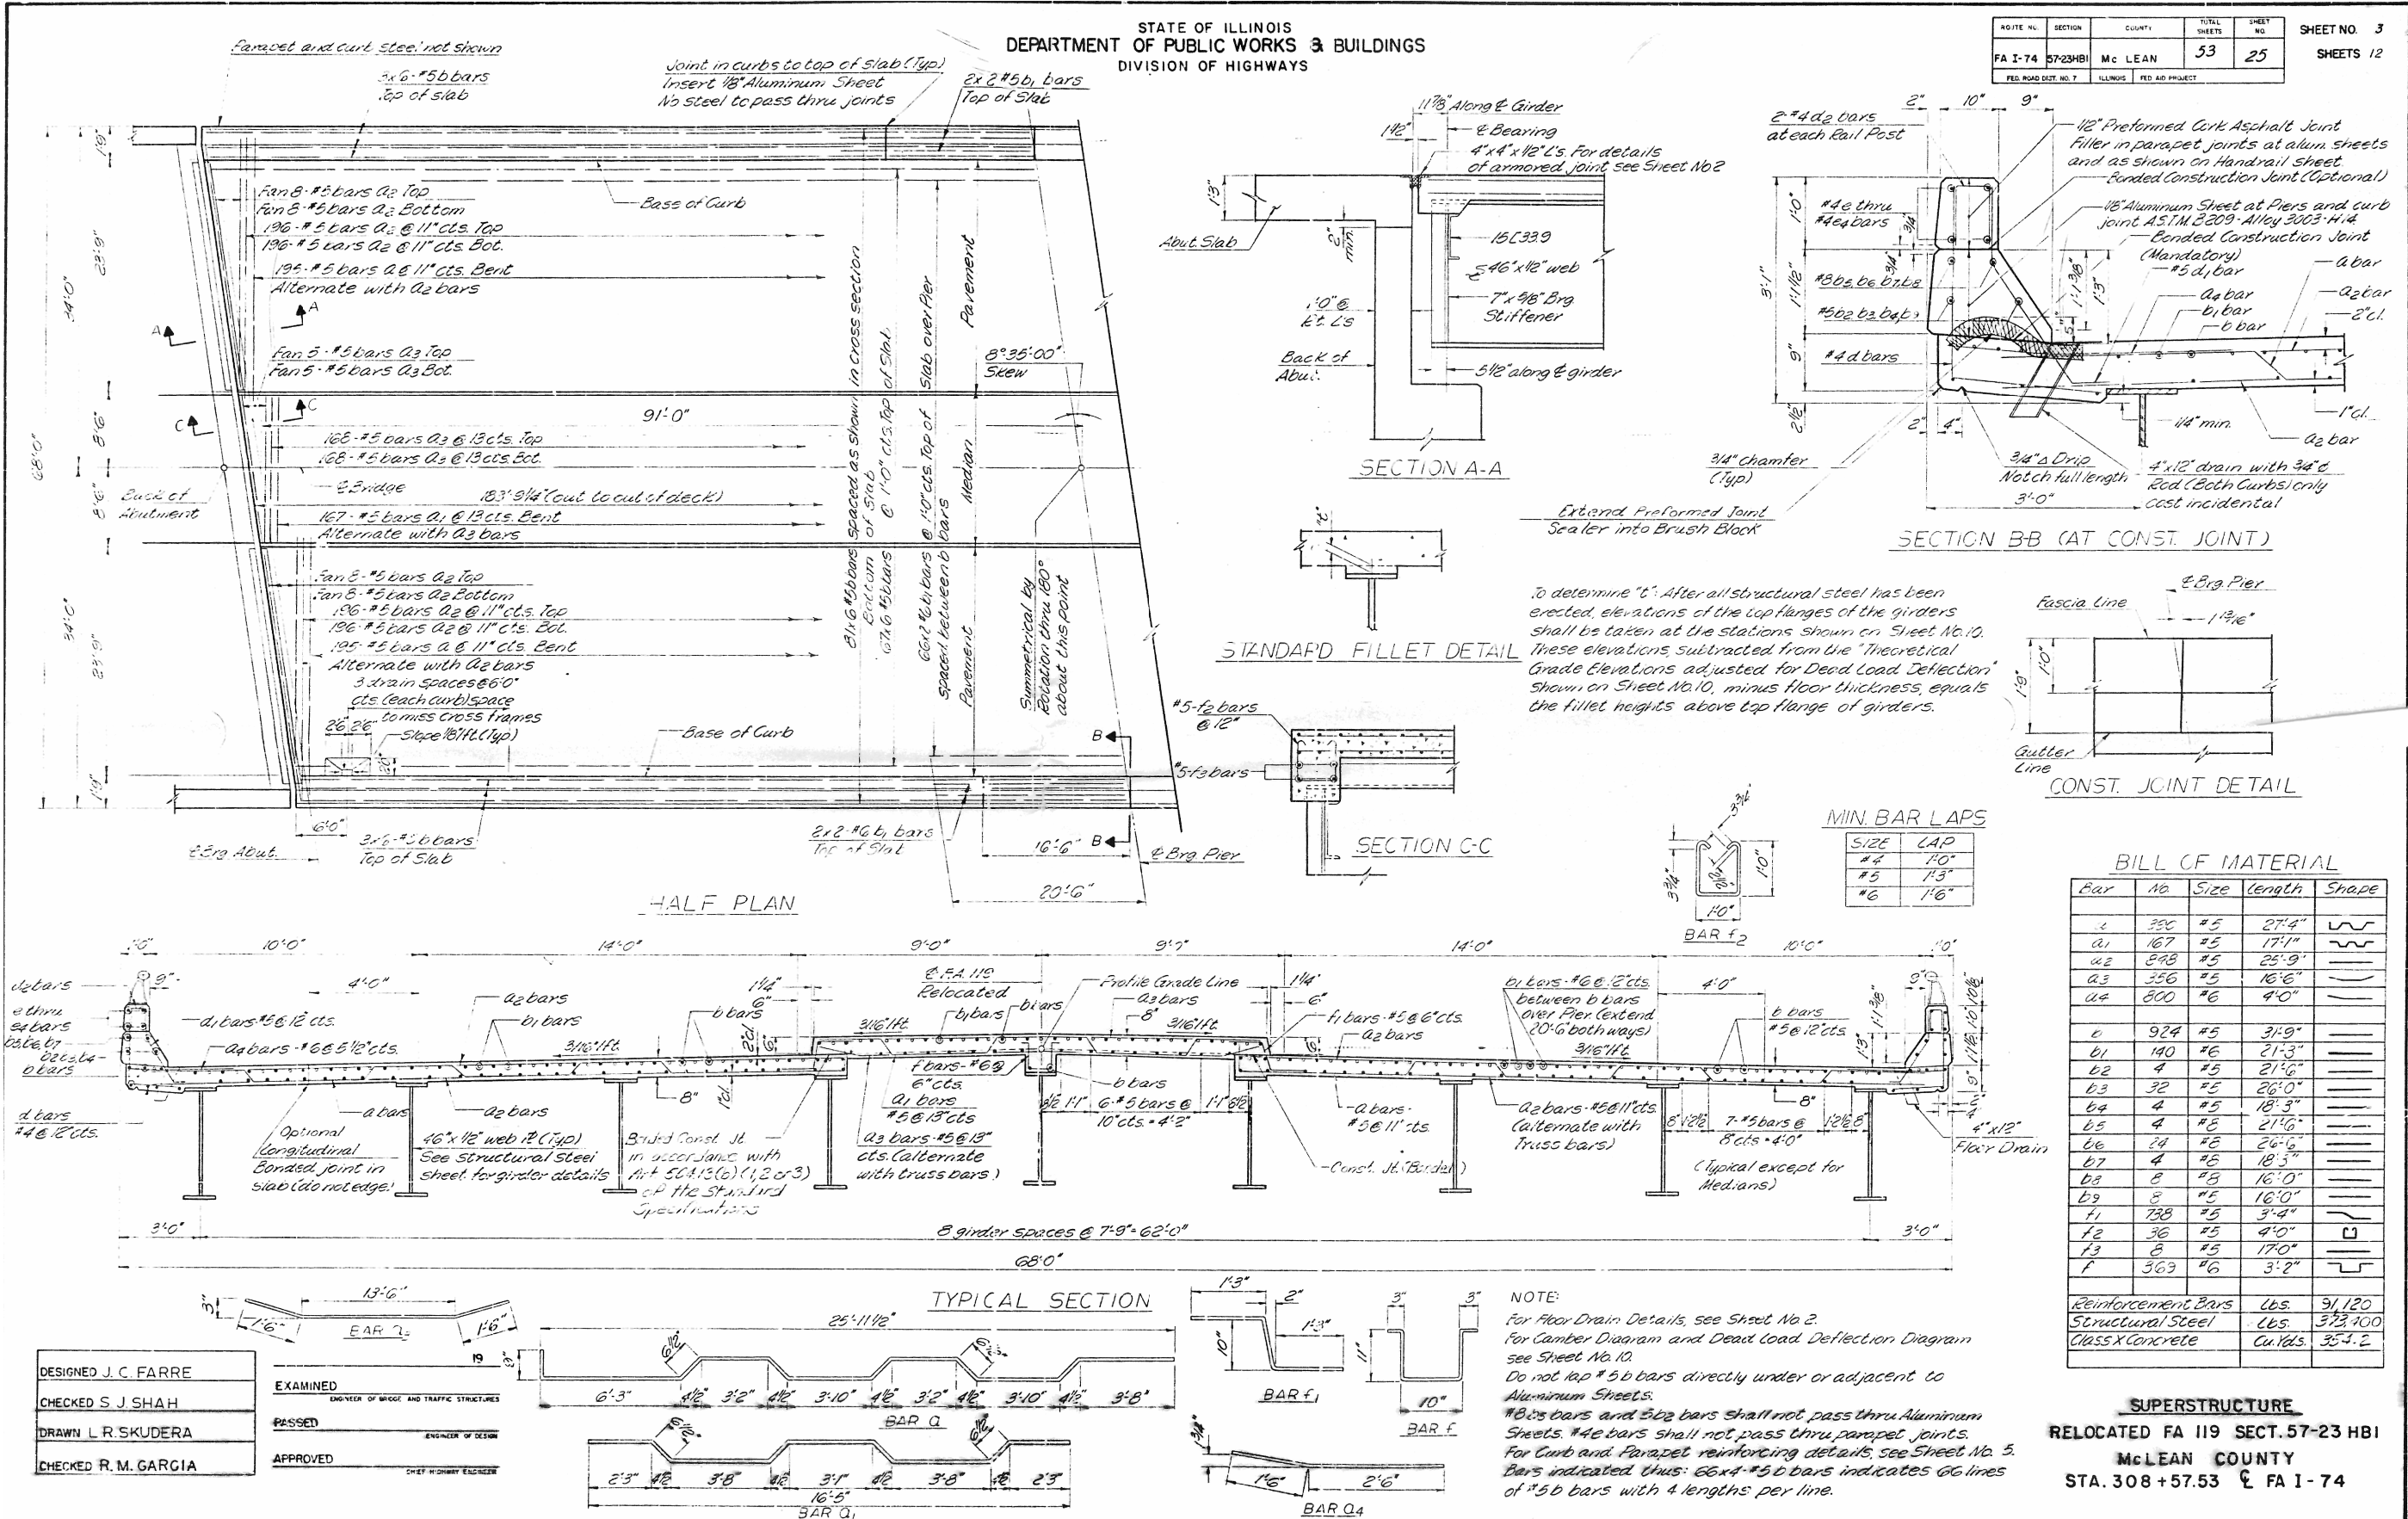

DESIGNED J. C. FARRE
CHECKED S. J. SHAH
DRAWN L. R. SKUDERA
CHECKED R. M. GARGIA

EXAMINED
PASSED
APPROVED

NOTE:
For Floor Drain Details, see Sheet No. 2.
For Camber Diagram and Dead Load Deflection Diagram see Sheet No. 10.
Do not lap #5 bars directly under or adjacent to Aluminum Sheets.
#6 bars and #5 bars shall not pass thru Aluminum Sheets. #4 bars shall not pass thru parapet joints.
For Curb and Parapet reinforcing details, see Sheet No. 5.
Bars indicated thus: 66x4-#5 bars indicates 66 lines of #5 bars with 4 lengths per line.