


AS-BUILT PLANS - S.N. 057-0132 FOR INFORMATION ONLY

FAI	SECTION	COUNTY	TOTAL SHEETS	SHEET NO.
74	*	McLEAN	47	37
STA.		TO STA.		
F.A.I. PROJ. NO.		BLDG.	F.A.I. PROJ.	

* (57-23)RS-HB-1

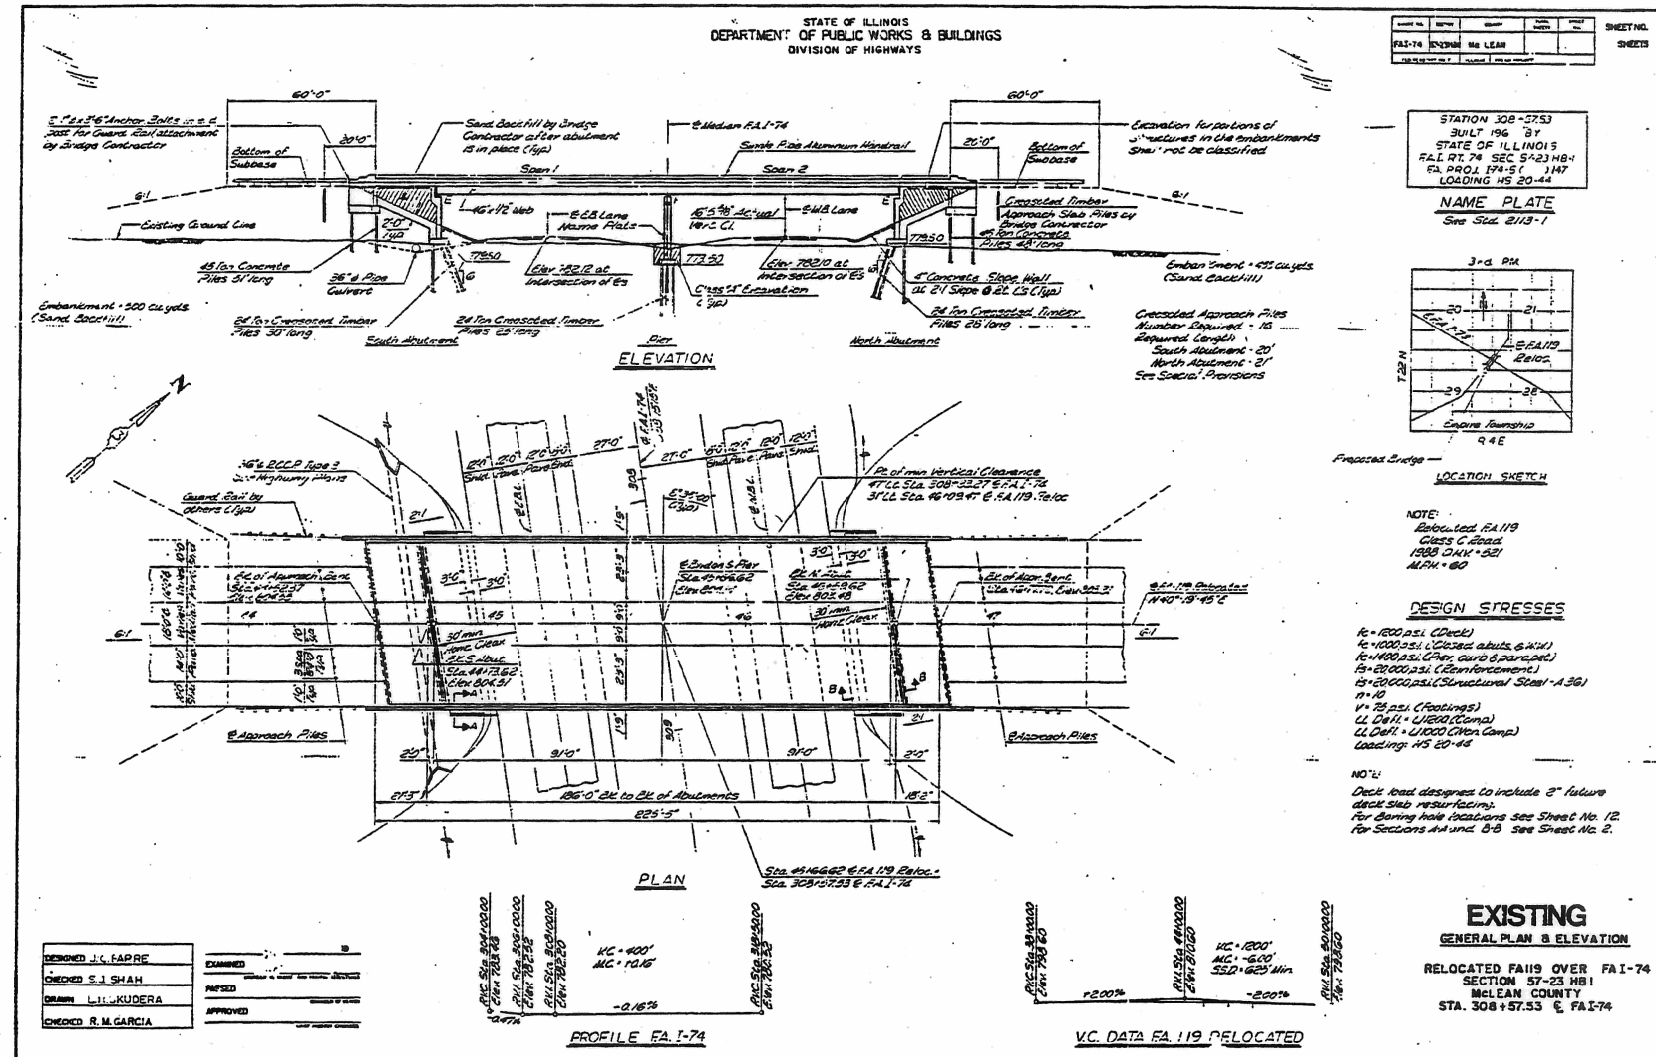

BILL OF MATERIALS				
ITEM	UNIT	STAGE 1	STAGE 2	TOTAL
Concrete Removal	Cu. M.	7.5	6.7	14.2
Concrete Superstructure	Cu. M.	8.3	7.5	15.8
Bituminous Concrete Removal (Deck)	Sq. M.	481	481	962
Deck Slab Repair (Partial)	Sq. M.	145	144	289
Concrete Bridge Deck Scarification (10mm)	Sq. M.	481	481	962
Bridge Deck Polymer Concrete Thin Overlay	Sq. M.	481	481	962
Reinforcement Bars (Epoxy Coated)	Kilogram	1031	809	1840
Furnishing and Erecting Structural Steel	Kilogram	2850	2460	5310
Elastomeric Bearing Assembly, Type 1	Each	10	8	18
Jack and Remove Existing Bearings	Each	10	8	18
Preformed Joint Seal - 102 mm	Meter	23	21	44
Cleaning and Painting Steel Bridge	L. Sum			1
Blasting Residue Containment and Disposal	L. Sum			1
Power Tool Cleaning Residue Containment and Disposal	L. Sum			1

REVISIONS	
NAME	DATE

ILLINOIS DEPARTMENT OF TRANSPORTATION

GENERAL NOTES AND BILL OF MATERIAL

DR/WH/1 Y
CHECKED BY

DATE