


LEGEND	SYMBOL
	INDUCTION LOOP
	HANDHOLE
	POLYETHYLENE DUCT
	CABINET
	HEAVY DUTY HANDHOLE
	GALVANISED STEEL CONDUIT
	FLASHER
	SERVICE INSTALLATION
	DIRECT BURIAL CABLE
	JUNCTION BOX
	LIGHT STANDARD
	RAMP METERING SIGNAL

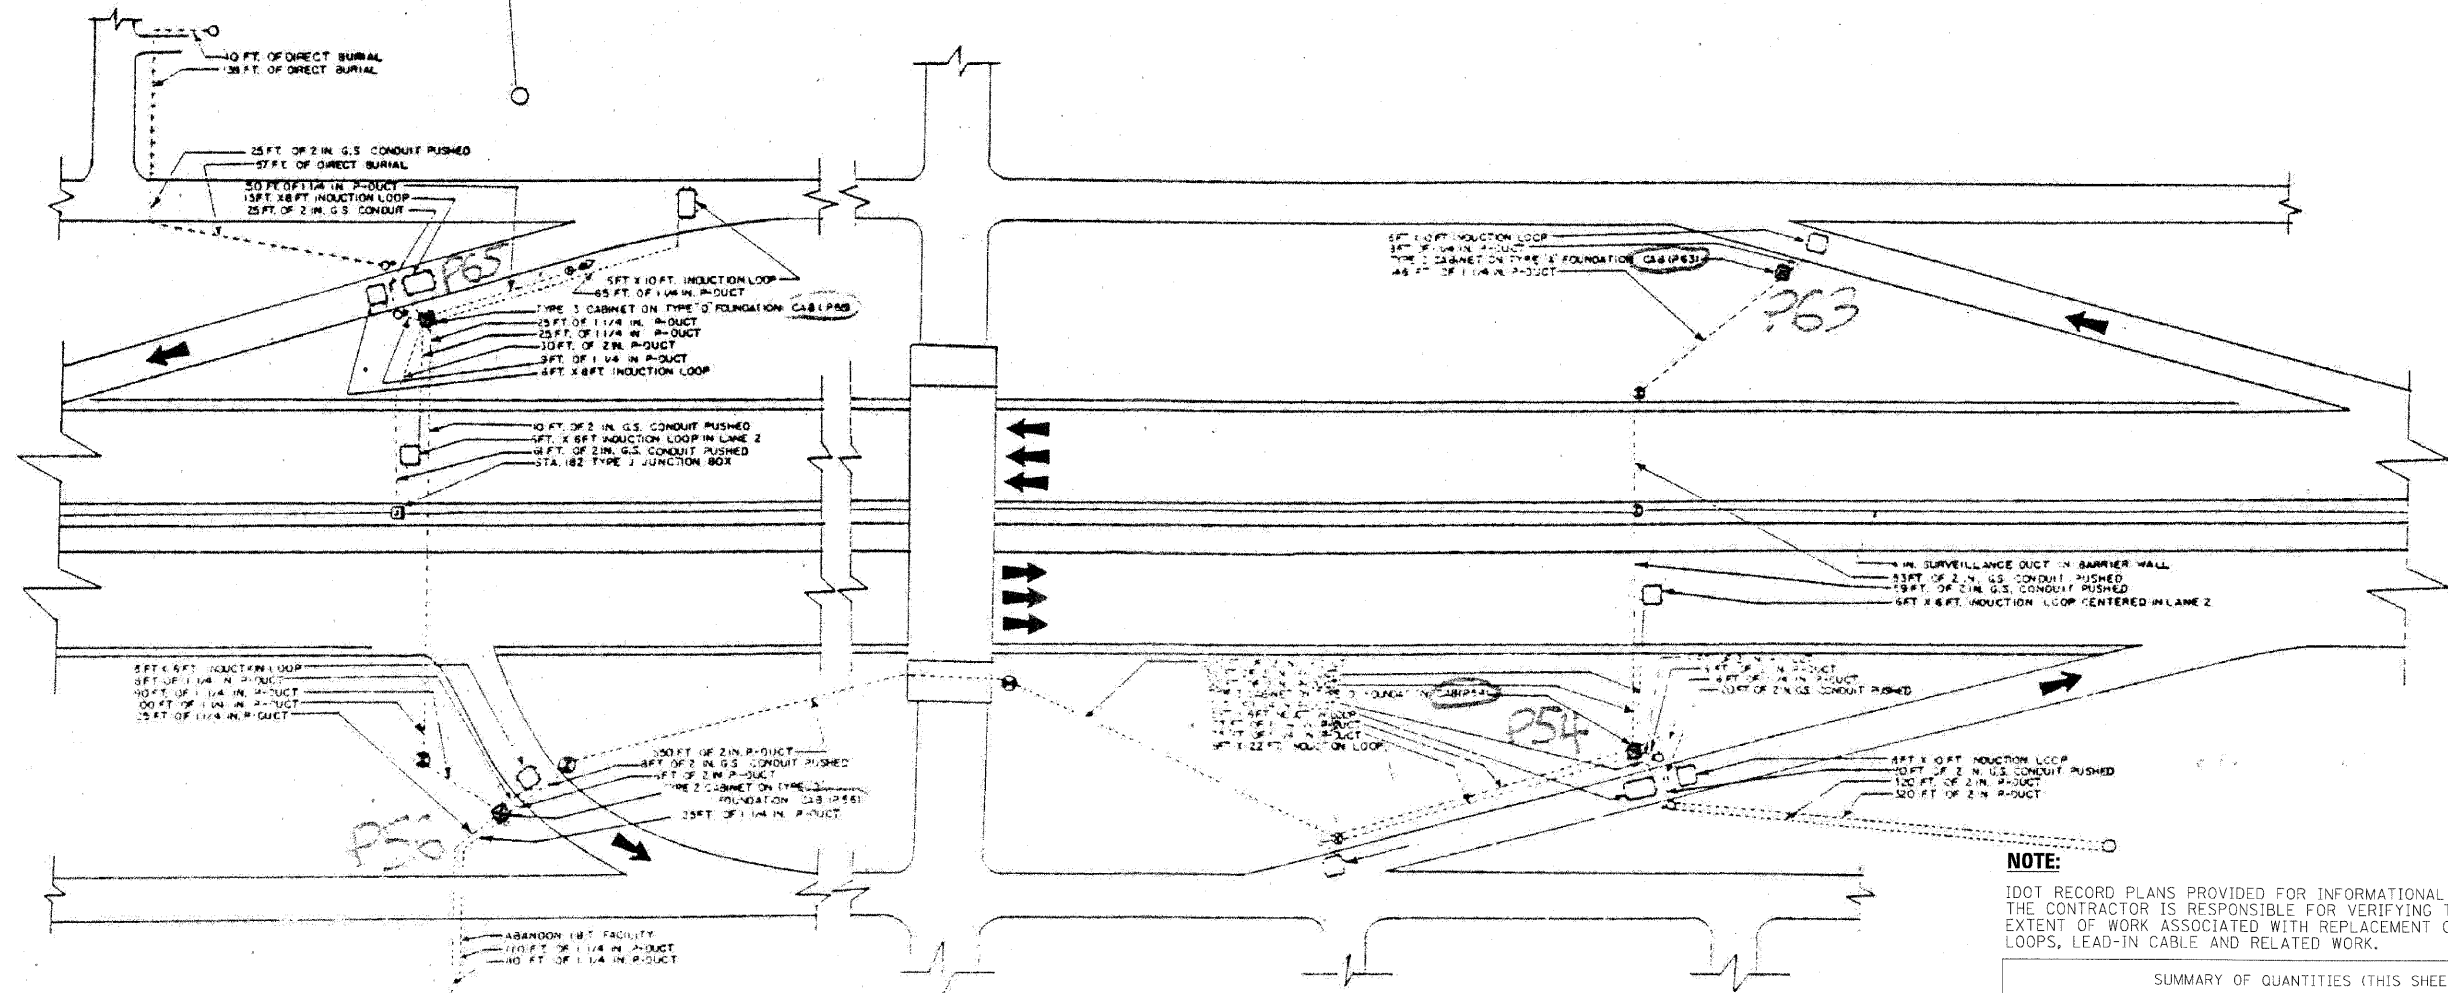

NOTE:
 IDOT RECORD PLANS PROVIDED FOR INFORMATIONAL PURPOSES ONLY. THE CONTRACTOR IS RESPONSIBLE FOR VERIFYING THE LOCATION AND EXTENT OF WORK ASSOCIATED WITH REPLACEMENT OF INDUCTION LOOPS, LEAD-IN CABLE AND RELATED WORK.

SUMMARY OF QUANTITIES (THIS SHEET)		
DESCRIPTION	UNIT	QUANTITY
ELECTRIC CABLE IN CONDUIT, LEAD-IN, NO. 18 4/C, TWISTED, SHIELDED	LF	302
INDUCTION LOOP	LF	399

FILE NAME =	DESIGNED - GHT	REVISED -
...\\Signels\prp\In_ABC_C2.ts_09.dgn	DRAWN - TMB	REVISED -
USER NAME = tblank	CHECKED - MPM	REVISED -
PLOT DATE = 1/25/2010	DATE - 1/25/10	REVISED -

benesch

STATE OF ILLINOIS
 DEPARTMENT OF TRANSPORTATION

TRAFFIC SURVEILLANCE
 17TH AVE INSTALLATION
 SCALE: N.T.S. SHEET NO. 1 OF 8 SHEETS STA. TO STA.

F.A.I. RTE.	SECTION	COUNTY	TOTAL SHEETS	SHEET NO.
290	(3435, ETC., 3838RS-5	COOK	264	225
FED. ROAD DIST. NO.		ILLINOIS FED. AID PROJECT		

CONTRACT NO. 60G52