


ROUTE NO.	SECTION	COUNTY	TOTAL SHEETS	SHEET NO.
F.A. 131	2525.1-1B	COOK	30	3
FED. ROAD DIST. NO. 6 ILLINOIS			PROJECT U.S. 66 (2)	

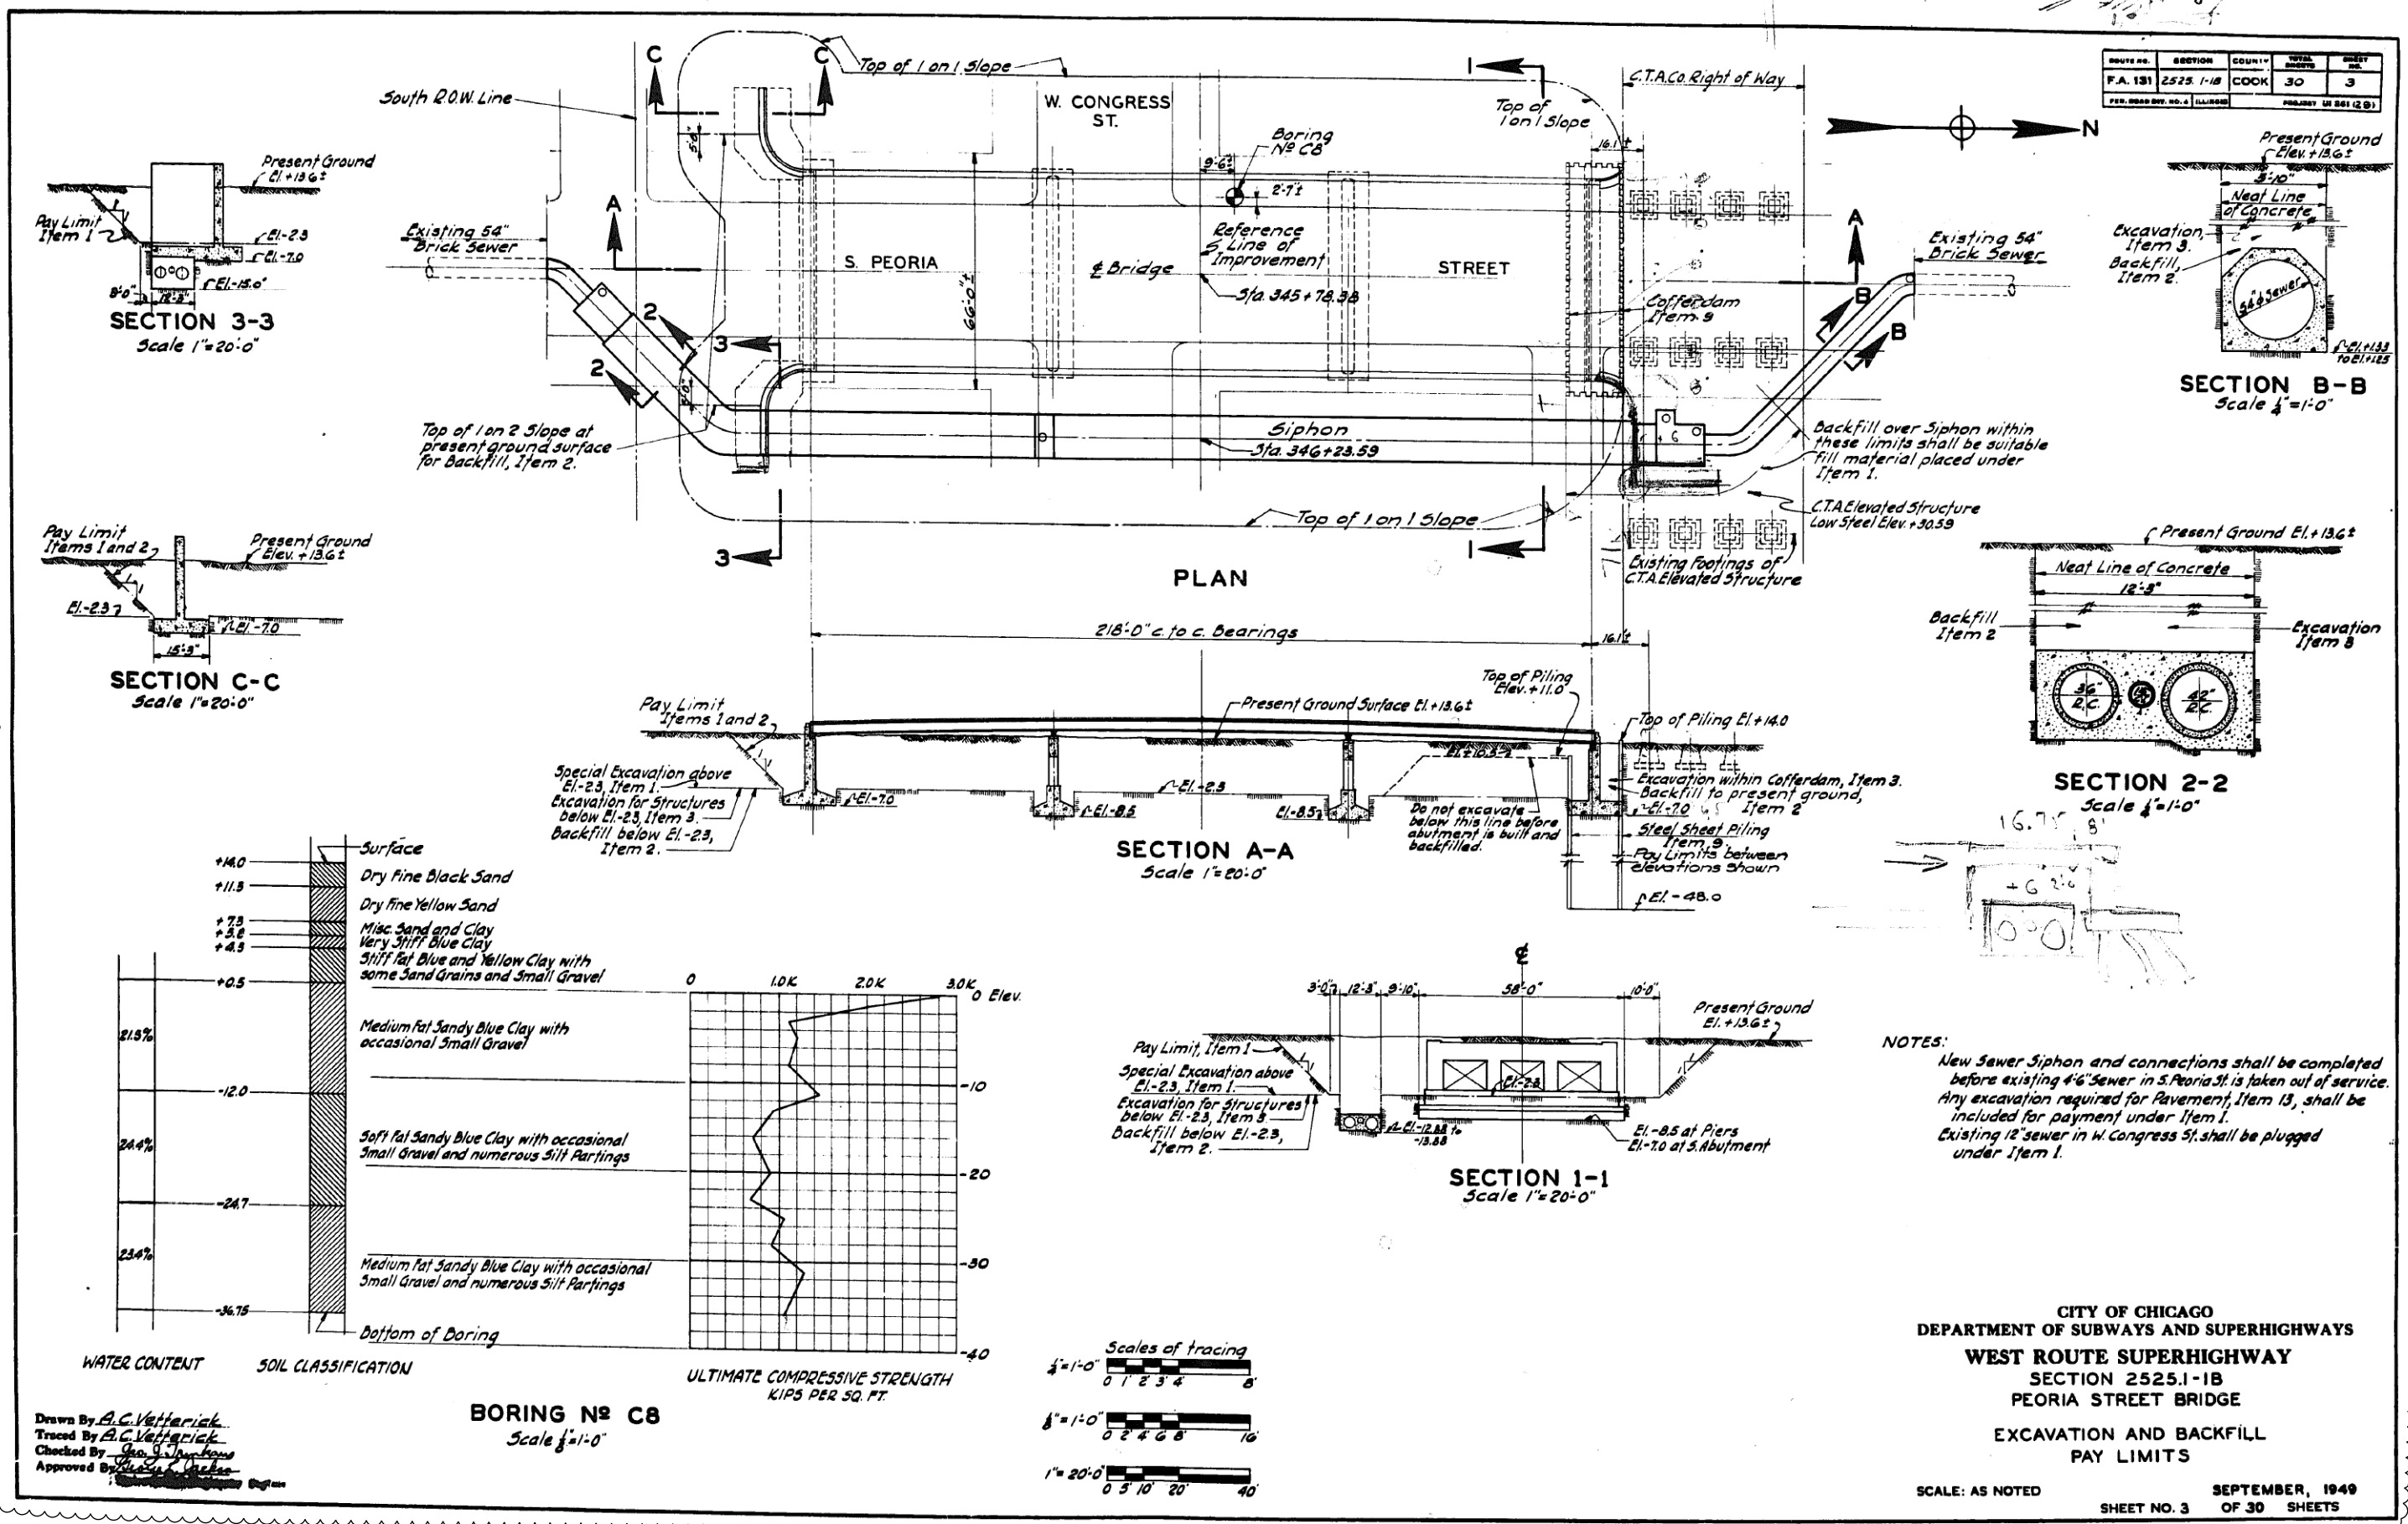


**NOTES:**  
 New Sewer Siphon and connections shall be completed before existing 4'-6" sewer in S. Peoria St. is taken out of service. Any excavation required for Pavement, Item 13, shall be included for payment under Item 1.  
 Existing 12" sewer in W. Congress St. shall be plugged under Item 1.

**CITY OF CHICAGO**  
**DEPARTMENT OF SUBWAYS AND SUPERHIGHWAYS**  
**WEST ROUTE SUPERHIGHWAY**  
**SECTION 2525.1-1B**  
**PEORIA STREET BRIDGE**  
**EXCAVATION AND BACKFILL**  
**PAY LIMITS**  
 SCALE: AS NOTED  
 SEPTEMBER, 1949  
 SHEET NO. 3 OF 30 SHEETS

Drawn By *A.C. Vetterick*  
 Traced By *A.C. Vetterick*  
 Checked By *Geo. J. Johnson*  
 Approved By *Charles E. DeLoe*  
 Illinois State Highway Dept.

**BORING NO. C8**  
 Scale 1/4" = 1'-0"

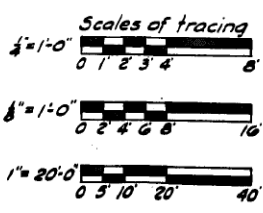

D:\6029-sht-Ex-Siphon-03.dgn	DESIGNED -	REVISED -	12/18/2013
USER NAME = BAW:tor t	DRAWN - BAW	REVISED -	
PLOT SCALE = 100.0000 / in.	CHECKED - JWC	REVISED -	
PLOT DATE = 12/19/2013	DATE - 10/30/2013	REVISED -	

**STATE OF ILLINOIS**  
**DEPARTMENT OF TRANSPORTATION**

<b>AS BUILT SIPHON PLANS</b>			
<b>PEORIA STREET</b>			
SCALE: NONE	SHEET 3	OF 14 SHEETS	STA. TO STA.

F.A.I. R.E.	SECTION	COUNTY	TOTAL SHEETS	SHEET NO.
90/94/290	2013-011R	COOK	356	76D
ILLINOIS FED. AID PROJECT			CONTRACT NO. 60W29	