


FILE PATH = c:\p1\388935\part1\escomon\line\local\PAE\CD\000\Documents\01_Americas\Transportation\662629938_Circle Phase II\000_CAD\000_Roadway_Sheets\662629938_sht-Ex-Siphon-11.dgn

SECTION	2525-1B	33	28
DATE	12/18/2013		

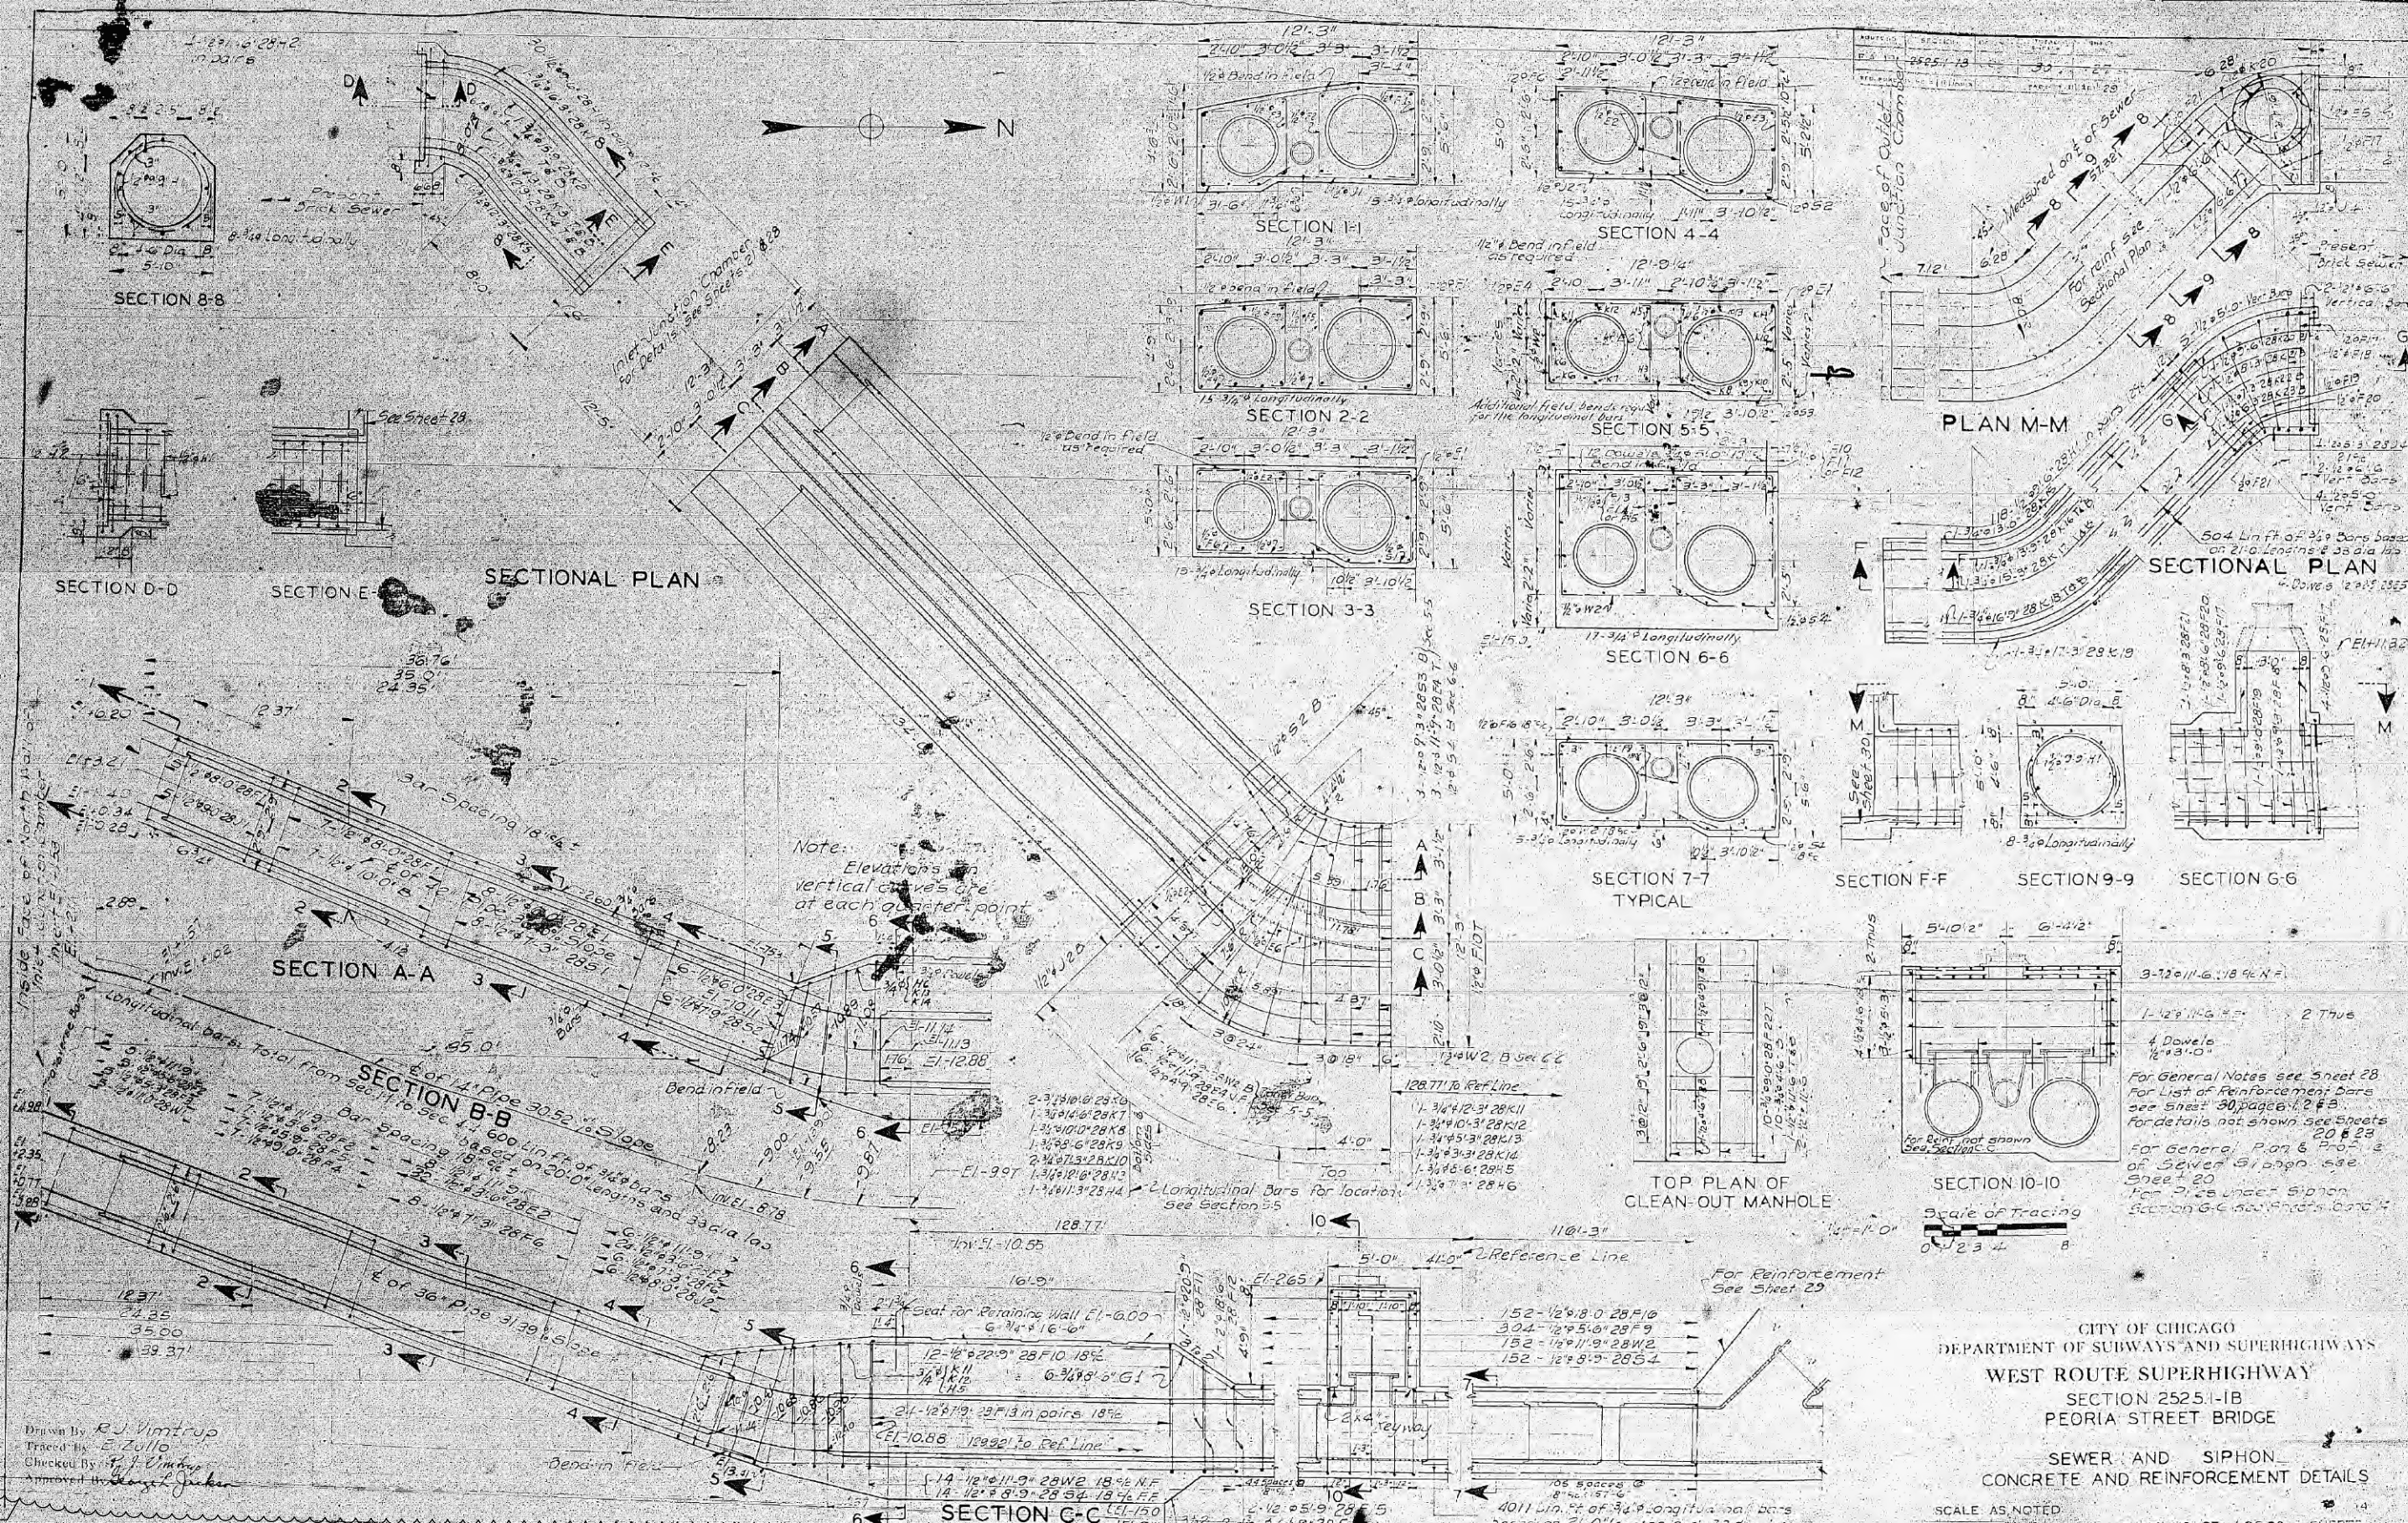

Note:
Elevations on vertical curves are at each center point

For General Notes see Sheet 28
For List of Reinforcement Bars see Sheet 30, page 2 of 3
For details not shown see Sheets 20 & 23
For General Plan & Profile of Sewer Siphon see Sheet 20
For Details under Siphon Section G-G see Sheet 20

CITY OF CHICAGO
DEPARTMENT OF SUBWAYS AND SUPERHIGHWAYS
WEST ROUTE SUPERHIGHWAY
SECTION 2525-1B
PEORIA STREET BRIDGE
SEWER AND SIPHON
CONCRETE AND REINFORCEMENT DETAILS



D160W29-sht-Ex-Siphon-11.dgn
USER NAME = BAW1tor1
PLOT SCALE = 100.0000' / in.
PLOT DATE = 12/19/2013

DESIGNED -	REVISIONS -	DATE -
DRAWN - BAW	12/18/2013	
CHECKED - JWC		
DATE - 10/30/2013		

STATE OF ILLINOIS
DEPARTMENT OF TRANSPORTATION

AS BUILT SIPHON PLANS
PEORIA STREET

SCALE: NONE SHEET 11 OF 14 SHEETS STA. TO STA.

F.A.I. RTE.	SECTION	COUNTY	TOTAL SHEETS	SHEET NO.
90/94/290	2013-011R	COOK	356	76L
CONTRACT NO. 60W29				
ILLINOIS FED. AID PROJECT				