



THE LOCATION OF THE UTILITIES SHOWN ARE DETERMINED FROM THE BEST AVAILABLE DATA. THEY ARE FOR INFORMATIONAL PURPOSES ONLY AND ARE NOT INTENDED TO PURPORT THE ACTUAL LOCATIONS OF SUCH UTILITIES. THE CONTRACTOR SHALL VERIFY THE LOCATIONS OF THE UTILITIES IN THE FIELD AT THE TIME OF CONSTRUCTION. THE CONTRACTOR SHALL BE RESPONSIBLE FOR PROTECTING ALL UTILITIES AND SHALL BE LIABLE FOR ANY DAMAGES TO THEM RESULTING FROM HIS OPERATIONS.

NEW WATERMAIN SHALL BE 12-INCH D.I.P. TYTON JOINT, PRESSURE CLASS 350 WITH 8 MIL POLYETHYLENE PIPE WRAP

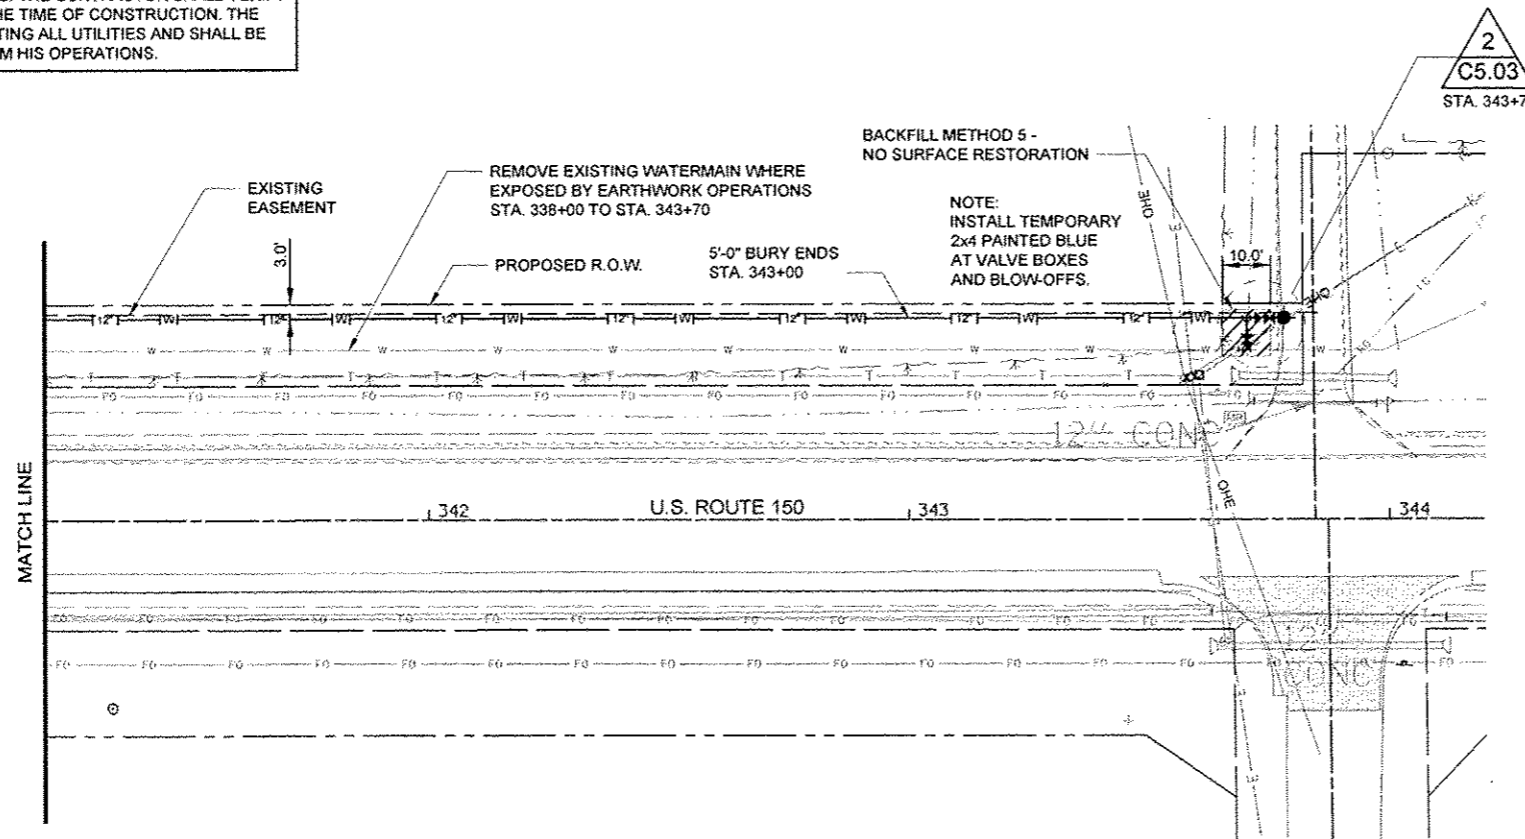

**NOTICE**  
SEE "EXISTING WATERMAIN SHUT-OFF" SHEET G0.03, FOR REQUIRED PROCEDURES TO CUT AND PLUG EXISTING MAIN

- TEMPORARY BLOW-OFF**
1. INSTALL BLOW-OFF DISCHARGE 3 FEET ABOVE GRADE.
  2. DIRECT BLOW-OFF FLOW TOWARD LOCAL DRAINAGE.
  3. REMOVE BLOW-OFF AT THE REQUEST OF ILAW.

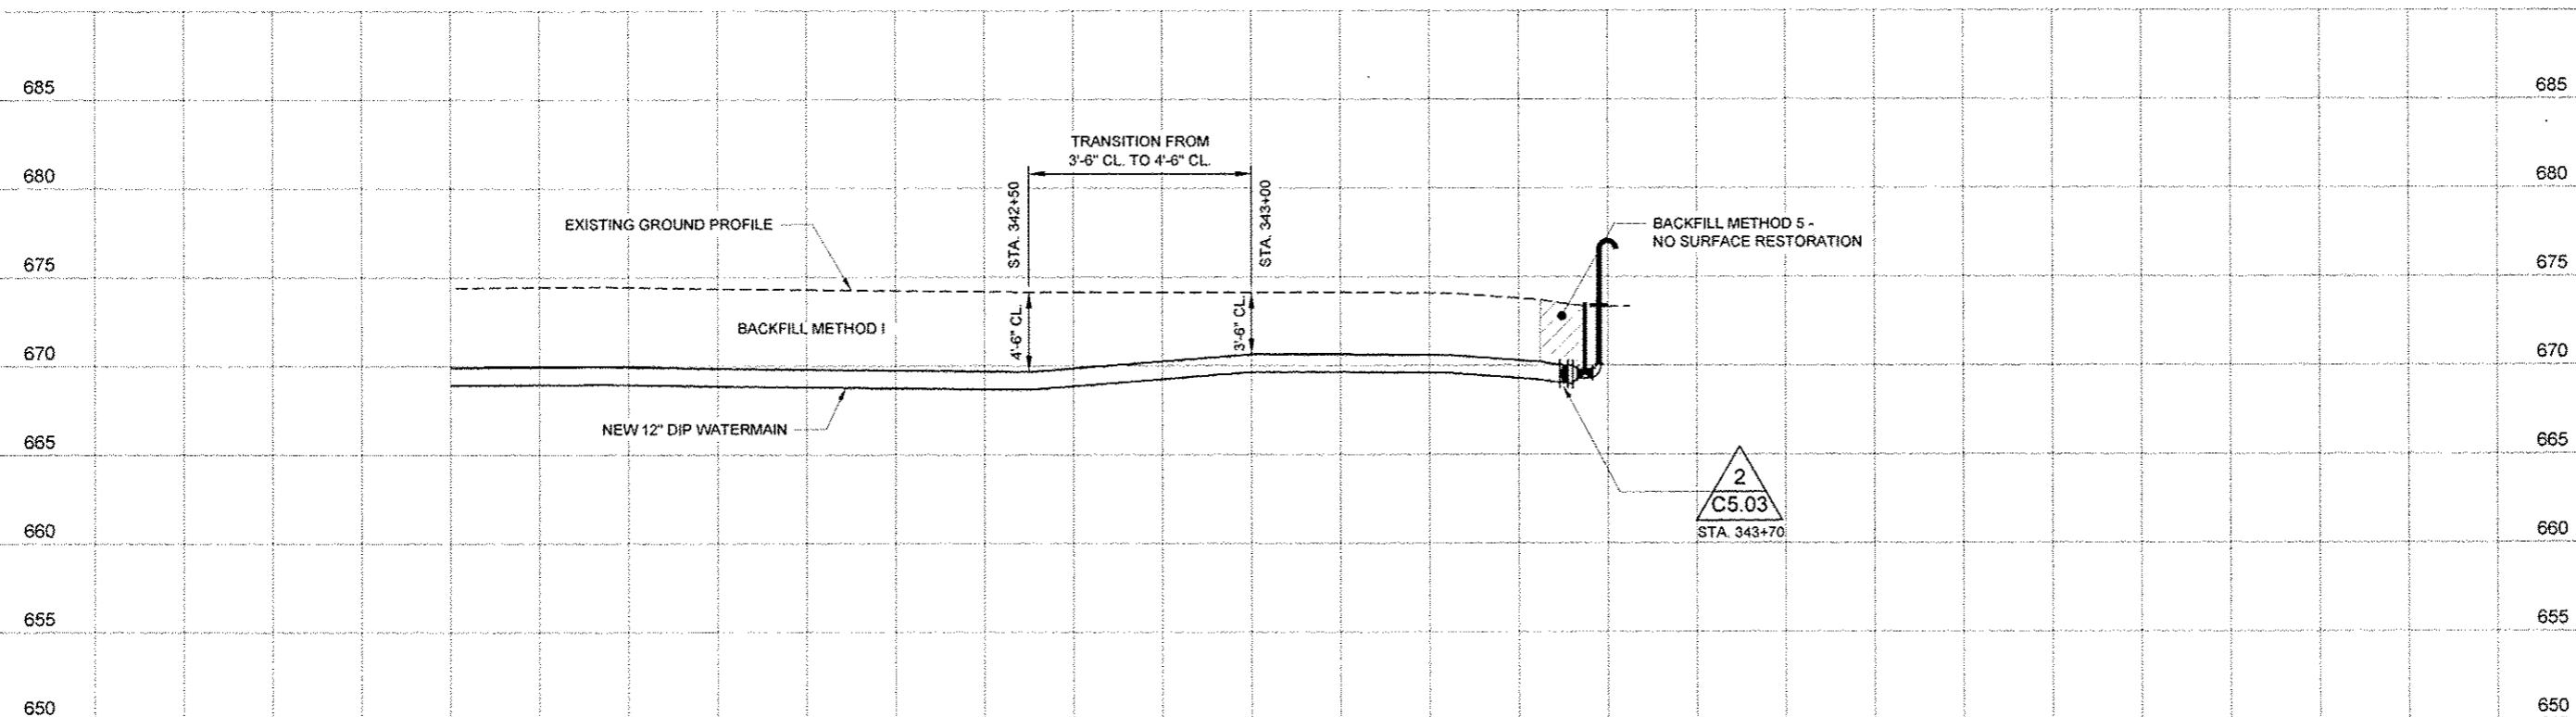


42" MINIMUM COVER TO 48" MAXIMUM COVER FOR WATERMAIN INSTALLATION UNLESS NOTED ON DRAWINGS OR APPROVED BY ILLINOIS AMERICAN WATER.

CUSTOMER NOTIFICATION OF SERVICE INTERRUPTION, IF NECESSARY, WILL BE THE RESPONSIBILITY OF ILLINOIS-AMERICAN. CONTRACTOR SHALL ADHERE TO THE SUBMITTED CONSTRUCTION SCHEDULE OR NOTIFY ILLINOIS-AMERICAN OF ANY DELAYS ONE WEEK PRIOR TO SCHEDULED WORK.

TRAFFIC CONTROL SHALL BE IN ACCORDANCE WITH IDOT STD 701101 UNLESS NOTED OTHERWISE.

WATERMAIN BACKFILL, FINAL GRADING, TOPSOIL STORAGE AND REPLACEMENT, SEEDING AND MULCHING SHALL BE AS REQUIRED IN THE STANDARD SPECIFICATIONS FOR WATER AND SEWER MAIN CONSTRUCTION IN ILLINOIS.

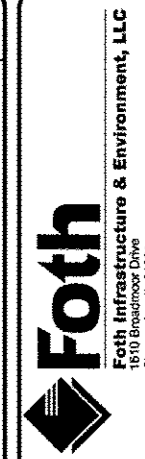

**Foth Infrastructure & Environment, LLC**  
1610 Brantmore Drive  
Champaign, IL 61821  
Phone: 217-352-4169 Fax: 217-352-0085  
Illinois Professional Design Firm No. 154.004913

REUSE OF DOCUMENTS  
THIS DOCUMENT HAS BEEN DEVELOPED FOR A SPECIFIC APPLICATION AND NOT FOR GENERAL USE. THEREFORE IT MAY NOT BE USED WITHOUT THE WRITTEN APPROVAL OF FOTH INFRASTRUCTURE & ENVIRONMENT, LLC. UNAUTHORIZED USE IS THE SOLE RESPONSIBILITY OF THE UNAUTHORIZED USER.


**ROUTE 150 WATERMAIN RELOCATION  
BETWEEN URBANA AND ST. JOSEPH  
ILLINOIS AMERICAN WATER COMPANY  
IDOT CONTRACT NO. 70663**

CHAMPAIGN COUNTY URBANA, ILLINOIS

REVISIONS		RECORD DRAWING OF COMPLETED CONSTRUCTION BY	DATE
NO.	BY	DESCRIPTION	DATE
1	MAJ	RECORD DRAWING OF COMPLETED CONSTRUCTION	
2	MAJ	RECORD DRAWING OF COMPLETED CONSTRUCTION	
3	MAJ	RECORD DRAWING OF COMPLETED CONSTRUCTION	

Date of Preparation: July 17, 2013	
BY	DATE
SURVEYED: FOTH	07-13-2013
DRAWN: WGH	07-17-2013
DESIGNED: MAJ	07-17-2013
CHECKED: MAJ	07-17-2013

SHEET NAME  
STA. 341+20 TO  
STA. 343+70

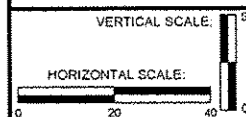

PROJECT ID 11013

**C1.23**  
SHEET 26 OF 29