

STATE OF ILLINOIS
DEPARTMENT OF TRANSPORTATION

F.A. RTE	SECTION	COUNTY	TOTAL SHEETS	SHEET NO.
VARIOUS	D3 LIGHTING REPAIR 2019-4	VARIOUS	3	1
		ILLINOIS	CONTRACT NO. 66J78	

INDEX OF SHEETS




1. COVER SHEET
2. GENERAL NOTES & HIGHWAY STANDARDS
3. SUMMARY OF QUANTITIES

PROPOSED HIGHWAY PLANS

VARIOUS ROUTES
SECTION D3 LIGHTING REPAIR 2019-4
PROJECT
AREA FOUR ON CALL LIGHTING REPAIR
VARIOUS COUNTIES

C-93-058-19

D-93-037-19

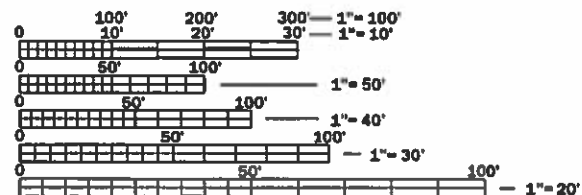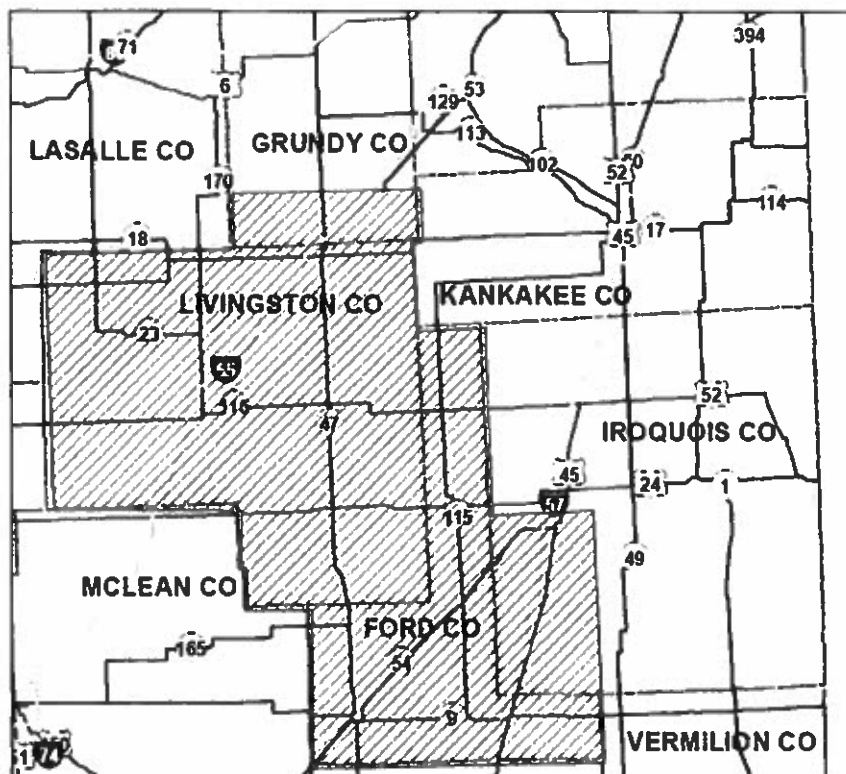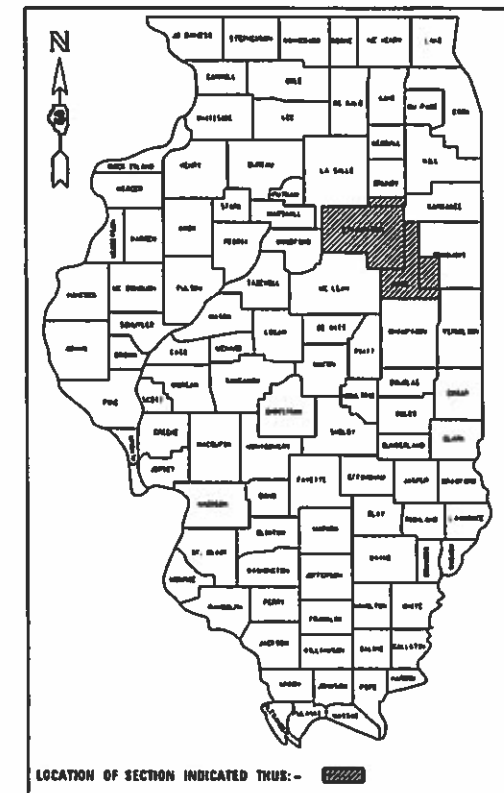

FULL SIZE PLANS HAVE BEEN PREPARED USING STANDARD ENGINEERING SCALES. REDUCED SIZED PLANS WILL NOT CONFORM TO STANDARD SCALES. IN MAKING MEASUREMENTS ON REDUCED PLANS, THE ABOVE SCALES MAY BE USED.

J.U.L.I.E.
JOINT UTILITY LOCATION INFORMATION FOR EXCAVATION
1-800-892-0123
OR 811

PROJECT ENGINEER: YOGESH PATEL P.E.
UNIT CHIEF: DAN DEVINE P.E.
TOWNSHIPS: VARIOUS
DISTRICT 3 NO. (815) 434-6131
CONTRACT NO. 66J78

STATE OF ILLINOIS
DEPARTMENT OF TRANSPORTATION

SUBMITTED 12/20 2018
[Signature]
REGIONAL ENGINEER

Feb 20 2019
[Signature]
ENGINEER OF DESIGN AND ENVIRONMENT

Feb 20 2019
[Signature]
DIRECTOR OF HIGHWAYS PROJECT IMPLEMENTATION

PRINTED BY THE AUTHORITY
OF THE STATE OF ILLINOIS

LIST OF ILLINOIS DOT HIGHWAY STANDARDS

- 701001-02 OFF-ROAD OPERATIONS 2L, 2W, MORE THAN 15' (4.5 m) AWAY
- 701006-05 OFF-ROAD OPERATIONS 2L, 2W, 15' (4.5 m) TO 24" (600 mm) FROM PAVEMENT EDGE
- 701101-05 OFF-ROAD OPERATIONS MULTILANE, 15' (4.5 m) TO 24" (600 mm) FROM PAVEMENT EDGE
- 701106-02 OFF-ROAD OPERATIONS, MULTILANE, MORE THAN 15' (4.5 m) AWAY
- 701201-05 LANE CLOSURE, 2L, 2W, DAY ONLY, FOR SPEEDS ≥ 45 MPH
- 701206-05 LANE CLOSURE, 2L, 2W, NIGHT ONLY, FOR SPEEDS ≥ 45 MPH
- 701301-04 LANE CLOSURE, 2L, 2W, SHORT TIME OPERATIONS
- 701400-09 APPROACH TO LANE CLOSURE, FREEWAY/EXPRESSWAY
- 701401-12 LANE CLOSURE, FREEWAY/EXPRESSWAY
- 701406-12 LANE CLOSURE, FREEWAY/EXPRESSWAY, DAY OPERATIONS ONLY
- 701411-09 LANE CLOSURE, MULTILANE, AT ENTRANCE OR EXIT RAMP FOR SPEEDS ≥ 45 MPH
- 701421-08 LANE CLOSURE, MULTILANE, DAY OPERATIONS ONLY, FOR SPEEDS ≥ 45 MPH TO 55 MPH
- 701422-10 LANE CLOSURE, MULTILANE, FOR SPEEDS ≥ 45 MPH TO 55 MPH
- 701426-09 LANE CLOSURE, MULTILANE INTERMITTENT OR MOVING OPERATION, FOR SPEEDS ≥ 45 MPH
- 701427-05 LANE CLOSURE, MULTILANE INTERMITTENT OR MOVING OPERATION, FOR SPEEDS ≤ 40 MPH
- 701428-01 TRAFFIC CONTROL SETUP AND REMOVAL FREEWAY/EXPRESSWAY
- 701456-05 PARTIAL EXIT RAMP CLOSURE FREEWAY/EXPRESSWAY
- 701601-09 URBAN LN CLOSURE 2L 2W WITH BIDIRECT LEFT TURN LN
- 701901-08 TRAFFIC CONTROL DEVICES

GENERAL NOTES

THE LOCATIONS OF THE REPAIR AREAS SHALL BE DETERMINED BY THE ENGINEER.

REMOVAL OF DAMAGED MATERIALS SHALL INCLUDE DISMANTLING, LOADING, HAULING, AND DISPOSAL.

THE WORK SITE SHALL BE LEFT IN A SAFE AND ORDERLY CONDITION.

NO MATERIAL SHOULD BE LEFT ON OR NEAR THE ROADWAY.

ALL EXCAVATED MATERIAL, WHICH INCLUDED DIGGING OR GRADING OF ANY SOIL OR FILL MATERIAL, WITH THE EXCEPTION OF AGGREGATE FILLS, MUST BE INCORPORATED WITHIN, THE IDOT RIGHT OF WAY DUE TO ENVIRONMENTAL DOCUMENTATION REQUIREMENTS

ANY WORK ORDER MAY BE CANCELLED AT THE ENGINEERS DISCRETION.

NO OVERNIGHT LANE CLOSURES WILL BE ALLOWED.

ANY REFERENCE TO A STANDARD IN THESE PLANS SHALL BE INTERPRETED TO MEAN THE EDITION AS INDICATED BY THE SUBNUMBER SHOWN IN THE LIST OF STANDARDS OR THE COPY INCLUDED IN THESE PLANS.

THE CONTRACTOR IS ADVISED THAT THERE MAY BE PRESENCE OF DEPARTMENT OWNED UNDERGROUND ELECTRICAL CABLE WITHIN THE LIMITS OF THE PROPOSED IMPROVEMENT. THE CONTRACTOR SHALL REQUEST THE ILLINOIS DEPARTMENT OF TRANSPORTATION IN OTTAWA (815-434-8505) TO LOCATE THE UNDERGROUND FACILITIES, PROVIDING A MINIMUM 72 HOURS NOTICE. THE DEPARTMENT IS NOT A MEMBER OF THE JOINT UTILITY LOCATION INFORMATION FOR EXCAVATORS (JULIE) SYSTEM.

ALL DAMAGE TO DEPARTMENT OWNED UNDERGROUND FACILITIES, CAUSED BY THE CONTRACTOR SHALL BE REPAIRED TO THE SATISFACTION OF THE DEPARTMENT AT THE CONTRACTOR'S EXPENSE. THIS SHALL INCLUDE ALL TEMPORARY REPAIRS REQUIRED TO KEEP THE FACILITY OPERATIONAL WHILE MATERIAL IS BEING OBTAINED TO MAKE PERMANENT REPAIRS. SPLICING OF ELECTRIC CABLE WILL NOT BE ALLOWED. ELECTRIC CABLE SHALL BE REPLACED FROM POLE TO POLE OR CONTROLLER.

THE CONTRACTOR SHALL BE RESPONSIBLE FOR PROTECTING UTILITY PROPERTY FROM CONSTRUCTION OPERATIONS AS OUTLINED IN ARTICLE 107.31 OF THE STANDARD SPECIFICATIONS. THE J.U.L.I.E NUMBER IS 1-800-892-0123. A MINIMUM OF 48 HOURS ADVANCE NOTICE IS REQUIRED.

STATE OF ILLINOIS
DEPARTMENT OF TRANSPORTATION
DISTRICT THREE
AS BUILT INFORMATION

STATE OF ILLINOIS
DEPARTMENT OF TRANSPORTATION
DISTRICT THREE

SUPERVISING CONSTRUCTION FIELD ENGINEER

DATE: 12-20-19

RESIDENT ENGINEER / TECHNICIAN

PREPARED BY: [Signature]
DISTRICT OPERATIONS ENGINEER

START & END DATES
OF CONSTRUCTION:

EXAMINED BY: [Signature]
DISTRICT STUDIES & PLANS ENGINEER

INSPECTORS:

[Signature]
DISTRICT CONSTRUCTION ENGINEER

[Signature]
DISTRICT MATERIALS ENGINEER

STATE OF ILLINOIS
DEPARTMENT OF TRANSPORTATION

F.A. RTE	SECTION	COUNTY	TOTAL SHEETS	SHEET NO.
VARIOUS	D3 LIGHTING REPAIR 2019.4	VARIOUS	3	2
CONTRACT NO. 66J78			ILLINOIS	

USER NAME = flanaganr	DESIGNED -	REVISED -
	DRAWN -	REVISED -
PLOT SCALE = 100.0740' / in	CHECKED -	REVISED -
PLOT DATE = 1/10/2019	DATE -	REVISED -

MODEL: D:\aspl\...
 FILE NAME: pw\...
 ILLINOIS STATE DEPARTMENT OF TRANSPORTATION

CONSTRUCTION CODE
STATE FUNDS
100%
ROADWAY
0021
RURAL

CODE NO.	ITEM	UNIT	TOTAL QUANTITY	VARIOUS COUNTIES
X7011834	TRAFFIC CONTROL AND PROTECTION, CALL OUT WORK	EACH	4	4
XP000001	JOURNEYMAN ELECTRICIAN	HOURL	300	300
XP000002	APPRENTICE ELECTRICIAN	HOURL	100	100
XP000003	JOURNEYMAN ELECTRICIAN (WEEKLY OVERTIME RATE)	HOURL	25	25
XP000004	JOURNEYMAN ELECTRICIAN (SATURDAY OVERTIME RATE)	HOURL	25	25
XP000005	JOURNEYMAN ELECTRICIAN (SUNDAY AND HOLIDAY OVERTIME RATE)	HOURL	15	15
XP000006	APPRENTICE ELECTRICIAN (WEEKLY OVERTIME RATE)	HOURL	25	25
XP000007	APPRENTICE ELECTRICIAN (SATURDAY OVERTIME RATE)	HOURL	25	25
XP000008	APPRENTICE ELECTRICIAN (SUNDAY AND HOLIDAY OVERTIME RATE)	HOURL	25	25
XP000009	PICK-UP TRUCK	HOURL	200	200
XP000010	BUCKET TRUCK (LENGTH LESS THAN 35 FEET)	HOURL	60	60
XP000011	BUCKET TRUCK (LENGTH 35 TO 65 FEET)	HOURL	100	100

USER NAME = fanaganr	DESIGNED -	REVISED -
	DRAWN -	REVISED -
PLOT SCALE = 100.5129' / in.	CHECKED -	REVISED -
PLOT DATE = 1/10/2019	DATE -	REVISED -

**STATE OF ILLINOIS
 DEPARTMENT OF TRANSPORTATION**

SCALE	SHEET	OF	SHEETS	STA	TO STA
-------	-------	----	--------	-----	--------

F A RTE	SECTION	COUNTY	TOTAL SHEETS	SHEET NO
VARIOUS	D3 LIGHTING REPAIR 2109-4	VARIOUS	3	3
			CONTRACT NO. 66178	
ILLINOIS				