

# SUMMARY OF QUANTITIES

CODE NO.	ITEM	UNIT	TOTAL QUANTITY	MFT/STU FUNDS	ITEP FUNDS
△ *	X7830078 GROOVING FOR RECESSED PAVEMENT MARKING 13"	FOOT	126		126
△ *	X8211190 LUMINAIRE, LED, HORIZONTAL MOUNT, 160W (SPECIAL)	EACH	11	11	
*	XX000856 MAILBOX REMOVAL AND RELOCATION	EACH	3		3
△ *	<del>Z0043790 CONSTRUCTION LAYOUT</del>	<del>LSUM</del>	<del>1</del>	<del>0.75</del>	<del>0.25</del>
*	Z0003850 BENCHES	EACH	2	2	
△ *	Z0007601 BUILDING REMOVAL NO. 1	LSUM	1		1
*	Z0022800 FENCE REMOVAL	FOOT	379		379
*	Z0054500 ROCK FILL	TON	410		410
*	Z0064562 SEGMENTAL BLOCK RETAINING WALL REPAIR	SQ FT	82	61	21
# *	Z0076600 TRAINEES	HOUR	1000		
# *	Z0076604 TRAINEES TRAINING PROGRAM GRADUATE	HOUR	1000		

△ SPECIALTY ITEMS #0042

\* PAY ITEM REQUIRES A SPECIAL PROVISION



© Copyright Hanson Professional Services Inc. 2019


FINAL

FILE NAME =	USER NAME = Shipp01364	DESIGNED - JDS	REVISED - <del>Δ</del> 2/14/19	<b>STATE OF ILLINOIS DEPARTMENT OF TRANSPORTATION</b>	<b>SUMMARY OF QUANTITIES - 10</b>	F.A.U. RTE.	SECTION	COUNTY	TOTAL SHEETS	SHEET NO.	
1:\14\jobs\14L0114A\CAD\Road\Sheet\C-6015.dgn		DRAWN - JDS	REVISED -			6998	16-00352-00-PV	VERMILION	125	13	
PLOT SCALE = 0.1667' / 1"		CHECKED - MH	REVISED -			C-95-071-18 CONTRACT NO. 91752					
Sheet 10	PLOT DATE = 2/4/2019	DATE - 12/19/2018	REVISED -			ILLINOIS FED. AID PROJECT					

SCALE: SHEET 9 OF 9 SHEETS STA. TO STA.


GUARDRAIL NOTE:  
 THE LOCATION OF GUARDRAIL TYPE B SHALL BE PLACED TO AVOID CONFLICT WITH THE EXISTING FIBER OPTIC DUCT. THE FIBER LINES SHALL BE FIELD LOCATED AND PLACEMENT OF PROPOSED GUARDRAIL WILL BE ADJUSTED WITHIN THE 3' SHOULDER TO AVOID IMPACTS TO THE FIBER.

EXISTING R.O.W.

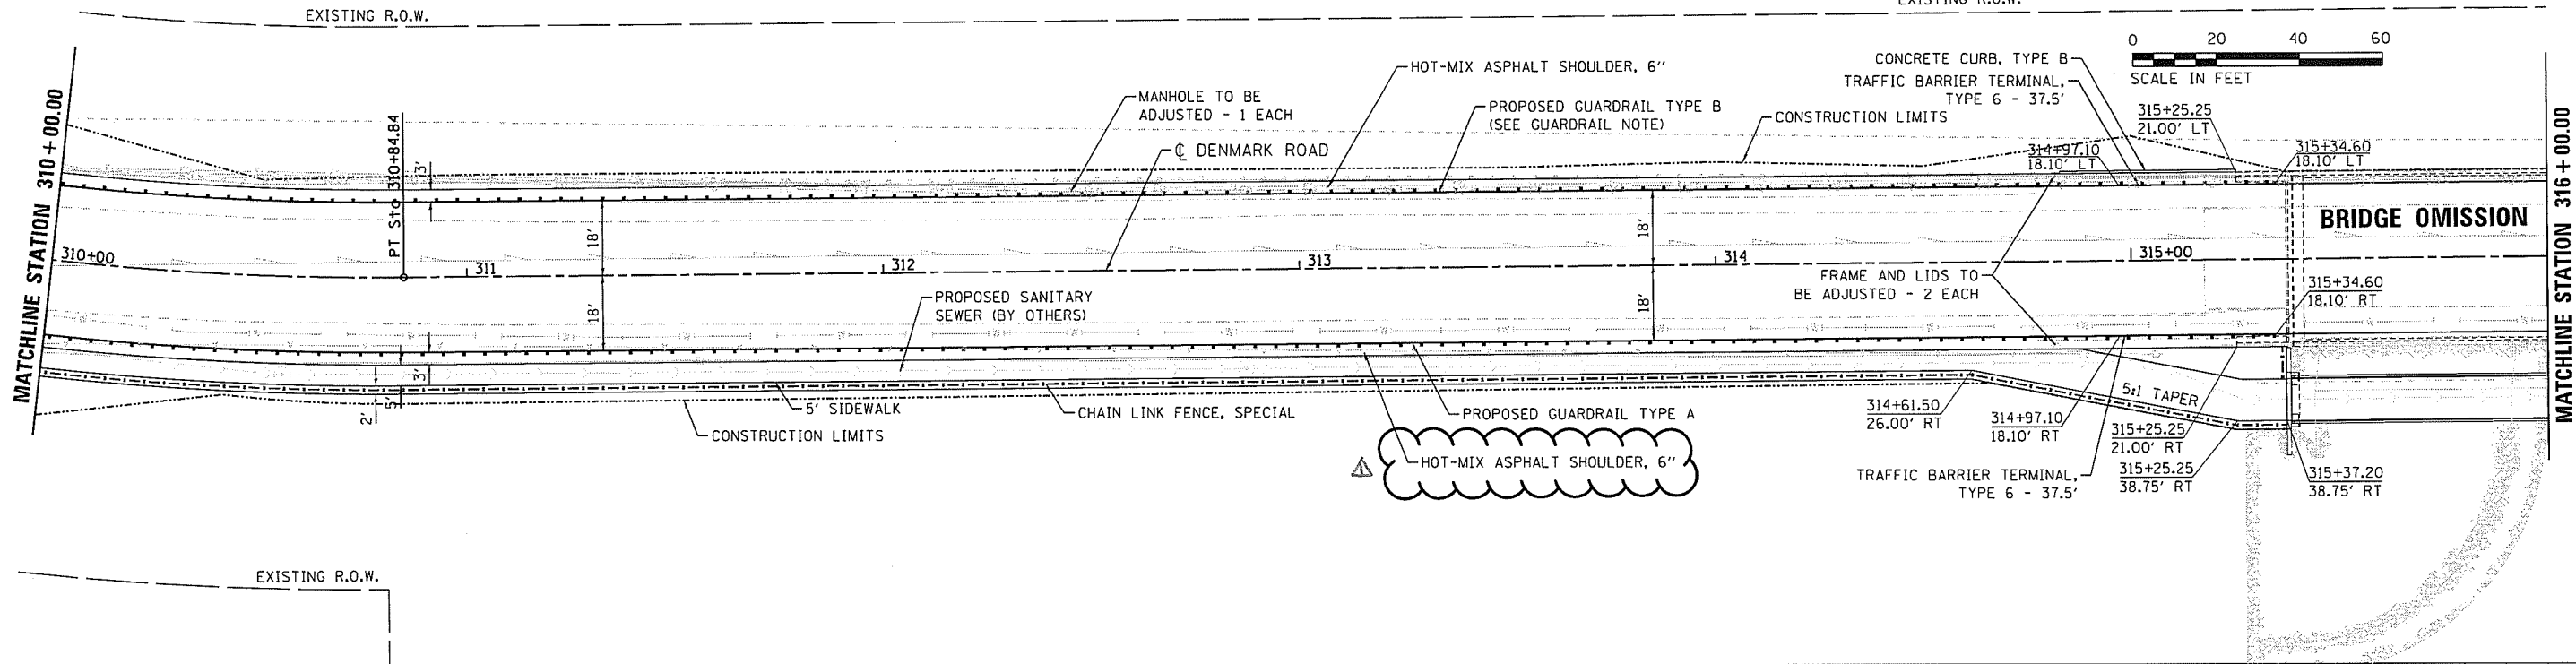

PLAN	DESIGNED	DATE
	DRAWN	BY
	CHECKED	
	REVIEWED	

PROFILE	GRADES CHECKED	DATE
	STRUCTURE NOTATIONS CHNG	BY

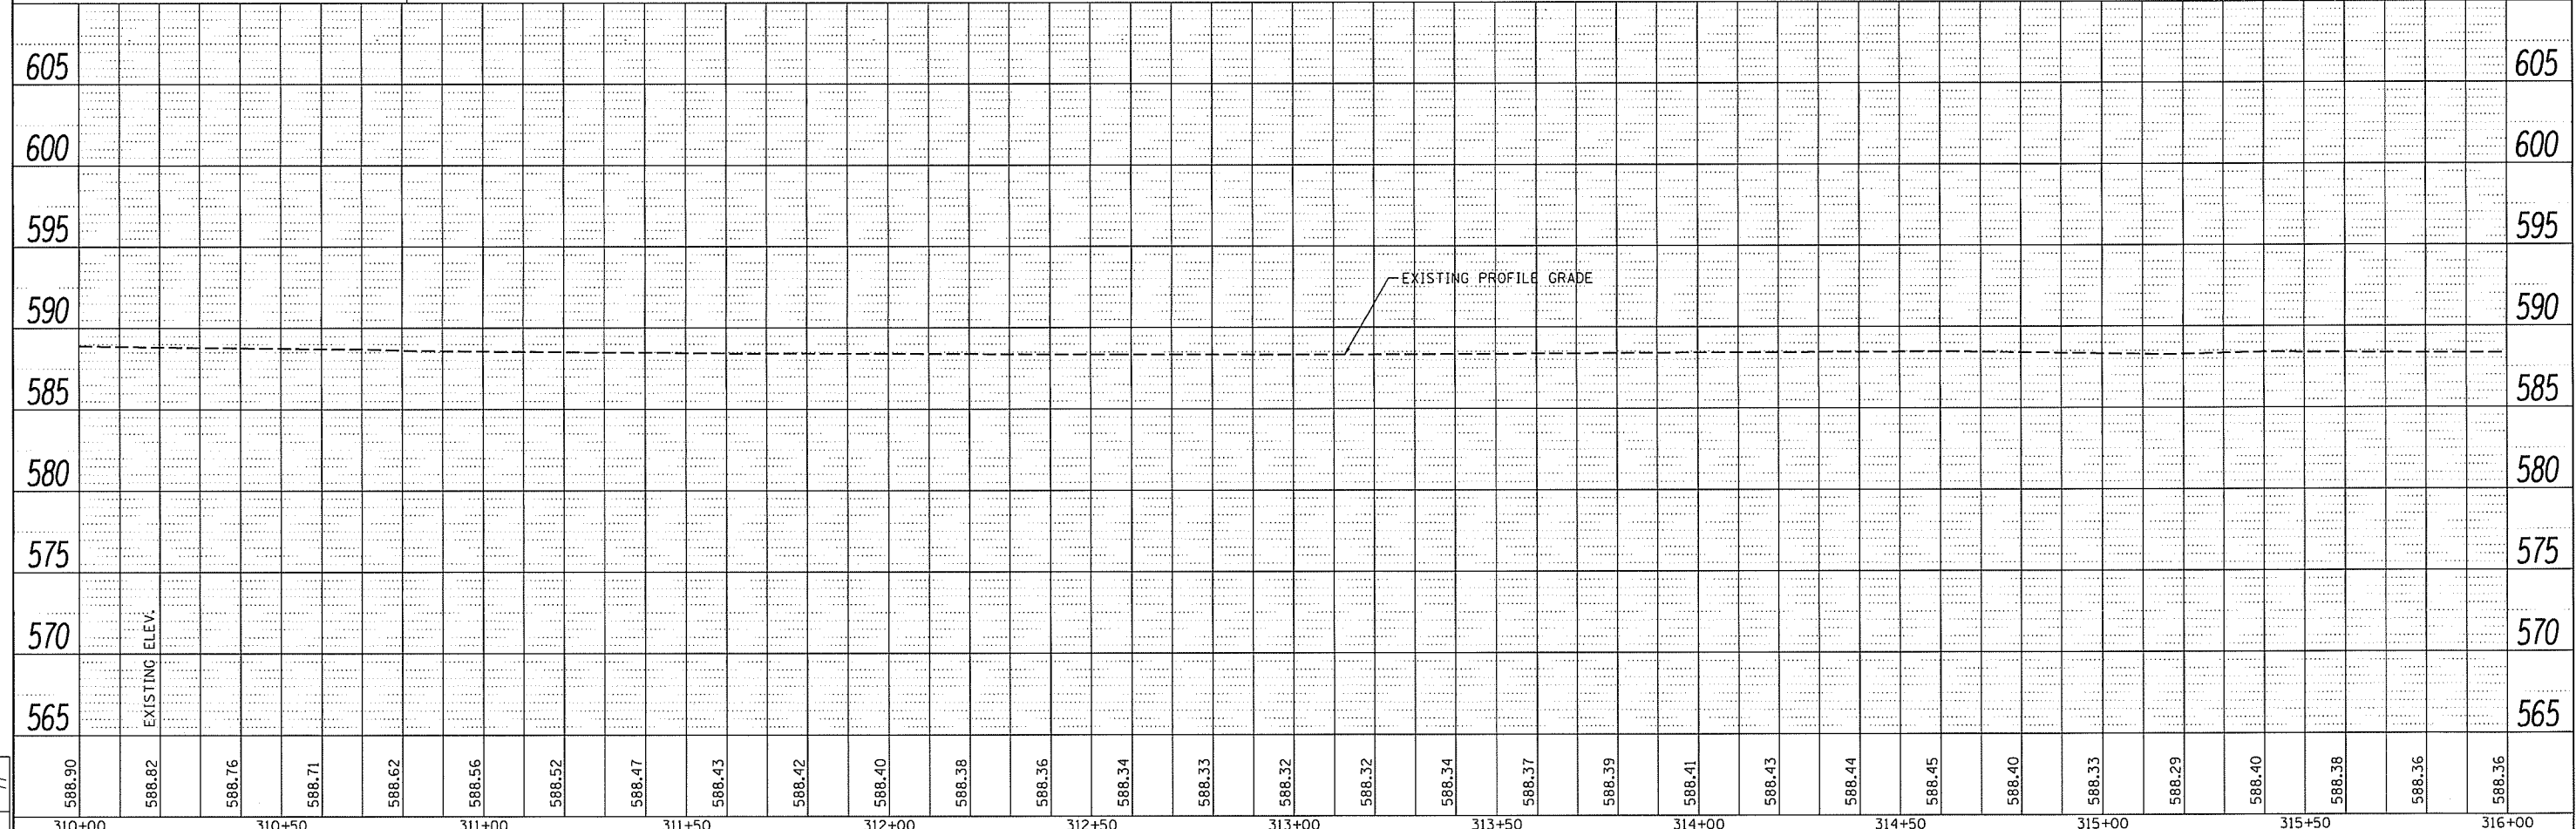



FINAL	DESIGNED	DATE
	DRAWN	BY
	CHECKED	
	REVIEWED	

FILE NAME =	USER NAME = Shupp01364	DESIGNED - JDS	REVISED - 2/14/19	<b>STATE OF ILLINOIS</b> <b>DEPARTMENT OF TRANSPORTATION</b>	<b>DENMARK ROAD</b> <b>DANVILLE, IL</b> <b>PLAN AND PROFILES - 3</b>	F.A.U. RTE. 6998	SECTION 16-00352-00-PV	COUNTY VERMILION	TOTAL SHEETS 125	SHEET NO. 39		
h:\14\jobs\14L0114\ACAD\Road\Sheet\C-703.dgn	PLOT SCALE = 40.0000' / 1" =	CHECKED - JDS	REVISED -			SCALE: 20:1	SHEET 3 OF 8 SHEETS	CONTRACT NO. 91752	ILLINOIS FED. AID PROJECT			
Default	PLOT DATE = 2/4/2019	DATE - 12/19/2018	REVISED -			TO STA.						

PLAN	DESIGNED	DATE
	DRAWN	
	CHECKED	
	REVIEWED	
	BY	
	DATE	



PROFILE	DESIGNED	DATE
	DRAWN	
	CHECKED	
	REVIEWED	
	BY	
	DATE	

FINAL	DESIGNED	DATE
	DRAWN	
	CHECKED	
	REVIEWED	
	BY	
	DATE	

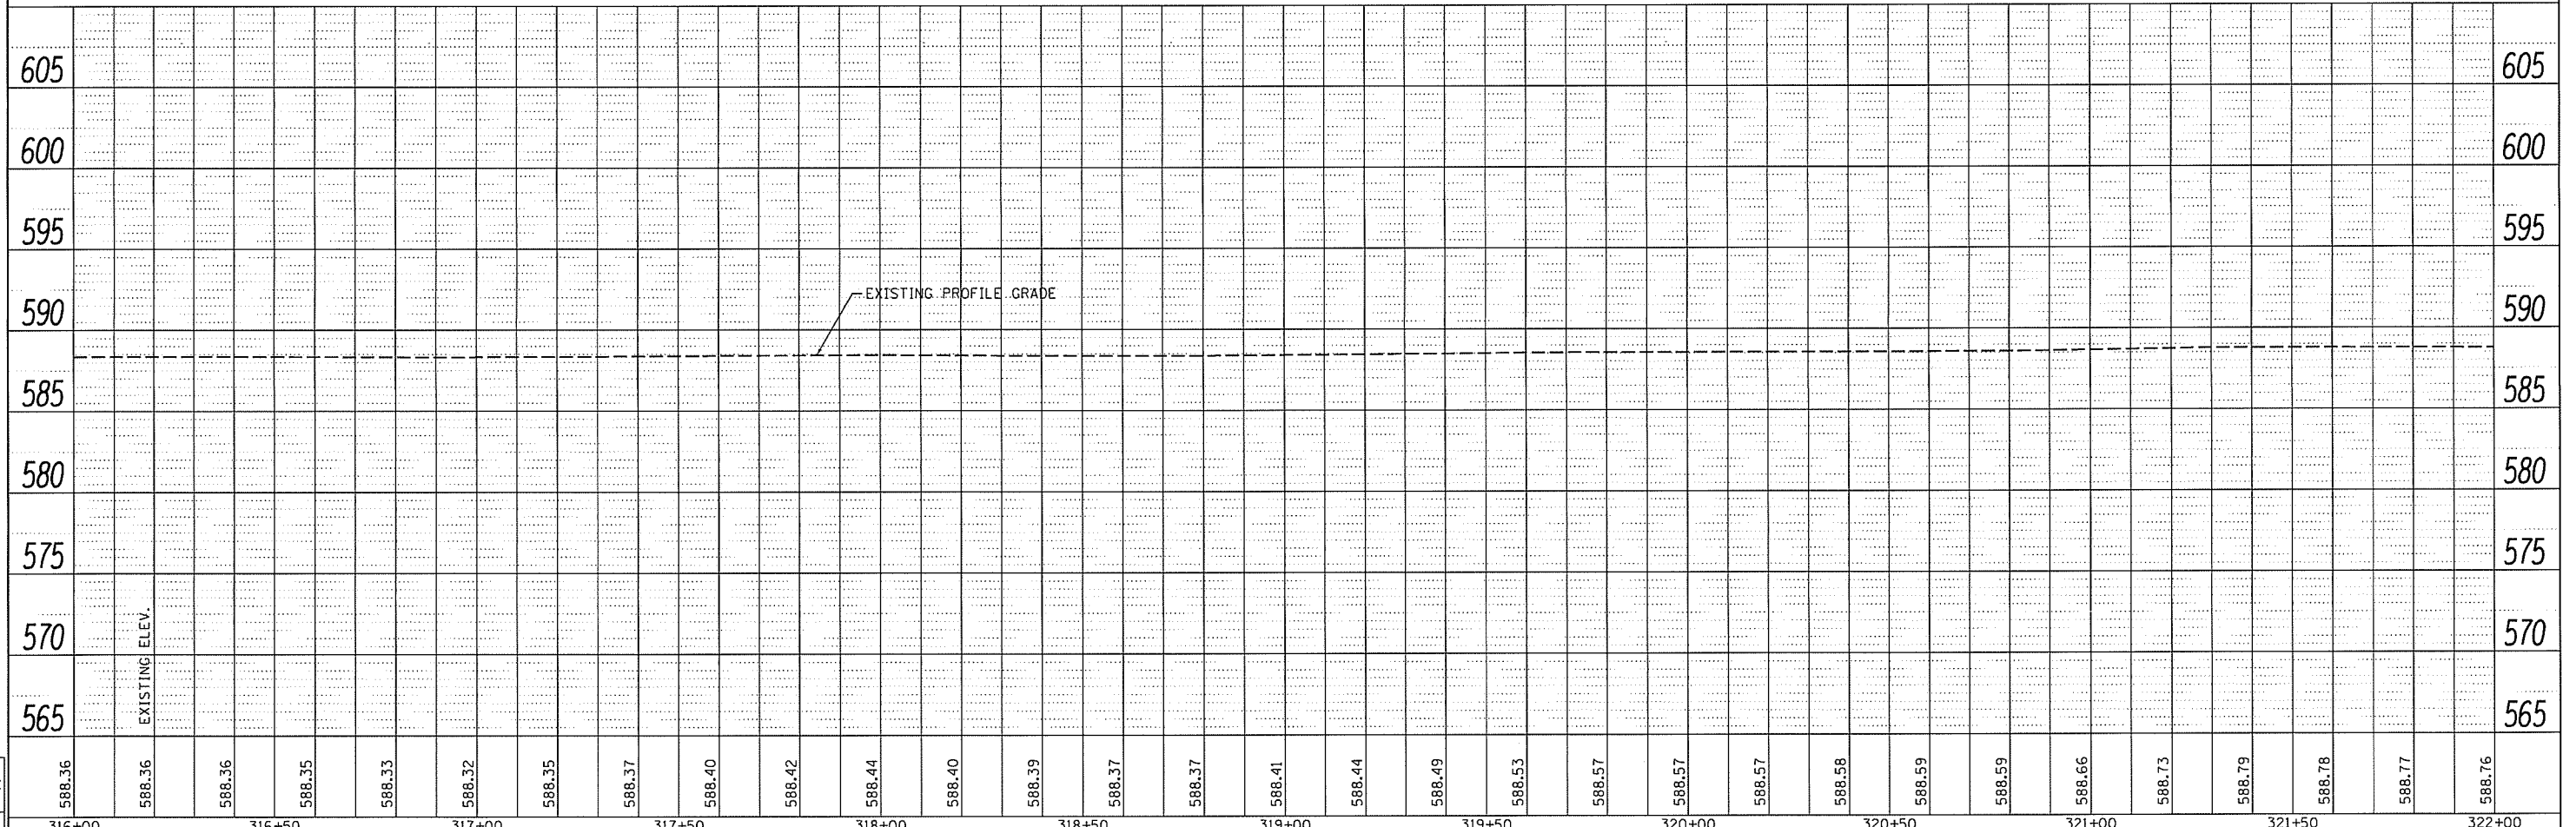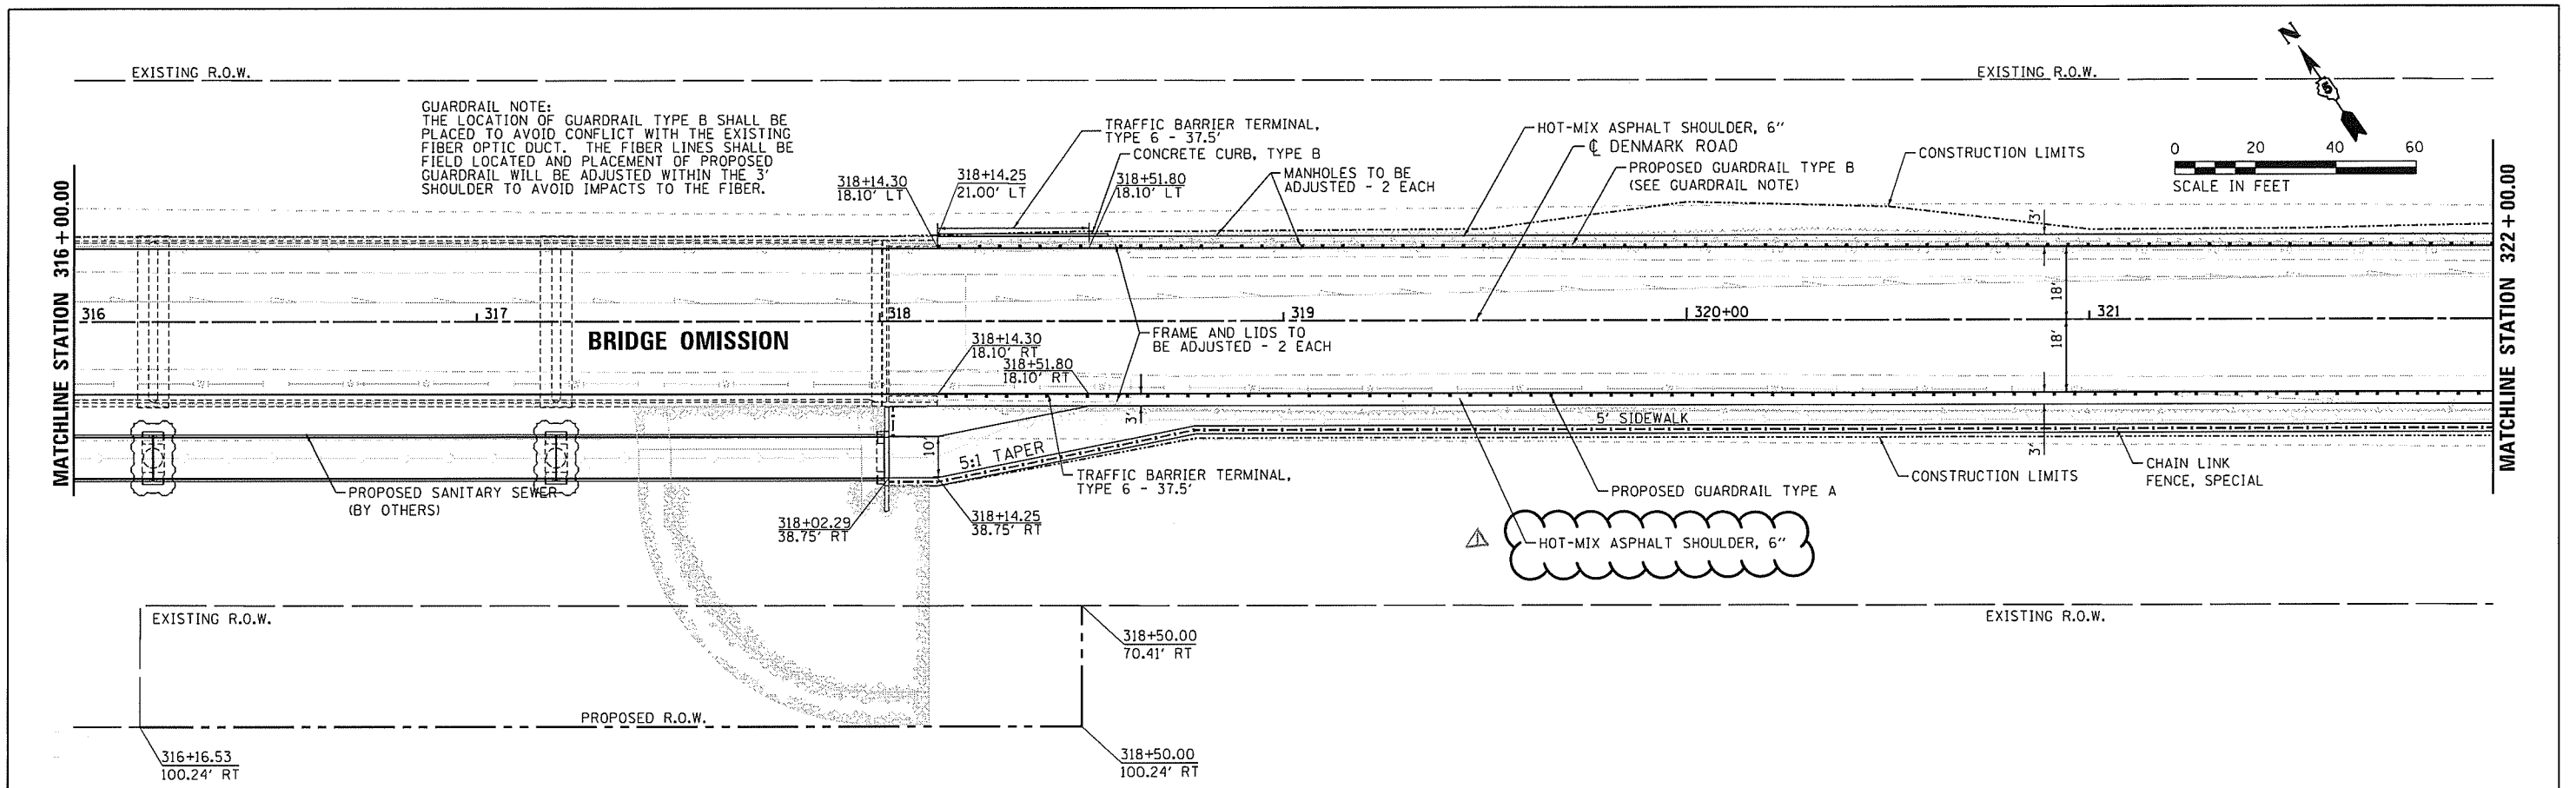


FILE NAME =	USER NAME = Shipp01364	DESIGNED - JDS	REVISED - $\Delta$ 2/14/19	<b>DENMARK ROAD</b> <b>DANVILLE, IL</b> <b>PLAN AND PROFILES - 4</b>				F.A.U. RTE.	SECTION	COUNTY	TOTAL SHEETS	SHEET NO.
Default	PLOT SCALE = 40.0000' / 1"	CHECKED - JDS	REVISED -					6998	16-00352-00-PV	VERMILION	125	40
	PLOT DATE = 2/4/2019	DATE - 12/19/2018	REVISED -	SCALE: 20:1 SHEET 4 OF 8 SHEETS STA. TO STA.				C-95-071-18 CONTRACT NO. 91752				
								[ILLINOIS] FED. AID PROJECT				

GUARDRAIL NOTE:  
 THE LOCATION OF GUARDRAIL TYPE B SHALL BE  
 PLACED TO AVOID CONFLICT WITH THE EXISTING  
 FIBER OPTIC DUCT. THE FIBER LINES SHALL BE  
 FIELD LOCATED AND PLACEMENT OF PROPOSED  
 GUARDRAIL WILL BE ADJUSTED WITHIN THE 3'  
 SHOULDER TO AVOID IMPACTS TO THE FIBER.

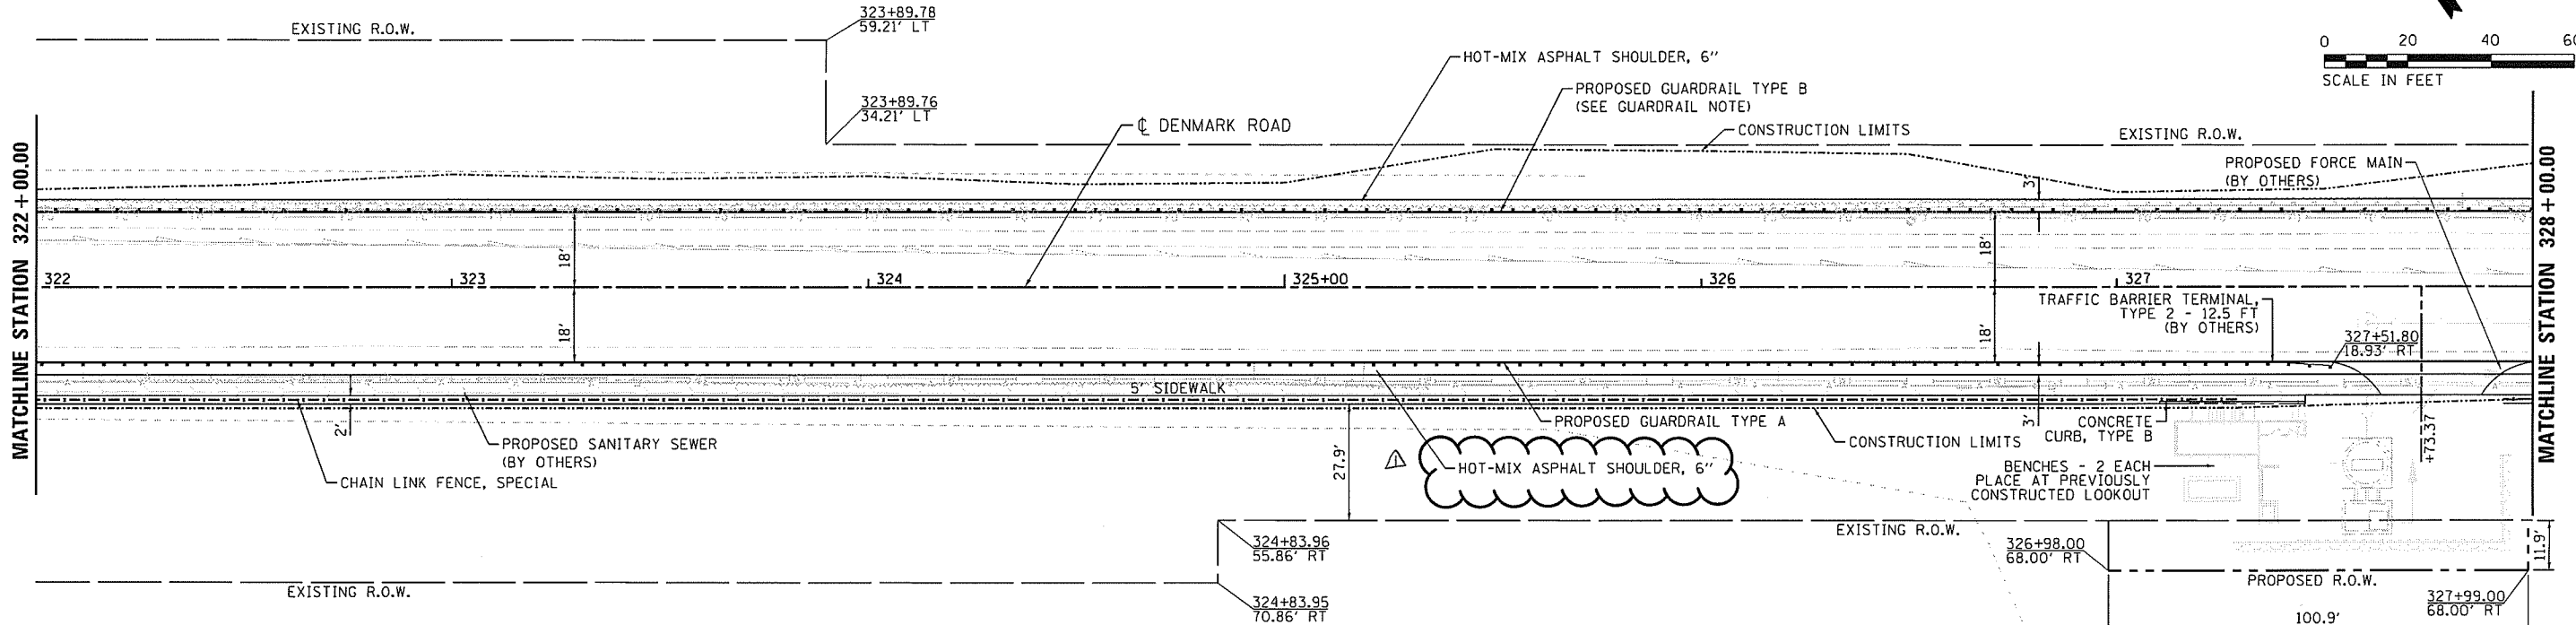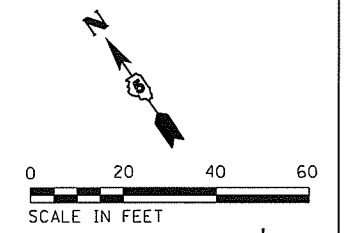

PLAN	SURVEYED	DATE
	PLOTTED	BY
	NOTED	
	REVISIONS	
	RT. OF WAY CHECKED	
	FILE NAME	

PROFILE	SURVEYED	DATE
	PLOTTED	BY
	NOTED	
	REVISIONS	
	STRUCTURE NOTATIONS CHECKED	

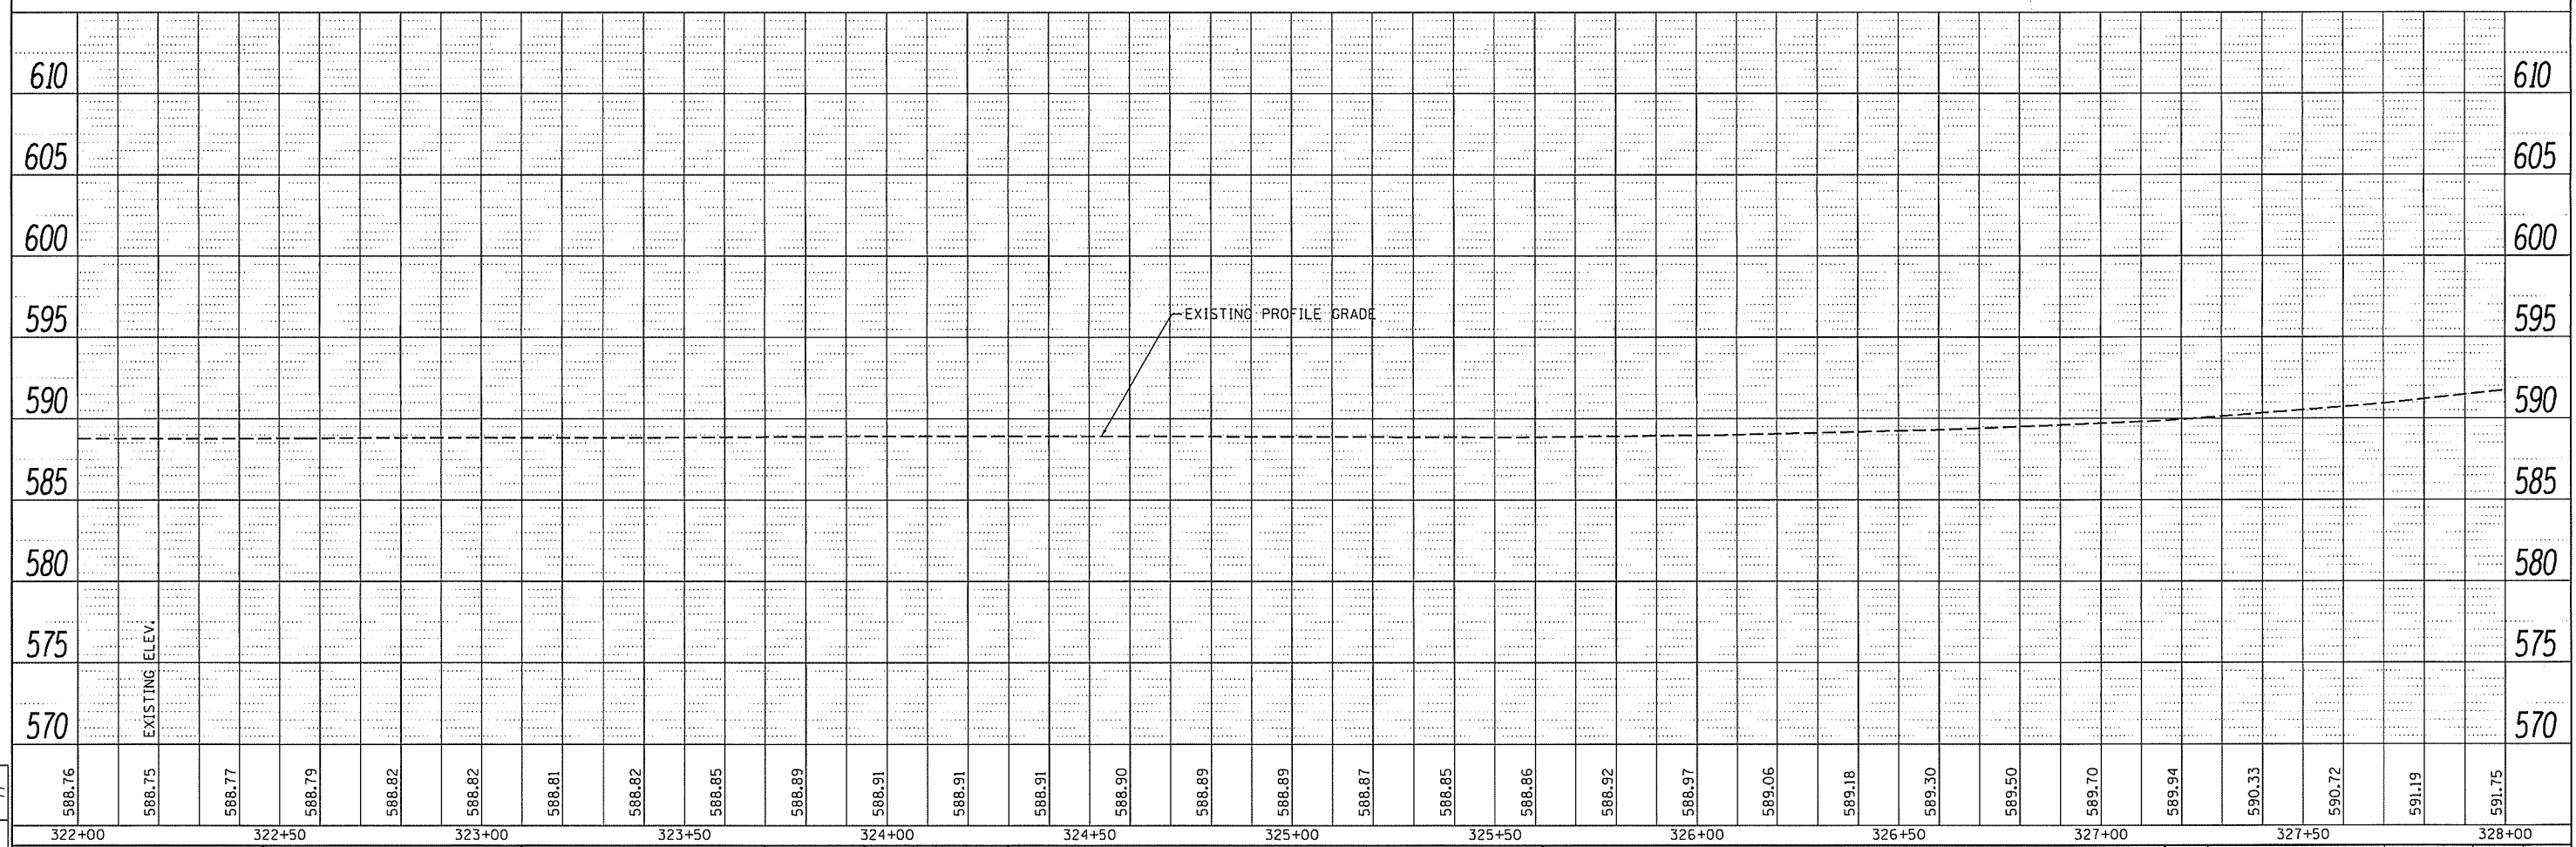

FINAL	DESIGNED	DATE
	DRAWN	BY
	REVIEWED	

FILE NAME =	USER NAME = Shipp01364	DESIGNED - JDS	REVISED - $\Delta$ 2/14/19	STATE OF ILLINOIS DEPARTMENT OF TRANSPORTATION		DENMARK ROAD DANVILLE, IL PLAN AND PROFILES - 5		F.A.U. RTE.	SECTION	COUNTY	TOTAL SHEETS	SHEET NO.
H:\14jobs\14L0114A\CAD\Road\Sheet\C-705.dgn		DRAWN - DJP	REVISED -					6998	16-00352-00-PV	VERMILION	125	41
Default	PLOT SCALE = 40.0000' / in.	CHECKED - JDS	REVISED -	SCALE: 20:1		SHEET 5 OF 8 SHEETS STA. TO STA.		C-95-071-18		CONTRACT NO. 91752		
	PLOT DATE = 2/4/2019	DATE - 12/19/2018	REVISED -					ILLINOIS FED. AID PROJECT				