


INDEX OF SHEETS

- 1 COVER SHEET
- 2 INDEX OF SHEETS, HIGHWAY STANDARDS, GENERAL NOTES, AND COMMITMENTS
- 3 SUMMARY OF QUANTITIES
- 4-6 SIGNING SCHEDULE
- 7 TYPICAL SECTIONS
- 8-17 SIGNING & ROADWAY PLANS
- 18-36 SIGNING DETAILS
- 37-39 CROSS-SECTIONS
- 40 TRAFFIC CONTROL DETAILS FOR FREEWAY SINGLE & MULTI-LANE WEAVE (TC-09)
- 41 TRAFFIC CONTROL DETAILS FOR FREEWAY SHOULDER CLOSURES AND PARTIAL RAMP CLOSURES (TC-17)
- 42 ~~SIGNING FOR FLAGGING OPERATIONS AT WORK ZONE OPENINGS (TC18)~~ 
- 43 ~~ARTERIAL ROAD INFORMATION SIGN (TC22)~~

LIST OF ILLINOIS DOT HIGHWAY STANDARDS

- 000001-00 STANDARD SYMBOLS, ABBREVIATIONS, AND PATTERNS
- 630001-09 STEEL PLATE BEAM GUARDRAIL
- 630301-05 SHOULDER WIDENING FOR TYPE 1 (SPECIAL) GUARDRAIL TERMINALS
- 631011-07 TRAFFIC BARRIER TERMINAL, TYPE 2
- 631031-09 TRAFFIC BARRIER TERMINAL, TYPE 6
- 635006-03 REFLECTOR AND TERMINAL MARKER PLACEMENT
- 635011-02 REFLECTOR MARKER AND MOUNTING DETAILS
- 701400-05 APPROACH TO LANE CLOSURE, FREEWAY/EXPRESSWAY
- 701401-06 LANE CLOSURE, FREEWAY/EXPRESSWAY
- ~~701406 LANE CLOSURE, FREEWAY/EXPRESSWAY, DAY OPERATIONS ONLY~~
- ~~701456 PARTIAL EXIT RAMP CLOSURE, FREEWAY/EXPRESSWAY~~
- 701901-01 TRAFFIC CONTROL DEVICES

GENERAL NOTES

1. BEFORE STARTING ANY EXCAVATION, THE CONTRACTOR SHALL CALL "J.U.L.I.E." AT 800-892-0123 FOR FIELD LOCATIONS OF BURIED ELECTRIC, TELEPHONE, AND GAS FACILITIES. 48 HOUR NOTIFICATION IS REQUIRED.
2. THE CONTRACTOR SHALL COORDINATE CONSTRUCTION ACTIVITIES WITH THE UTILITY COMPANIES, ARLINGTON HEIGHTS, AND CITY OF PALATINE.
3. THE CONTRACTOR WILL NOT BE ALLOWED TO SET UP A YARD OR FIELD OFFICE ON STATE PROPERTY WITHOUT WRITTEN PERMISSION FROM THE DEPARTMENT.
4. ~~BARRICADES: THE CONTRACTOR SHALL PROVIDE AND INSTALL TWO (2) WEIGHTED SANDBAGS ON EACH TYPE I OR TYPE II BARRICADE USED - ONE (1) WEIGHTED SANDBAG ACROSS EACH BOTTOM RAIL.~~
5. THE CONTRACTOR SHALL CONTACT THE DISTRICT ONE EXPRESSWAY TRAFFIC CONTROL SUPERVISOR AT (847) 705-4155 A MINIMUM OF 72 HOURS IN ADVANCE OF BEGINNING WORK.
6. DO NOT SCALE PLANS FOR CONSTRUCTION DIMENSIONS.

COMMITMENTS


NO COMMITMENTS FOR THIS PROJECT

FILE NAME : P:\2009\ME09006_Var-Var-Phil\CADD\W019_IL53\Shs\02-0160K21-shr-IL53-GNOTE.dgn
 PLOT SCALE : 1/8"=1'-0"
 USER NAME : Millennium Professional Services



300 22ND Street, Suite 216, Lombard, IL 60148
 630.705.0110 voice, 630.839.2566 fax
 www.mps-ill.com

MILLENNIA PROFESSIONAL SERVICES

DESIGNED - CJD	REVISED - 
DRAWN - CJD	REVISED -
CHECKED - TVN	REVISED -
DATE - 2/24/2011	REVISED -

**STATE OF ILLINOIS
 DEPARTMENT OF TRANSPORTATION**

**ILLINOIS ROUTE 53
 RAND ROAD TO LAKE COOK ROAD**

**INDEX OF SHEETS, LIST OF IDOT
 HIGHWAY STANDARD, GENERAL NOTES,
 AND COMMITMENTS**

F.A.P. RTE. 2592	SECTION 2010-003 I	COUNTY COOK	TOTAL SHEETS 43	SHEET NO. 2
SCALE: N/A			CONTRACT NO. 60K21	
SHEET NO. OF SHEETS		STA. TO STA.		
FED. ROAD DIST. NO. 1 ILLINOIS FED. AID PROJECT				

P:\2009\ME09006_Var-Var-Phil\CADD\W019_IL53\Shs\02-0160K21-shr-IL53-GNOTE.dgn

SUMMARY OF QUANTITIES

CODE NO.	ITEM DESCRIPTION	UNIT	TOTAL QUANTITY 90% FED. 10% STATE URBAN	CONSTRUCTION TYPE CODE	
				0021 SAFETY	
20200100	EARTH EXCAVATION	CU YD	1196	1196	-
21101615	TOPSOIL FURNISH AND PLACE, 4"	SO YD	2774	2774	-
25000210	SEEDING, CLASS 2A	ACRE	0.6	0.60	-
25000400	NITROGEN FERTILIZER NUTRIENT	POUND	52	52	-
25000500	PHOSPHORUS FERTILIZER NUTRIENT	POUND	52	52	-
25000600	POTASSIUM FERTILIZER NUTRIENT	POUND	52	52	-
25100630	EROSION CONTROL BLANKET	SO YD	2774	2774	-
48101500	AGGREGATE SHOULDERS, TYPE B 6"	SO YD	1347	1347	-
63000001	STEEL PLATE BEAM GUARD RAIL, TYPE A, 6 FOOT POSTS	FOOT	2775	2775	-
63000015	STEEL PLATE BEAM GUARD RAIL, TYPE D	FOOT	1117	1117	-
63100045	TRAFFIC BARRIER TERMINAL, TYPE 2	EACH	10	10	-
63100085	TRAFFIC BARRIER TERMINAL, TYPE 6	EACH	2	2	-
63100167	TRAFFIC BARRIER TERMINAL, TYPE 1 (SPECIAL) TANGENT	EACH	13	13	-
63200310	GUARDRAIL REMOVAL	FOOT	1433	1433	-
67000400	ENGINEER'S FIELD OFFICE, TYPE A	CAL MO	6	6	-
67100100	MOBILIZATION	L SUM	1	1	-
70100000	CHANGEABLE MESSAGE SIGN	CAL MO	1	1	-
72000100	SIGN PANEL - TYPE 1	SO FT	477	477	-
72000200	SIGN PANEL - TYPE 2	SO FT	516	516	-
72000300	SIGN PANEL - TYPE 3	SO FT	3089	3089	-
72400100	REMOVE SIGN PANEL ASSEMBLY - TYPE A	EACH	10	10	-
72400200	REMOVE SIGN PANEL ASSEMBLY - TYPE B	EACH	22	22	-
72400310	REMOVE SIGN PANEL - TYPE 1	SQ FT	313	313	-
72400320	REMOVE SIGN PANEL - TYPE 2	SQ FT	281	281	-
72400330	REMOVE SIGN PANEL - TYPE 3	SO FT	3333	3333	-
72800100	TELESCOPING STEEL SIGN SUPPORT	FOOT	133	133	-
73000100	WOOD SIGN SUPPORT	FOOT	1151	1151	-
73700100	REMOVE GROUND MOUNTED SIGN SUPPORT	EACH	7	7	-
78200410	GUARDRAIL MARKERS, TYPE A	EACH	40	40	-

* SPECIALTY ITEM

SUMMARY OF QUANTITIES

CODE NO.	ITEM DESCRIPTION	UNIT	TOTAL QUANTITY 90% FED. 10% STATE URBAN	CONSTRUCTION TYPE CODE	
				0021 SAFETY	
78201000	TERMINAL MARKER - DIRECT APPLIED	EACH	23	23	-
84200600	REMOVAL OF LIGHTING UNIT, NO SALVAGE	EACH	37	37	-
20030050	TEMPORARY INFORMATION SIGNING	SO FT	156	156	-
X2020110	GRADING AND SHAPING SHOULDERS	UNIT	12	12	-
X7011015	TRAFFIC CONTROL AND PROTECTION (EXPRESSWAYS)	L SUM	1	1	-
Z0026346	NIGHTTIME WORK ZONE LIGHTING	L SUM	1	1	-
Z0029999	IMPACT ATTENUATOR REMOVAL	EACH	1	1	-
Z0030030	IMPACT ATTENUATORS (FULLY REDIRECTIVE, NARROW), TEST LEVEL 3	EACH	1	1	-
73700200	REMOVE CONCRETE FOUNDATION - GROUND MOUNT	EACH	2	2	-

Rev. 2-25-11

FILE NAME: P:\2009\ME09006_Ver-Var_Pht\CADD\W019_IL53\Shets\03-D160K21-sh1-IL53-500.dgn
 PLOT SCALE: 1:8000 / IN.
 USER NAME: Millennium Professional Services



200 22ND Street, Suite 216, Lombard, IL 60148
 630.785.0110 voice, 630.839.2566 fax
 www.mps-il.com
MILLENNIA PROFESSIONAL SERVICES

DESIGNED - CJD	REVISED -
DRAWN - CJD	REVISED -
CHECKED - TVN	REVISED -
DATE - 1/3/2011	REVISED -

STATE OF ILLINOIS
DEPARTMENT OF TRANSPORTATION

ILLINOIS ROUTE 53
RAND ROAD TO LAKE COOK ROAD

SUMMARY OF QUANTITIES

F.A.P. RTE. 2592	SECTION 2010-003 1	COUNTY COOK	TOTAL SHEETS 43	SHEET NO. 3
FED. ROAD DIST. NO. 1 (ILLINOIS) FED. AID PROJECT			CONTRACT NO. 60K21	

SCALE: NTS SHEET NO. OF SHEETS STA. TO STA.

P:\2009\ME09006_Ver-Var_Pht\CADD\W019_IL53\Shets\03-D160K21-sh1-IL53-500.dgn

SIGNING SCHEDULE

SIGN PANELS																	SIGN SUPPORTS								
STATION	LT/RT	SIGN NO.	LEGEND/ DESCRIPTION	"AA" (L.F.)	"BB" (L.F.)	EXISTING PANEL DIMENSIONS		PROPOSED PANEL DIMENSIONS		SIGN AREA (SQ FT)	72000100 SIGN PANEL - TYPE 1 (SQ FT)	72000200 SIGN PANEL - TYPE 2 (SQ FT)	72000300 SIGN PANEL - TYPE 3 (SQ FT)	72400310 REMOVE SIGN PANEL - TYPE 1 (SQ FT)	72400100 REMOVE SIGN PANEL ASSEMBLY - TYPE A (EACH)	72400320 REMOVE SIGN PANEL - TYPE 2 (SQ FT)	72400200 REMOVE SIGN PANEL ASSEMBLY - TYPE B (EACH)	72400330 REMOVE SIGN PANEL - TYPE 3 (SQ FT)	73700100 REMOVE GROUND MOUNTED SIGN SUPPORT (EACH)	72800100 - TELESCOPING STEEL SIGN SUPPORT			73000100 WOOD SIGN SUPPORT		
						HEIGHT (L.F.)	WIDTH (L.F.)	HEIGHT (L.F.)	WIDTH (L.F.)											P1 (L.F.)	P2 (L.F.)	PAY LENGTH (L.F.)	P1 (L.F.)	P2 (L.F.)	PAY LENGTH (L.F.)
396+17	RT	NB-53-TS-4	R5-1A (WRONG WAY)		7	2	3	2.5	3.5	8.75	8.75	-	-	6	1	-	-	-	-	15	15				
396+17	RT	NB-53-TS-5	R3-8a (LEFT ONLY / LEFT THRU / RIGHT ONLY)		7	2.5	3	2.5	3	7.5	7.5	-	-	7.50	-	-	-	-	-	14	14				
396+55	RT	NB-53-TS-3	R5-1A (WRONG WAY)		7	2	3	2	3	6	6	-	-	6	1	-	-	-	-						
396+55	RT	NB-53-WP-6	M3-2 (EAST)		8	1	2	1	2	2	2	-	-	2	-	-	-	-	-						
396+55	RT	NB-53-WP-7	M1-4 (US 12)		8	2	2	2	2	4	4	-	-	4	-	-	-	-	-						
396+55	RT	NB-53-WP-8	M6-1 (RIGHT ARROW)		8	1.25	1.75	1.25	1.75	2.1875	2.1875	-	-	2.19	-	-	1	-	-				16	16	
396+55	RT	NB-53-WP-9	R5-1 (DO NOT ENTER)		8	3	3	4	4	16	16	-	-	16	-	-	-	-	-						
396+60	RT	NB-53-LP-10	R3-1 (NO RIGHT TURN)		8	3	3	3	3	9	9	-	-	9	-	-	-	-	-						
397+27	RT	NB-53-WP-11	M3-4 (WEST)		8	1	2	1	2	2	2	-	-	2	-	-	-	-	-						
397+27	RT	NB-53-WP-12	M1-4 (US 12)		8	2	2	2	2	4	4	-	-	4	-	-	-	-	-						
397+27	RT	NB-53-WP-13	M5-1 (ADVANCE LEFT TURN ARROW)		8	1.25	1.75	1.25	1.75	2.1875	2.1875	-	-	2.19	-	-	1	-	-				16	16	
397+27	RT	NB-53-WP-14	R5-1 (DO NOT ENTER)		8	3	3	4	4	16	16	-	-	16	-	-	-	-	-						
51+65	RT	WB-68-LP-37	R3-5 (RIGHT ONLY)		7	3	2.5	3	2.5	7.5	7.5	-	-	7.50	-	-	-	-	-						
50+09	RT	WB-68-LP-35	M3-4 (WEST)		7	1	2	1	2	2	2	-	-	2	-	-	-	-	-						
50+09	RT	WB-68-LP-36	M1-100 (IL 68)		7	2	2	2	2	4	4	-	-	4	-	-	-	-	-						
436+06	RT	NB-53-WP-38	R5-100 (BUCKLE UP)		7	5	4	5	4	20	20	-	-	20	-	-	1	-	-				17	17	
494+44	RT	NB-53-WP-134	W4-1 (MERGE LEFT ARROW)		7	4	4	4	4	16	16	-	-	16	-	-	1	-	-				18	18	
440+69	LT	SB-53-TS-74	R5-1A (WRONG WAY)		7	2	3	2.5	3.5	8.75	8.75	-	-	8.00	1	-	-	-	-	15	15				
440+69	LT	SB-53-TS-75	(LEFT ONLY / RIGHT ONLY)		7	2.5	2.5	2.5	2.5	6.25	6.25	-	-	6.25	-	-	-	-	-						
429+15	RT	NB-53-LP-135	(DUAL LEFT ONLY)		7	2.5	2.5	2.5	2.5	6.25	6.25	-	-	6.25	-	-	-	-	-						
429+15	RT	NB-53-LP-136	(DUAL RIGHT ONLY)		7	2.5	2.5	2.5	2.5	6.25	6.25	-	-	6.25	-	-	-	-	-						
440+36	LT	SB-53-TS-76	R5-1A (WRONG WAY)		7	2	3	2.5	3.5	8.75	8.75	-	-	6	1	-	-	-	-	15	15				
438+27	LT	SB-53-WP-78	M3-1 (NORTH)		8	1	2	1	2	2	2	-	-	2	-	-	-	-	-						
438+27	LT	SB-53-WP-79	M1-100 (ILLINOIS-53)		8	2	2	2	2	4	4	-	-	4	-	-	1	-	-				19	19	
438+27	LT	SB-53-WP-80	M3-4 (WEST)		8	1	2	1	2	2	2	-	-	2	-	-	-	-	-						
438+27	LT	SB-53-WP-81	M1-100 (ILLINOIS-68)		8	2	2	2	2	4	4	-	-	4	-	-	-	-	-						
438+27	LT	SB-53-WP-82	M6-1 (RIGHT ARROW)		8	1.25	1.75	1.25	1.75	2.1875	2.1875	-	-	2.19	-	-	-	-	-						
438+25	LT	SB-53-WP-83	M3-2 (EAST)		8	1	2	1	2	2	2	-	-	2	-	-	-	-	-						
438+25	LT	SB-53-WP-84	M1-100 (ILLINOIS-68)		8	2	2	2	2	4	4	-	-	4	-	-	-	-	-				16	16	
438+25	LT	SB-53-WP-85	M6-1 (LEFT ARROW)		8	1.25	1.75	1.25	1.75	2.1875	2.1875	-	-	2.19	-	-	-	-	-						
437+59	LT	SB-53-WP-86	R5-1 (DO NOT ENTER)		7	3	3	4	4	16	16	-	-	16	-	-	1	-	-				16	16	
437+42	LT	SB-53-WP-87	R5-1 (DO NOT ENTER)		7	3	3	4	4	16	16	-	-	16	-	-	1	-	-				16	16	
436+92	LT	SB-53-LP-98	R3-2 (NO LEFT TURN)		7	3	3	3	3	9	9	-	-	9	-	-	-	-	-						
437+15	LT	SB-53-LP-99	R3-1 (NO RIGHT TURN)		7	3	3	3	3	9	9	-	-	9	-	-	-	-	-						
436+92	LT	SB-53-LP-92	SOUTH ILLINOIS-53		7	1	2	8.5	6.5	55.25	55.25	-	-	4	-	-	-	2	-				21	21	
436+92	LT	SB-53-LP-93	RIGHT ARROW		7	1.25	1.75	0	0	0	0	-	-	2.19	-	-	-	-	-						
436+61	LT	SB-53-CL-95	SOUTH-ILLINOIS-53		7	7.5	21.5	7.5	17	127.5	127.5	-	-	161.25	-	-	-	-	-						
436+44	LT	SB-53-LP-96	R3-5 (RIGHT ONLY)		7	3	2.5	3	2.5	7.5	7.5	-	-	7.50	-	-	-	-	-						
436+34	LT	SB-53-TS-97	W-13-3 (RAMP - 15 - M.P.H)		7	4	3	4	3	12	12	-	-	12	-	-	1	-	-	16	16				
436+08	LT	SB-53-LP-107	SOUTH ILLINOIS-53		7	1	2	8.5	6.5	55.25	55.25	-	-	4	-	-	-	2	-						
436+08	LT	SB-53-LP-108	RIGHT ARROW		7	1.25	1.75	0	0	0	0	-	-	2.19	-	-	-	-	-				21	21	
436+08	LT	SB-53-LP-134	RIGHT ARROW		7	1.25	1.75	0	0	0	0	-	-	2.19	-	-	-	-	-						
438+24	LT	SB-53-LP-77	R5-100 (BUCKLE UP)		7	5	4	5	4	20	20	-	-	20	-	-	1	-	-				16	16	
436+54	LT	SB-53-WP-100	W-13-3 (RAMP - 15 - M.P.H)		7	4	3	4	3	12	12	-	-	12	-	-	1	-	-						
436+54	LT	SB-53-LP-101	R3-5 (RIGHT ONLY)		7	3	2.5	3	2.5	7.5	7.5	-	-	7.50	-	-	-	-	-				16	16	
436+24	LT	SB-53-CL-102	SOUTH-ILLINOIS-53		7	7.5	21.5	7.5	17	127.5	127.5	-	-	161.25	-	-	-	-	-						
436+06	LT	SB-53-TS-103	SOUTH-ILLINOIS-53-RIGHT ARROW		7	1	2	8.5	6.5	55.25	55.25	-	-	4	-	-	-	2	-						
436+06	LT	SB-53-TS-104	SOUTH-ILLINOIS-53-RIGHT ARROW		7	2	2	0	0	0	0	-	-	2.19	-	-	1	-	-				21	21	
436+06	LT	SB-53-TS-106	SOUTH-ILLINOIS-53-RIGHT ARROW		7	1.25	1.75	0	0	0	0	-	-	2.19	-	-	-	-	-						
432+63	LT	SB-53-LP-106	R5-100 (BUCKLE UP)		7	5	4	5	4	20	20	-	-	20	-	-	1	-	-						
430+24	RT	NB-53-TS-22	R5-1A (WRONG WAY)		7	2	3	2.5	3.5	8.75	8.75	-	-	6	1	-	-	-	-	15	15				
431+67	RT	NB-53-LP-23	R5-1A (WRONG WAY)		7	2	3	2.5	3.5	8.75	8.75	-	-	6	-	-	-	-	-						
432+05	RT	NB-53-WP-24	M3-1 (NORTH)		8	1	2	1.5	2.5	3.75	3.75	-	-	2	-	-	-	-	-						
432+05	RT	NB-53-WP-25	M1-100 (IL 53)		8	2	2	3	3	9	9	-	-	4	-	-	-	-	-						
432+05	RT	NB-53-WP-26	M6-1 (LEFT ARROW)		8	1.25	1.75	1.5	2.5	3.75	3.75	-	-	2.19	-	-	-	-	-						
432+05	RT	NB-53-WP-27	M3-4 (WEST)		8	1	2	1.5	2.5	3.75	3.75	-	-	2	-	-	-	-	-						
432+05	RT	NB-53-WP-28	M1-100 (IL 68)		8	2	2	3	3	9	9	-	-	4	-	-	-	-	-				18	18	
432+05	RT	NB-53-WP-29	M6-1 (LEFT ARROW)		8	1.25	1.75	1.5	2.5	3.75	3.75	-	-	2.19	-	-	-	-	-						
432+05	RT	NB-53-WP-30	M3-2 (EAST)		8	1	2	1.5	2.5	3.75	3.75	-	-	2	-	-	-	-	-						
432+05	RT	NB-53-WP-31	M1-100 (IL 68)																						

SIGNING SCHEDULE

SIGN PANELS																		SIGN SUPPORTS																	
STATION	LT/RT	SIGN NO.	LEGEND/ DESCRIPTION	"AA" (L.F.)	"BB" (L.F.)	EXISTING PANEL DIMENSIONS		PROPOSED PANEL DIMENSIONS		SIGN AREA (SQ FT)	72000100 SIGN PANEL - TYPE 1 (SQ FT)	72000200 SIGN PANEL - TYPE 2 (SQ FT)	72000300 SIGN PANEL - TYPE 3 (SQ FT)	72400310 REMOVE SIGN PANEL - TYPE 1 (SQ FT)	72400100 REMOVE SIGN PANEL ASSEMBLY - TYPE A (EACH)	72400320 REMOVE SIGN PANEL - TYPE 2 (SQ FT)	72400200 REMOVE SIGN PANEL ASSEMBLY - TYPE B (EACH)	72400330 REMOVE SIGN PANEL TYPE 3 (SQ FT)	73700100 REMOVE GROUND MOUNTED SIGN SUPPORT (EACH)	72800100 - TELESCOPING STEEL SIGN SUPPORT			73000100 WOOD SIGN SUPPORT												
						HEIGHT (L.F.)	WIDTH (L.F.)	HEIGHT (L.F.)	WIDTH (L.F.)											P1 (L.F.)	P2 (L.F.)	PAY LENGTH (L.F.)	P1 (L.F.)	P2 (L.F.)	PAY LENGTH (L.F.)										
433+42	RT	NB-53-LP-33	R5-1 (DO NOT ENTER)		7	3	3	4	4	16	-	16	-	-	-	9	1	-																	
434+10	RT	NB-53-WP-34	R5-1 (DO NOT ENTER)		7	5	4	4	4	16	-	16	-	-	-	20	1	-						17	17										
400+68	LT	SB-53-WP-123	R5-1100 (BUCKLE UP)			5	4	5	4	20	-	20	-	-	-	20	1	-						10	10										
403+54	LT	SB-53-LP-113	M-3-3 (SOUTH)			1	2	1.5	2.5	3.75	-	-	-	-	-	-	-	-																	
403+54	LT	SB-53-LP-114	M1-1100 (ILLINOIS-53)			2	2	3	3	9	-	-	-	-	-	-	-	-																	
403+54	LT	SB-53-LP-115	M6-1 (LEFT ARROW)			1.25	1.75	1.5	2.5	3.75	3.75	-	-	-	-	2.19	-	-																	
403+54	LT	SB-53-LP-116	M3-3 (SOUTH)			1	2	1.5	2.5	3.75	3.75	-	-	-	-	-	-	-																	
403+54	LT	SB-53-LP-117	M1-1100 (ILLINOIS-53)			2	2	3	3	9	-	-	-	-	-	-	-	-																	
403+54	LT	SB-53-LP-118	M6-1 (RIGHT ARROW)			1.25	1.75	1.5	2.5	3.75	3.75	-	-	-	-	2.19	-	-																	
403+29	LT	SB-53-LP-119	M3-3 (SOUTH)			1	2	1.5	2.5	3.75	3.75	-	-	-	-	-	-	-																	
403+29	LT	SB-53-LP-120	M1-1100 (ILLINOIS-53)			2	2	3	3	9	-	-	-	-	-	-	-	-																	
403+29	LT	SB-53-LP-121	M6-3 (UP ARROW)			1.25	1.75	1.5	2.5	3.75	3.75	-	-	-	-	2.19	-	-																	
1+20	LT	NB-53-WP-137	W1-8 (CHEVRON)		7	-	-	3	2.5	7.5	7.5	-	-	-	-	-	-	-					15	15											
2+40	LT	NB-53-WP-138	W1-8 (CHEVRON)		7	-	-	3	2.5	7.5	7.5	-	-	-	-	-	-	-					15	15											
3+60	LT	NB-53-WP-139	W1-8 (CHEVRON)		7	-	-	3	2.5	7.5	7.5	-	-	-	-	-	-	-					15	15											
4+80	LT	NB-53-WP-140	W1-8 (CHEVRON)		7	-	-	3	2.5	7.5	7.5	-	-	-	-	-	-	-					15	15											
6+00	LT	NB-53-WP-141	W1-8 (CHEVRON)		7	-	-	3	2.5	7.5	7.5	-	-	-	-	-	-	-					15	15											
7+20	LT	NB-53-WP-142	W1-8 (CHEVRON)		7	-	-	3	2.5	7.5	7.5	-	-	-	-	-	-	-					15	15											
8+40	LT	NB-53-WP-143	W1-8 (CHEVRON)		7	-	-	3	2.5	7.5	7.5	-	-	-	-	-	-	-					15	15											
9+60	LT	NB-53-WP-144	W1-8 (CHEVRON)		7	-	-	3	2.5	7.5	7.5	-	-	-	-	-	-	-					15	15											
11+92	LT	NB-53-WP-145	W1-8 (CHEVRON)		7	-	-	3	2.5	7.5	7.5	-	-	-	-	-	-	-					15	15											
13+02	LT	NB-53-WP-146	W1-8 (CHEVRON)		7	-	-	3	2.5	7.5	7.5	-	-	-	-	-	-	-					15	15											
14+22	LT	NB-53-WP-147	W1-8 (CHEVRON)		7	-	-	3	2.5	7.5	7.5	-	-	-	-	-	-	-					15	15											
434+00	RT	NB-53-WP-21A	W19-5 (FREEWAY ENDS- 1 Mile)		7	-	-	4	12	48	-	-	48	-	-	-	-	-					16	16/16	48										
434+00	RT	NB-53-WP-21A	W19-5 (FREEWAY ENDS- 1 Mile)		7	-	-	4	12	48	-	-	48	-	-	-	-	-					16	16/16	48										
462+00	RT	NB-53-LP-40A	W3-5 (SPEED LIMIT)		7	-	-	5	4	20	-	-	20	-	-	-	-	-					17	17	34										
462+00	LT	NB-53-LP-40B	W3-5 (SPEED LIMIT)		7	-	-	5	4	20	-	-	20	-	-	-	-	-					17	17	34										
475+00	RT	NB-53-TR-43A	W19-3 (FREEWAY ENDS)			-	-	4	4	16	-	-	16	-	-	-	-	-																	
475+00	LT	NB-53-TR-43B	W19-3 (FREEWAY ENDS)			-	-	4	4	16	-	-	16	-	-	-	-	-																	
EB RAMP	LT	NB-53-WP-134A	W1-8 (CHEVRON)		7	-	-	3	2.5	7.5	7.5	-	-	-	-	-	-	-					15	15											
EB RAMP	LT	NB-53-WP-134B	W1-8 (CHEVRON)		7	-	-	3	2.5	7.5	7.5	-	-	-	-	-	-	-					15	15											
EB RAMP	LT	NB-53-WP-134C	W1-8 (CHEVRON)		7	-	-	3	2.5	7.5	7.5	-	-	-	-	-	-	-					15	15											
EB RAMP	LT	NB-53-WP-134D	W1-8 (CHEVRON)		7	-	-	3	2.5	7.5	7.5	-	-	-	-	-	-	-					15	15											
EB RAMP	RT	NB-53-WP-47A	W-13-3 (RAMP - 30 - M.P.H)		7	-	-	4	3	12	-	12	-	-	-	-	-	-					16	16											
TOTALS														162	136	96	25	0	49	3	0	0	0	0	0	0	0	0	0	0	0	0	432		
GRAND TOTALS											477	516	3089	313	10	281	22	3333	7	0	0	0	0	0	0	0	0	0	0	0	0	0	0	0	1151

FILE NAME: P:\2009\ME\9006\Var\Var_P\I\CADD\W019_IL53\Shets\DI60K21-sht-Signschedule.dgn
 PLOT SCALE: 5/8"=1'-0"
 USER NAME: P:\2009\ME\9006\Var\Var_P\I\CADD\W019_IL53\Shets\DI60K21-sht-Signschedule.dgn



200 22ND Street, Suite 216, Lombard, IL 60148
 630.765.0110 voice, 630.839.2566 fax
 www.mps-il.com
MILLENNIA PROFESSIONAL SERVICES

DESIGNED	CJD	REVISED	△
DRAWN	CJD	REVISED	-
CHECKED	TVN	REVISED	-
DATE	2/24/2011	REVISED	-


STATE OF ILLINOIS
DEPARTMENT OF TRANSPORTATION

ILLINOIS ROUTE 53
RAND ROAD TO LAKE COOK ROAD

SIGNING SCHEDULE

F.A.P. RTE.	SECTION	COUNTY	TOTAL SHEETS	SHEET NO.
2592	2010-003 I	COOK	43	6
FED. ROAD DIST. NO. 1 ILLINOIS FED. AID PROJECT			CONTRACT NO. 60K21	

P:\2009\ME\9006\Var\Var_P\I\CADD\W019_IL53\Shets\DI60K21-sht-Signschedule.dgn

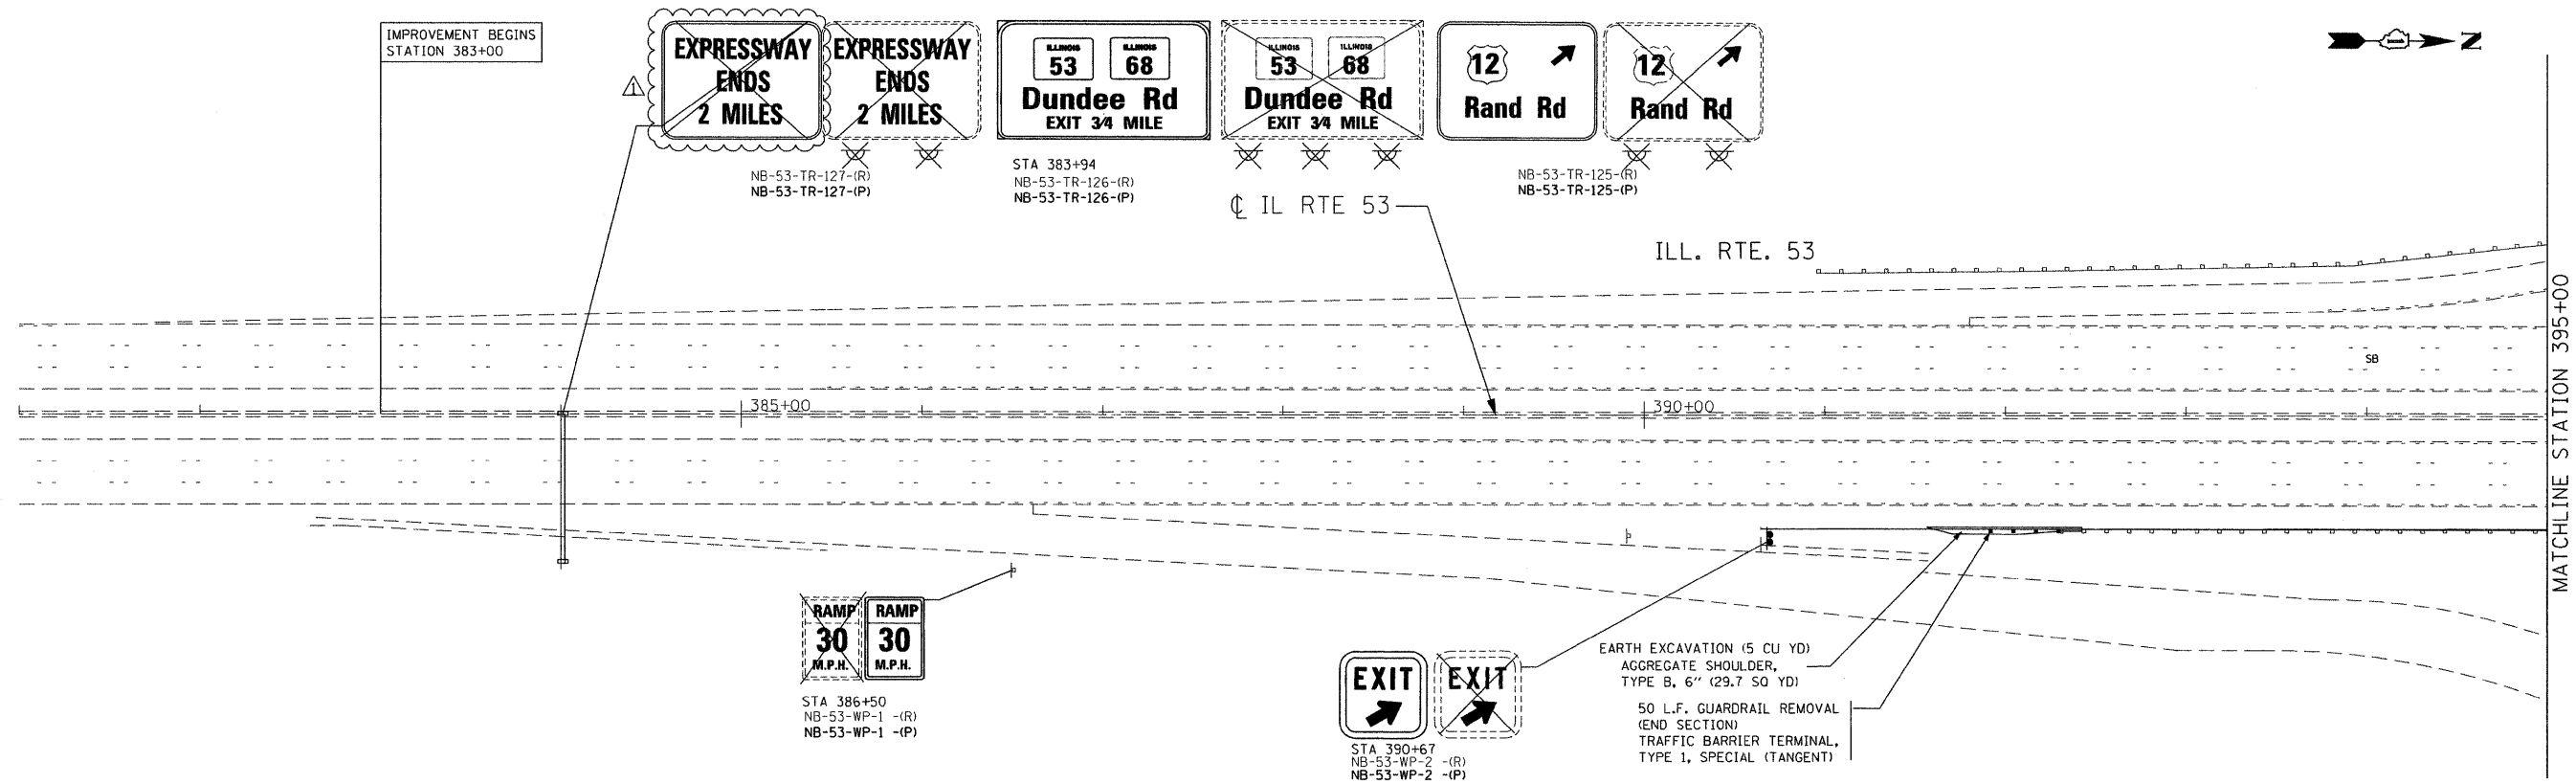

GUIDE SIGN SEQUENCE
NUMBERING CODE

EXAMPLE		
	NB-53-TR-34-(R)	REMOVE (R)
		PROPOSED (P)
		EXISTING (E)
DIRECTION OF TRAFFIC		SIGN PANEL NUMBER
NB - NORTHBOUND		
SB - SOUTHBOUND		
EB - EASTBOUND		
WB - WESTBOUND		
		MOUNTING TYPE
ROADWAY OR INTERCHANGE		TR - TRUSS
53 - ILLINOIS ROUTE 53		CL - CANTILEVER
68 - ILLINOIS ROUTE 68		BR - BRIDGE MOUNTED
LC - LAKE COOK ROAD		WP - WOOD POLE
		TS - TELESCOPIC STEEL
		BS - BREAKAWAY STEEL
		CY - CANOPY MOUNTED
		CW - CONCRETE WALL
		ST - STEEL TUBULAR
		LP - LIGHT POLE

✕ EXISTING LUMINAIRE TO BE REMOVED

NOTE:

△ ALL EXISTING SIGN PANELS THAT CONFLICT WITH MAINTENANCE OF TRAFFIC SIGNING SHALL BE COVERED.

FILE NAME = P:\2009\ME09006-Var\Var-Plan\CADD\W019_IL53_Shts\0160K21-sht-pln-01.dgn
 PLOT SCALE = 50.0000' / 1" IN.
 USER NAME = Millennium Professional Services



200 22ND Street, Suite 216, Lombard, IL 60148
 630.705.0110 voice, 630.839.2566 fax
 www.mps-il.com

MILLENNIA PROFESSIONAL SERVICES

DESIGNED - CJD	REVISED - △
DRAWN - CJD	REVISED -
CHECKED - TVN	REVISED -
DATE - 2/24/2011	REVISED -

STATE OF ILLINOIS
 DEPARTMENT OF TRANSPORTATION

ILLINOIS ROUTE 53
 RAND ROAD TO LAKE COOK ROAD


SIGNING & ROADWAY PLANS

SCALE: 1"=50' SHEET NO. OF SHEETS STA. 381+00 TO STA. 395+00


F.A.P. RTE. 2592	SECTION 2010-003 I	COUNTY COOK	TOTAL SHEETS 43	SHEET NO. 8
FED. ROAD DIST. NO. 1 ILLINOIS FED. AID PROJECT			CONTRACT NO. 60K21	

PLN-01

P:\2009\ME09006-Var\Var-Plan\CADD\W019_IL53_Shts\0160K21-sht-pln-01.dgn

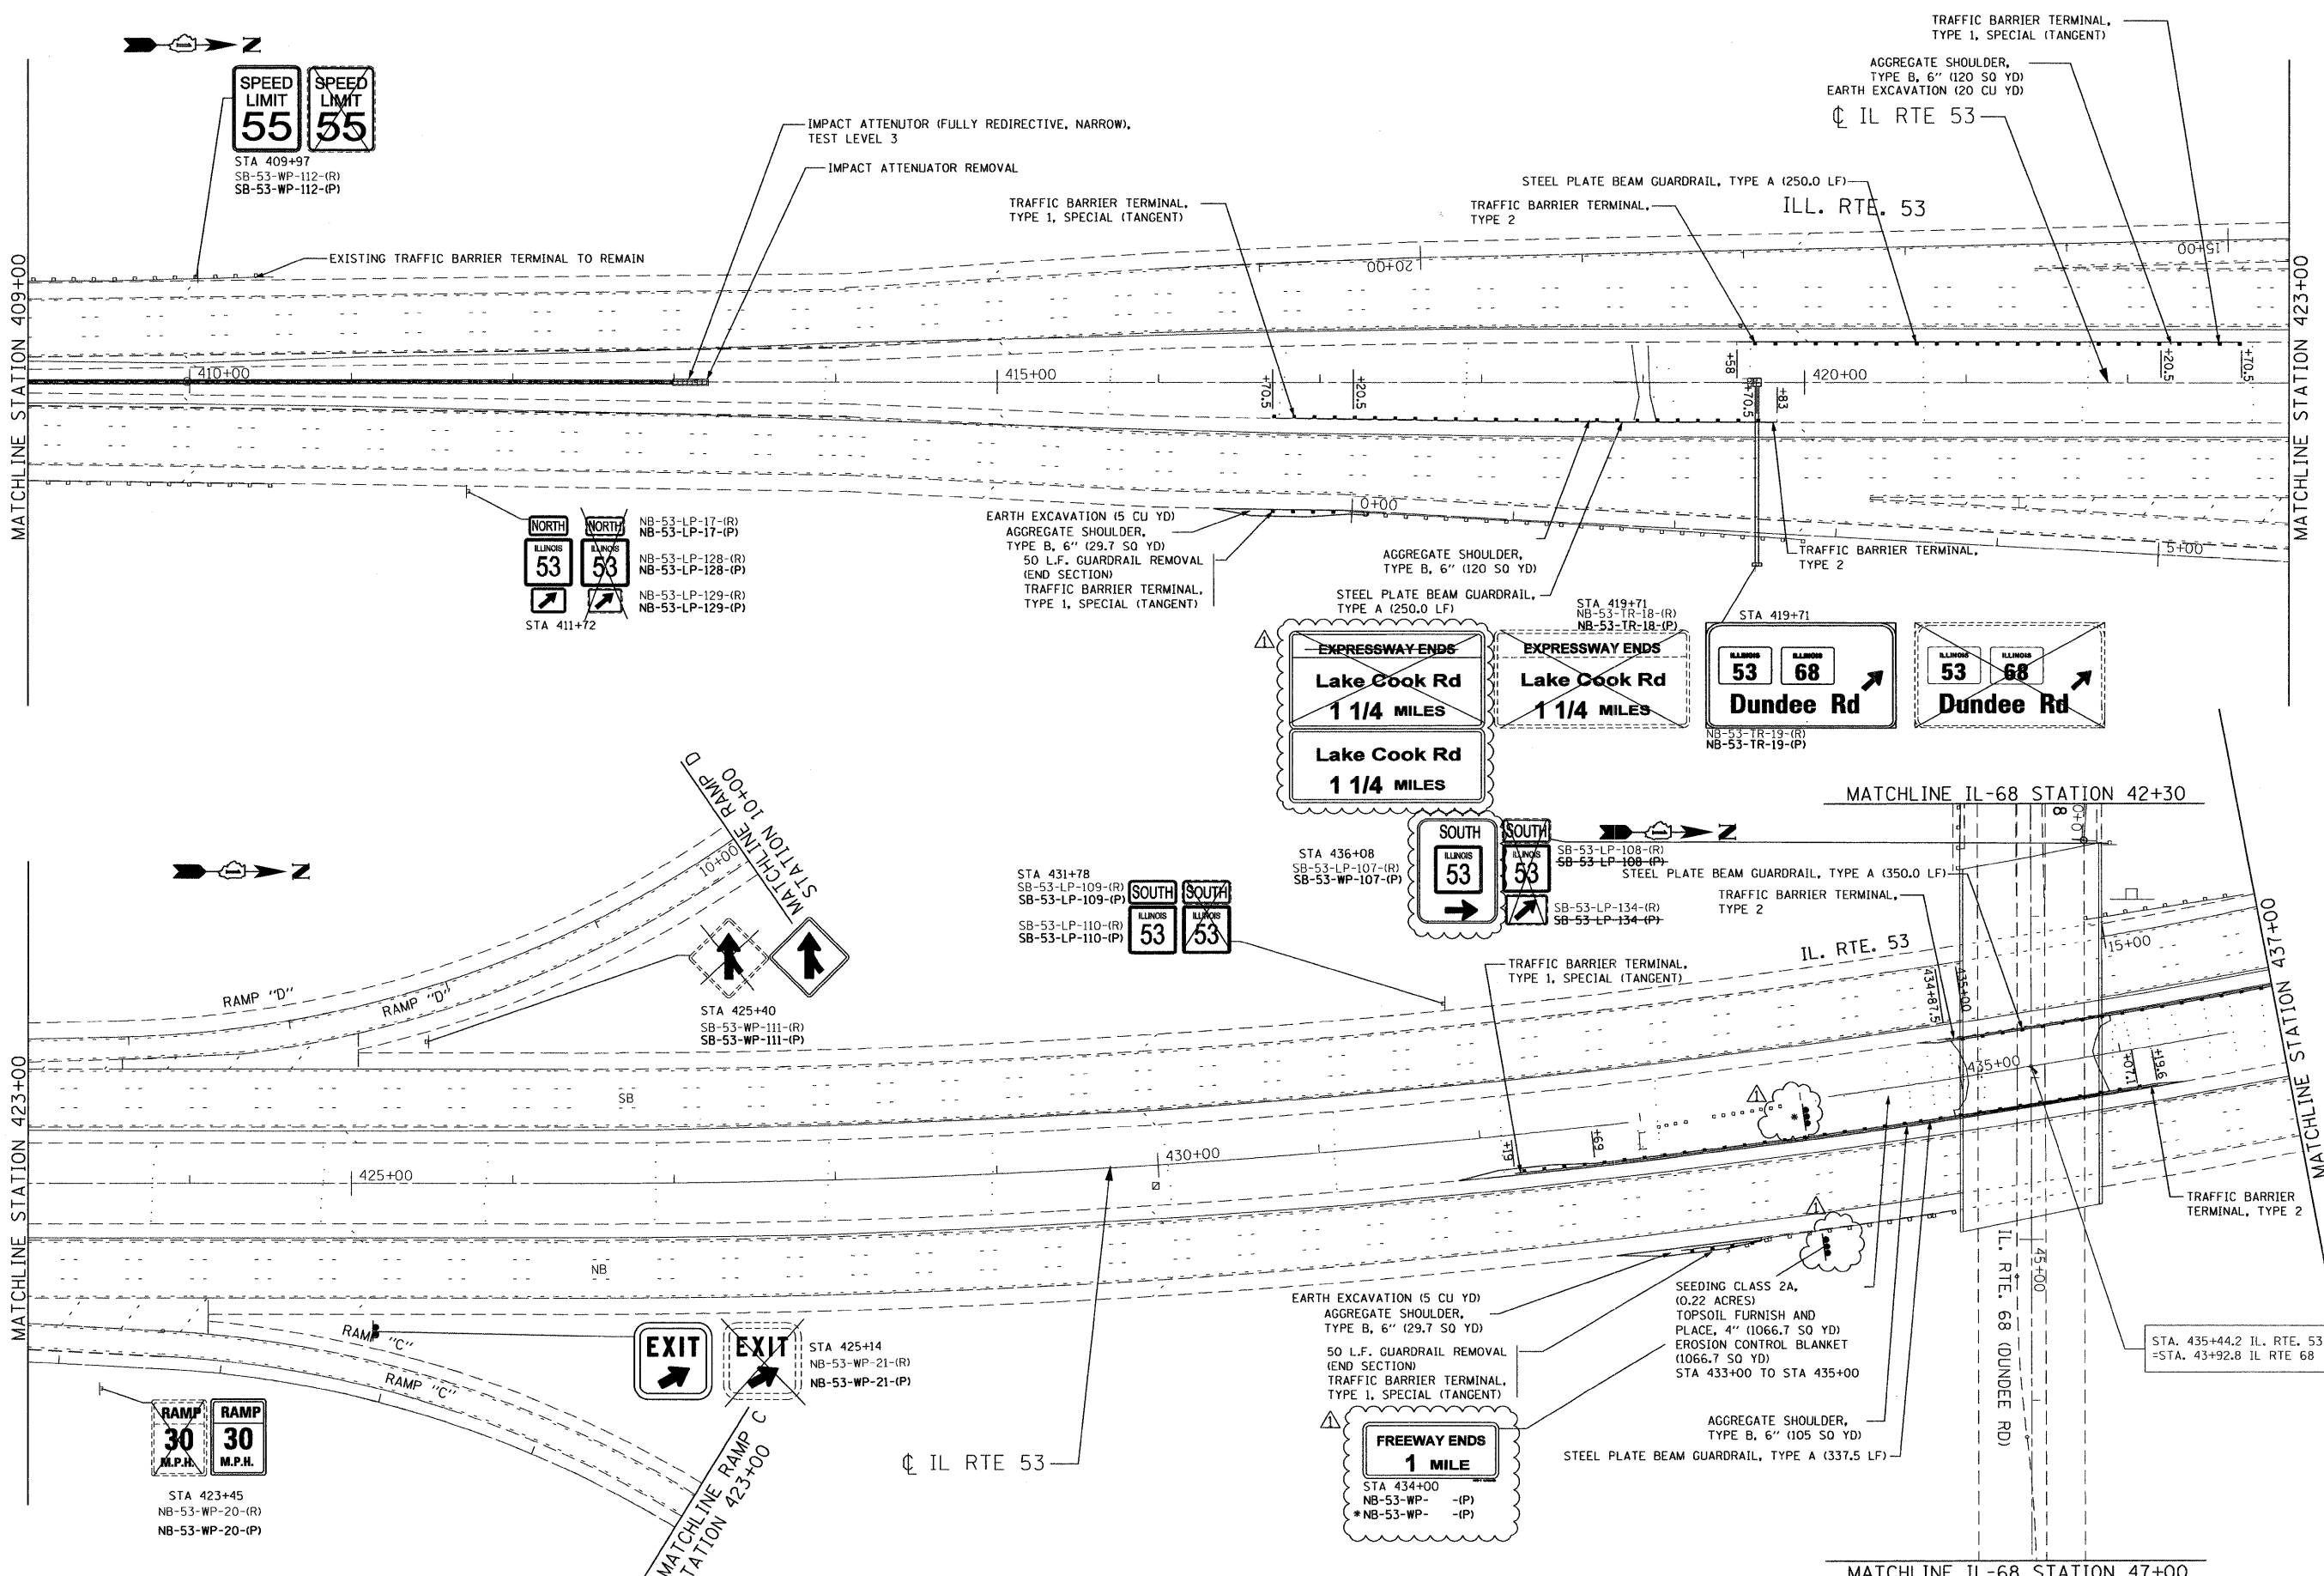

FILE NAME = P:\2009\ME09086_Ver-Vor-Philly\CADD\W019_IL53\Shots\0160K21-shr-pln-03.dgn
 PLOT SCALE = 50.2220 / IN.
 USER NAME = Millennia Professional Services



200 22ND Street, Suite 216, Lombard, IL 60148
 630.705.0110 voice, 630.839.2566 fax
 www.mps-il.com
MILLENNIA PROFESSIONAL SERVICES

DESIGNED - CJD	REVISED -
DRAWN - CJD	REVISED -
CHECKED - TVN	REVISED -
DATE - 2/24/2011	REVISED -

STATE OF ILLINOIS
DEPARTMENT OF TRANSPORTATION



ILLINOIS ROUTE 53
RAND ROAD TO LAKE COOK ROAD

SIGNING & ROADWAY PLANS
 STA. 409+00 TO STA. 437+00

F.A.P. RTE. 2592	SECTION 2010-003 I	COUNTY COOK	TOTAL SHEETS 43	SHEET NO. 10
FED. ROAD DIST. NO. 1 ILLINOIS FED. AID PROJECT			CONTRACT NO. 60K21	

PLN-03

P:\2009\ME09086_Ver-Vor-Philly\CADD\W019_IL53\Shots\0160K21-shr-pln-03.dgn

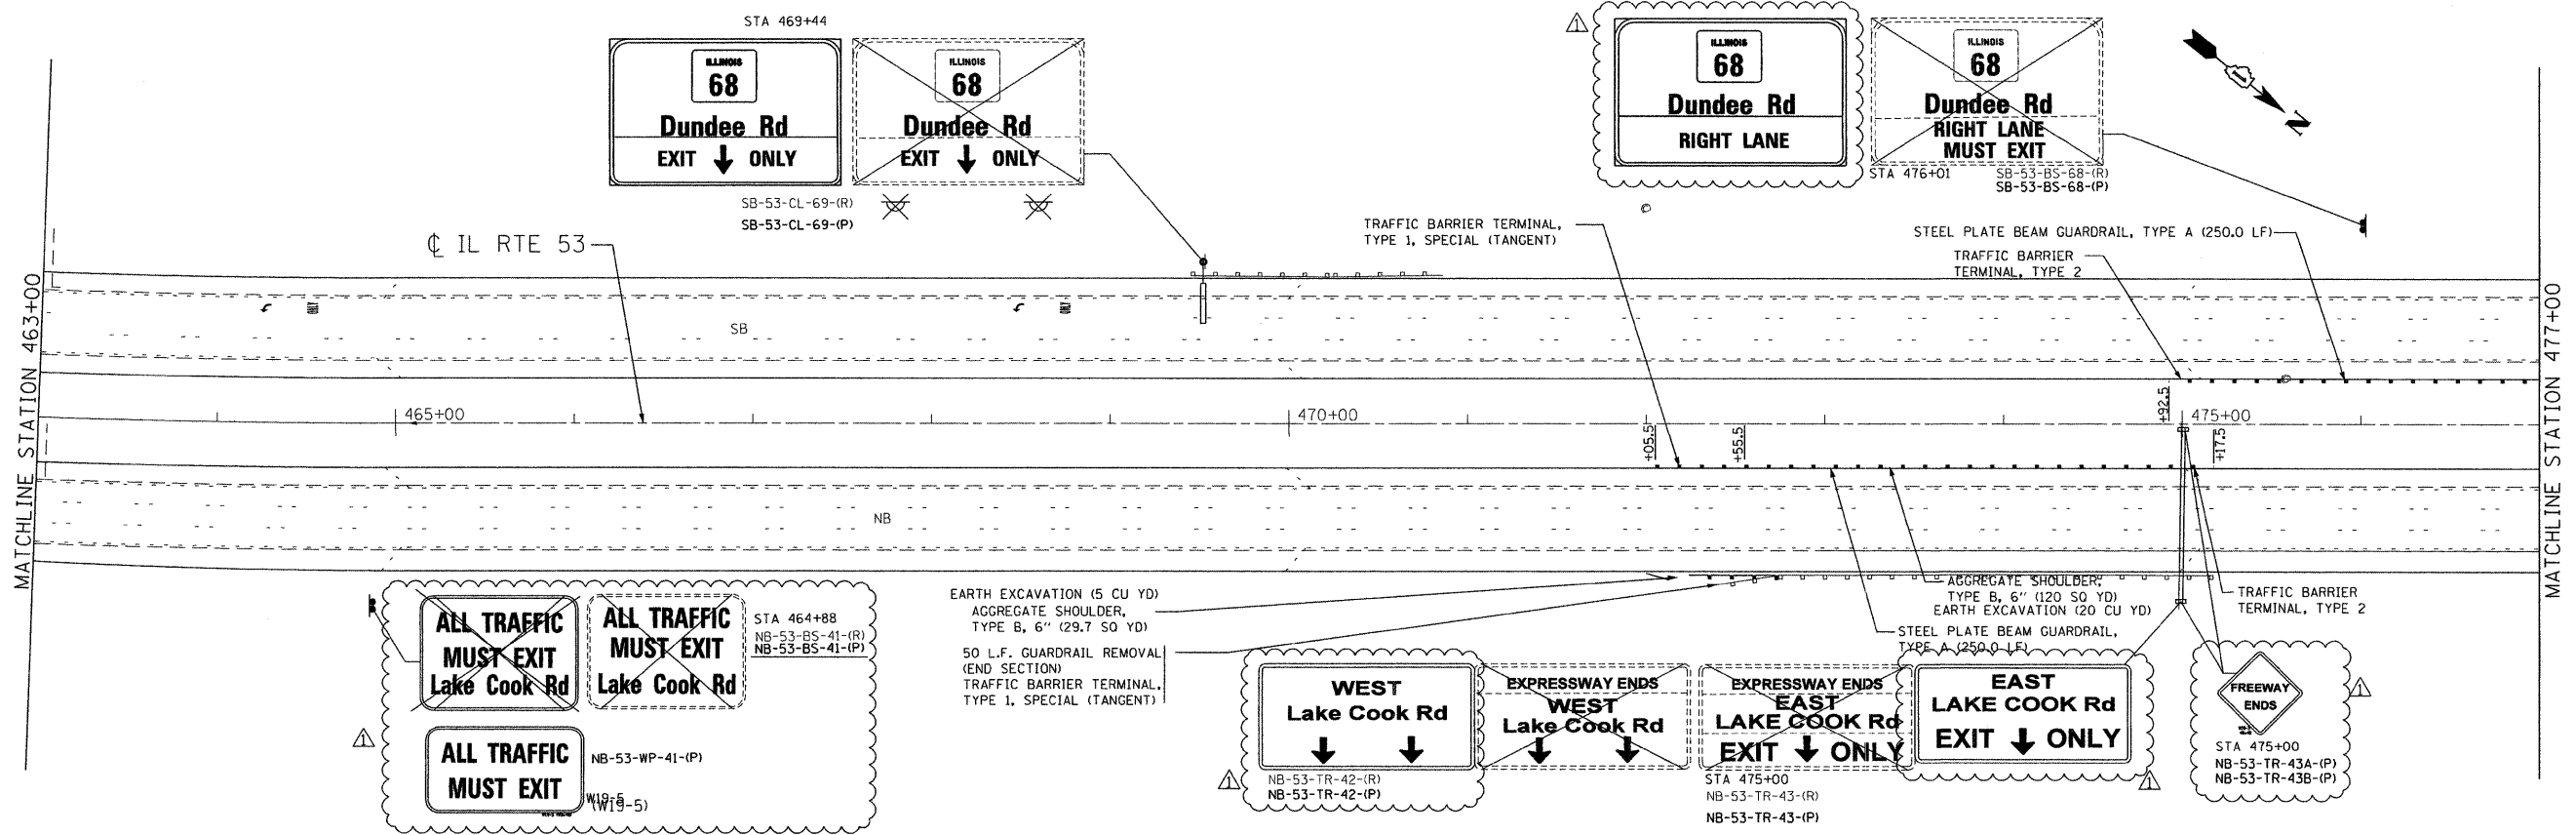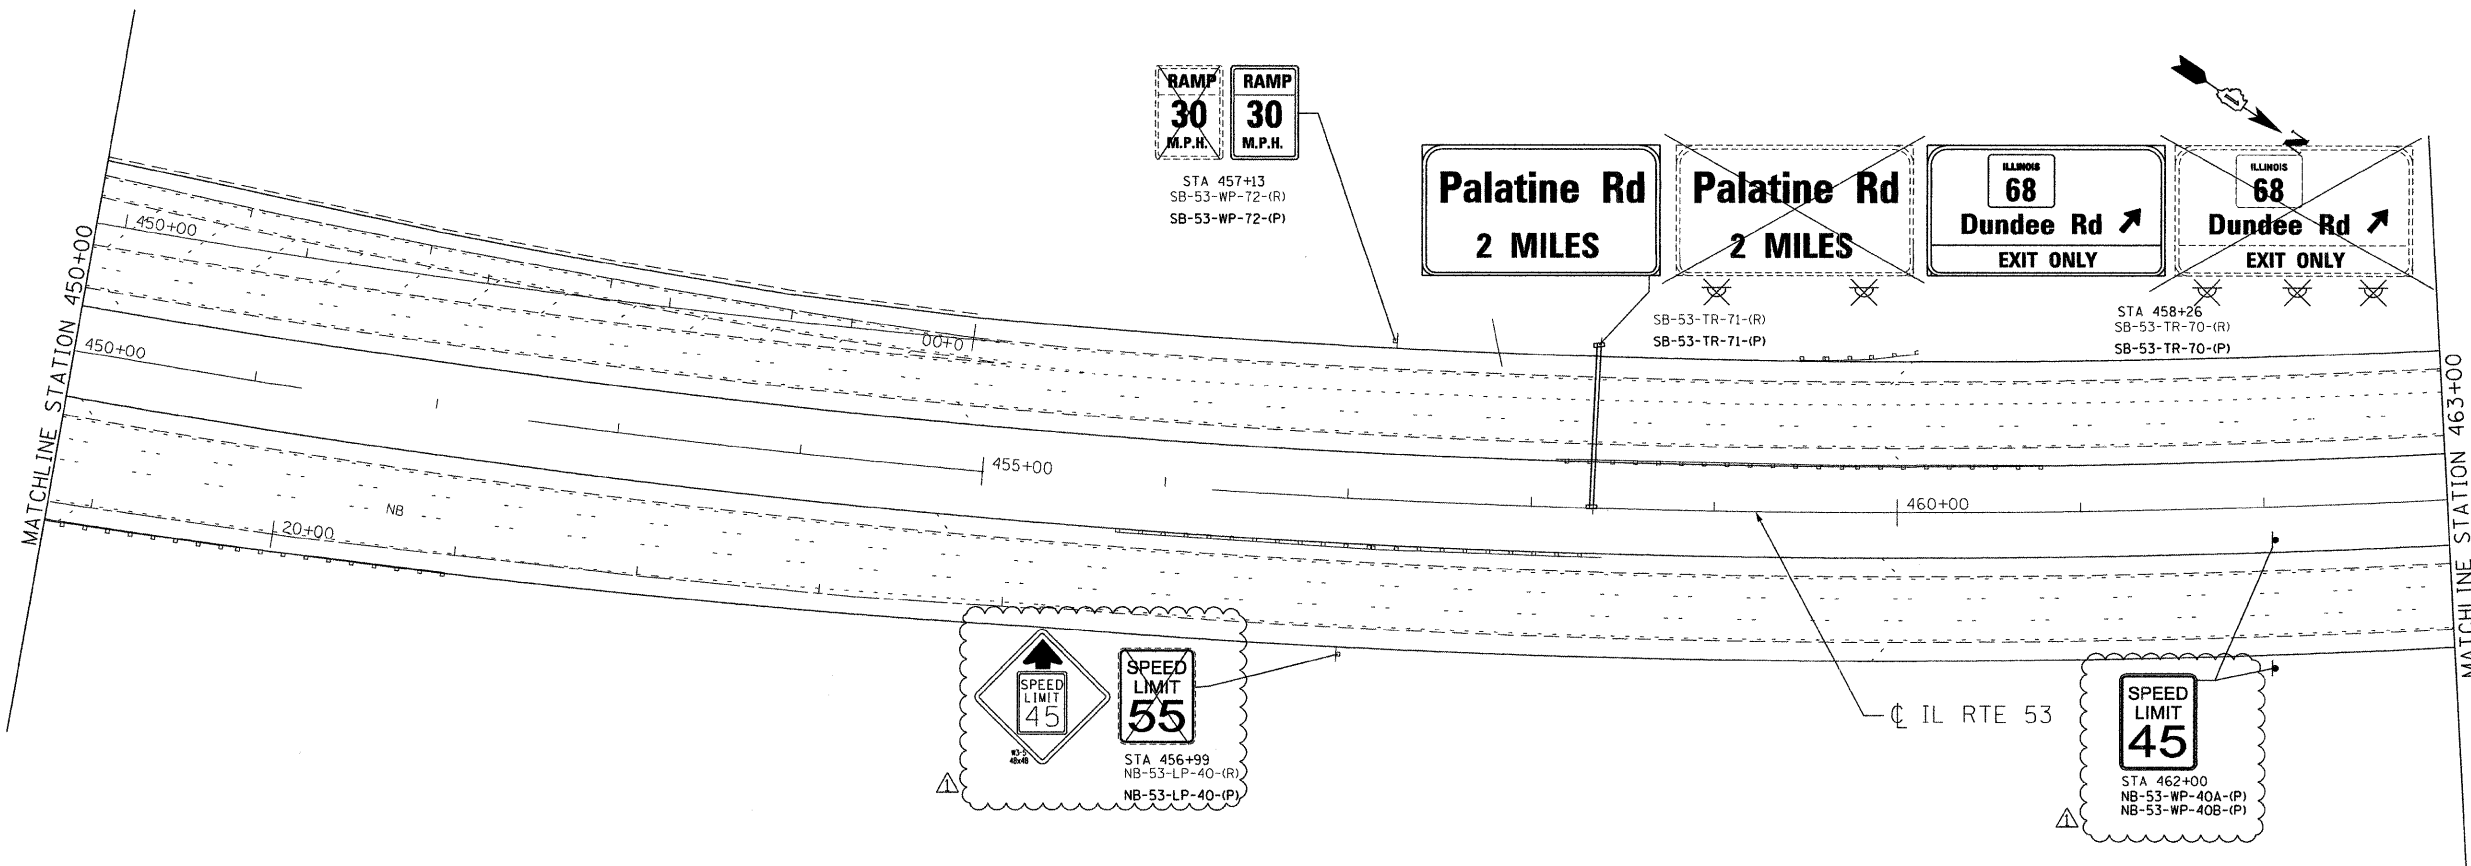

FILE NAME : P:\2009\ME09006_Var-Var_Plan\CADD\W019_IL53\Shas\16621-ht-pln-05.dgn
 PLOT SCALE : 50.0000 / 1 IN.
 USER NAME : PhilLennie (Professional) Services



200 22ND Street, Suite 216, Lombard, IL 60148
 630.795.8110 voice, 630.839.2566 fax
 www.mps-il.com
MILLENNIA PROFESSIONAL SERVICES

DESIGNED	CJD	REVISED	▲
DRAWN	CJD	REVISED	-
CHECKED	TVN	REVISED	-
DATE	2/24/2011	REVISED	-

STATE OF ILLINOIS
DEPARTMENT OF TRANSPORTATION

ILLINOIS ROUTE 53
RAND ROAD TO LAKE COOK ROAD




SIGNING & ROADWAY PLANS

F.A.P. RTE.	SECTION	COUNTY	TOTAL SHEETS	SHEET NO.
2592	2010-003 I	COOK	43	12
CONTRACT NO. 60K21				
FED. ROAD DIST. NO. 1 ILLINOIS FED. AID PROJECT				


PLN-05

SCALE: 1"=50' SHEET NO. OF SHEETS STA. 450+00 TO STA. 477+00

P:\2009\ME09006_Var-Var_Plan\CADD\W019_IL53\Shas\16621-ht-pln-05.dgn

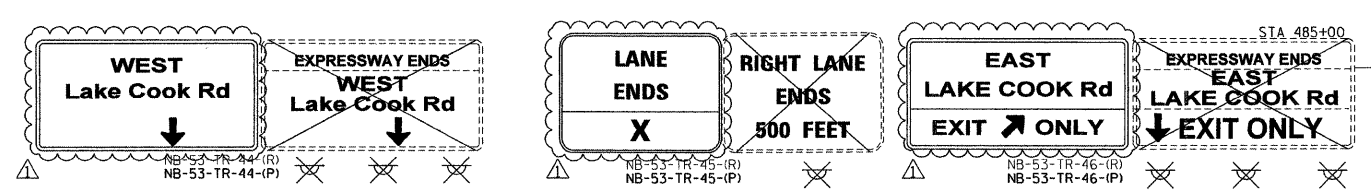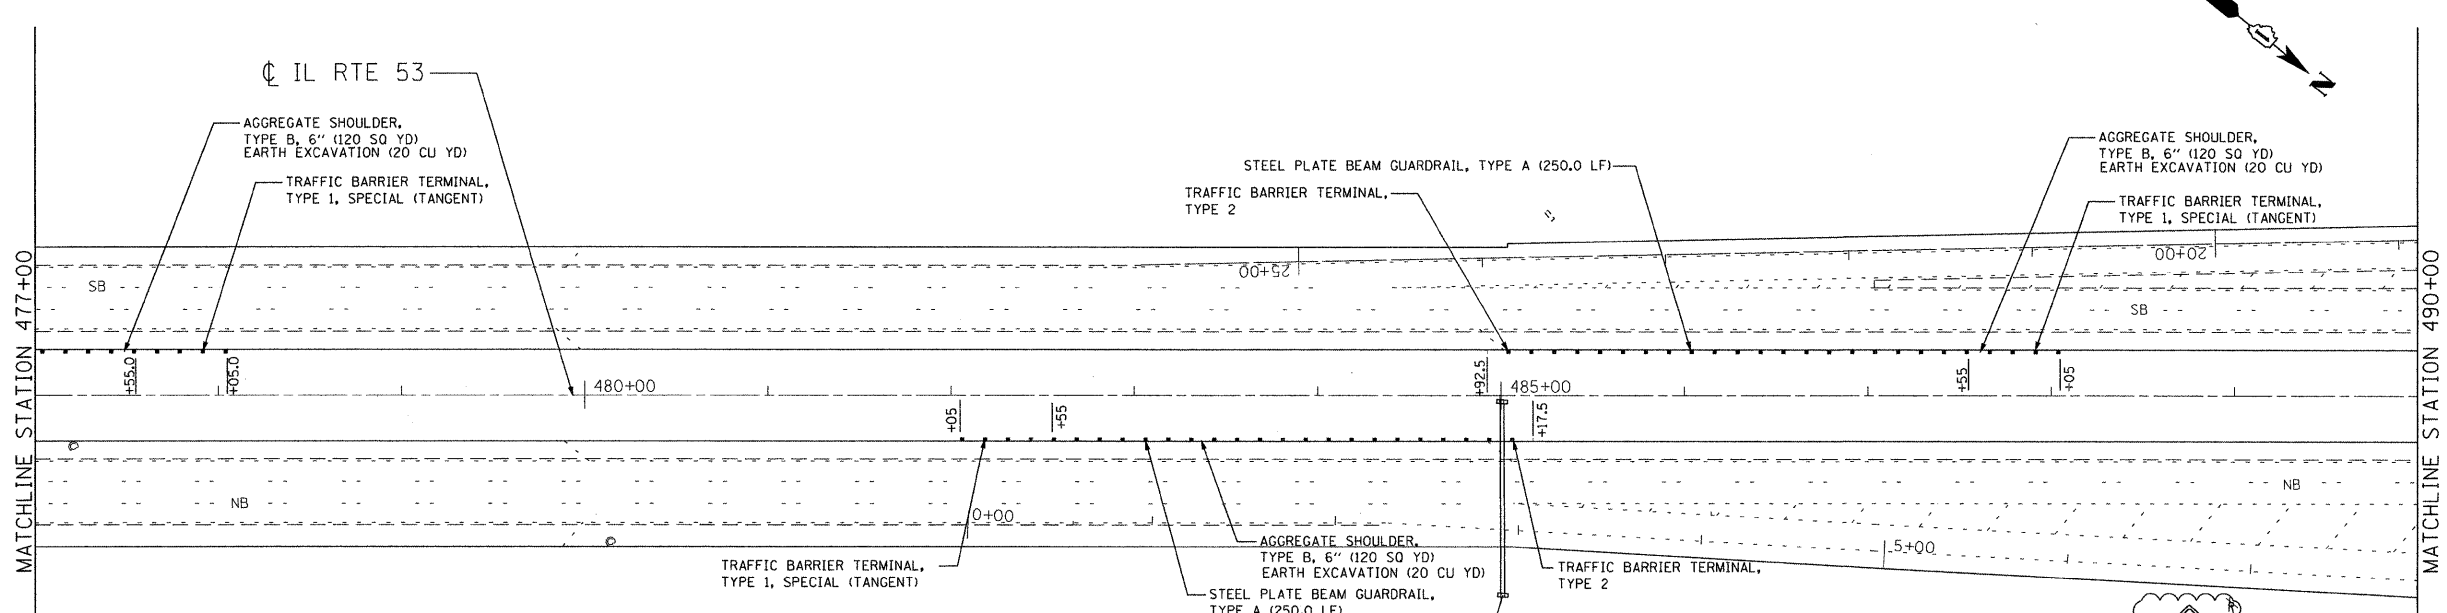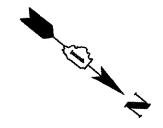

FILE NAME = P:\2009\ME09086_Ver-Yor_Pht\CADD\WD19_IL53\Shas\DI60K21-sht-pln-06.dgn
 PLOT SCALE = 50.0000 / IN.
 USER NAME = Millennia Professional Services

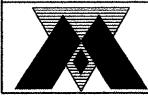

200 22ND Street, Suite 216, Lombard, IL 60148
 630.765.0110 voice, 630.839.2566 fax
 www.mps-il.com
MILLENNIA PROFESSIONAL SERVICES

DESIGNED -	CJD	REVISED -	△
DRAWN -	CJD	REVISED -	
CHECKED -	TVN	REVISED -	
DATE -	2/24/2011	REVISED -	

STATE OF ILLINOIS
DEPARTMENT OF TRANSPORTATION

ILLINOIS ROUTE 53
RAND ROAD TO LAKE COOK ROAD


SIGNING & ROADWAY PLANS

F.A.P. RTE.	SECTION	COUNTY	TOTAL SHEETS	SHEET NO.
2592	2010-003 I	COOK	43	13
FED. ROAD DIST. NO. 1 ILLINOIS FED. AID PROJECT			CONTRACT NO. 60K21	


PLN-06


SCALE: 1"=50' SHEET NO. OF SHEETS STA. 477+00 TO STA. 490+00

P:\2009\ME09086_Ver-Yor_Pht\CADD\WD19_IL53\Shas\DI60K21-sht-pln-06.dgn

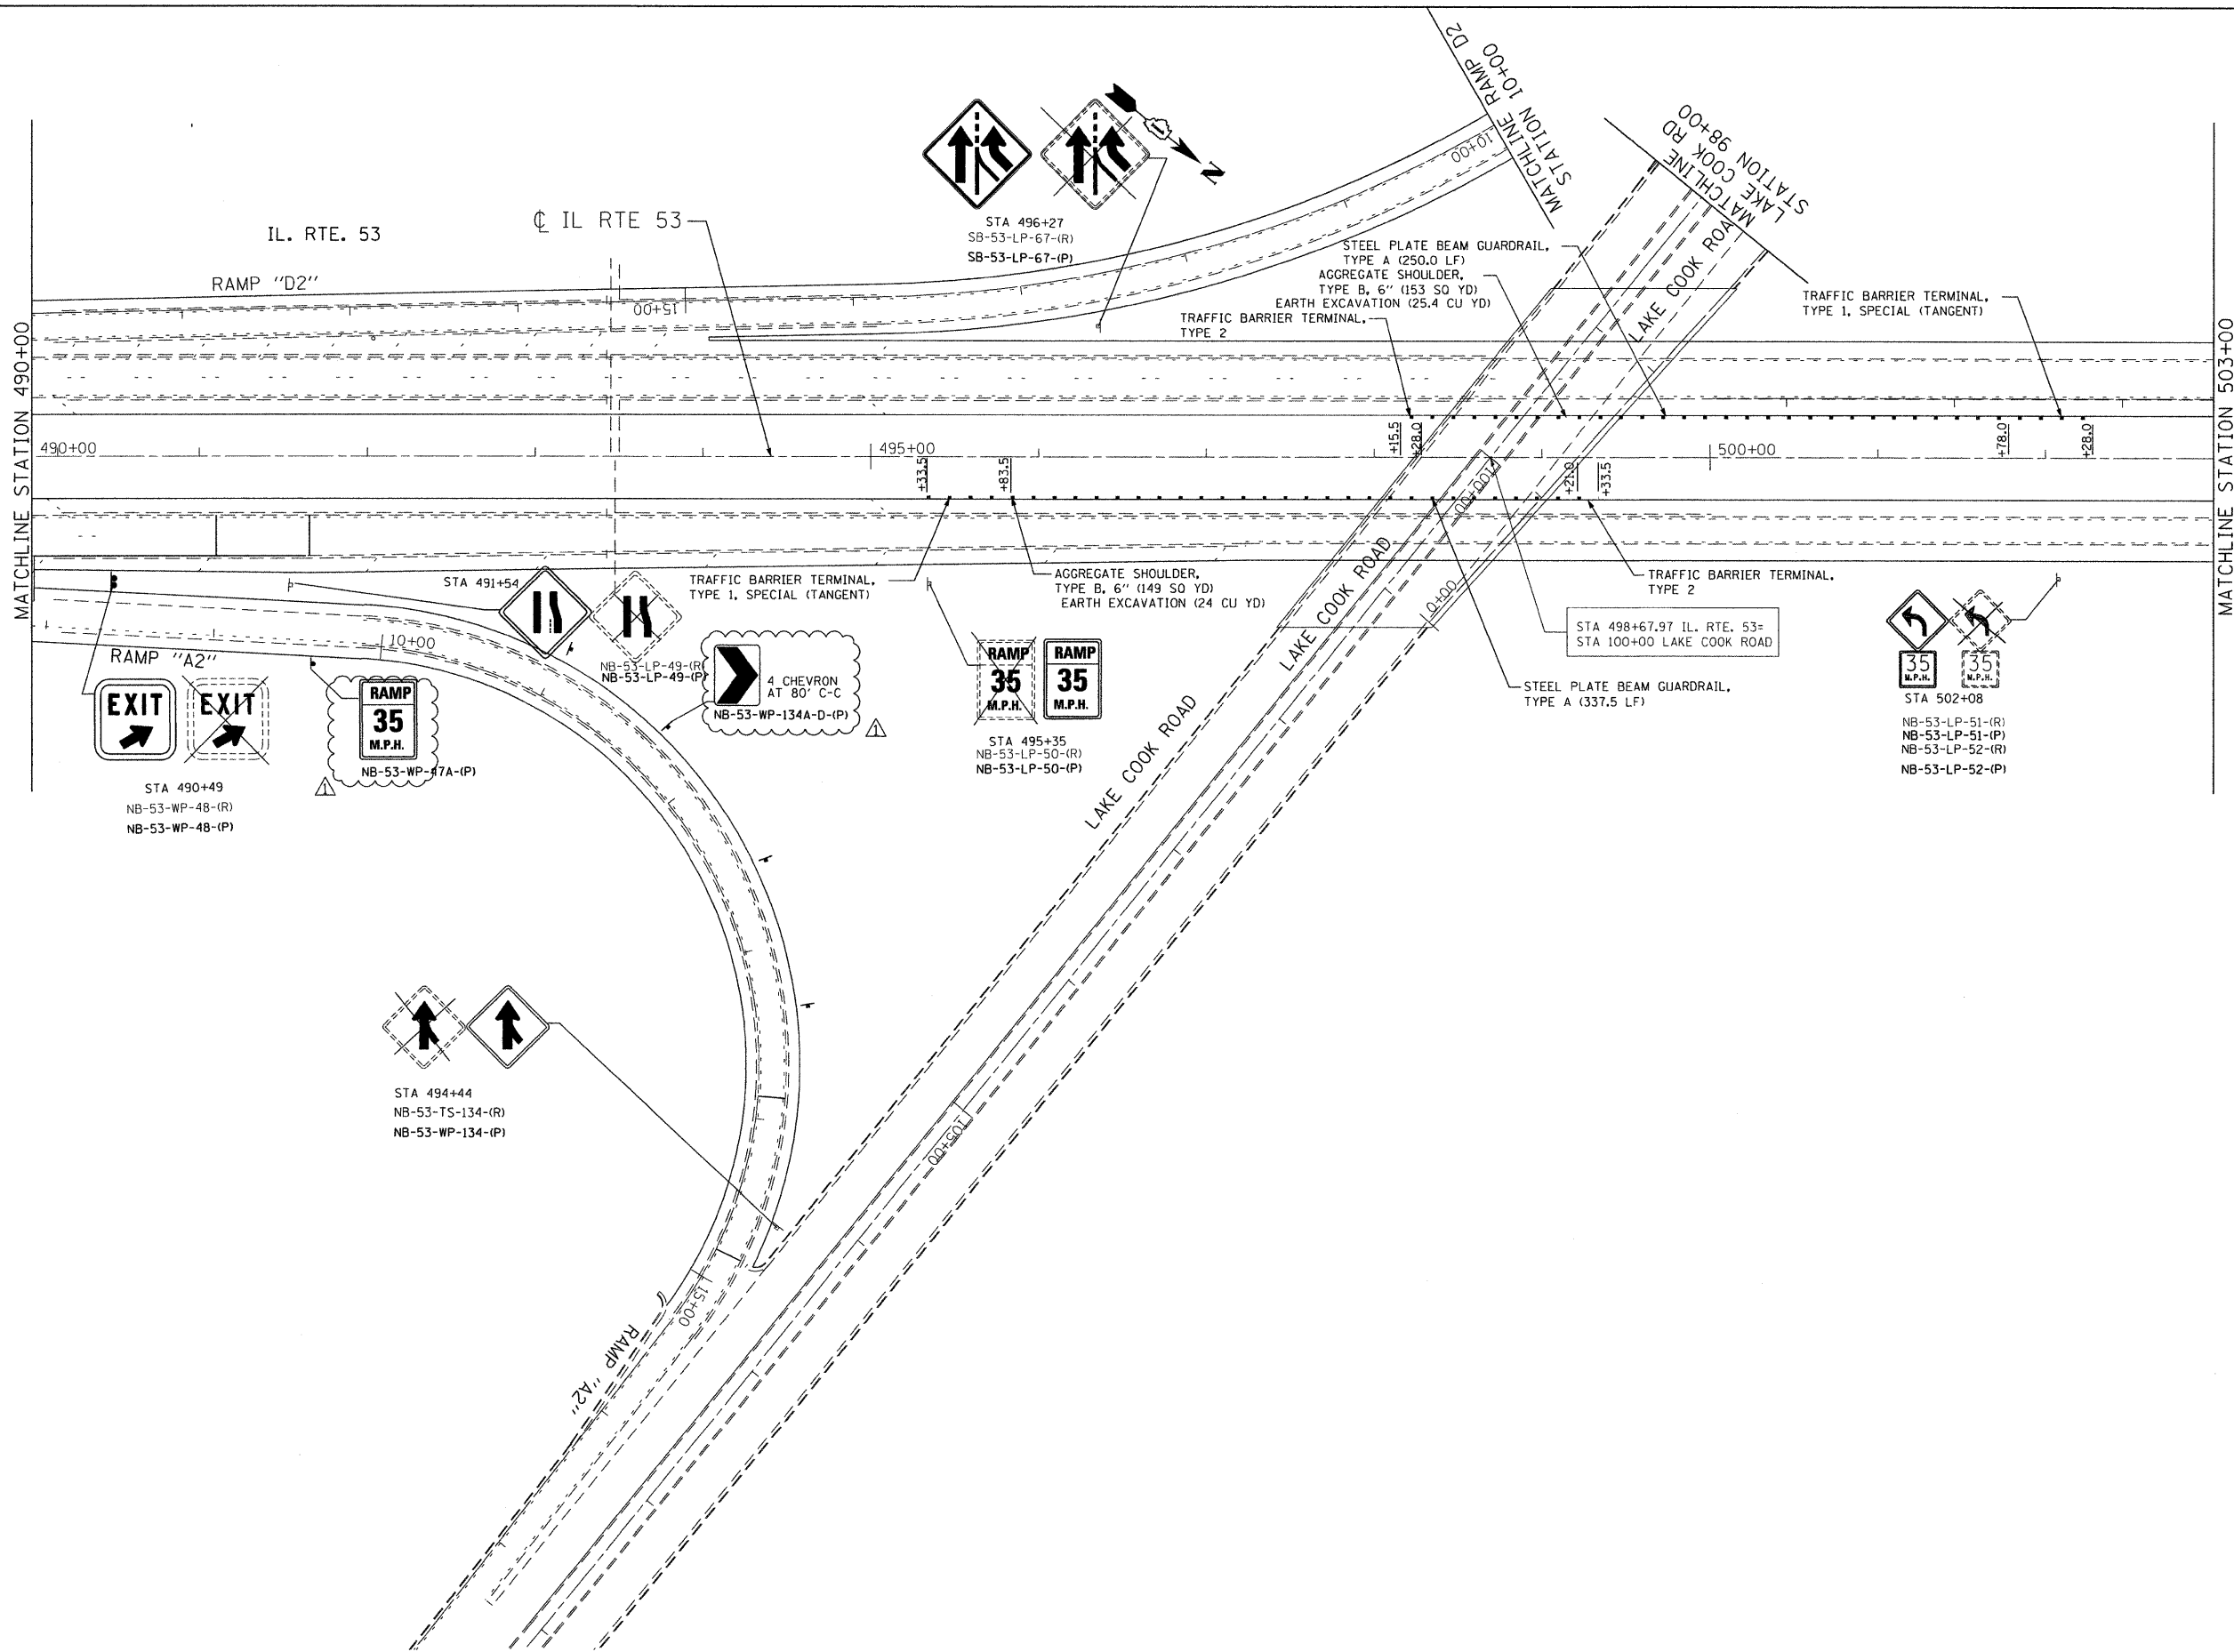

P:\2009\ME09006_Ver-Vor-Phi\CADD\W019_IL53\Shs\0160k21-sht-pln-07.dgn
 FILE NAME =
 USER NAME = Millennium Professional Services


MILLENNIA PROFESSIONAL SERVICES
 200 22ND Street, Suite 216, Lombard, IL 60148
 630.705.0110 voice, 630.839.2566 fax
 www.mps-il.com

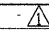DESIGNED - CJD	REVISED - 
DRAWN - CJD	REVISED -
CHECKED - TVN	REVISED -
DATE - 2/24/2011	REVISED -


STATE OF ILLINOIS
DEPARTMENT OF TRANSPORTATION

ILLINOIS ROUTE 53 RAND ROAD TO LAKE COOK ROAD		SIGNING & ROADWAY PLANS	
SCALE: 1"=50'	SHEET NO. OF SHEETS	STA. 490+00 TO STA. 503+00	

F.A.P. RTE. 2592	SECTION 2010-003 I	COUNTY COOK	TOTAL SHEETS 43	SHEET NO. 14
FED. ROAD DIST. NO. 1 ILLINOIS FED. AID PROJECT CONTRACT NO. 60K21				

PLN-07

P:\2009\ME09006_Ver-Vor-Phi\CADD\W019_IL53\Shs\0160k21-sht-pln-07.dgn

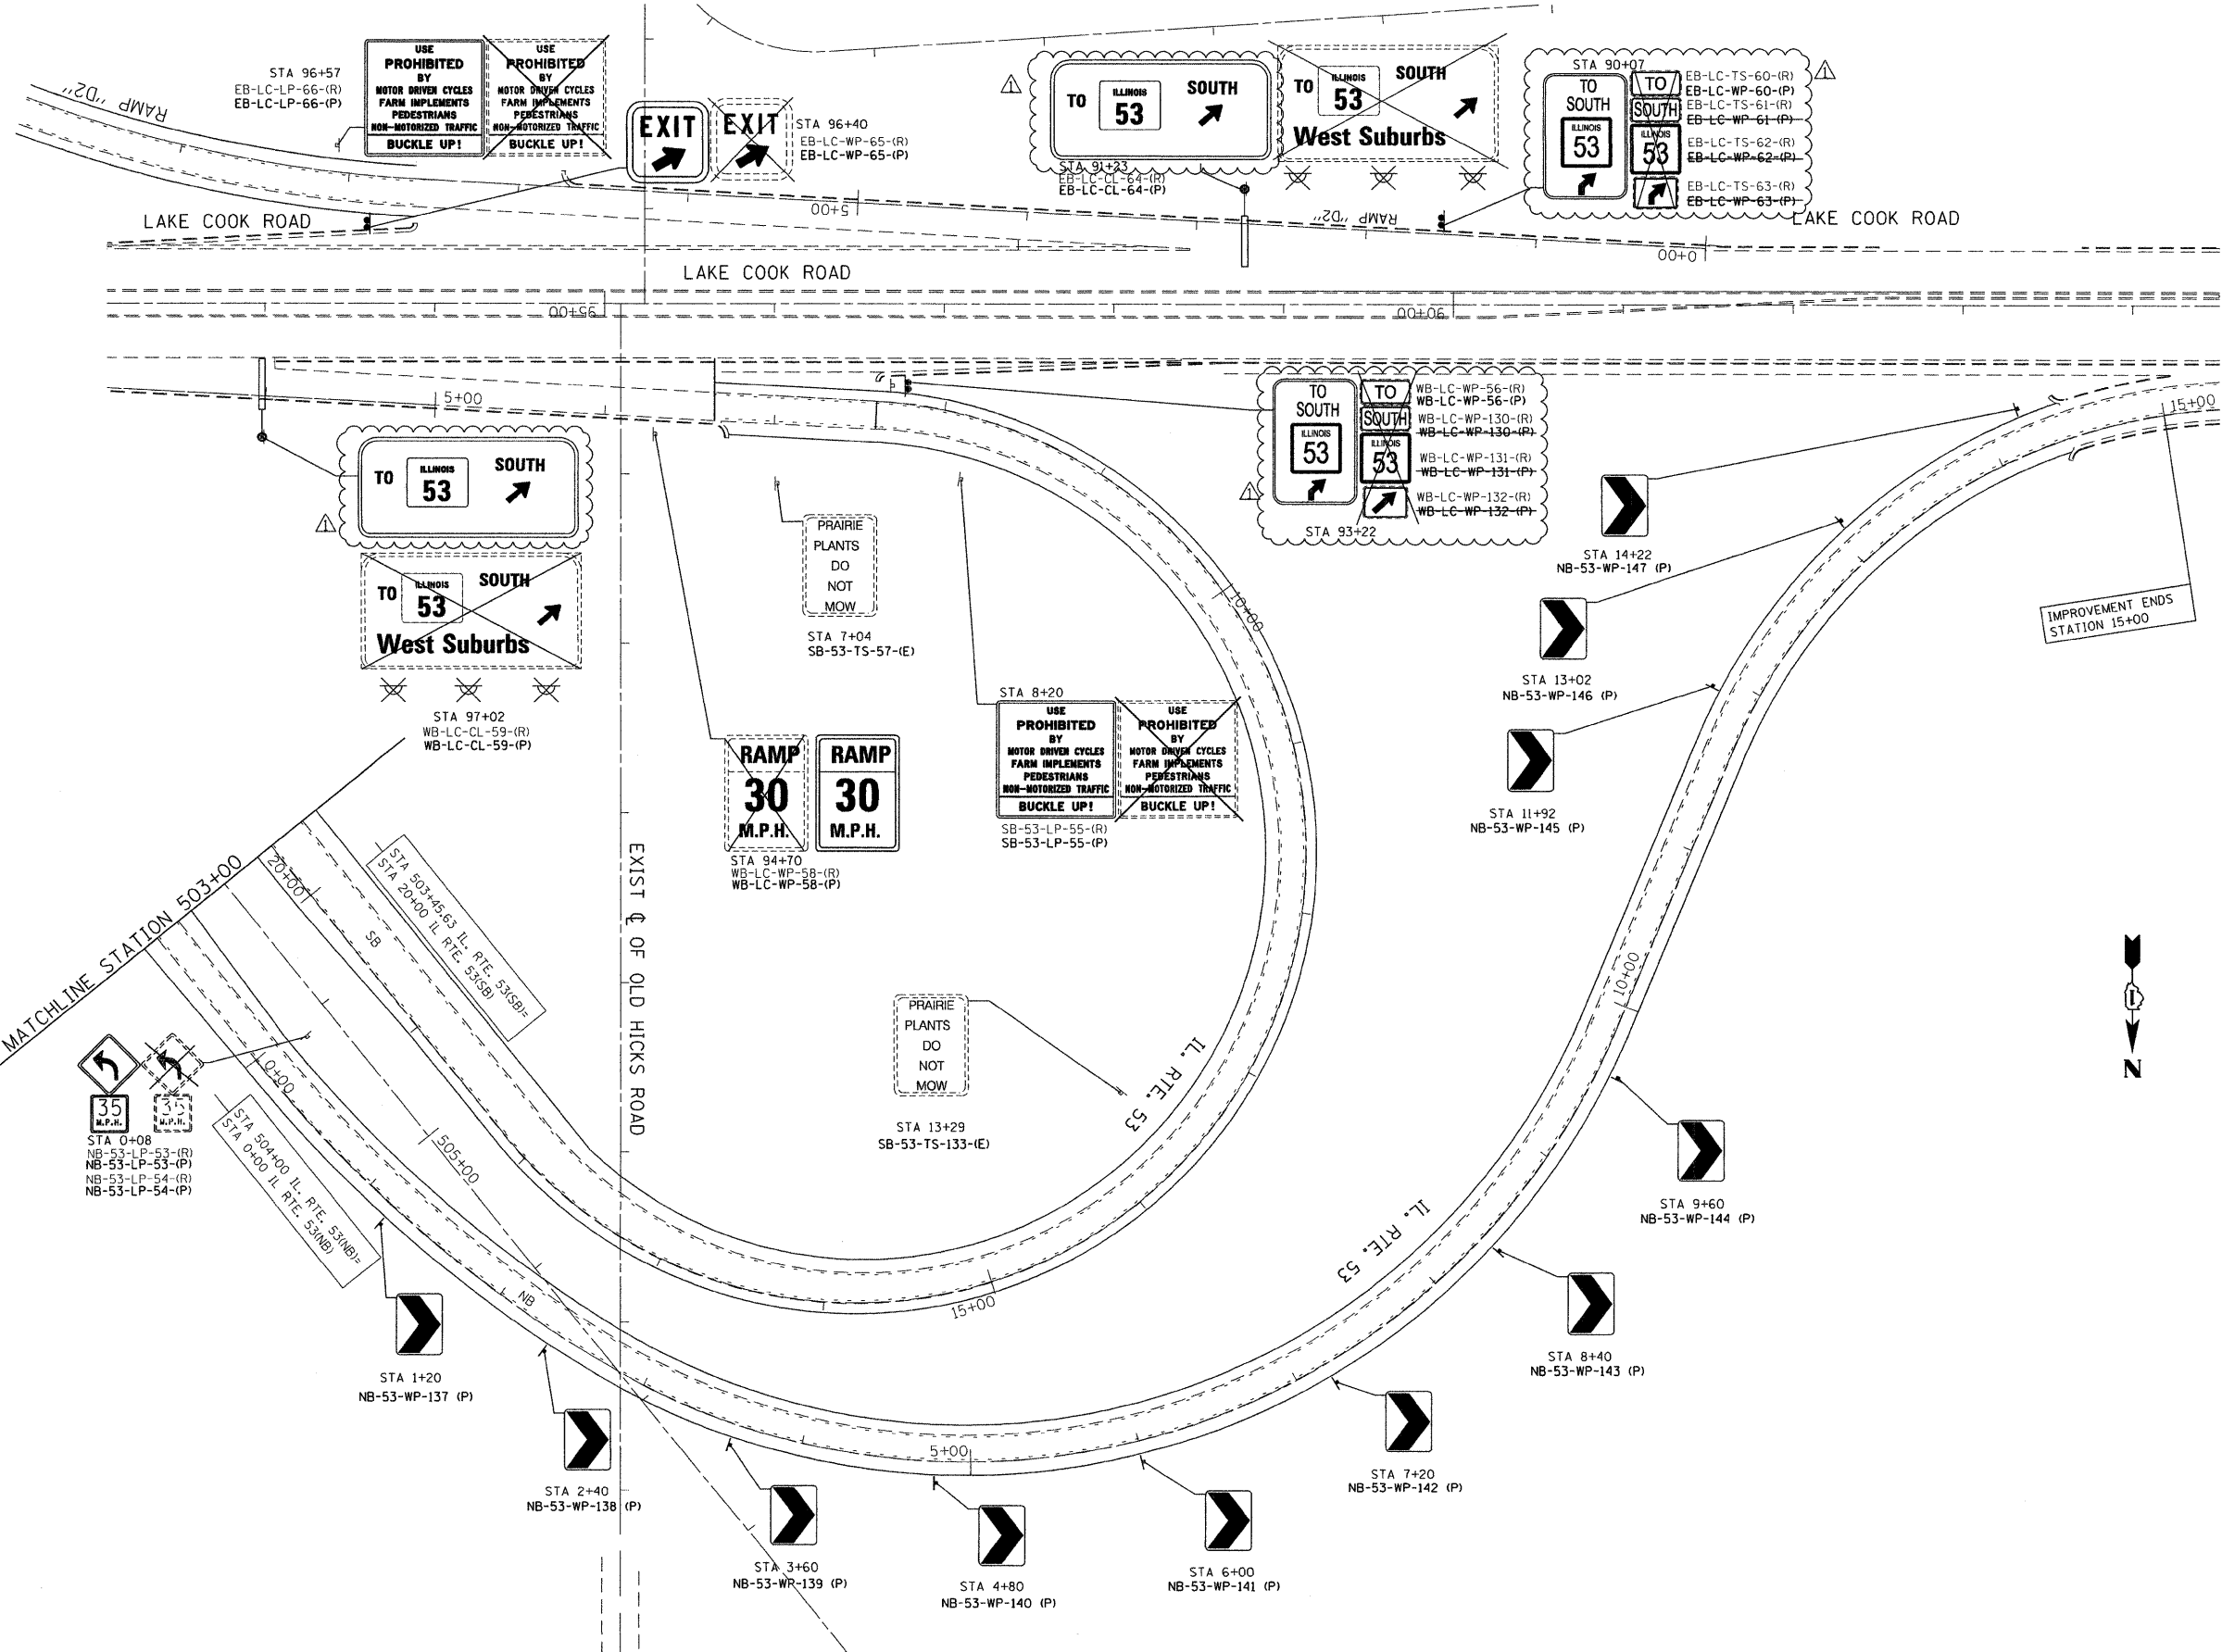

FILE NAME: P:\2009\ME09086_Var-Var_Phil\CADD\W019_IL53\Shsta\0168K21-shr-pln-08.dgn
 PLOT SCALE: 5/8"=1'-0"
 USER NAME: Millennium Professional Services



100 21st Street, Suite 216, Lombard, IL 60148
 630.705.0110 voice, 630.639.2566 fax
 www.mps-ill.com
MILLENNIA PROFESSIONAL SERVICES

DESIGNED - CJD	REVISED -
DRAWN - CJD	REVISED -
CHECKED - TVN	REVISED -
DATE - 2/24/2011	REVISED -

STATE OF ILLINOIS
DEPARTMENT OF TRANSPORTATION

ILLINOIS ROUTE 53
RAND ROAD TO LAKE COOK ROAD
 SCALE: 1"=50' SHEET NO. OF SHEETS STA. 503+00 TO STA. 15+00


SIGNING & ROADWAY PLANS

F.A.P. RTE. 2592	SECTION 2010-003 I	COUNTY COOK	TOTAL SHEETS 43	SHEET NO. 15
FED. ROAD DIST. NO. 1 ILLINOIS FED. AID PROJECT			CONTRACT NO. 60K21	

PLN-08

P:\2009\ME09086_Var-Var_Phil\CADD\W019_IL53\Shsta\0168K21-shr-pln-08.dgn

FILE NAME : P:\2009\ME090606_Ver-Vor-Ph11\CADD\W019_IL53\Sheet\160K21-sht-pln-09.dgn
 PLOT SCALE : 45,9853 / IN.
 USER NAME : Millennia Professional Services

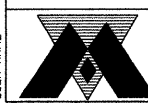

200 22ND Street, Suite 216, Lombard, IL 60148
 630.705.0110 voice, 630.839.2566 fax
 www.mps-ll.com

MILLENNIA PROFESSIONAL SERVICES

DESIGNED - CJD	REVISED -
DRAWN - CJD	REVISED -
CHECKED - TVN	REVISED -
DATE - 2/24/2011	REVISED -

**STATE OF ILLINOIS
 DEPARTMENT OF TRANSPORTATION**

**ILLINOIS ROUTE 53
 RAND ROAD TO LAKE COOK ROAD**

SCALE: 1"=50' SHEET NO. OF SHEETS STA. 395+00 TO STA. 409+00

SIGNING & ROADWAY PLANS

F.A.P. RTE. 2592 SECTION 2010-003 1 COUNTY COOK TOTAL SHEETS 43 SHEET NO. 16 CONTRACT NO. 60K21

F.A.P. RTE.	SECTION	COUNTY	TOTAL SHEETS	SHEET NO.
2592	2010-003 1	COOK	43	16
FED. ROAD DIST. NO. 1 ILLINOIS FED. AID PROJECT				

PLN-09

