

INDEX OF SHEETS

92


SHEET NO.	ITEM
1	TITLE SHEET
2-3	TYPICAL SECTIONS
4	GENERAL NOTES
5-8A	SUMMARY OF QUANTITIES
6	SCHEDULE OF QUANTITIES
6A	TIE POINTS
7-8	PLAN AND PROFILES
9	STAGE I CONSTRUCTION, TRAFFIC CONTROL PLAN
10	STAGE II CONSTRUCTION, TRAFFIC CONTROL PLAN
11	TRAFFIC CONTROL AND PROTECTION, STANDARD 7014II (SPECIAL)
12	STAGE CONSTRUCTION DETAILS
13	CONSTRUCTION DETAILS
14	INERTIAL BARRIER DETAILS
15	GUARDRAIL MARKER DETAILS, SLIPFORMED PARAPET WALL DETAILS
16-40	BRIDGE PLANS
41-47	CROSS-SECTIONS

STANDARDS

00001-1	STANDARD SYMBOLS AND ABBREVIATIONS
55001	NAME PLATES FOR BRIDGES
542401	METAL END SECTION FOR PIPE CULVERTS
630001	STEEL PLATE BEAM GUARDRAIL
702001	TYPICAL APPLICATION OF TRAFFIC CONTROL DEVICES
701006-1	TYPICAL APPLICATION OF TRAFFIC CONTROL DEVICES
70201	TYPICAL APPLICATION OF TRAFFIC CONTROL DEVICES
701301	TYPICAL APPLICATION OF TRAFFIC CONTROL DEVICES
7031	TYPICAL APPLICATION OF TRAFFIC CONTROL DEVICES
70101	TYPICAL APPLICATION OF TRAFFIC CONTROL DEVICES
70406	TYPICAL APPLICATION OF TRAFFIC CONTROL DEVICES
610001-1	SHOULDER INLET WITH CURB (2 SHEETS)
631031	TRAFFIC BARRIER TERMINAL, TYPE 6
280001	TEMPORARY EROSION CONTROL SYSTEMS
704001	TEMPORARY CONCRETE BARRIER
790001	TYPICAL PAVEMENT MARKINGS
701321-01	TYPICAL APPLICATION OF TRAFFIC CONTROL DEVICES
420401-01	BRIDGE APPROACH PAVEMENT
70141	TYPICAL APPLICATION OF TRAFFIC CONTROL DEVICES
70106	TYPICAL APPLICATION OF TRAFFIC CONTROL DEVICES
603001	CONCRETE PARAPET SLIP-FORMING OPTION
631011	TRAFFIC BARRIER TERMINAL TYPE 2

I HEREBY CERTIFY THAT THESE PLANS WERE PREPARED BY ME OR UNDER MY DIRECT PERSONAL SUPERVISION AND THAT I AM A DULY REGISTERED PROFESSIONAL ENGINEER UNDER THE LAWS OF THE STATE OF ILLINOIS.

*Ted M. Montrey* DATE 3/13/96  
 TED M. MONTREY  
 LICENSE EXPIRES 11-30-97 P.E. NO. 49591

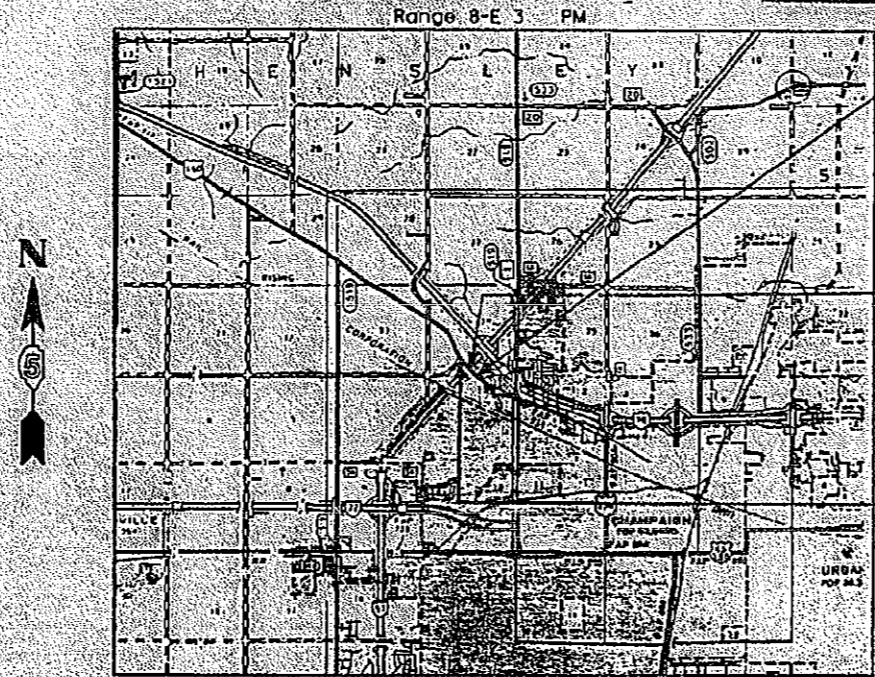

LOCATION MAP



NET LENGTH OF SECTION & PROJECT IM-57-5(178)237 = 442.52 METERS = 0.443 Km


**AS BUILT PLANS**

STATE OF ILLINOIS  
 DEPARTMENT OF TRANSPORTATION  
 DIVISION OF HIGHWAYS  
**PLANS FOR PROPOSED  
 FEDERAL AID HIGHWAY**

PLAN 1:500  
 PROFILE HORIZ. 1:500  
 PROFILE VERT. 1:50  
 CROSS SECTIONS HORIZ. 1:200  
 CROSS SECTIONS VERT. 1:100

F.A.I. ROUTE 57 (I-57)  
 SECTION (10-34HB)BR  
 CHAMPAIGN COUNTY  
 PROJECT NO. IM-57-5(178)237  
 C-95-153-91  
 DECK REPLACEMENT

CONTRACTOR	Freesen, Inc. P.O. Box 10420 Springfield, IL 62791
RESIDENT ENGINEER	S. T. MCMASTER
START DATE	9-21-99
COMPLETION DATE	6-22-01

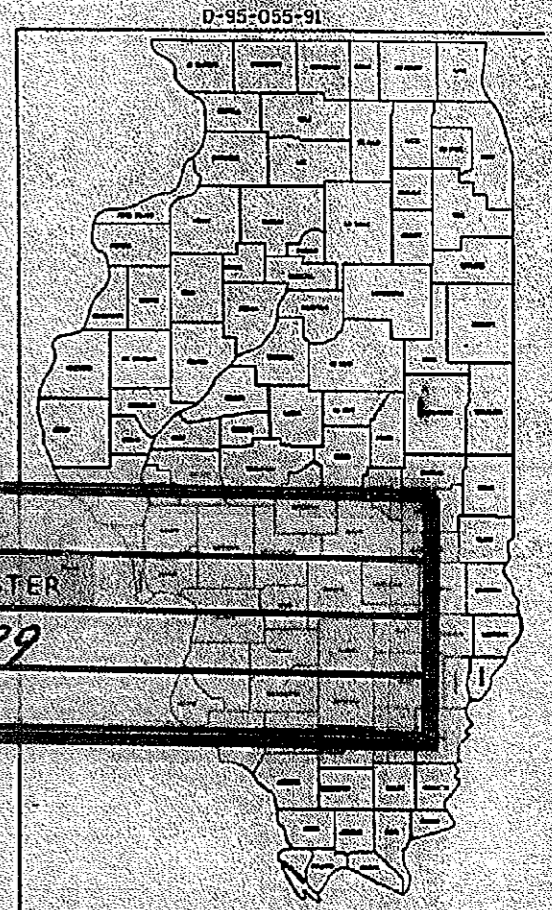

LOCATION OF SECTION INDICATED THUS: -

PROJECT IM-57-5(178)237  
 ENDS STA. 5+045.000

SECTION (10-34HB)BR INCLUDES THE CONSTRUCTION OF A FOUR (4) SPAN SLAB DECK ON EXISTING 36WF135 STEEL BEAMS AND PROPOSED W920 x 201 BEAMS (WIDENED STRUCTURE) 78.79 M BK. TO BK. OF ABUTMENTS, 0° SKEW, AND ALL COLLATERAL WORK IN CONJUNCTION WITH THEM, AT STA. 4+794.32 ON C. U.S. RTE. 150.

PROJECT IM-57-5(178)237  
 BEGINS STA. 4+602.48

STATE OF ILLINOIS DEPARTMENT OF TRANSPORTATION DIVISION OF HIGHWAYS	
SUBMITTED	9/18 1999
EXAMINED	19
PASSED	May 1, 1998
APPROVED	May 7, 1999

JOINT UTILITY LOCATING INFORMATION FOR EXCAVATIONS, U.U.L.I.E. PHONE: 800-892-0123

(HENSLY TOWNSHIPS)

REVISIONS		LIN ENGINEERING, LTD	
NAME	DATE	DESIGNED: R.P.	CHECKED: T.M.M.
B. BLAND	2-27-97	DRAWN: R.P.	DATE: 2/96

PROJECT ENGINEER: BRIAN TRYGG (217) 465-4181

DESIGNER: LIN ENGINEERING, LTD (217) 483-4168


CONTRACT NO. 90409

COUNTY: CHAMPAIGN SECTION: (10-34HB)BR ROUTE: U.S. 150




STATE NO.	DISTRICT	COUNTY	SHEET NO.	TOTAL SHEETS
F.A.I. 57	(10-34HB)BR	CHAMPAIGN	47	2
FED. ROAD DIST. NO. 1		SCALE: 1" = 10'-0"		

EXISTING TYPICAL CROSS SECTION F.A.I. RTE. 57

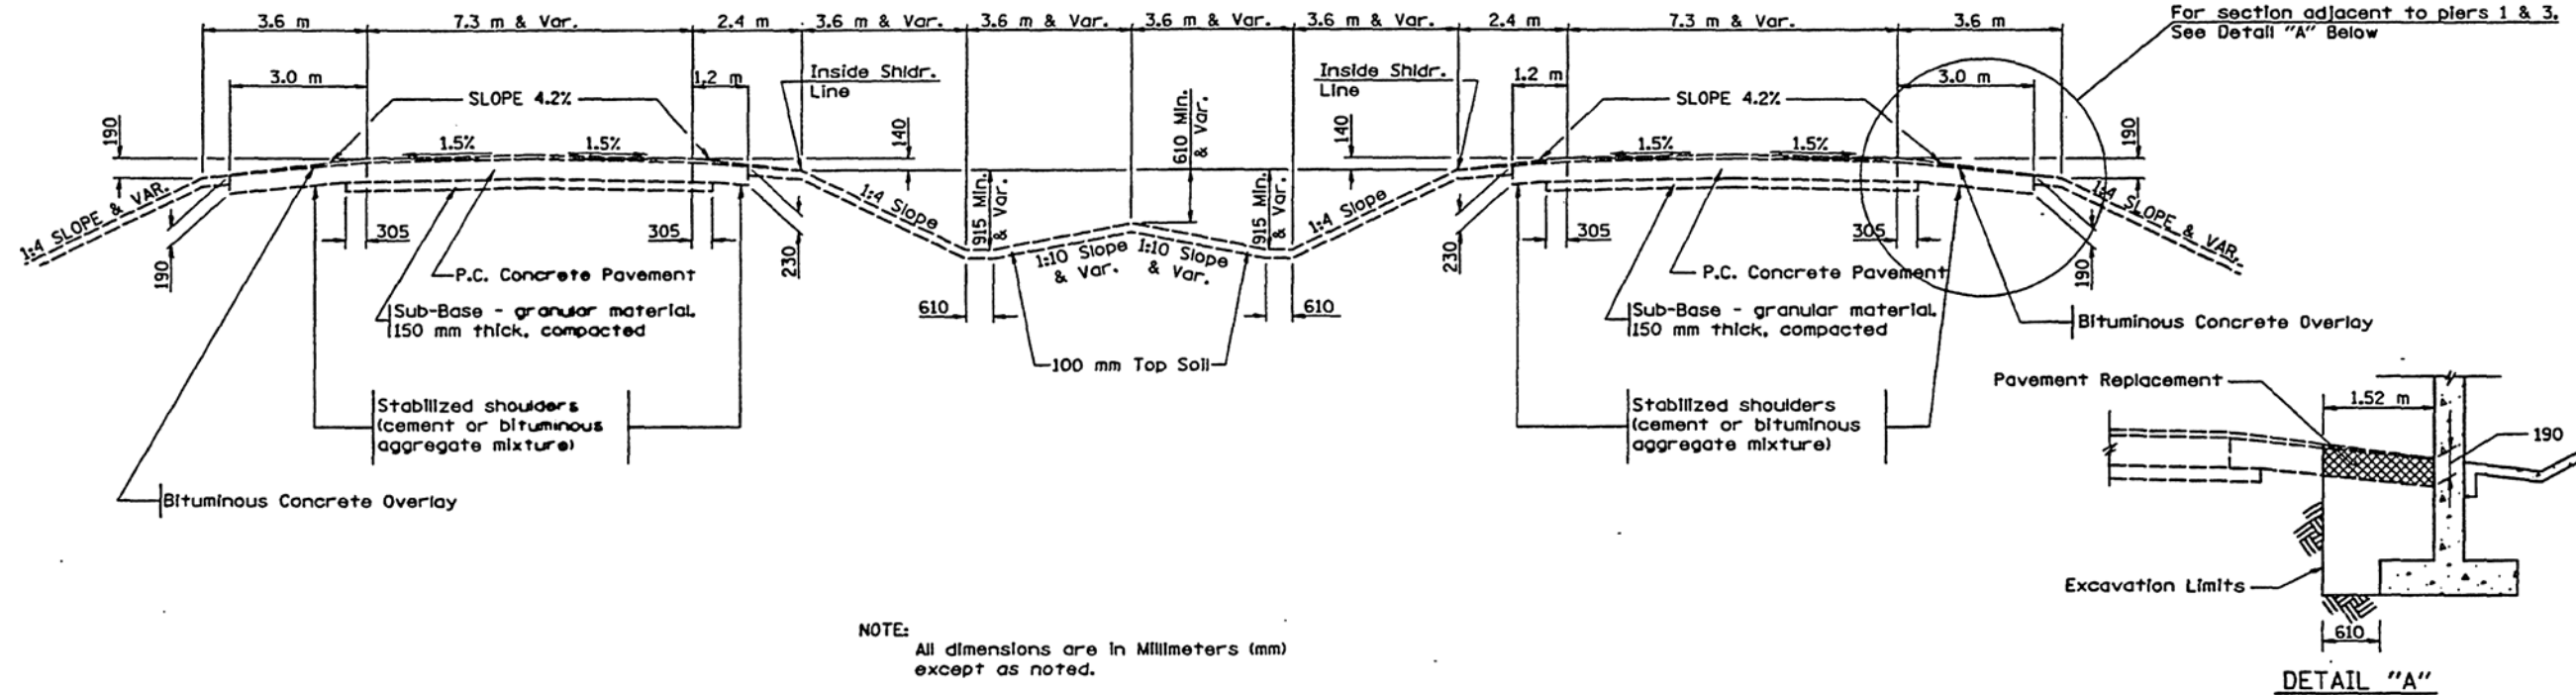

EXISTING TYPICAL ROADWAY CROSS SECTION U.S. RTE. 150

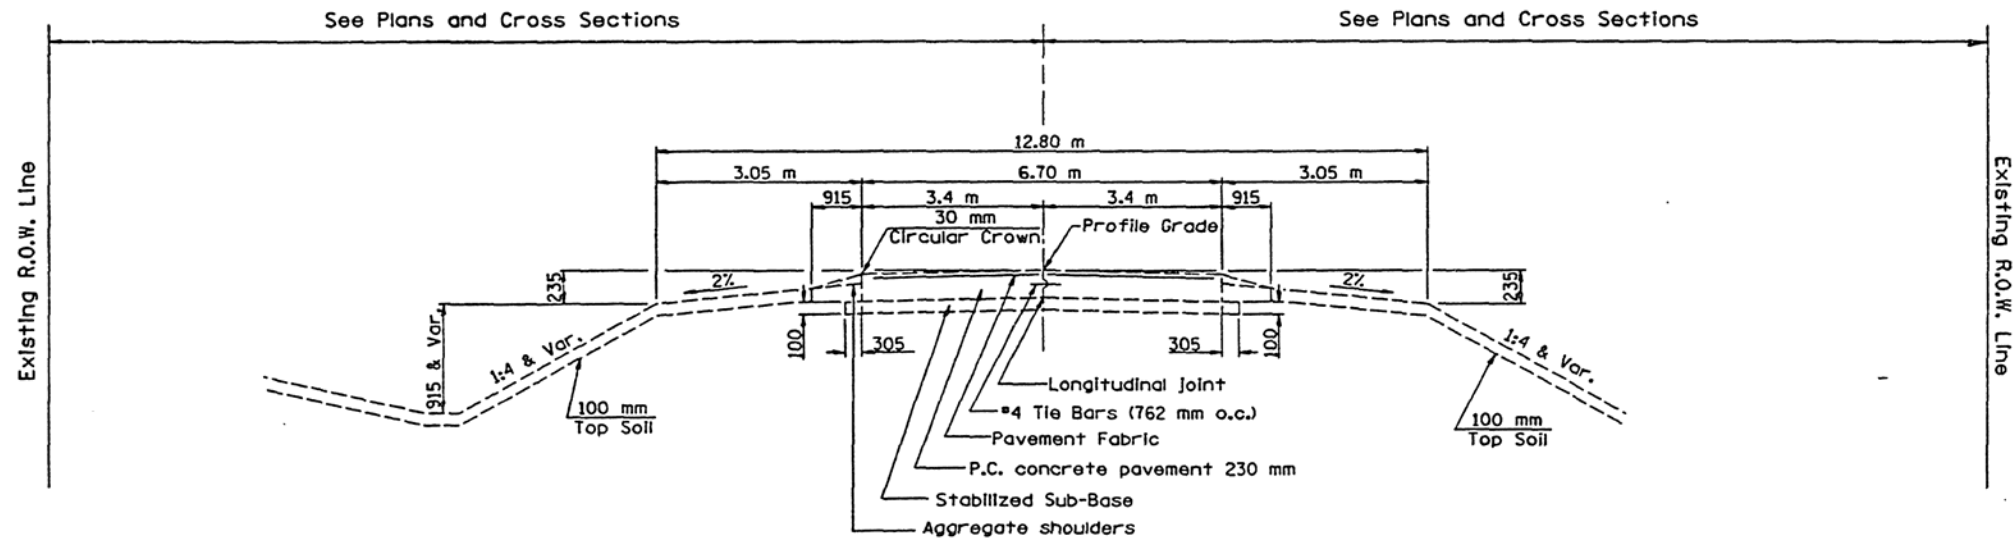

1997 ADT = 6,000  
2017 ADT = 10,000

STATE OF ILLINOIS  
DEPARTMENT OF TRANSPORTATION  
DISTRICT FIVE

REVIEWED BY: Dennis J. Marshall  
ENGINEER OF PROGRAM DEVELOPMENT  
DATE: 3/11/99  
EXAMINED BY: Jerry W. Carlock  
ENGINEER OF PROJECT IMPLEMENTATION  
Phillip A. Buehler  
ENGINEER OF OPERATIONS


TYPICAL SECTIONS

LIN ENGINEERING, LTD.

DESIGNED: R.P. CHECKED: T.J.M.  
DRAWN: R.P. DATE: 2/96


PROJECT NO.	SECTION	COUNT	SHEET	TOTAL
F.A.I. 57	(10-34HB)BR	CHAMPAIGN	47	3
F.A.I. 4000 DIST. NO. 7		ALPHAS	F.A.I. 400 PROJECT	

**PROPOSED SUPERELEVATED TYPICAL ROADWAY CROSS SECTION U.S. RTE. 150**  
 STA. 4+602.48 TO STA. 4+746.14

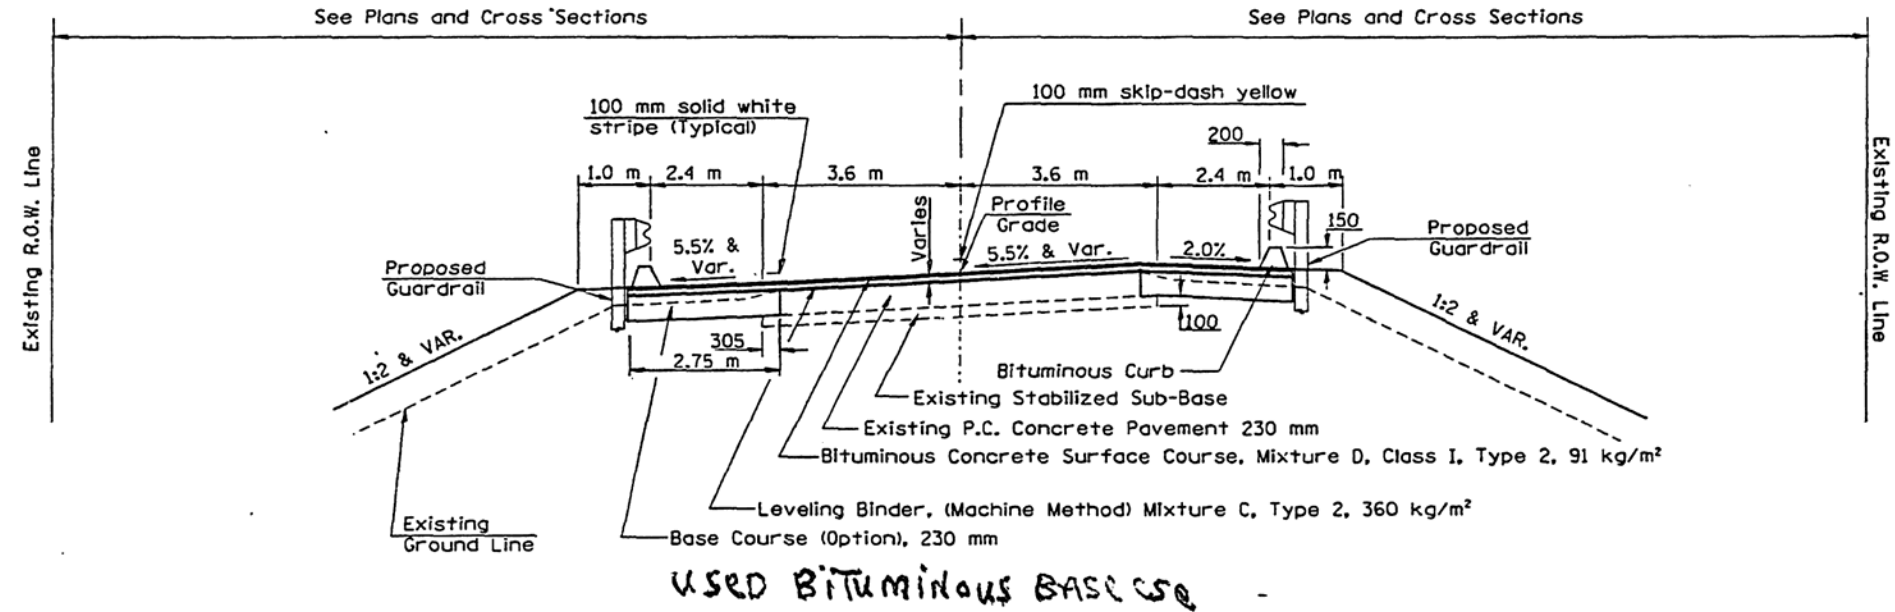

NOTE:  
 All dimensions are in Millimeters (mm)  
 except as noted.

**PROPOSED TYPICAL ROADWAY CROSS SECTION U.S. RTE. 150**  
 STA. 4+842.93 TO STA. 5+045.000

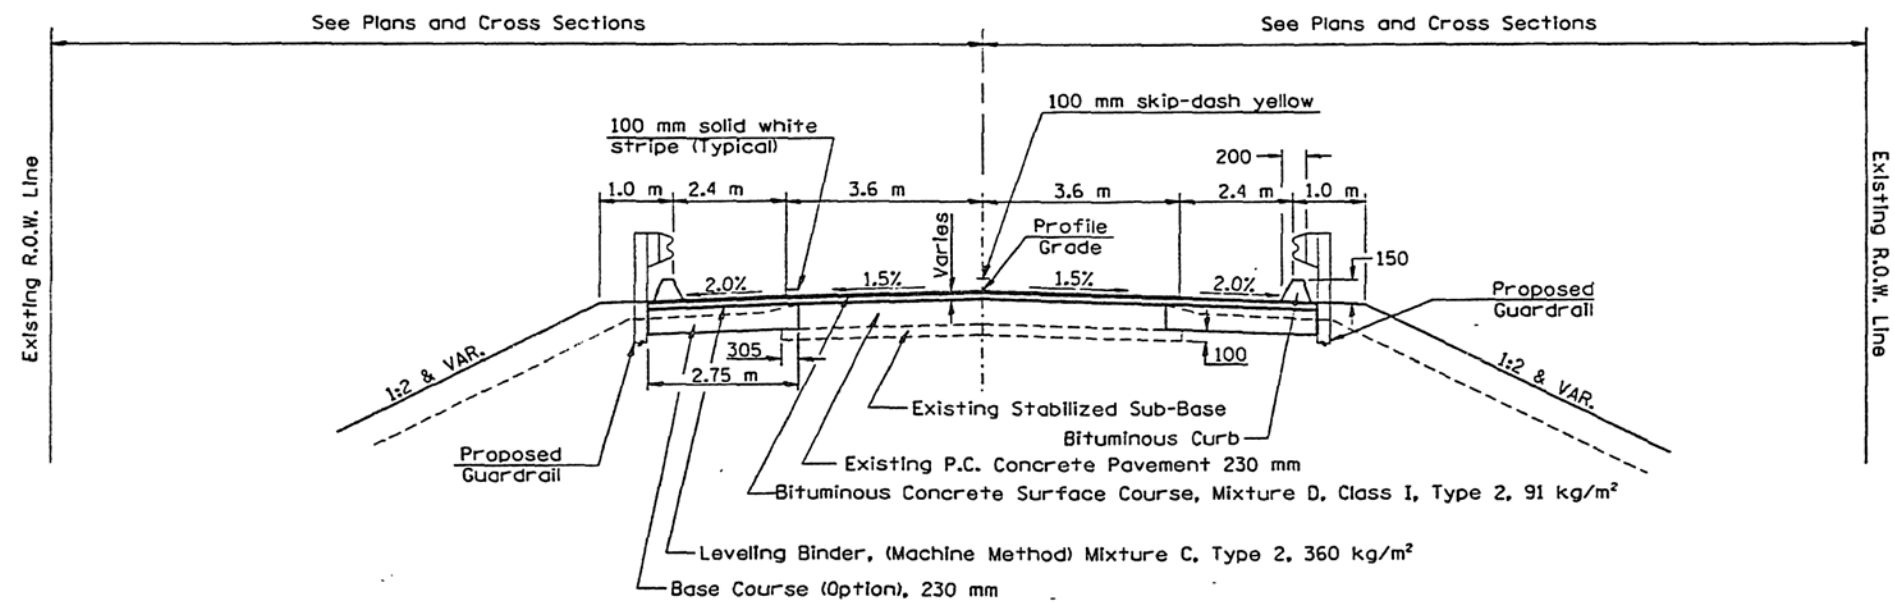

NOTE:  
 All dimensions are in Millimeters (mm)  
 except as noted.

TYPICAL SECTIONS

LIN ENGINEERING, LTD.

DESIGNED: R.P.      CHECKED: T.M.M.  
 DRAWN: R.P.        DATE: 2/96

# GENERAL NOTES

F.A.L. RTE.	SECTION	COUNTY	TOTAL SHEETS	SHEET NO.
57	00-348(B)R	CHAMPAIGN	47	4

## 1. G.N.-105.04

THE METRIC DIMENSIONS AND SPECIFICATIONS GIVEN HEREIN ARE INTENDED TO MEET METRIC DESIGN CRITERIA. HOWEVER, THE EXISTING FACILITIES WERE CONSTRUCTED USING ENGLISH DIMENSIONS. WHERE THE METRIC DIMENSIONS DIFFER FROM THE PHYSICAL DIMENSIONS OF EXISTING FEATURES TO REMAIN IN PLACE, THE EXISTING DIMENSIONS SHALL CONTROL. (FOR EXAMPLE, PAVEMENT WIDTH FOR RESURFACING.) THE EXISTING DIMENSIONS HAVE BEEN ACCOUNTED FOR IN THE PLAN QUANTITIES.

## 2. G.N.-105.07A

THE FOLLOWING IS A LIST OF UTILITY COMPANIES THAT HAVE UTILITIES LOCATED ALONG THIS SECTION. THE UTILITY OWNERS MARKED WITH AN 'A' BELONG TO J.U.L.I.E.

- ILLINOIS POWER COMPANY
- NORTHERN ILLINOIS WATER COMPANY
- AMERITECH
- MARATHON PIPELINE COMPANY
- URBANA - CHAMPAIGN SANITARY DISTRICT

## 3. G.N.-107.09

THE VERTICAL CLEARANCE SHALL NOT BE REDUCED WHEN PROTECTING TRAFFIC FROM FALLING OBJECTS AND/OR MATERIALS.

## 4. G.N.-205

BENCHING PROCEDURES SHALL BE USED IN AREAS WHERE EXISTING EMBANKMENTS ARE WIDENED FOR THE PROPOSED PAVEMENT. STEPS SHALL BE CUT INTO THE EXISTING EMBANKMENT SLOPES IN ACCORDANCE WITH THE DETAIL SHOWN ON SHEET NO. 13.

## 5. G.N.-250

SHOULDERS, DITCHES, FORE-SLOPES, BACK-SLOPES AND OTHER PORTIONS OF THE RIGHT-OF-WAY HAVING INSUFFICIENT VEGETATION SHALL BE SEEDDED AS LISTED ELSEWHERE IN THE PLANS. MEASUREMENT FOR PAYMENT SHALL NOT BE GREATER THAN THAT SHOWN IN THE PLANS.

## 6. G.N.-250A

THE FOLLOWING APPLICATION RATES HAVE BEEN USED TO CALCULATE THE VARIOUS ITEMS NECESSARY FOR SEEDING AND SODDING:

FERTILIZER NUTRIENTS CLASS 2 & 3 SEEDING  
NITROGEN 67 kg/ha (60 LBS. PER ACRE)  
PHOSPHOROUS 225 kg/ha (200 LBS. PER ACRE)  
POTASSIUM 67 kg/ha (60 LBS. PER ACRE)

## 7. G.N.-281

THE RIPRAP GRADATION SHALL BE IN ACCORDANCE WITH THE GRADATION SPECIFIED IN THE PLANS OR, WITH APPROVAL OF THE ENGINEER, A RIPRAP GRADATION MEETING A D50 GREATER THAN OR EQUAL TO 150 mm. D50 IS DEFINED AS THE MEAN ROCK SIZE AS DESCRIBED IN THE FHWA HYDRAULIC ENGINEERING CIRCULARS (HEC 11, HEC 14 AND HEC 15).

IF GRAVEL IS USED FOR THE BEDDING MATERIAL UNDER RIPRAP, THE GRAVEL SHALL BE CRUSHED AS ALLOWED UNDER ARTICLE 705.01.

## 8. G.N.-355 (SPECIAL)

BITUMINOUS BASE COURSE AND BITUMINOUS BASE COURSE WIDENING: - THE MATERIALS FOR THE BITUMINOUS CONCRETE MIXTURE SHALL BE BINDER MIXTURE A OR B, OF THE SAME 'TYPE' USED FOR RESURFACING ON THIS JOB, AND SHALL MEET THE REQUIREMENTS SPECIFIED IN ARTICLE 406.12 OF THE STANDARD SPECIFICATIONS. IT SHALL BE TRANSPORTED IN ACCORDANCE WITH ARTICLE 406.14 OF THE STANDARD SPECIFICATIONS.

## 9. G.N.-406

THE QUANTITIES INCLUDED IN THE PLANS FOR BITUMINOUS CONCRETE RESURFACING ARE INTENDED TO GIVE THE COVERAGE SHOWN ON THE TYPICAL CROSS SECTIONS. IT IS NOT INTENDED TO INCREASE THE THICKNESS OF THE BITUMINOUS MIXTURE IN ORDER TO USE ALL OF THE QUANTITIES INCLUDED IN THE CONTRACT. DESIGN THICKNESS CAN BE BACK CALCULATED USING THE CONVERSION FACTOR OF 1 mm THICKNESS = 2.39 KILOGRAMS PER SQUARE METER.

## 10. G.N.-406A

THE TOTAL AREA TO BE RESURFACED IS 5360 SQUARE METERS OF WHICH 0 SQUARE METERS ARE VARIABLE WIDTH.

### ESTIMATED QUANTITIES:

1595.0 LITERS BITUMINOUS MATERIALS (PRIME COAT)  
1575.0 METRIC TONS LEVELING BINDER (MACHINE METHOD), MIXTURE C, TYPE 2  
435.5 METRIC TONS BITUMINOUS CONCRETE SURFACE COURSE, MIXTURE D, CLASS 1, TYPE 2

## 11. G.N.-406C

FOR ALL LIFTS OF BITUMINOUS CONCRETE, CLASS 1, WHICH ARE PLACED AT A RATE OF 75 METRIC TONS PER HOUR OR MORE, A PNEUMATIC TIRED ROLLER SHALL BE USED AS AN INTERMEDIATE ROLLER.

## 12. G.N.-406D

ALL LEVELING BINDER OR BINDER SHALL BE GIVEN A FOG COAT OF PRIME BEFORE THE SURFACE COURSE IS PLACED WHEN DIRECTED BY THE ENGINEER.

THE FOG COAT WILL BE PAID FOR AT THE CONTRACT UNIT PRICE PER LITER FOR BITUMINOUS MATERIAL (PRIME COAT) AND NO ADDITIONAL COMPENSATION WILL BE ALLOWED.

## 13. G.N.-406F

THIS JOB INCLUDES LEVELING BINDER OF 40 mm OR GREATER THICKNESS. LOCATIONS OF LEVELING BINDER EQUAL TO OR GREATER THAN 40 mm IN THICKNESS ARE AS FOLLOWS:

THE ENTIRE LENGTH OF THE PROJECT

THE ABOVE LIST MAY NOT BE ALL INCLUSIVE DUE TO CONSTRUCTION VARIATIONS, VARIATIONS BETWEEN PLOTTED CROSS-SECTIONS, OR OTHER REASONS. ALL APPLICABLE REQUIREMENTS OF SECTION 406 OF THE STANDARD SPECIFICATIONS WILL BE ENFORCED FOR ALL LEVELING BINDER CONSTRUCTED 40 mm OR THICKER.

## 14. G.N.-406 (SPECIAL)

THE TEMPORARY BITUMINOUS RAMPS SHOWN AT THE ENDS OF THE PROPOSED BRIDGE APPROACH PAVEMENTS SHALL BE CONSIDERED INCIDENTAL TO THE CONTRACT AND NO ADDITIONAL COMPENSATION SHALL BE ALLOWED.

## 15. G.N.-420.21

WHEN REQUIRED BY ARTICLE 420.21, A PROTECTIVE COAT SHALL BE APPLIED TO CONCRETE PAVEMENT, GUTTER FLAGS, CURB SURFACES AND OTHER CONCRETE APPURTENANCES ADJACENT TO THE PAVEMENT.

### ESTIMATED QUANTITIES:

BRIDGE APPROACH 222.5 SQ M  
BRIDGE SUPERSTRUCTURE 178.6 SQ M

## 16. G.N.-506

ALL FINAL SURFACES OF THE BEAMS SHALL BE PAINTED WITH LIGHT GREY (MUNSELL COLOR STANDARD - 10Y 7/1) EXCEPT THE EXTERIOR SURFACES OF THE EXTERIOR BEAMS WHICH SHALL BE PAINTED WITH INTERSTATE GREEN (MUNSELL COLOR STANDARD 7.5G 4/8).

## 17. G.N.-630

GUARD RAIL DESIGN IN THESE PLANS WERE BASED ON THE FOLLOWING INFORMATION:  
CLEAR ZONE WIDTH = 7 m (FROM EDGE OF PAVEMENT).  
OPERATING SPEED = 88 km/h (POSTED SPEED LIMIT).  
A.D.T. = 3600 (2018).

## 18. G.N.-631

IF THE CONTRACTOR ELECTS TO USE THE ALTERNATE MOUNTING METHOD OF THROUGH DRILLING THE MOUNTING HOLES FOR THE TRAFFIC BARRIER TERMINALS, TYPE 6, THE HOLES SHALL BE DRILLED USING A CORE DRILL. A HAMMER DRILL WILL NOT BE ALLOWED.

## 19. G.N.-703

THE FOLLOWING QUANTITIES ARE ALLOWED FOR PLACING STANDARD PAVEMENT MARKINGS IN ACCORDANCE WITH SECTION 703 ON THE MILLED SURFACE OR INTERMEDIATE LIFTS AND TO DELINEATE NON-PASSING ZONES DURING CONSTRUCTION. QUANTITIES FOR THE FINAL PAVEMENT MARKING ARE INCLUDED ELSEWHERE HEREIN.

### ESTIMATED QUANTITIES:

YELLOW: 89.0 METER TEMPORARY PAVEMENT MARKING - LINE 100 mm

WHITE: 885.0 METER TEMPORARY PAVEMENT MARKING - LINE 100 mm

### TOTALS:

974.0 METER TEMPORARY PAVEMENT MARKING - LINE 100 mm

## 20. G.N.-703A

SHORT TERM PAVEMENT MARKING SHALL BE APPLIED TO THE PAVEMENT AFTER ANY OF THE FOLLOWING: COLD MILLING AND/OR PLACING BITUMINOUS MATERIALS (PRIME COAT), LEVELING BINDER (MACHINE METHOD), BINDER AND SURFACE COURSES. SHORT TERM PAVEMENT MARKING PLACED ON THE SURFACE SHALL COINCIDE WITH THE FINAL PAVEMENT STRIPING. SHORT TERM PAVEMENT MARKING PLACED PRIOR TO THE SURFACE SHALL COINCIDE WITH THE EXISTING PAVEMENT MARKINGS. USE 1.2 m/12m (OR 10% PER STATION).  
ESTIMATED QUANTITY:  
399.0 METERS SHORT TERM PAVEMENT MARKING  
(133.0 METERS YELLOW AND 266.0 METERS WHITE)

## 21. G.N.-704

TEMPORARY CONCRETE BARRIER, STATE OWNED AND TEMPORARY CONCRETE BARRIER TERMINAL SECTION, STATE OWNED ARE LOCATED AT THE ILLINOIS DEPARTMENT OF TRANSPORTATION'S MAINTENANCE STORAGE AT RANTOUL, ILLINOIS WHICH IS LOCATED 1 MILE NORTH OF RANTOUL ON THE WEST SIDE OF U.S. 45. CONNECTING PINS, DOWEL BARS, STYROFOAM PADS, AND DRIFT PINS USED WITH THE BARRIERS AND TERMINAL SECTIONS SHALL BE FURNISHED BY THE CONTRACTOR.

THE COST OF NECESSARY CONNECTING PINS, DOWEL BARS AND STYROFOAM PADS SHALL BE INCLUDED IN THE CONTRACT UNIT PRICE PER METER FOR TEMPORARY CONCRETE BARRIER, STATE OWNED. THE COST OF NECESSARY STYROFOAM PADS AND DRIFT PINS SHALL BE INCLUDED IN THE COST EACH FOR TEMPORARY CONCRETE BARRIER TERMINAL SECTION, STATE OWNED.

## 22. G.N.-780.06

PAINT PAVEMENT MARKINGS SHALL BE APPLIED TO THE FINAL CONCRETE PAVEMENT SURFACE.

### ESTIMATED QUANTITIES:

YELLOW: 221.0 METER PAINT PAVEMENT MARKING - LINE 100 mm

WHITE: 885.0 METER PAINT PAVEMENT MARKING - LINE 100 mm

### TOTALS:

1106.0 METER PAINT PAVEMENT MARKING - LINE 100 mm

## 23. G.N.-1004.01

COARSE AGGREGATE GRADATION CA-10 MAY BE USED WHENEVER COARSE AGGREGATE CA-6 IS SPECIFIED IN THE STANDARD SPECIFICATIONS.

## 24. G.N.-1004.03

REVISE ARTICLE 1004.03 (c) NOTE 5/ OF THE STANDARD SPECIFICATIONS TO READ:

'5/ GRADATION CA-16 SHALL BE USED IN LIEU OF CA-13 WHEN THE SURFACE COURSE IS LESS THAN 45 mm IN THICKNESS. CA-13 OR CA-16 MAY BE USED WHEN THE SURFACE COURSE IS 45 mm OR MORE IN THICKNESS.'

## 25. G.N.-Z0038

A BRONZE TABLET OF THE TYPE SHOWN ON STANDARD 667101 SHALL BE PLACED ON THE PROPOSED STRUCTURE AS DIRECTED BY THE ENGINEER. THE BENCH MARK ELEVATION WILL BE ESTABLISHED AND MARKED BY THE STATE.

ESTIMATED QUANTITY:  
1.0 EACH PERMANENT BENCH MARK



FORCE ACCOUNTS AND ADDED ITEMS

Pay Item Key	Pay Item Description	Units	Awarded	Added	Deducted	Adjusted Quantity	Qty Posted	FINAL QUANTITY
FRC00300-Q01J01-019X7712A-A	LAYOUT ERROR	DOLLAR	0.000	3,000.000	0.000	3,000.000	3,596.990	3596.99
FRC00600-Q01J01-019X7712A-A	UNDERCUT UNSTABLE MAT	DOLLAR	0.000	1,844.630	0.000	1,844.630	1,844.630	1844.63
FRC00601-Q01J01-019X7712A-A	PAV.T. MAINTENANCE	DOLLAR	0.000	419.720	0.000	419.720	419.720	419.72
FRC00602-Q01J01-019X7712A-A	PICK UP TERM. SECTION DA	DOLLAR	0.000	231.960	0.000	231.960	231.960	231.96
FRC00603-Q01J01-019X7712A-A	SET-UP & REMOVE TRAF. C	DOLLAR	0.000	443.830	0.000	443.830	443.830	443.83
FRC00604-Q01J01-019X7712A-A	ADD BLACK TAPE OVER CO	DOLLAR	0.000	5,644.720	0.000	5,644.720	5,644.720	5644.72
FRC00605-Q01J01-019X7712A-A	ADD RT. SHLDR. CLOSED SI	DOLLAR	0.000	1,568.360	0.000	1,568.360	1,568.360	1568.36
FRC00800-Q01J01-019X7712A-A	REMOBILIZE TRAF.CONT.I-5	DOLLAR	0.000	2,500.000	0.000	2,500.000	2,494.200	2494.20
FRC00801-Q01J01-019X7712A-A	USE WETTED BURLAP	DOLLAR	0.000	3,000.000	0.000	3,000.000	3,478.830	3478.83
FRC00802-Q01J01-019X7712A-A	CORRECT DESIGN ERROR	DOLLAR	0.000	300.000	0.000	300.000	0.000	220.94
FRC00803-Q01J01-019X7712A-A	RELOCATE LIGHT CABLE	DOLLAR	0.000	2,500.000	0.000	2,500.000	1,560.250	1560.25
FRC01000-Q01J01-019X7712A-A	ADD SHLDR STONE	DOLLAR	0.000	0.000	0.000	0.000	0.000	1172.75
70103815	TR CONT. SURVEILLANCE							1.98
78109100	RAISED REF. PVT. MKR							18.00
78201090	TERM. MKR. DIRECT APPLIED							1.00
78309200	RAISED REF. PVT. MKR REM							146.50
M2010110	TREE REMOVAL 6-15							32.50
M2010210	TREE REMOVAL OVER 15							2.00
X9500700	NIGHT WORK STR STEEL							0.00
X9501000	CONC. CURB DOWELED							6058.81
XXX03200	ANTISTRIP ADDITIVE							0.00
XXX16000	TRAFFIC CONTROL DEFICIENCY							0.00
Z0077800	WOOD POSTS							1555.21
FRC01200	INSTALL WOOD BLOCKOUT							3168.96
FRC01300	EROSION CONTROL							

GENERAL NOTES

FINAL QUANTITY

# SUMMARY OF QUANTITIES

F.A.I. RTE.	SECTION	COUNTY	TOTAL SHEETS	SHEET NO.
57	110-34MBR	CHAMPAIGN	47	5

LOCATION OF WORK:

2 LANE  
URBAN  
U.S. 150 OVER  
F.A.I. 57  
90% FEDERAL  
10% STATE  
STATION 4+602.48  
TO  
STATION 5+045

CONSTRUCTION TYPE CODE:

CODE NO	ITEM
50104800	REMOVAL OF EXISTING CONCRETE DECK
50300100	FLOOR DRAINS
50300310	ELASTOMERIC BEARING ASSEMBLY, TYPE I
50300320	ELASTOMERIC BEARING ASSEMBLY, TYPE II
50500505	STUD SHEAR CONNECTORS
50500715	JACK AND REMOVE EXISTING BEARINGS
50600300	CLEANING AND PAINTING STEEL BRIDGE
50606200	BLASTING RESIDUE CONTAINMENT AND DISPOSAL
50606300	POWER TOOL CLEANING RESIDUE CONTAINMENT AND DISPOSAL
51204200	TEST PILE CONCRETE
51500100	NAME PLATES
60900515	CONCRETE THRUST BLOCKS
61000115	TYPE E INLET BOX, STANDARD 610001
63100045	TRAFFIC BARRIER TERMINAL, TYPE 2
63100085	TRAFFIC BARRIER TERMINAL, TYPE 6
63100165	TRAFFIC BARRIER TERMINAL, TYPE 1 (SPECIAL)
67000400	ENGINEER'S FIELD OFFICE, TYPE A
67100100	MOBILIZATION
70100405	TRAFFIC CONTROL AND PROTECTION, STANDARD 701321
70100450	TRAFFIC CONTROL AND PROTECTION, STANDARD 701201
70100700	TRAFFIC CONTROL AND PROTECTION, STANDARD 701406
70101220	TRAFFIC CONTROL AND PROTECTION, STANDARD 701411 (SPECIAL)
70400700	TEMPORARY CONCRETE BARRIER, TERMINAL SECTION (STATE OWNED)
70500625	TEMPORARY TRAFFIC BARRIER TERMINAL, TYPE 2
78200405	GUARDRAIL MARKERS
78200500	BARRIER WALL MARKERS
M2020010	EARTH EXCAVATION
M2050150	EMBANKMENT
M2500200	SEEDING, CLASS 2
M2500300	SEEDING, CLASS 3
M2500350	SEEDING, CLASS 7
M2500400	NITROGEN FERTILIZER NUTRIENT
M2500500	PHOSPHORUS FERTILIZER NUTRIENT
M2500600	POTASSIUM FERTILIZER NUTRIENT
M2500700	AGRICULTURAL GROUND LIMESTONE
M2510115	MULCH, METHOD 2
M2800900	FENCE (EROSION CONTROL)
M2810105	STONE RIPRAP, CLASS A3
M2820100	FILTER FABRIC FOR USE WITH RIPRAP
M4060100	BITUMINOUS MATERIALS (PRIME COAT)
M4060300	AGGREGATE (PRIME COAT)
M4060560	LEVELING BINDER (MACHINE METHOD), MIXTURE B, TYPE 2
M4060850	BITUMINOUS CONCRETE SURFACE COURSE, MIXTURE D, CLASS I, TYPE 2
M4205000	BRIDGE APPROACH PAVEMENT
M4205200	PROTECTIVE COAT

UNIT	TOTAL QUANTITY	X771/2A TOTAL QUANTITY	FINAL QTY
L SUM	1.0	1.0	1.0
EACH	8.0	8.0	6.0
EACH	16.0	16.0	16.0
EACH	16.0	16.0	16.0
EACH	4856.0	4856.0	4860.0
EACH	30.0	30.0	30.0
L SUM	1.0	1.0	1.0
L SUM	1.0	1.0	1.0
L SUM	1.0	1.0	1.0
EACH	1.0	1.0	1.0
EACH	2.0	2.0	2.0
EACH	10.0	10.0	10.0
EACH	10.0	10.0	10.0
EACH	2.0	2.0	2.0
EACH	4.0	4.0	4.0
EACH	1.0	1.0	1.0
CAL MO	12.0	12.0	12.0
L SUM	1.0	1.0	1.0
EACH	1.0	1.0	1.0
L SUM	1.0	1.0	1.0
L SUM	1.0	1.0	1.0
EACH	2.0	2.0	2.0
EACH	2.0	2.0	2.0
EACH	2.0	2.0	2.0
EACH	40.0	40.0	43.0
EACH	8.0	8.0	8.0
CU M	302.0	302.0	450.1
CU M	3960.0	3960.0	3672.42
HA	0.1	0.1	0.20
HA	0.7	0.7	1.10
HA	0.8	0.8	0.60
KG	51.0	51.0	89.7
KG	171.0	171.0	142.8
KG	51.0	51.0	89.7
M TON	3.4	3.4	0.10
HA	0.8	0.8	1.90
METER	692.0	692.0	824.0
SQ M	14.0	14.0	14.0
SQ M	14.0	14.0	14.0
LITER	1595.0	1595.0	1674.75
M TON	12.0	12.0	9.53
M TON	1575.0	1575.0	1203.07
M TON	436.0	436.0	732.13
SQ M	223.0	223.0	223.00
SQ M	223.0	223.0	0.00



# SUMMARY OF QUANTITIES (Cont'd)

LOCATION OF WORK:

2 LANE URBAN  
U. S. 150 OVER  
F. A. I. 57  
90% FEDERAL  
10% STATE  
STATION 4+602.48  
TO 4+602.48  
STATION 5+045  
STATION 5+045  
X 771/2A

CONSTRUCTION TYPE CODE:

CODE NO	ITEM
M4206200	BRIDGE APPROACH PAVEMENT CONNECTOR (FLEXIBLE)
M4402000	PAVEMENT REMOVAL
M4402060	APPROACH SLAB REMOVAL
M4410100	PAVEMENT REPLACEMENT
M5010240	CONCRETE REMOVAL
M5020100	STRUCTURE EXCAVATION
M5030350	CONCRETE STRUCTURES
M5030360	CONCRETE SUPER STRUCTURES
M5030390	BRIDGE DECK GROOVING
M5030450	PROTECTIVE COAT
M5050105	FURNISHING AND ERECTING STRUCTURAL STEEL
M5050410	STRUCTURAL STEEL REMOVAL
M5080205	REINFORCEMENT BARS, EPOXY COATED
M5110100	SLOPE WALL 100 MM
M5120300	FURNISHING CONCRETE PILES
M5120305	DRIVING CONCRETE PILES
M5120900	TEMPORARY SHEET PILING
M542F012	METAL END SECTIONS 300MM
M5870020	BRIDGE SEAT SEALER
M6010125	PIPE DRAINS 300MM
M6100010	PORTLAND CEMENT CONCRETE SHOULDERS
M6300100	STEEL PLATE BEAM GUARD RAIL, TYPE A
M6300110	STEEL PLATE BEAM GUARD RAIL, TYPE B
M6300120	STEEL PLATE BEAM GUARD RAIL, TYPE C
M6320030	GUARD RAIL REMOVAL
M6610300	BITUMINOUS SHOULDER CURB
M7030100	SHORT-TERM PAVEMENT MARKING
M7030200	TEMPORARY PAVEMENT MARKING
M7031000	WORK ZONE PAVEMENT MARKING REMOVAL
M7040300	RELOCATE TEMPORARY CONCRETE BARRIER (STATE OWNED)
M7040400	TEMPORARY CONCRETE BARRIER (STATE OWNED)
M7050100	TEMPORARY STEEL PLATE BEAM GUARD RAIL, TYPE A
M7800205	PAINT PAVEMENT MARKING - LINE 100MM
MX032081	BONDED PREFORMED JOINT SEAL 102 MM
MX406900	OCCA BITUMINOUS
MX420900	OCCA CONCRETE
MZ002000	ATTENUATOR BASE
MZ002900	BASE COURSE (OPTION)
MZ047300	PROTECTIVE SHIELD
X7050165	TEMPORARY TRAFFIC BARRIER TERMINAL, TYPE 1 (SPECIAL)
Z0002600	BAR SPLICERS
Z0017900	DRAINAGE SCUPPERS
Z0030200	INERTIAL BARRIER INSTALLATION
Z0038700	PERMANENT BENCH MARKS
Z0070100	SURVEY MONUMENT COVER ASSEMBLY

UNIT	TOTAL QUANTITY	TOTAL QUANTITY	FINAL QTY
SO M	99.0	99.0	98.18
SO M	202.0	202.0	158.74
SQ M	80.0	80.0	80.0
SQ M	44.0	44.0	42.67
CU M	20.7	20.7	21.43
CU M	210.0	210.0	269.507
CU M	177.4	177.4	178.797
CU M	252.5	252.5	252.50
SO M	936.0	936.0	1152.40
SO M	1115.0	1115.0	0.00
L SUM	1.0	1.0	1.0
KG	450.0	450.0	450.0
KG	47580.0	47580.0	47580.0
SO M	135.0	135.0	163.40
METER	73.0	73.0	85.344
METER	73.0	73.0	47.884
SQ M	16.5	16.5	12.703
EACH	10.0	10.0	10.0
SO M	14.0	14.0	17.13
METER	151.0	151.0	166.20
SO M	108.0	108.0	59.46
METER	823.4	823.4	823.60
METER	7.6	7.6	13.60
METER	22.9	22.9	25.80
METER	942.0	942.0	954.00
METER	692.0	692.0	689.70
METER	399.0	399.0	229.20
METER	974.0	974.0	736.0.00
METER	230.0	230.0	230.00
METER	235.0	235.0	232.63
METER	884.3	884.3	926.90
METER	1106.0	1106.0	1920.00
METER	25.6	25.6	26.0
M TON	2011.0	2011.0	3338.42
CU M	1031.4	1031.4	560.446
SQ M	25.2	25.2	25.20
SQ M	1935.0	1935.0	1957.00
SQ M	714.0	714.0	514.776
EACH	3.0	3.0	1.0
EACH	750.0	750.0	730.0
EACH	2.0	2.0	2.0
EACH	1.0	1.0	1.0
EACH	1.0	1.0	1.0
EACH	1.0	1.0	1.0

REVISED  
PLAN SHEETS

SEEDING SCHEDULE

OPERATION AND LOCATION	SEEDING CLASS 2	SEEDING CLASS 3	FERTILIZER NUTRIENTS			AGRICULTURAL GROUND LIMESTONE 4.5 M TON/Ha	MULCH, METHOD 2
			NITROGEN	PHOSPHOROUS	POTASSIUM		
US 150 FINAL STAGE CONSTRUCTION	Ha	Ha	Kg	Kg	Kg	M TON	Ha
STA 4+602.48 TO STA 4+755	0.17	0.03	13.4	45	13.4	0.90	0.20
STA 4+834 TO STA 5+045	0.52	0.04	37.5	126	37.5	2.52	0.52
<b>TOTAL</b>	<b>0.69</b>	<b>0.07</b>	<b>50.9</b>	<b>171</b>	<b>50.9</b>	<b>3.42</b>	<b>0.72</b>

RIPRAP SCHEDULE

OPERATION AND LOCATION	STONE RIPRAP CLASS A3 Sq. M	FILTER FABRIC FOR USE W/RIPRAP Sq. M
US 150 STAGE II CONSTRUCTION		
LT STA 4+650.00	1.4	1.4
RT STA 4+650.00	1.4	1.4
LT STA 4+682.99	1.4	1.4
RT STA 4+682.99	1.4	1.4
LT STA 4+883.73	1.4	1.4
RT STA 4+883.73	1.4	1.4
LT STA 4+959.93	1.4	1.4
RT STA 4+959.93	1.4	1.4
LT STA 5+036.13	1.4	1.4
RT STA 5+036.13	1.4	1.4
<b>TOTAL</b>	<b>14</b>	<b>14</b>

BITUMINOUS CURB

OPERATION AND LOCATION	QUANTITY M
US 150 FINAL STAGE	
LT. & RT. STA 4+602.48 TO STA 4+746.14	287.32
LT. & RT. STA 4+842.93 TO STA 5+045	404.14
<b>TOTAL</b>	<b>691.46</b>

INERTIAL BARRIER INSTALLATION

OPERATION AND LOCATION	QUANTITY EACH
FAI 57 PRELIMINARY STAGE	
LT. STA 17+759.55 TO STA 17+770.68	1
<b>TOTAL</b>	<b>1</b>

ATTENUATOR BASE

OPERATION AND LOCATION	QUANTITY Sq. M
FAI 57 PRELIMINARY STAGE	
LT. STA 17+759.55 TO STA 17+770.68	25.2
<b>TOTAL</b>	<b>25.2</b>

EARTHWORK SCHEDULE

OPERATION AND LOCATION	EARTH EXCAVATION Cu. M	EMBANKMENT Cu. M
US 150 PRELIM. & FINAL STAGE		
STA 4+602.48 TO STA 4+755	129.3	708.8
STA 4+834 TO STA 5+045	172.8	3248.9
<b>TOTAL</b>	<b>302.1</b>	<b>3957.7</b>

PAVEMENT REPLACEMENT SCHEDULE

LOCATION	WIDTH (m)	LENGTH (m)	AREA (m)
PIER 1	1.52	14.5	22.04
PIER 3	1.52	14.5	22.04
<b>TOTAL</b>			<b>44.08</b>

PAVEMENT REMOVAL

OPERATION & LOCATION (PRIOR TO PLACING P.C. CONCRETE SHOULDERS)	QUANTITY SQ M
U.S. 150 STAGE II CONSTRUCTION	
LT STA 4+650.00	10.8
RT STA 4+650.00	10.8
LT STA 4+682.99	10.8
RT STA 4+682.99	10.8
LT STA 4+883.73	10.8
RT STA 4+883.73	10.8
LT STA 4+959.93	10.8
RT STA 4+959.93	10.8
LT STA 5+036.13	10.8
RT STA 5+036.13	10.8
<b>TOTAL</b>	<b>108.0 SQ M</b>

PORTLAND CEMENT CONCRETE SHOULDERS

OPERATION & LOCATION	QUANTITY SQ. M
US 150 STAGE II CONSTRUCTION	
LT STA 4+650.00	10.8
RT STA 4+650.00	10.8
LT STA 4+682.99	10.8
RT STA 4+682.99	10.8
LT STA 4+883.73	10.8
RT STA 4+883.73	10.8
LT STA 4+959.93	10.8
RT STA 4+959.93	10.8
LT STA 5+036.13	10.8
RT STA 5+036.13	10.8
<b>TOTAL</b>	<b>108.0</b>

FENCE (EROSION CONTROL)

OPERATION AND LOCATION	QUANTITY M
US 150 PRELIMINARY STAGE	
LT. & RT. STA 4+625 TO STA 4+755	260
LT. & RT. STA 4+834 TO STA 5+045	422
<b>TOTAL</b>	<b>682</b>

TERMINAL MARKER - DIRECT APPLIED

LOCATION	QUANTITY EACH
RT. STA. 4+585	1
RT. STA. 5+156	1
LT. STA. 5+080	1
<b>TOTAL</b>	<b>3</b>

GUARDRAIL MARKERS

LOCATION	QUANTITY EACH
RT. STA. 4+602.48 TO STA. 5+080	18
LT. STA. 4+585 TO STA. 5+156	22
<b>TOTAL</b>	<b>40</b>

BARRIER WALL MARKERS

LOCATION	QUANTITY EACH
RT. STA. 4+756 TO STA. 4+833	4
LT. STA. 4+756 TO STA. 4+833	4
<b>TOTAL</b>	<b>8</b>

OCQA BITUMINOUS:

ITEM  
LEVELING BINDER (MACHINE METHOD), MIX B, TYPE 2  
BITUMINOUS SURFACE COURSE, MIX D, CLASS I, TYPE 2

QUANTITY	UNIT	CONVERSION FACTOR	M. TONS
1575.0	MTON		1575.0
436.0	MTON		436.0

TOTAL = 2011.0 M. TONS

OCQA CONCRETE:

ITEM  
CONCRETE STRUCTURES  
CONCRETE SUPERSTRUCTURES  
APPROACH PAVEMENT FLEXIBLE CONNECTOR  
BRIDGE APPROACH PAVEMENT  
BASE COURSE OPTION, 230mm  
P.C.C. SHOULDERS, 230mm  
SLOPEWALL, 100mm  
PAVEMENT REPLACEMENT

QUANTITY	UNIT	CONVERSION FACTOR	CU M
177.4	CU. M		177.4
252.5	CU. M		252.5
98.9	SQ. M	.250M	24.7
222.5	SQ. M	.385M	85.7
1934.5	SQ. M	.230M	444.9
108.0	SQ. M	.230M	24.8
135.1	SQ. M	.100M	13.5
44.1	SQ. M	.178M	7.9

TOTAL = 1031.4 CU M

**SCHEDULE OF QUANTITIES**


**LIN ENGINEERING, LTD.**  
DESIGNED: R.P. CHECKED: T.M.M.  
DRAWN: R.P. DATE: 2/96




# TIE POINTS

F.A.I. RTE.	SECTION	COUNTY	TOTAL SHEETS	SHEET NO.
57	(10-34)B1B	CHAMPAIGN	47	6A


**PT STA 4+293.535**

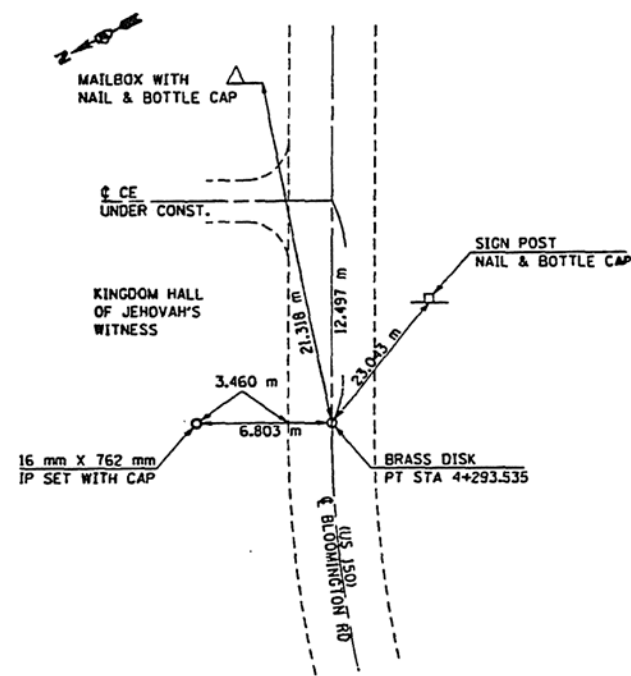


**PC STA 4+394.802**

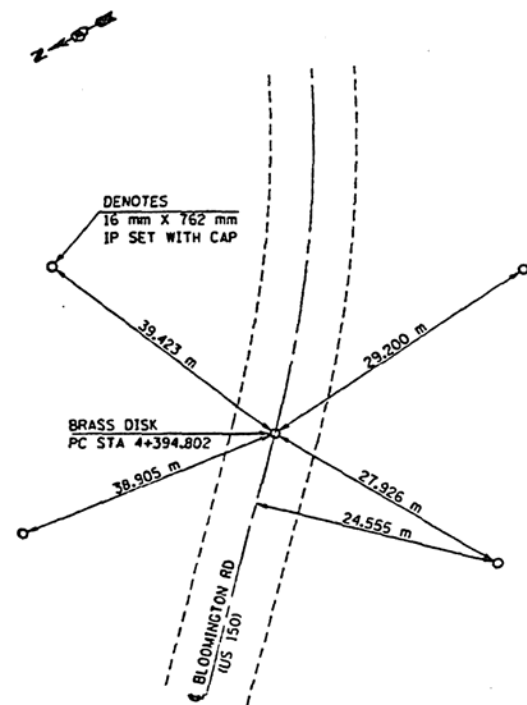


**STA 4+555.693**

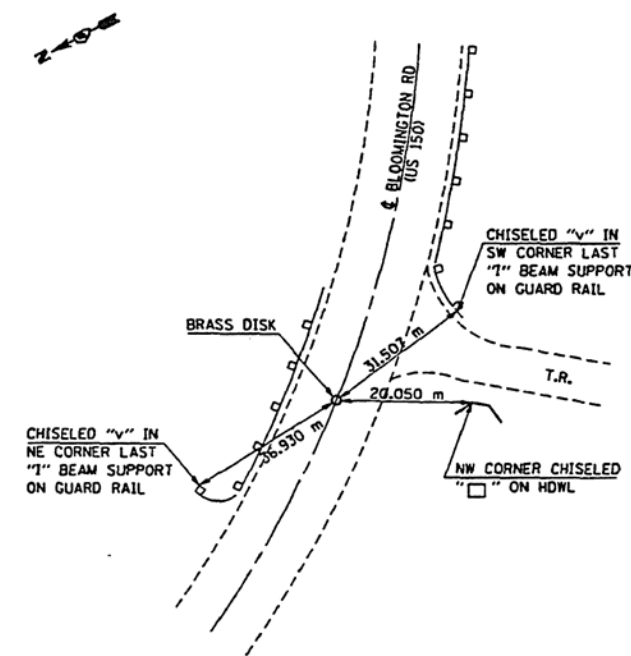


**PT STA 4+717.34**

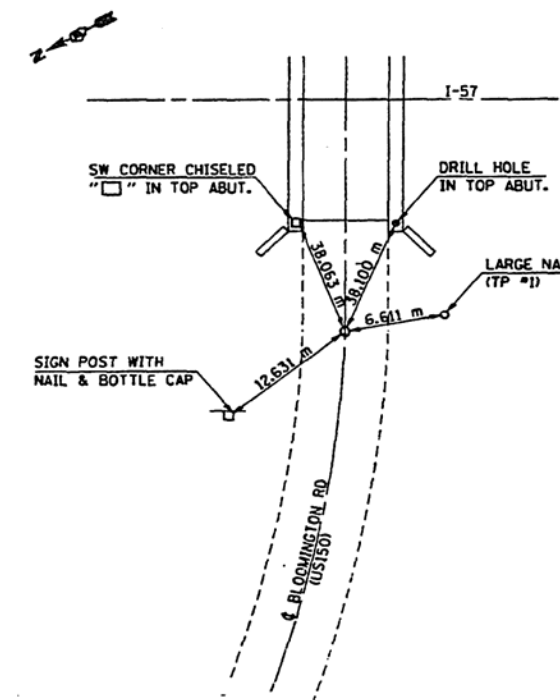


**POT STA 4+948.684**

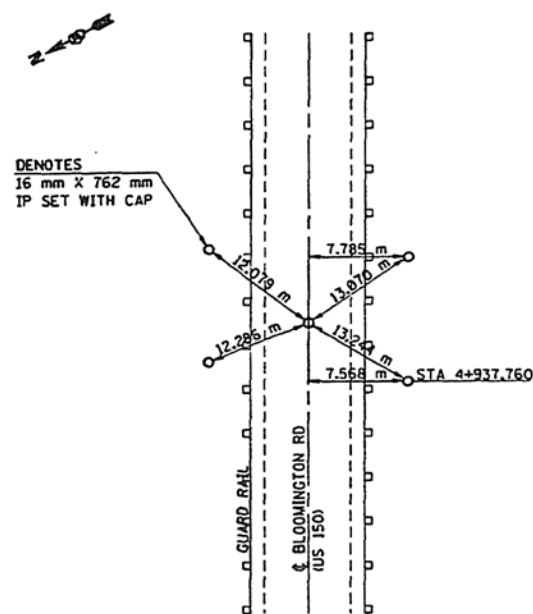

**POT STA 5+090.16**

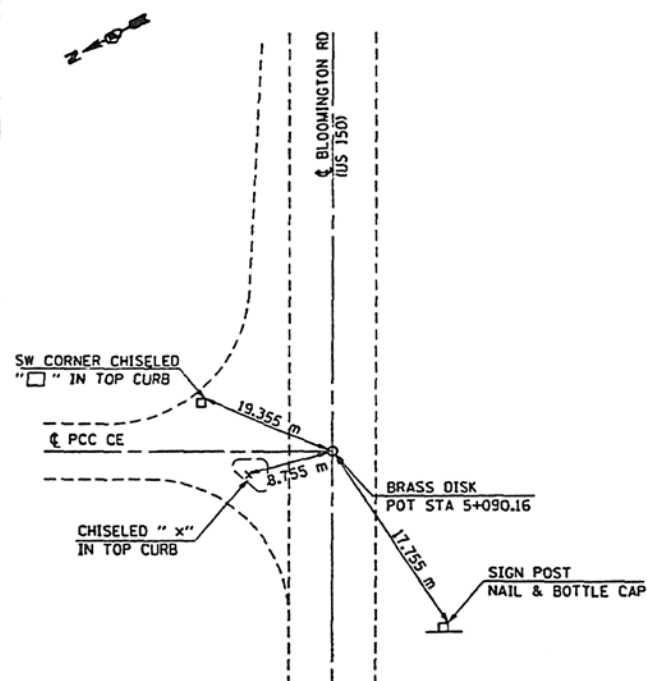

**POT STA 5+177.851**

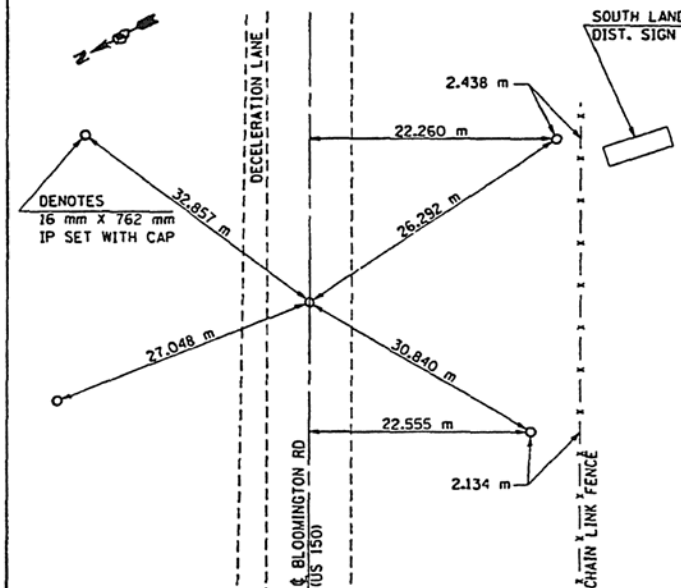



B.M. - CHISELED SQUARE ON TOP OF ABUTMENT  
N.E. CORNER OF BRIDGE 4.27 m LT. OF  
STA. 4+833.52, ELEV.=241.411

**EXISTING CURVE DATA**

P.I. STA. = 4+561.12  
 $\Delta = 35^\circ 20' 00''$   
 R = 523.91 m  
 T = 166.87 m  
 L = 323.09 m  
 E = 25.93 m  
 P.C. STA. = 4+394.26  
 P.T. STA. = 4+717.34  
 S.E. = 5.5%  
 S.E. RUNOFF LENGTH = 50 m  
 STA. 4+700.67 TO STA. 4+750.67

QUANTITIES OUTSIDE THE LIMITS OF THE PROJECT ARE INCLUDED HEREIN.


SURVEY MONUMENT  
COVER ASSEMBLY = 1 EACH  
SEE CONSTRUCTION DETAILS  
SHEET 13.

PROJECT NO.	DATE	BY	CHKD	APP'D
F.A.I. 57	(10-34)BIBR	CHAMPAIGN	47	7

**LEGEND**


- RIPRAP
- TYPE E, INLET BOX
- FENCE (EROSION CONTROL)
- STEEL PLATE BEAM GUARDRAIL, TYPE A

SHOULDER SLOPE @ 1:15 MAXIMUM  
OR AS DIRECTED BY THE ENGINEER.

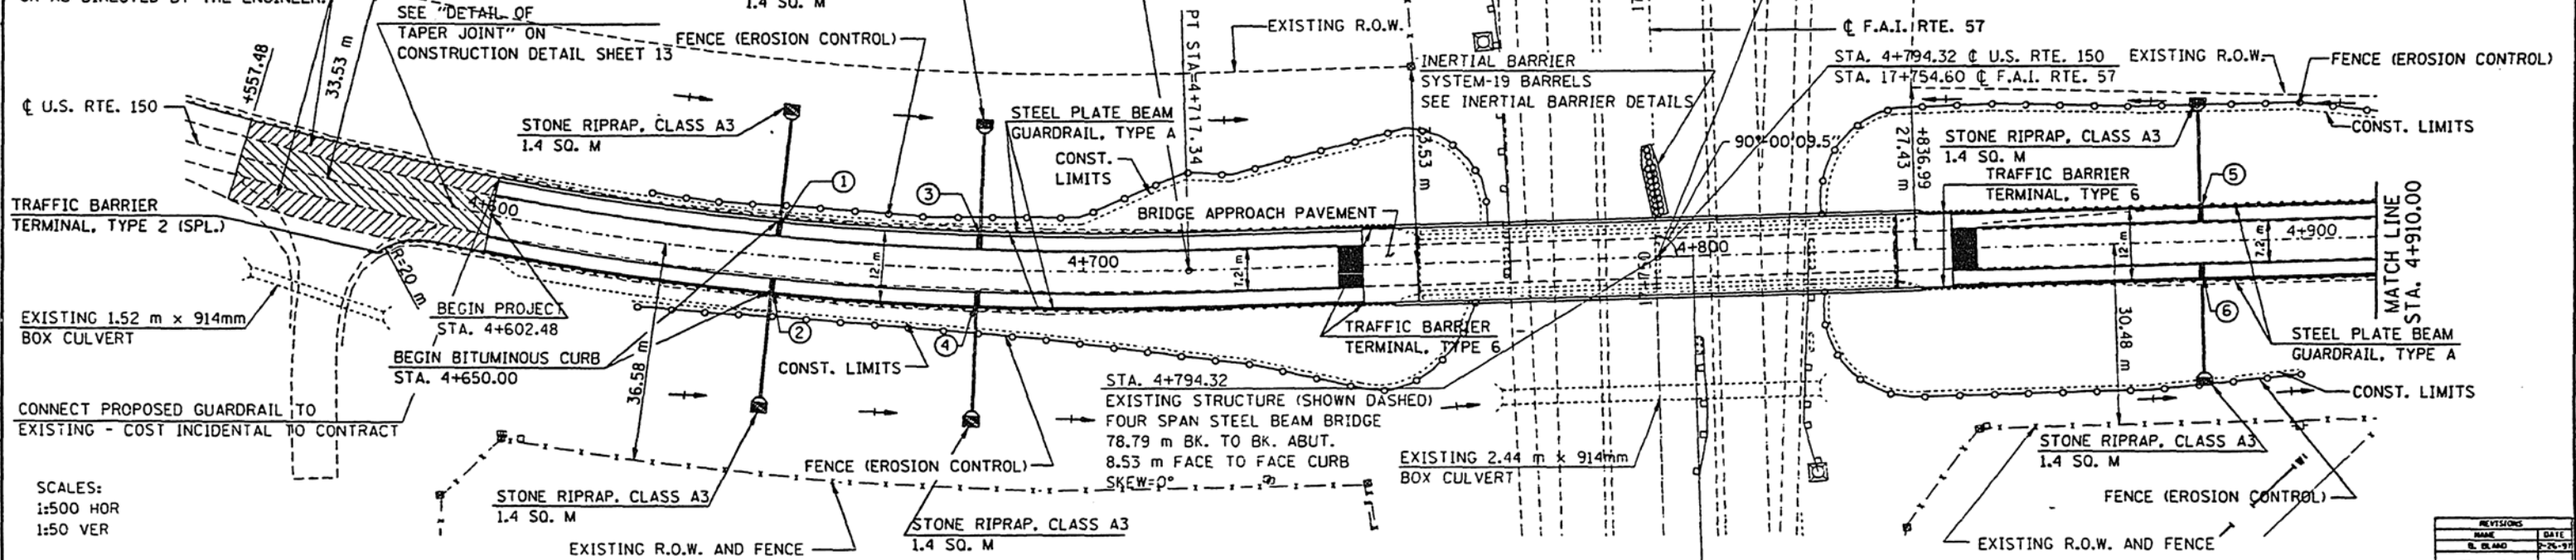


SCALES:  
1:500 HOR  
1:50 VER

REVISIONS	NAME	DATE

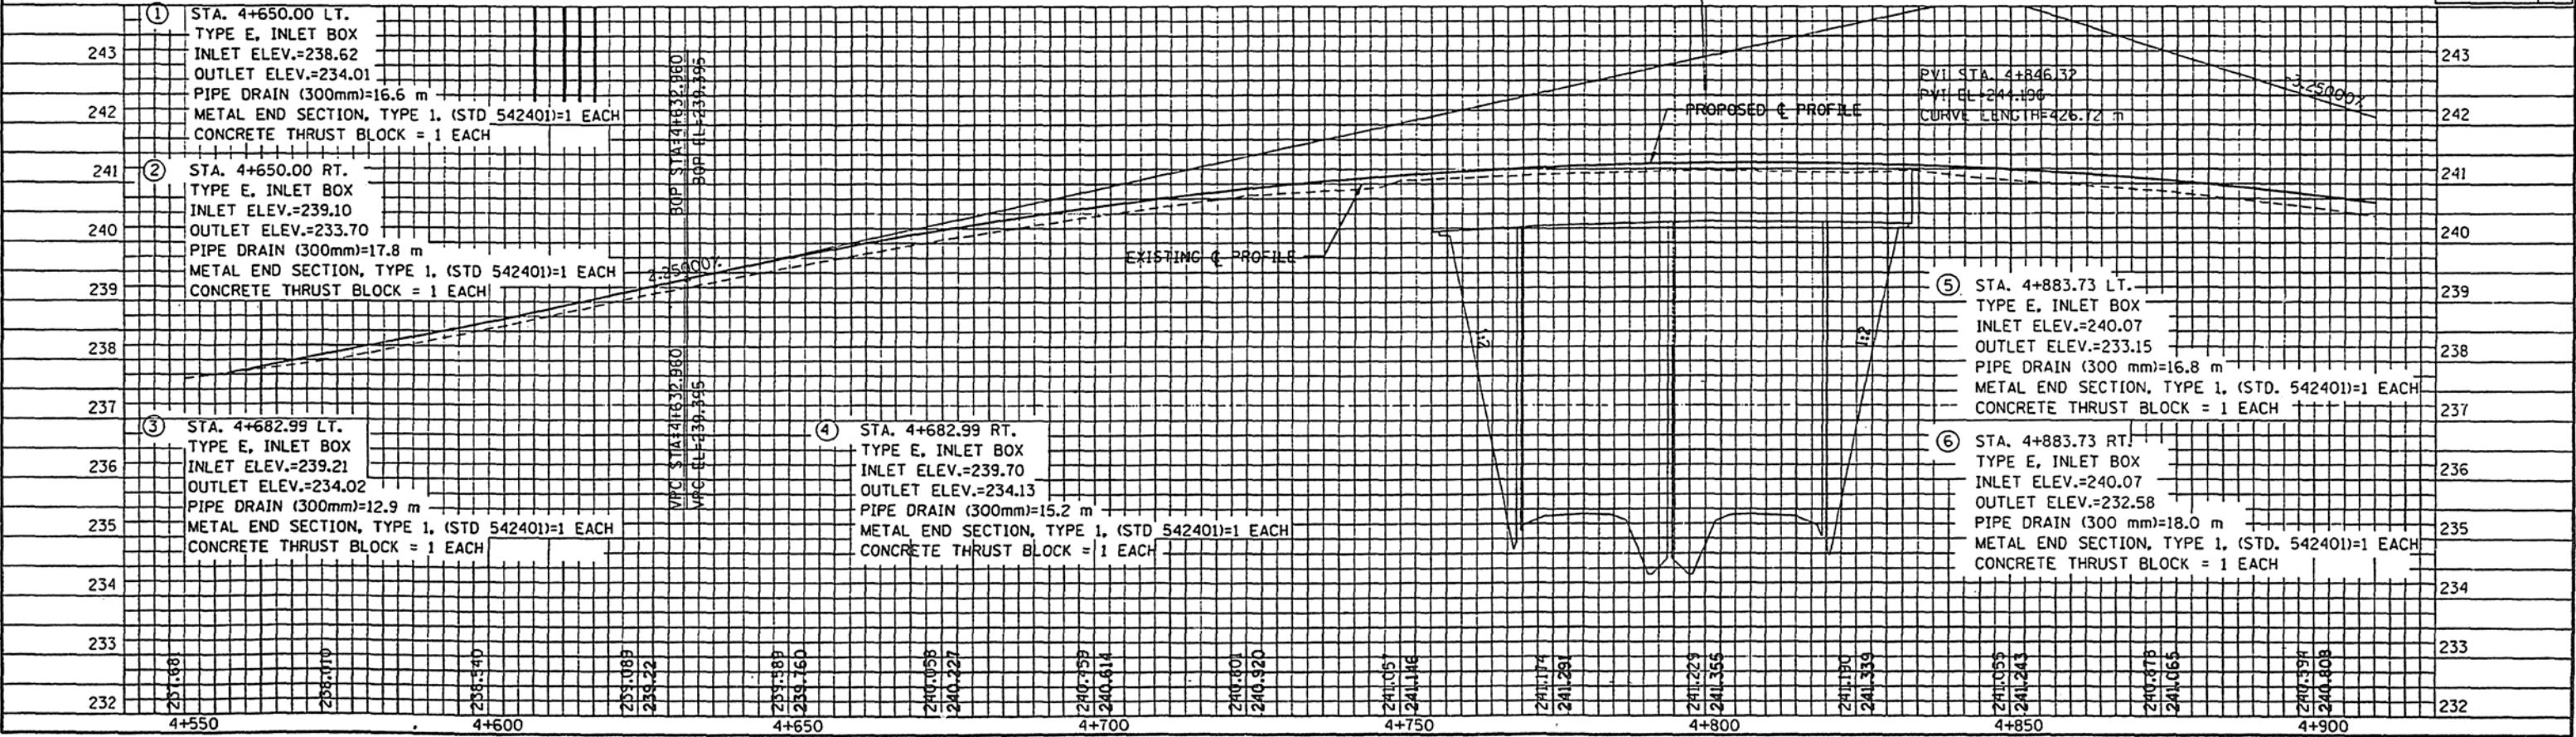




PROJECT NO.	SECTION	CITY	SHEET NO.	TOTAL SHEETS
F.A.I. 57	(10-34)B1BR	CHAMPAIGN	47	8
F.I.L. DRAWING NO. 1		SCALE	F.O.L. AND PROJECT	

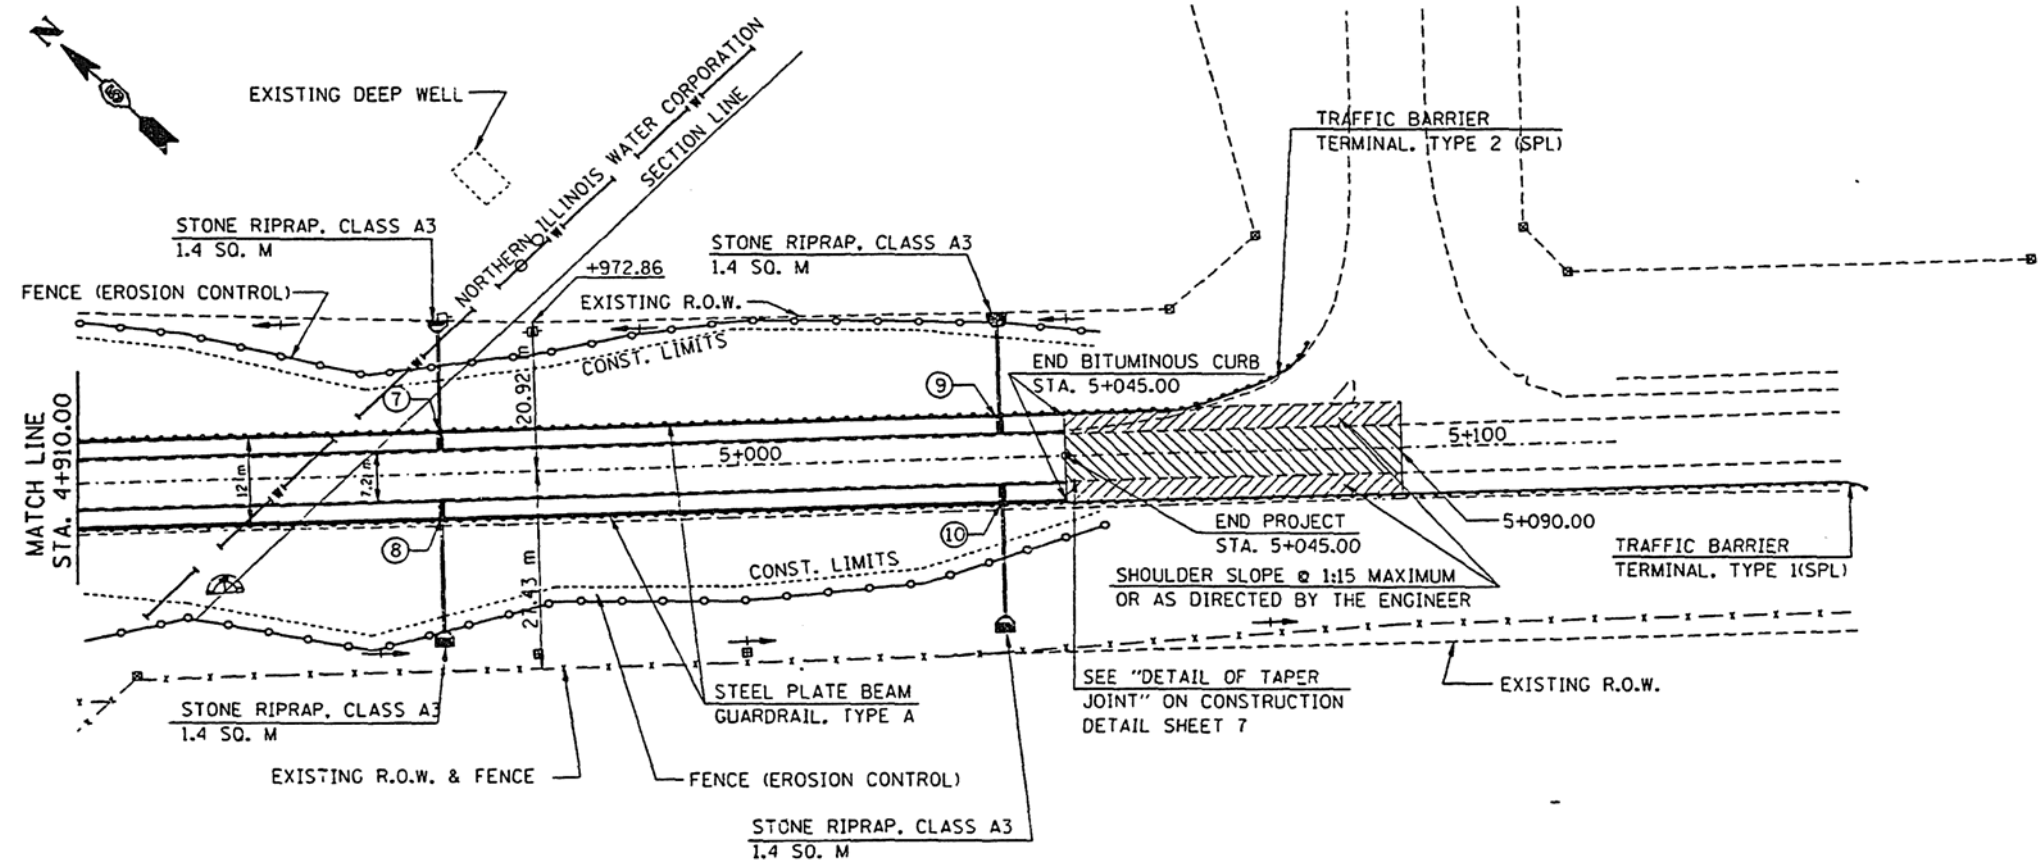


SCALES:  
1:500 HOR  
1:50 VER

REVISIONS	
NAME	DATE
B. BLAND	2-22-97

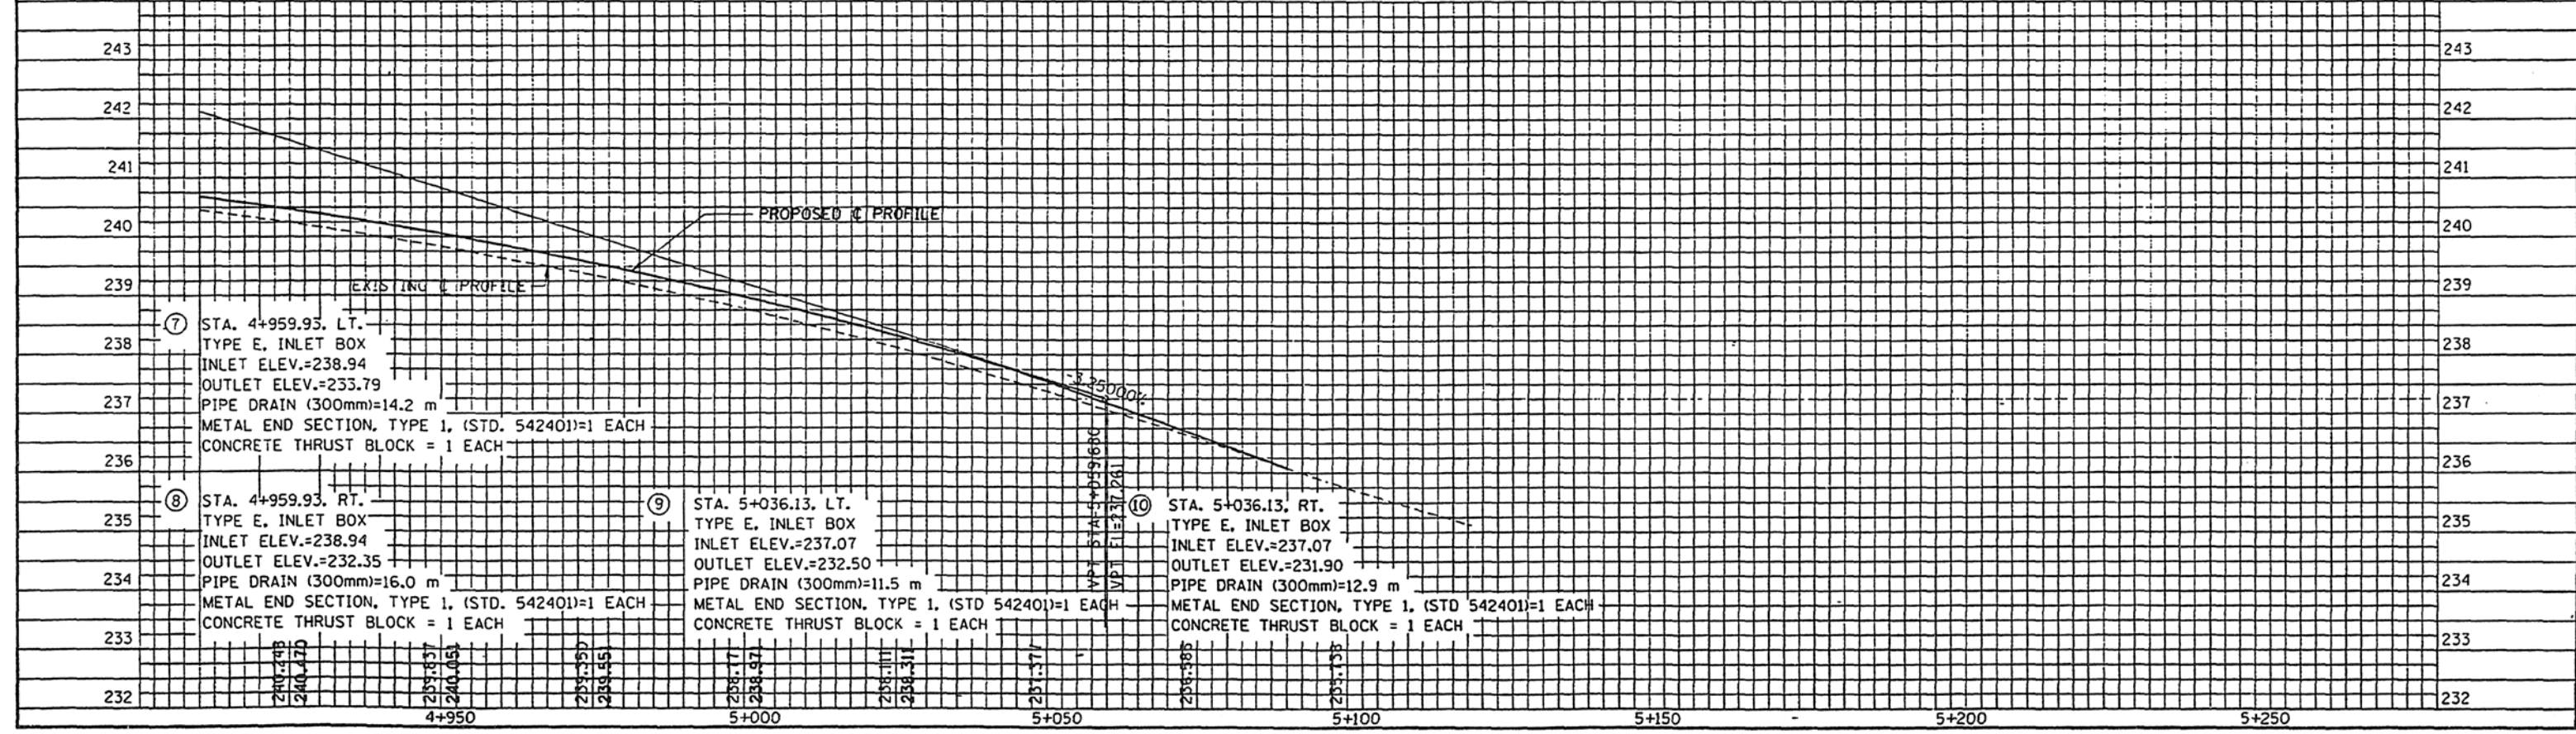



SCALE: 1:500

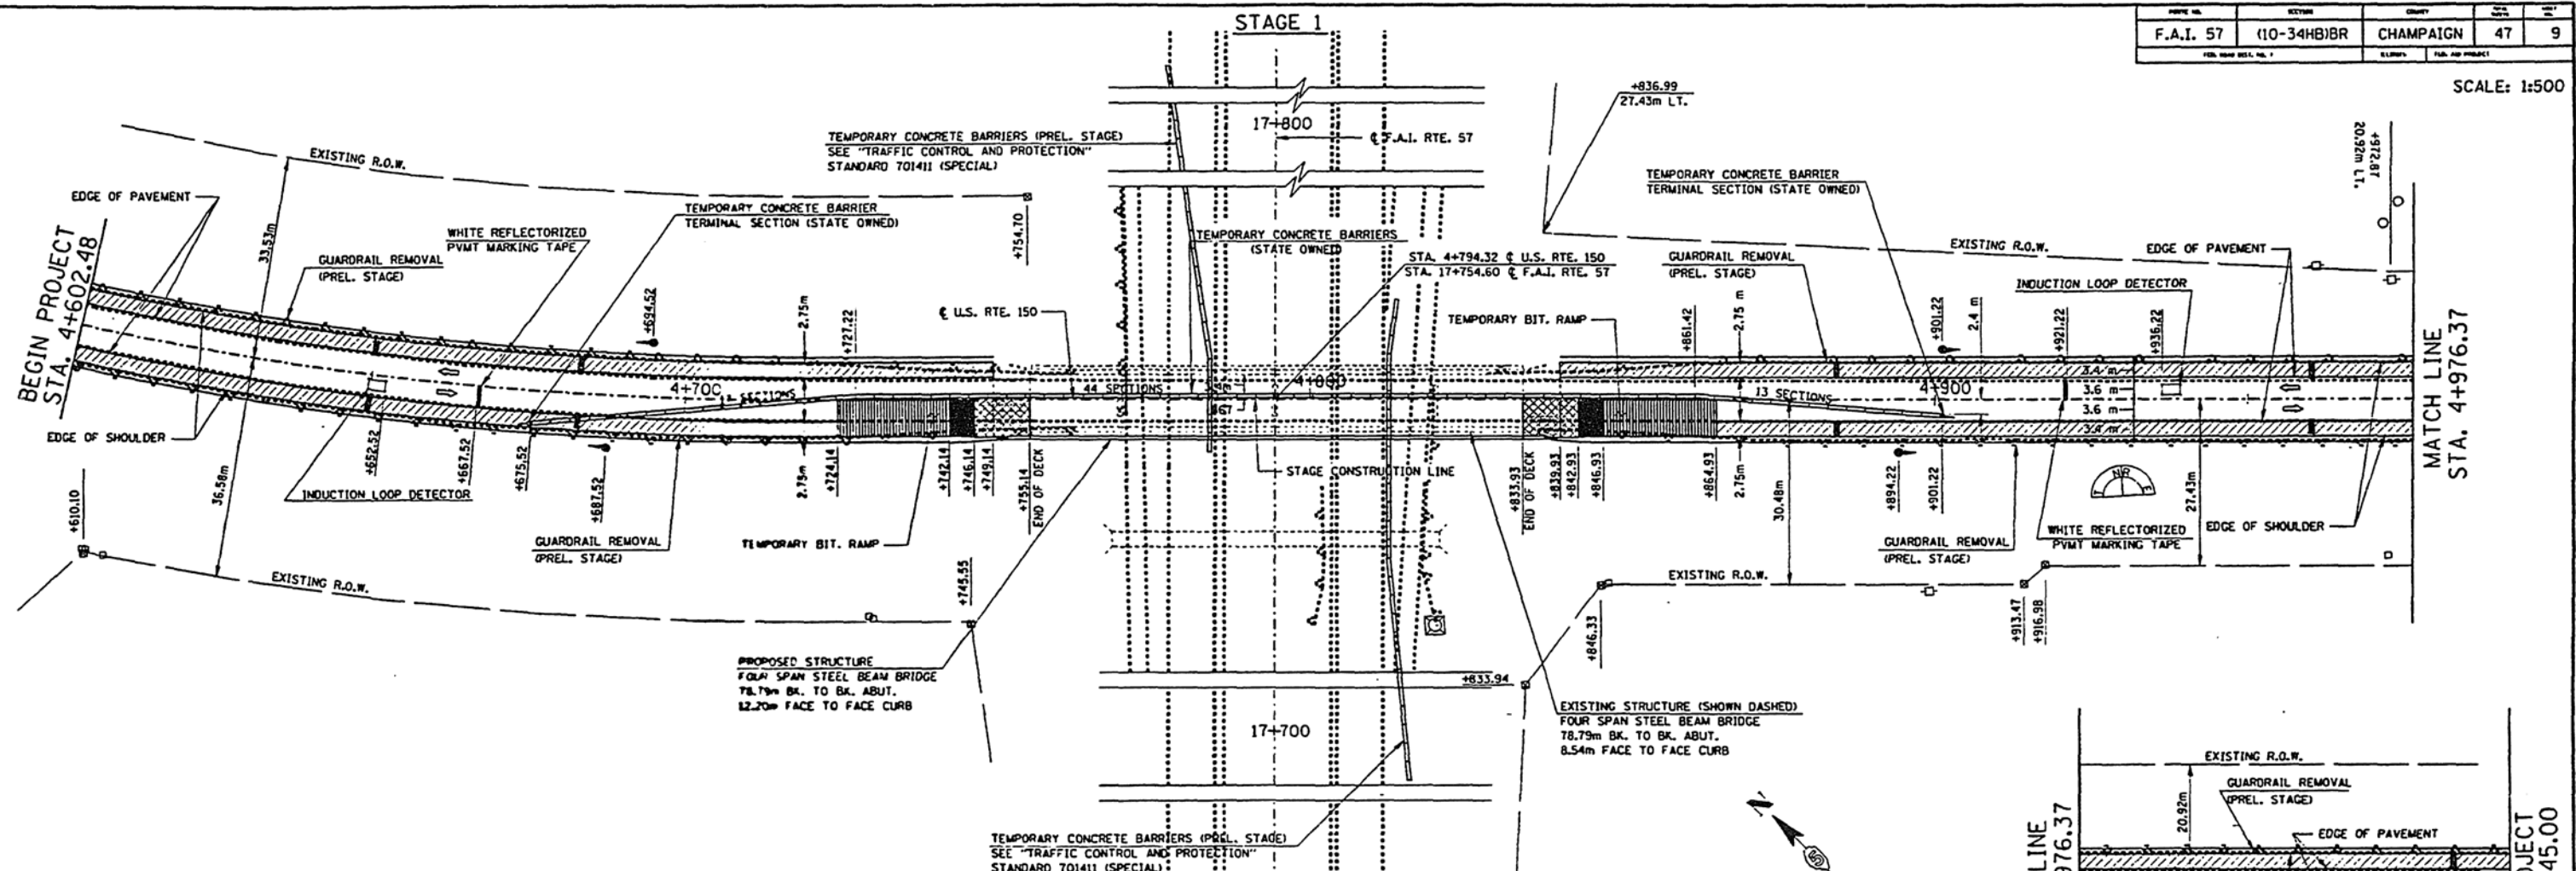

**BRIDGE APPROACH PAVEMENT (STD. 2442)**

RT. STA. 4+746.14 TO STA. 4+755.14 = 55.62  
 RT. STA. 4+833.93 TO STA. 4+842.93 = 55.62

TOTAL = 111.24 Sq. m

**BRIDGE APPROACH PAVEMENT CONNECTOR (FLEXIBLE)**

RT. STA. 4+742.14 TO STA. 4+746.14 = 26.52  
 RT. STA. 4+842.93 TO STA. 4+846.93 = 26.52

TOTAL = 53.04 Sq. m

**GUARDRAIL REMOVAL**

RT. STA. 4+585 TO STA. 4+762 = 177  
 RT. STA. 4+827 TO STA. 5+156 = 329

TOTAL = 506

**PAVEMENT REMOVAL**

RT. STA. 4+742.14 TO STA. 4+749.14 = 26.6  
 RT. STA. 4+839.93 TO STA. 4+846.93 = 26.6

TOTAL = 53.2 Sq. m

**INSTALL TEMPORARY CONCRETE BARRIER (STATE OWNED)**

STA. 4+675.52 TO STA. 4+901.22 = 225.7 m

**TRAFFIC BARRIER TERMINAL, TYPE 6**

RT. STA. 4+742.304 TO STA. 4+752.407 = 1 EACH  
 RT. STA. 4+836.668 TO STA. 4+846.771 = 1 EACH

TOTAL = 2 EACH

**APPROACH SLAB REMOVAL**

RT. STA. 4+749.14 TO STA. 4+755.14 = 22.8  
 RT. STA. 4+833.93 TO STA. 4+839.93 = 22.8

TOTAL = 45.6 Sq. m

**INSTALL TEMPORARY CONCRETE BARRIER TERMINAL SECTION (STATE OWNED)**

STA. 4+673.39 TO STA. 4+675.52 = 1  
 STA. 4+901.22 TO STA. 4+903.35 = 1

TOTAL = 2 EACH

**TRAFFIC BARRIER TERMINAL, TYPE 1 (SPECIAL)**

RT. STA. 5+148.38 TO STA. 5+156 = 1 EACH

**TRAFFIC BARRIER TERMINAL, TYPE 2**

RT. STA. 4+586.094 TO STA. 4+587.904 = 1 EACH

**BASE COURSE (OPTION)**

RT. STA. 4+602.48 TO STA. 4+749.14 = 146.66  
 RT. STA. 4+839.93 TO STA. 5+045.00 = 205.07  
 LT. STA. 4+602.48 TO STA. 4+749.14 = 146.66  
 LT. STA. 4+839.93 TO STA. 5+045.00 = 205.07

TOTAL = 1934.50 Sq. m

**STEEL PLATE BEAM GUARDRAIL, TYPE A**

RT. STA. 4+589.904 TO STA. 4+742.304 = 152.40  
 RT. STA. 4+846.771 TO STA. 5+148.38 = 301.609

TOTAL = 455.009

**TEMPORARY STEEL PLATE BEAM GUARDRAIL, TYPE A**

RT. STA. 4+587.904 TO STA. 4+755 = 176.096  
 RT. STA. 4+834 TO STA. 5+148.38 = 314.38



TOTAL = 490.476

**TEMPORARY TRAFFIC BARRIER TERMINAL, TYPE 1 (SPL.)**

RT. STA. 5+148.38 TO STA. 5+156 = 1 EACH

**TEMPORARY TRAFFIC BARRIER TERMINAL, TYPE 2**

RT. STA. 4+585.040 TO STA. 4+587.904 = 1 EACH

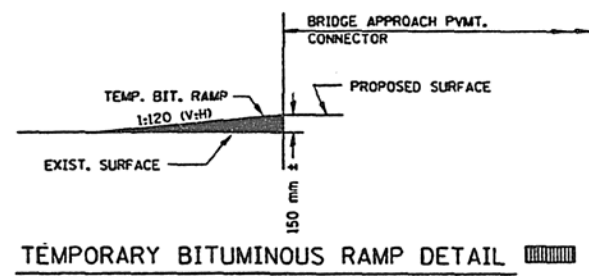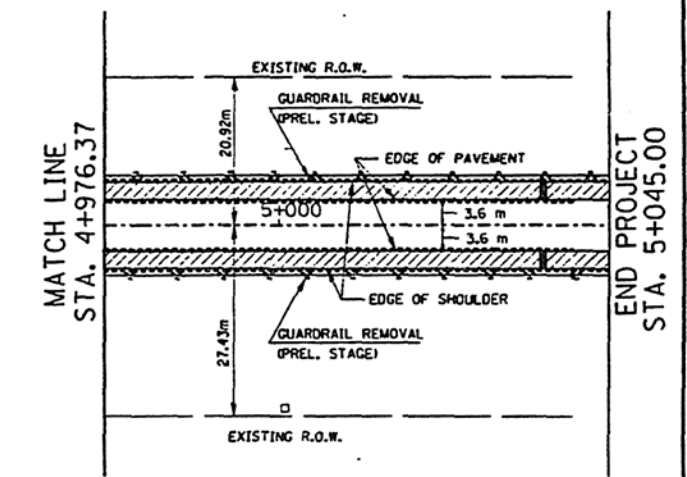

STAGE I CONSTRUCTION TRAFFIC CONTROL PLAN

**LIN ENGINEERING, LTD**  
 DESIGNED: R.J.P. CHECKED: T.M.M.  
 DRAWN: R.J.P. DATE: 2/96


- THE GUARDRAIL REMOVAL LENGTH INCLUDES THE TERMINAL SECTIONS
- TO BE ACCOMPLISHED DURING PRELIMINARY STAGE
- TO BE ACCOMPLISHED DURING FINAL STAGE

NOTE:  
 ALL DIMENSIONS ARE IN MILLIMETERS (mm) EXCEPT AS NOTED.  
 SEE STAGE CONSTRUCTION DETAILS FOR MORE INFORMATION.



ROUTE NO.	SECTION	CITY	SHEET	TOTAL
F.A.I. 57	(10-34HB)BR	CHAMPAIGN	47	10
P.O. PROJ. DES. NO. 7		CLIENT	116.00 PROJECT	

SCALE: 1:500

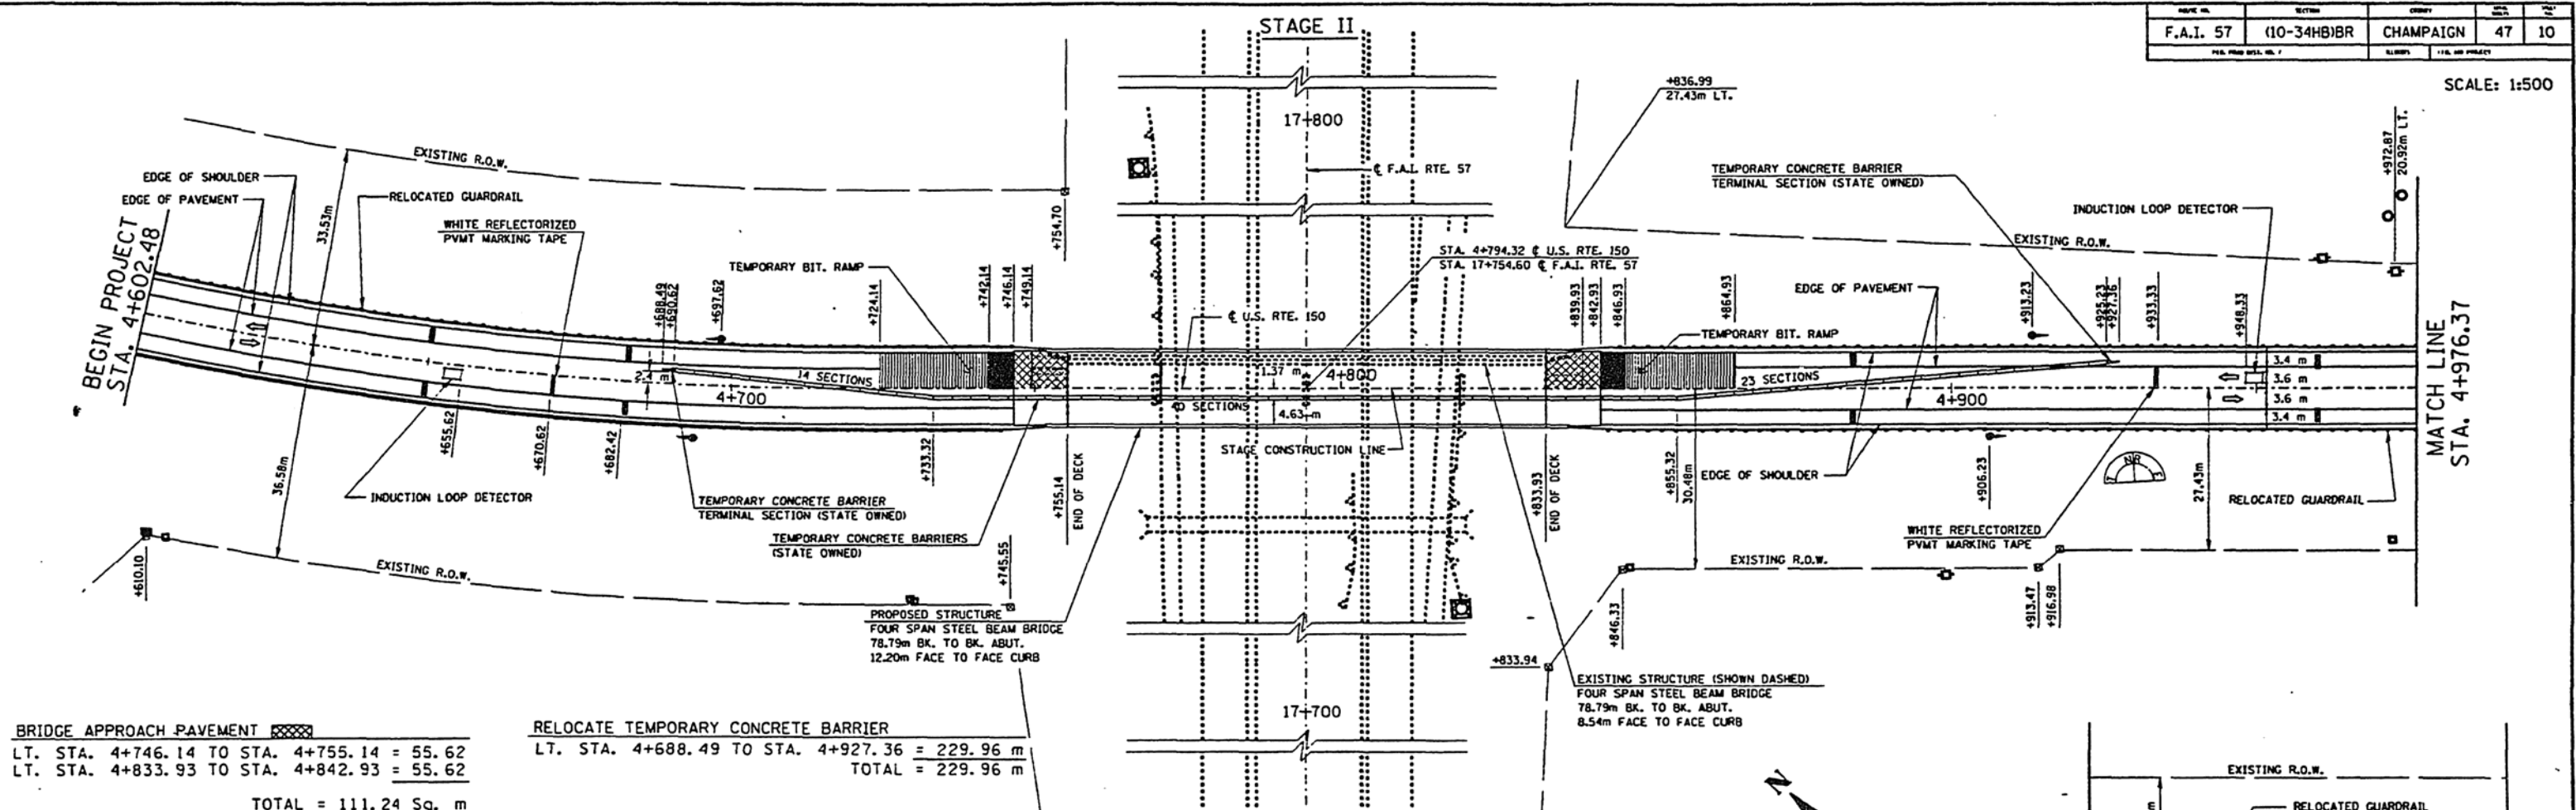

**BRIDGE APPROACH PAVEMENT** [Hatched Pattern]

LT. STA. 4+746.14 TO STA. 4+755.14 = 55.62  
 LT. STA. 4+833.93 TO STA. 4+842.93 = 55.62

TOTAL = 111.24 Sq. m

**RELOCATE TEMPORARY CONCRETE BARRIER**

LT. STA. 4+688.49 TO STA. 4+927.36 = 229.96 m  
 TOTAL = 229.96 m

\*\*\* **INSTALL TEMPORARY CONCRETE BARRIER (STATE OWNED)**

LT. STA. 4+688.49 TO STA. 4+927.36 = 9.15 m  
 TOTAL = 9.15 m

**PAVEMENT REMOVAL** [Dotted Pattern]

LT. STA. 4+742.14 TO STA. 4+749.93 = 20.3  
 LT. STA. 4+839.93 TO STA. 4+846.93 = 20.3

TOTAL = 40.6 Sq. m

\*\*\* **STEEL PLATE BEAM GUARDRAIL, TYPE A**

LT. STA. 4+602.48 TO STA. 4+742.304 = 139.824  
 LT. STA. 4+846.771 TO STA. 5+075.371 = 228.600

TOTAL = 368.424

**TRAFFIC BARRIER TERMINAL, TYPE 2**

LT. STA. 5+075.371 TO STA. 5+079.18 = 1 EACH  
 TOTAL = 1 EACH

**APPROACH SLAB REMOVAL** [Dotted Pattern]

LT. STA. 4+749.14 TO STA. 4+755.14 = 17.4  
 LT. STA. 4+833.93 TO STA. 4+839.93 = 17.4

TOTAL = 34.8 Sq. m

\*\*\* **GUARDRAIL REMOVAL**

LT. STA. 4+602.48 TO STA. 4+762 = 159.52  
 LT. STA. 4+828 TO STA. 5+080 = 252

TOTAL = 411.52

\*\* **TEMPORARY STEEL PLATE BEAM GUARDRAIL, TYPE A**

LT. STA. 4+602.48 TO STA. 4+755 = 152.50  
 LT. STA. 4+834 TO STA. 5+075.371 = 231.371

TOTAL = 393.871

**BRIDGE APPROACH PAVEMENT CONNECTOR** [Hatched Pattern]

LT. STA. 4+742.14 TO STA. 4+746.14 = 22.92  
 LT. STA. 4+842.93 TO STA. 4+846.93 = 22.92

TOTAL = 45.84 Sq. m


\*\*\* **TRAFFIC BARRIER TERMINAL, TYPE 6**

LT. STA. 4+742.304 TO STA. 4+752.407 = 1 EACH  
 LT. STA. 4+836.668 TO STA. 4+846.771 = 1 EACH

TOTAL = 2 EACH

\*\* **TEMPORARY TRAFFIC BARRIER TERMINAL, TYPE 2**

LT. STA. 5+075.371 TO STA. 5+079.180 = 1 EACH  
 TOTAL = 1 EACH

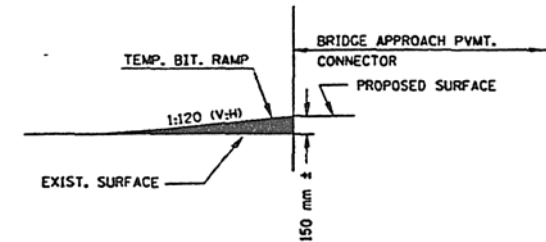

TEMPORARY BITUMINOUS RAMP DETAIL [Hatched Pattern]

- THE GUARDRAIL REMOVAL LENGTH INCLUDES THE TERMINAL SECTIONS
- TO BE ACCOMPLISHED DURING PRELIMINARY STAGE
- TO BE ACCOMPLISHED DURING FINAL STAGE
- THREE (3) ADDITIONAL TEMPORARY CONCRETE BARRIERS ARE REQUIRED FOR STAGE II



NOTE:  
 ALL DIMENSIONS ARE IN MILLIMETERS (mm) EXCEPT AS NOTED.  
 SEE STAGE CONSTRUCTION DETAILS FOR MORE INFORMATION.

STAGE II CONSTRUCTION  
 TRAFFIC CONTROL PLAN

**LIN ENGINEERING, LTD**  
 DESIGNED: R.J.P. CHECKED: T.M.M.  
 DRAWN: R.J.P. DATE: 2/96

PROJECT NO.	SECTION	DATE	SCALE
F.A.I. 57	(10-34HB)BR	CHAMPAIGN	47
F.A.I. 57		CHAMPAIGN	47

DUAL DISPLAY		
SIGN	CODE	STATION
RCA	W20-1(0)	STA. 17+450 STA. 18+260
RIGHT LANE CLOSED AHEAD	W20-SR-A	STA. 17+300 STA. 18+110

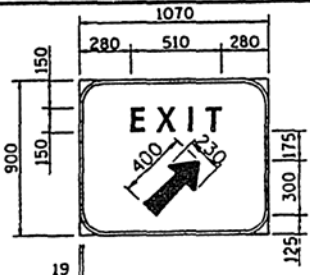
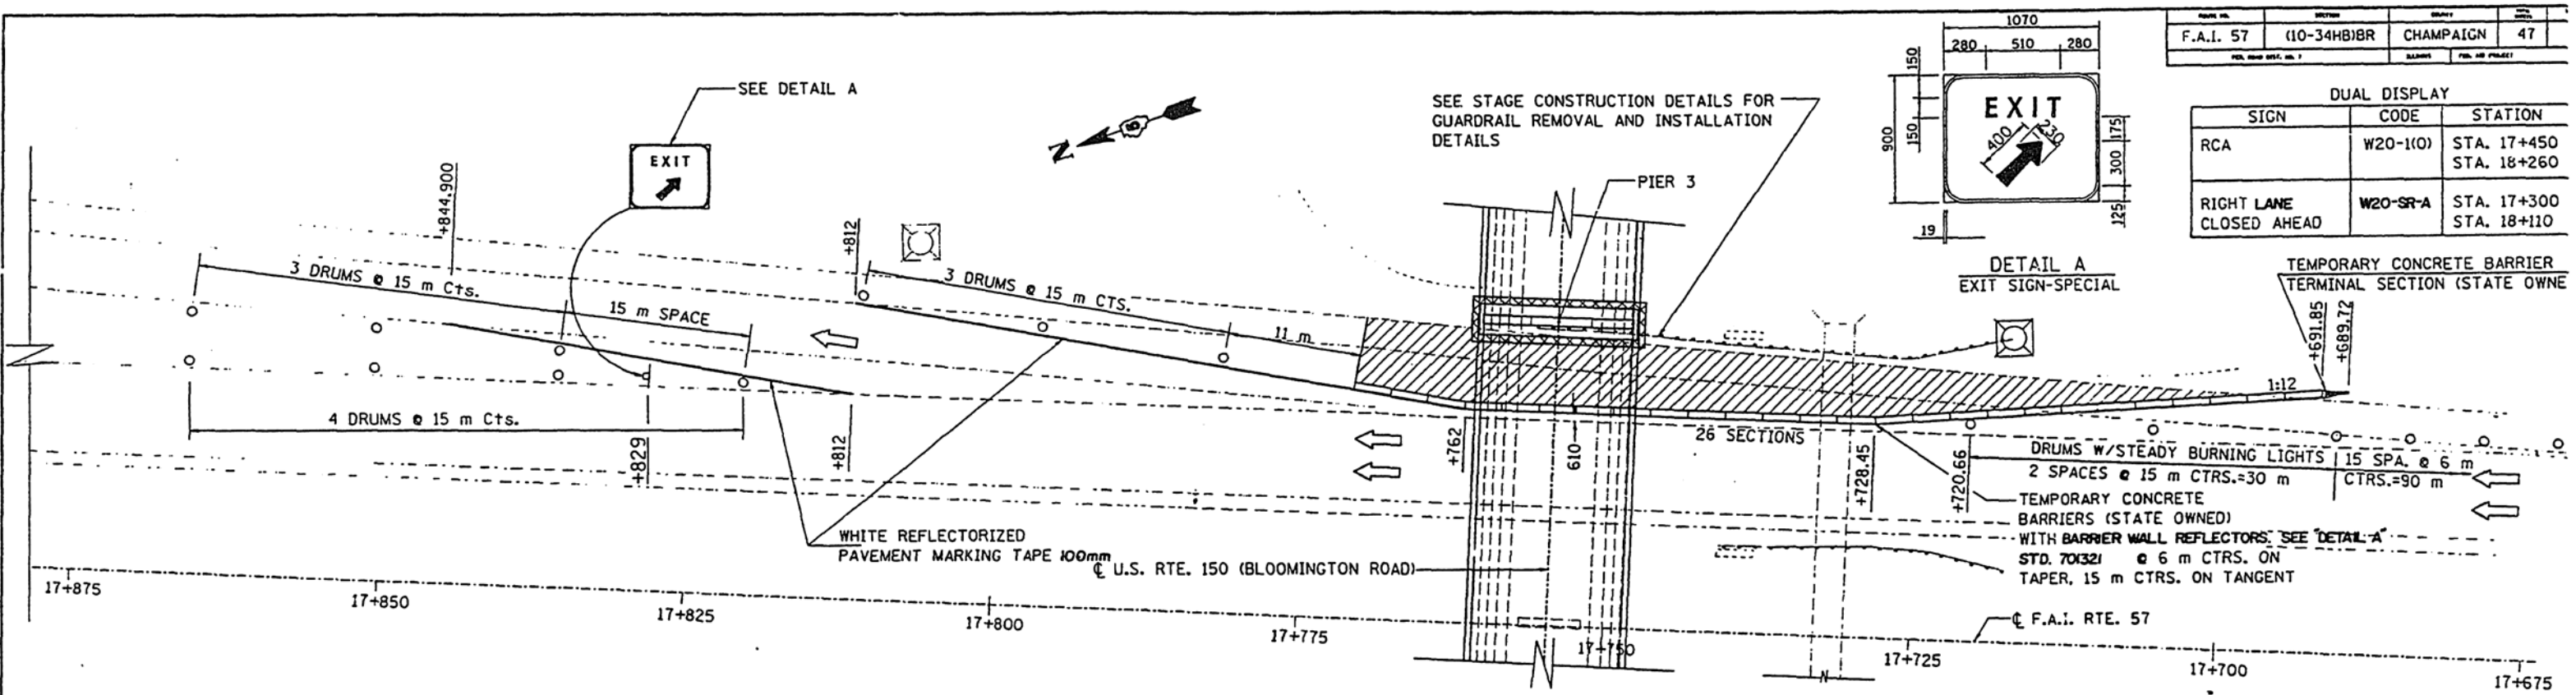


TEMPORARY CONCRETE BARRIER  
TERMINAL SECTION (STATE OWNE)

DETAIL A  
EXIT SIGN-SPECIAL

SEE STAGE CONSTRUCTION DETAILS FOR  
GUARDRAIL REMOVAL AND INSTALLATION  
DETAILS

SEE DETAIL A

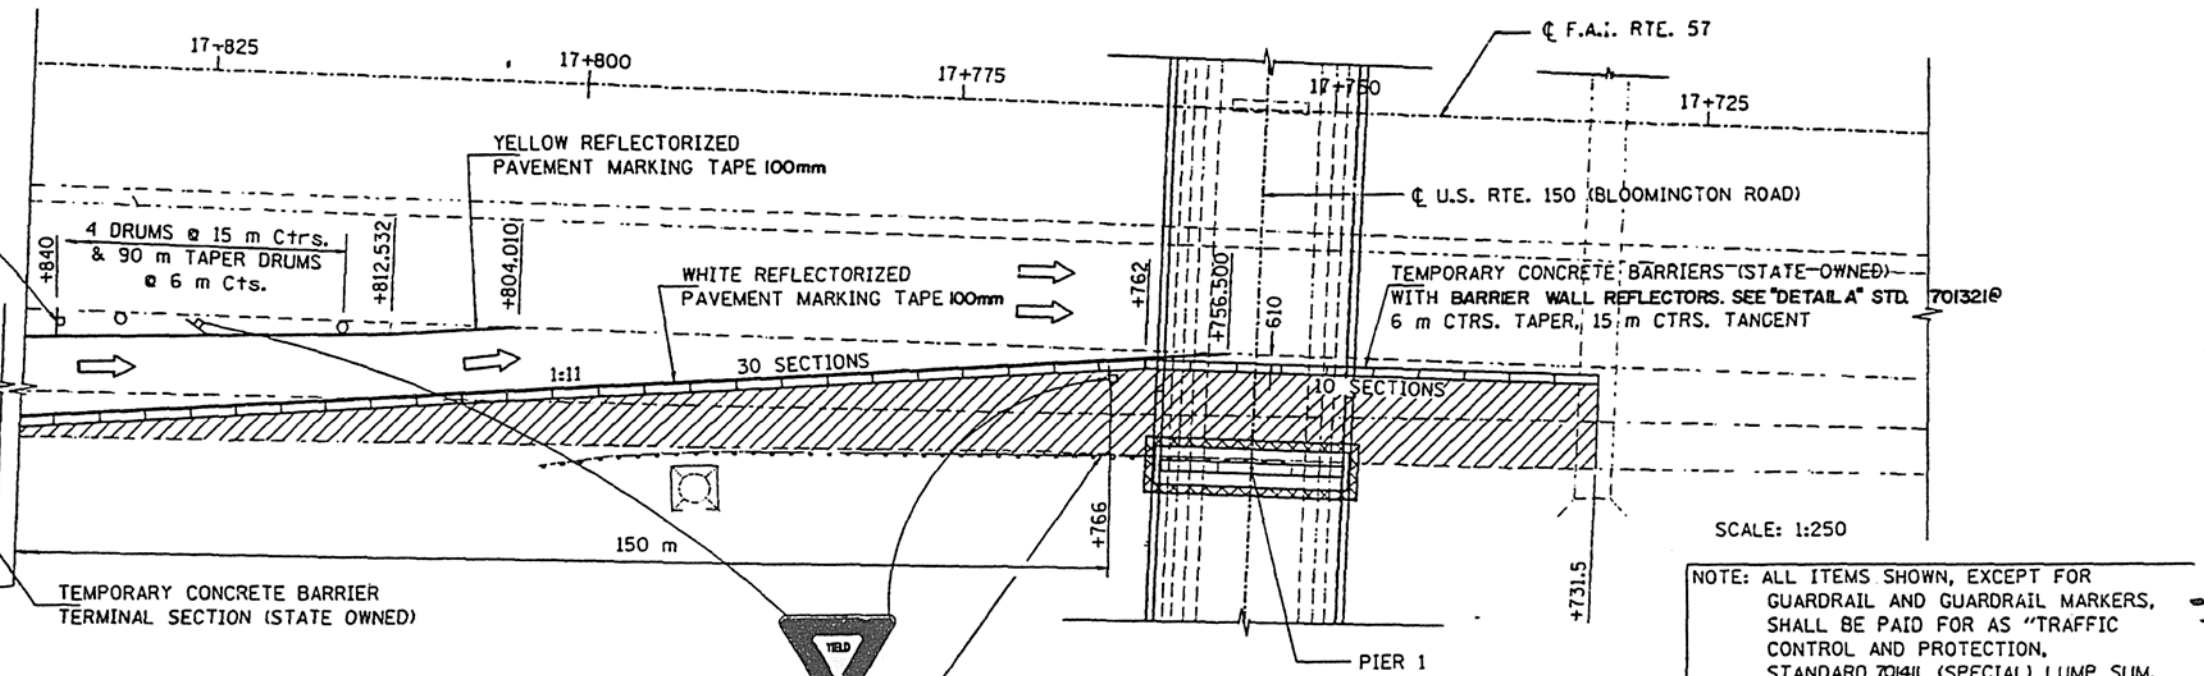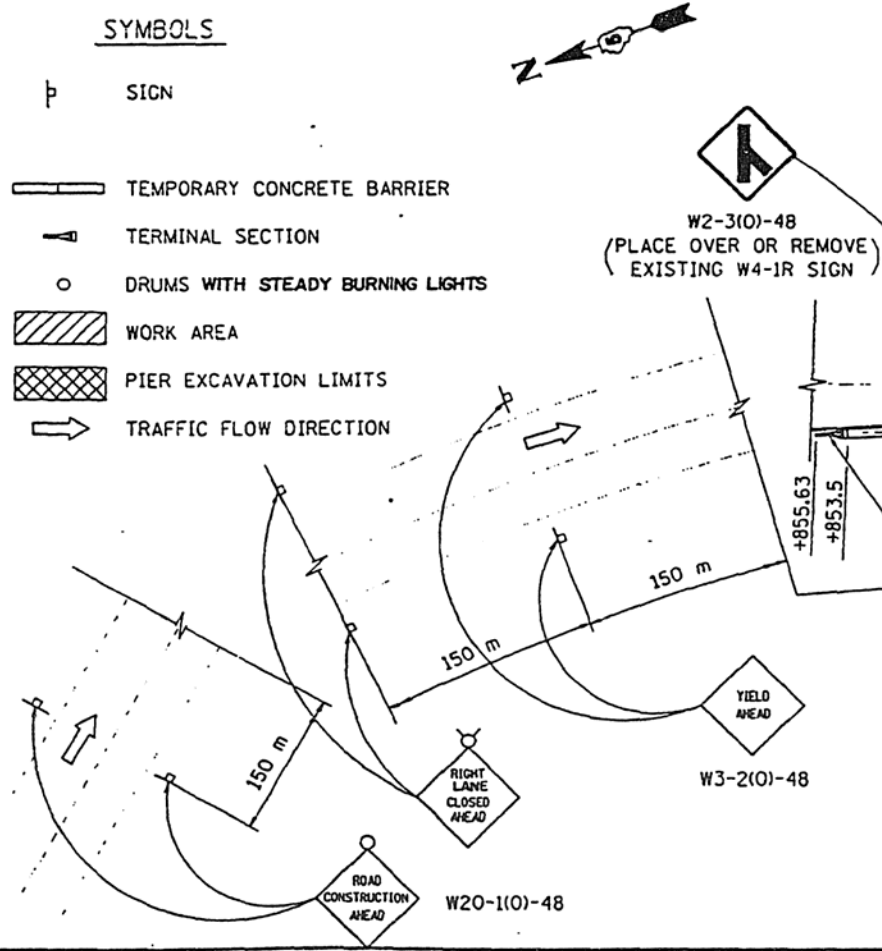

SCALE: 1:250  
NOTE: ALL ITEMS SHOWN, EXCEPT FOR  
GUARDRAIL AND GUARDRAIL MARKERS,  
SHALL BE PAID FOR AS "TRAFFIC  
CONTROL AND PROTECTION,  
STANDARD 70411 (SPECIAL) LUMP SUM.

GUARDRAIL REMOVAL  
PIER 1 = 12.0 m  
PIER 3 = 12.0 m  
TOTAL = 24.0 m

GUARDRAIL MARKERS  
PIER 1 = 2 EACH  
PIER 3 = 2 EACH  
TOTAL = 4 EACH

STEEL PLATE BEAM GUARDRAIL, TYPE C  
PIER 1 = 11.333 m  
PIER 3 = 11.333 m  
TOTAL = 22.666 m

STEEL PLATE BEAM GUARDRAIL, TYPE B  
PIER 1 = 3.81 m  
PIER 2 = 3.81 m  
TOTAL = 7.62 m

ALL DIMENSIONS ARE IN MILLIMETERS UNLESS OTHERWISE SHOWN

TRAFFIC CONTROL AND PROTECTION  
STANDARD 70411 (SPECIAL)

LIN ENGINEERING, LTD.  
DESIGNED: R.J.P. CHECKED: T.M.M.  
DRAWN: R.J.P. DATE: 2/1/96  
REVISIONS: B. BLAND 3-12-97







REMOVE SPBGR AND ERECT TEMPORARY STEEL PLATE BEAM GUARDRAIL DURING PRELIMINARY STAGE TO ALLOW FOR BASE COURSE OPTION. SEE "PRELIMINARY STAGE" TYP. SECTION DETAIL ON THIS SHEET FOR OFFSET REQUIREMENTS.


NOTE: ① SEE SHEETS 11 AND 12 FOR SCHEDULE OF GUARDRAIL ITEMS. GUARDRAIL ITEMS TO THE RIGHT OF  $\phi$  U.S. RTE. 150 ARE SHOWN ON SHEET 11 AND ITEMS TO THE LEFT OF  $\phi$  ARE SHOWN ON SHEET 12.

② STAGE I AND STAGE II ARE FOR CONSTRUCTION OF BRIDGE SUPERSTRUCTURE. SEQUENCE OF STAGES ARE AS FOLLOWS:


- ① PRELIMINARY STAGE
- ② STAGE I
- ③ STAGE II
- ④ FINAL STAGE

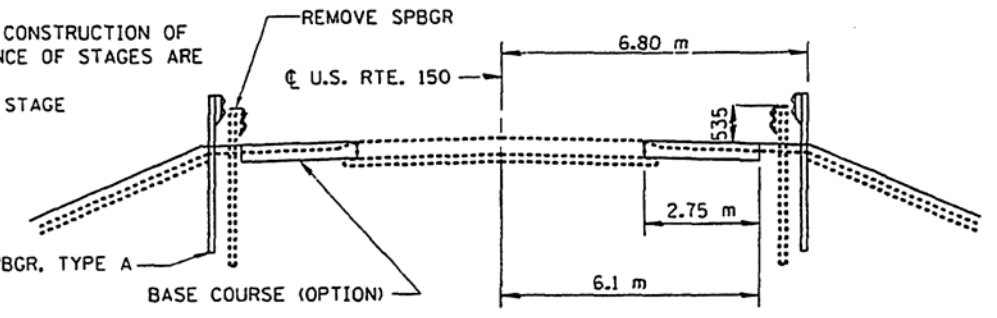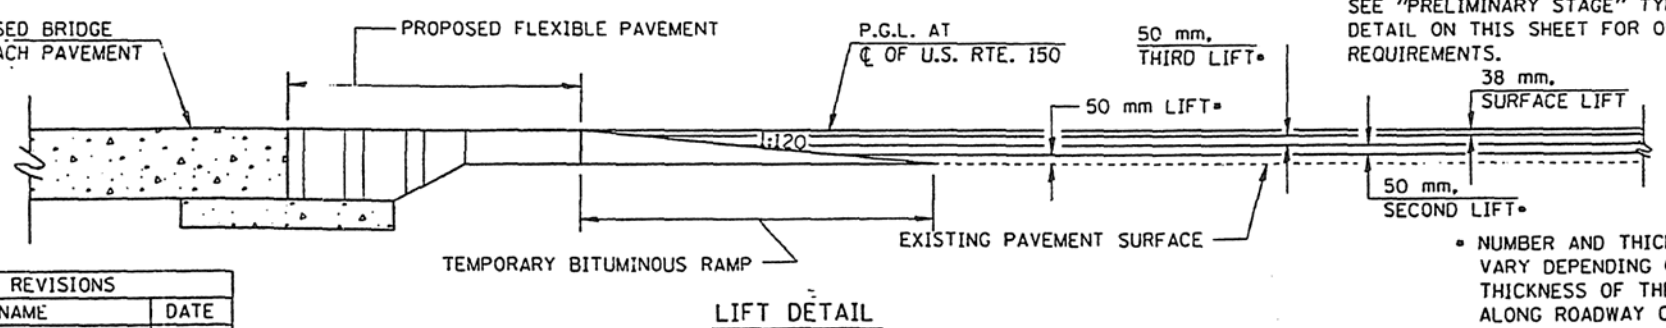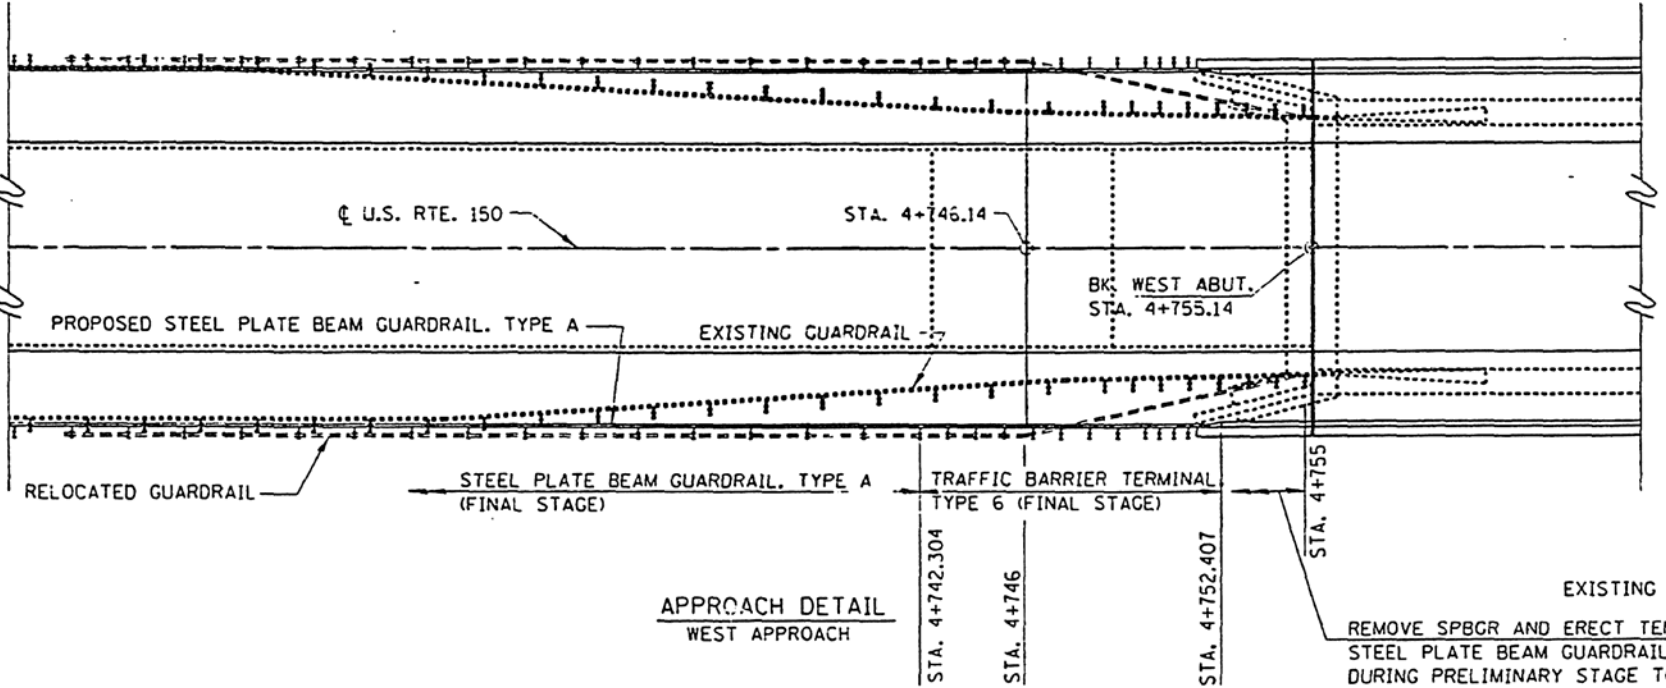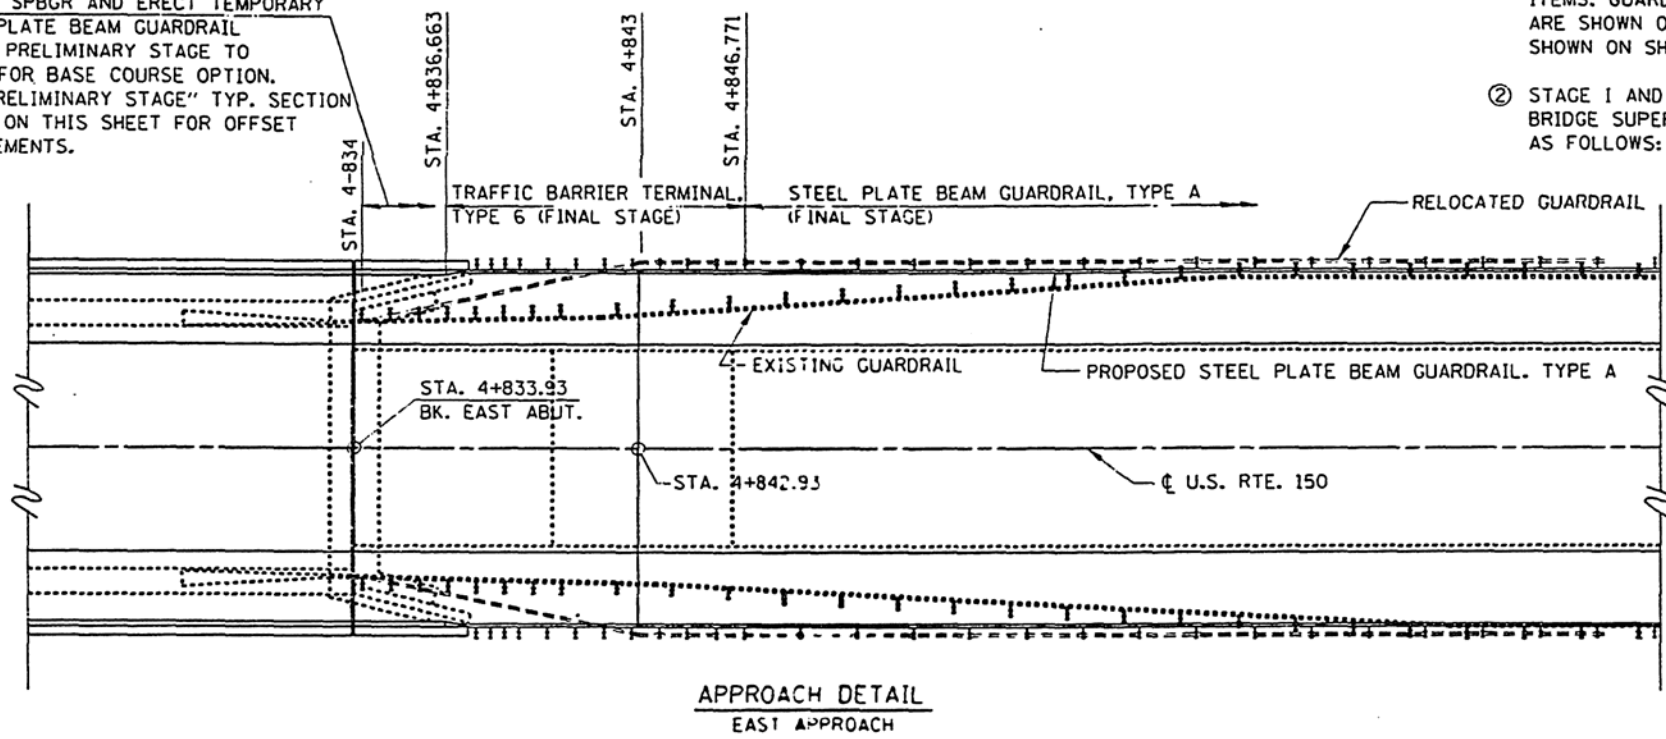

PRELIMINARY STAGE (TYP. SECTION)  
(TO BE CONSTRUCTED USING STD. 701201)

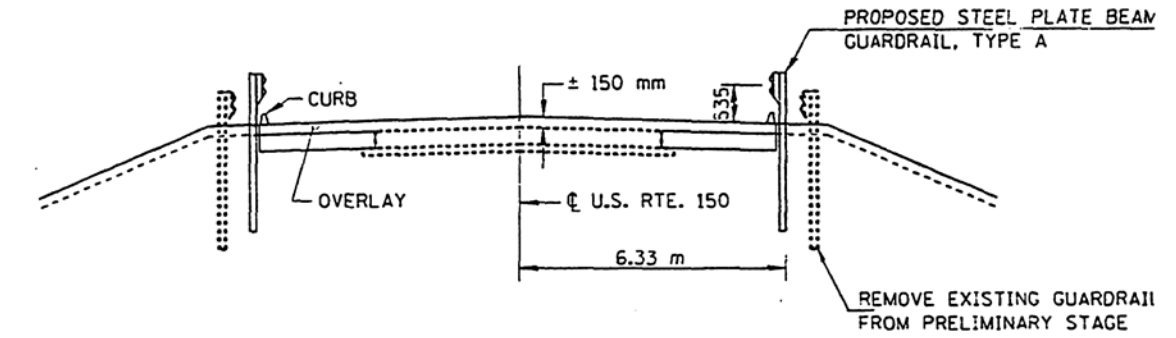

FINAL STAGE (TYP. SECTION)  
(TO BE CONSTRUCTED USING STD. 701201)

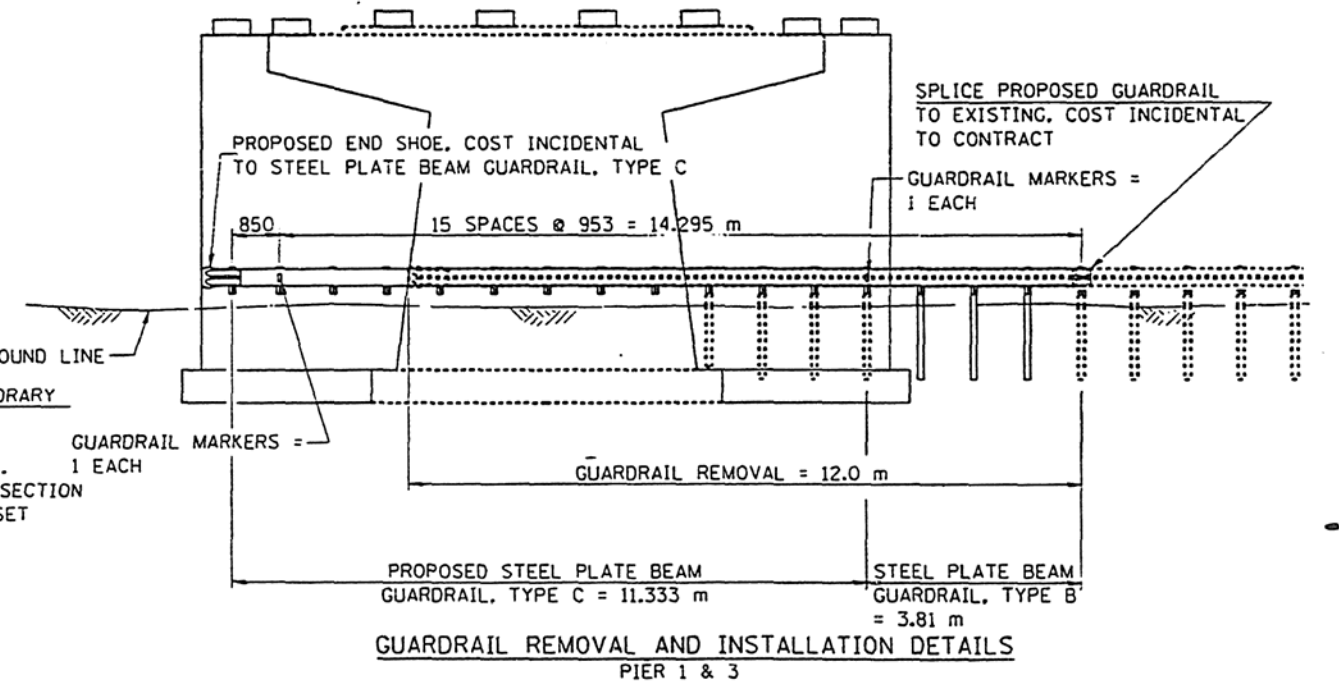

GUARDRAIL REMOVAL AND INSTALLATION DETAILS  
PIER 1 & 3


NUMBER AND THICKNESS OF LIFTS MAY VARY DEPENDING ON THEIR LOCATION. THE THICKNESS OF THE LIFTS WILL VARY TRANSVERSELY ALONG ROADWAY CROSS SECTION DUE TO THE EXISTING CIRCULAR CROWN AND SUPERELEVATED AREA WEST OF THE BRIDGE.

REVISIONS	
NAME	DATE
B. BLAND	2-22-97

STAGE CONSTRUCTION DETAILS  
LIN ENGINEERING, LTD.  
DESIGNED: R.J.P. CHECKED: T.M.M.  
DRAWN: R.J.P. DATE: 2/1/96

## DETAIL OF SURVEY MONUMENT COVER ASSEMBLY

TO BE INSTALLED OVER EXISTING MARKERS FOR LAND SURVEY MONUMENT, P.C.'S, P.I.'S AND P.T.'S AT LOCATIONS SHOWN ON PLANS

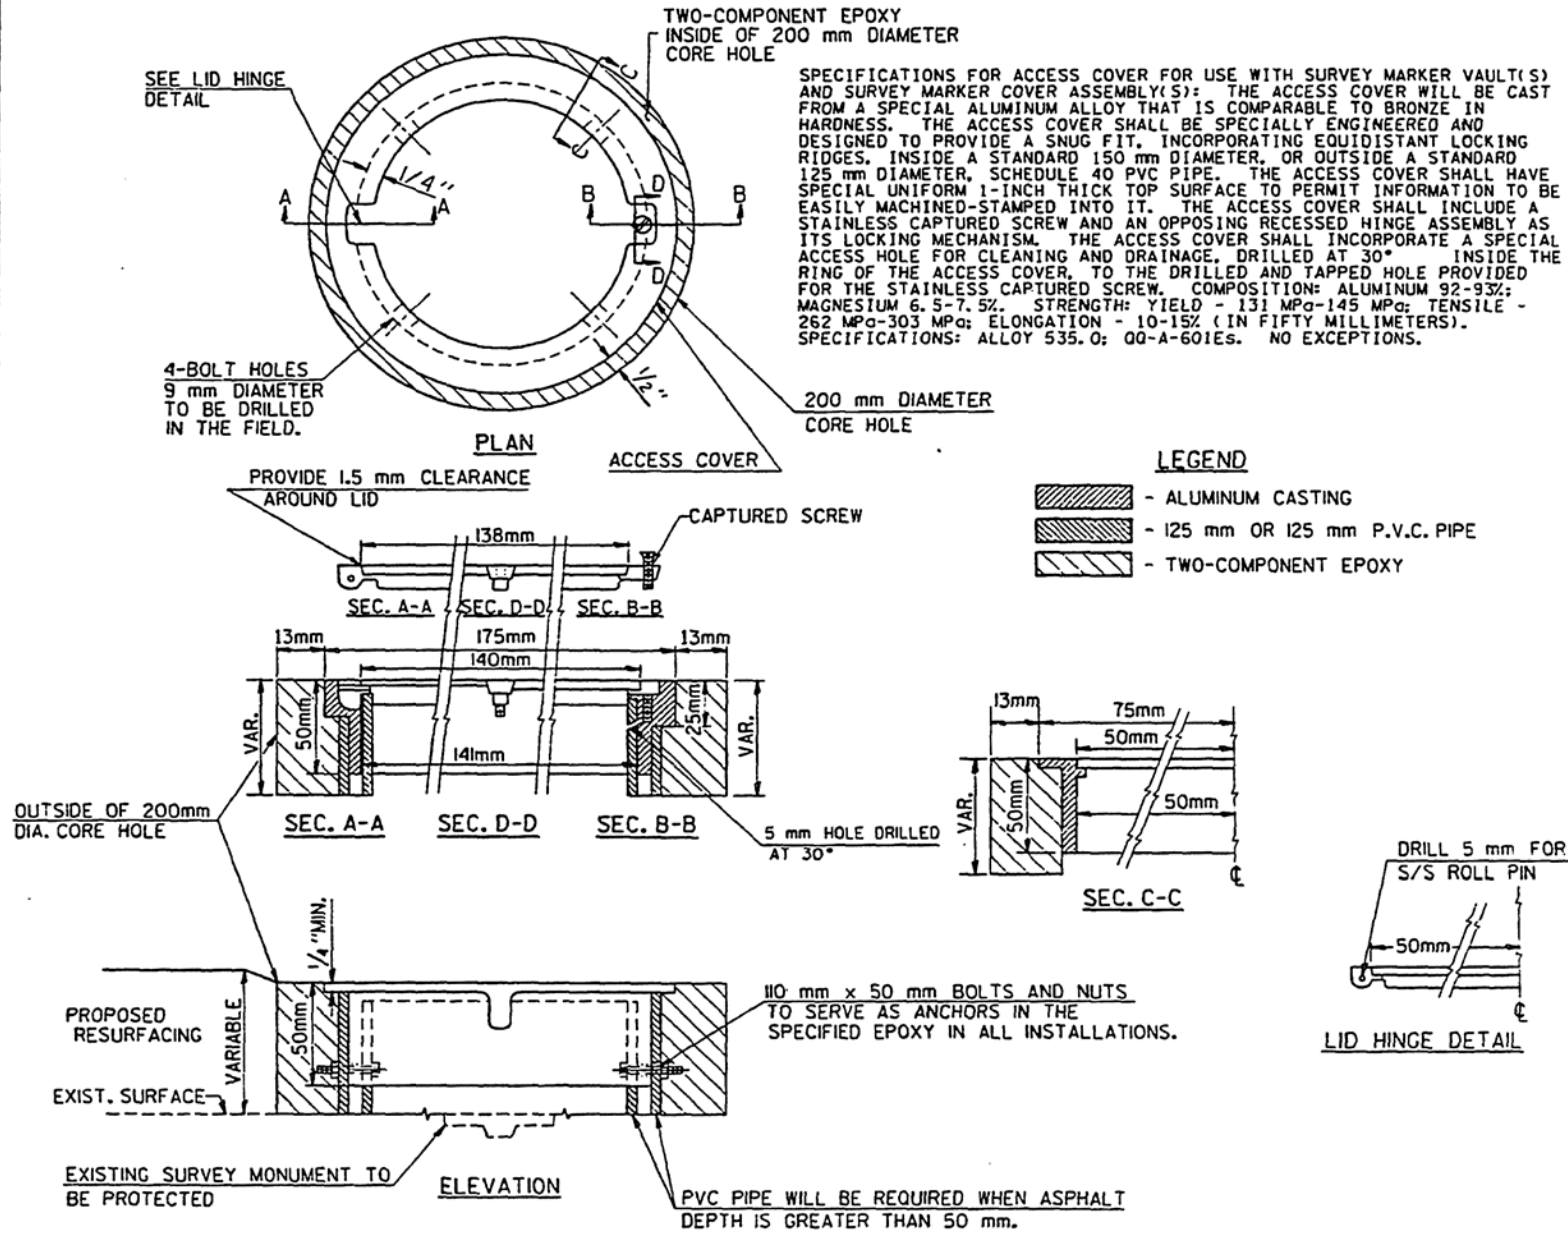

**SPECIFICATIONS FOR ACCESS COVER FOR USE WITH SURVEY MARKER VAULT(S) AND SURVEY MARKER COVER ASSEMBLY(S):** THE ACCESS COVER WILL BE CAST FROM A SPECIAL ALUMINUM ALLOY THAT IS COMPARABLE TO BRONZE IN HARDNESS. THE ACCESS COVER SHALL BE SPECIALLY ENGINEERED AND DESIGNED TO PROVIDE A SNUG FIT, INCORPORATING EQUIDISTANT LOCKING RIDGES, INSIDE A STANDARD 150 mm DIAMETER, OR OUTSIDE A STANDARD 125 mm DIAMETER, SCHEDULE 40 PVC PIPE. THE ACCESS COVER SHALL HAVE SPECIAL UNIFORM 1-INCH THICK TOP SURFACE TO PERMIT INFORMATION TO BE EASILY MACHINED-STAMPED INTO IT. THE ACCESS COVER SHALL INCLUDE A STAINLESS CAPTURED SCREW AND AN OPPOSING RECESSED HINGE ASSEMBLY AS ITS LOCKING MECHANISM. THE ACCESS COVER SHALL INCORPORATE A SPECIAL ACCESS HOLE FOR CLEANING AND DRAINAGE, DRILLED AT 30° INSIDE THE RING OF THE ACCESS COVER, TO THE DRILLED AND TAPPED HOLE PROVIDED FOR THE STAINLESS CAPTURED SCREW. COMPOSITION: ALUMINUM 92-93%; MAGNESIUM 6.5-7.5%. STRENGTH: YIELD - 131 MPa-145 MPa; TENSILE - 262 MPa-303 MPa; ELONGATION - 10-15% (IN FIFTY MILLIMETERS). SPECIFICATIONS: ALLOY 535.0; 00-A-601Es. NO EXCEPTIONS.

### LEGEND

- ALUMINUM CASTING
- 125 mm OR 150 mm P.V.C. PIPE
- TWO-COMPONENT EPOXY

### GENERAL NOTES

1. WORK SHALL NOT START ON THIS ITEM UNTIL THE FINAL LIFT OF CLASS I HAS BEEN COMPLETED.
2. THE SURVEY MONUMENT COVER ASSEMBLY SHALL BE CENTERED ABOVE THE SURVEY MONUMENT TO BE PROTECTED.
3. MODIFICATION OF THE ALUMINUM CASTING SHALL BE DONE BY GRINDING OR SAWING WHEN HEIGHT REDUCTION IS REQUIRED.
4. ALL SURVEY MONUMENT COVER ASSEMBLIES SHALL BE PLACED 6 mm(±) BELOW THE FINAL SURFACE.
5. ALUMINUM CASTING SHALL BE PLACED OVER A 125 mm P.V.C. PIPE OR INSIDE OF A 150 mm P.V.C. PIPE WHEN AN INCREASE IN HEIGHT IS REQUIRED.
6. THE CASTING SHALL BE ANCHORED IN THE 200 mm DIAMETER CORE HOLE WITH TWO-COMPONENT EPOXY CONFORMING TO APPLICABLE PORTIONS OF ARTICLE 1025.01 OF THE STANDARD SPECIFICATIONS.
7. THIS WORK WILL BE PAID FOR AT THE CONTRACT UNIT PRICE EACH FOR SURVEY MONUMENT COVER ASSEMBLY WHICH PRICE SHALL INCLUDE ALL LABOR AND MATERIAL AS SPECIFIED INCLUDING CORING THE NEW PAVEMENT SURFACE AND EPOXY. NO ADDITIONAL COMPENSATION WILL BE ALLOWED.
8. THE 200 mm DIAMETER CORE HOLE SHALL BE SUBJECT TO THE APPROVAL OF THE ENGINEER.

### BILL OF MATERIAL

ALUMINUM CASTING OF THE DIMENSIONS AND SPECIFICATIONS SHOWN OR OTHER SUBJECT TO ENGINEER'S APPROVAL OF SHOP DRAWINGS, 4 EACH -8 mm x 50 mm BOLTS WITH NUTS, EPOXY, 125 mm OR 150 mm Ø P.V.C. PIPE, SCHEDULE 40 (WHEN REQUIRED).


DESIGNED		CHECKED		CADD NO.	
NAME	DATE	NAME	DATE		
A.W.H.	2-28-91	J.H.M.	2-28-91	D-LO4	

REVISIONS			
NAME	DATE	NAME	DATE
A.W. HAYES	8-22-91		

PROJECT NO.	SECTION	COUNTY	TOWNSHIP	RANGE
F.A.I. 57	(10-34HB)BR	CHAMPAIGN	47	13



## FEATHEREDGE RUNDOWN DETAIL

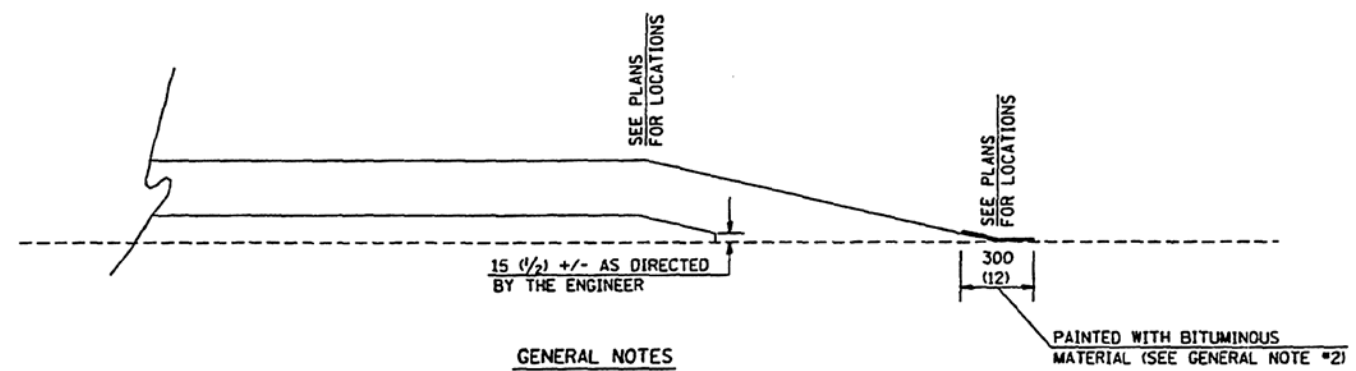

- ### GENERAL NOTES
1. ALL PROPOSED RUNDOWNS SHALL BE UNIFORMLY CONSTRUCTED AS FOLLOWS:  
1:240 (20 FEET PER INCH) OF THICKNESS FOR NON-INTERSTATE IMPROVEMENTS (SEE ARTICLE 406.19)  
1:360 (30 FEET PER INCH) OF THICKNESS FOR INTERSTATE IMPROVEMENTS
  2. ON RESURFACING RUNDOWNS THAT ARE TO REMAIN IN PLACE AFTER COMPLETION OF THE SECTION, THE END OF THE FEATHEREDGE SHALL BE PAINTED WITH A UNIFORM COATING OF AC OR HFE BITUMINOUS MATERIAL APPROVED BY THE ENGINEER AFTER THE RUNDOWN IS COMPLETED. THE BITUMINOUS MATERIAL SHALL BE PAINTED ACROSS THE END OF THE RUNDOWN APPROXIMATELY 300 mm (12 INCHES) WIDE, 150 mm (6 INCHES) ON THE RUNDOWN AND 150 mm (6 INCHES) ON THE PAVEMENT. THE PAINTED STRIP SHALL BE COVERED WITH SAND. THIS WORK WILL NOT BE PAID FOR SEPARATELY, BUT SHALL BE CONSIDERED INCIDENTAL TO THE CONTRACT AND NO ADDITIONAL COMPENSATION WILL BE ALLOWED.

All dimensions are in millimeters (inches) unless otherwise shown.

REVISIONS			
NAME	DATE	NAME	DATE
DESIGNED	J.M.H. 1-92	J.M.H.	1-92
CHECKED	D.L.P. 1-92	D.L.P.	11-94
CADD NO.	X-4.02	C.A.M.	11-95

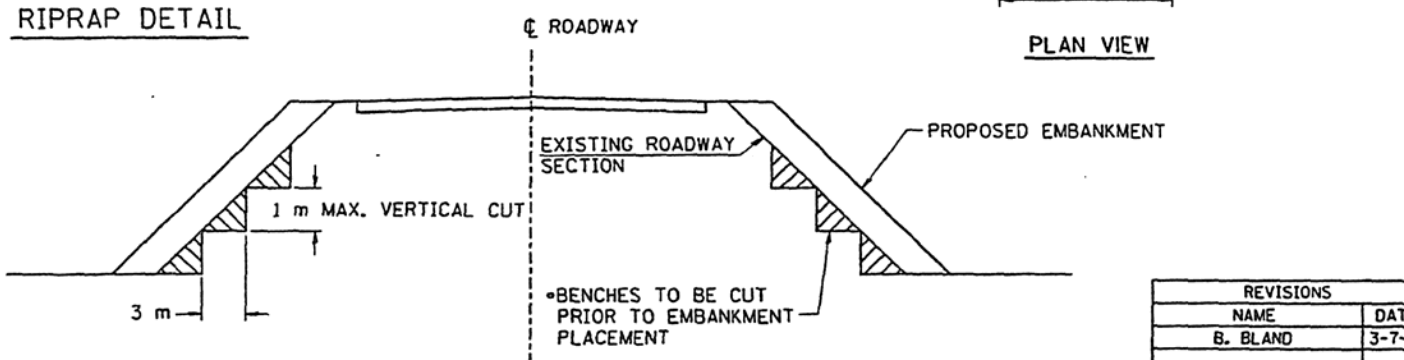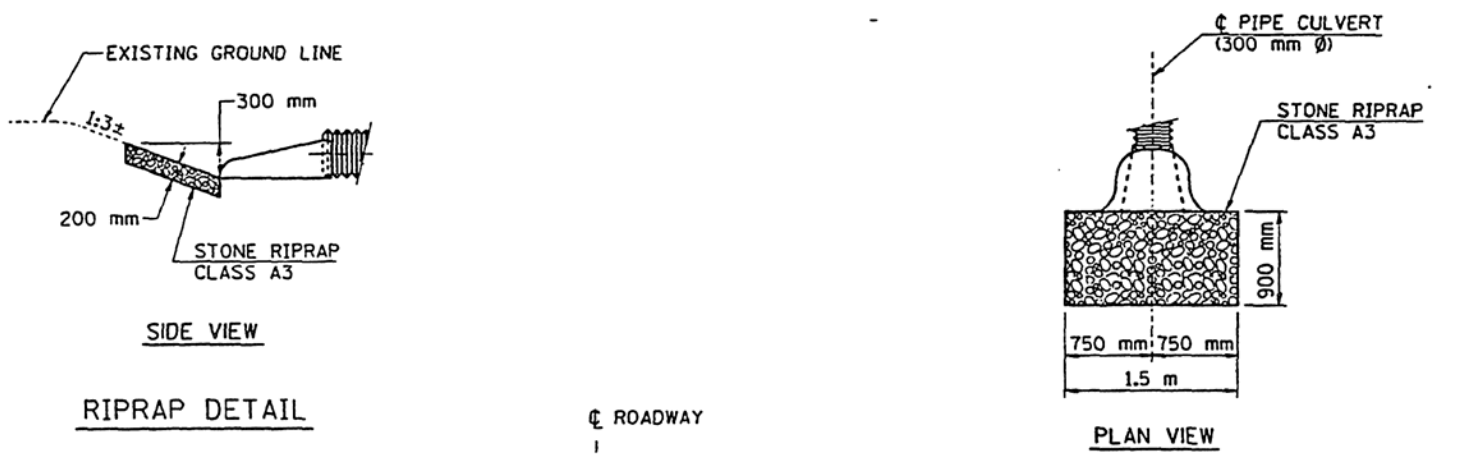

\*COST INCIDENTAL TO CONTRACT

### EXISTING SLOPE BENCHING DETAIL


REVISIONS	
NAME	DATE
B. BLAND	3-7-97

### CONSTRUCTION DETAILS


**LIJ ENGINEERING, LTD.**  
 DESIGNED: R.P.      CHECKED: T.J.M.  
 DRAWN: R.P.         DATE: 2/96



**DETAIL OF INERTIAL BARRIERS**  
(110km/h (70 MPH) DESIGN - 19.5m (64') MEDIAN)

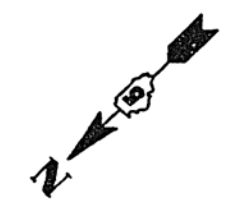


THIS SIDE FOR  
INFORMATION ONLY

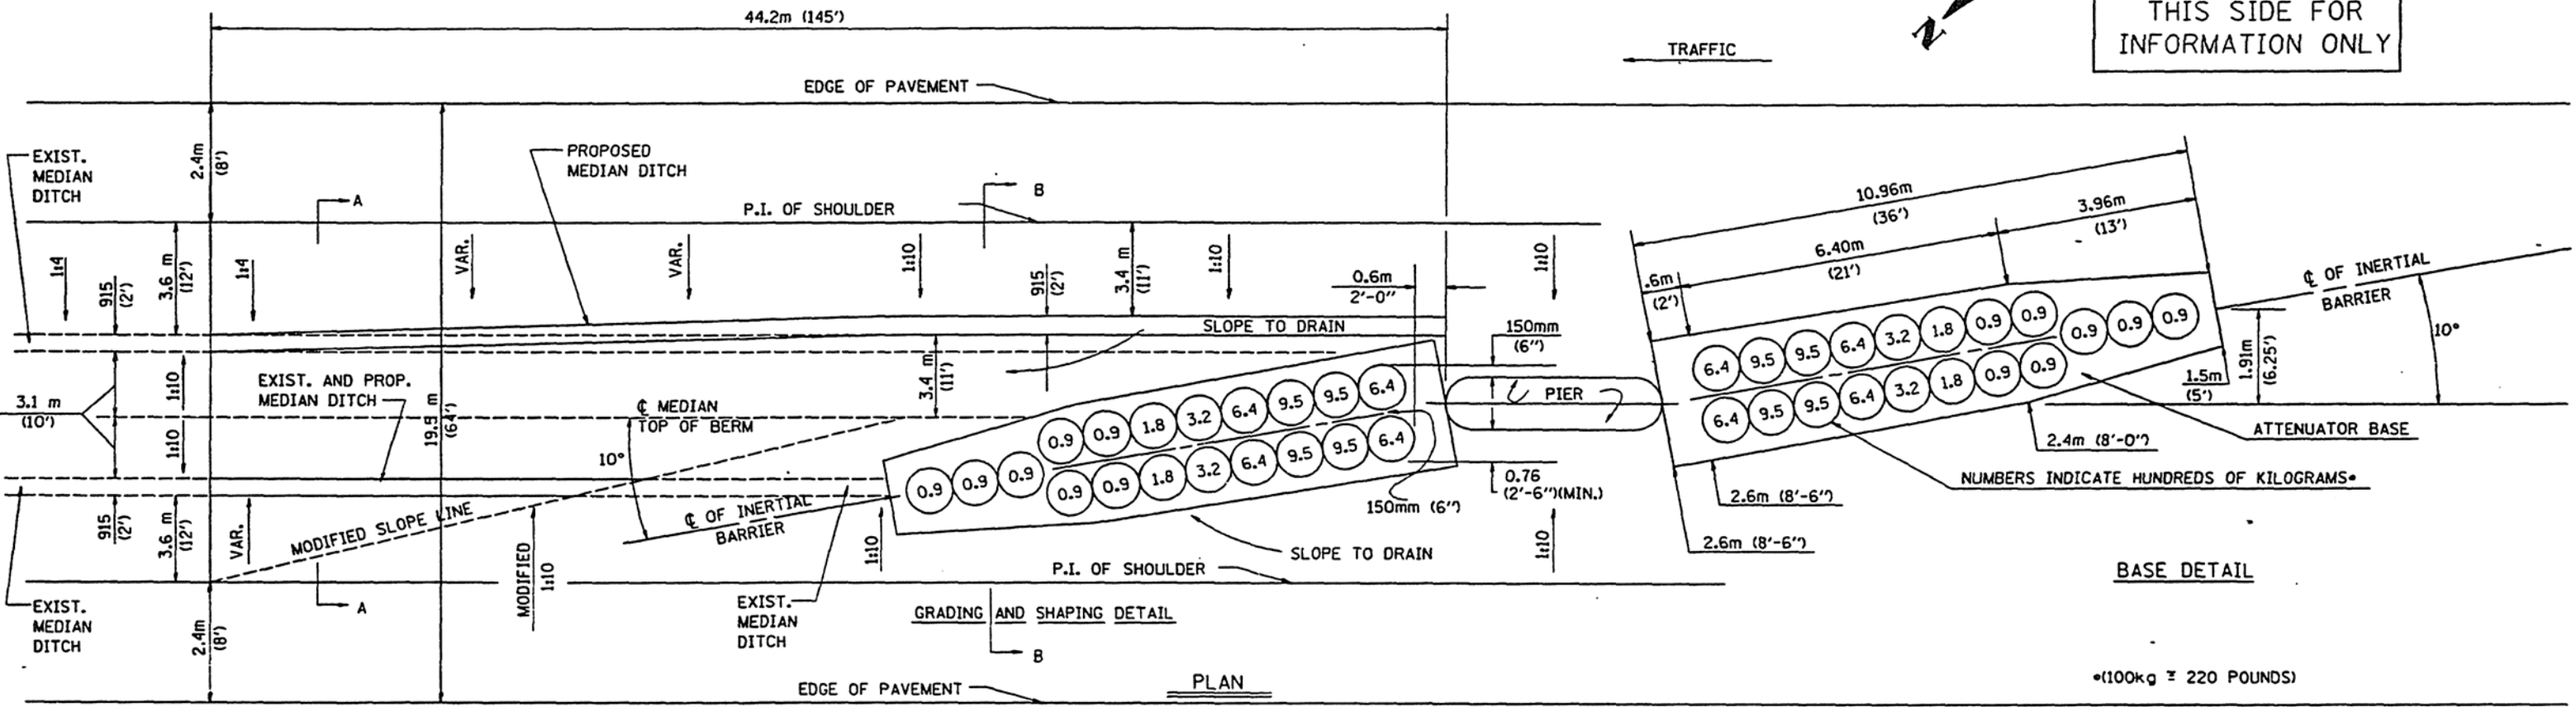

**PLAN**

**BASE DETAIL**

\*100kg ≈ 220 POUNDS

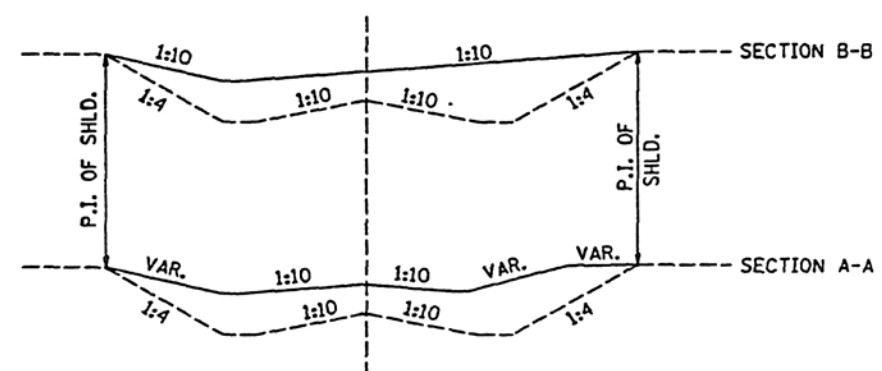


**GENERAL NOTES**

1. ALL 1:10 SLOPES SHOWN ON THIS DETAIL SHALL BE CONSTRUCTED 1:10 OR FLATTER.
2. ANY EXISTING DRAINAGE STRUCTURES LOCATED WITHIN THE 44.2 m (145') WORKING AREA SHALL BE MODIFIED OR LEFT IN PLACE AS SHOWN ON THE PLANS. WHERE THE EXISTING DRAINAGE STRUCTURES ARE TO REMAIN IN PLACE, THE SLOPES ARE TO BE CONSTRUCTED AS SHOWN AS MODIFIED SLOPES ON THIS DETAIL AND AS DIRECTED BY THE ENGINEER.
3. THE SLOPES AS SHOWN ON THIS DETAIL SHALL APPLY TO BOTH ENDS OF THE BRIDGE PIER.
4. 19 MODULES-MASS 7990 kg (17600 LBS.)
5. IN AREAS OF 1:10 SLOPES PRECEDING THE ATTENUATOR IN THE MEDIAN INSTALLATION, 4 WOOD POSTS SHALL BE PLACED AT 1.5 m (15') INTERVALS IN THE MEDIAN C, SEE SPECIAL PROVISIONS.

	NAME	DATE	REVISIONS	
DESIGNED	D.L.P.	3-91	NAME	DATE
CHECKED	F.M.S.	3-91	D.L.P.	6/94
CADD NO.	F-1.51A			

**INERTIAL BARRIER DETAILS**


**LIN ENGINEERING, LTD.**  
DESIGNED: S.M.W. CHECKED: A.W.W.  
DRAWN: R.K.A. DATE: 12/95

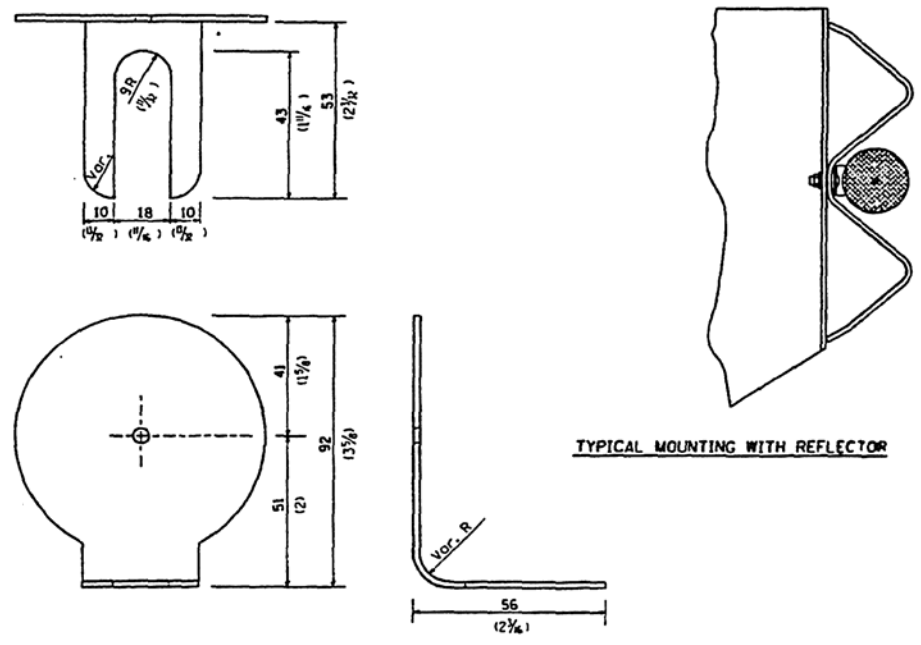

TYPICAL MOUNTING WITH REFLECTOR


**GENERAL NOTES**  
 All dimensions shown are minimum.  
 All dimensions are in millimeters (inches)  
 unless otherwise shown.

**REFLECTOR MARKER TYPE A**

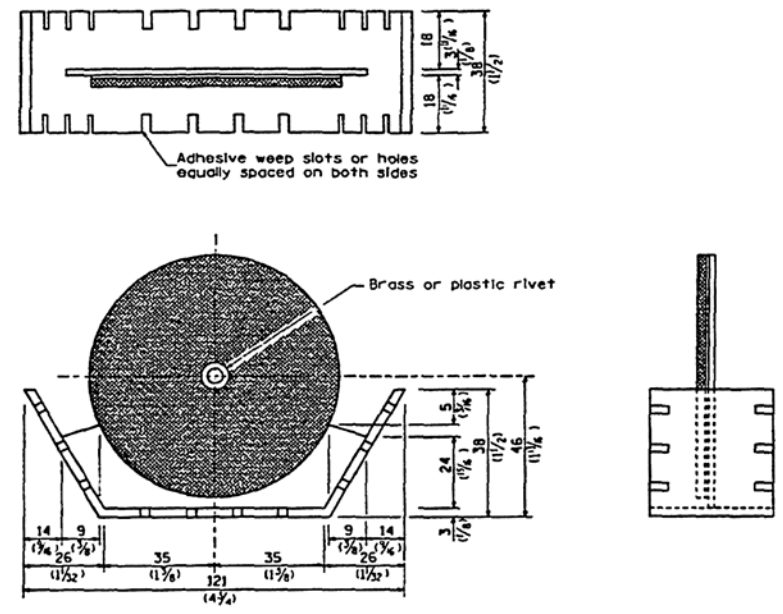


**GENERAL NOTES**  
 All dimensions shown are minimum.  
 All dimensions are in millimeters (inches)  
 unless otherwise shown.

**REFLECTOR MARKER TYPE B**

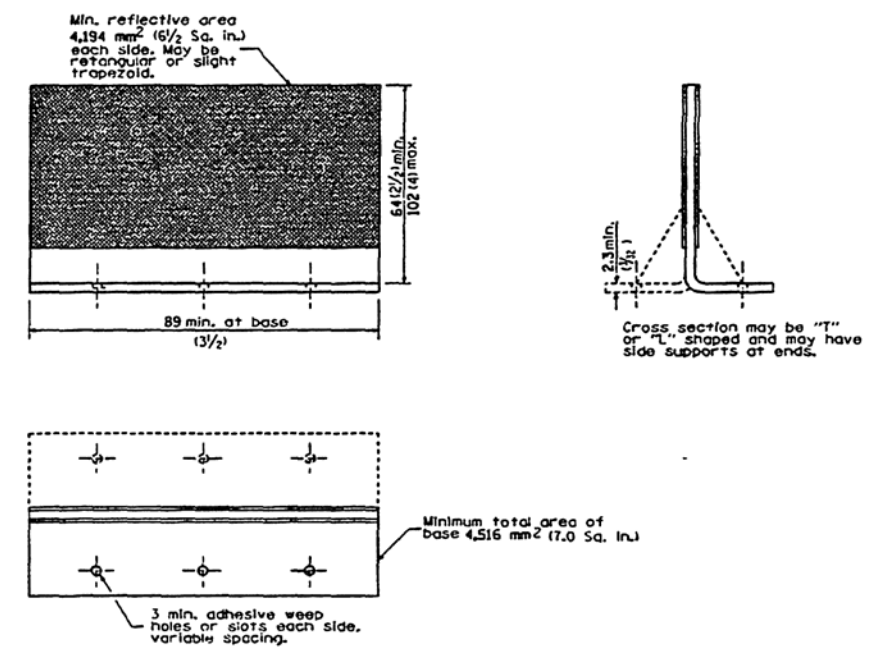

All dimensions are in millimeters (inches)  
 unless otherwise shown.

**REFLECTOR MARKER TYPE C**

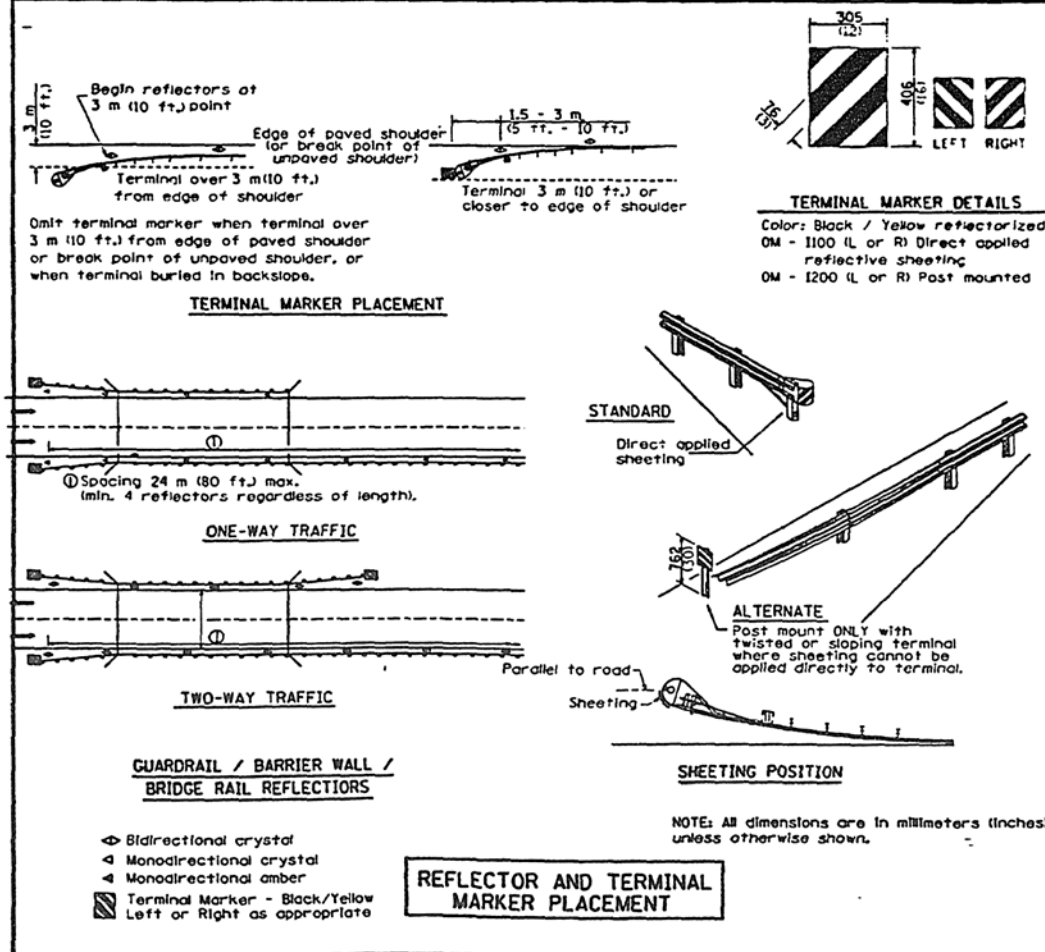


**TERMINAL MARKER DETAILS**  
 Color: Black / Yellow reflectorized  
 OM - 1100 (L or R) Direct applied reflective sheeting  
 OM - 1200 (L or R) Post mounted

NOTE: All dimensions are in millimeters (inches)  
 unless otherwise shown.

**REFLECTOR AND TERMINAL MARKER PLACEMENT**

- ◊ Bidirectional crystal
- ◄ Monodirectional crystal
- ◄ Monodirectional amber
- ◊ Terminal Marker - Black/Yellow
- ◊ Left or Right as appropriate

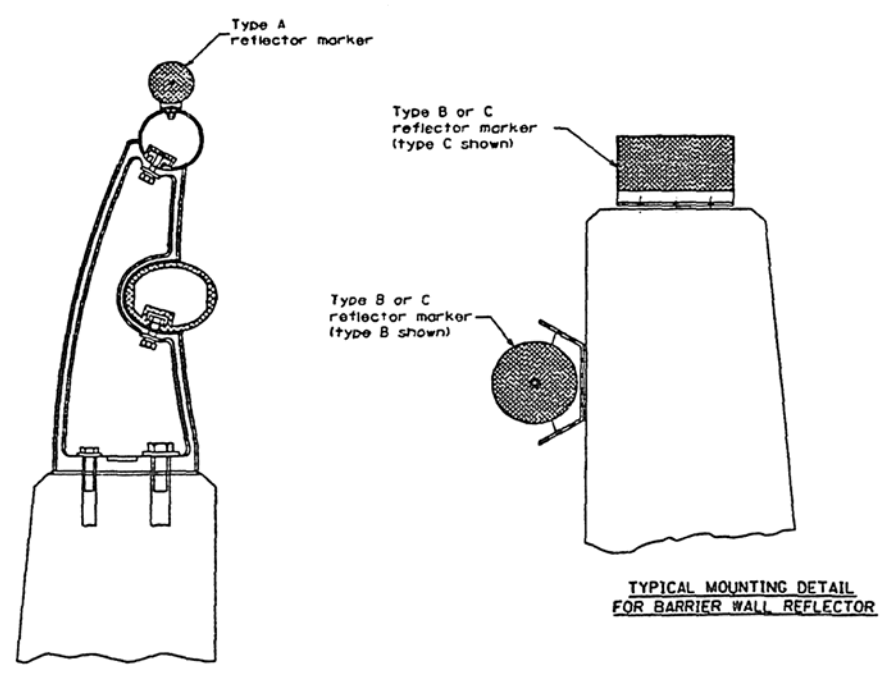

All dimensions are in millimeters (inches)  
 unless otherwise shown.

**REFLECTOR MOUNTING**



B.M. Chisled square on top of abutment N.E. corner of bridge, 4.27 m left of Sta. 4+833.52, Elev. = 241.411 left of Sta. 4+833.52 Elev. = 241.411

**EXISTING STRUCTURE:** The superstructure consists of a R.C. deck 78.11 m long by 10.26 m wide supported on a four span 36 WF 135 girder. Traffic shall be maintained during the rehabilitation of the structure by stage construction. S.N. 010-0050 built as Section (10-34HB)BR in 1964. The removed pipe handrail shall be salvaged and shall remain the property of the Department and stored on site as directed by the Engineer.

Traffic Barrier Terminal Type 6 (Typ.) - Std. 631031


ROUTE NO.	SECTION	COUNTY	TOTAL SHEETS	SHEET NO.
F.A.I. 57	(10-34HB)BR	CHAMPAIGN	47	16

Sheet #1 of 25  
Sheet #1 of 25


**TOTAL BILL OF MATERIAL**

ITEM	UNIT	SUPER	SUB	TOTAL
Concrete Removal	m <sup>3</sup>		20.7	20.7
Removal of Existing Concrete Deck	Each	1		1
Structure Excavation	m <sup>3</sup>		209.8	209.8
Preformed Joint Seal 102 mm	m	25.6		25.6
Concrete Structures	m <sup>3</sup>		177.4	177.4
Concrete Superstructure	m <sup>3</sup>	252.5		252.5
Bridge Deck Grooving	m <sup>2</sup>	936.0		936.0
Protective Coating	m <sup>2</sup>	1115		1115
Elastomeric Bearing Assembly, Type I	Each	16		16
Elastomeric Bearing Assembly, Type II	Each	16		16
Furnishing and Erecting Structural Steel	L. Sum	1		1
Stud Shear Connectors	Each	4856		4856
Jack and Remove Existing Bearings	Each	30		30
Structural Steel Removal	kg	450		450
Cleaning and Painting Steel Bridge	L. Sum	1		1
Reinforcement Bars, Epoxy Coated	kg	35,890	11,690	47,580
Slope Wall 100 mm Epoxy Coated	m <sup>2</sup>	135.1		135.1
Name Plates 50 mm	Each	2	135.1	137.1
Bridge Seat Sealer	m <sup>2</sup>		13.9	13.9
Bar Splicers	Each	724	26	750
Power Tool Cleaning Residue Containment and Disposal	L. Sum	1	26	27
Blasting Residue Containment and Disposal	L. Sum	1		1
Drainage Scupper	Each	2		2
Floor Drains	Each	8		8
Furnishing Concrete Piles	m		73.0	73.0
Driving Concrete Piles	m		73.0	73.0
Test Piles - Concrete	Each		1	1
Temporary Sheet Piling	m <sup>2</sup>		16.3	16.3
Protective Shield	m <sup>2</sup>		714	714

**ELEVATION**

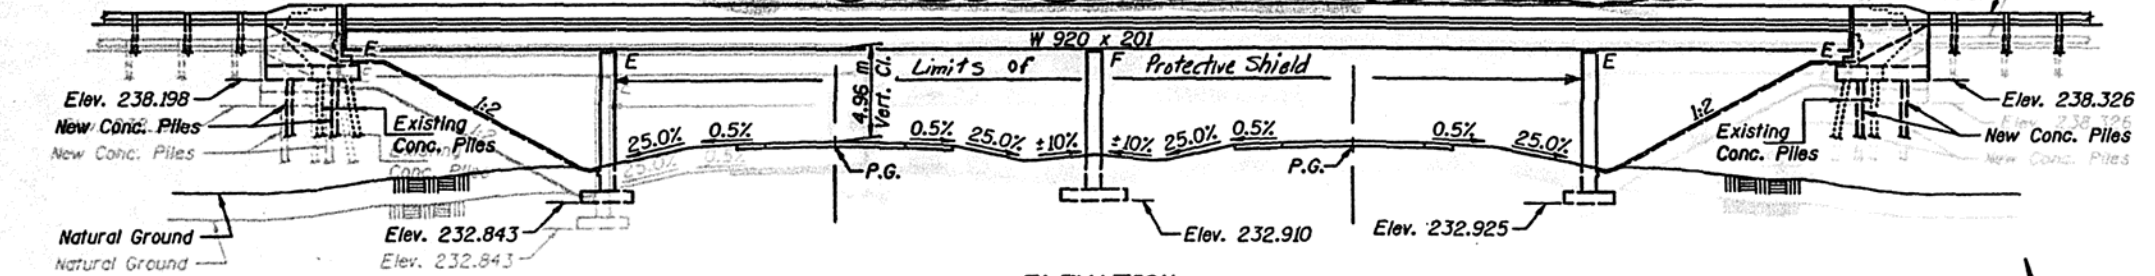

**PLAN**

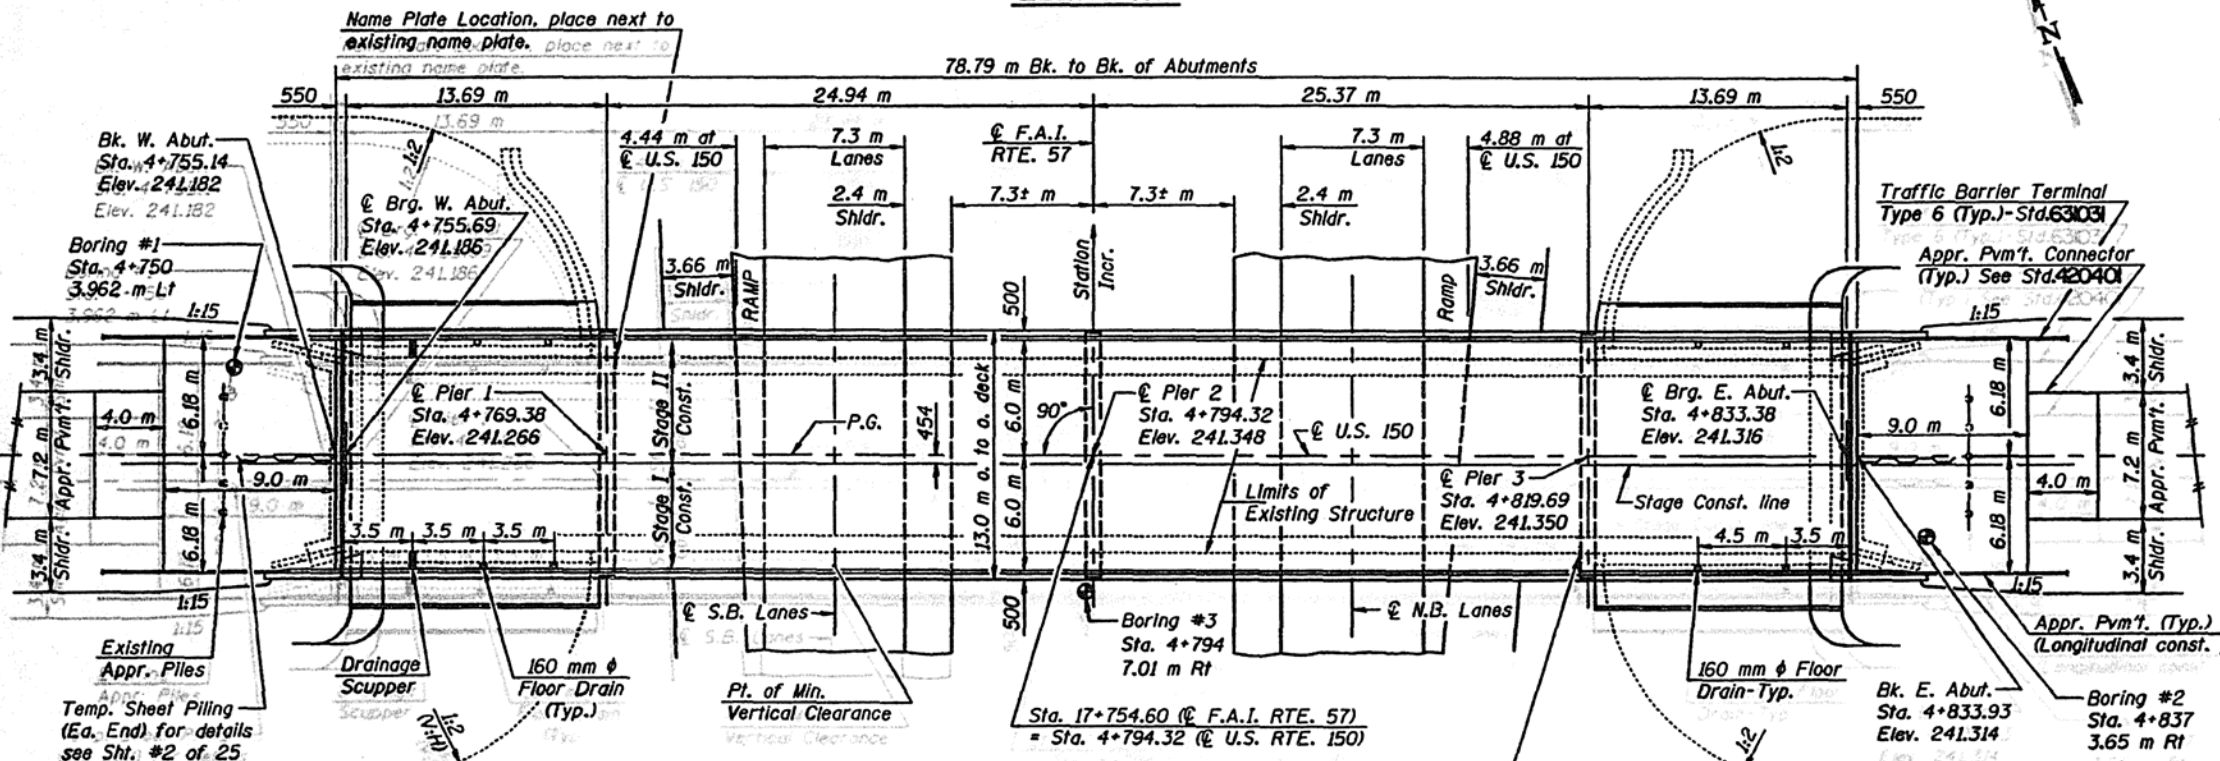

Note: All dimensions are in millimeters (mm) except as noted.

**INDEX OF SHEETS**

1. General Plan & Elevation
2. Stage Construction and Slopewall Details
3. Deck Elevations
4. Deck Elevations
5. Deck Elevations
6. Superstructure
7. Superstructure Details
8. Structural Steel Details
9. Structural Steel Details
10. Bearing Details-Existing Beams
11. Bearing Details-Existing Beams
12. Bearing Details-New Beams
13. Abutment Concrete Removal Details
14. East Abutment Details
15. West Abutment Details
16. Abutment Details
17. Pier Extension-Pier 1 & 3
18. Pier Extension-Pier 2 & 3
19. Temporary Concrete Barrier and Preformed Joint Seal Details
20. Bar Splicer Details
21. Steel Drainage Scupper Details
22. Alternate Cast Iron Drainage Scupper Details
23. Pile Details
24. Anchor Bolt Details
25. Soil Boring Data

**SEISMIC DATA**

Seismic Performance Category (SPC) = A  
Bedrock Acceleration Coefficient (A) = 0.05  
Site Coefficient (S) = 1.0

**DESIGN SPECIFICATIONS**

1992 AASHTO & 1993 Interim & 1994 Interim  
1983 Seismic Retrofitting Guidelines for Highway Bridges  
F.H.W.A./RD-83/007

**LOADING MS18**

Allow 1.2 kN/m<sup>2</sup> for future wearing surface.  
Allow 1.2 kN/m<sup>2</sup> for future wearing surface.

**DESIGN STRESSES**

**NEW CONSTRUCTION**  
f<sub>c</sub> = 24 MPa  
f<sub>s</sub> = 138 MPa (struct. steel)  
f<sub>s</sub> = 400 MPa (reinf.)

**OLD CONSTRUCTION**  
f<sub>c</sub> = 138 MPa (struct. steel)  
f<sub>s</sub> = 138 MPa (reinf.)  
f<sub>s</sub> = 9.65 MPa

**REVISED PLAN SHEETS**

APPROVED FOR STRUCTURAL ADEQUACY ONLY

Paul E. Anderson  
ENGINEER OF DESIGN AND STRUCTURES


STATION 4+794.32  
REBUILT BY  
STATE OF ILLINOIS  
F.A.I. 57 SEC. (10-34HB)BR  
F.A. PROJ. 1M-57-51 1257  
LOADING MS18  
STR. NO. 010-0050

NAME PLATE  
See Std. 5600



Paul B. Fin  
ILLINOIS STRUCTURAL NO. 4419  
DATE 3-12-96



**GENERAL PLAN & ELEVATION**  
U.S. RTE. 150 (BLOOMINGTON RD.)  
OVER F.A.I. RTE. 57  
SECTION (10-34HB)BR  
STA. 4+794.32 (U.S. RTE. 150)  
STA. 17+754.60 (F.A.I. RTE. 57)  
CHAMPAIGN COUNTY  
S.N. 010-0050

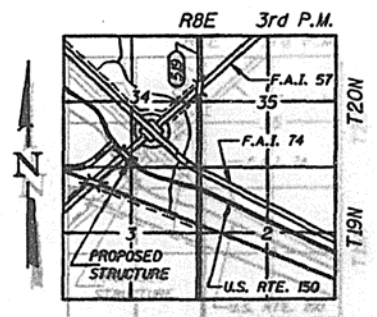

**LOCATION SKETCH**

**LIN ENGINEERING, LTD.**  
DESIGN T.M.M.  
DRAWN H.C.  
CHECKED J.W.  
DATE 12/95

REVISIONS	NAME	DATE
B. BLAND		2-20-97
B. BLAND		2-20-97

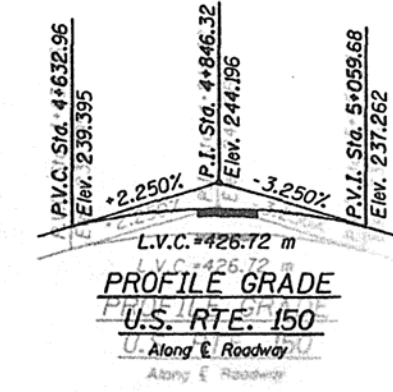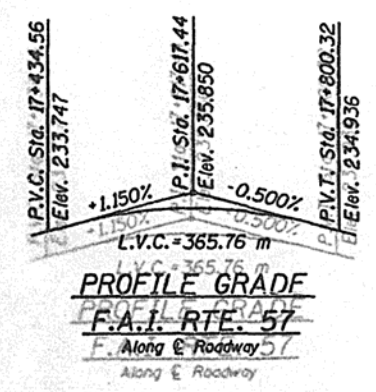



**GENERAL NOTES**

Fasteners shall be high strength bolts (AASHTO M164M). Bolts M20, open holes 22 mm  $\phi$ , unless otherwise noted. Calculated weight of Structural Steel = 320 kg.

Field welding of construction accessories will not be permitted to the bottom flange of beams or girders nor to the top flange for a distance equal to one-fourth the span length each way from the pier supports. Field welding in other areas will be permitted only when approved by the Engineer. Reinforcement bars shall conform to the requirements of AASHTO M-31M, M-42M or M-53M Grade 400.

Slope wall shall be reinforced with welded wire fabric, 152 x 152 - MW25.8 x MW25.8, weighing 2.91 Kg per sq. m.

Plan dimensions and details relative to existing structure have been taken from existing plans and are subject to nominal construction variations. It shall be the Contractor's responsibility to verify such dimensions and details in the field and make necessary approved adjustments prior to construction or ordering of materials. Such variations shall not be cause for additional compensation for a change in the scope of the work, however, the Contractor will be paid for the quantity actually furnished at the unit price bid for the work.

Bearing pad surfaces shall be constructed or adjusted to the designated elevations within a tolerance of 3 mm. Adjustment shall be made either by grinding the surface or by shimming the bearing. Two 3 mm adjusting shims, of the dimension of the bottom bearing plate, shall be provided for each bearing in addition to all other plates or shims. (For Type I Elastomeric Bearings, shims of the dimensions of top plate shall be provided and placed as detailed.)

Bridge Seat Sealer shall be applied to the new concrete pedestals only.

Cleaning and painting of the existing structural steel shall be as specified in the Special Provision for "Cleaning and Painting Existing Steel Structures". All existing structural steel within 1.5 m of either side of expansion joints shall be cleaned by Method 1. The exterior and the bottom flange of the fascia beams shall be cleaned by Method 3. All remaining existing structural steel shall be cleaned by Method 2. The aluminum epoxy mastic / acrylic paint system shall be used for painting of the existing structural steel. The color of the final finish coat for all interior steel surfaces shall be light gray, Munsell No. 5B 7/1.


The inorganic zinc rich primer / Acrylic / Acrylic Paint System shall be used for shop and field painting of new structural steel except where otherwise noted. The color of the final finish coat for all interior steel surfaces shall be light gray, Munsell No. 5B 7/1. The color of the final finish coat for the exterior and bottom flange of the fascia beams shall be Interstate Green, Munsell No. 7.5G 4/8. See Special Provision for "Cleaning and Painting New Metal Structures".

The main load carrying member components subject to tensile stress shall conform to the Supplemental Requirements for Notch Toughness Zone 2. These components are the wide flange beams, cover plates, and all splice plate material except fill plates (New Beams).

The contractor shall drive one test pile in a permanent location at west abutment as directed by the Engineer before ordering the remainder of piles. All dimensions are in millimeters (mm) except as noted. Anchor Bolts shall be set before bolting Diaphragms over the supports. The pay width of the Protective Shield shall be 0.6 m beyond the outside edges of the existing deck.

ROUTE NO.	SECTION	COUNTY	TOTAL SHEETS	SHEET NO.
F.A.I.-57	(10-34HB)BR	CHAMPAIGN	47	17

Sheet #2 of 25

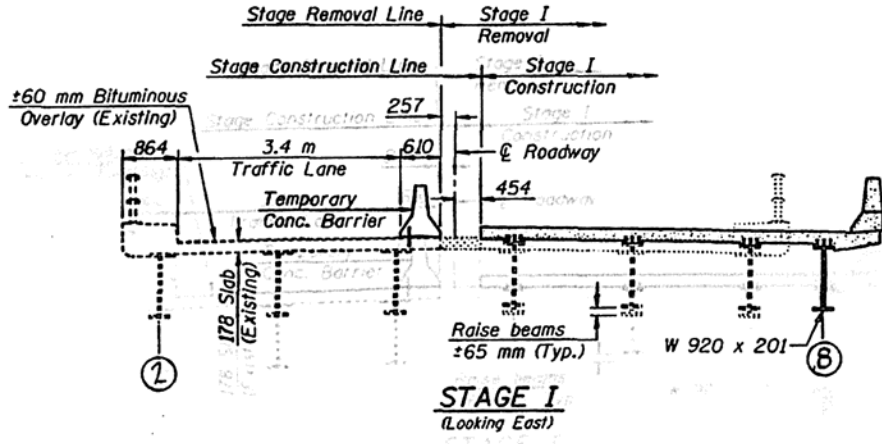

**STAGE I CONSTRUCTION**

1. Place temporary concrete barrier and shift traffic to locations as shown above.
2. Remove deck, parapet and rails as shown above. Remove existing approach pavement as is shown on the traffic control plans and drive temporary sheet piling.
- 2A. Disconnect diaphragms between beams 4 & 5. See Step 3.
4. Jack existing beams (150 mm max.), in accordance with instructions on Sht. #11 of 25, and remove existing bearings.
5. Remove abutment backwall and wings.
6. Build abutment and pier extensions, including concrete pads.
7. Allow concrete pads to cure.
8. Widen existing slopewalls.
9. Install new bearings for existing beams at abutments and piers and lower beams onto new bearings.
10. Erect new beam and bearings at abutment and piers.
11. Construct stage I bridge deck, parapet and approach pavement.


Prior to pouring the new concrete for the deck, all loose rust, loose mill scale, and all other loose, detrimental foreign material shall be removed from the portions of the flanges of stringers in contact with concrete. The removal shall be accomplished in accordance with the requirements of the SSPC Surface Preparation Specifications SP-3 for power tool cleaning or SP-2 for hand tool cleaning. Cost shall be included with "Removal of Existing Concrete Deck".

The existing structural steel coating contains lead. The Contractor should take appropriate precautions to deal with the presence of lead on this project.

NOTE: For pay item "Temporary Concrete Barrier" see traffic control plans.




Work this sheet with sheet # 11 of 25.

3. Prior to jacking of existing diaphragms, the following shall be done:
  - a) Remove existing rivets connecting angle A to the existing beams.
  - b) Reconnect angle A to the existing beams with new M20 H.S. bolts.
  - c) Cost included with "Jack and Remove Existing Bearings".

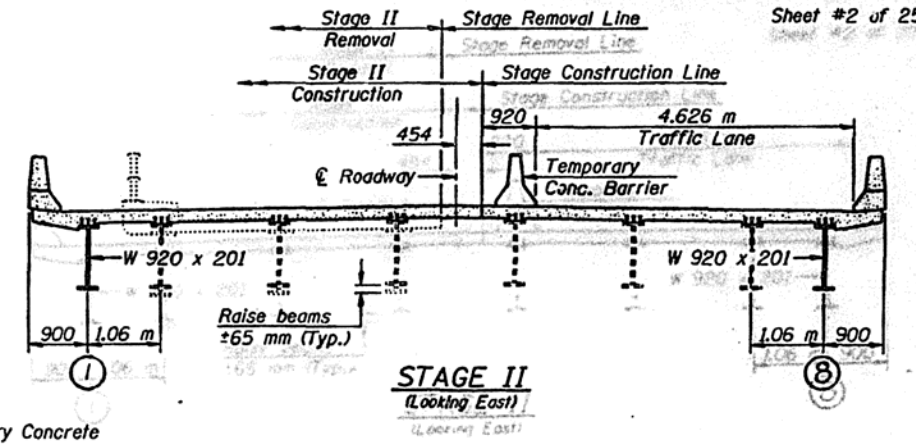


**STAGE II CONSTRUCTION**

1. Place temporary concrete barrier and shift traffic to locations as shown above.
2. Remove remainder of existing deck, parapet, rails and approach pavements. See Step 3.
- 3a. Jack existing beams (150 mm max.), in accordance with instructions on Sht. #11 of 25, and remove existing bearings.
4. Remove abutment backwall and wings.
5. Build abutment and pier extensions, including concrete pads.
6. Allow concrete pads to cure.
7. Widen existing slopewalls.
8. Install new bearings for existing beams at abutments and piers and lower beams onto new bearings.
9. Reconnect existing diaphragms between beams 4 & 5.
10. Erect new beam and bearings at abutments and piers.
11. Construct stage II bridge deck, parapet and approach pavement.

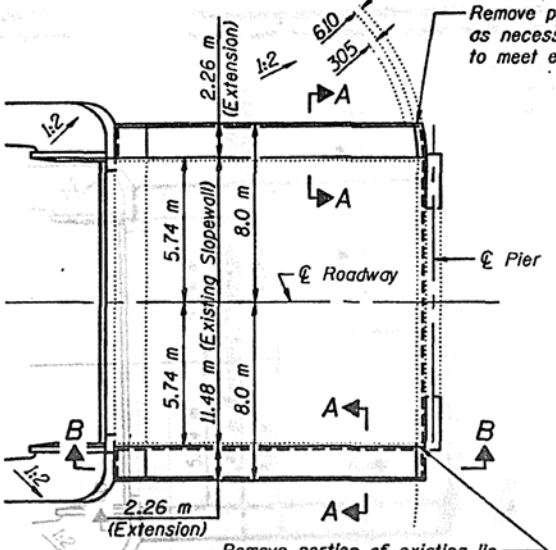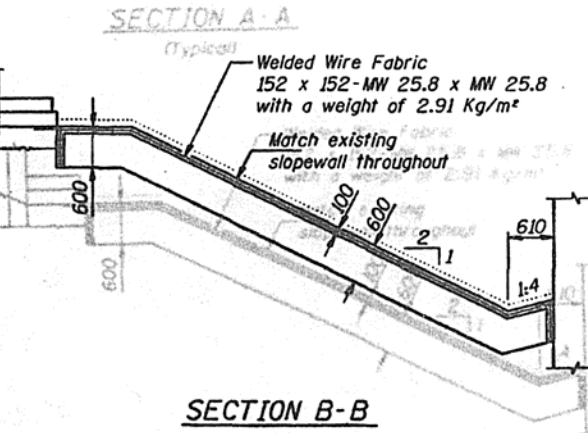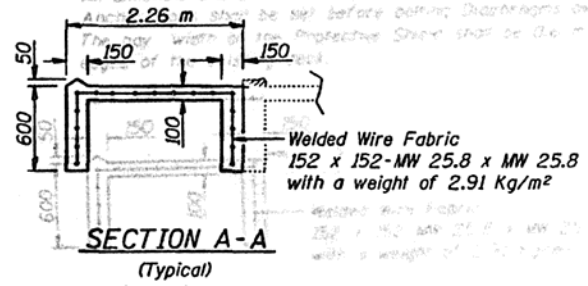

**SLOPEWALL EXTENSION**

West Abutment Shown  
East Abutment-Opposite Hand

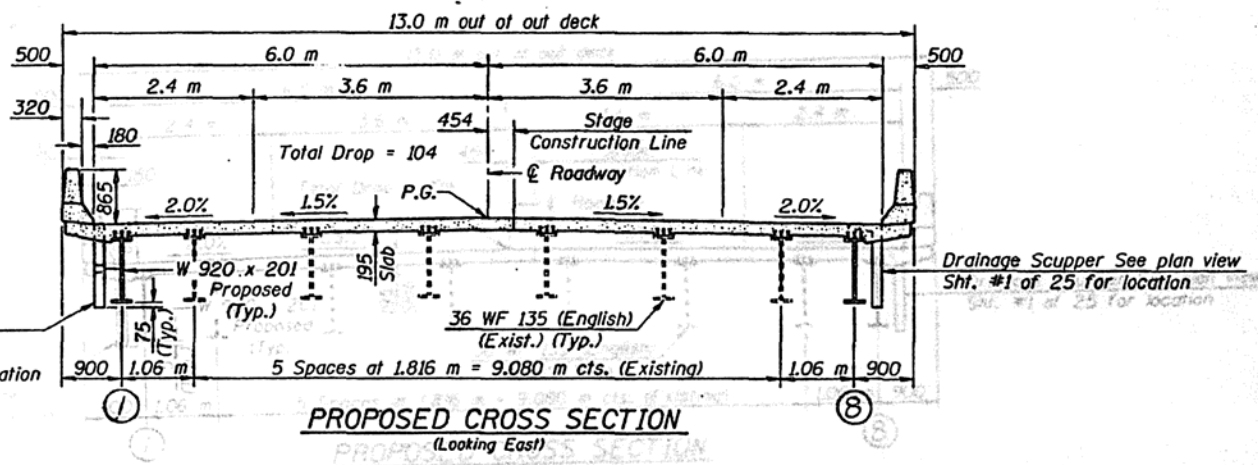


**PROPOSED CROSS SECTION (Looking East)**

NOTE: If the Contractor chooses to alter the temporary cantilevered sheet piling design requirements shown on the plans for lesser design requirements, then full design submittals with the required seals will be expected by the Department for review and approval.

Req'd. Embedment = 1.4 m  
Req'd. Sec. Mod. = 80.659 mm<sup>3</sup> per m

NOTE: Any sheets not reaching their required embedment due to the abutment footing must be restrained by developing an attachment to the existing abutment backwall. This attachment shall be approved by the Engineer.

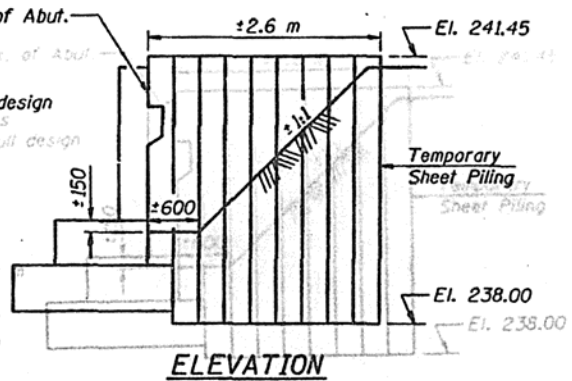


**ELEVATION**

TEMPORARY SHEET PILING - EA. ABUT.  
TEMPORARY SHEET PILING - EA. ABUT.


**STAGE CONSTRUCTION AND SLOPEWALL DETAILS**  
U.S. RTE. 150 (BLOOMINGTON RD.)  
OVER F.A.I. RTE. 57  
SECTION (10-34HB)BR  
STA. 4+794.32 (U.S. RTE. 150)  
STA. 17+754.60 (F.A.I. RTE. 57)  
CHAMPAIGN COUNTY  
S.N. 010-0050

<b>LIN ENGINEERING, LTD.</b>	
DESIGN J.W.	CHECKED T.M.M.
DRAWN J.C.	DATE: 12/95



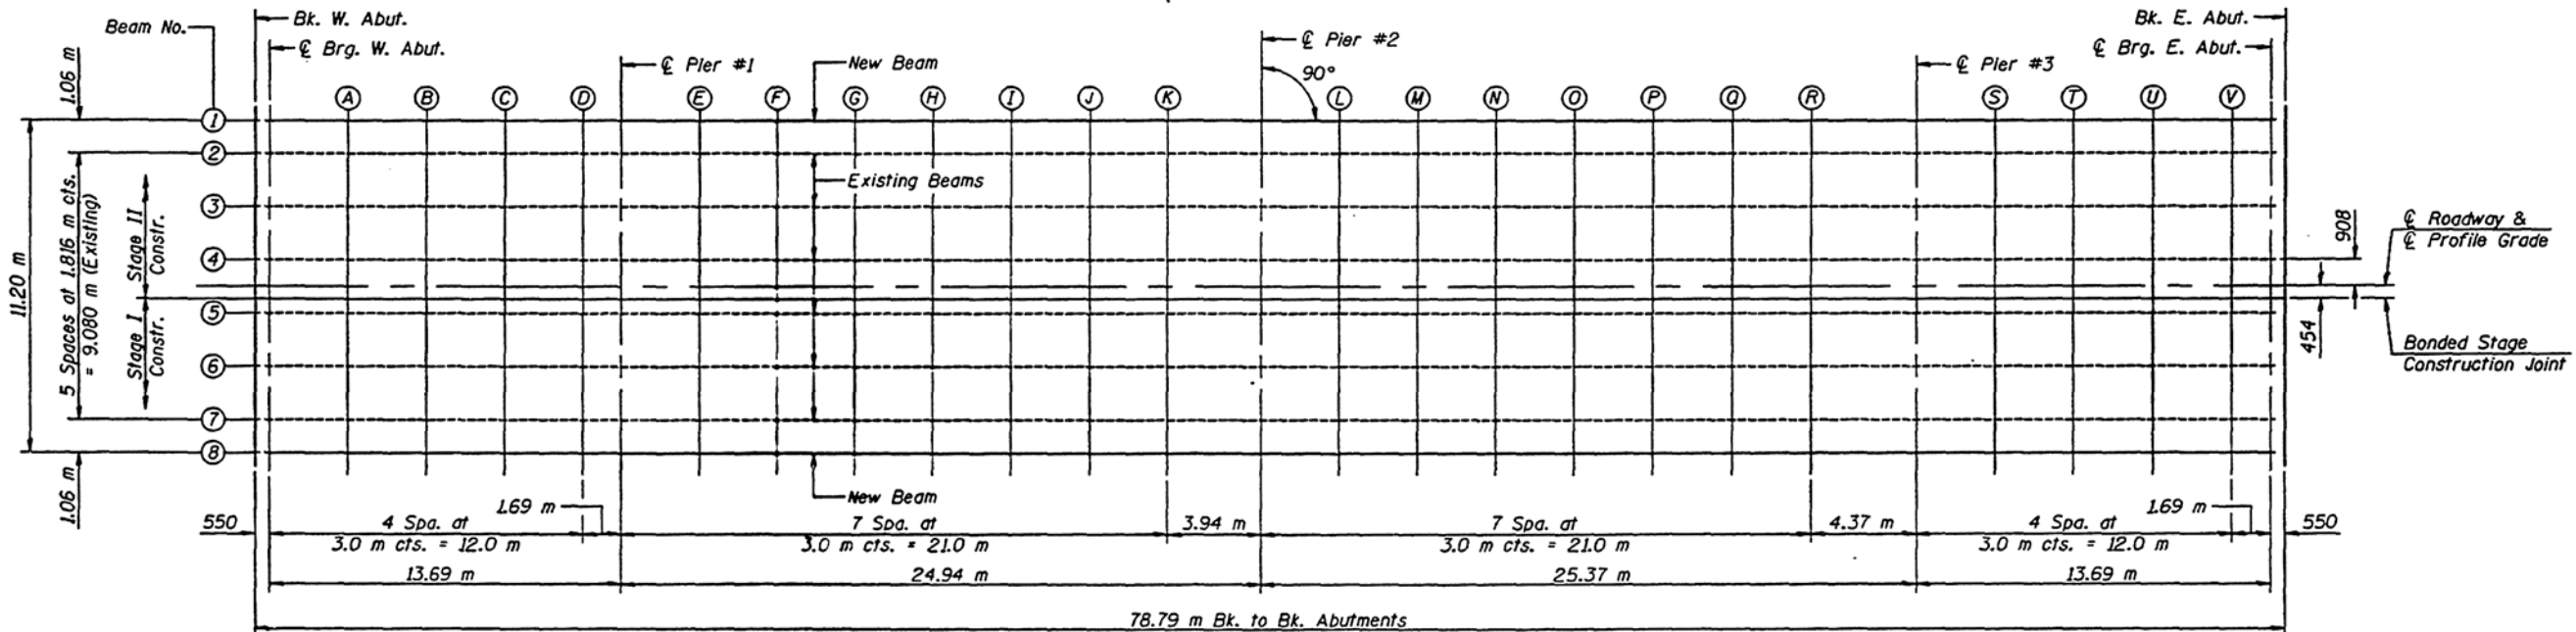


PLAN

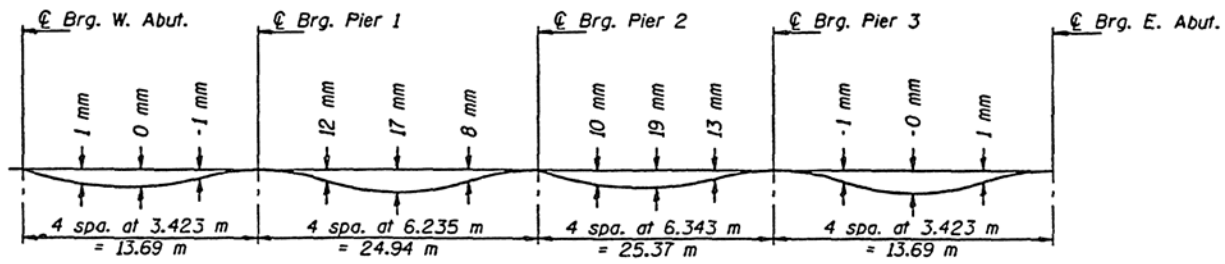

DEAD LOAD DEFLECTION DIAGRAM

(Includes weight of concrete only)

Note: The above deflections are not to be used in the field if the engineer is working from the grade elevations adjusted for dead load deflections as shown on Sheet #4 & #5 of 25.

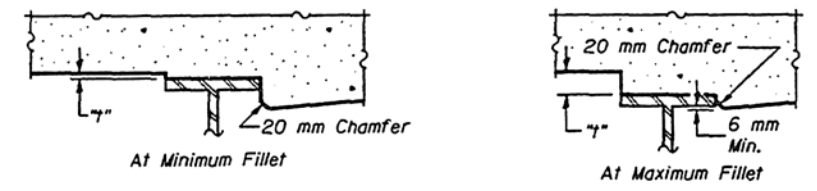

To determine "f": After all structural steel has been erected, elevations of the top flanges of the beams shall be taken at intervals shown below. These elevations subtracted from the "Theoretical Grade Elevations Adjusted for Dead Load Deflection" shown below, minus slab thickness, equals the fillet heights "f" above top flange of beams.

FILLET HEIGHTS

**DECK ELEVATIONS**  
**U.S. ROUTE 150 (BLOOMINGTON RD.)**  
**OVER F.A.I. RTE. 57**  
**SECTION (10-34HB)BR**  
**STA. 4+794.32 (U.S. RTE. 150)**  
**STA. 17+754.60 (F.A.I. RTE. 57)**  
**CHAMPAIGN COUNTY**  
**S.N. 010-0050**

**BEAM #1**

Location	Station	Offset (m)	Theoretical Grade Elevations	Theoretical Grade Elevations Adjusted For Dead Load Deflection
Bk. West Abut.	4+755.140	-5.600	241.088	241.088
€ Brg. West Abut.	4+755.690	-5.600	241.092	241.092
A	4+758.690	-5.600	241.112	241.112
B	4+761.690	-5.600	241.130	241.130
C	4+764.690	-5.600	241.147	241.147
D	4+767.690	-5.600	241.163	241.162
€ Pier 1	4+769.380	-5.600	241.172	241.172
E	4+772.380	-5.600	241.186	241.191
F	4+775.380	-5.600	241.199	241.210
G	4+778.380	-5.600	241.211	241.226
H	4+781.380	-5.600	241.221	241.238
I	4+784.380	-5.600	241.231	241.246
J	4+787.380	-5.600	241.239	241.249
K	4+790.380	-5.600	241.246	241.250
€ Pier 2	4+794.320	-5.600	241.254	241.254
L	4+797.320	-5.600	241.259	241.261
M	4+800.320	-5.600	241.262	241.271
N	4+803.320	-5.600	241.264	241.279
O	4+806.320	-5.600	241.265	241.284
P	4+809.320	-5.600	241.265	241.284
Q	4+812.320	-5.600	241.264	241.279
R	4+815.320	-5.600	241.261	241.270
€ Pier 3	4+819.690	-5.600	241.256	241.256
S	4+822.690	-5.600	241.250	241.249
T	4+825.690	-5.600	241.244	241.244
U	4+828.690	-5.600	241.236	241.237
V	4+831.690	-5.600	241.228	241.228
€ Brg. East Abut.	4+833.380	-5.600	241.222	241.222
Bk. East Abut.	4+833.930	-5.600	241.220	241.220

**BEAM #2**

Location	Station	Offset (m)	Theoretical Grade Elevations	Theoretical Grade Elevations Adjusted For Dead Load Deflection
Bk. West Abut.	4+755.140	-4.540	241.110	241.110
€ Brg. West Abut.	4+755.690	-4.540	241.113	241.113
A	4+758.690	-4.540	241.133	241.133
B	4+761.690	-4.540	241.151	241.152
C	4+764.690	-4.540	241.168	241.168
D	4+767.690	-4.540	241.184	241.183
€ Pier 1	4+769.380	-4.540	241.193	241.193
E	4+772.380	-4.540	241.207	241.212
F	4+775.380	-4.540	241.220	241.231
G	4+778.380	-4.540	241.232	241.248
H	4+781.380	-4.540	241.242	241.260
I	4+784.380	-4.540	241.252	241.267
J	4+787.380	-4.540	241.260	241.270
K	4+790.380	-4.540	241.268	241.271
€ Pier 2	4+794.320	-4.540	241.275	241.275
L	4+797.320	-4.540	241.280	241.282
M	4+800.320	-4.540	241.283	241.292
N	4+803.320	-4.540	241.285	241.301
O	4+806.320	-4.540	241.286	241.305
P	4+809.320	-4.540	241.286	241.305
Q	4+812.320	-4.540	241.285	241.300
R	4+815.320	-4.540	241.283	241.291
€ Pier 3	4+819.690	-4.540	241.277	241.277
S	4+822.690	-4.540	241.272	241.270
T	4+825.690	-4.540	241.265	241.265
U	4+828.690	-4.540	241.258	241.258
V	4+831.690	-4.540	241.249	241.249
€ Brg. East Abut.	4+833.380	-4.540	241.243	241.243
Bk. East Abut.	4+833.930	-4.540	241.242	241.242

**BEAM #3**

Location	Station	Offset (m)	Theoretical Grade Elevations	Theoretical Grade Elevations Adjusted For Dead Load Deflection
Bk. West Abut.	4+755.140	-2.724	241.142	241.142
€ Brg. West Abut.	4+755.690	-2.724	241.145	241.145
A	4+758.690	-2.724	241.165	241.165
B	4+761.690	-2.724	241.183	241.184
C	4+764.690	-2.724	241.200	241.200
D	4+767.690	-2.724	241.216	241.215
€ Pier 1	4+769.380	-2.724	241.225	241.225
E	4+772.380	-2.724	241.239	241.244
F	4+775.380	-2.724	241.252	241.263
G	4+778.380	-2.724	241.264	241.279
H	4+781.380	-2.724	241.274	241.292
I	4+784.380	-2.724	241.284	241.299
J	4+787.380	-2.724	241.292	241.302
K	4+790.380	-2.724	241.299	241.303
€ Pier 2	4+794.320	-2.724	241.307	241.307
L	4+797.320	-2.724	241.312	241.314
M	4+800.320	-2.724	241.315	241.324
N	4+803.320	-2.724	241.317	241.333
O	4+806.320	-2.724	241.318	241.337
P	4+809.320	-2.724	241.318	241.337
Q	4+812.320	-2.724	241.317	241.332
R	4+815.320	-2.724	241.315	241.323
€ Pier 3	4+819.690	-2.724	241.309	241.309
S	4+822.690	-2.724	241.304	241.302
T	4+825.690	-2.724	241.297	241.297
U	4+828.690	-2.724	241.290	241.290
V	4+831.690	-2.724	241.281	241.281
€ Brg. East Abut.	4+833.380	-2.724	241.275	241.275
Bk. East Abut.	4+833.930	-2.724	241.273	241.273

**BEAM #4**

Location	Station	Offset (m)	Theoretical Grade Elevations	Theoretical Grade Elevations Adjusted For Dead Load Deflection
Bk. West Abut.	4+755.140	-0.908	241.169	241.169
€ Brg. West Abut.	4+755.690	-0.908	241.172	241.172
A	4+758.690	-0.908	241.192	241.193
B	4+761.690	-0.908	241.210	241.211
C	4+764.690	-0.908	241.227	241.227
D	4+767.690	-0.908	241.243	241.242
€ Pier 1	4+769.380	-0.908	241.252	241.252
E	4+772.380	-0.908	241.266	241.271
F	4+775.380	-0.908	241.279	241.290
G	4+778.380	-0.908	241.291	241.307
H	4+781.380	-0.908	241.302	241.319
I	4+784.380	-0.908	241.311	241.326
J	4+787.380	-0.908	241.320	241.329
K	4+790.380	-0.908	241.327	241.330
€ Pier 2	4+794.320	-0.908	241.334	241.334
L	4+797.320	-0.908	241.339	241.342
M	4+800.320	-0.908	241.342	241.351
N	4+803.320	-0.908	241.345	241.360
O	4+806.320	-0.908	241.346	241.365
P	4+809.320	-0.908	241.345	241.364
Q	4+812.320	-0.908	241.344	241.359
R	4+815.320	-0.908	241.342	241.350
€ Pier 3	4+819.690	-0.908	241.336	241.336
S	4+822.690	-0.908	241.331	241.330
T	4+825.690	-0.908	241.324	241.324
U	4+828.690	-0.908	241.317	241.317
V	4+831.690	-0.908	241.308	241.308
€ Brg. East Abut.	4+833.380	-0.908	241.303	241.303
Bk. East Abut.	4+833.930	-0.908	241.301	241.301

**€ ROADWAY & PROFILE GRADE**

Location	Station	Offset (m)	Theoretical Grade Elevations	Theoretical Grade Elevations Adjusted For Dead Load Deflection
Bk. West Abut.	4+755.140	0.000	241.182	241.182
€ Brg. West Abut.	4+755.690	0.000	241.186	241.186
A	4+758.690	0.000	241.206	241.206
B	4+761.690	0.000	241.224	241.224
C	4+764.690	0.000	241.241	241.241
D	4+767.690	0.000	241.257	241.256
€ Pier 1	4+769.380	0.000	241.266	241.266
E	4+772.380	0.000	241.280	241.285
F	4+775.380	0.000	241.293	241.304
G	4+778.380	0.000	241.305	241.320
H	4+781.380	0.000	241.315	241.332
I	4+784.380	0.000	241.325	241.340
J	4+787.380	0.000	241.333	241.343
K	4+790.380	0.000	241.340	241.344
€ Pier 2	4+794.320	0.000	241.348	241.348
L	4+797.320	0.000	241.353	241.355
M	4+800.320	0.000	241.356	241.365
N	4+803.320	0.000	241.358	241.373
O	4+806.320	0.000	241.359	241.378
P	4+809.320	0.000	241.359	241.378
Q	4+812.320	0.000	241.358	241.373
R	4+815.320	0.000	241.355	241.364
€ Pier 3	4+819.690	0.000	241.350	241.350
S	4+822.690	0.000	241.344	241.343
T	4+825.690	0.000	241.338	241.338
U	4+828.690	0.000	241.330	241.331
V	4+831.690	0.000	241.322	241.322
€ Brg. East Abut.	4+833.380	0.000	241.316	241.316
Bk. East Abut.	4+833.930	0.000	241.314	241.314

DECK ELEVATIONS  
U.S. ROUTE 150 (BLOOMINGTON RD.)  
OVER F.A.I. RTE. 57  
SECTION (10-34HB)BR  
STA. 4+794.32 (U.S. RTE. 150)  
STA. 17+754.60 (F.A.I. RTE. 57)  
CHAMPAIGN COUNTY  
S.N. 010-0050

LIN ENGINEERING, LTD.

DESIGN: T.M.M. CHECKED: J.W.  
DRAWN: N.C. DATE: 12/95



**STAGE CONSTRUCTION**

Location	Station	Offset (m)	Theoretical Grade Elevations	Theoretical Grade Elevations Adjusted For Dead Load Deflection
Bk. West Abut.	4+755.140	0.454	241.176	241.176
⊕ Brg. West Abut.	4+755.690	0.454	241.179	241.179
A	4+758.690	0.454	241.199	241.199
B	4+761.690	0.454	241.217	241.218
C	4+764.690	0.454	241.234	241.234
D	4+767.690	0.454	241.250	241.249
⊕ Pier 1	4+769.380	0.454	241.259	241.259
E	4+772.380	0.454	241.273	241.278
F	4+775.380	0.454	241.286	241.297
G	4+778.380	0.454	241.298	241.314
H	4+781.380	0.454	241.308	241.326
I	4+784.380	0.454	241.318	241.333
J	4+787.380	0.454	241.326	241.336
K	4+790.380	0.454	241.334	241.337
⊕ Pier 2	4+794.320	0.454	241.341	241.341
L	4+797.320	0.454	241.346	241.348
M	4+800.320	0.454	241.349	241.358
N	4+803.320	0.454	241.351	241.367
O	4+806.320	0.454	241.352	241.371
P	4+809.320	0.454	241.352	241.371
Q	4+812.320	0.454	241.351	241.366
R	4+815.320	0.454	241.349	241.357
⊕ Pier 3	4+819.690	0.454	241.343	241.343
S	4+822.690	0.454	241.338	241.336
T	4+825.690	0.454	241.331	241.331
U	4+828.690	0.454	241.324	241.324
V	4+831.690	0.454	241.315	241.315
⊕ Brg. East Abut.	4+833.380	0.454	241.309	241.309
Bk. East Abut.	4+833.930	0.454	241.308	241.308

**BEAM #5**

Location	Station	Offset (m)	Theoretical Grade Elevations	Theoretical Grade Elevations Adjusted For Dead Load Deflection
Bk. West Abut.	4+755.140	0.908	241.169	241.169
⊕ Brg. West Abut.	4+755.690	0.908	241.172	241.172
A	4+758.690	0.908	241.192	241.193
B	4+761.690	0.908	241.210	241.211
C	4+764.690	0.908	241.227	241.227
D	4+767.690	0.908	241.243	241.242
⊕ Pier 1	4+769.380	0.908	241.252	241.252
E	4+772.380	0.908	241.266	241.271
F	4+775.380	0.908	241.279	241.290
G	4+778.380	0.908	241.291	241.307
H	4+781.380	0.908	241.302	241.319
I	4+784.380	0.908	241.311	241.326
J	4+787.380	0.908	241.320	241.329
K	4+790.380	0.908	241.327	241.330
⊕ Pier 2	4+794.320	0.908	241.334	241.334
L	4+797.320	0.908	241.339	241.342
M	4+800.320	0.908	241.342	241.351
N	4+803.320	0.908	241.345	241.360
O	4+806.320	0.908	241.346	241.365
P	4+809.320	0.908	241.345	241.364
Q	4+812.320	0.908	241.344	241.359
R	4+815.320	0.908	241.342	241.350
⊕ Pier 3	4+819.690	0.908	241.336	241.336
S	4+822.690	0.908	241.331	241.330
T	4+825.690	0.908	241.324	241.324
U	4+828.690	0.908	241.317	241.317
V	4+831.690	0.908	241.308	241.308
⊕ Brg. East Abut.	4+833.380	0.908	241.303	241.303
Bk. East Abut.	4+833.930	0.908	241.301	241.301

**BEAM #6**

Location	Station	Offset (m)	Theoretical Grade Elevations	Theoretical Grade Elevations Adjusted For Dead Load Deflection
Bk. West Abut.	4+755.140	2.724	241.142	241.142
⊕ Brg. West Abut.	4+755.690	2.724	241.145	241.145
A	4+758.690	2.724	241.165	241.165
B	4+761.690	2.724	241.183	241.184
C	4+764.690	2.724	241.200	241.200
D	4+767.690	2.724	241.216	241.215
⊕ Pier 1	4+769.380	2.724	241.225	241.225
E	4+772.380	2.724	241.239	241.244
F	4+775.380	2.724	241.252	241.263
G	4+778.380	2.724	241.264	241.279
H	4+781.380	2.724	241.274	241.292
I	4+784.380	2.724	241.284	241.299
J	4+787.380	2.724	241.292	241.302
K	4+790.380	2.724	241.299	241.303
⊕ Pier 2	4+794.320	2.724	241.307	241.307
L	4+797.320	2.724	241.312	241.314
M	4+800.320	2.724	241.315	241.324
N	4+803.320	2.724	241.317	241.333
O	4+806.320	2.724	241.318	241.337
P	4+809.320	2.724	241.318	241.337
Q	4+812.320	2.724	241.317	241.332
R	4+815.320	2.724	241.315	241.323
⊕ Pier 3	4+819.690	2.724	241.309	241.309
S	4+822.690	2.724	241.304	241.302
T	4+825.690	2.724	241.297	241.297
U	4+828.690	2.724	241.290	241.290
V	4+831.690	2.724	241.281	241.281
⊕ Brg. East Abut.	4+833.380	2.724	241.275	241.275
Bk. East Abut.	4+833.930	2.724	241.273	241.273

Sht. #5 of 25

**BEAM #7**

Location	Station	Offset (m)	Theoretical Grade Elevations	Theoretical Grade Elevations Adjusted For Dead Load Deflection
Bk. West Abut.	4+755.140	4.540	241.110	241.110
⊕ Brg. West Abut.	4+755.690	4.540	241.113	241.113
A	4+758.690	4.540	241.133	241.133
B	4+761.690	4.540	241.151	241.152
C	4+764.690	4.540	241.168	241.168
D	4+767.690	4.540	241.184	241.183
⊕ Pier 1	4+769.380	4.540	241.193	241.193
E	4+772.380	4.540	241.207	241.212
F	4+775.380	4.540	241.220	241.231
G	4+778.380	4.540	241.232	241.248
H	4+781.380	4.540	241.242	241.260
I	4+784.380	4.540	241.252	241.267
J	4+787.380	4.540	241.260	241.270
K	4+790.380	4.540	241.268	241.271
⊕ Pier 2	4+794.320	4.540	241.275	241.275
L	4+797.320	4.540	241.280	241.282
M	4+800.320	4.540	241.283	241.292
N	4+803.320	4.540	241.285	241.301
O	4+806.320	4.540	241.286	241.305
P	4+809.320	4.540	241.286	241.305
Q	4+812.320	4.540	241.285	241.300
R	4+815.320	4.540	241.283	241.291
⊕ Pier 3	4+819.690	4.540	241.277	241.277
S	4+822.690	4.540	241.272	241.270
T	4+825.690	4.540	241.265	241.265
U	4+828.690	4.540	241.258	241.258
V	4+831.690	4.540	241.249	241.249
⊕ Brg. East Abut.	4+833.380	4.540	241.243	241.243
Bk. East Abut.	4+833.930	4.540	241.242	241.242

**BEAM #8**

Location	Station	Offset (m)	Theoretical Grade Elevations	Theoretical Grade Elevations Adjusted For Dead Load Deflection
Bk. West Abut.	4+755.140	5.600	241.088	241.088
⊕ Brg. West Abut.	4+755.690	5.600	241.092	241.092
A	4+758.690	5.600	241.112	241.112
B	4+761.690	5.600	241.130	241.130
C	4+764.690	5.600	241.147	241.147
D	4+767.690	5.600	241.163	241.162
⊕ Pier 1	4+769.380	5.600	241.172	241.172
E	4+772.380	5.600	241.186	241.191
F	4+775.380	5.600	241.199	241.210
G	4+778.380	5.600	241.211	241.226
H	4+781.380	5.600	241.221	241.238
I	4+784.380	5.600	241.231	241.246
J	4+787.380	5.600	241.239	241.249
K	4+790.380	5.600	241.246	241.250
⊕ Pier 2	4+794.320	5.600	241.254	241.254
L	4+797.320	5.600	241.259	241.261
M	4+800.320	5.600	241.262	241.271
N	4+803.320	5.600	241.264	241.279
O	4+806.320	5.600	241.265	241.284
P	4+809.320	5.600	241.265	241.284
Q	4+812.320	5.600	241.264	241.279
R	4+815.320	5.600	241.261	241.270
⊕ Pier 3	4+819.690	5.600	241.256	241.256
S	4+822.690	5.600	241.250	241.249
T	4+825.690	5.600	241.244	241.244
U	4+828.690	5.600	241.236	241.237
V	4+831.690	5.600	241.228	241.228
⊕ Brg. East Abut.	4+833.380	5.600	241.222	241.222
Bk. East Abut.	4+833.930	5.600	241.220	241.220


**DECK ELEVATIONS**  
**U.S. ROUTE 150 (BLOOMINGTON RD.)**  
**OVER F.A.I. RTE. 57**  
**SECTION (10-34HB)BR**  
**STA. 4+794.32 (U.S. RTE. 150)**  
**STA. 17+754.60 (F.A.I. RTE. 57)**  
**CHAMPAIGN COUNTY**  
**S.N. 010-0050**

**LIN ENGINEERING, LTD.**

DESIGN: T.M.U.      CHECKED: J.W.  
 DRAWN: M.C.      DATE: 12/95

ROUTE NO.	SECTION	COUNTY	TOTAL SHEETS	SHEET NO.
F.A.I. 57	(10-34HB)BR	CHAMPAIGN	47	21
FED. ROAD DIST. NO. 7		ILLINOIS	FED. AID PROJECT-	


Sht. #6 of 25

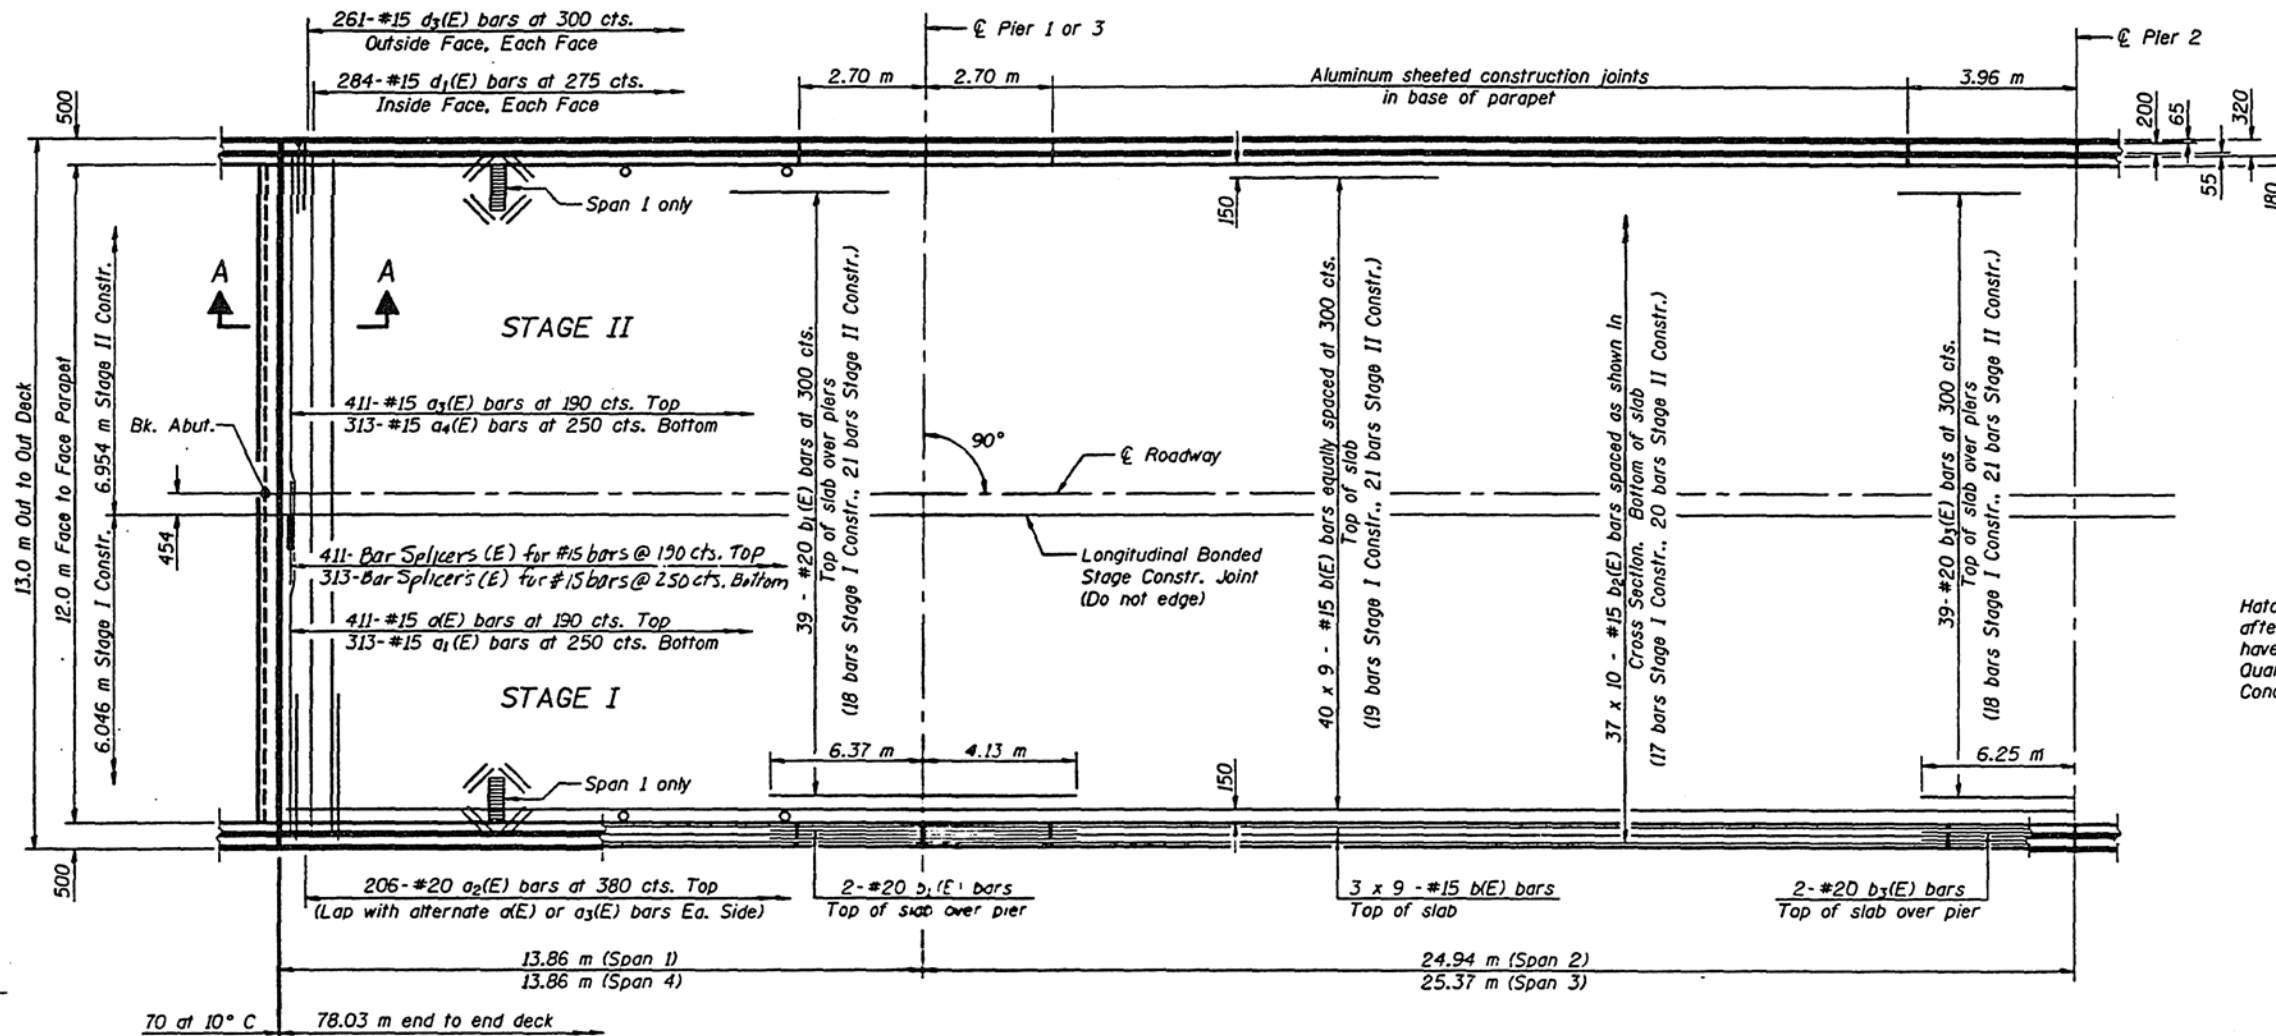


HALF PLAN

MIN. BAR LAP  
#15 bars 640 mm

Hatched area to be poured after superstructure forms have been removed. Quantity billed with Concrete Superstructures.

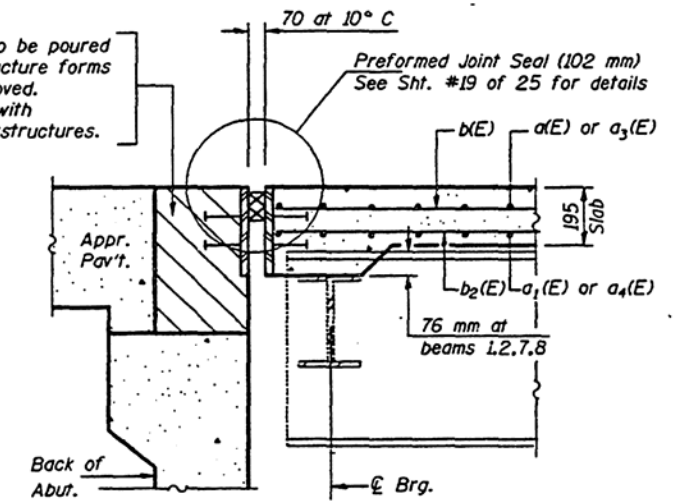

SECTION A-A

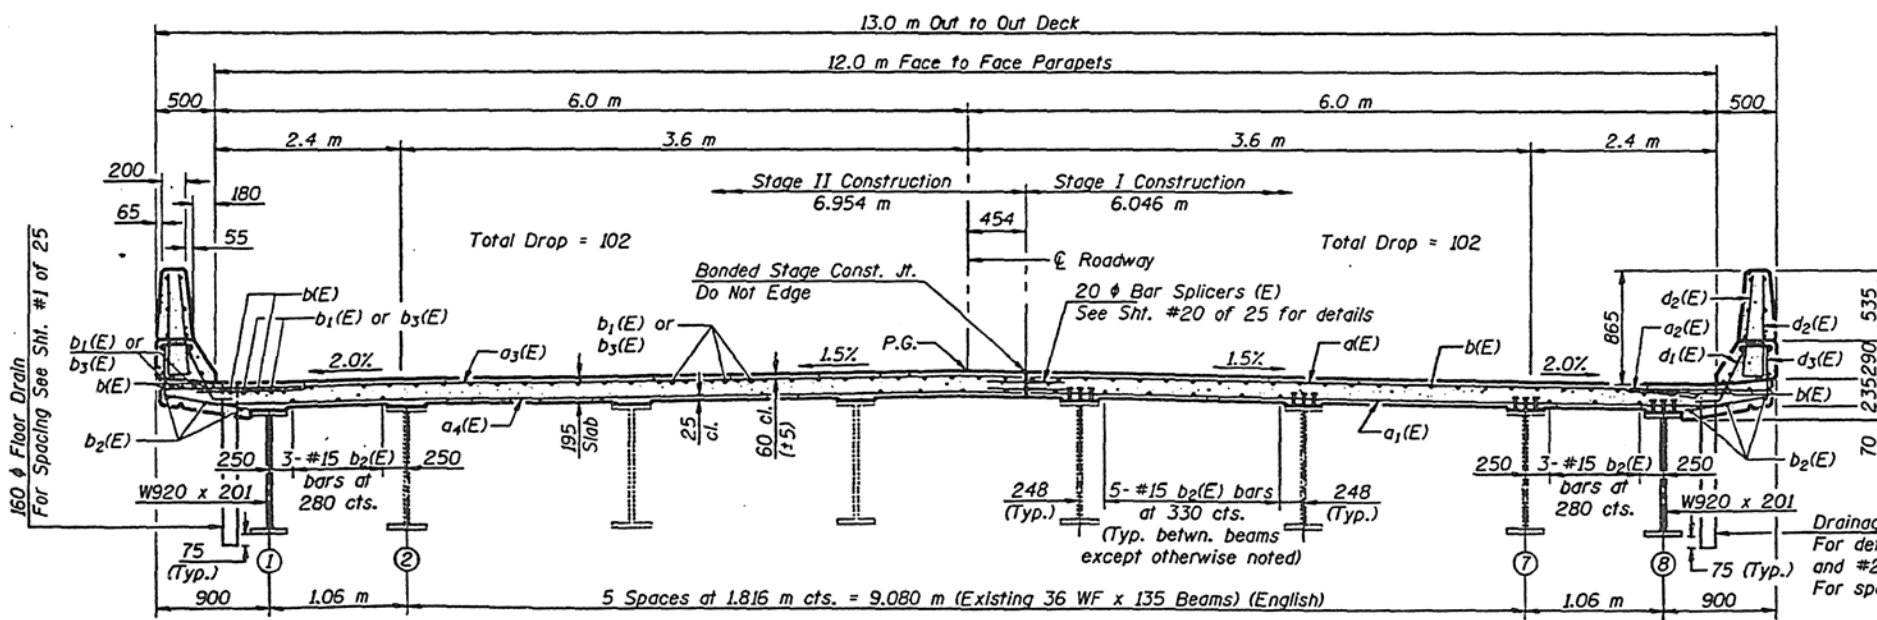

NEAR PIERS

CROSS SECTION  
(Looking East)

NEAR MIDSPAN

Notes: See sheet #7 of 25 for superstructure details and Bill of Material.

Reinforcement bars designated (E) shall be epoxy coated.

Bars indicated thus 20 x 3-#15 etc. indicates 20 lines of bars with 3 lengths per line.

All dimensions are in millimeters (mm) except as noted.

See sheet #20 of 25 for Bar Splicer details at bonded stage construction joint.

Drains shall be located clear of all diaphragms. See sheet #7 of 25 for parapet reinforcement.


Work this sheet with sht. #7 of 25.

**SUPERSTRUCTURE**  
**U.S. RTE. 150 (BLOOMINGTON RD.)**  
**OVER F.A.I. RTE. 57**  
**SECTION (10-34HB)BR**  
**STA. 4+794.32 (U.S. RTE. 150)**  
**STA. 17+754.60 (F.A.I. RTE. 57)**  
**CHAMPAIGN COUNTY**  
**S.N. 010-0050**

LIN ENGINEERING, LTD.

DESIGN: T.M.M. CHECKED: J.W.  
 DRAWN: H.C. DATE: 12/95



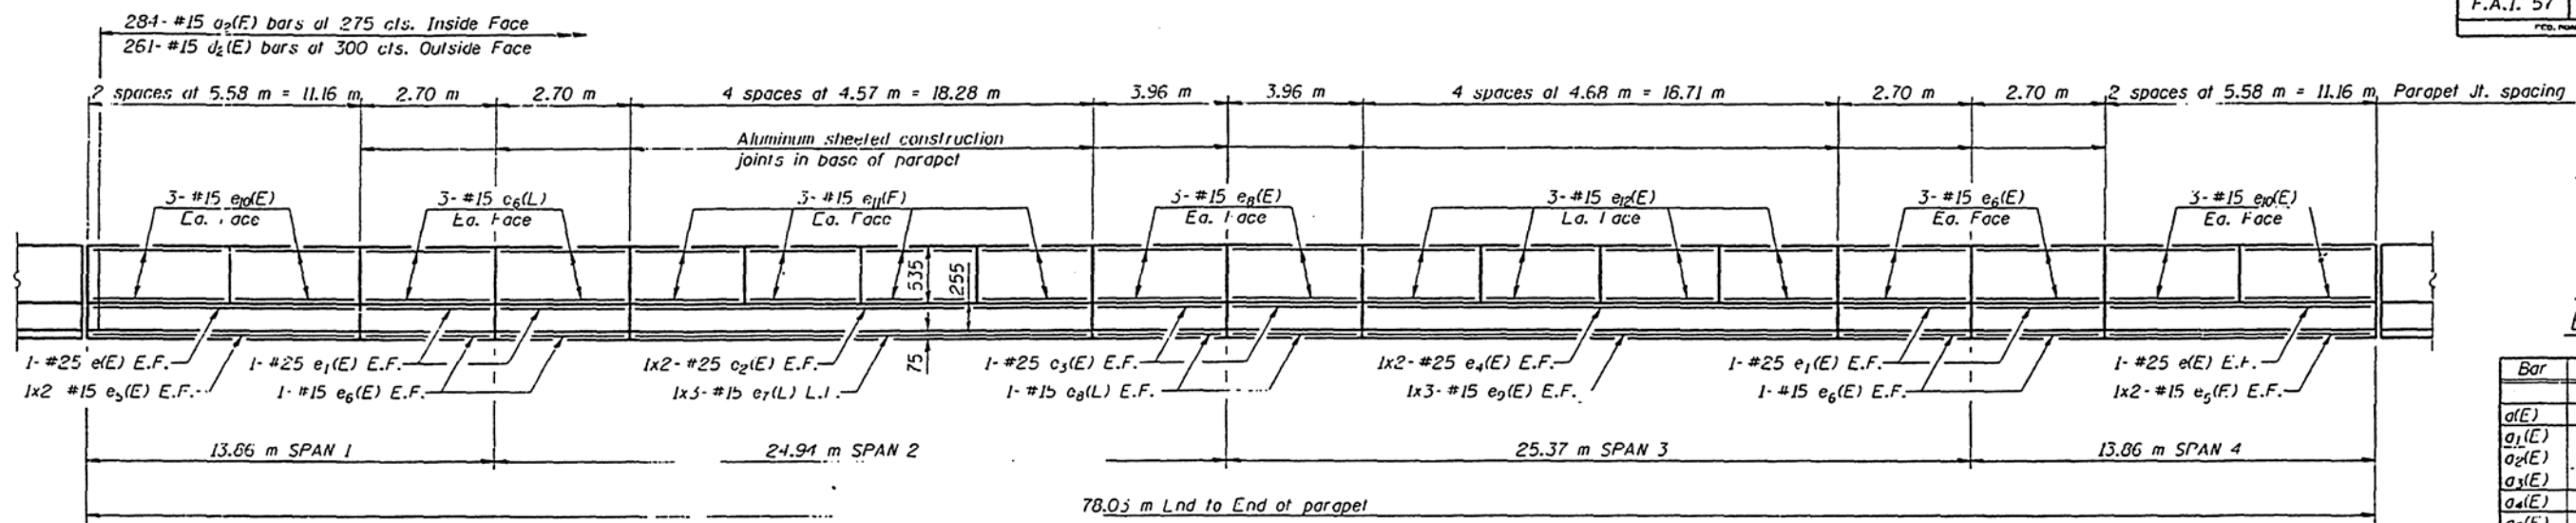






**MIN. BAR LAP**

#15 bars 640  
#25 bars 1.32 m

**SUPERSTRUCTURE  
BILL OF MATERIAL**

Bar	No.	Size	Length (m)	Shape
a1(E)	411	#15	5.80	—
a2(E)	313	#15	5.60	—
a3(E)	412	#20	1.20	—
a4(E)	411	#15	6.70	—
a5(E)	313	#15	6.50	—
a6(E)	16	#15	0.60	—
b1(L)	414	#15	9.23	—
b2(L)	86	#20	10.50	—
b3(L)	370	#15	8.37	—
b4(L)	43	#20	17.5	—
d1(E)	568	#15	0.80	L
d2(E)	1090	#15	0.91	L
d3(E)	522	#15	1.18	L
e1(E)	8	#25	11.08	—
e2(E)	16	#25	2.12	—
e3(E)	8	#25	9.76	—
e4(E)	8	#25	3.87	—
e5(E)	8	#25	9.38	—
e6(E)	16	#15	5.86	—
e7(E)	64	#15	2.62	—
e8(E)	12	#15	6.49	—
e9(E)	32	#15	3.87	—
e10(E)	12	#15	6.64	—
e11(E)	48	#15	5.50	—
e12(E)	18	#15	4.49	—
e13(E)	48	#15	4.60	—
Reinforcement Bars, Epoxy Coated	kg		35,890	
Concrete Superstructures	Cu. m		252.5	
Removal of Existing Structure	L'ach		1	

**INSIDE ELEVATION OF PARAPET**

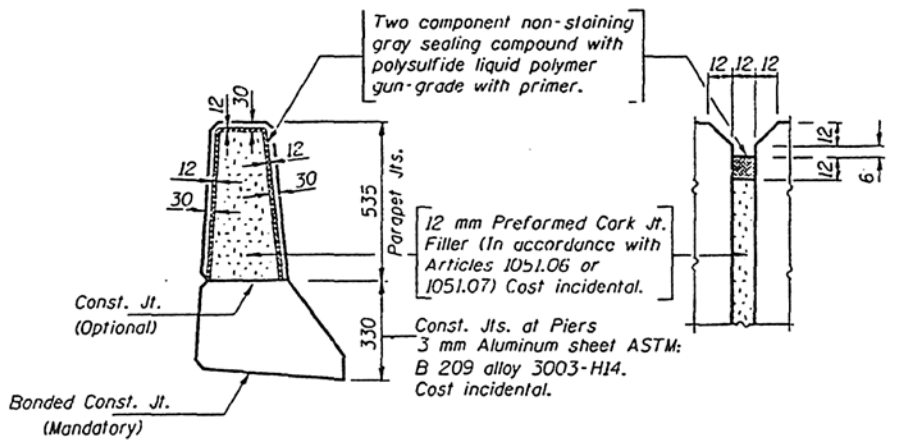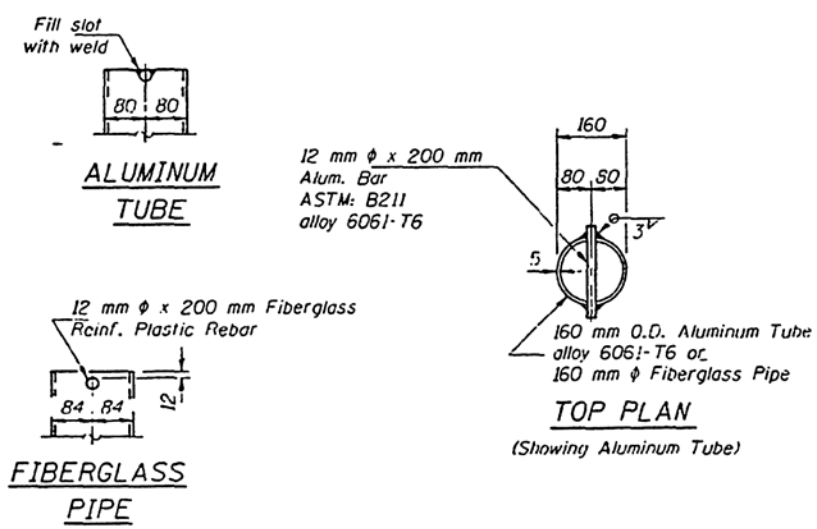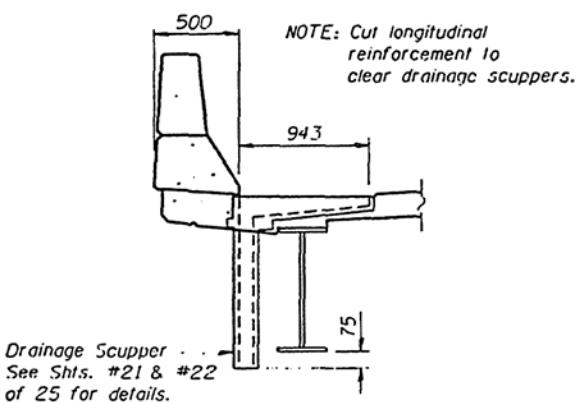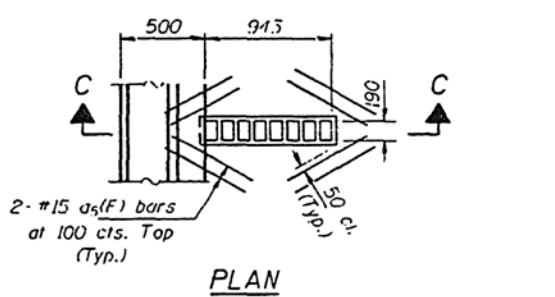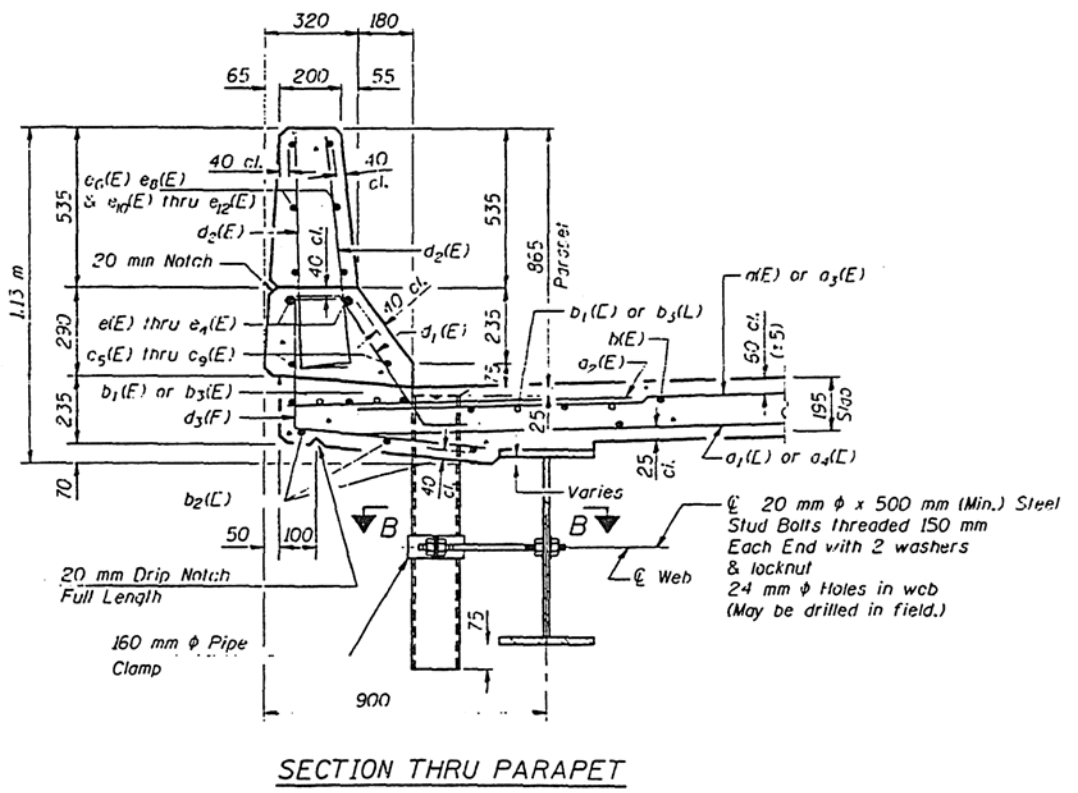

**Notes:**  
The exterior surfaces of the Floor Drain shall be painted with the finish coat of paint system specified for Structural Steel. The exterior surfaces of the drain shall be cleaned and given a washcoat pretreatment in accordance with Steel Structures Painting Council's Spec. SSPC-SPI & SSPC-Paint 27 prior to painting.  
Fiberglass pipe shall conform to ASTM: D2996, with short-time rupture strength hoop tensile stress of 200 Mpa minimum. The surface of the Fiberglass pipe shall be free of bond inhibiting agents.



Reinforcement bars designated (E) shall be epoxy coated.  
Bars indicated thus 1 x 3-#15 etc. indicates 1 line of bars with 3 lengths per line.  
All dimensions are in millimeters (mm) excepts as noted.

REVISIONS	
NAME	DATE
B. BLAND	2-26-

**SUPERSTRUCTURE DETAILS  
U.S. RTE. 150 (BLOOMINGTON RD.)  
OVER F.A.I. ROUTE 57  
SECTION (10-34HB)BR  
STA. 4+794.32 (U.S. RTE. 150)  
STA. 17+754.60 (F.A.I. RTE. 57)  
CHAMPAIGN COUNTY  
S.N. 010-0050**

**LIN ENGINEERING, LTD.**


DESIGN: T.M.M. CHECKED: J.W.  
DRAWN: M.C. DATE: 12/95

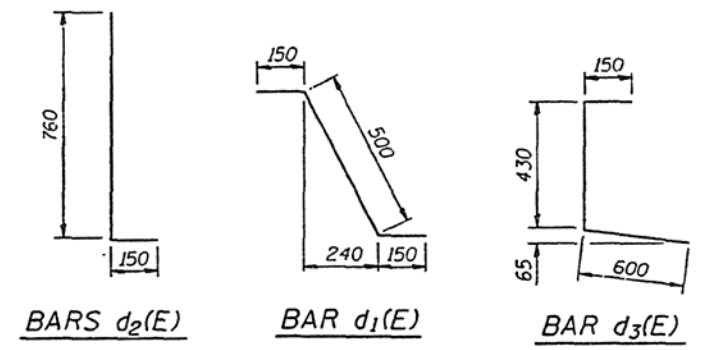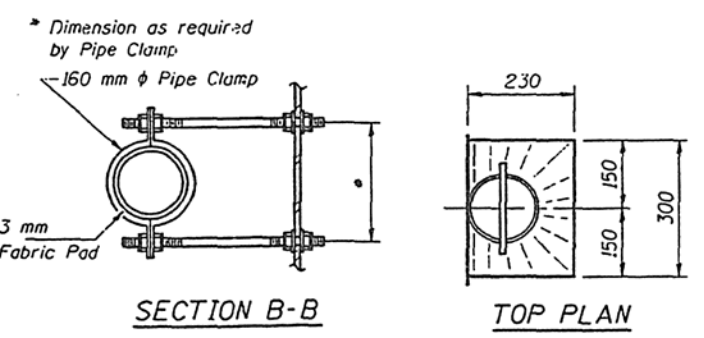




ROUTE NO.	SECTION	QUANTITY	TOTAL SHEETS	SHEET NO.
F.A.I. 57	(10-34HB)BR	CHAMPAIGN	47	23
FED. ROAD DIST. NO. 7		ILLINOIS	FED. AID PROJECT	

Sht. #8 of 25

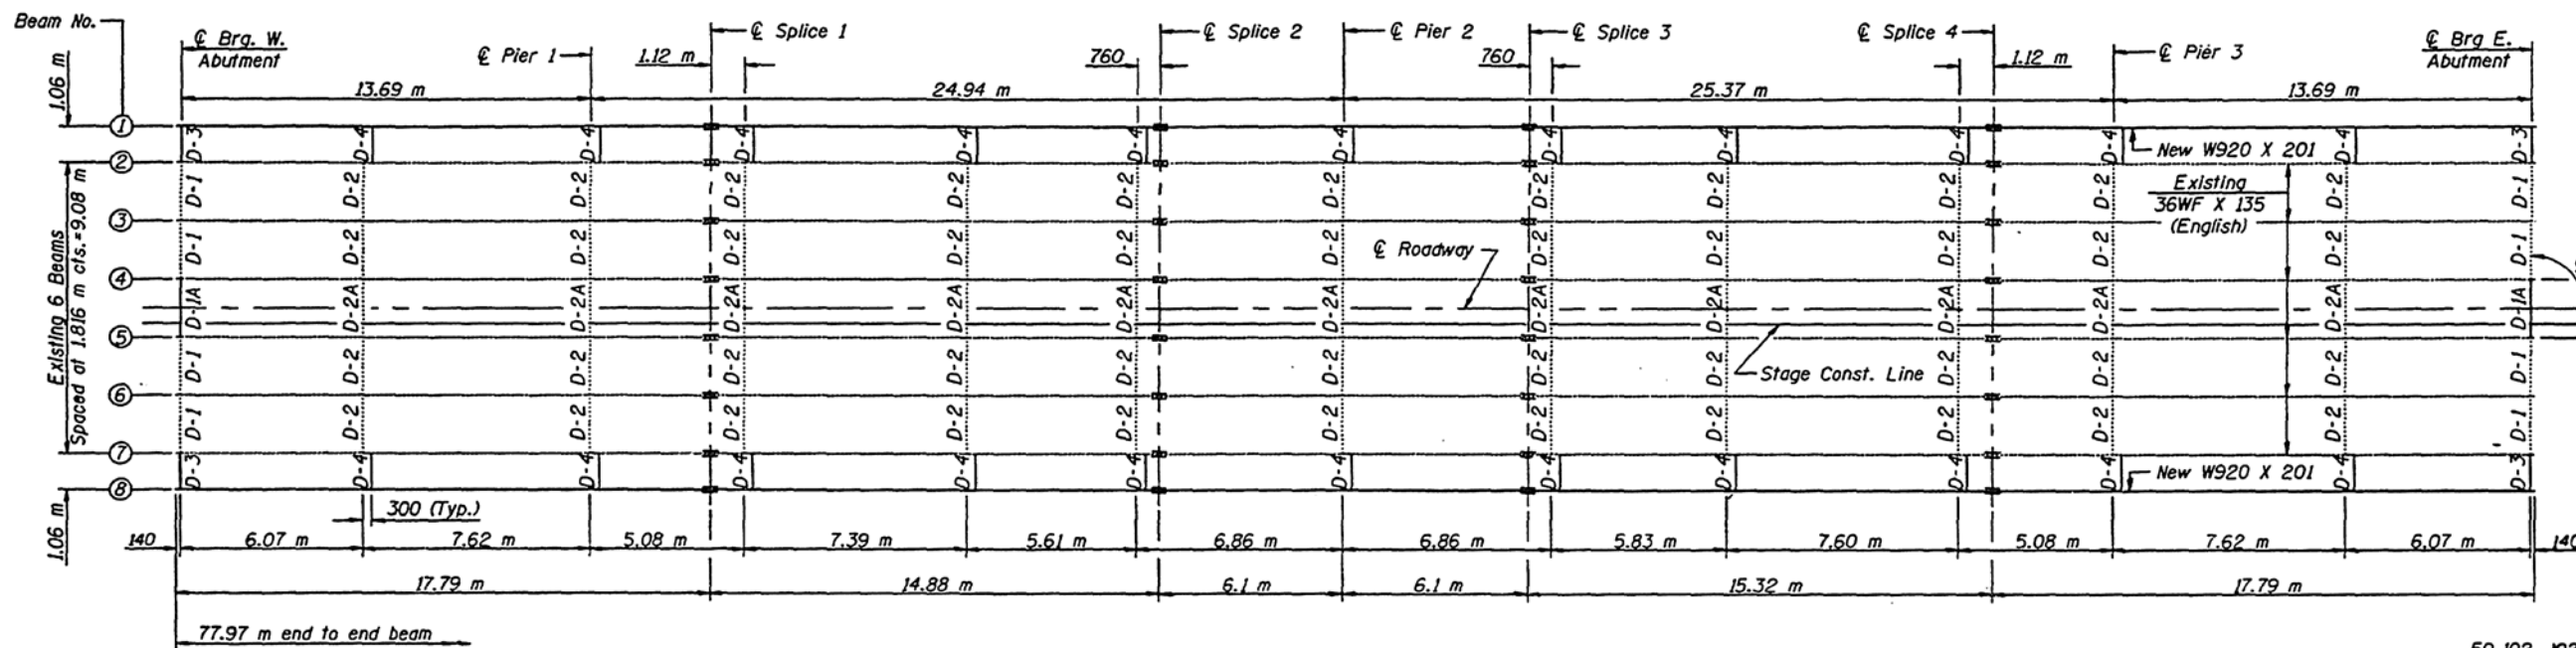


**FRAMING PLAN**

NOTE: All existing D2-A diaphragms are to be removed during Stage Construction and reconnected after Stage Construction. For details of diaphragm D1-A, D2-A, D-3, and D-4 see sheet #9 of 25.

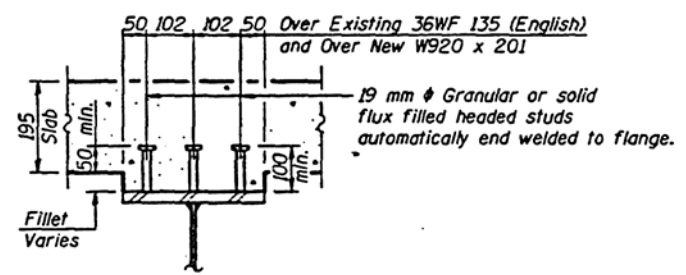


**SECTION A-A**

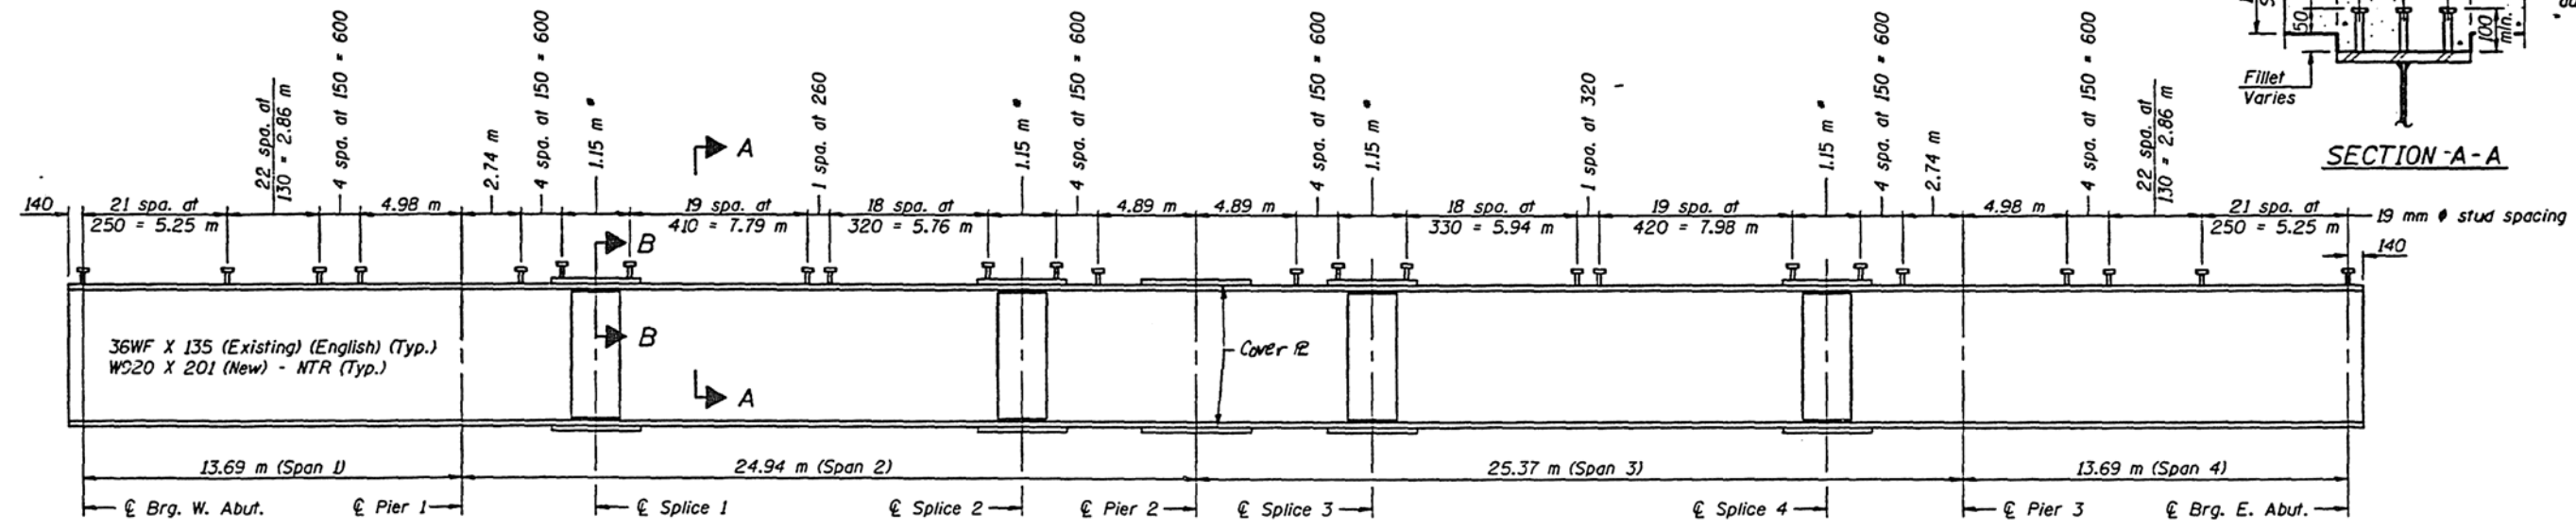


**BEAM ELEVATION**

NOTE: "NTR" denotes Notch Toughness Requirements - Zone 2  
 \* For spacing of studs on top splice plate see "Stud Spacing at Splice Locations".


All dimensions are in millimeters (mm) except as noted.

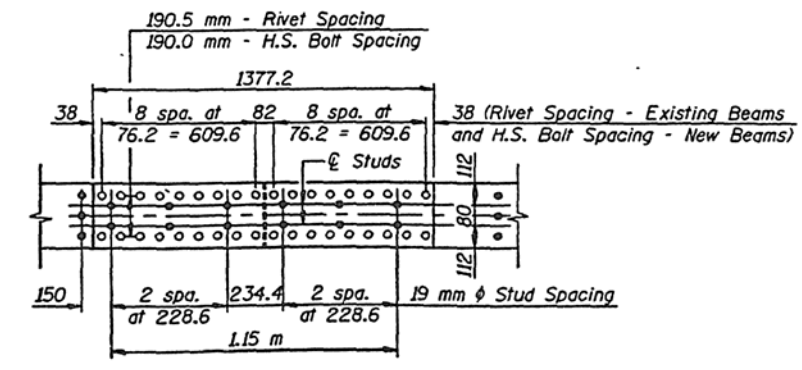

**STUD SPACING AT SPLICE LOCATIONS**  
 Splice 1 & 3 Shown  
 Splice 2 & 4 (Rotate 180°)

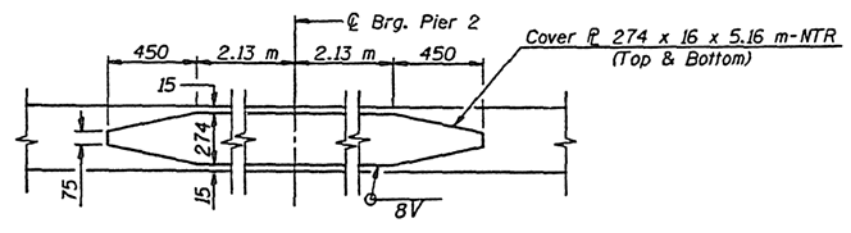

**COVER PLATE DETAIL**  
 4 Req'd

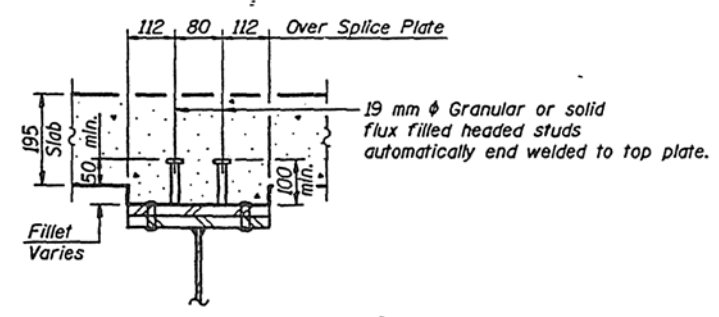

**SECTION B-B**

**STRUCTURAL STEEL DETAILS**  
 U.S. RTE. 150 (BLOOMINGTON RD.)  
 OVER F.A.I. RTE. 57  
 SECTION (10-34HB)BR  
 STA. 4+794.32 (U.S. RTE. 150)  
 STA. 17+754.60 (F.A.I. RTE. 57)  
 CHAMPAIGN COUNTY  
 S.N. 010-0050

**LIN ENGINEERING, LTD.**  
 DESIGN: J.W. CHECKED: T.J.M.  
 DRAWN: N.C. DATE: 12/95



Is and Ss are the moment of inertia and section modulus of the steel section used in computing fs (Total). VR is the maximum Live Load + Impact shear range in span.  
Icω, Ic(ω), and Sc(ω), Sc(ω) are the moment of inertia and section modulus of the composite section used in computing fs (Total).

**INTERIOR GIRDER MOMENT TABLE**

	0.4 Sp. (1)	Pier 1	0.5 Sp. (2)	Pier 2	0.5 Sp. (3)	Pier 3	0.6 Sp. (4)
Is (10 <sup>6</sup> mm <sup>4</sup> )	3246.6	3246.6	3246.6	5119.2	3246.6	3246.6	3246.6
Ic (n) (10 <sup>6</sup> mm <sup>4</sup> )	7957.6	7957.6	7957.6	7957.6	7957.6	7957.6	7957.6
Ic (sn) (10 <sup>6</sup> mm <sup>4</sup> )	5838.3	5838.3	5838.3	5838.3	5838.3	5838.3	5838.3
Ss (10 <sup>3</sup> mm <sup>3</sup> )	7193.9	7193.9	7193.9	10953.4	7193.9	7193.9	7193.9
Sc (n) (10 <sup>3</sup> mm <sup>3</sup> )	10207.5	10207.5	10207.5	10207.5	10207.5	10207.5	10207.5
Sc (sn) (10 <sup>3</sup> mm <sup>3</sup> )	9211.7	9211.7	9211.7	9211.7	9211.7	9211.7	9211.7
D (kN/m)	10.6	10.65	10.70	10.65	10.70	10.65	10.6
M <sub>ℓ</sub> (kN-m)	78.6	399.3	289.9	684.4	309.2	418.9	70.7
fs <sub>ℓ</sub> non-comp (MPa)	11.0	55.6	40.3	62.5	43.0	58.2	9.8
fs <sub>ℓ</sub> (kN/m)	3.68	3.68	3.68	3.68	3.68	3.68	3.68
Ms <sub>ℓ</sub> (kN-m)	38.1	113.1	132.1	195.9	140.1	115.9	36.4
fs <sub>ℓ</sub> (comp) (MPa)	4.2	15.7	14.3	17.9	15.2	16.1	4.0
M <sub>t</sub> (kN-m)	326.7	311.7	619.5	449.3	627.1	316.2	329.6
M (Imp) (kN-m)	96.1	82.6	148.6	107.8	150.5	83.8	96.9
fs (M <sub>t</sub> + M <sub>Imp</sub> ) (MPa)	41.4	54.8	75.1	50.9	76.1	55.6	41.8
fs (Total) (MPa)	56.6	126.1	129.7	131.3	134.3	129.9	55.6
VR (kN)	196.0		211.1		211.7		197.8

**TOP OF BEAM ELEVATION**


Location	Bms. 1 & 8	Bms. 2 & 7	Bms. 3 & 6	Bms. 4 & 5
West Abut.	240.859	240.880	240.914	240.932
℄ Pier 1	240.938	240.959	240.993	241.011
℄ Splice 1	240.963	240.984	241.018	241.036
℄ Splice 2	241.005	241.026	241.060	241.078
℄ Pier 2	241.021	241.042	241.076	241.094
℄ Splice 3	241.039	241.060	241.094	241.112
℄ Splice 4	241.033	241.054	241.088	241.106
℄ Pier 3	241.024	241.045	241.079	241.097
East Abut.	240.987	241.008	241.042	241.060

NOTE: Elevations are to top of beam flange including splice plate and cover plate locations.

**INTERIOR GIRDER REACTION TABLE**

	West Abut.	Pier 1	Pier 2	Pier 3	East Abut.
R <sub>ℓ</sub> (kN)	60.0	299.4	390.1	305.1	58.7
R <sub>t</sub> (kN)	131.7	177.0	204.6	177.9	132.1
R <sub>Imp.</sub> (kN)	38.7	47.0	49.1	47.0	38.8
R (Total) (kN)	230.4	523.4	643.8	530.0	229.6

NOTE: Use 22 mm x 40 mm slotted holes in connection angles (A) & (B) at beam #4 only. Provide 50 x 50 x 8 mm plate washers for slotted holes. Bolts shall be finger tightened prior to the deck pour for Stage II Construction and then be fully tightened after completion of the deck pour for Stage II Construction.



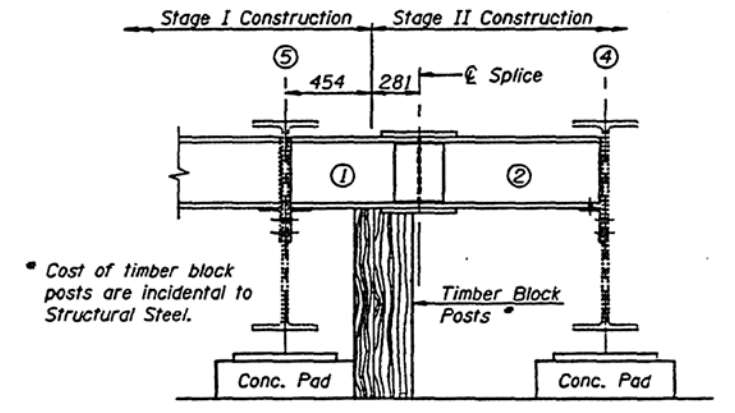


**DIAPHRAGM D-1A CONSTRUCTION SEQUENCE**  
(Each Abutment)

- Order diaphragm D-1A in two sections with lengths of 719 mm and 1.065 m.
- Remove existing deck (Stage I) and connect seat L for diaphragm to beam #5 and connect section ① to seat L with M20 bolts.
- Place timber block posts between section ① of diaphragm and abutment bearing seat. Run section ① level.
- After Stage I deck has been poured, remove Stage II deck and raise Stage II beams to Stage II level.
- Connect seat L for diaphragm to beam #4 and connect section ② to seat L with M20 bolts.
- Connect top flange splice plate and web splice plates to diaphragm sections ① and ②.
- Remove timber block posts and connect bottom flange splice plate to diaphragm sections ① and ②.
- Place Stage II deck.



**STRUCTURAL STEEL DETAILS**  
U.S. RTE. 150 (BLOOMINGTON RD.)  
OVER F.A.I. RTE. 57  
SECTION (10-34HB)BR  
STA. 4+794.32 (U.S. RTE. 150)  
STA. 17+754.60 (F.A.I. RTE. 57)  
CHAMPAIGN COUNTY  
S.N. 010-0050

**LIN ENGINEERING, LTD.**  
DESIGN: J.W. CHECKED: T.M.M.  
DRAWN: N.C. DATE: 12/95

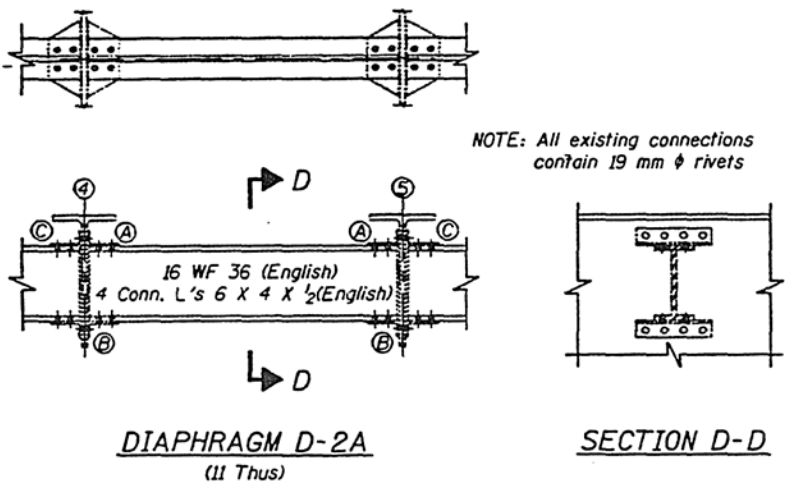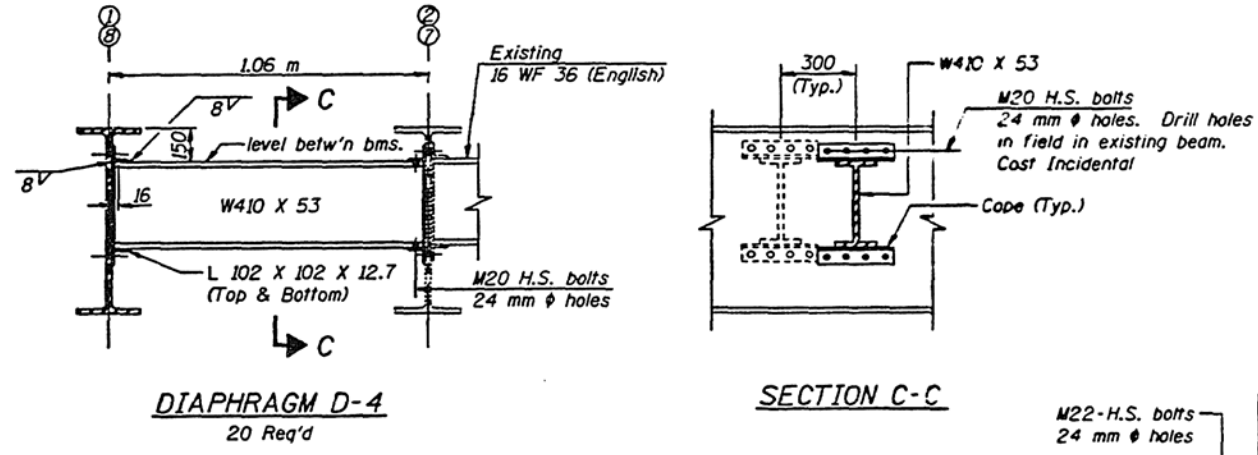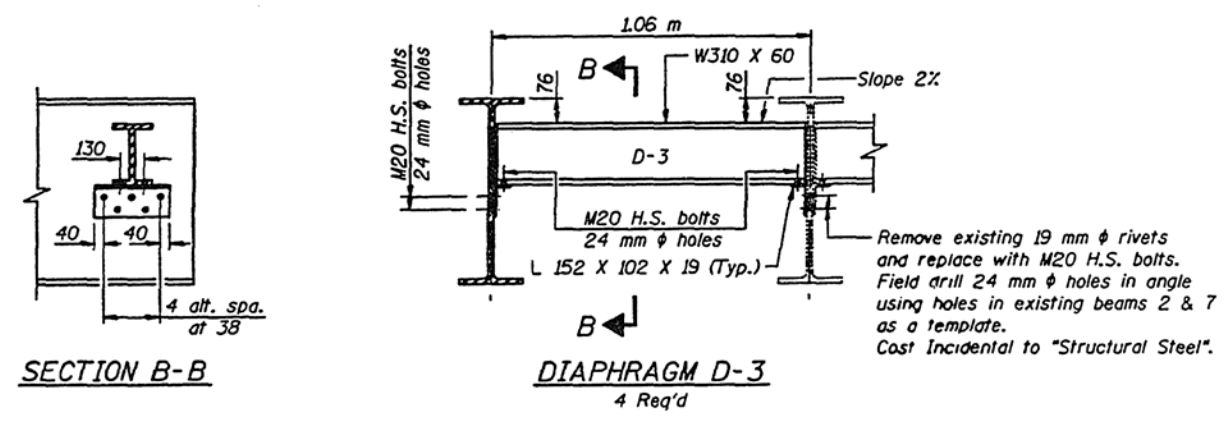


**REMOVAL & RECONNECTION PROCEDURE OF DIAPHRAGM D-2A**

- Prior to raising existing beams for Stage I Const. the following shall be done.
  - Disconnect LA from both existing beam and diaphragm. (Provide new L's for reconnection)
  - Disconnect diaphragm from LB
  - Let diaphragm remain disconnected while beams of Stage I are being raised to new positions.
  - Temporarily reconnect LC to beam before raising Stage I beams.
- Raise beams of Stage I to proper position.
- After Stage I Construction is complete, raise Stage II beams into position.
- Replace existing diaphragm back onto LB and connect with M20 H.S. bolts. (Note: If LB had been damaged during removal they shall be replaced.)
- Remove temporary bolts in LC.
- Provide new L's (152 X 102 X 12.7) for LA.
- Reconnect LA to both beam and diaphragm with M20 φ bolts.
- Complete Stage II Constr.

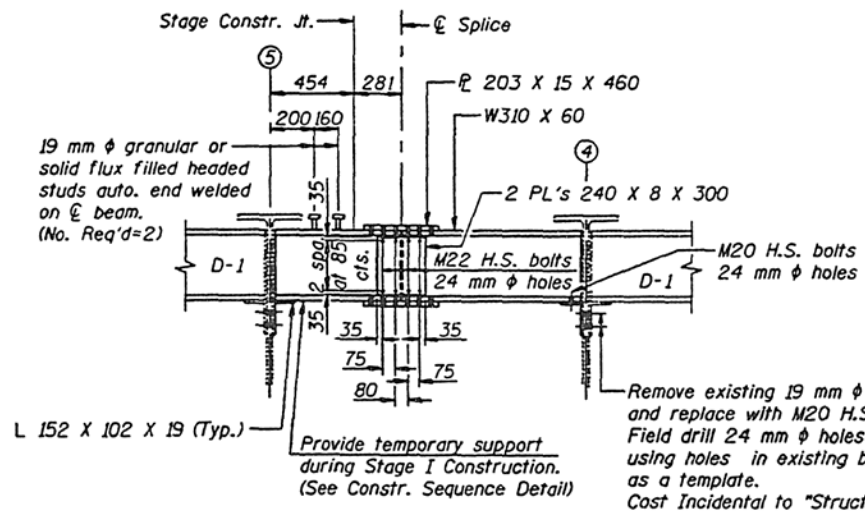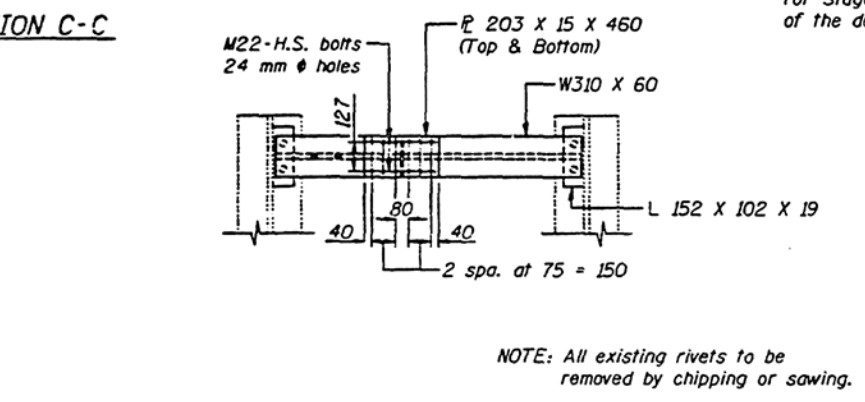


**DIAPHRAGM D-1A**  
West Abut.-Shown  
East Abut.-Opposite Hand

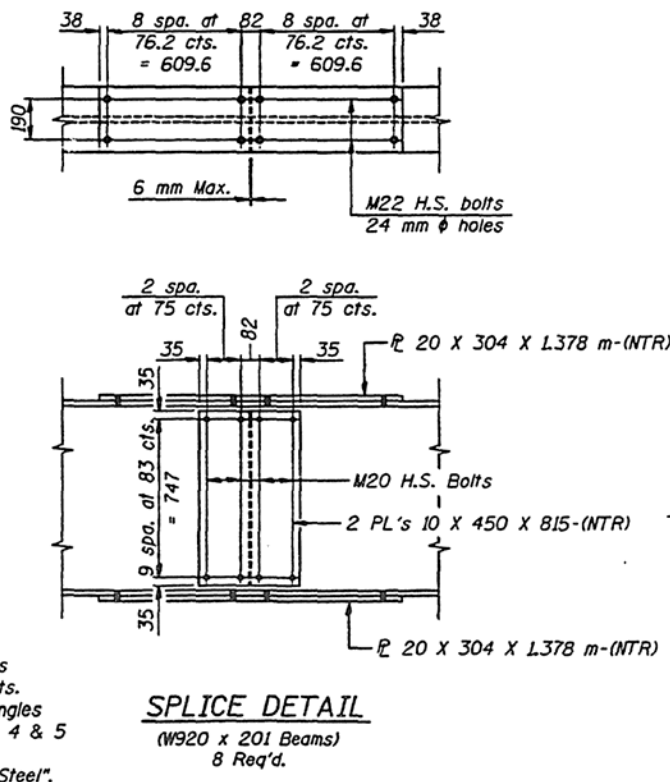


NOTE: All dimensions are in millimeters (mm) except as noted. "NTR" denotes Notch Toughness Requirements - Zone 2. Two hardened washers shall be required over all 24 mm φ holes for diaphragm connections. All contact surfaces of joints shall be free of paint or lacquer.



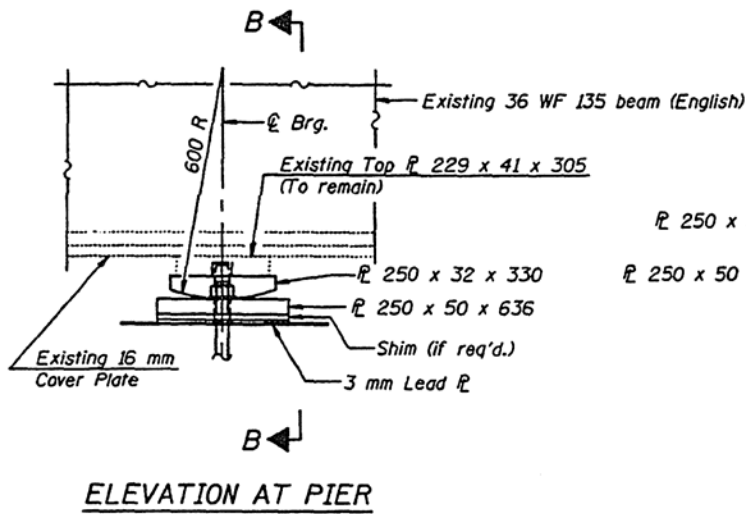


ELEVATION AT PIER

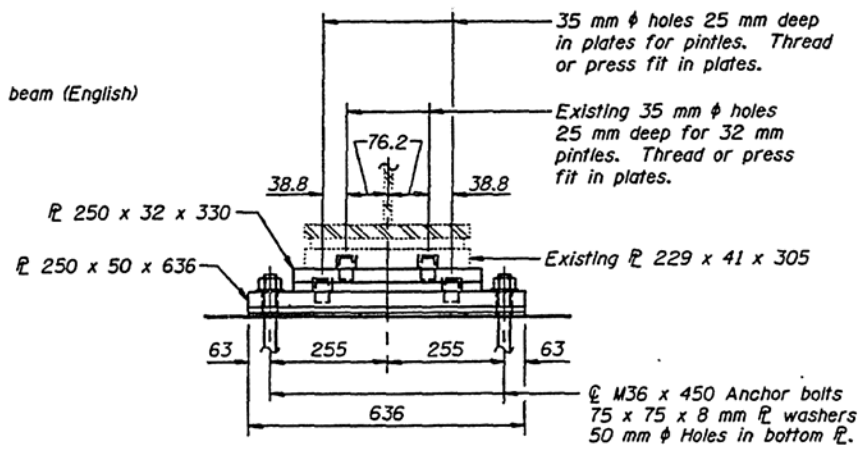


SECTION B-B


FIXED BEARING AT PIER 2  
 (Beams #2 Thru #7)

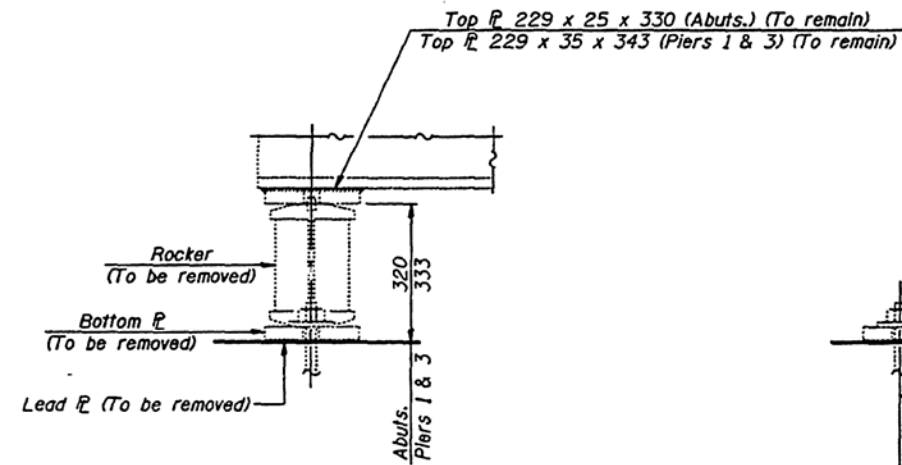


EXISTING EXPANSION BEARING

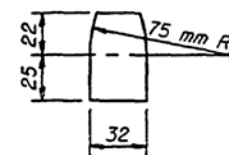

PIN TLE

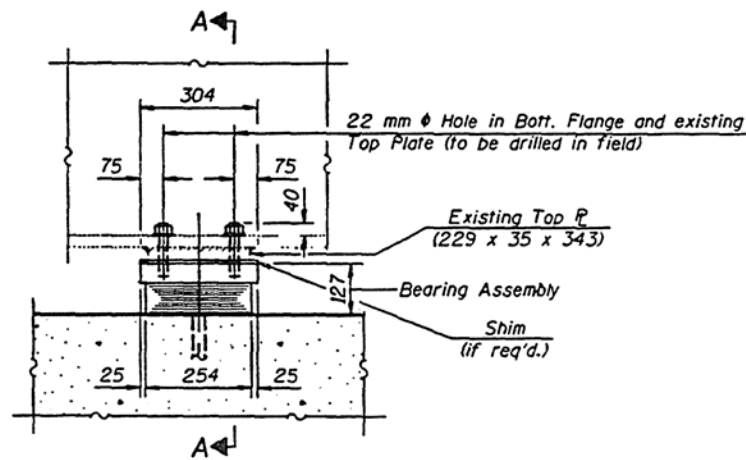


ELEVATION

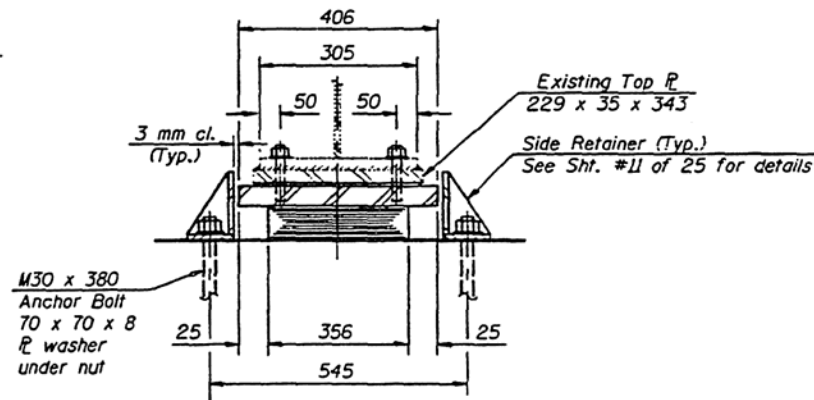


SECTION A-A



TYPE I ELASTOMERIC EXP. BRG. AT PIERS 1 & 3  
 (Beams #2 Thru #7)

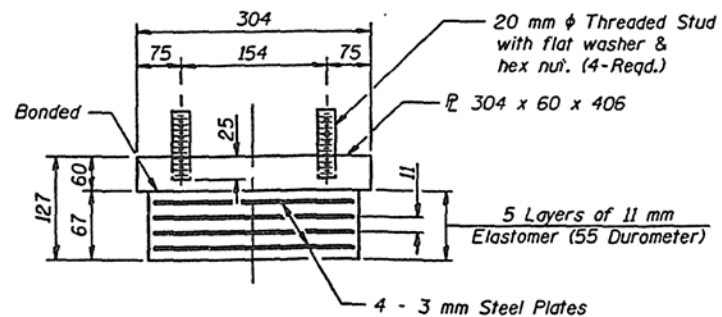

BEARING ASSEMBLY

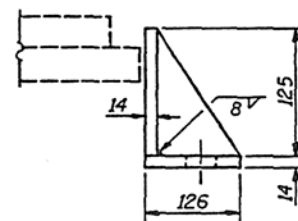

SIDE RETAINER - PIERS 1 & 3  
 (32 Req'd)

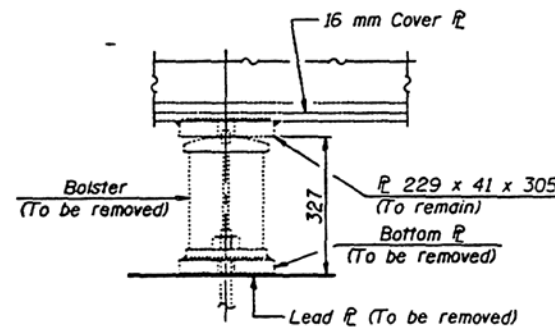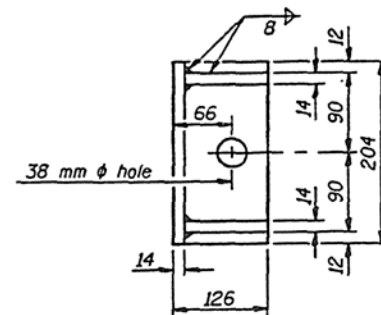

EXISTING FIXED BEARING

Notes: All dimensions are in millimeters (mm) except as noted. See sheet #24 of 25 for Anchor Bolt installation.

BILL OF MATERIAL



Item	Unit	Total
Elastomeric Bearing Assembly, Type I	Each	16
Elastomeric Bearing Assembly, Type II	Each	16
Jack & Remove Existing Bearings	Each	30

BEARING DETAILS-EXISTING BEAMS  
 U.S. RTE. 150 (BLOOMINGTON RD.)  
 OVER F.A.I. RTE. 57  
 SECTION (10-34HB)BR  
 STA 4+794.32 (U.S. RTE. 150)  
 STA. 17+754.60 (F.A.I. RTE. 57)  
 CHAMPAIGN COUNTY  
 S.N. 010-0050

LIN ENGINEERING, LTD.


DESIGN: J.W. CHECKED: S.F.M.  
 DRAWN: H.C. DATE: 12/95



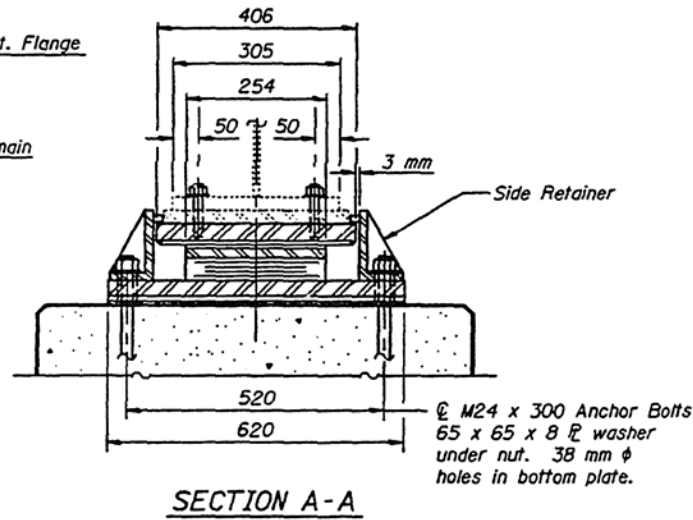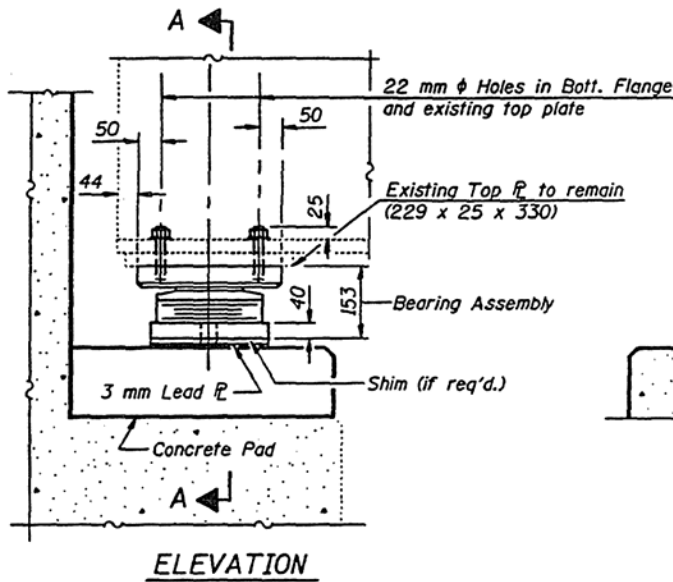

Note: The 3 mm TFE sheet shall be bonded directly to the top steel plate with a two-component, medium viscosity epoxy resin, conforming to the requirements of the Federal Specification MMM-A-134, Type I. The bond agent shall be applied on the full area of the contact surfaces.

Bonding of 3 mm TFE sheet during vulcanizing process will be permitted provided the process and method of adjusting assembly height is approved by the Engineer.

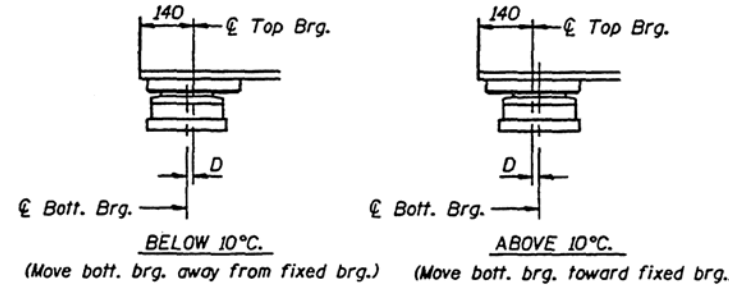




**SETTING ANCHOR BOLTS AT EXP. BRG'S.**

D = 1 mm per each 10 m of expansion for every 8°C temp. change from the normal temp. of 10°C.


**JACK AND REMOVAL PROCEDURE OF EXISTING BEARINGS**

- The Contractor shall submit for approval by the Engineer, plans for jacking prior to commencing any work at the bearings.  
Dead Load = Abut. = 9.5 kN  
Piers 1 & 3 = 50.0 kN  
Pier 2 = 64.0 kN  
Min. Jack Capacity = 150 kN. } Each Beam
- Jacking and removing existing bearings and raising of beams to proper elevation and placement of new bearings shall be done after removal of the deck and before the new deck has been poured.
- All beams at each abutment or pier during each separate stage shall be lifted (or lowered) simultaneously. In addition, the lifting or lowering differential at any time between abutments and piers shall not exceed 7 mm.
- The nuts and washer of the existing anchor bolts shall be removed prior to placing the concrete pad.
- The new bearings shall be placed on the concrete pad and the jacks shall be lowered before the new deck is poured. However, placement of the bearing on the concrete pad shall not be done prior to 72 hours after pouring the pad.


**TYPE II TFE ELASTOMERIC EXP. BRG. (ABUTS.)**  
(Beams #2 Thru #7)

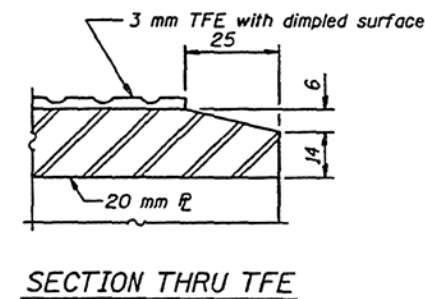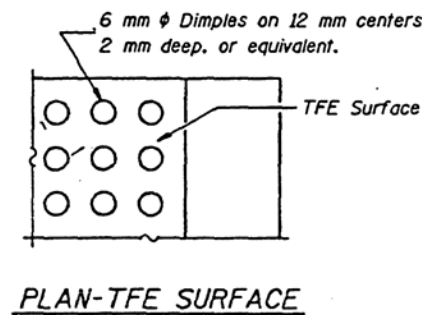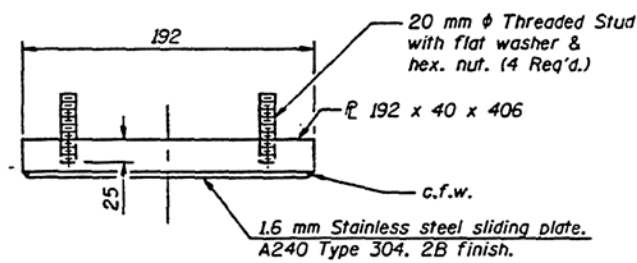


**TOP BEARING ASSEMBLY**  
(Abutments)

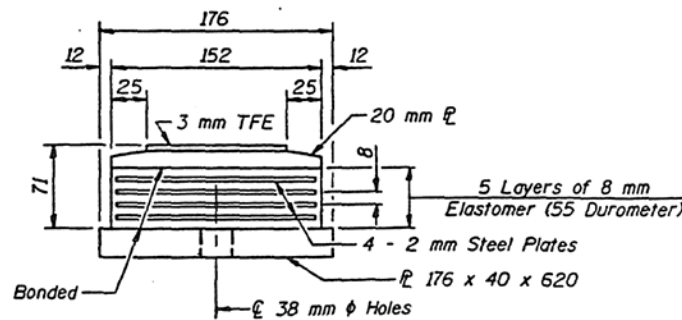

**BOTTOM BEARING ASSEMBLY**  
(Abutments)

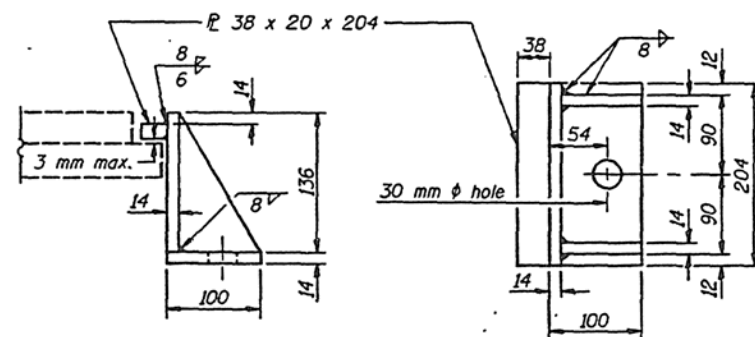

**ABUTMENT SIDE RETAINER**  
(32 Req'd)

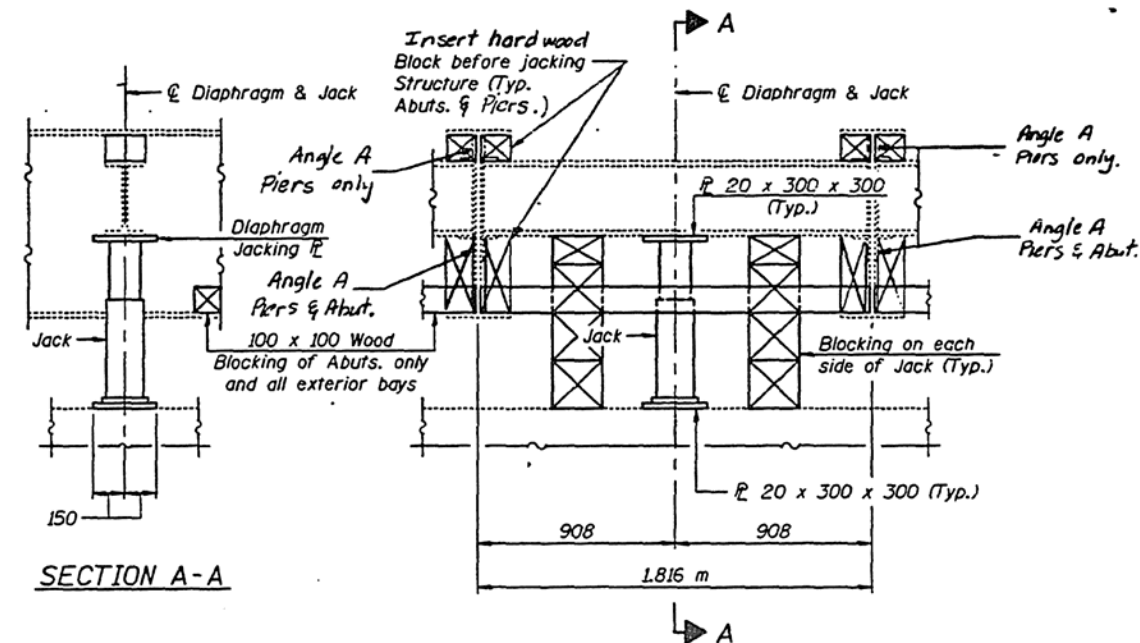

**JACKING DETAILS**

(Typical between Beams #2 & #3, #3 & #4, #5 & #6, #6 & #7)  
Work this sheet with Sheet #2 of 25.

NOTE: For Existing Bearing details & Bill of Material See Sht. #10 of 25. See Sht. #24 of 25 for Anchor Bolt Installation. All dimensions are in millimeters (mm) except as noted.

**BEARING DETAILS-EXISTING BEAMS**  
U.S. RTE. 150 (BLOOMINGTON RD.)


OVER F.A.I. RTE. 57  
SECTION (10-34HB)BR  
STA 4+794.32 (U.S. RTE. 150)  
STA. 17+754.60 (F.A.I. RTE. 57)  
CHAMPAIGN COUNTY  
S.N. 010-0050

LIN ENGINEERING, LTD.

DESIGN: J.W. CHECKED: S.F.M.  
DRAWN: M.C. DATE: 12/95


ROUTE NO.	SECTION	COUNTY	TOTAL SHEETS	SHEET NO.
F.A.I. 57	(10-34HB)BR	CHAMPAIGN	47	27
FED. ROAD DIST. NO. 7		ILLINOIS		FED. AID PROJECT

Sht. #12 of 25

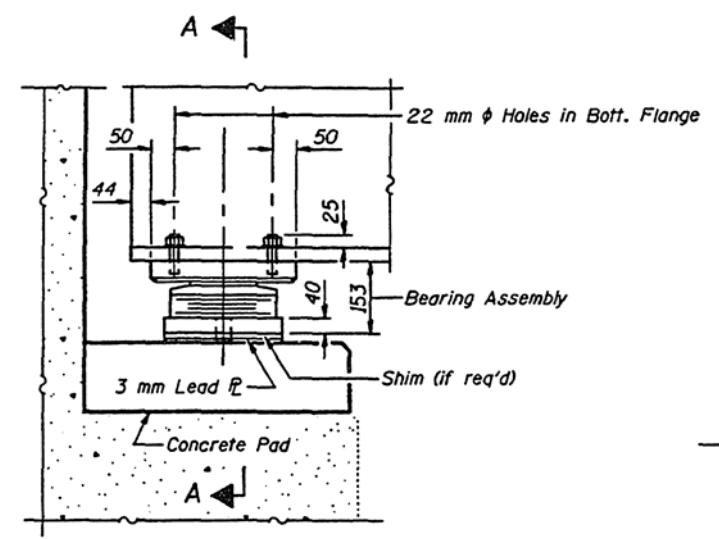


ELEVATION

TYPE II TFE ELASTOMERIC EXP. BRG. (ABUTS.)  
(Beams #1 & #8)

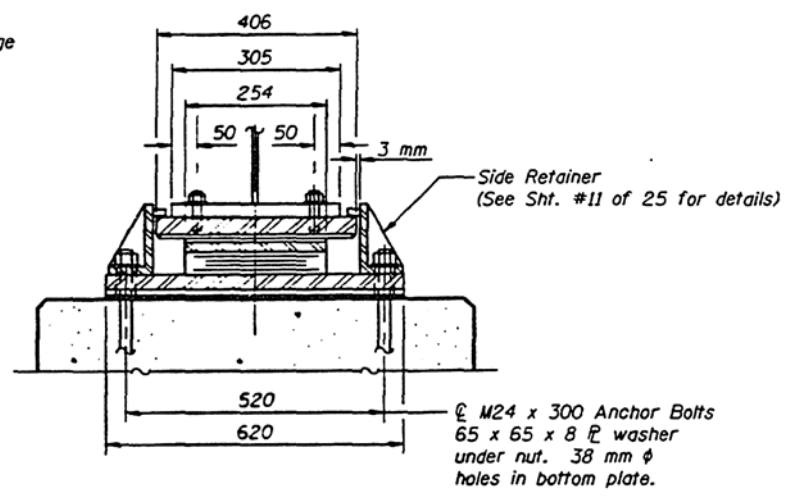


SECTION A-A

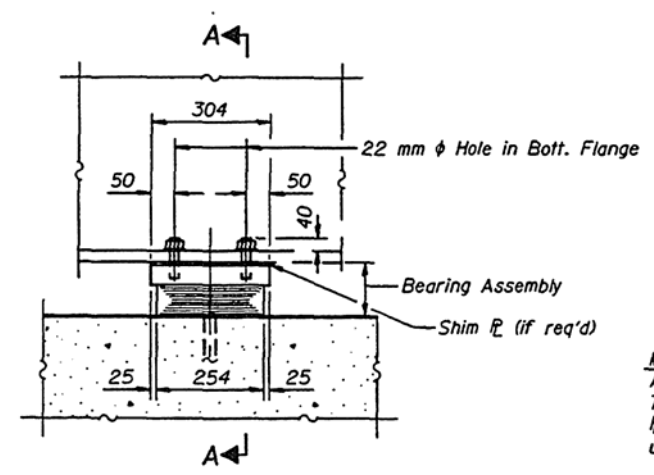


ELEVATION


TYPE I ELASTOMERIC EXP. BRG. AT PIERS 1 & 3  
(Beams #1 & #8)

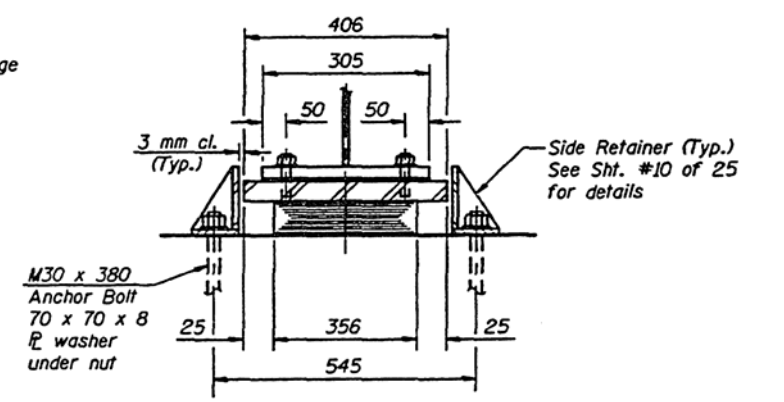

SECTION A-A

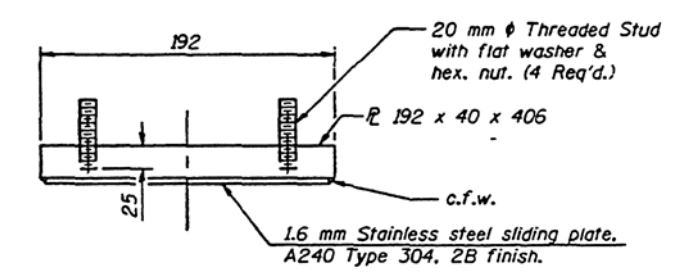


TOP BEARING ASSEMBLY  
(Abutments)

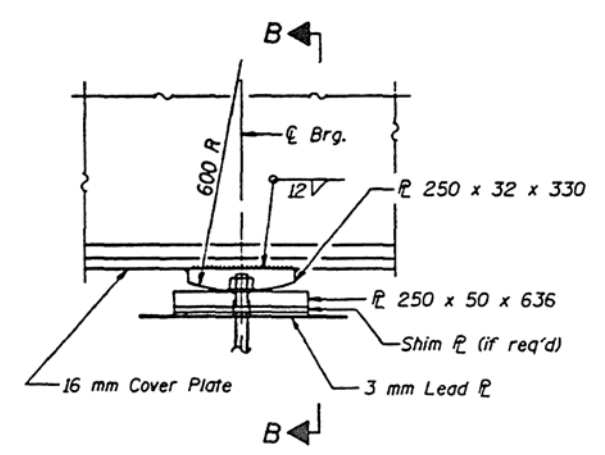


ELEVATION


FIXED BEARING AT PIER 2  
(Beams #1 & #8)

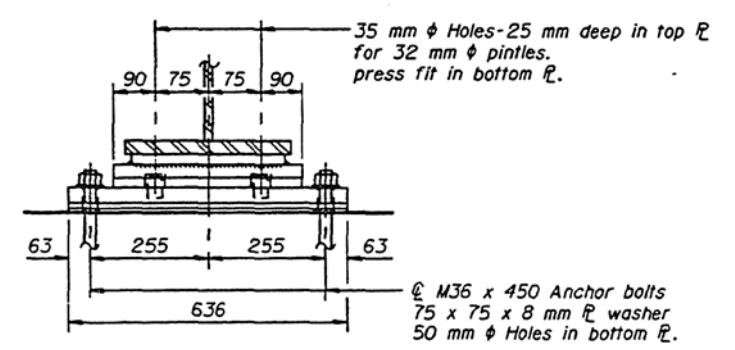

SECTION B-B

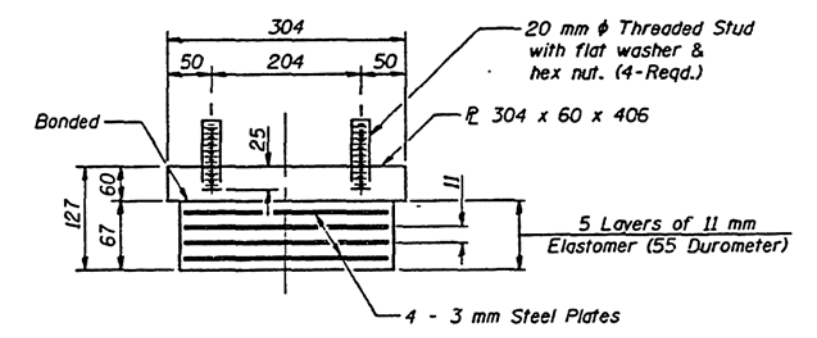

BEARING ASSEMBLY  
(Piers 1 & 3)

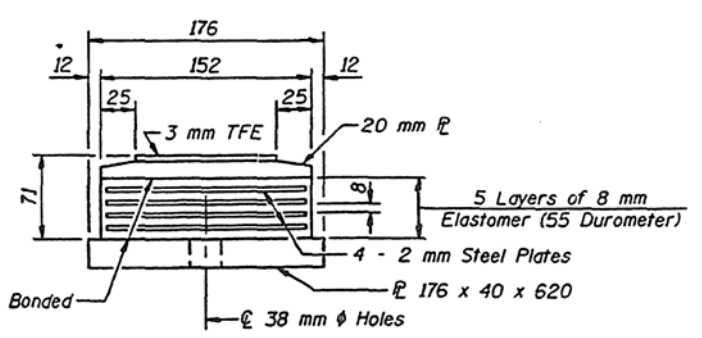


BOTTOM BEARING ASSEMBLY  
(Abutments)

NOTE: See Sht. #24 of 25 for Anchor Bolt installation.  
For Bill of Material See Sht. #10 of 25.  
All dimensions are in millimeters (mm) except as noted.


BEARING DETAILS-NEW BEAMS  
U.S. RTE. 150 (BLOOMINGTON RD.)  
OVER F.A.I. RTE. 57  
SECTION (10-34HB)BR  
STA 4+794.32 (U.S. RTE. 150)  
STA. 17+754.60 (F.A.I. RTE. 57)  
CHAMPAIGN COUNTY  
S.N. 010-0050

<b>LIN ENGINEERING, LTD.</b>	
DESIGN: J.W.	CHECKED: S.F.M
DRAWN: R.C.	DATE: 12/95




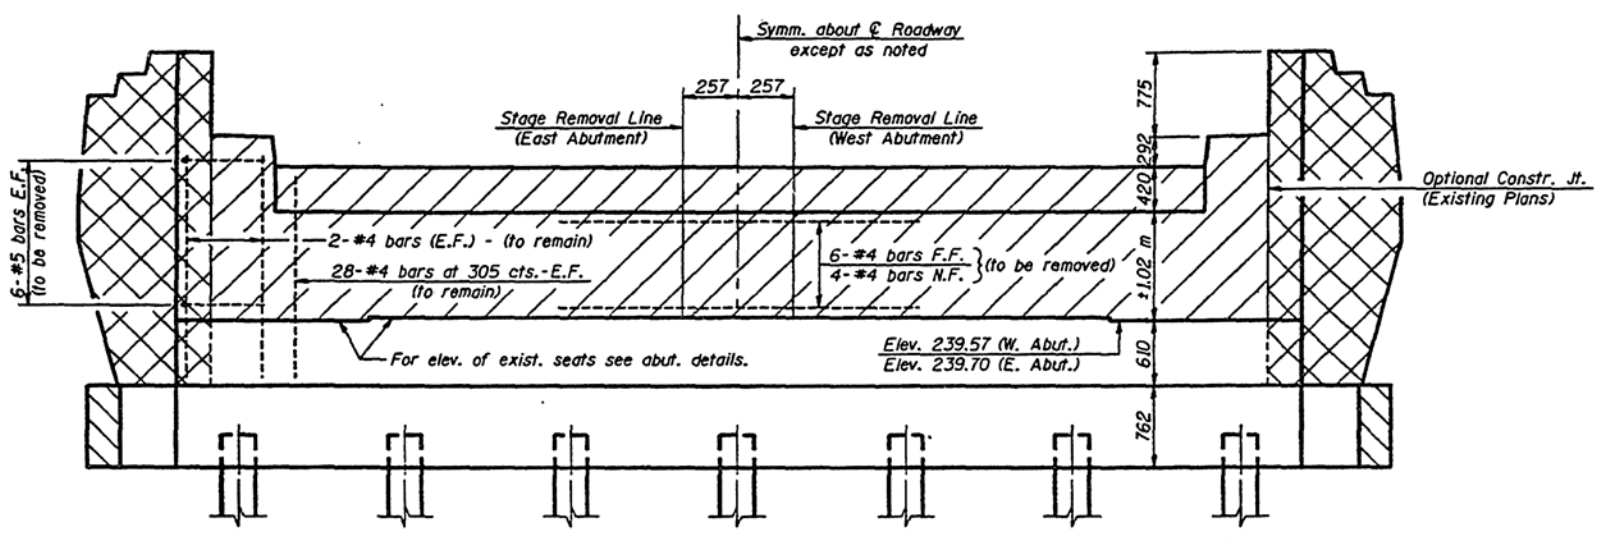

**ELEVATION**  
(Typ. Each Abut.)

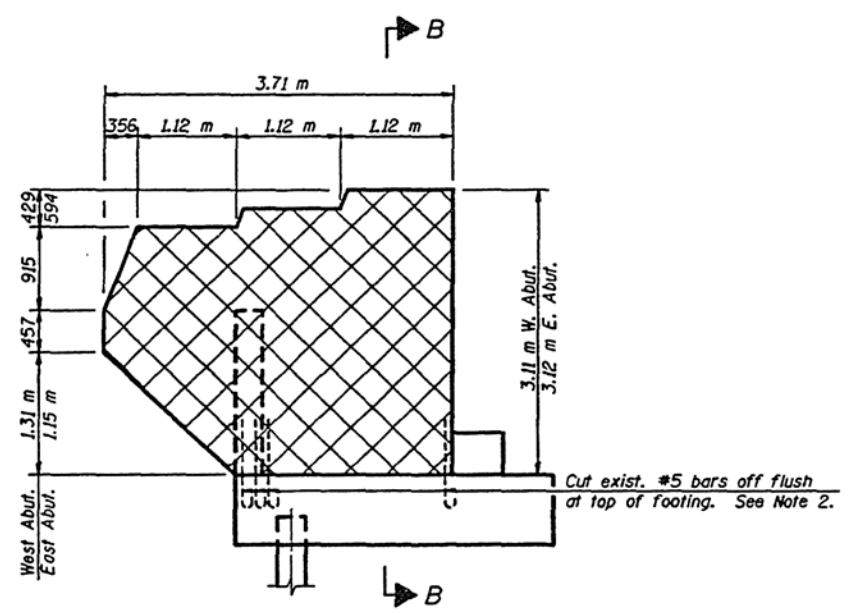



**WINGWALL ELEVATION**

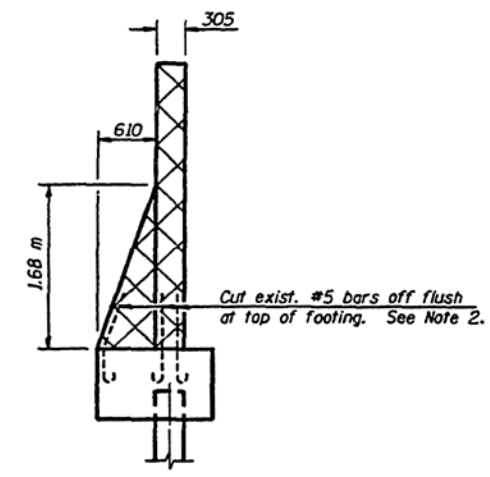


**SECTION B-B**

**NOTE: 1**  
Existing reinforcement bars to be saved shall be cleaned to grey metal by sandblasting in place. The Contractor shall exercise care during Concrete Removal so as not to damage rebar to be reused. Rebars which have been cut or corroded and have lost more than 20% of their Cross Sectional area shall be supplemented by new bars of the same size Spliced in place. The Cost of the above noted work shall not be paid for separately but shall be incidental to Concrete Removal.

**NOTE: 2**  
All Existing Reinforcement Exposed by Concrete Removal which is not being incorporated into New Construction shall be Cut Off Flush with the Remaining Concrete Surfaces and a Layer of 51 mm Cement Mortar shall be Applied to these Surfaces. Cost shall be incidental to Concrete Removal.

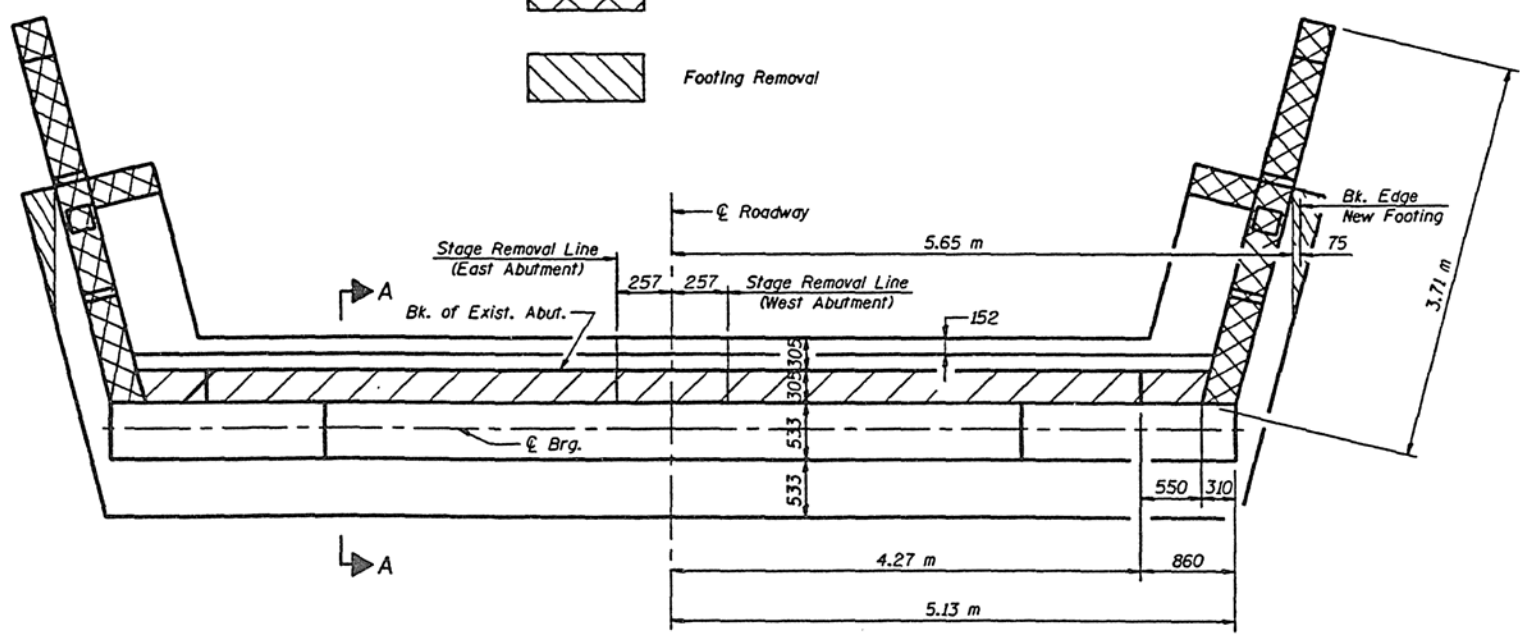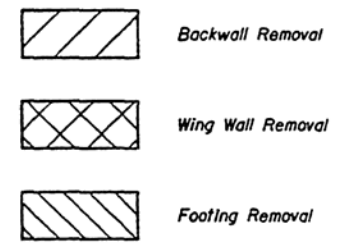

**PLAN**

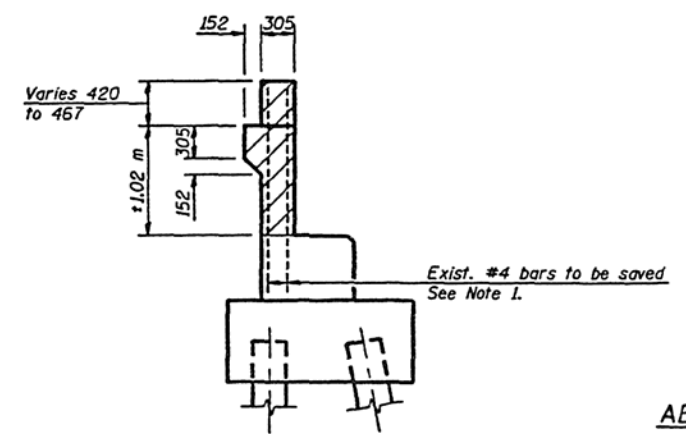

**SECTION A-A**




**BILL OF MATERIAL**  
**TWO ABUTMENTS**

Item	Unit	Total
Concrete Removal	m <sup>3</sup>	20.7

**ABUTMENT CONCRETE REMOVAL DETAILS**  
**U.S. RTE. 150 (BLOOMINGTON RD.)**  
**OVER F.A.I. RTE. 57**  
**SECTION (10-34HB)BR**  
**STA. 4+794.32 (U.S. RTE. 150)**  
**STA. 17+754.60 (F.A.I. RTE. 57)**  
**CHAMPAIGN COUNTY**  
**S.N. 010-0050**

All dimensions are in millimeters (mm) except as noted.  
All existing reinforcement bar sizes shown on this sheet are in English.

**LIN ENGINEERING, LTD.**  
 DESIGNED: J.W. CHECKED: T.M.M.  
 DRAWN: M.C. DATE: 12/95

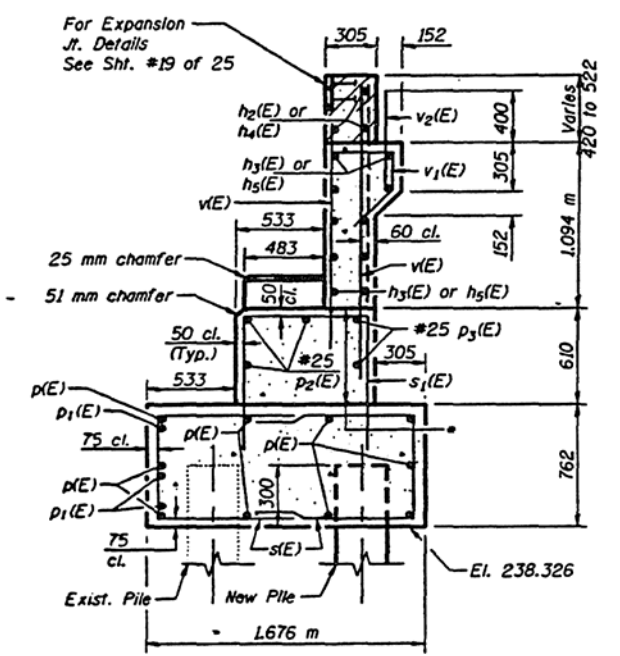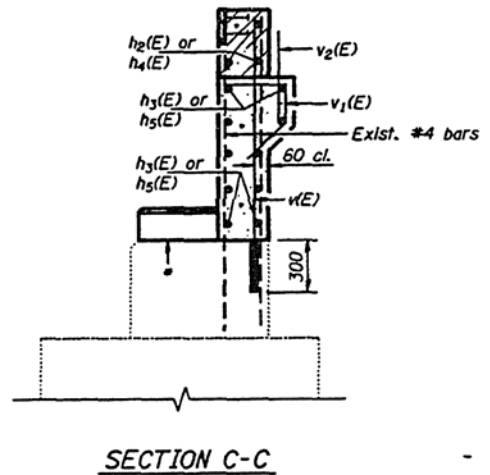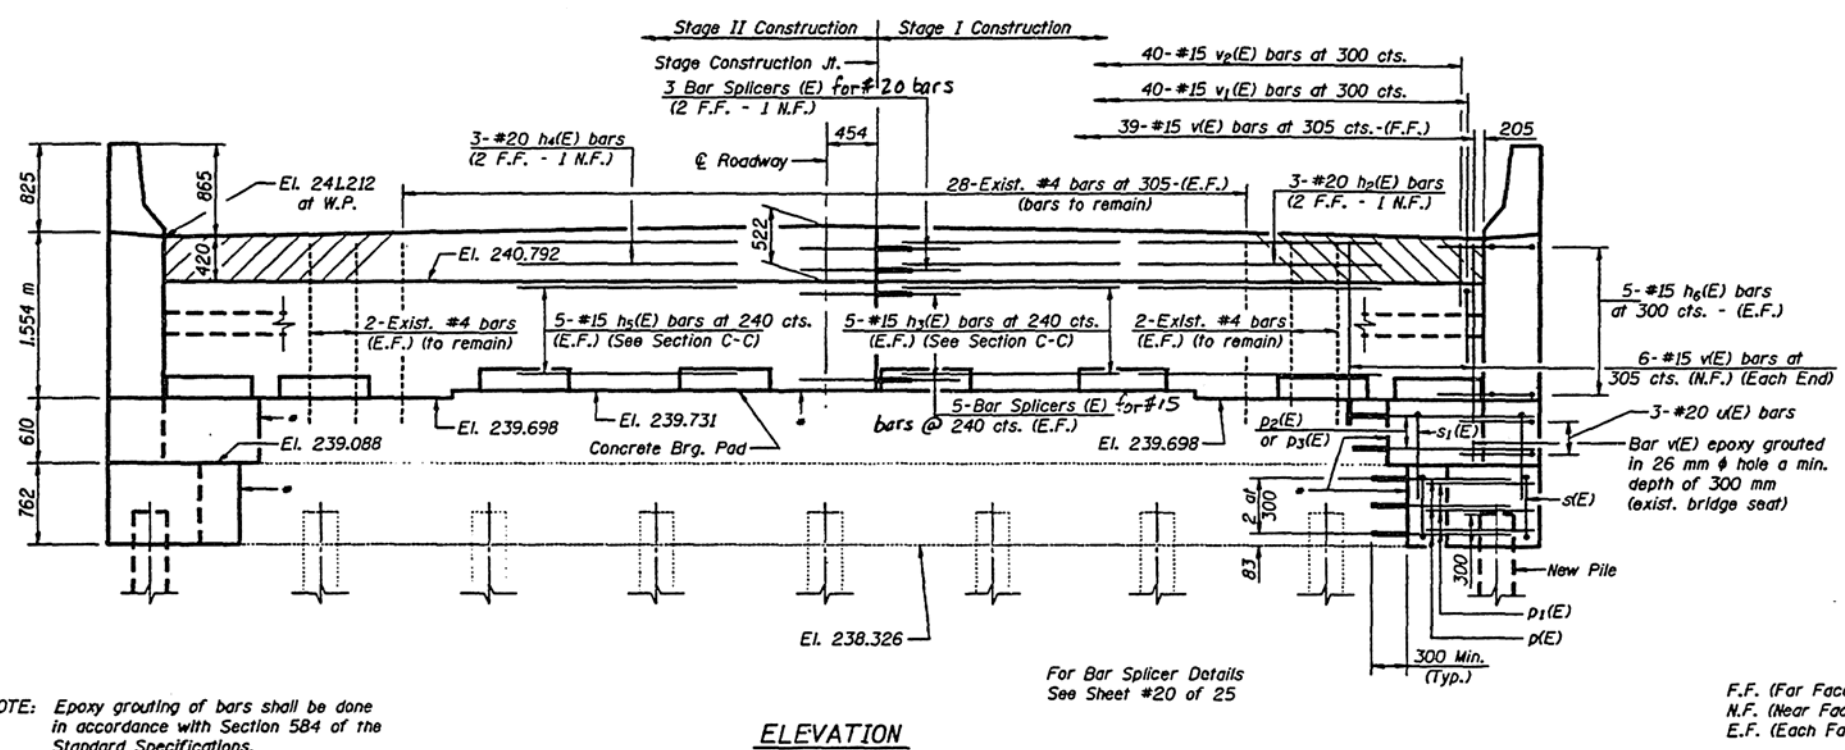

NOTE: Epoxy grouting of bars shall be done in accordance with Section 584 of the Standard Specifications. Provide 26 mm  $\phi$  holes for #20 bars and 21 mm  $\phi$  holes for #15 bars. The grout and method of application shall be approved by the Engineer.

ELEVATION


\* Bonded construction joint

NOTE: Hatched area to be poured after superstructure falsework has been removed. Quantity of concrete included with Concrete Superstructure.


F.F. (Far Face)  
N.F. (Near Face)  
E.F. (Each Face)

TOP OF BRG. PAD ELEVATIONS

Beam	Elevation
1 & 8	239.928
2 & 7	239.924
3 & 6	239.958
4 & 5	239.976

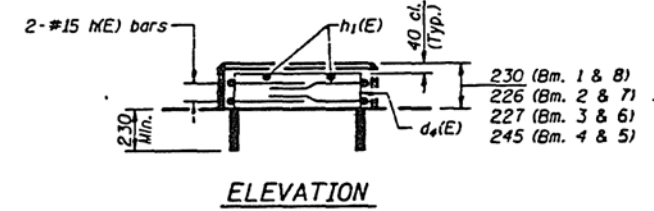


ELEVATION

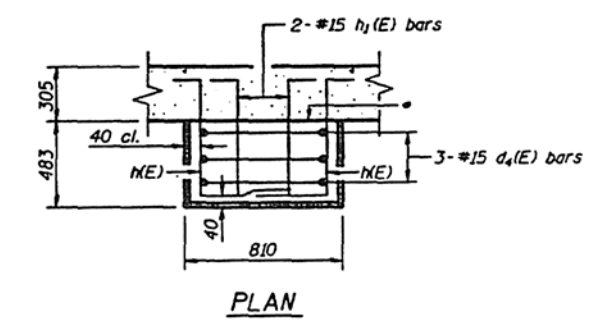

PLAN

BEARING PAD DETAILS  
(8 Thus)

Notes: Space reinforcement in concrete pads to miss anchor bolts. Reinforcement bars designated (E) shall be epoxy coated. All dimensions are in millimeters (mm) except as noted. For Section A-A, Wing Details and Bill of Materials, See Sht. #16 of 25. All existing reinforcement bar sizes shown on this sheet are in English.

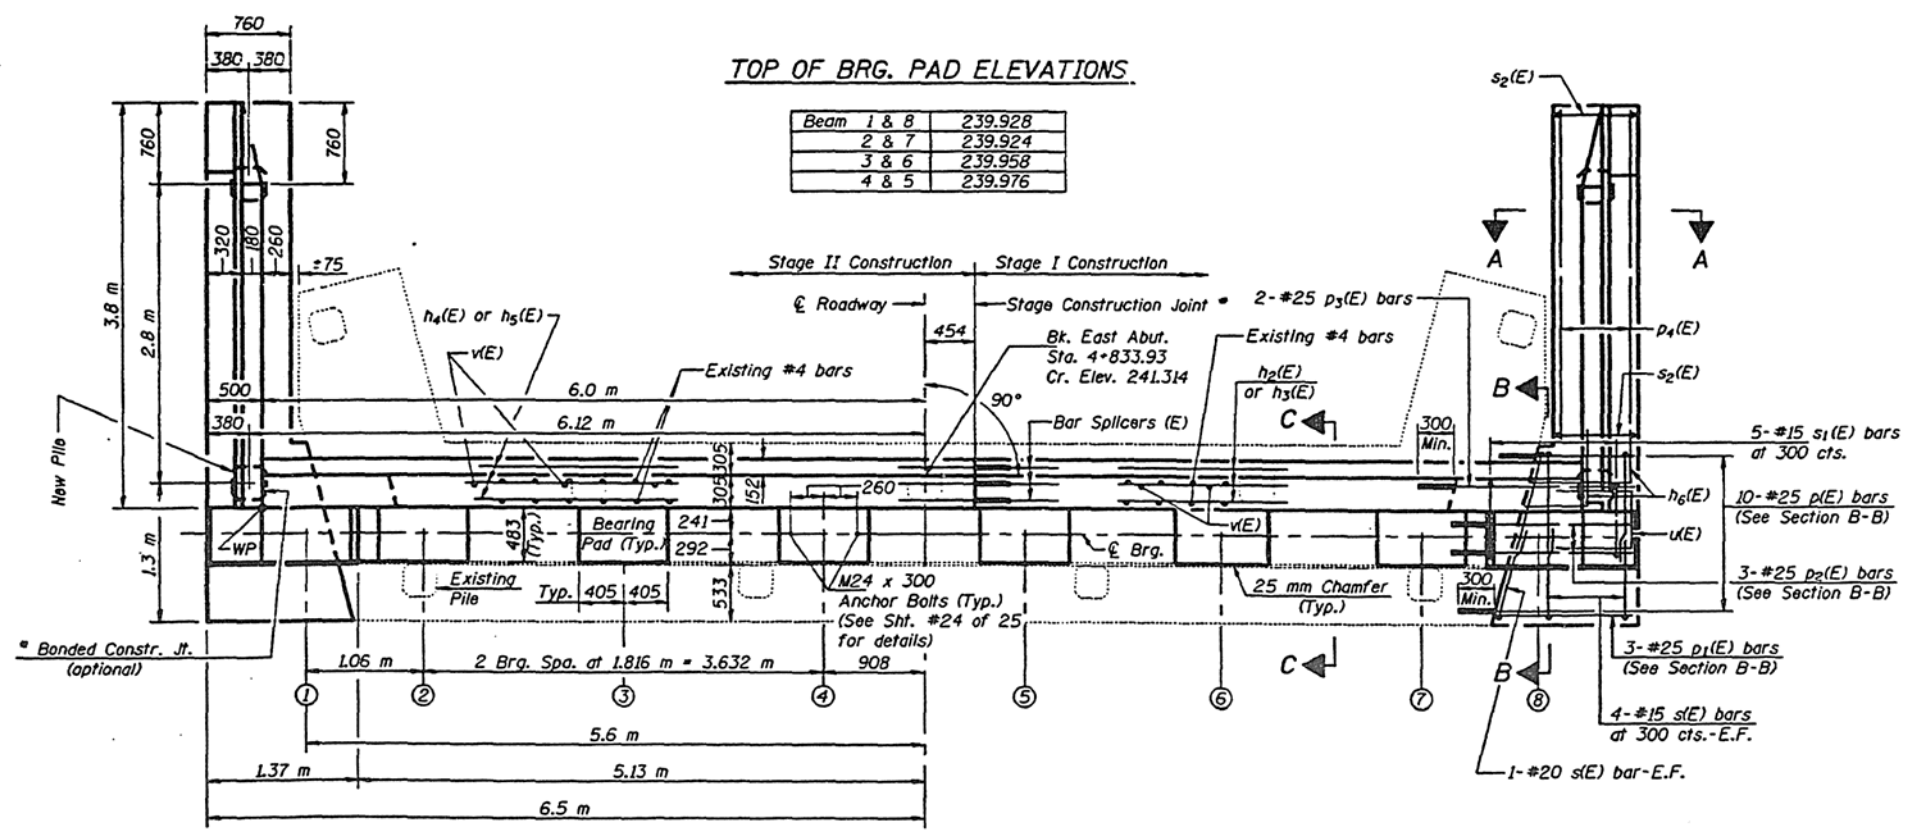

REINFORCEMENT

DIMENSIONS

PLAN


PILE DATA

Type - Concrete  
Capacity - 270 kN  
No. Req'd. - 4  
Est. Length - 10.0 m


**EAST ABUTMENT DETAILS**  
U.S. RTE. 150 (BLOOMINGTON RD.)  
OVER F.A.I. RTE. 57  
SECTION (10-34HB)BR  
STA. 4+794.32 (U.S. RTE. 150)  
STA. 17+754.60 (F.A.I. RTE. 57)  
CHAMPAIGN COUNTY  
S.N. 010-0050






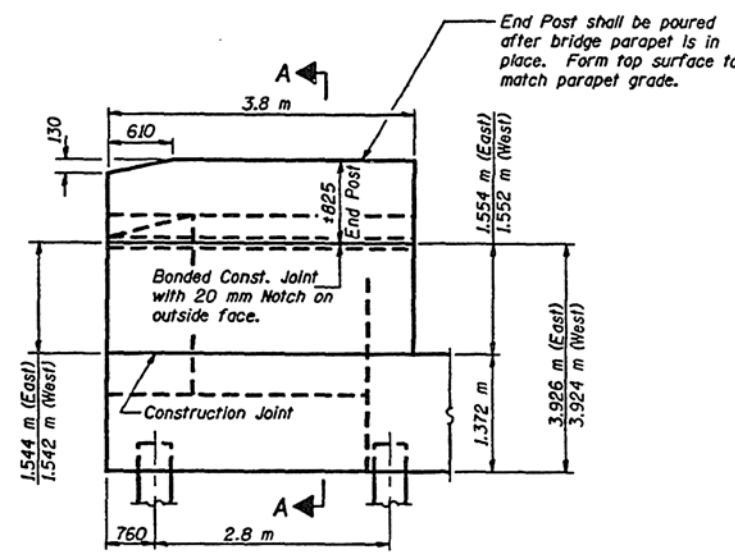


**WING WALL ELEVATION**  
(4 thus)

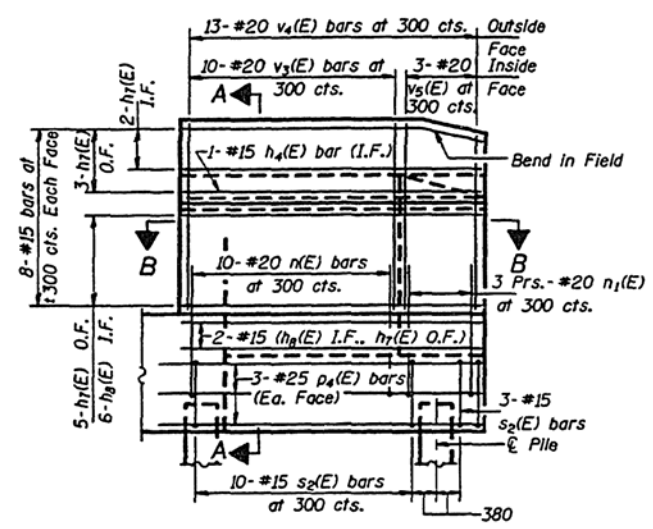


**WING WALL ELEVATION**  
Reinforcement

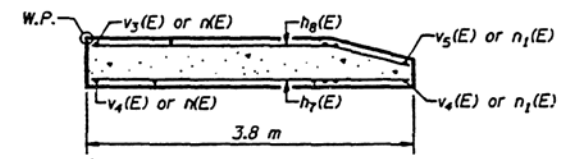


**SECTION B-B**

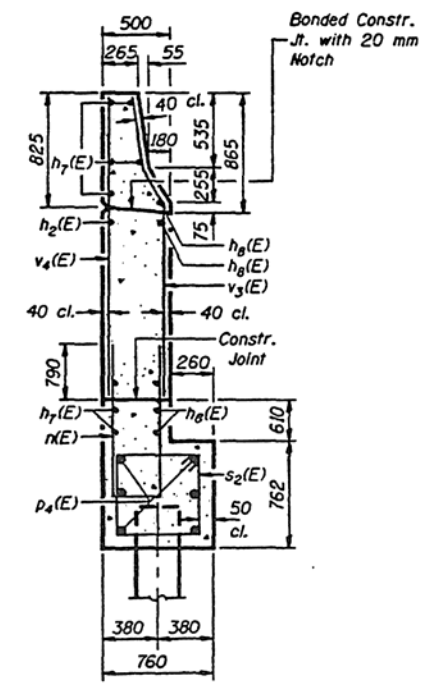


**SECTION A-A**

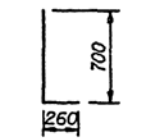


**BAR h1(E)**

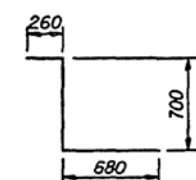


**BAR h(E)**

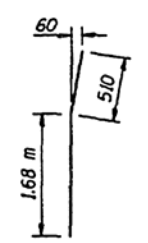


**BAR v5(E)**

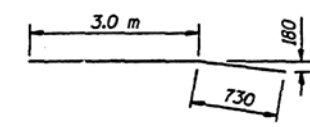


**BAR h8(E)**

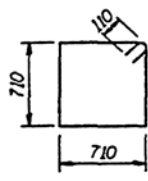


**BAR s2(E)**

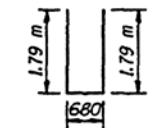


**BAR n(E)**

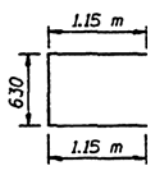


**BAR s(E)**

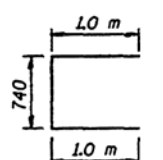


**BAR s1(E)**

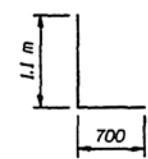


**BAR h6(E)**

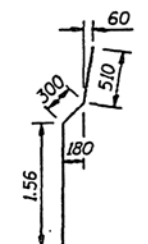


**BAR v3(E)**

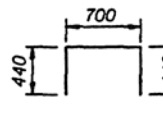


**BAR d4(E)**

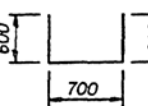


**BAR u(E)**

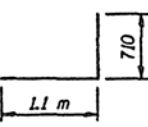

**BAR h6(E)**

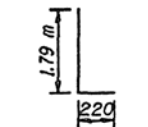

**BAR n1(E)**

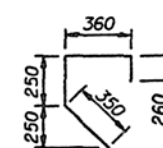

**BAR v1(E)**

**2 ABUTMENTS**  
**BILL OF MATERIAL**

Bar	No.	Size	Length (m)	Shape
d4(E)	48	#15	1.58	┌
n(E)	64	#15	1.64	└
h1(E)	32	#15	0.96	└
h2(E)	8	#20	5.45	└
h3(E)	20	#15	5.45	└
h4(E)	8	#20	6.35	└
h5(E)	20	#15	6.35	└
h6(E)	40	#15	1.81	└
h7(E)	48	#15	3.70	└
h8(E)	32	#15	3.73	└
n(E)	40	#20	4.26	└
n1(E)	24	#20	2.01	└
p(E)	40	#25	1.23	└
p1(E)	12	#25	1.29	└
p2(E)	12	#25	1.63	└
p3(E)	8	#25	1.86	└
p4(E)	24	#25	3.70	└
s(E)	40	#15	2.93	└
s1(E)	20	#15	2.74	└
s2(E)	52	#15	3.06	└
u(E)	12	#20	1.90	└
v(E)	102	#15	1.78	└
v1(E)	80	#15	1.22	└
v2(E)	80	#15	0.80	└
v3(E)	40	#20	2.37	└
v4(E)	52	#20	2.33	└
v5(E)	12	#20	2.19	└
Structure Excavation	Cu. m		82.6	
Concrete Structures	Cu. m		45.5	
Reinforcement Bars (Epoxy Coated)	kg		4,320	
Test Piles	Each		1	
Furnishing Conc. Piles	Lin. m		73.0	
Driving Conc. Piles	Lin. m		73.0	

Reinforcement bars designated (E) shall be epoxy coated.  
All dimensions are in millimeters (mm) except as noted.

**ABUTMENT DETAILS**  
**U.S. RTE. 150 (BLOOMINGTON RD.)**  
**OVER F.A.I. RTE. 57**  
**SECTION (10-34HB)BR**  
**STA. 4+794.32 (U.S. RTE. 150)**  
**STA. 17+754.60 (F.A.I. RTE. 57)**  
**CHAMPAIGN COUNTY**  
**S.N. 010-0050**


**LIN ENGINEERING, LTD.**  
DESIGNED: J.W. CHECKED: S.F.M.  
DRAWN: M.C. DATE: 12/95






**NOTES**


- 1) Epoxy grouted bars shall be done in accordance with Section 584 of the Standard Specifications. Provide 21 mm  $\phi$  holes to depth indicated for #15 bars and 26 mm  $\phi$  holes for #20 bars. The grout and method of application shall be approved by the Department.
- 2) Space reinforcement in conc. pad to miss anchor bolts and exist. reinforcement
- 3) All edges shall have standard 20 mm chamfers except as noted.
- 4) All dimensions are in millimeters (mm) except as noted.
- 5) For Anchor Bolt Installation See Sht. #24 of 25.
- 6) Bonded construction joint standard specifications.

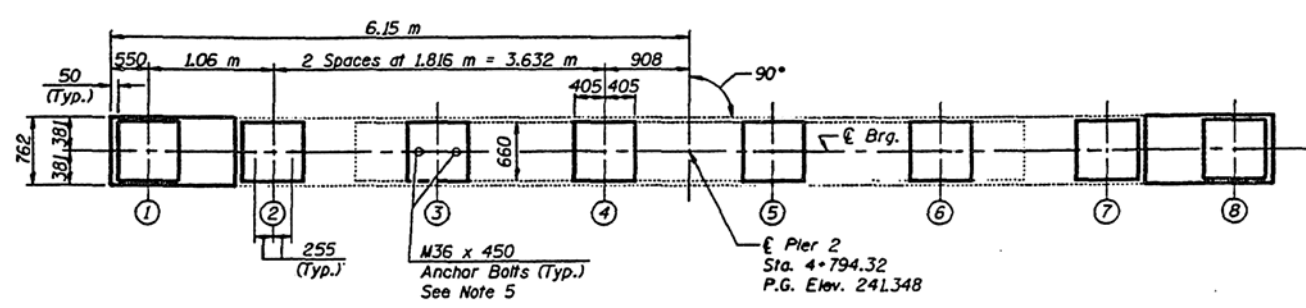

**TOP PLAN**

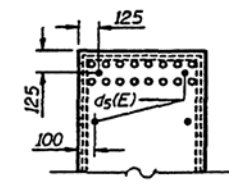


**SECTION B-B**

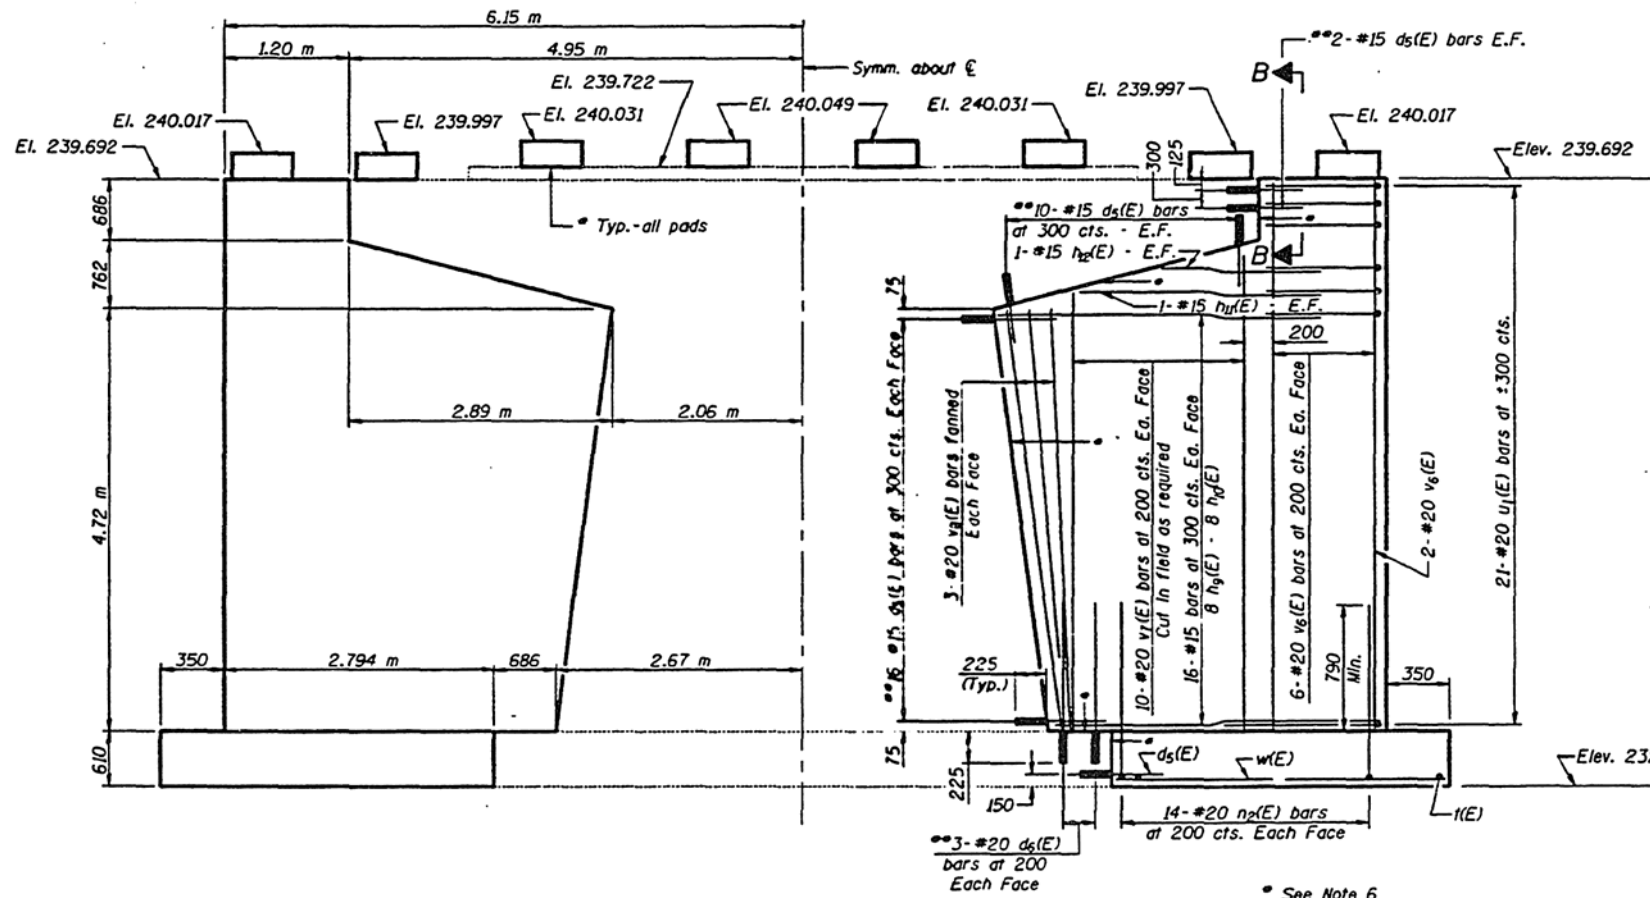


**ELEVATION**

• See Note 6  
 •• See Note 1  
 Maximum Pressure = 143.6 KPa

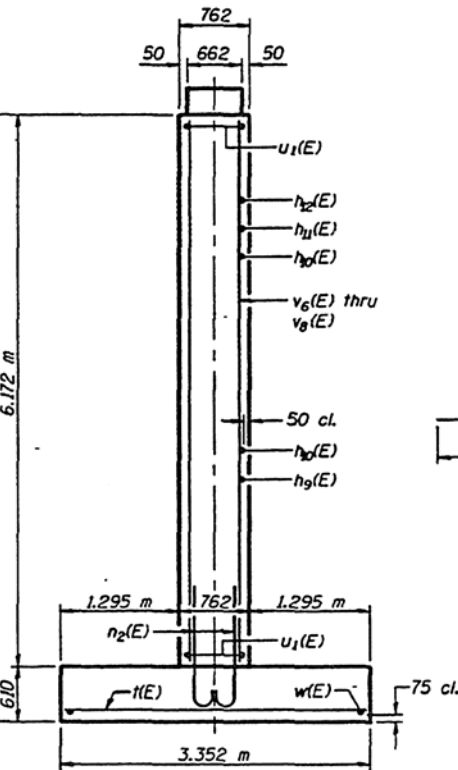


**END VIEW**

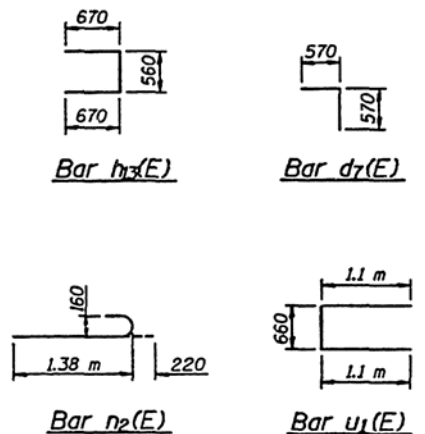


**BILL OF MATERIAL**

Bar	No.	Size	Length (m)	Shape
d5(E)	136	#15	0.90	—
d6(E)	12	#20	1.06	—
d7(E)	96	#20	1.14	—
h9(E)	32	#15	3.27	—
h2(E)	32	#15	3.55	—
h1(E)	4	#15	2.74	—
h2(E)	4	#15	1.45	—
h3(E)	32	#15	1.90	—
n2(E)	56	#20	1.60	—
n(E)	22	#25	3.25	—
u1(E)	42	#20	2.86	—
v6(E)	28	#20	6.10	—
v7(E)	40	#20	5.41	—
v8(E)	12	#20	4.72	—
w(E)	24	#15	3.05	—
Structure Excavation		Cu. m	45.2	
Concrete Structures		Cu. m	45.7	
Reinforcement Bars, Epoxy Coated		kg	2,880	


Reinforcement bars designated (E) shall be epoxy coated.

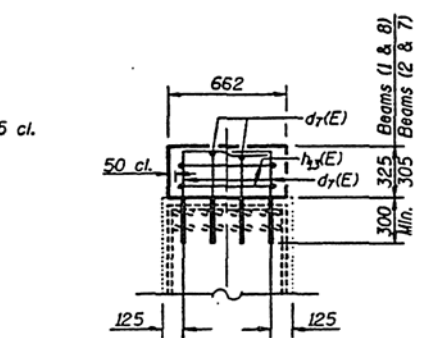


**SECTION A-A**  
(Beams #1,2,7,8)

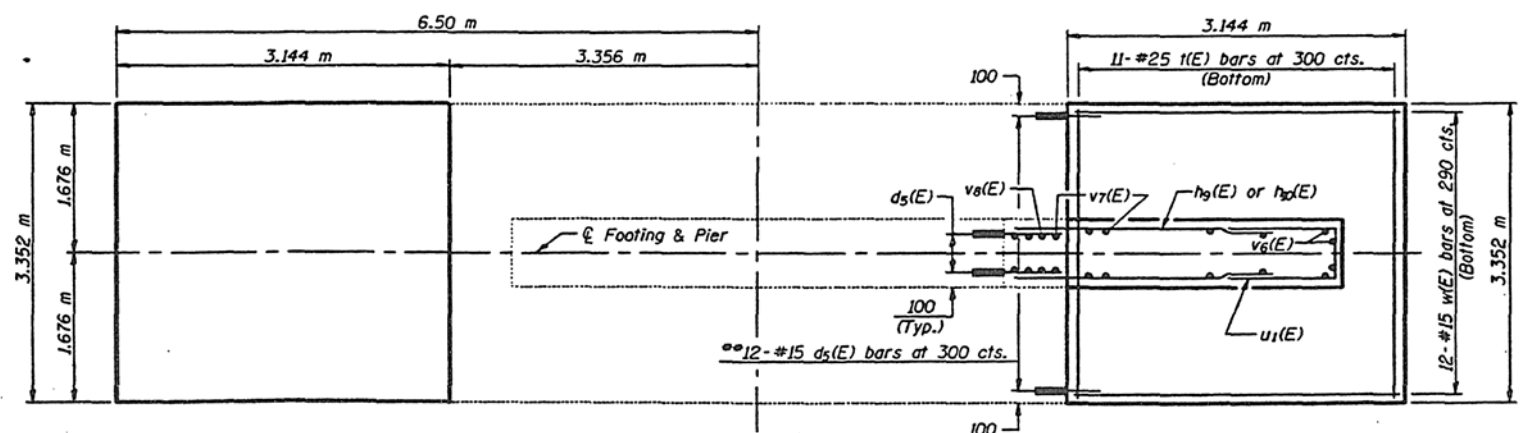

**FOOTING PLAN**

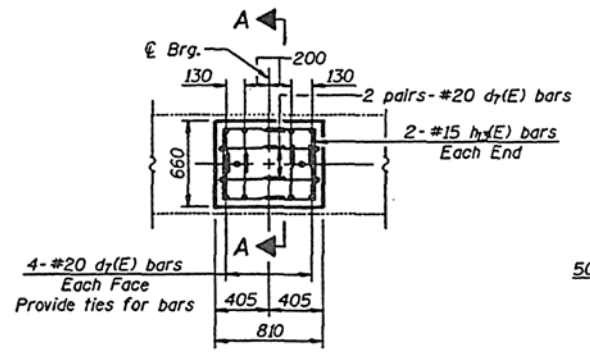


**PLAN-CONC. BRG. PAD**

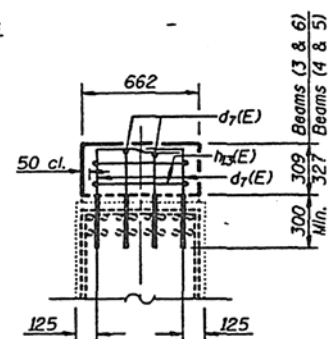

**SECTION A-A**  
(Beams #3 thru #6)

**PIER EXTENSION - PIER 2**  
 U.S. RTE. 150 OVER  
 F.A.I. RTE. 57  
 SECTION (10-34HB)BR  
 STA. 4+794.32 (U.S. RTE. 150)  
 STA. 17+754.60 (F.A.I. RTE. 57)  
 CHAMPAIGN COUNTY  
 S.N. 010-0050



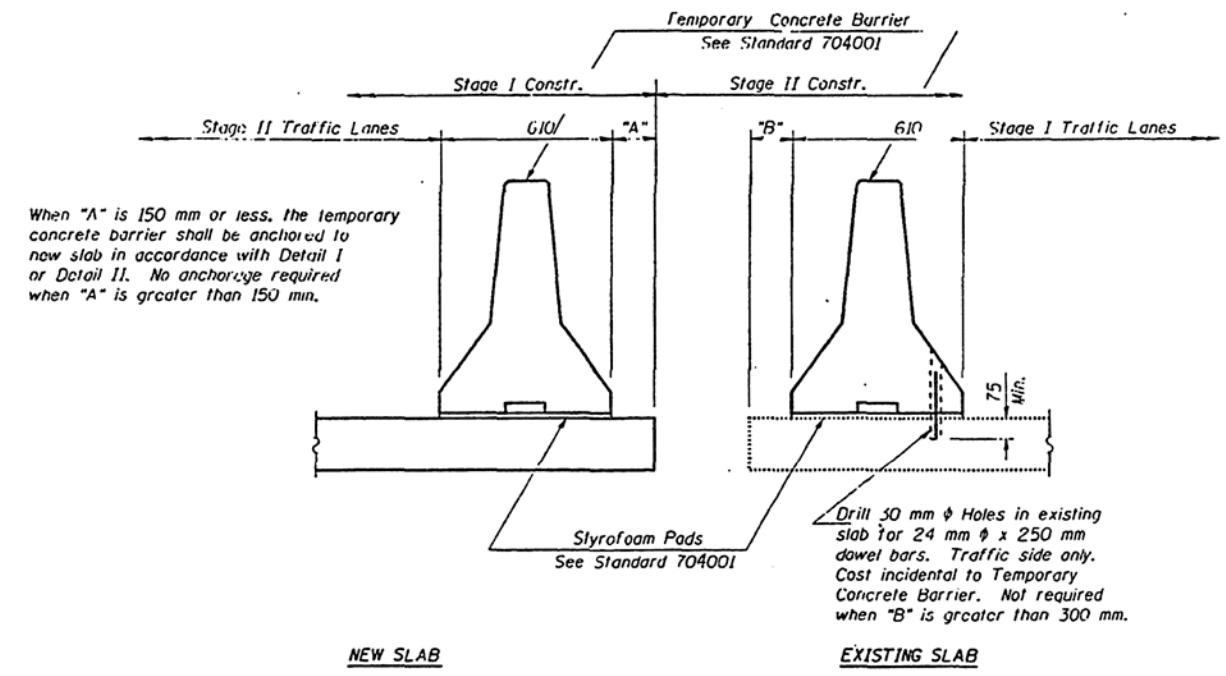

**SECTIONS THRU SLAB**


**NOTES**

**Detail I - With Bar Splicer or Couplers:**  
Connect one (1) 25x180x250 steel  $\bar{r}$  to the top layer of couplers with 2-16 mm  $\phi$  bolts screwed to coupler at approximate  $\bar{c}$  of each 3 m barrier panel.


**Detail II - With Extended Reinforcement Bars:**  
Connect one (1) 25x180x250 steel  $\bar{r}$  to the concrete slab with 2-16 mm  $\phi$  Expansion Anchors or cast in place inserts spaced between the top layer of reinforcement at approximate  $\bar{c}$  of each 3 m barrier panel.

Cost of anchorage is incidental to Temporary Concrete Barrier.

All dimensions are in millimeters (mm) except as noted.

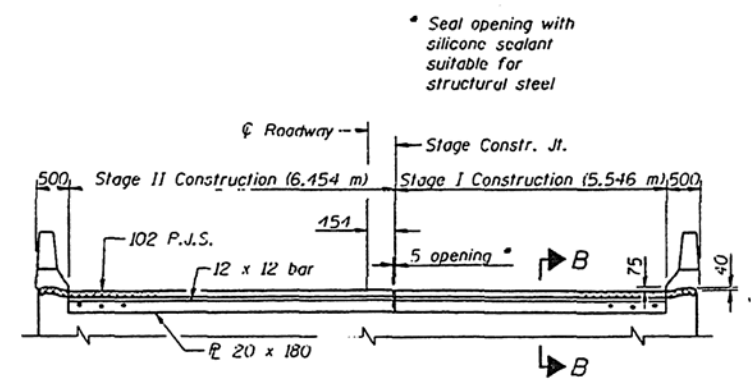

**ELEVATION**

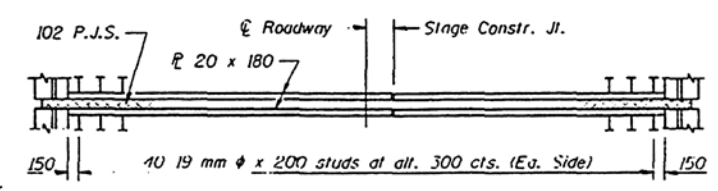


**PLAN**


**EXPANSION JOINT**

Last Abut. shown  
West Abut. - Opposite Hand


NOTE: After fabrication, all surfaces of the steel plates shall be given one shop coat of paint specified for Structural Steel.  
Cost of structural steel included in pay item for Structural Steel.

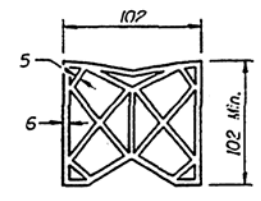

**PREFORMED JOINT SEAL 102 mm**

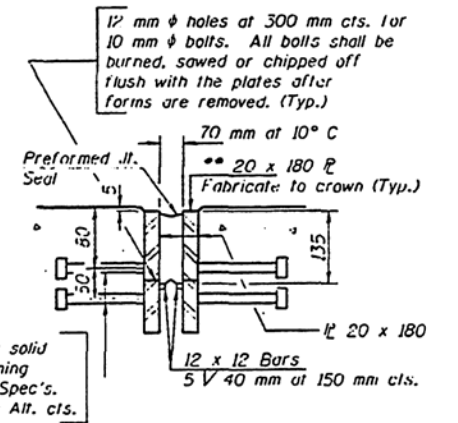


19 mm  $\phi$  x 200 mm granular or solid flux filled headed studs conforming to Article 1006.32 of the Std. Spec's. automatically end welded at 300 Air. cts.

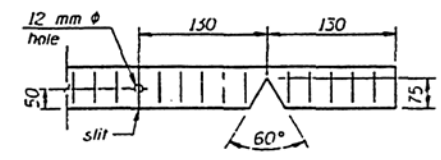


**SEAL CUT-OUT (102 mm)**


**PREFORMED JOINT SEAL DETAILS**

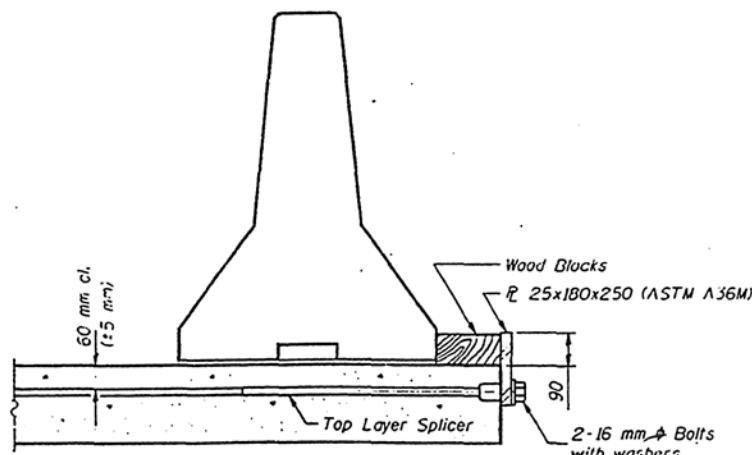

The 25x180x250 Plate shall not be removed until Stage II Construction forms and reinforcement bars are in place.

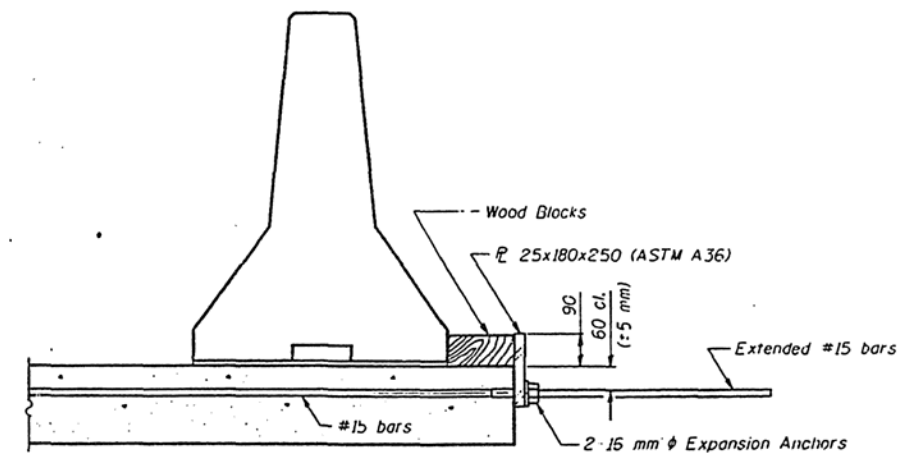

The 25x180x250 Plate shall not be removed until Stage II Construction forms and all reinforcement bars are in place and the concrete is ready to be placed.

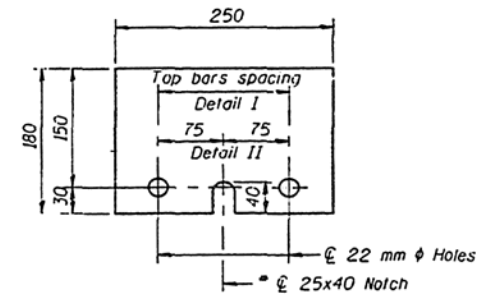

**TEMPORARY CONCRETE BARRIER AND PREFORMED JOINT SEAL DETAILS**  
U.S. RTE. 150 (BLOOMINGTON RD.)  
OVER F.A.I. RTE. 57  
SECTION (10-34HB)BR  
STA. 4+794.32 (U.S. RTE. 150)  
STA. 17+754.60 (F.A.I. RTE. 57)  
CHAMPAIGN COUNTY  
S.N. 010-0050


REVISIONS		DATE
NAME		
B. BLAND		3-7-97

DESIGNED: J.W. DRAWN: K.C.		CHECKED: T.M.M. DATE: 12/95	
-------------------------------	--	--------------------------------	--

**LIN ENGINEERING, LTD.**

STATE OF ILLINOIS  
DEPARTMENT OF TRANSPORTATION


DATE	BY	NO.	REV.	SHEET NO. 20
4/7	35			25 SHEETS

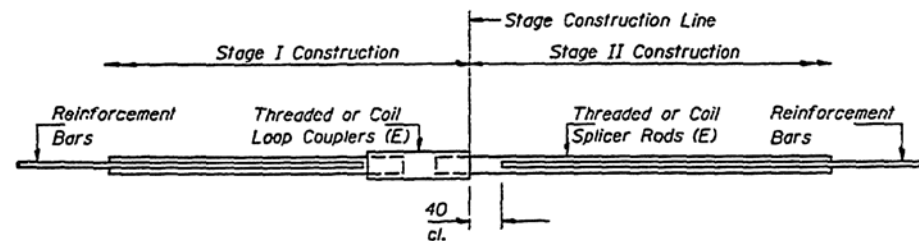

BAR SPLICER ASSEMBLY DETAIL

Bar Size	No. Assemblies Required	Location
20	3	E. Abut.
15	10	E. Abut.
20	3	W. Abut.
15	10	W. Abut.
15	724	Superstructure


The diameter of this part is equal or larger than the diameter of bar spliced.

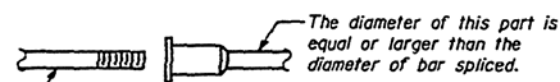

ROLLED THREAD DOWEL BAR




ONE PIECE

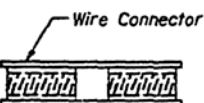

WELDED SECTIONS


BAR SPLICER ASSEMBLY ALTERNATIVES

\*\* Heavy Hex Nuts conforming to ASTM A 563M, Grade C, D or DH may be used.

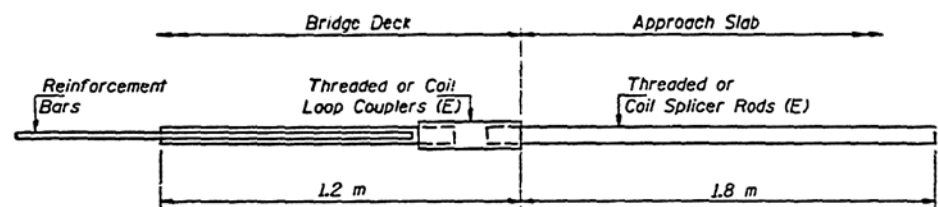

INTEGRAL ABUTMENT  
BAR SPLICER ASSEMBLY DETAIL  
FOR #15 BAR

Min. Capacity = 100 kN - tension
Min. Pull-out Strength = 40 kN - tension
No. Required =

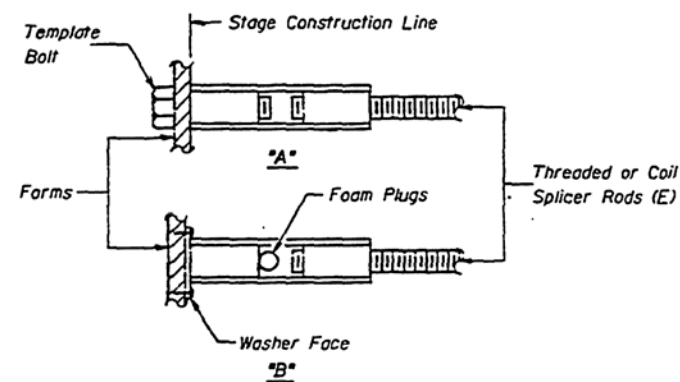

INSTALLATION AND SETTING METHODS

"A": Set bar splicer assembly by means of a template bolt.  
"B": Set bar splicer assembly by nailing to wood forms or cementing to steel forms.  
(E): Indicates epoxy coating.

NOTES

Bar splicer assemblies shall be of an approved type and shall develop in tension at least 125 percent of the yield strength of the lapped reinforcement bars. Splicer rods shall be of minimum 400 MPa yield strength, threaded or coiled full length. All reinforcement bars shall be lapped and tied to the splicer rods or dowel bars. Bar splicer assemblies shall be epoxy coated according to the requirements for reinforcement bars.

Other systems of similar design may be submitted to the Engineer for approval. Approval shall be based on certified test results from an approved testing laboratory that the proposed bar splicer assembly satisfies the following requirements:

- ① Minimum Capacity =  $1.25 \times 10^{-3} \times f_y \times A_1$   
(Tension in kN)
- ② Minimum Pull-out Strength =  $1.25 \times 10^{-3} \times f_{sallow} \times A_1$   
(Tension in kN)

Where  $f_y$  = Yield strength of lapped reinforcement bars in MPa.  
 $f_{sallow}$  = Allowable tensile stress in lapped reinforcement bars in MPa (Service Load)  
 $A_1$  = Tensile stress area of lapped reinforcement bars ( $mm^2$ ).  
\* = 28 day concrete

Bar Size to be Spliced	Splicer Rod or Dowel Bar Length	Strength Requirements	
		Min. Capacity kN - tension	Min. Pull-Out Strength kN - tension
#15	610 mm	100	40
#20	790 mm	150	60
#25	104 m	250	100
#30	137 m	350	140

Bar splicer assemblies shall be according to Section 508 of the Standard Specifications, except as noted. The furnishing and installation of bar splicer assemblies will be measured and paid for at the contract unit price each for "BAR SPLICERS."  
All dimensions are in millimeters (mm) except as noted.

DESIGNED
CHECKED
DRAWN
CHECKED

BSD-1 (M) 4-30-97

BAR SPLICER ASSEMBLY DETAILS  
SECTION (10-34HB)BR  
STA. 4+794.32  
CHAMPAIGN COUNTY












The Illinois Coil-Lock Anchor Bolt is a proprietary item which is the property of the Illinois Department of Transportation. Use, reproduction or disclosure without express written permission is prohibited and protected under Federal copyright laws. The production and the fabrication of this bolt for use on highway projects in the State of Illinois shall be permitted and there shall be no incurred charges or fees to the manufacturer or the fabricator for producing or fabricating this bolt.

D	E	H	K	"d"
25	28	21	44	6
32	35	28	51	10
38	41	34	54	13
50	53	46	73	15
65	68	61	86	25

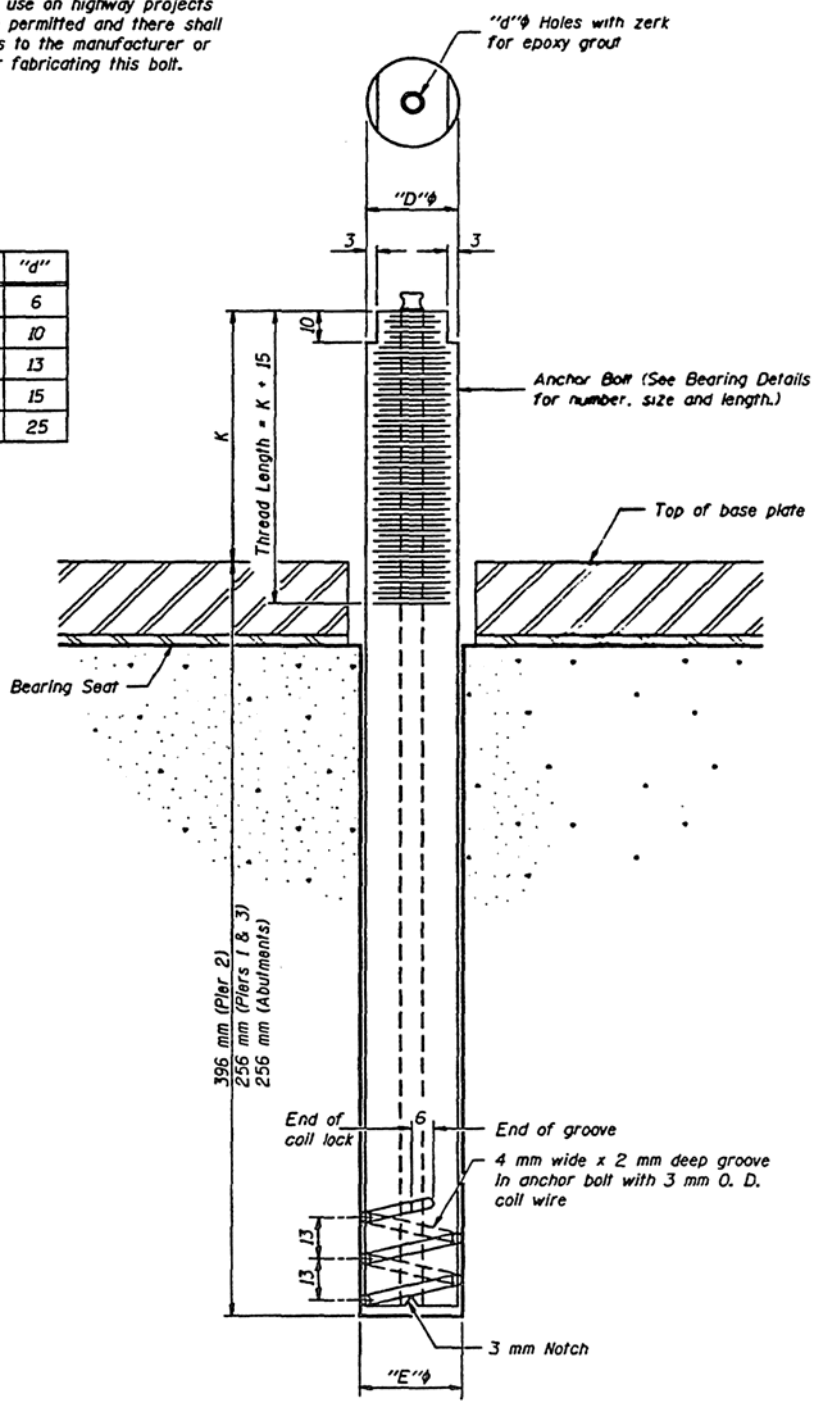

ILLINOIS COIL-LOCK ANCHOR BOLT

**MATERIALS FOR ILLINOIS COIL-LOCK ANCHOR BOLT**


The anchor bolt shall be fabricated from cold drawn or hot finished seamless carbon steel mechanical tubing conforming to ASTM A519, Grade 1026 and supplied with hexagonal nuts and cut washers.  
 The coil wire shall be made of any suitable soft steel wire.  
 The finished anchor bolt shall be cleaned of rust and other foreign materials and wrapped or packaged to prevent contamination until they are installed.  
 The epoxy grout shall be a two-component, epoxy resin bonding system conforming to ASTM C881 Type I, Grade 1 and of a Class suitable for the temperature of installation.

**INSTALLATION PROCEDURE for the ILLINOIS COIL-LOCK ANCHOR BOLT**

1. With the coil wire in place, the bolt shall be inserted into the hole and turned clockwise to a snug fit in the hole. Nut and washer shall be placed on the bolt. The nut shall be tensioned until the steel base plates are held securely to the concrete bearing seat.
2. Epoxy grout shall be pumped through the zerk fitting with a pressure gun. Pumping shall continue until the epoxy overflows the hole around the bolt shank. After pumping is discontinued, excess epoxy shall be immediately wiped off.

**ALTERNATE ANCHOR BOLTS**

The Contractor may use, at his option, the capsule or the adhesive cartridge type anchor rods that have been previously tested and given a prior approval by the Department. The Contractor shall install these anchor rods in pre-drilled holes in accordance with the manufacturer's recommendations and procedures.  
 The capsule or the adhesive cartridge type anchor rods shall be a two part system composed of:  
 1. A threaded rod stud with nut and washer conforming to ASTM A307.  
 2. A sealed glass capsule or a sealed glass adhesive cartridge containing premeasured amounts of the adhesive chemical.

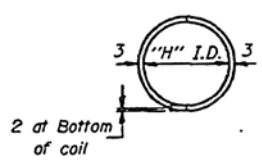

PLAN-COIL WIRE


**GENERAL NOTES**

Holes in the masonry for anchor bolts shall be drilled through the base plates to the diameter and depth shown or in accordance with the manufacturer's recommendation after beams or girders have been erected and adjusted.  
 Prior to setting the bolts, the holes shall be dry and all dust and loose particles shall be removed by the use of compressed air or vacuuming.  
 The anchor bolts, furnished and installed including the epoxy grout or capsules shall not be paid for separately but shall be included in the unit bid price for "Furnishing and Erecting Structural Steel".  
 All dimensions are in millimeters (mm) except as noted.



**ANCHOR BOLT DETAILS**  
 U.S. RTE. 150 (BLOOMINGTON RD.)  
 OVER F.A.I. RTE. 57  
 SECTION (10-34HB)BR  
 STA. 4+794.32 (U.S. RTE. 150)  
 STA. 17+754.60 (F.A.I. RTE. 57)  
 CHAMPAIGN COUNTY  
 S.N. 010-0050






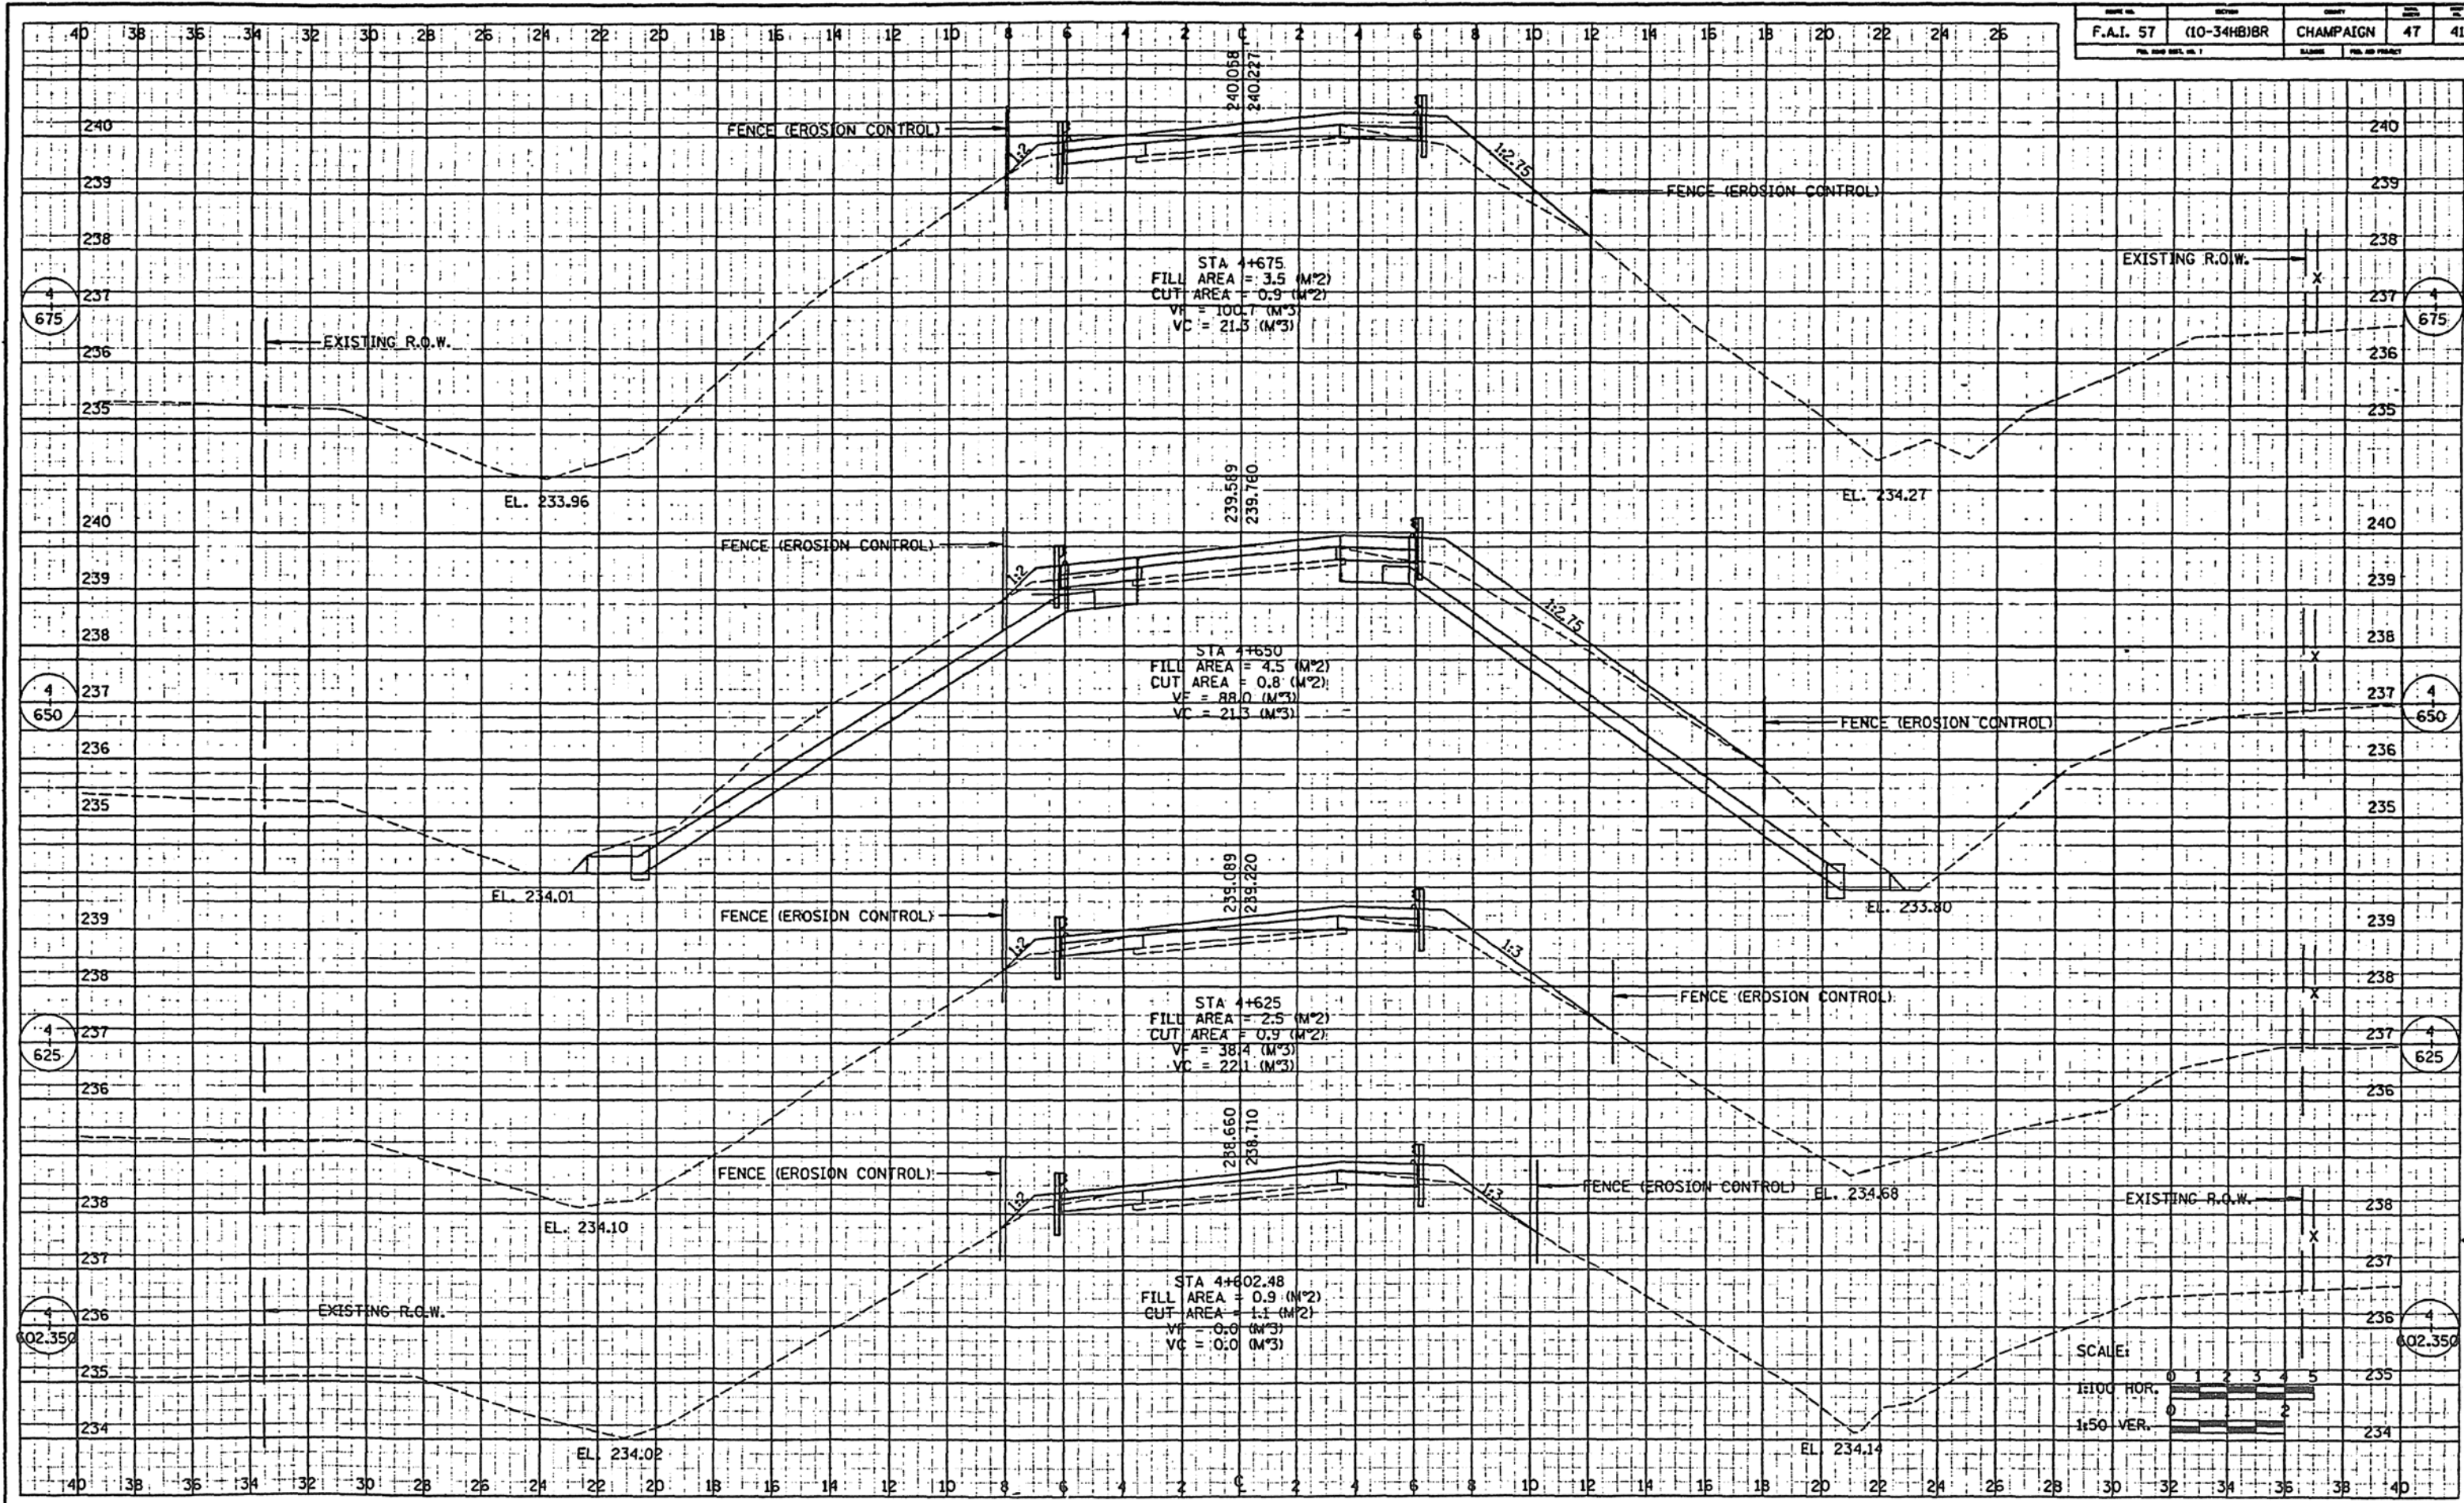



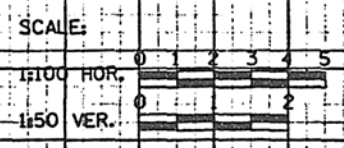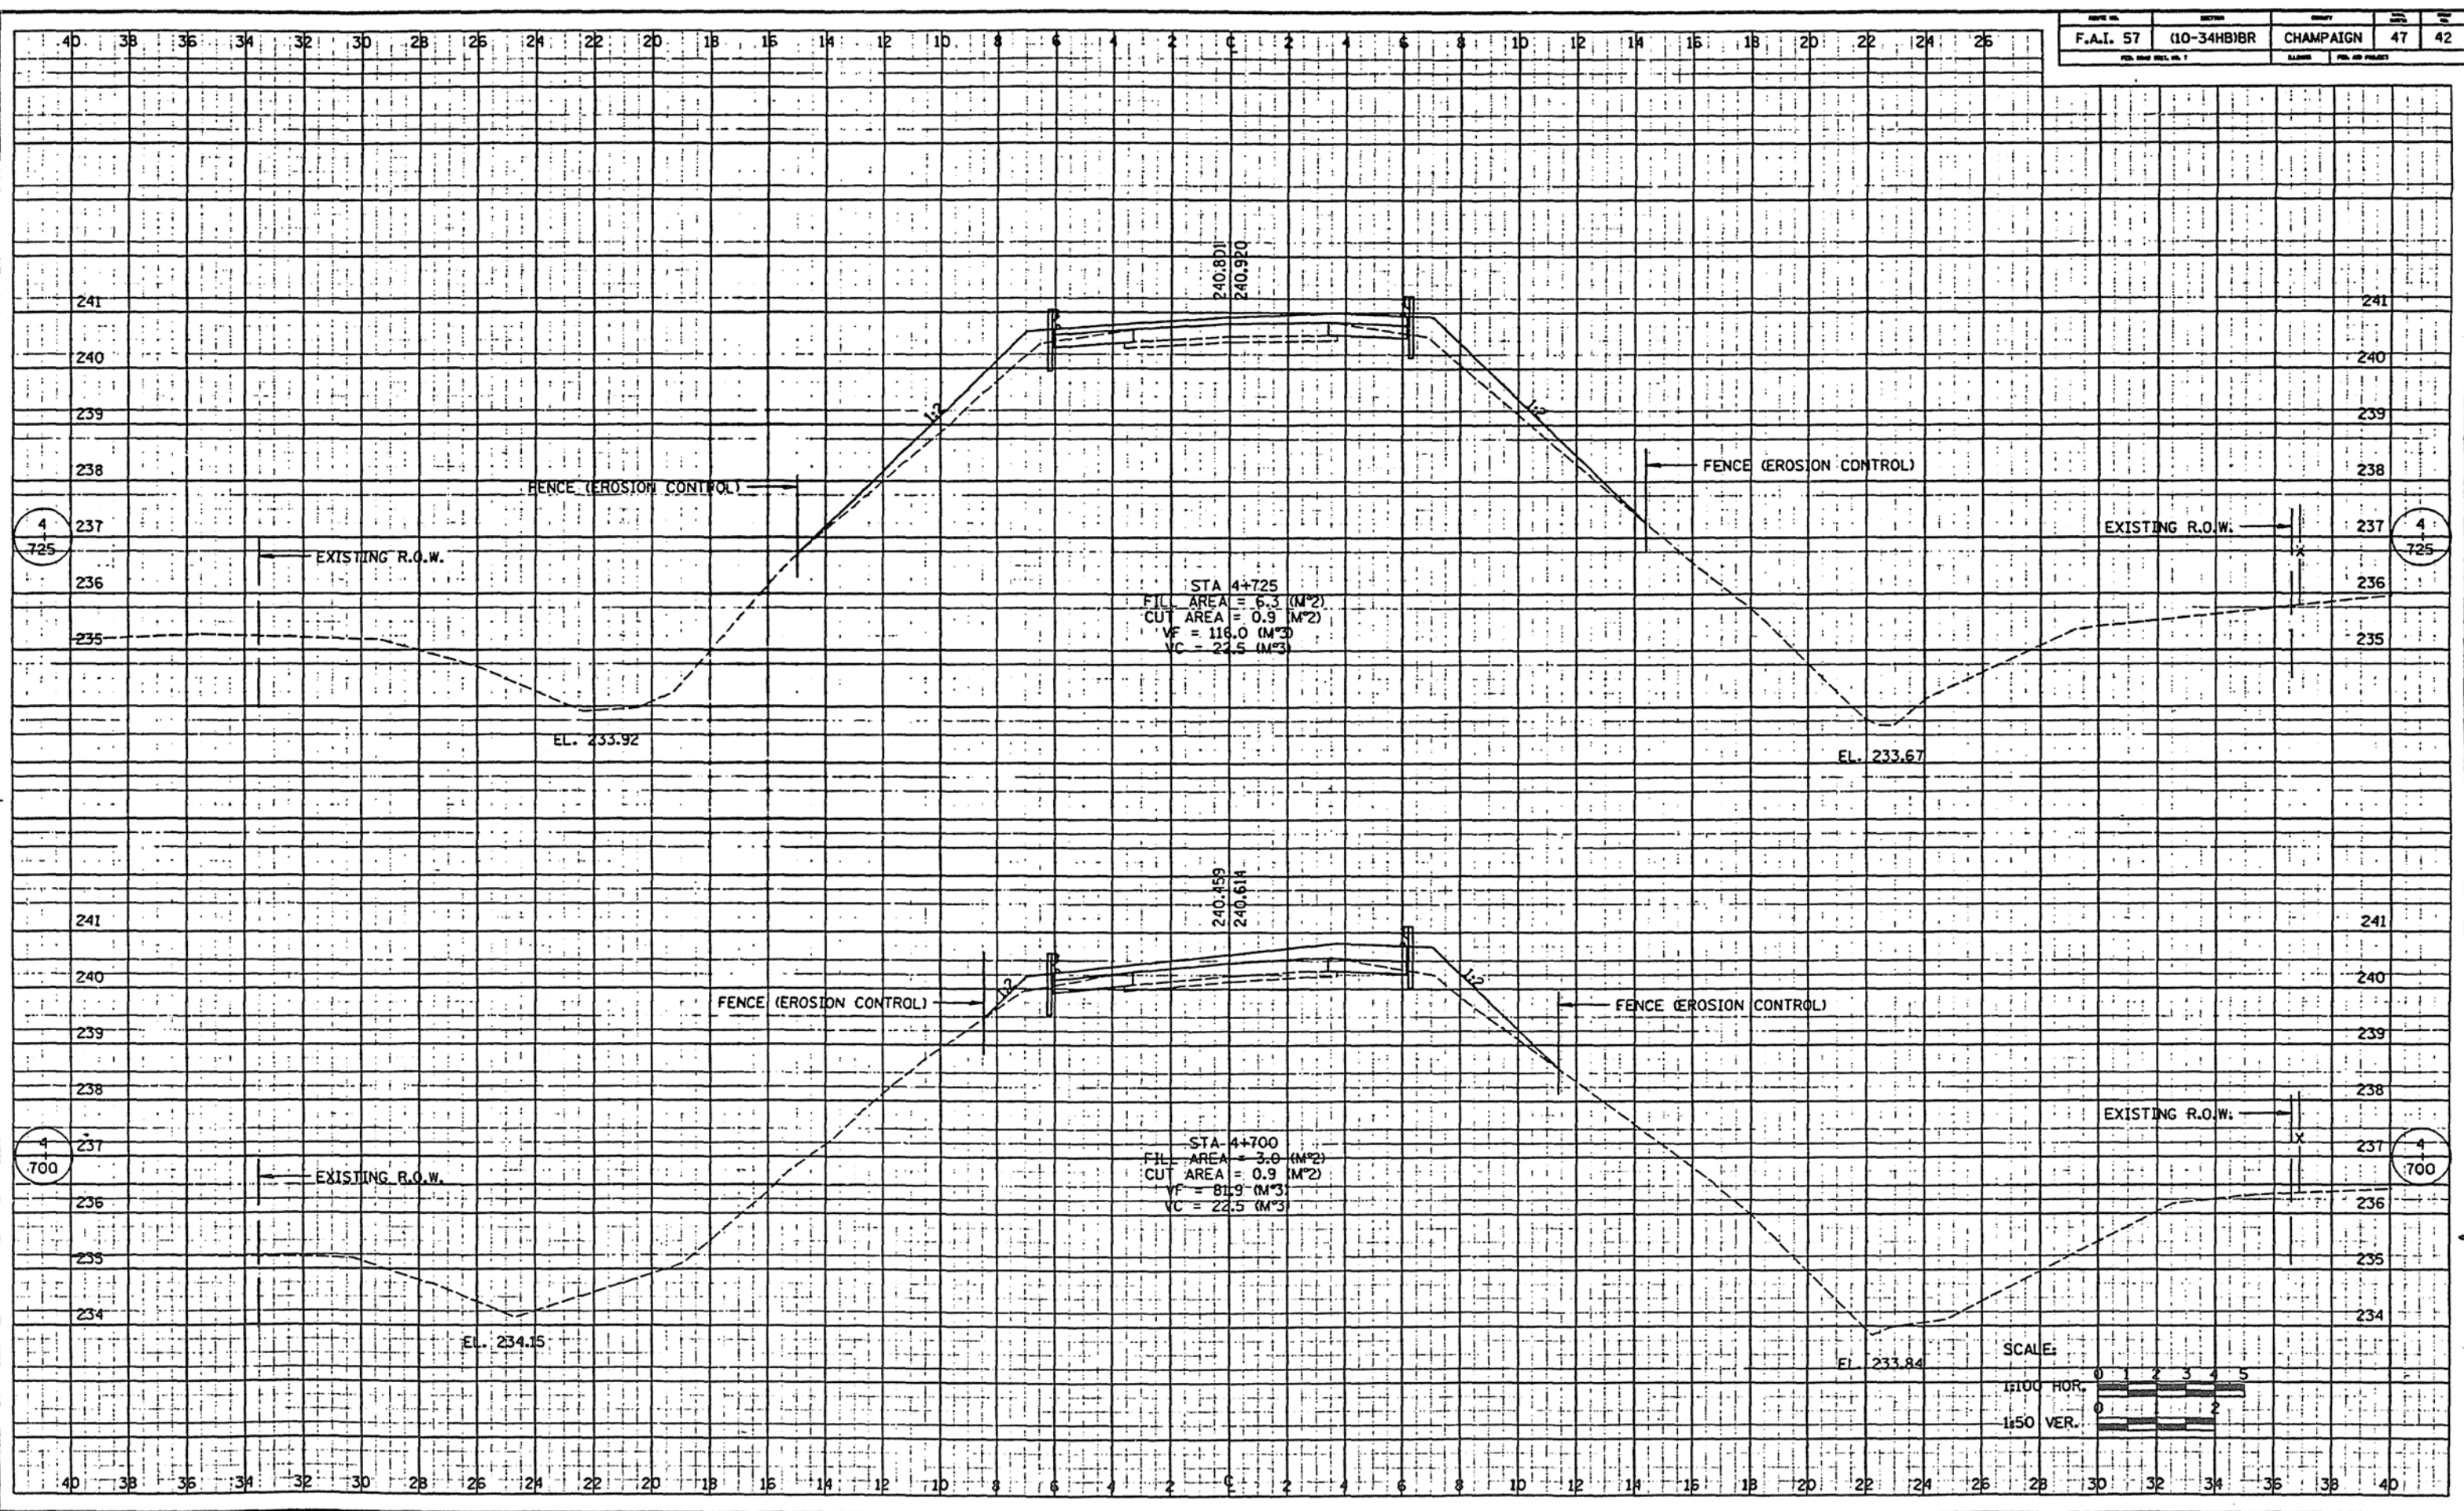




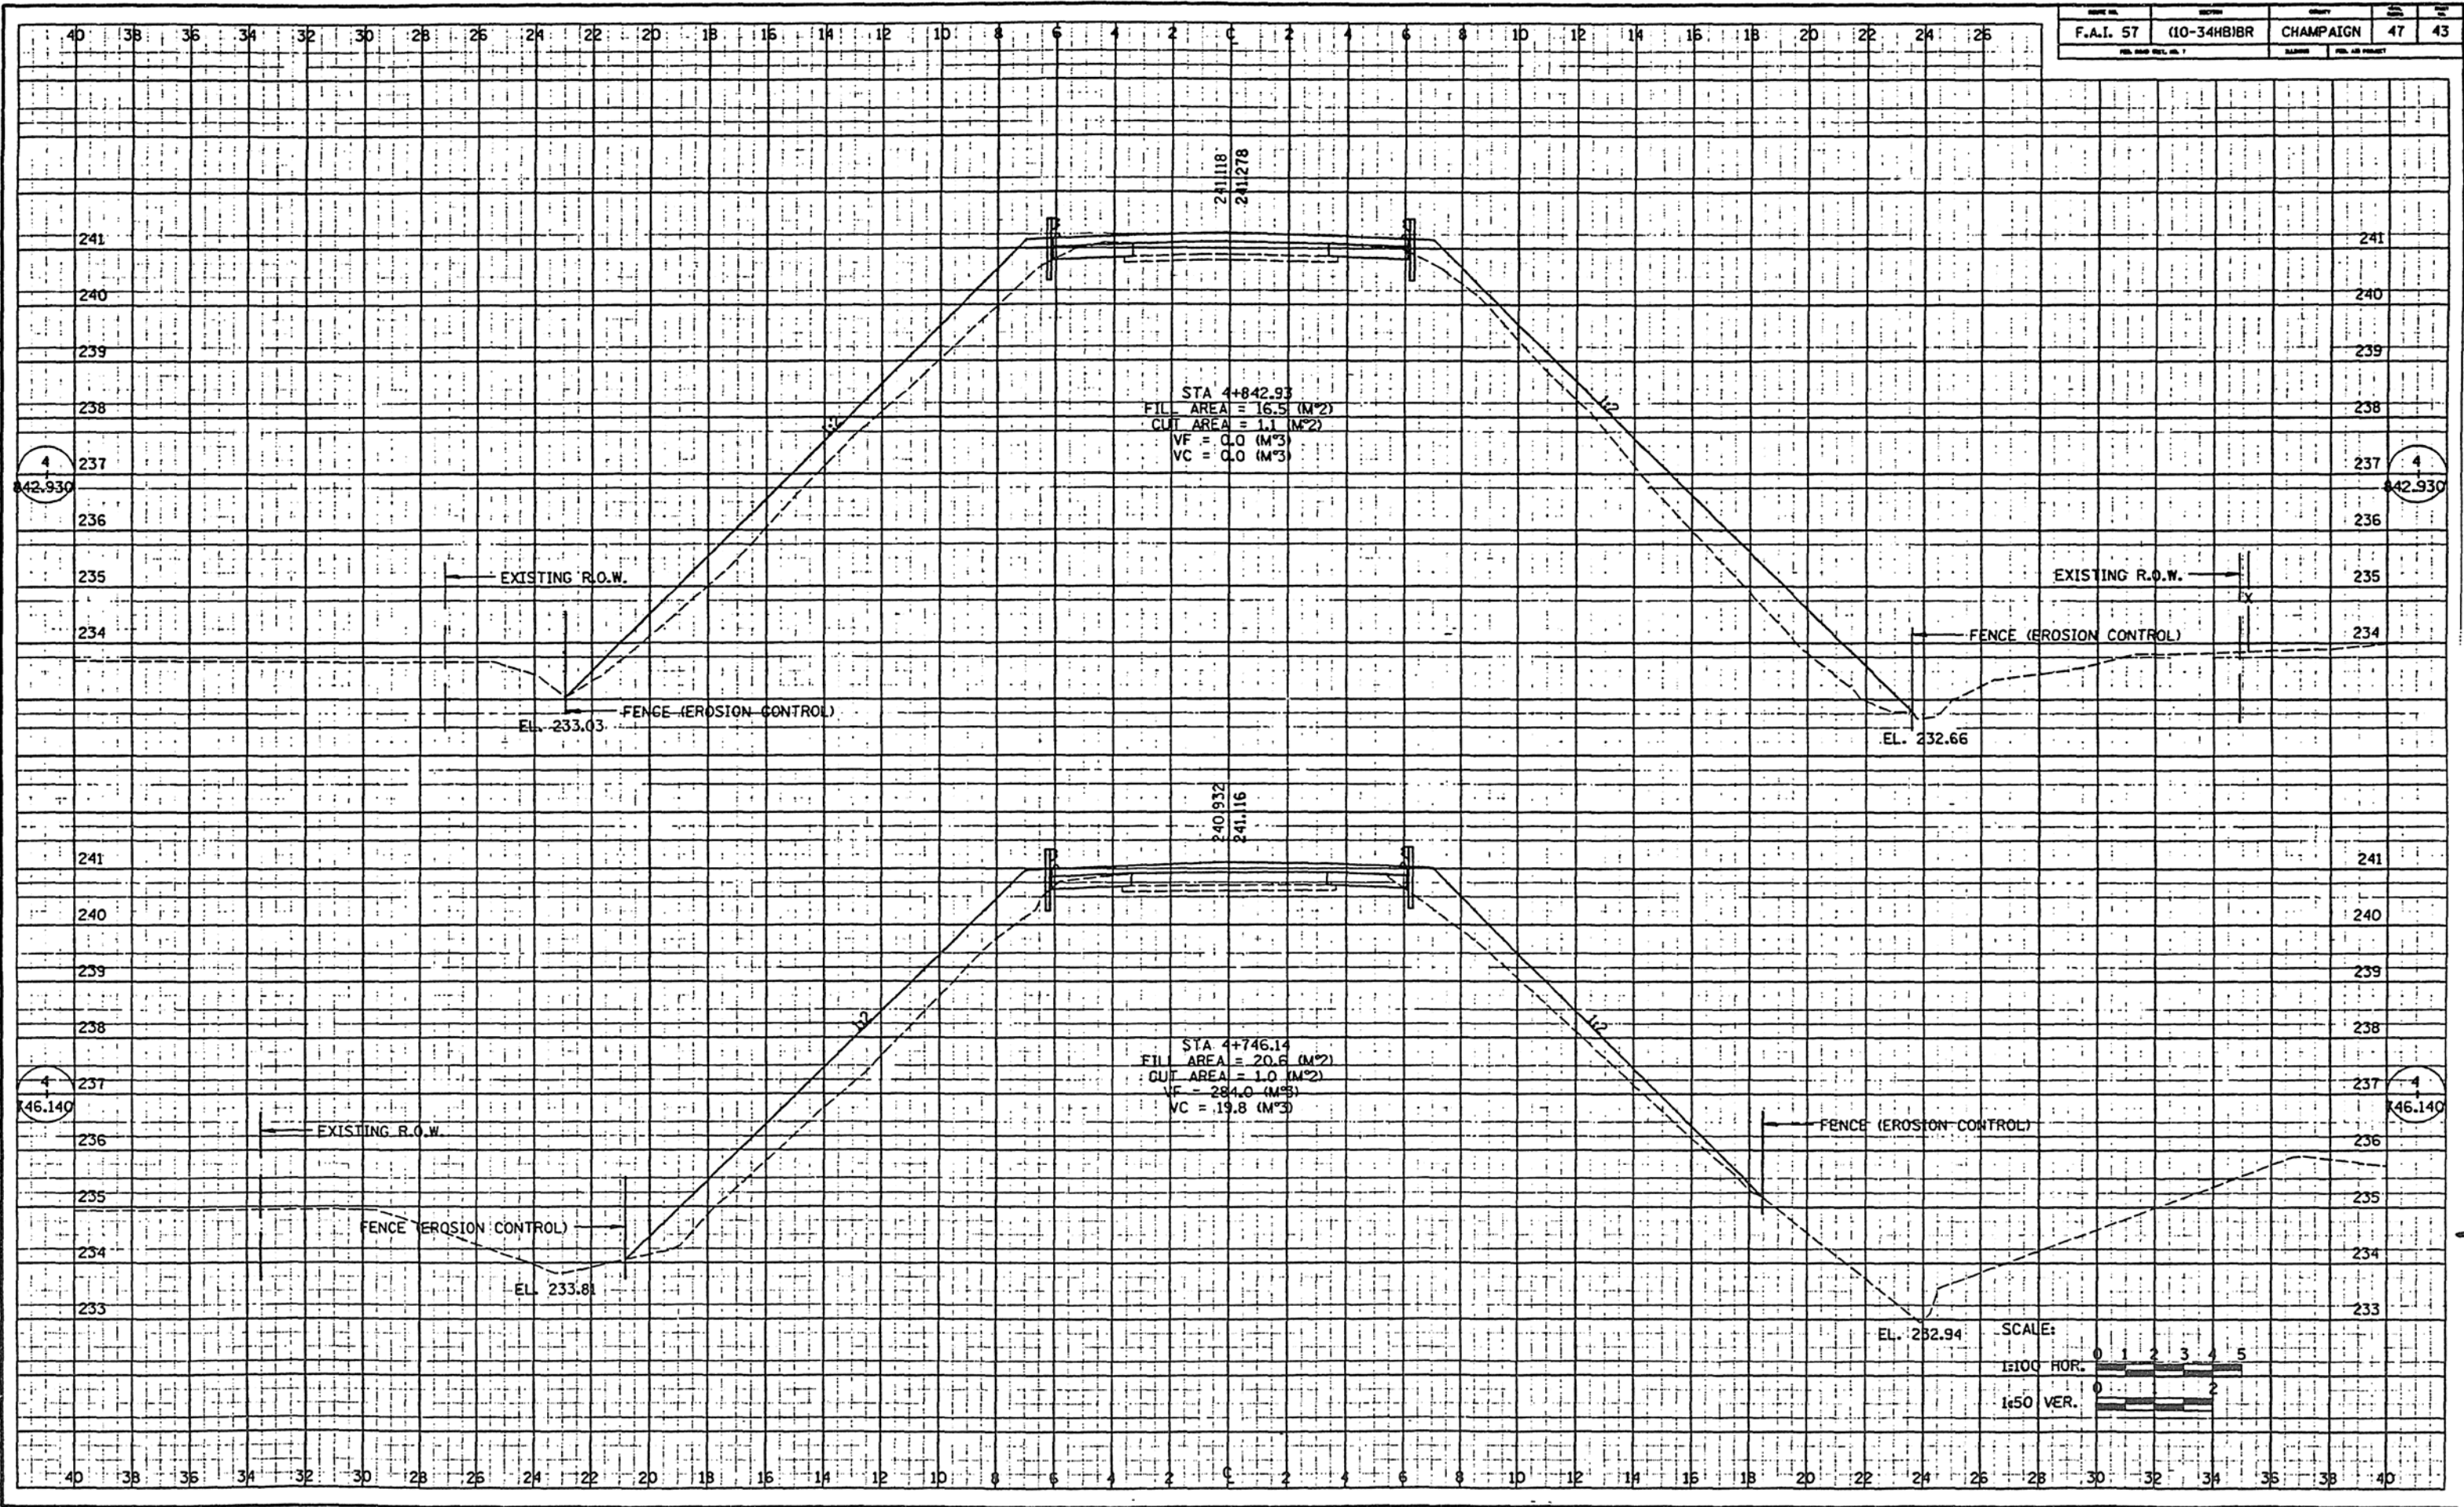




40 38 36 34 32 30 28 26 24 22 20 18 16 14 12 10 8 6 4 2 0 2 4 6 8 10 12 14 16 18 20 22 24 26

DATE	SECTION	PROJECT	NO.	OF
F.A.I. 57	(10-34HB)BR	CHAMPAIGN	47	44
FILL DATA SHEET, NO. 7		STATION	FILL AND PROJECT	

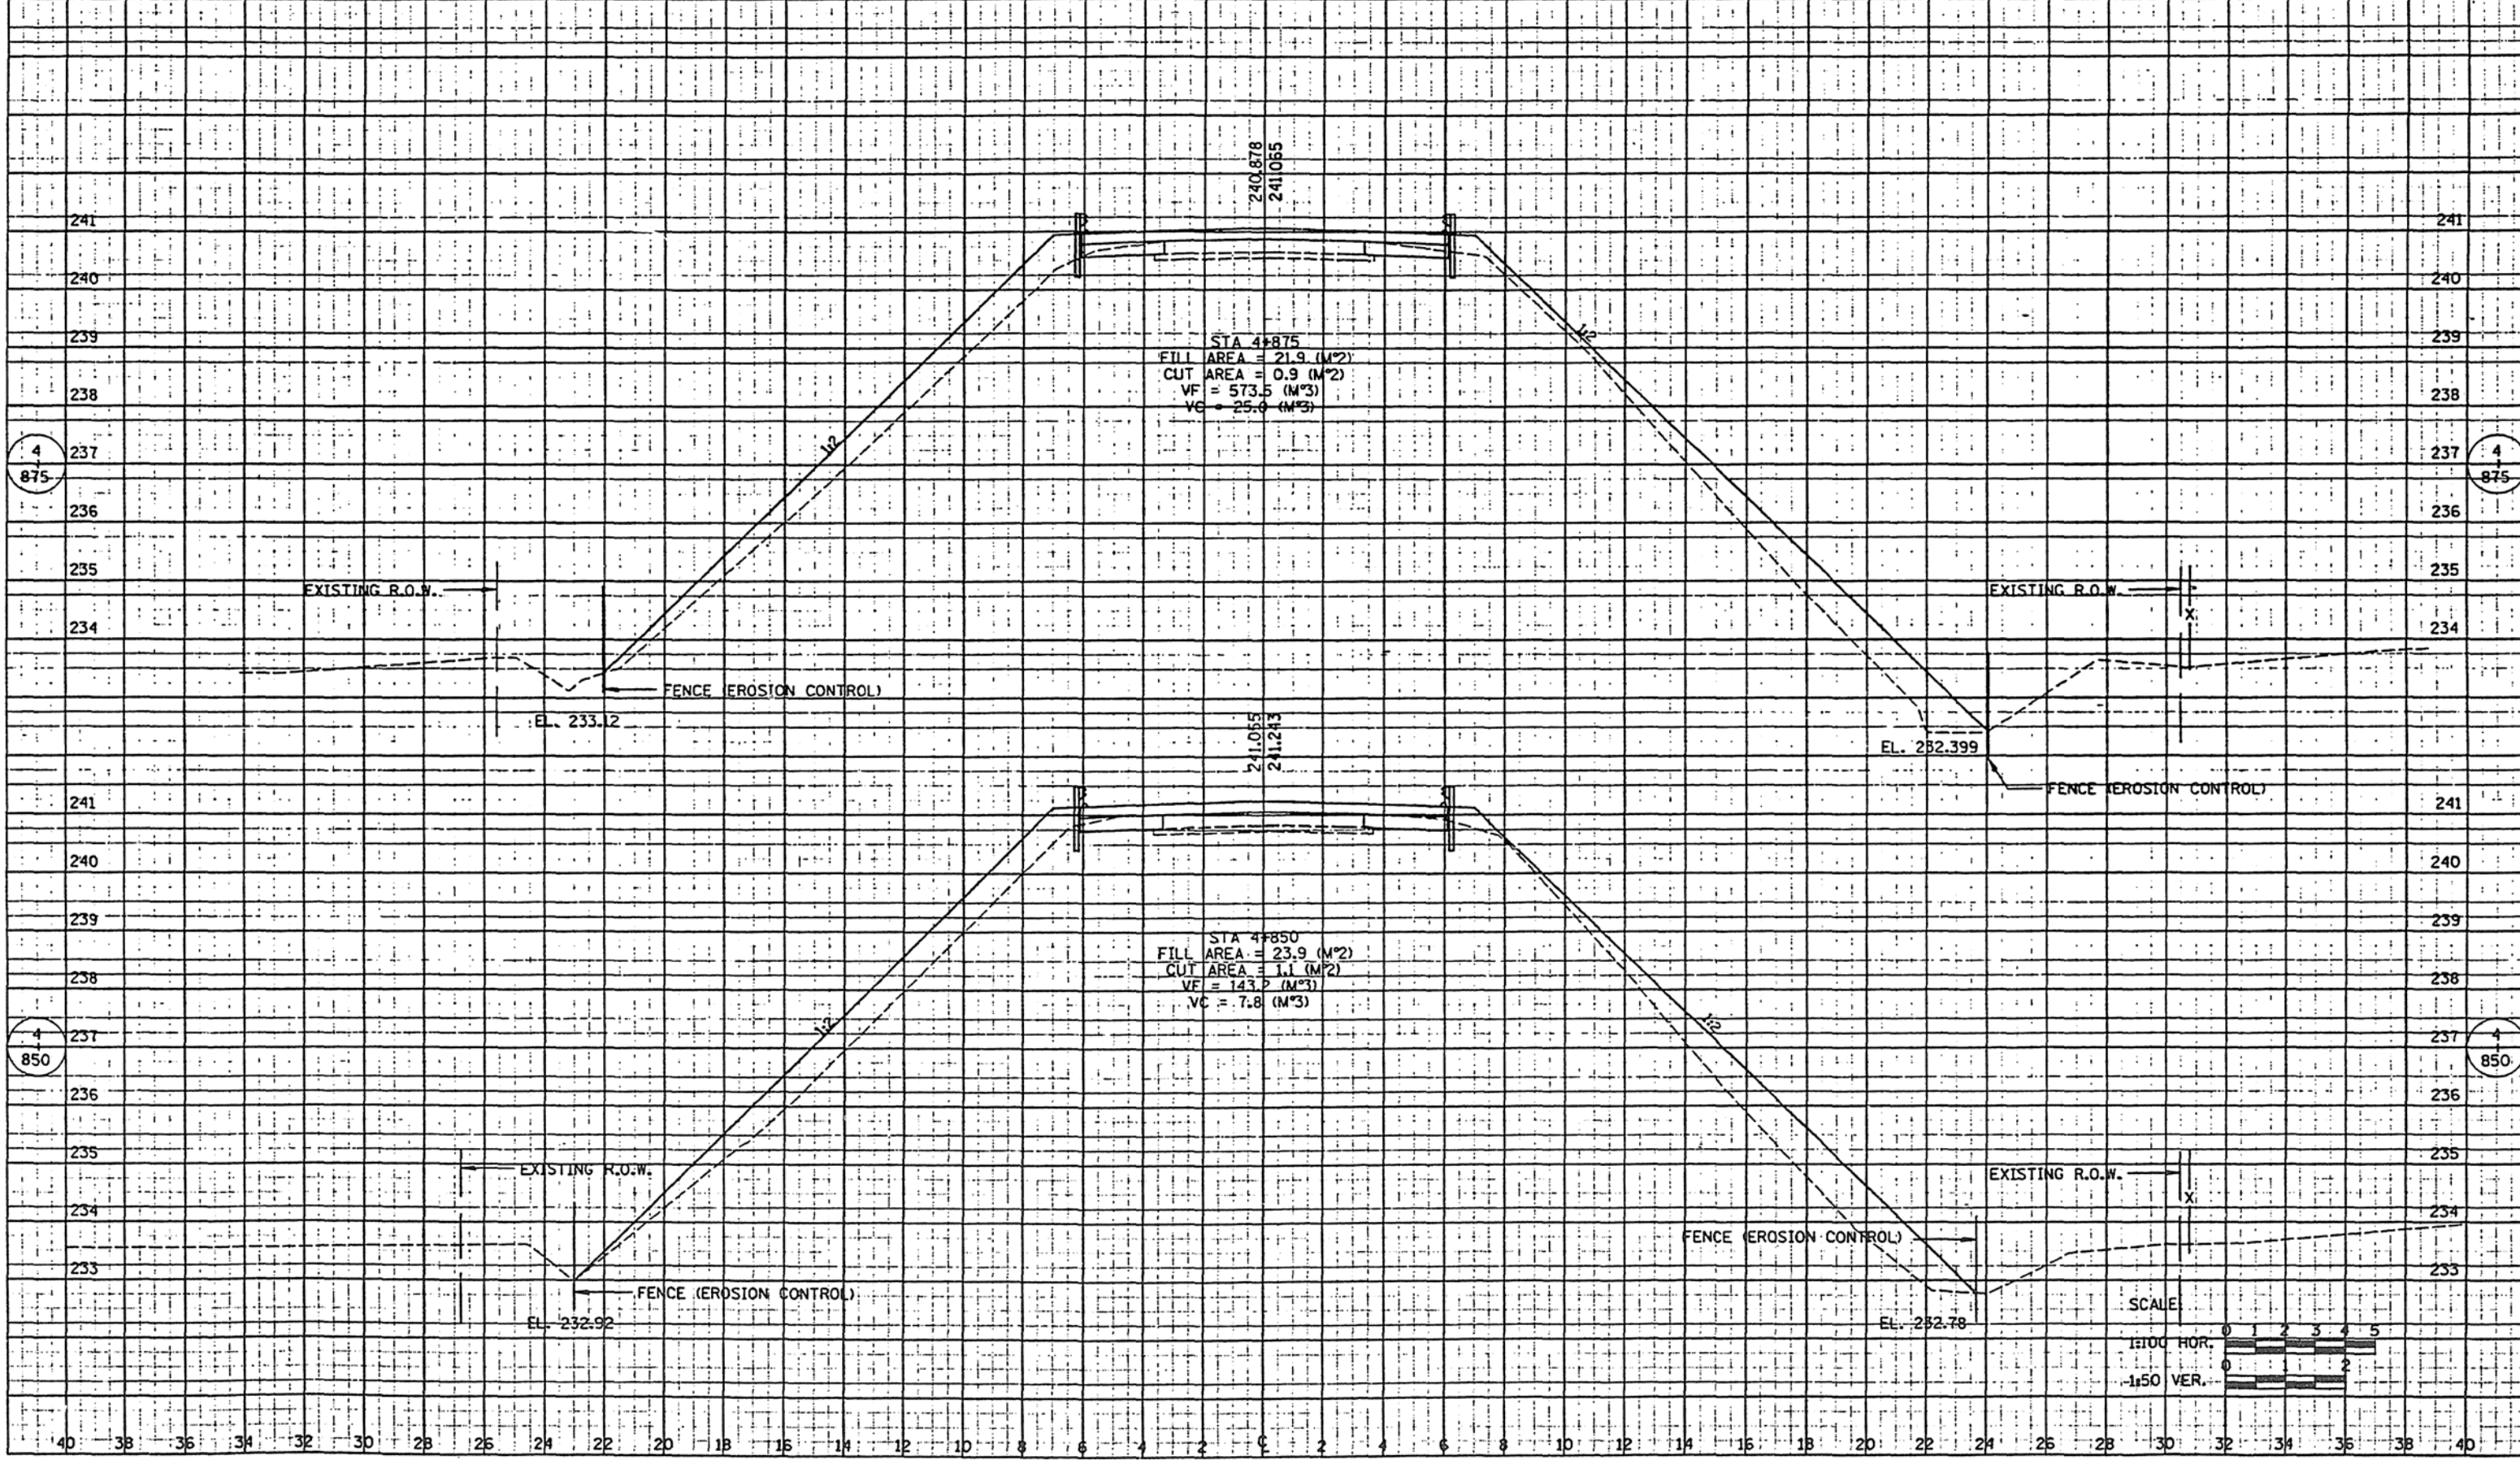


40 38 36 34 32 30 28 26 24 22 20 18 16 14 12 10 8 6 4 2 0 2 4 6 8 10 12 14 16 18 20 22 24 26 28 30 32 34 36 38 40




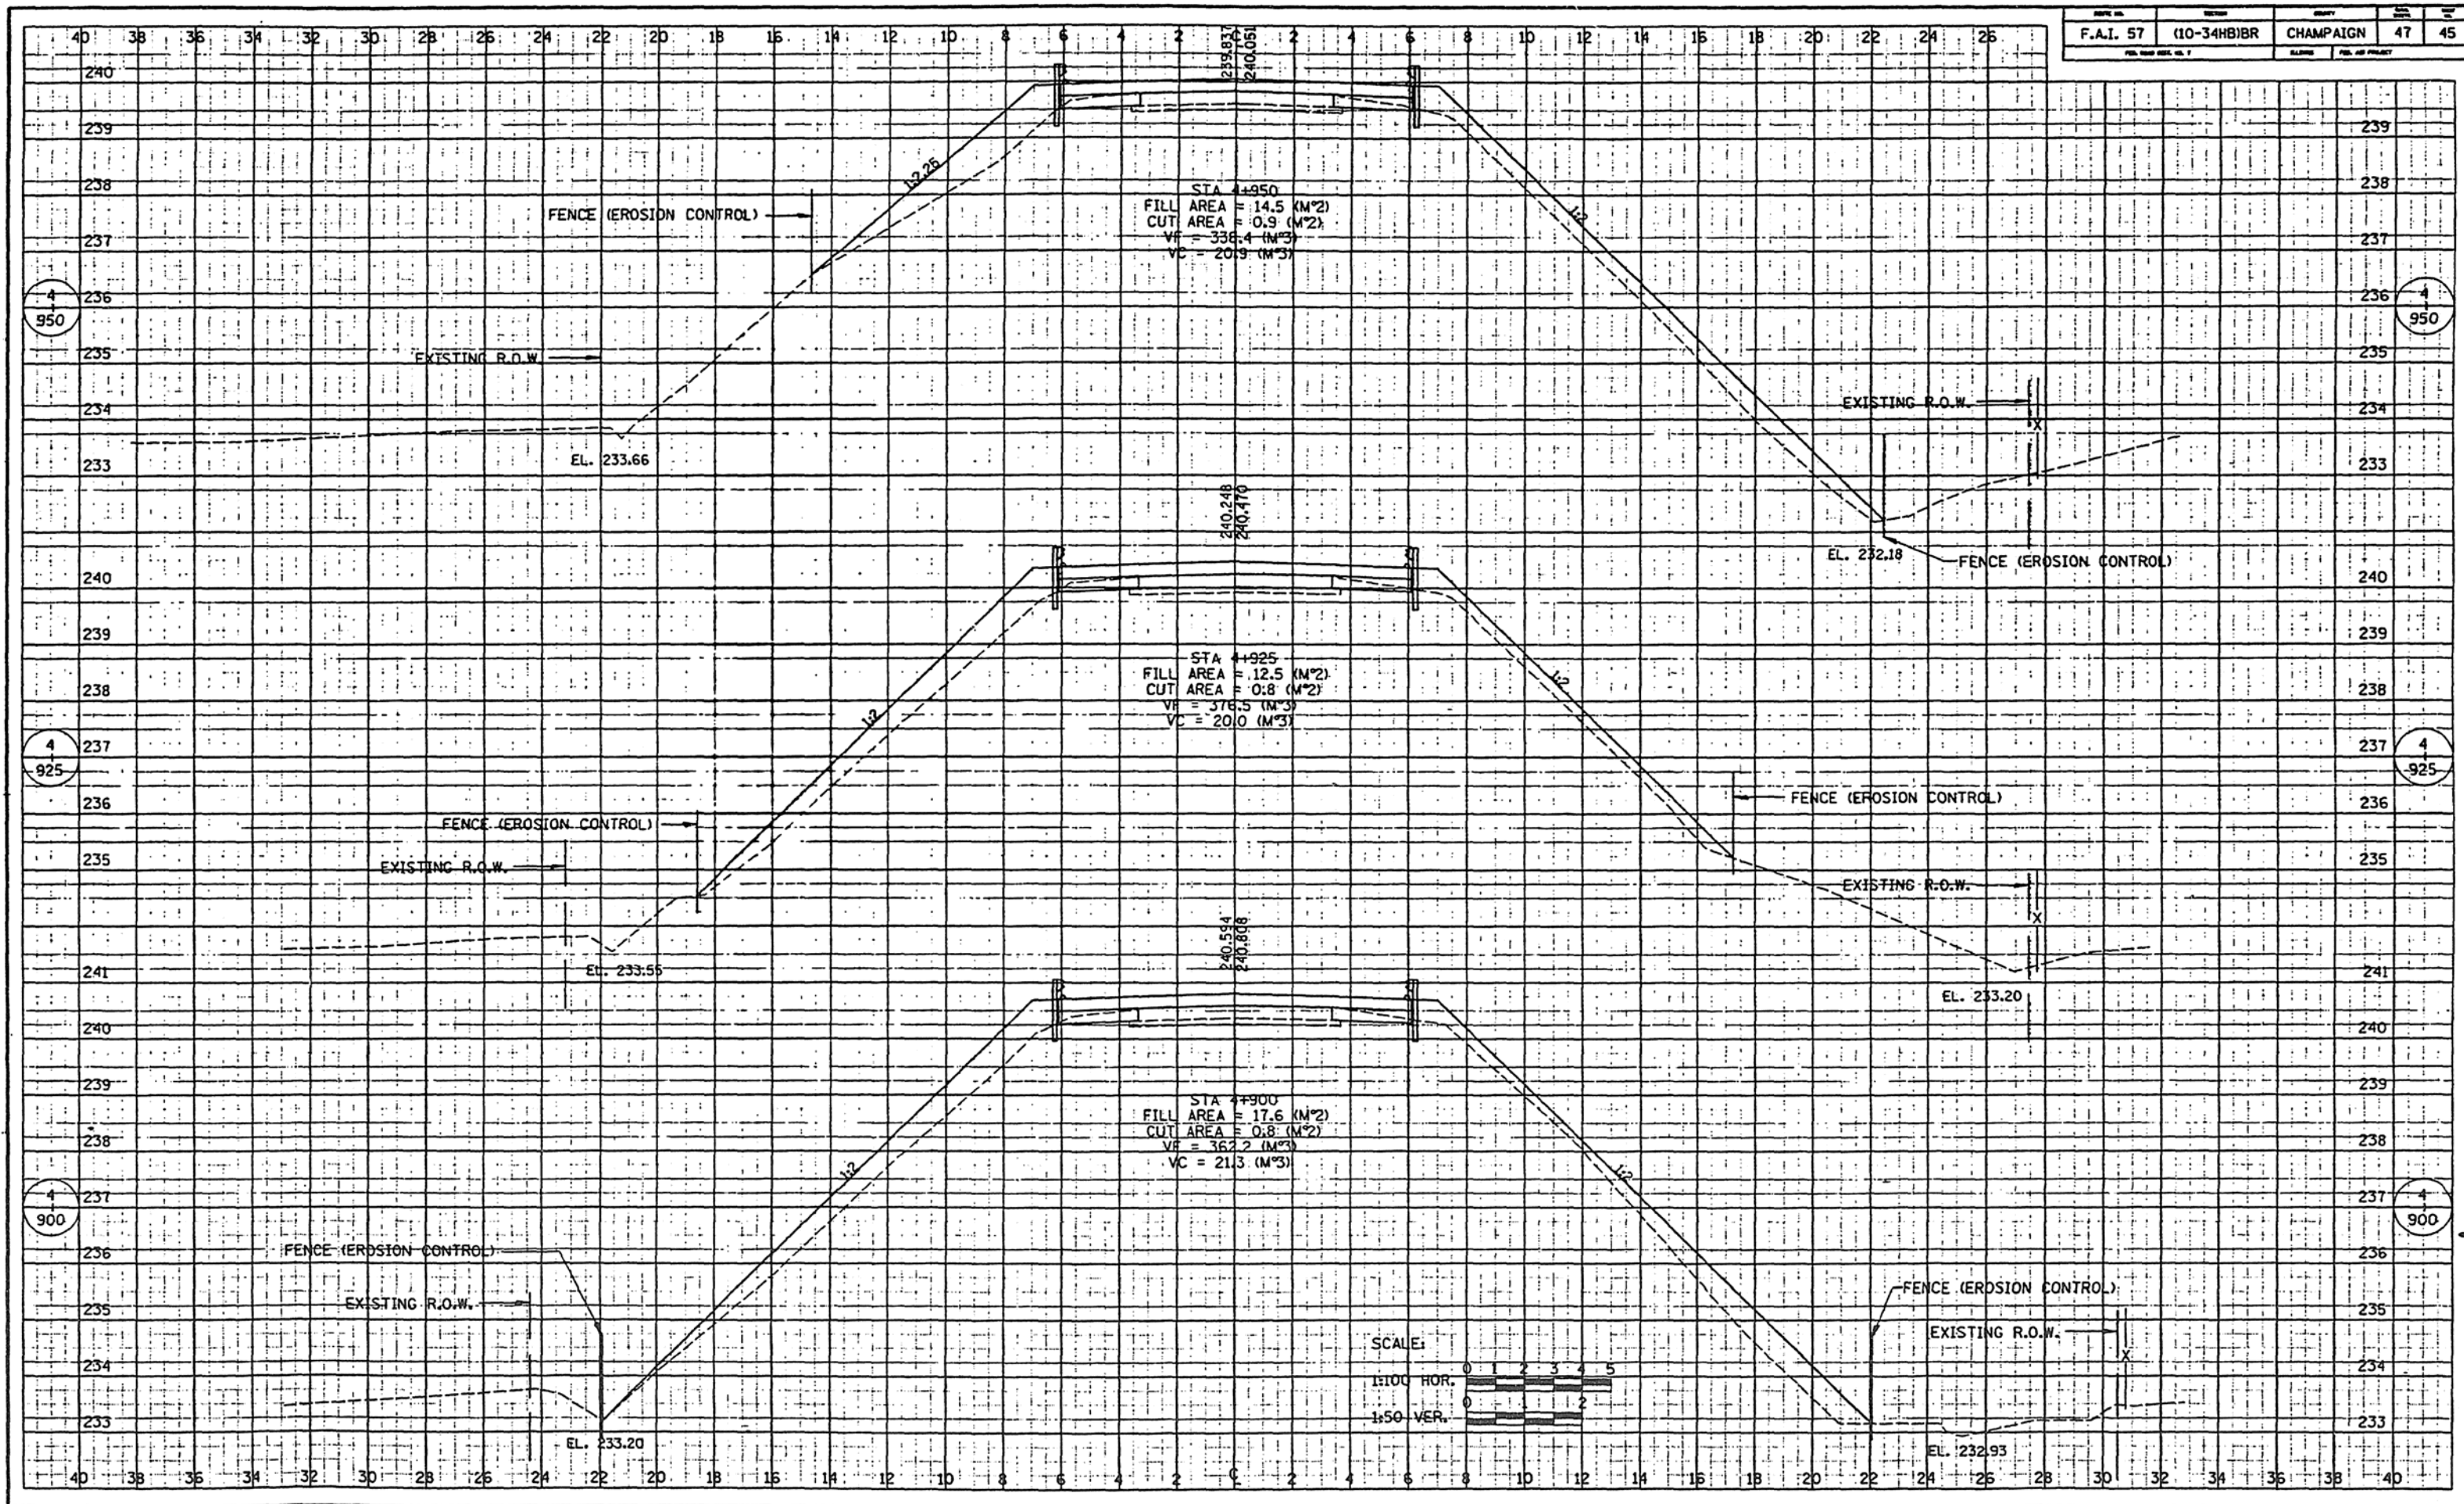



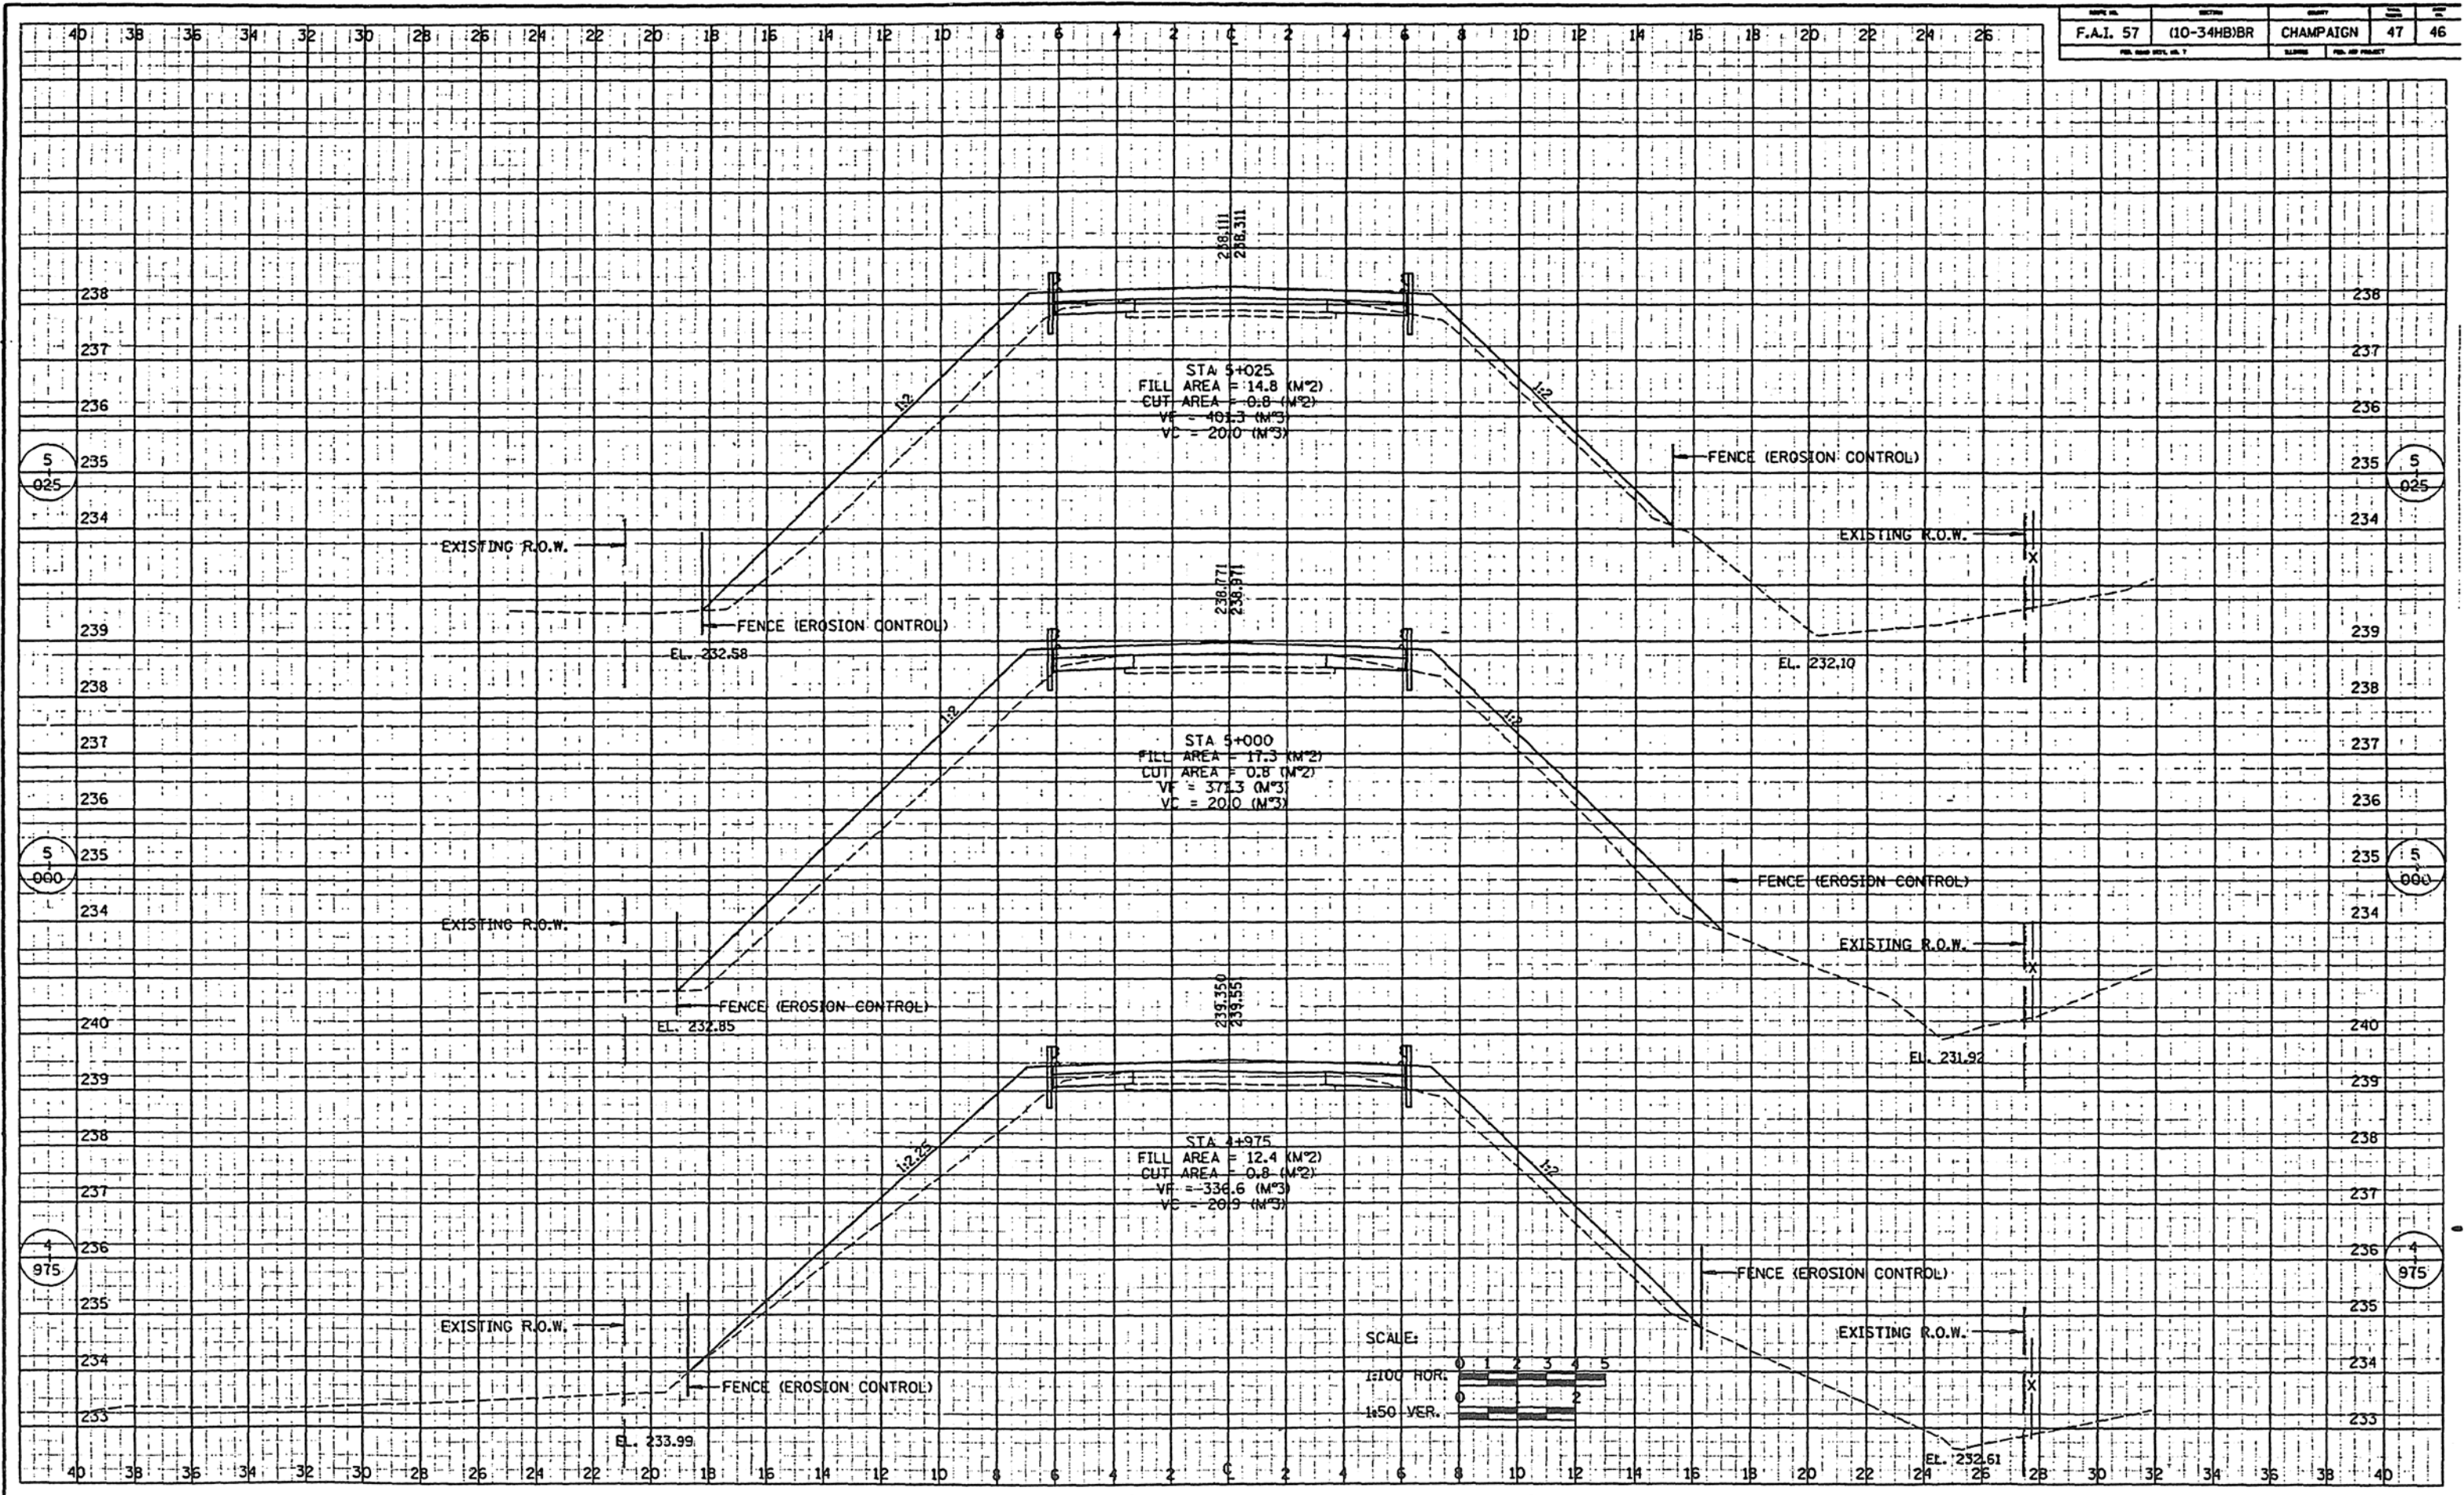




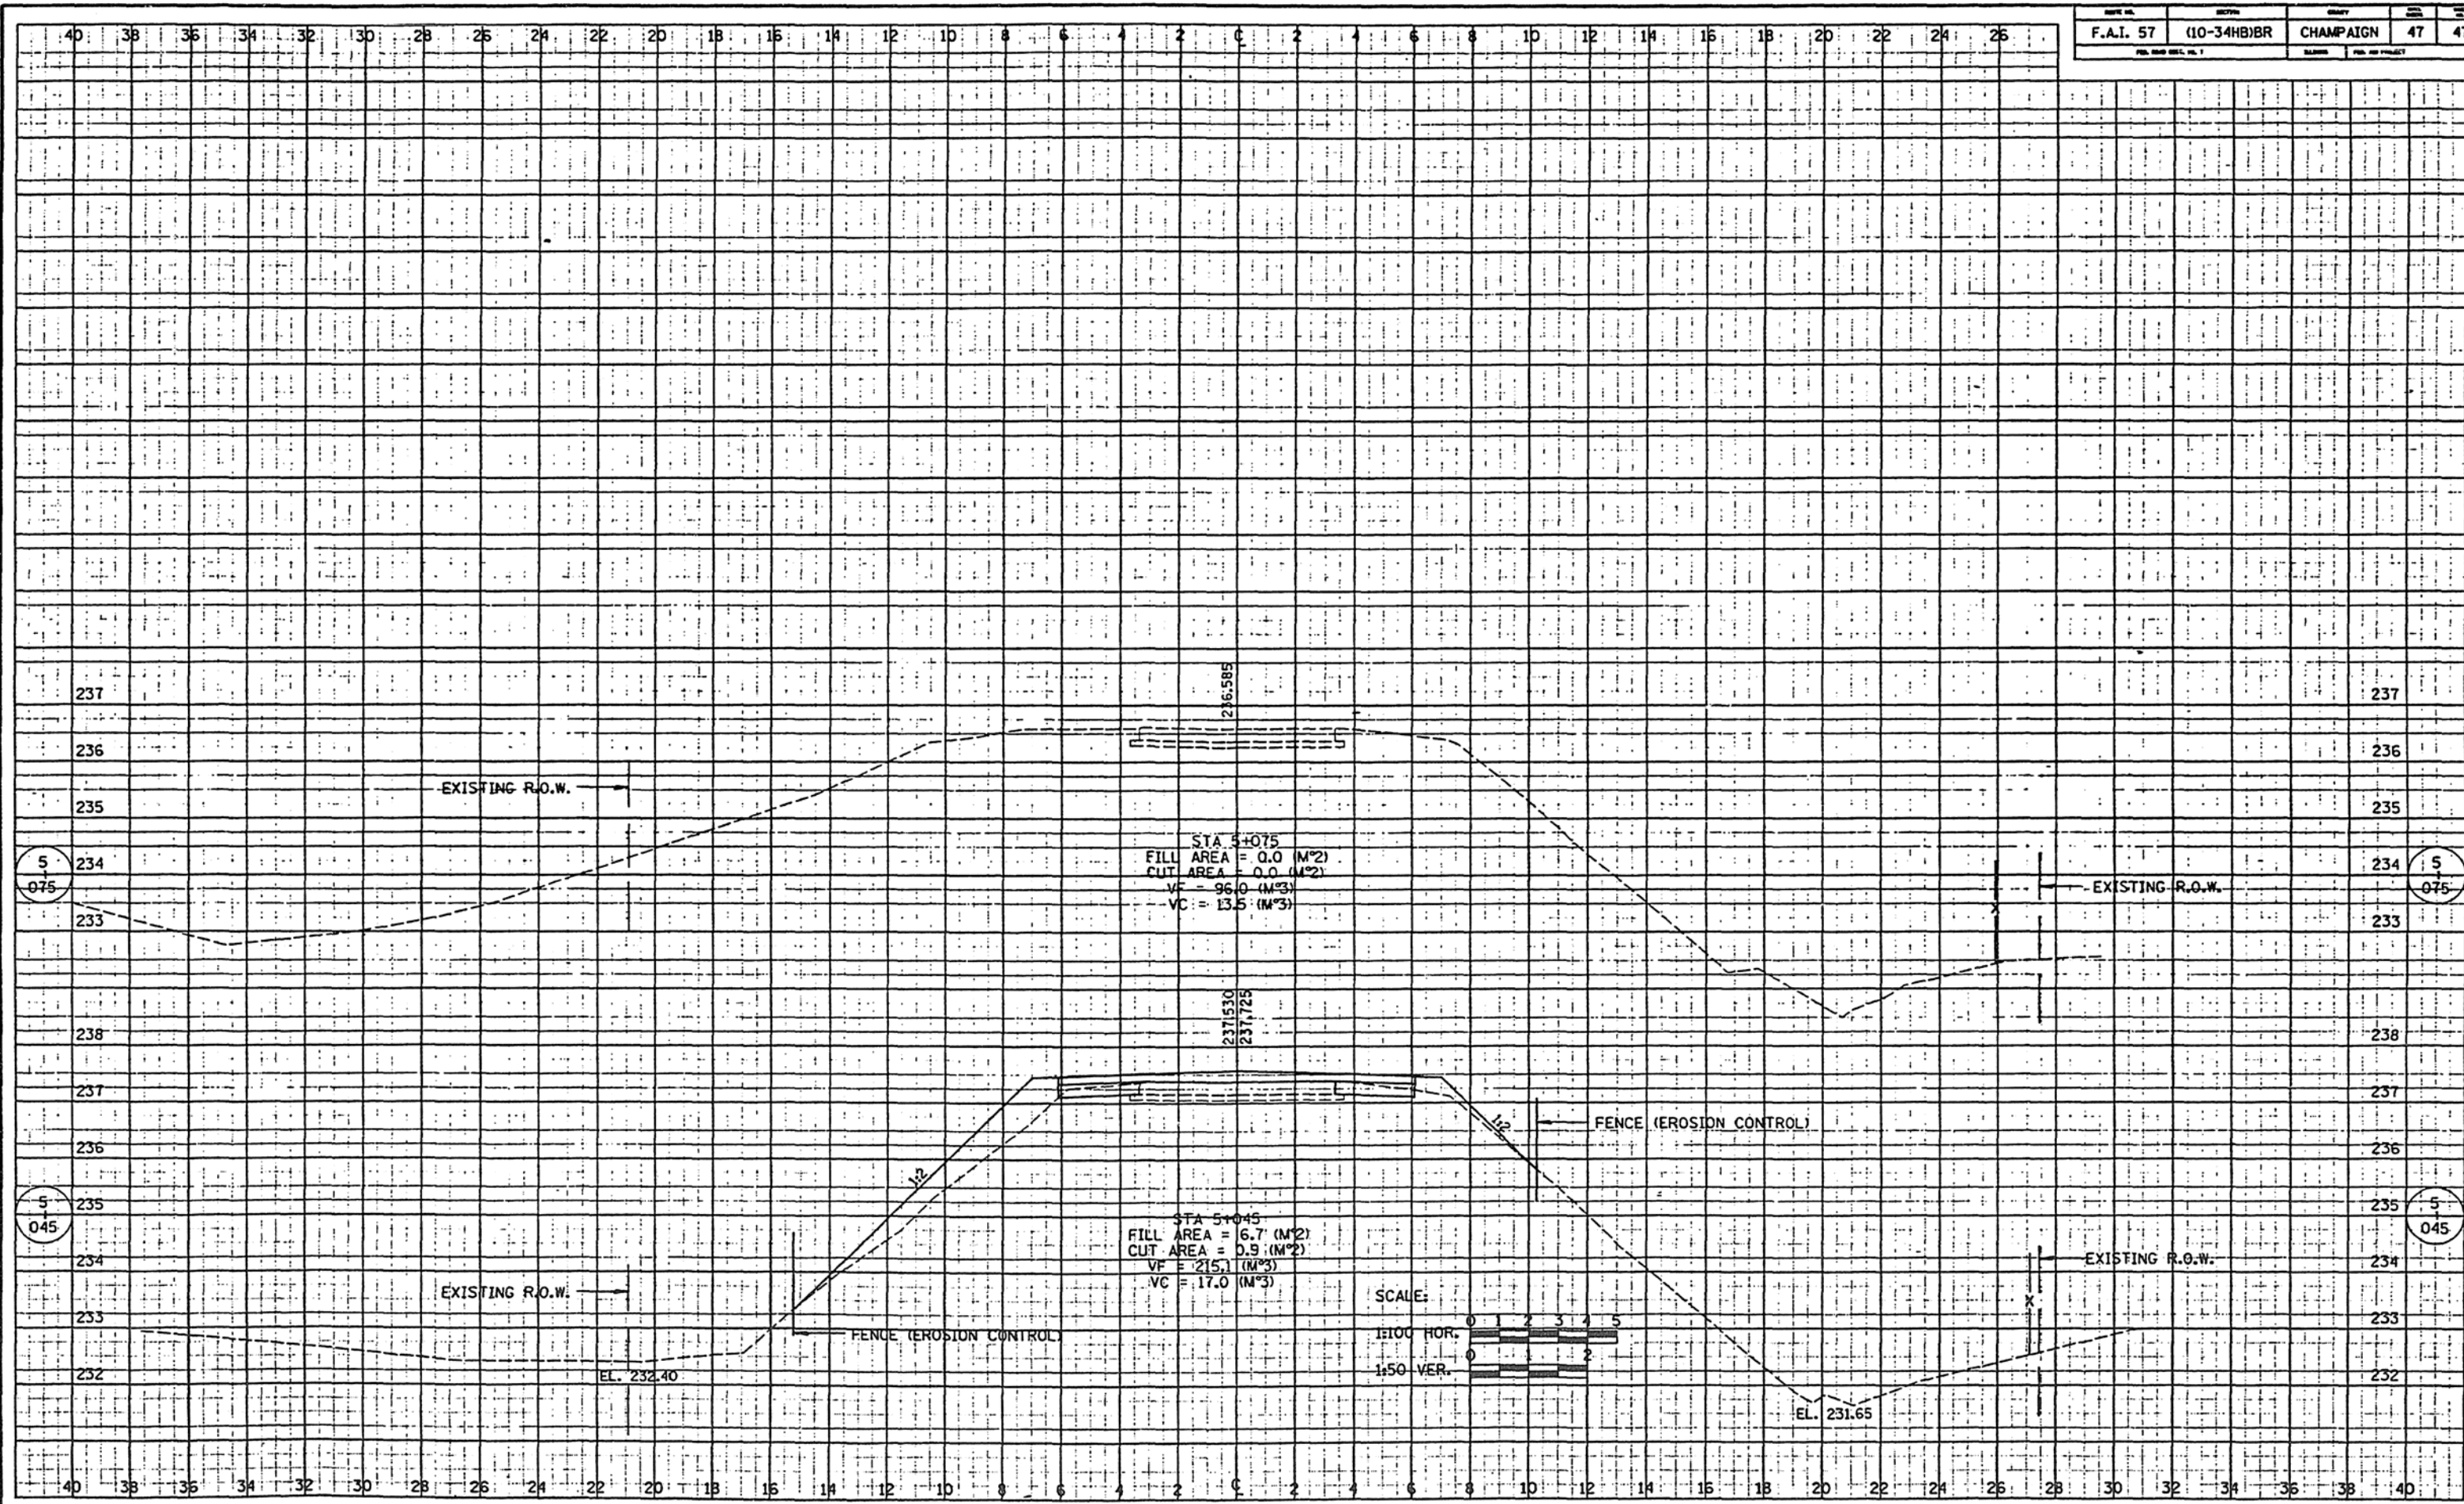



ABV	ABOVE	DIA	DIAMETER	INV	INVERT	R	RADIUS	T	TANGENT DISTANCE
A/C	ACCESS CONTROL	DIST	DISTRICT	IP	IRON PIPE	RR	RAILROAD	T.R.	TANGENT RUNOUT DISTANCE
AC	ACRE	DOM	DOMESTIC	IR	IRON ROD	RC	REMOVE CROWN	TEL	TELEPHONE
ADJ	ADJUST	DBL	DOUBLE	JT	JOINT	RPS	REFERENCE POINT STAKE	TB	TELEPHONE BOX
AS	AERIAL SURVEYS	DSEL	DOWNSTREAM ELEVATION	kg	KILOGRAM	RRS	RAILROAD SPIKE	TP	TELEPHONE POLE
AGG	AGGREGATE	DSFL	DOWNSTREAM FLOWLINE	km	KILOMETER	REF	REFLECTIVE	TEMP	TEMPORARY
AH	AHEAD	DR	DRAINAGE	LS	LANDSCAPING	RCCP	REINFORCED CONCRETE	TBM	TEMPORARY BENCH MARK
APT	APARTMENT	DI	DRAINAGE INLET OR DROP INLET	LN	LANE		CULVERT PIPE	TD	TILE DRAIN
ASPH	ASPHALT	DRV	DRIVEWAY	LT	LEFT	REINF	REINFORCEMENT	TBE	TO BE EXTENDED
AGS	AUXILIARY GAS VALVE (SERVICE)	DCT	DUCT	LP	DUCT	RET	RETAINING	TBR	TO BE REMOVED
		EA	EACH	LGT	LIGHTING	REM	REMOVAL	TBS	TO BE SAVED
AX	AXIS OF ROTATION	EB	EASTBOUND	LF	LINEAL FEET OR LINEAR FEET	REP	REPLACEMENT	TWP	TOWNSHIP
BK	BACK	EOP	EDGE OF PAVEMENT	L	LITER OR CURVE LENGTH	REST	RESTAURANT	TR	TOWNSHIP ROAD
B-B	BACK TO BACK	E-CL	EDGE TO CENTERLINE	LC	LONG CHORD	RESURF	RESURFACING	TS	TRAFFIC SIGNAL
BKPL	BACKPLATE	E-E	EDGE TO EDGE	LNG	LONGITUDINAL	RT	RIGHT	TSCB	TRAFFIC SIGNAL CONTROL BOX
BARR	BARRICADE	EL	ELEVATION	L SUM	LUMP SUM	ROW	RIGHT-OF-WAY	TSC	TRAFFIC SYSTEMS CENTER
BGN	BEGIN	ENTR	ENTRANCE	MACH	MACHINE	RD	ROAD	TRVS	TRANSVERSE
BM	BENCHMARK	EXC	EXCAVATION	MB	MAIL BOX	RDWY	ROADWAY	TRVL	TRAVEL
BIND	BINDER	EX	EXISTING	MH	MANHOLE	RTE	ROUTE	TRN	TURN
BIT	BITUMINOUS	EXPWAY	EXPRESSWAY	MATL	MATERIAL	SAN	SANITARY	TY	TYPE
BTM	BOTTOM	E	OFFSET DISTANCE TO VERTICAL CURVE	MED	MEDIAN	SANS	SANITARY SEWER	T-A	TYPE A
BLVD	BOULEVARD			m	METER	SEC	SECTION	UNDGND	UNDERGROUND
BRK	BRICK	E	EXTERNAL DISTANCE OF HORIZONTAL CURVE	METH	METHOD	SEED	SEEDING	USGS	U. S. GEOLOGICAL SURVEY
BBOX	BUFFALO BOX	F-F	FACE TO FACE	MBH	MOBILE HOME	SHAP	SHAPING	USEL	UPSTREAM ELEVATION
BLDG	BUILDING	FA	FEDERAL AID	M	MID-ORDINATE	SH	SHEET	USFL	UPSTREAM FLOWLINE
CIP	CAST IRON PIPE	FAI	FEDERAL AID INTERSTATE	mm	MILLIMETER	SHLD	SHOULDER	UTIL	UTILITY
CB	CATCH BASIN	FAP	FEDERAL AID PRIMARY	mm DIA	MILLIMETER DIAMETER	SW	SIDEWALK	VBOX	VALVE BOX
C-C	CENTER TO CENTER	FAS	FEDERAL AID SECONDARY	MIX	MIXTURE	SIG	SIGNAL	VV	VALVE VAULT
CL	CENTERLINE	FAUS	FEDERAL AID URBAN SECONDARY	MFT	MOTOR FUEL TAX	SOD	SODDING	VLT	VAULT
CL-E	CENTERLINE TO EDGE	FP	FENCE POST	MOD	MODIFIED	SM	SOLID MEDIAN	VEH	VEHICLE
CL-F	CENTERLINE TO FACE	FE	FIELD ENTRANCE	N & BC	NAIL & BOTTLE CAP	SB	SOUTHBOUND	VP	VENT PIPE
CERT	CERTIFIED	FH	FIRE HYDRANT	N & C	NAIL & CAP	SE	SOUTHEAST	VERT	VERTICAL
CHSLD	CHISELED	FL	FLOW LINE	N & W	NAIL & WASHER	SW	SOUTHWEST	VC	VERTICAL CURVE
CP	CLAY PIPE	FB	FOOT BRIDGE	NB	NORTHBOUND	SPL	SPECIAL	VPC	VERTICAL POINT OF CURVATURE
CLSD	CLOSED	FDN	FOUNDATION	NE	NORTHEAST	SD	SPECIAL DITCH	VPI	VERTICAL POINT OF INTERSECTION
CLID	CLOSED LID	FR	FRAME	NC	NORMAL CROWN	SO FT	SQUARE FEET	VPT	VERTICAL POINT OF TANGENCY
CS	CITY STREET	F&G	FRAME & GRATE	NOAA	NATIONAL OCEANIC ATMOSPHERIC ADMINISTRATION	m <sup>2</sup>	SQUARE METER	WM	WATER MAIN
CT	COAT	FRWAY	FREEWAY			mm <sup>2</sup>	SQUARE MILLIMETER	WV	WATER VALVE
COMB	COMBINATION	GAL	GALLON	NW	NORTHWEST	SO YD	SQUARE YARD	WMAN	WATERMAIN
CE	COMMERCIAL ENTRANCE	GALV	GALVANIZED	OLID	OPEN LID	STB	STABILIZED	WB	WESTBOUND
CONC	CONCRETE	GM	GAS METER	PAT	PATTERN	STD	STANDARD	WLDLFL	WILDFLOWERS
CONST	CONSTRUCT	GV	GAS VALVE	PVD	PAVED	SBI	STATE BOND ISSUE	W	WITH
CONTD	CONTINUED	GRAN	GRANULAR	PVMT	PAVEMENT	SM	STATE OF ILLINOIS SURVEY MARKER	WO	WITHOUT
CONT	CONTINUOUS	GR	GRATE	PM	PAVEMENT MARKING				
COR	CORNER	GRVL	GRAVEL	PED	PEDESTAL	SR	STATE ROUTE		
CORR	CORRUGATED	GND	GROUND	PNT	POINT	STA	STATION		
CMP	CORRUGATED METAL PIPE	GUT	GUTTER	PC	POINT OF CURVATURE	SPBGR	STEEL PLATE BEAM GUARDRAIL		
CNTY	COUNTY	HH	HANDHOLE	PI	POINT OF INTERSECTION OF HORIZONTAL CURVE	SS	STORM SEWER		
CH	COUNTY HIGHWAY	HATCH	HATCHING	PRC	POINT OF REVERSE CURVATURE	STY	STORY		
CSE	COURSE	HD	HEAD	PT	POINT OF TANGENCY	ST	STREET		
XS&CT	CROSS SECTION	HDW	HEADWALL	POT	POINT ON TANGENT	STR	STRUCTURE		
m	CUBIC METER	HOUTY	HEAVY DUTY	POLYETH	POLYETHYLENE	e	SUPERELEVATION RATE		
mm	CUBIC MILLIMETER	ha	HECTARE	PCC	PORTLAND CEMENT CONCRETE	S. E. RUN.	SUPERELEVATION RUNOFF LENGTH		
CU YD	CUBIC YARD	HWY	HIGHWAY	PP	POWER POLE OR PRINCIPAL POINT	SURF	SURFACE		
CULV	CULVERT	HORIZ	HORIZONTAL	PRM	PRIME	SMK	SURVEY MARKER		
C&G	CURB & GUTTER	HSE	HOUSE	PE	PRIVATE ENTRANCE				
D	DEGREE OF CURVE	IL	ILLINOIS	PROF	PROFILE GRADELINE				
DC	DEPRESSED CURB	IMP	IMPROVEMENT	PROJ	PROJECT				
DET	DETECTOR	IN DIA	INCH DIAMETER	P. C.	PROPERTY CORNER				
		INL	INLET	PL	PROPERTY LINE				
		INST	INSTALLATION	PR	PROPOSED				
		IDS	INTERSECTION DESIGN STUDIES	R	RADIUS				

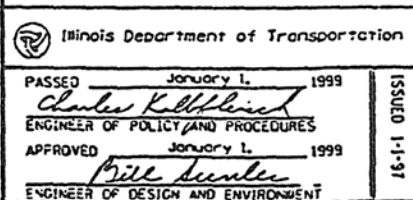

DATE	REVISIONS
1-1-99	Updated abbreviations and symbols.
1-1-98	Added and revised abbreviations.

**STANDARD SYMBOLS,  
ABBREVIATIONS  
AND PATTERNS**  
(Sheet 1 of 5)

**STANDARD 000001-02**

**ADJUSTMENT ITEMS**

	<u>EX</u>	<u>PR</u>
Domestic Service Box To Be Adjusted		
Frame and Grate To Be Adjusted		
Frame and Lid To Be Adjusted		
Item To Be Abandoned		
Item To Be Moved		
Item To Be Relocated		
Pavement Removal & Replacement		
Special Adjustment		
Structure To Be Adjusted		
Structure To Be Cleaned		
Structure To Be Filled		
Structure To Be Reconstructed		
Structure To Be Removed		
Valve Vault To Be Adjusted		

**ALIGNMENT ITEMS**

	<u>EX</u>	<u>PR</u>
Baseline		
Baseline Symbol		
Centerline		
Centerline Break Circle		
Centerline Symbol		
Horiz Ccurve Data	<p>CURVE</p> <p>P.I. STA=</p> <p>Δ=</p> <p>R=</p> <p>T=</p> <p>L=</p> <p>E=</p> <p>e=</p> <p>T.R.=</p> <p>S.E. RUN=</p> <p>P.C. STA=</p> <p>P.T. STA=</p>	<p>CURVE</p> <p>P.I. STA=</p> <p>Δ=</p> <p>R=</p> <p>T=</p> <p>L=</p> <p>E=</p> <p>e=</p> <p>T.R.=</p> <p>S.E. RUN=</p> <p>P.C. STA=</p> <p>P.T. STA=</p>
PI Indicator		
Point Indicator		

**BOUNDARIES ITEMS**

	<u>EX</u>	<u>PR</u>
County/Township Line		
Dashed Property Line		
Iron Pipe Found		
Iron Pipe Set		
Northwest Quarter Corner		
Property Line Symbol		
Same Ownership Symbol		
Section Corner		
Section/Grant Line		
Solid Property/Lot Line		
Southeast Quarter Corner		
State Line		
Survey Marker		

**CONTOUR ITEMS**

	<u>EX</u>	<u>PR</u>
Approx. Indes Line		
Approx. Intermediate Line		
Index Contour		
Intermediate Contour		
Slope Limit Line		

**DRAINAGE ITEMS**

	<u>EX</u>	<u>PR</u>
Aggregate Ditch		
Catch Basin		
Culvert End Section		
Culvert Line		
Ditch Check		
Ditch Profile Line		
Drainage Boundary Line		
Flowline		
Grading & Shaping Ditches		
Headwall		
Inlet		
Manhole		
Paved Ditch		
Roadway Ditch Flow		
Riprap		

**DRAINAGE ITEMS CONT.**

	<u>EX</u>	<u>PR</u>
Summit		
Swale		
Water Surface Indicator		

**EROSION & SEDIMENT CONTROL ITEMS**

	<u>EX</u>	<u>PR</u>
Cleaning & Grading Limits		
Dike		
Ditch Check Temporary		
Erosion Control Blanket		
Erosion Control Fence		
Fabric Formed Concrete Revetment Mat		
Fiber Mat		
Inlet & Pipe Protection		
Mulch Method 1		
Mulch Method 2 Stabilized		
Mulch Method 3 Hydraulic		
Mulch Temporary		
Perimeter Erosion Barrier		
Sediment Basin		
Temporary Fence		

**EXISTING IMPROVEMENT ITEMS**

	<u>EX</u>	<u>PR</u>
Advertising Sign		
Base of Levee		
Fence		
Mailbox		
Noise Attn./Levee		

**STANDARD SYMBOLS,  
ABBREVIATIONS  
AND PATTERNS**  
(Sheet 2 of 6)

**STANDARD 000001-02**

Illinois Department of Transportation

PASSED January 1, 1999  
*Charles Kollflich*  
ENGINEER OF POLICY AND PROCEDURES

APPROVED January 1, 1999  
*Bill Dunbar*  
ENGINEER OF DESIGN AND ENVIRONMENT

ISSUED 1-1-97




**LANDSCAPING ITEMS**

**EX**

**PR**

- Contour Mounding Line
- Evergreen Tree
- Deciduous Tree
- Intermediate Tree
- Shade Tree Code A
- Mowline
- Perennial Plants
- Seeding Class 2
- Seeding Class 3
- Seeding Class 4
- Seeding Class 5
- Seeding Class 7
- Seeding Type 1
- Seeding Type 2
- Shade Tree Code B (Interm)
- Shrubs Code C&D
- Sodding
- Tree Trunk Protection


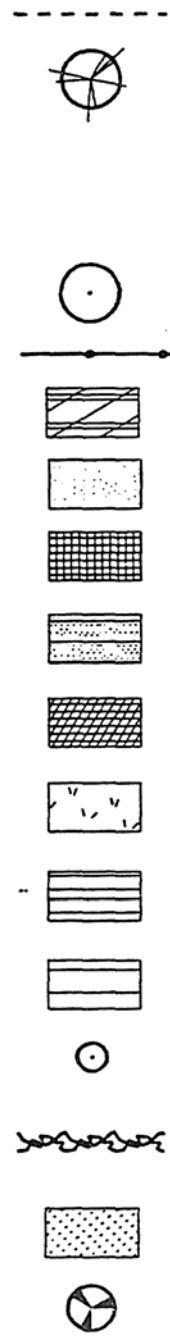


**LIGHTING**

**EX**

**PR**

- Cable In Duct w/o Ground
- Cable In Duct w/Ground
- Conduit w/Ground
- Controller
- Electrical Aerial Cable
- Electrical Buried Cable
- Electrical Ground
- Foundation Code A or C
- Handhole
- Heavyduty Handhole
- High Mast Pole
- Junction Box
- Light Unit Comb.
- Light Unit-1
- Power Pole
- Pull Point
- Traffic Flow Arrow
- Underpass Luminaire

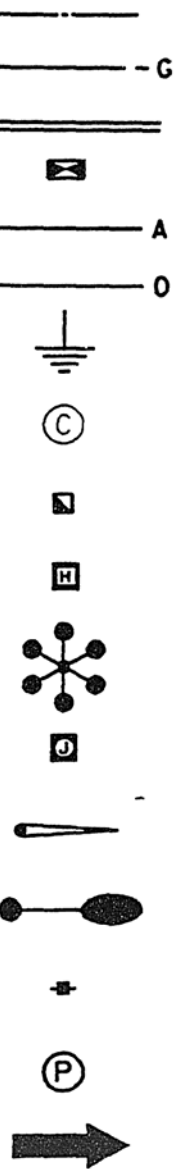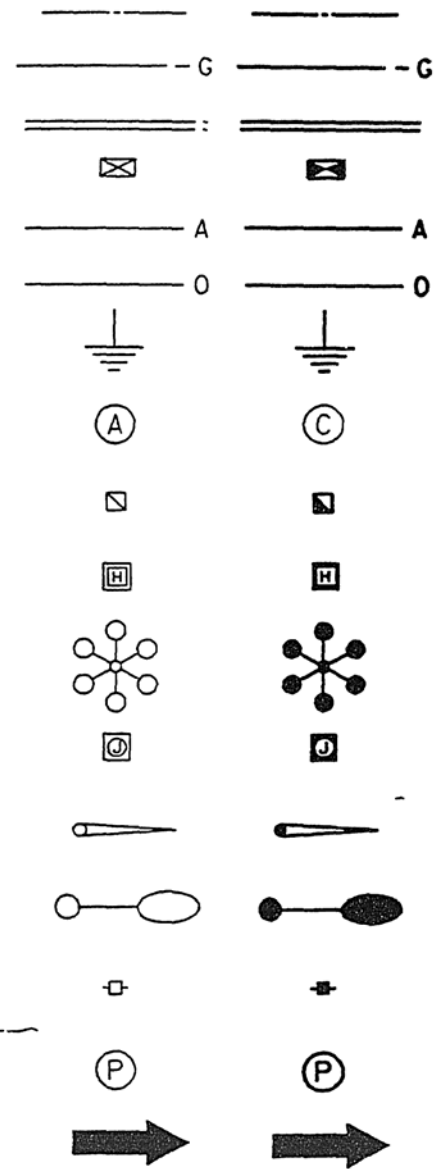


**PAVEMENT (MISC.)**

**EX**

**PR**

- Bituminous Shoulder
- Bituminous Taper
- Keyed Long. Joint
- Keyed Long. Joint w/Tie Bars
- Sawed Long. Joint w/Tie Bars
- Stabilized Driveway
- Widening

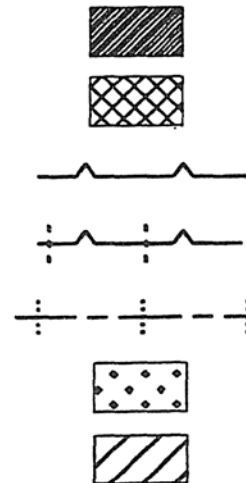


**PAVEMENT MARKINGS**

**EX**

**PR**

- CL 2Ln 2Way 12.2
- CL 2Ln 2Way 24.4
- CL Multilane Div. 12.2
- CL Multilane Div. 24.4
- CL Multilane Div. Dbl. 24.4
- CL Multilane Undiv.
- Dotted Lines
- Double Centerline
- Solid Line
- RR Crossing
- Raised Marker Amber 1 Way
- Raised Marker Amber 2 Way
- Raised Marker Crystal 1 Way
- Rural Combination Left Only
- Rural Combination Right Only
- Rural Left Turn Arrow
- Rural Left Turn Only
- Rural Right Turn Arrow
- Rural Right Turn Only
- Rural Thru Only

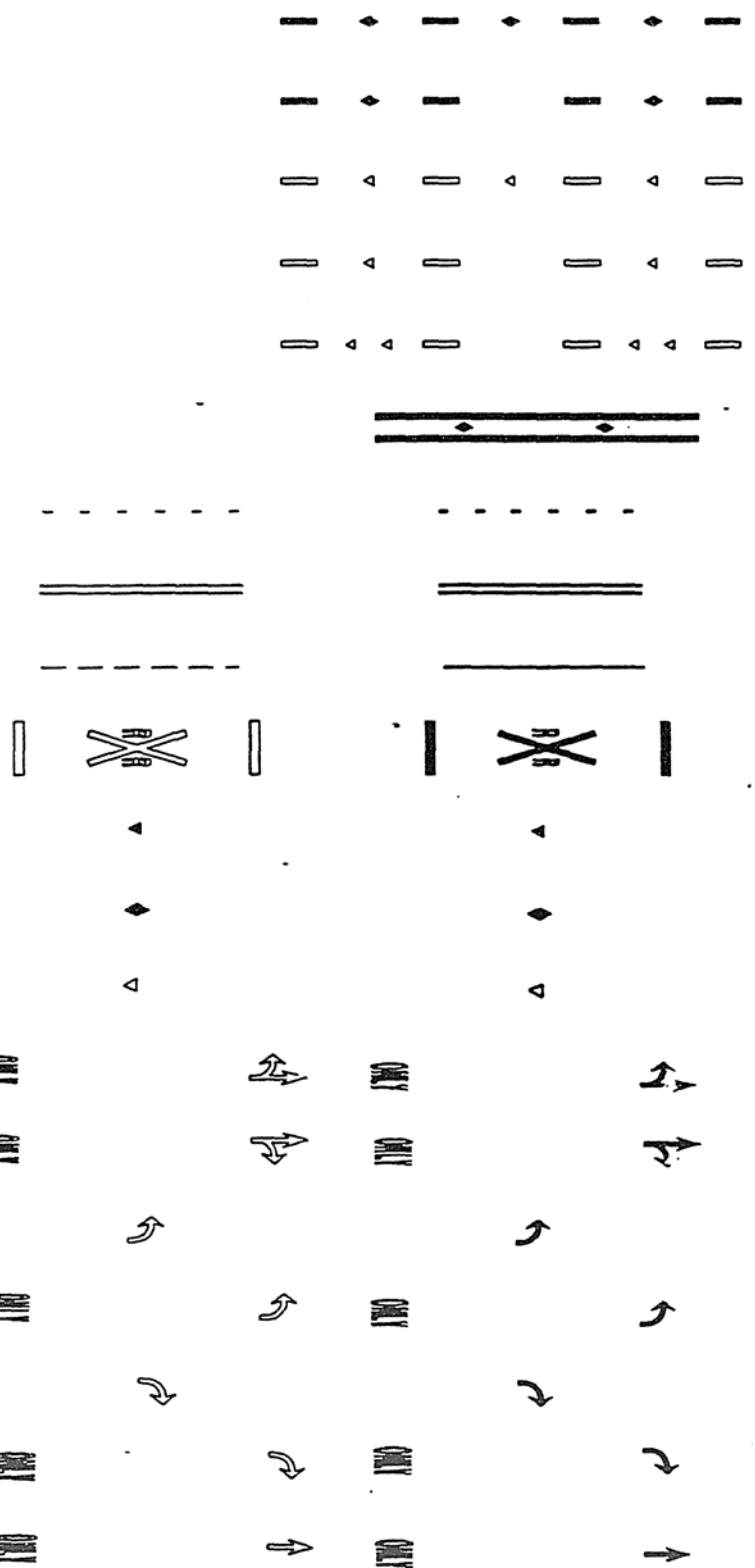

Illinois Department of Transportation

PASSED January 1, 1999  
*Charles Kallfleiter*  
 ENGINEER OF POLICY AND PROCEDURES

APPROVED January 1, 1999  
*Bill Sumler*  
 ENGINEER OF DESIGN AND ENVIRONMENT

ISSUED 1-1-97

**STANDARD SYMBOLS,  
 ABBREVIATIONS  
 AND PATTERNS**  
 (Sheet 3 of 6)

**STANDARD 000001-02**

**PAVEMENT MARKINGS CONT.**

	EX	PR
Shoulder Diag. Pattern		
Skip-Dash		
Skip-Dash White		
Skip-Dash Yellow		
Stop Lines		
Two Way Turn Left		
Two Way Turn Left Line		
Urban Combination Left Only		
Urban Combination Right Only		
Urban Left Turn Arrow		
Urban Right Turn Arrow		
Urban Left Turn Only		
Urban Thru Only		
Urban Right Turn Only		

**RAILROAD ITEMS**

	EX	PR
Abandoned Railroad		
Control Box		
Crossing Gate		
Flashing Signal		
Railroad Cant. Mast Arm		
Railroad		
Railroad Point		

**REMOVAL ITEMS**

	EX	PR
Bituminous Removal		
Hatch Pattern		
Removal Tic		

**RIGHT OF WAY ITEMS**

	EX	PR
Easement		
Future ROW Corner Monument		
ROW Line		
ROW Marker		
Temporary Easement		

**ROADWAY PLAN ITEMS**

	EX	PR
Corrugated Median		
Edge of Pavement		
Guardrail		
Guardrail Post		
Medians, C&G Line		
Traffic Sign		

**ROADWAY PROFILE**

	EX	PR
Earthworks Balance Point		
Begin Point		
P.I. Indicator		
Point Indicator		
Profile Line		
Vert. Curve Data	VPI = ELEV = L = E =	VPI = ELEV = L = E =

**SIGNING ITEMS**

	EX	PR
Barricade Type 1 or 2		
Barricade Type II		
Barricade Type III		
Barricade With Edge Line		
Detour Ahead W20-2		
Detour M4-10L-(0)		
Detour M4-10R-(0)		
Direction of Traffic		
Flashing Light Sign		
Keep Left R4-7AL		
Keep Left R4-7BL		
Keep Right R4-7AR		
Keep Right R4-7BR		
Left Lane Closed Ahead		
Left Turn Lane R3-1100L		
No Left Turn R3-2		

Illinois Department of Transportation

PASSED January 1, 1999  
*Charles Kallfleck*  
 ENGINEER OF POLICY AND PROCEDURES

ISSUED 1-1-97

APPROVED January 1, 1999  
*Bill Sumler*  
 ENGINEER OF DESIGN AND ENVIRONMENT

STANDARD SYMBOLS,  
 ABBREVIATIONS  
 AND PATTERNS  
 (Sheet 4 of 6)

STANDARD 000001-02



SIGNING ITEMS CONT.

EX

PR

No Right Turn R3-1



One Way Arrow Lrg. W1-6-(0)



One Way Left R6-1L



One Way Right R6-1R



Panels I



Panels II



Reverse Left W1-4L



Reverse Right W1-4R




Road Closed Ahead W20-R-(0)




Road Closed Ahead W20-3-(0)



Road Closed R11-2

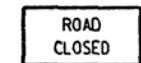

Road Closed Thru Traffic R11-2

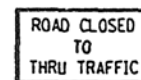

SIGNING ITEMS CONT.

EX

PR

Road Construct Ahead W20-1-(0)



Sign Flag



Single Lane Ahead



Stop Here On Red R10-6-AL



Stop Here On Red R10-6-AR



Transition Left W4-2L




Transition Right W4-2R



Two Way Arrow Large W1-7-(0)



Two Way Traffic Sign W6-3

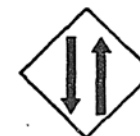

TRAFFIC SHEET ITEMS

EX

PR

Cable Number



Left Turn Green



Left Turn Yellow



Signal Backplate



Signal Section 200 mm



Signal Section 300 mm



Walk/Don't Walk Letters



Walk/Don't Walk Symbols




TRAFFIC SIGNAL ITEMS

EX

PR

Aluminum Mast Arm

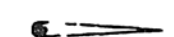

Conduit Splice





Controller





Detector Loop Larger



Detector Loop Line

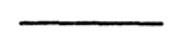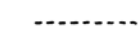

Detector Loop Quadrapole

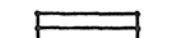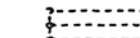

STANDARD SYMBOLS,  
ABBREVIATIONS  
AND PATTERNS

(Sheet 5 of 6)

STANDARD 000001-02

Illinois Department of Transportation

PASSED January 1, 1999  
*Charles Kallfleck*  
ENGINEER OF POLICY AND PROCEDURES

APPROVED January 1, 1999  
*Bill Sumler*  
ENGINEER OF DESIGN AND ENVIRONMENT

ISSUED 1-1-97

**TRAFFIC SIGNAL ITEMS CONT.**

EX

PR

 
 
Detector Loop Small



Detector Raceway



Galv. Steel Conduit



Gulfbox Junction



Handhole



Heavy Duty Handhole



Junction Box



Ped. Pushbutton Detector



Ped. Signal Head



Power Pole Service



Priority Veh. Detector



Signal Head



Signal Head w/Backplate



Signal Post



 
Steel Mast Arm



Temp. Signal Head



Undground Cable



Veh. Detector Magnetic



Wood Pole




**UNDERGROUND UTIL. ITEMS**

 EX

PR

Cable TV



Electric Cable



Fiber Optic



Gas Pipe



 
Oil Pipe



Pipe Undredrain




Sanitary Sewer



Storm Sewer



 Telephone Cable



Water Pipe



**UTILITIES ITEMS**

EX

PR

Controller



Double Handhole



Fire Hydrant



Handhole



Heavy Duty Handhole



Junction Box



Light Pole



Manhole



Power Pole



Splice Box Above Ground



Telephone Splice Box Above Ground



Telephone Pole



Traffic Signal



Water Meter Valve Box



**VEGETATION ITEMS**

EX

PR

Deciduous Tree



Evergreen Tree




Stump



Vegetation Line



Woods & Bush Line

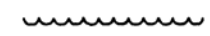

**WATER FEATURE ITEMS**

EX

PR


Disappearing Ditch



Marsh




Stream or Drainage Ditch

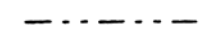

Water Point



Water Edge

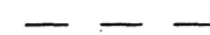

Illinois Department of Transportation

PASSED January 1, 1999  
*Charles Kallfleck*  
 ENGINEER OF POLICY AND PROCEDURES


APPROVED January 1, 1999  
*Bill Swales*  
 ENGINEER OF DESIGN AND ENVIRONMENT

ISSUED 1-1-97

STANDARD SYMBOLS,  
 ABBREVIATIONS  
 AND PATTERNS  
 (Sheet 6 of 6)


STANDARD 000001-02



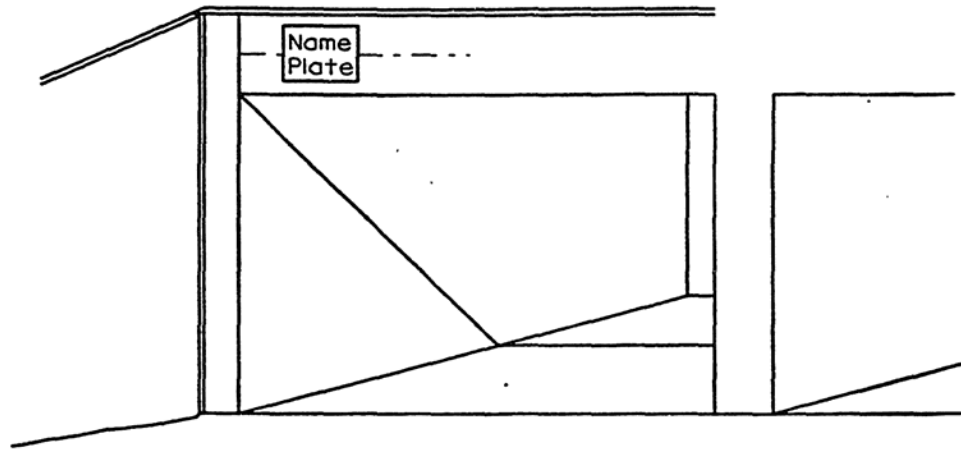


**FOR MULTI-SPAN CULVERTS**


(Unless otherwise noted on the plans, name plates are not required for single box culverts.)

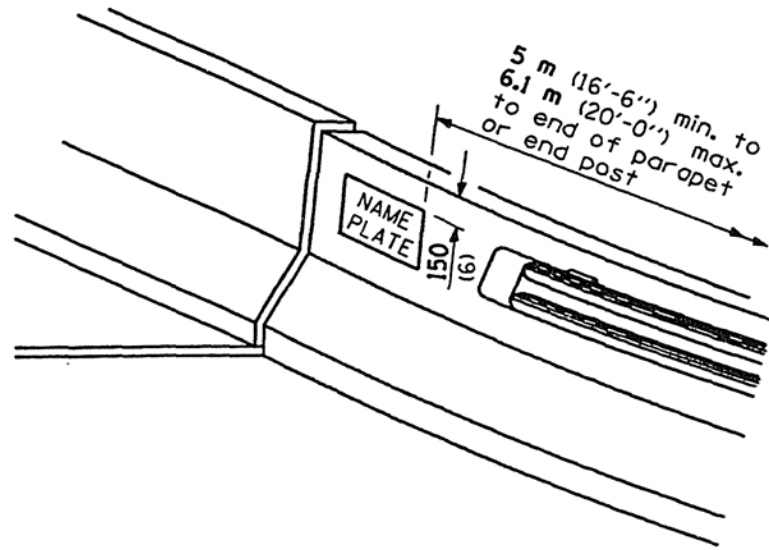


**FOR PARAPET AND END POST MOUNTED**

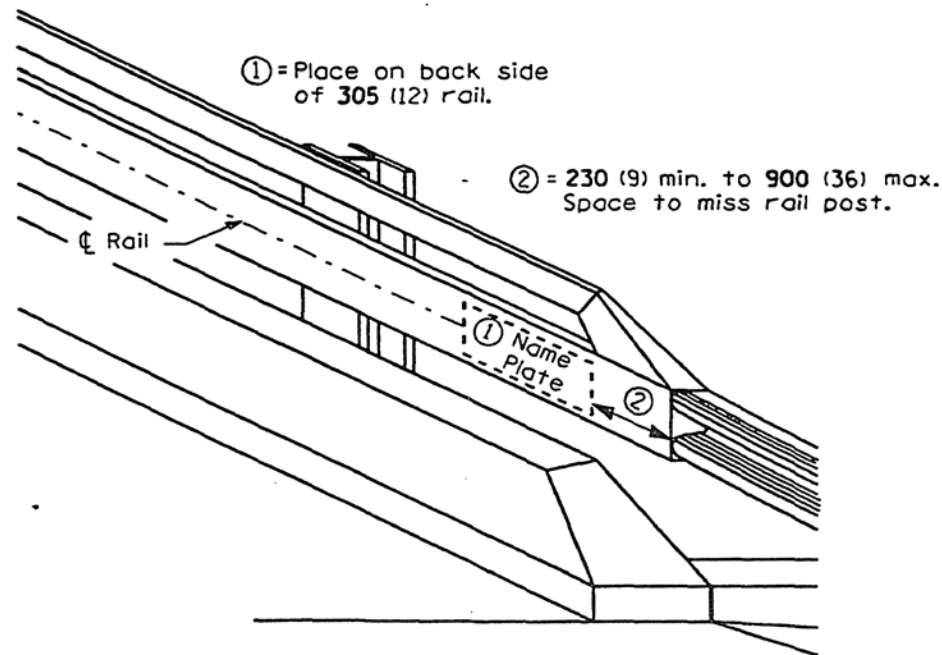

**FOR STEEL RAILS**

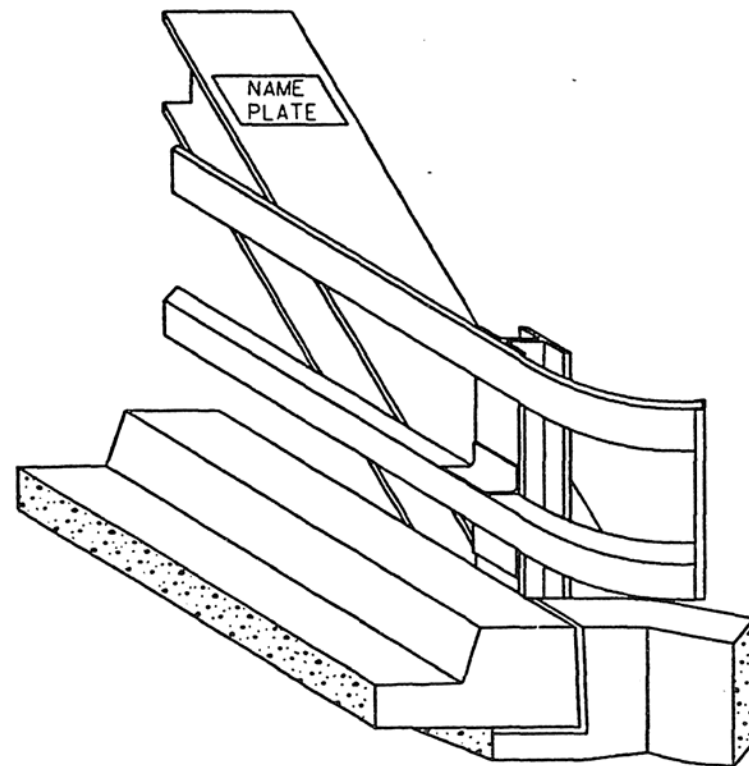

**FOR TRUSSES**

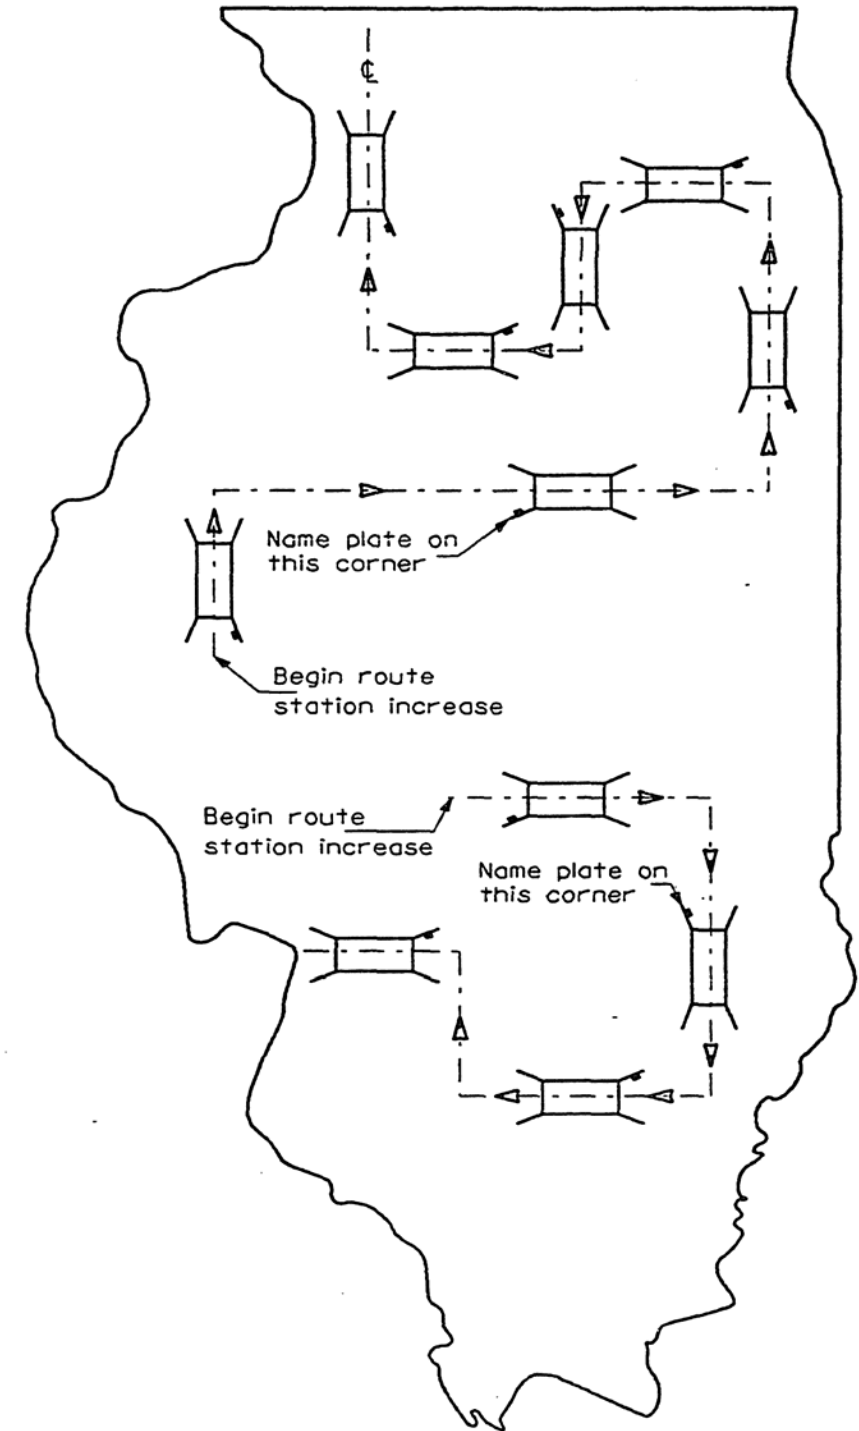

**TYPICAL EXAMPLES**

The name plate shall be located on the approach traffic end of a structure based on the direction of increasing stationing.

All dimensions are in millimeters (inches) unless otherwise shown.

Illinois Department of Transportation

APPROVED January 1, 1997  
*Ralph E. Anderson*  
 ENGINEER OF BRIDGES AND STRUCTURES

APPROVED January 1, 1997  
*Tom Stuel*  
 ENGINEER OF DESIGN AND ENVIRONMENT



ISSUED 1-1-97

DATE	REVISIONS
1-1-97	Renum. Standard 2113-4.
	Rev. metric value of raised letter height.
11-1-94	Revised plan of plate.

**NAME PLATE FOR BRIDGES**

(Sheet 1 of 2)

**STANDARD 515001**

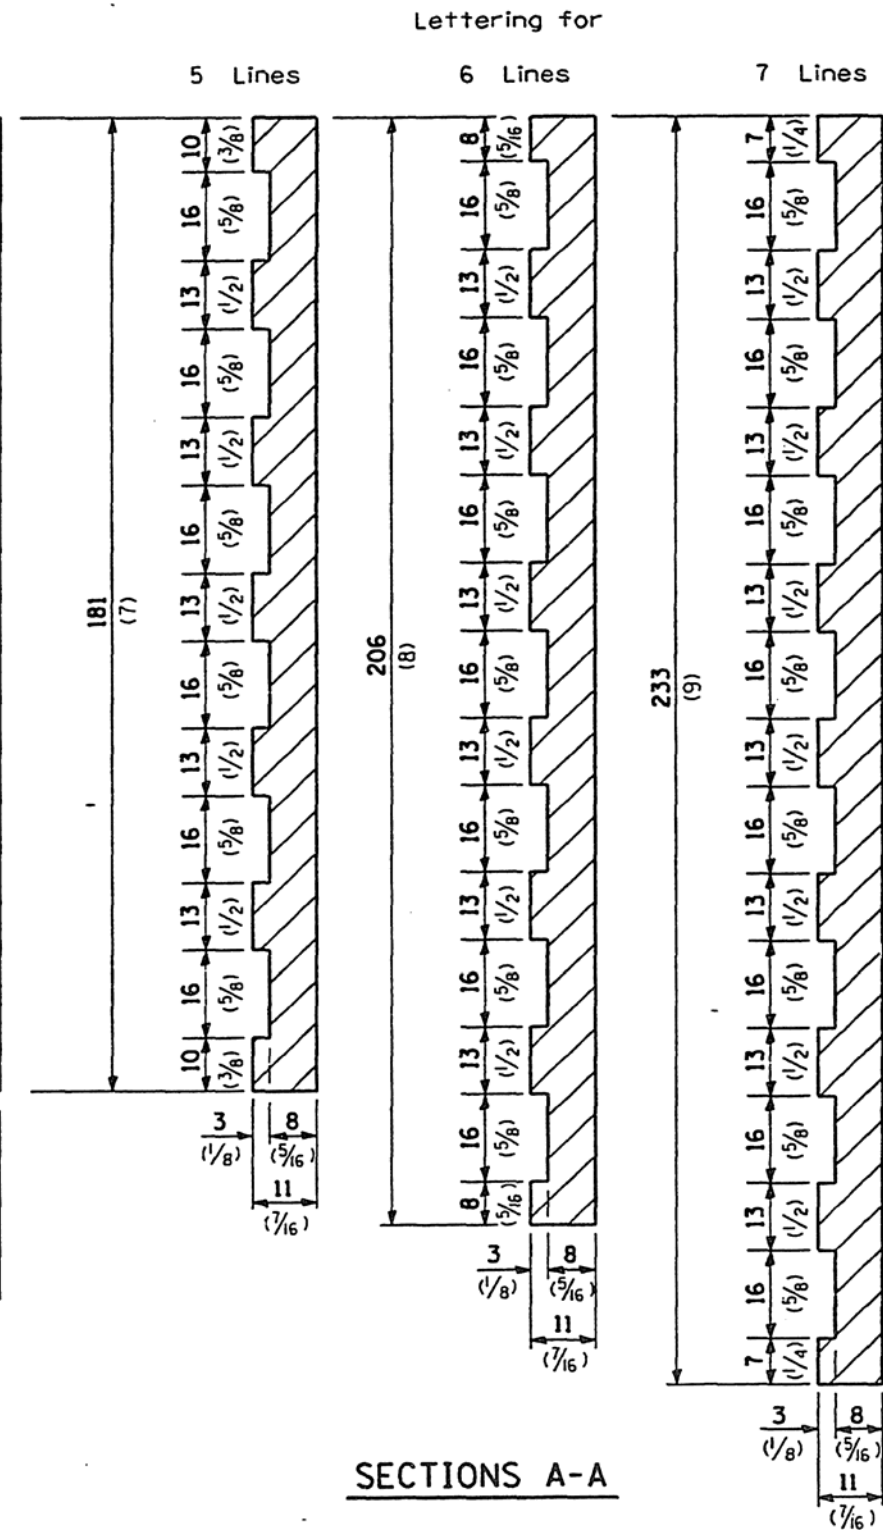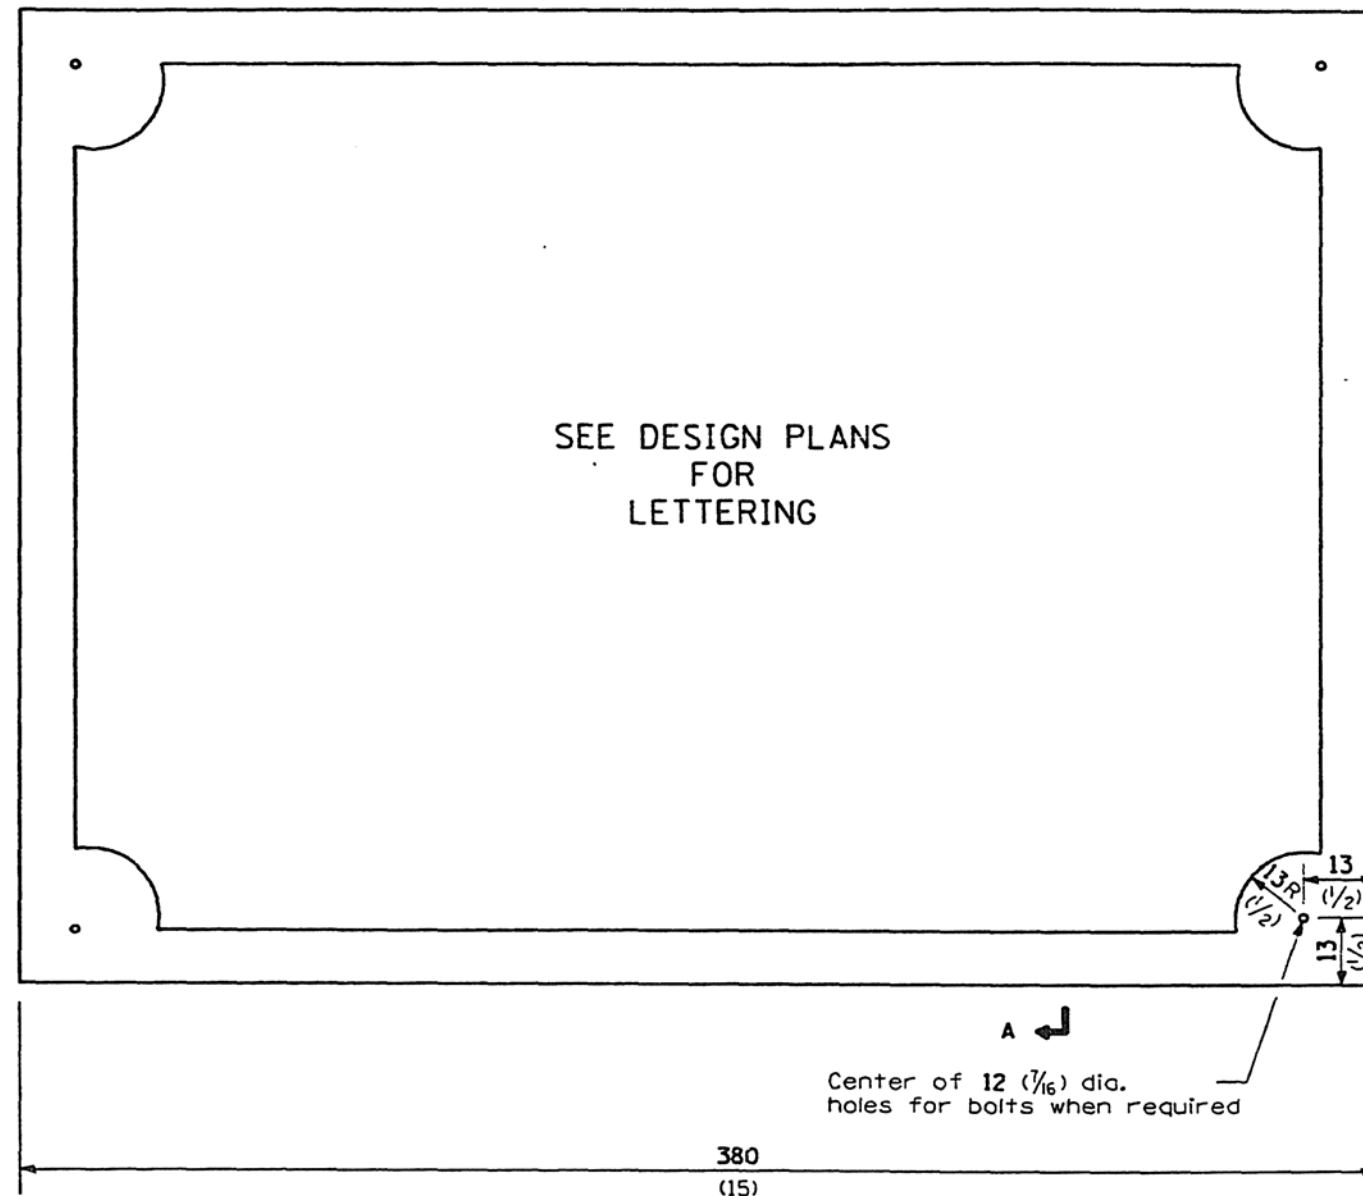

SECTIONS A-A

NOTE

Border and lettering:  
Raised  $3 \frac{1}{8}$ , square cut and not tapered.

Placing:  
For concrete parapets ----- Plates to be placed 5 m (16'-6") min. to 6.1 m (20'-0") max. to end of parapet.  
For steel truss span ----- Braze to end post about 1.5 m (5'-0") above roadway.  
For steel rails ----- Place on back side of 305 (12) rail.  
For subways ----- See design plans for location.

All dimensions are in millimeters (inches) unless otherwise shown.

Illinois Department of Transportation

APPROVED January 1, 1997  
*Ralph E. Anderson*  
ENGINEER OF BRIDGES AND STRUCTURES

APPROVED January 1, 1997  
*John J. Stuel*  
ENGINEER OF DESIGN AND ENVIRONMENT

ISSUED 1-1-97


NAME PLATE  
FOR BRIDGES

(Sheet 2 of 2)


STANDARD 515001




PIPE DIA.	THICKNESS	DIMENSIONS					SLOPE (Approx.) (V:H)	BODY	
		A	B	H	L	W			
300 (12)	1.63 (0.064)	25± (1)	150 (6)	150 (6)	38± (1 1/2)	535 (21)	610 (24)	1:2 1/2	1 Pc.
375 (15)	1.63 (0.064)	180 (7)	205 (8)	150 (6)	38± (1 1/2)	660 (26)	760 (30)	1:2 1/2	1 Pc.
450 (18)	1.63 (0.064)	205 (8)	255 (10)	150 (6)	38± (1 1/2)	785 (31)	915 (36)	1:2 1/2	1 Pc.
525 (21)	1.63 (0.064)	230 (9)	305 (12)	150 (6)	38± (1 1/2)	915 (36)	1.065 m (42")	1:2 1/2	1 Pc.
600 (24)	1.63 (0.064)	255 (10)	330 (13)	150 (6)	1.040 m (41")	1.220 m (48")		1:2 1/2	1 Pc.
750 (30)	2.01 (0.079)	305 (12)	405 (16)	205 (8)	1.295 m (51")	1.525 m (60")		1:2 1/2	1 Pc.
900 (36)	2.01 (0.079)	355 (14)	480 (19)	230 (9)	1.525 m (60")	1.830 m (72")		1:2 1/2	2 Pc.
1050 (42)	2.77 (0.109)	405 (16)	560 (22)	280 (11)	1.750 m (69")	2.135 m (84")		1:2 1/2	2 Pc.
1200 (48)	2.77 (0.109)	455 (18)	685 (27)	305 (12)	1.980 m (78")	2.285 m (90")		1:2 1/4	2 Pc.
1350 (54)	2.77 (0.109)	455 (18)	760 (30)	305 (12)	2.135 m (84")	2.590 m (102")		1:2	2 Pc.
1500 (60)	2.77 (0.109)	455 (18)	840 (33)	305 (12)	2.210 m (87")	2.895 m (114")		1:1 3/4	3 Pc.
1650 (66)	2.77 (0.109)	455 (18)	915 (36)	305 (12)	2.210 m (87")	3.050 m (120")		1:1 1/2	3 Pc.
1800 (72)	2.77 (0.109)	455 (18)	990 (39)	305 (12)	2.210 m (87")	3.200 m (126")		1:1 1/3	3 Pc.
1950 (78)	2.77 (0.109)	455 (18)	1.065 m (42")	305 (12)	2.210 m (87")	3.355 m (132")		1:1 1/4	3 Pc.
2250 (84)	2.77 (0.109)	455 (18)	1.145 m (45")	305 (12)	2.210 m (87")	3.505 m (138")		1:1 1/6	3 Pc.

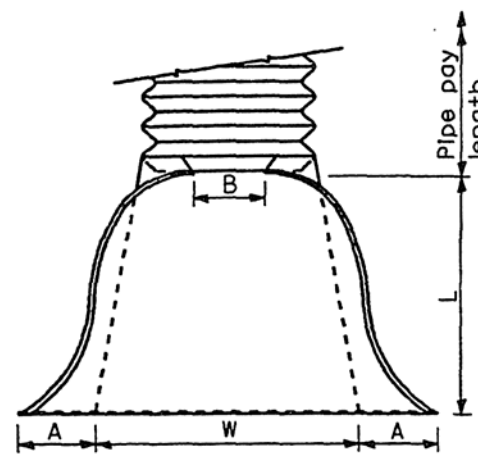

PLAN

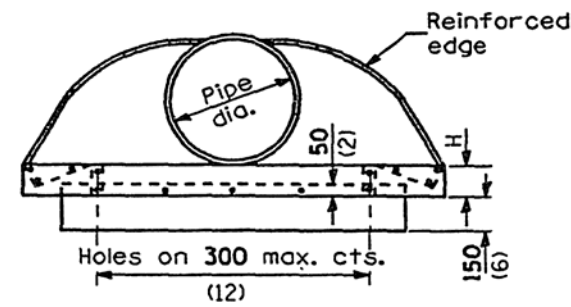

END VIEW

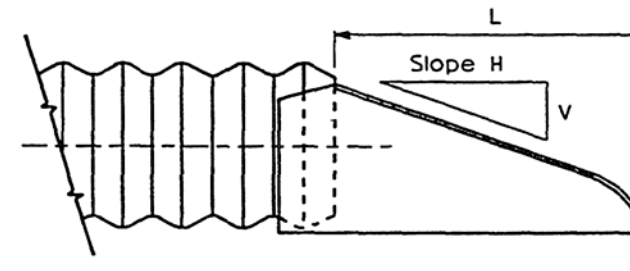


SIDE VIEW

END SECTION

NOTES


For 1500 mm (60") thru 2250 mm (84") sizes, reinforced edges shall be supplemented with stiffener angles. The angles shall be 51x51x6.4 mm (2x2x1/4") for 1500 mm (60") thru 1800 mm (72") diameter and 64x64x6.4 mm (2 1/2x2 1/2x1/4") for 1950 mm (78") thru 2250 mm (84") diameter. The angles shall be attached by M10 (3/8") rivets or bolts.

All slope ratios are expressed as units of vertical displacement to units of horizontal displacement (V:H).

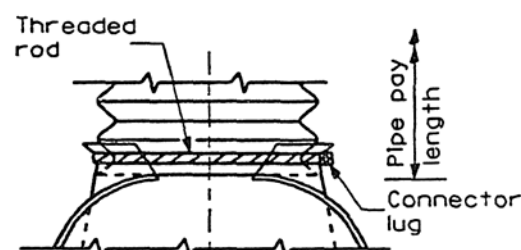


TYPE 1

For 300 (12) thru 600 (24) only (See Note 1)

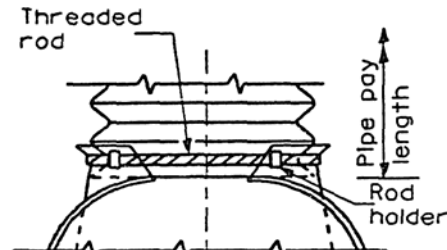

TYPE 2


For 750 (30) and 900 (36) only (See Note 1)

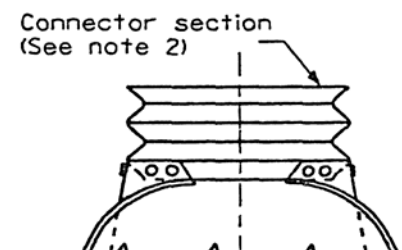

TYPE 3

(See Note 2)

Band shop bolted to end section with M10 (3/8) bolts.

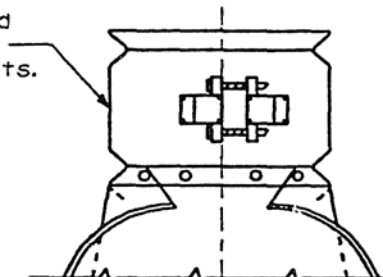


TYPE 4

(See Note 3)

NOTES

- Types 1 and 2 for pipes with annular ends only.
- Type 3 connection can be used for all pipe sizes and includes 300 mm (12") of the pipe length. The connector section shall be attached to the end section by rivets or bolts and shall be the same metal thickness as the end section. Stub shall be either 68 mm (2 2/3") pitch x 13 mm (1/2") depth or 75 mm (3") pitch x 25 mm (1") depth annular corrugated pipe.
- Type 4 connection can be used for all pipe sizes. Coupler shall be 68 mm x 13 mm (2 2/3"x1/2") dimple, hugger, or annular band of 75 mm x 25 mm (3"x1"). The dimple, hugger, or annular band may be used with corrugated metal pipes having annular ends. For corrugated metal pipes having helical ends, only the dimple band will be allowed.

All dimensions are in millimeters (inches) unless otherwise shown.

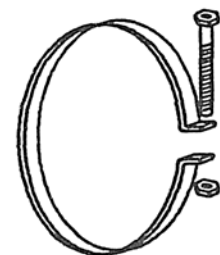

29 (1) Wide, 2.77 (0.109) thick strap with standard M12x150 (1/2x6) band bolt and nut.

ALTERNATE STRAP CONNECTOR

(For Type 1 only)

CONNECTIONS OF END SECTIONS

Illinois Department of Transportation

PASSED January 1, 1997

ENGINEER OF POLICY AND PROCEDURES

APPROVED January 1, 1997


ENGINEER OF DESIGN AND ENVIRONMENT

ISSUED 1-1-97

DATE	REVISIONS
1-1-97	Renum. Standard 2228-5.
6-15-94	Moved 3 Notes to specs.
	Added Metric.

METAL END SECTION FOR PIPE CULVERTS


STANDARD 542401

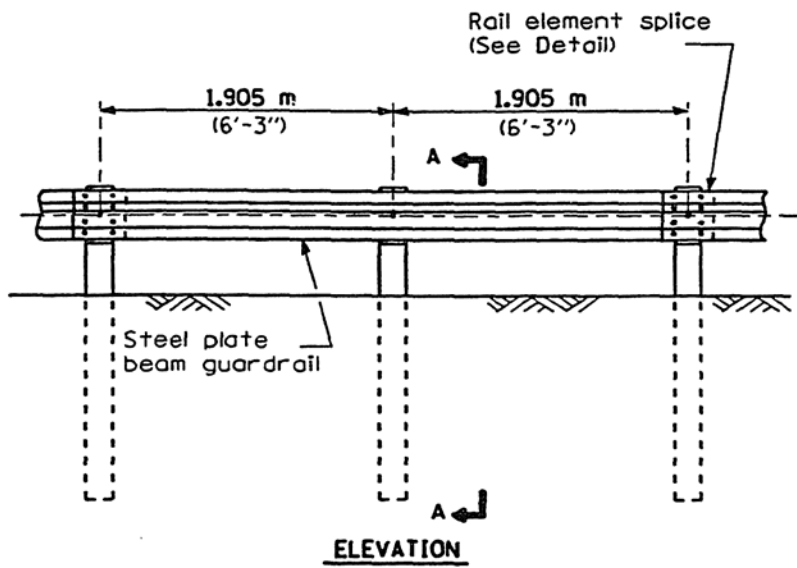


ELEVATION

**TYPE A**

1.905 m (6'-3") Typical post spacing

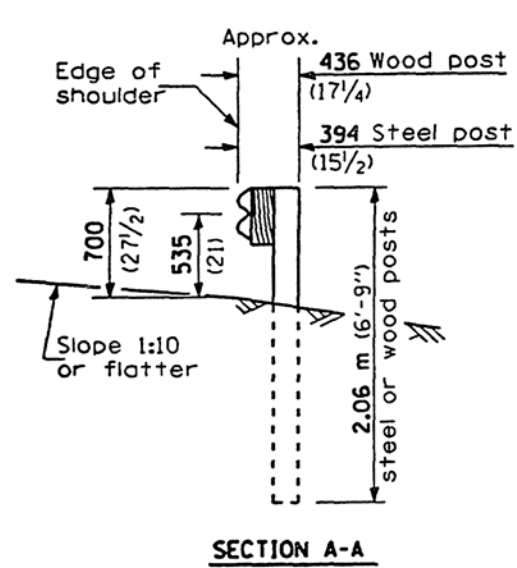


SECTION A-A

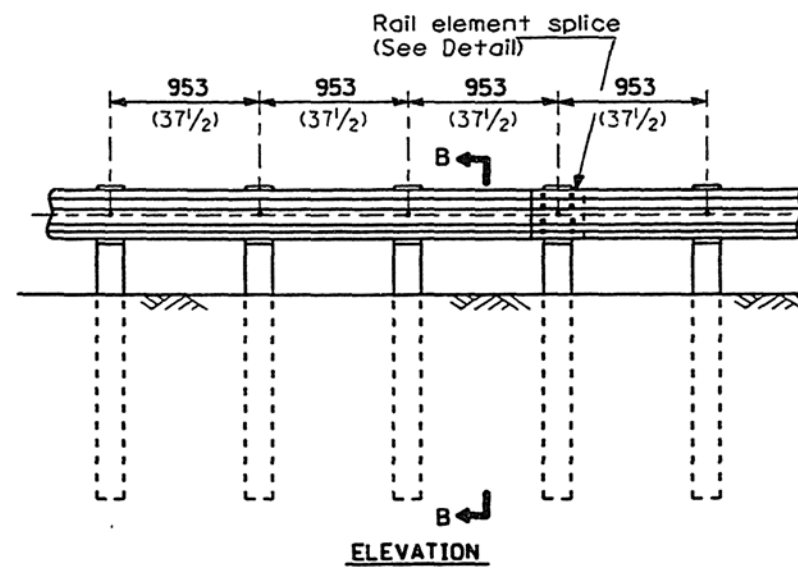


ELEVATION

**TYPE B**

953 (37 1/2) Closed post spacing

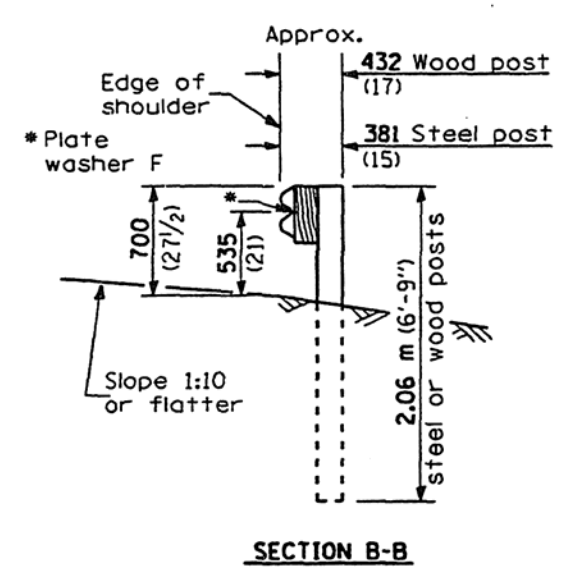


SECTION B-B

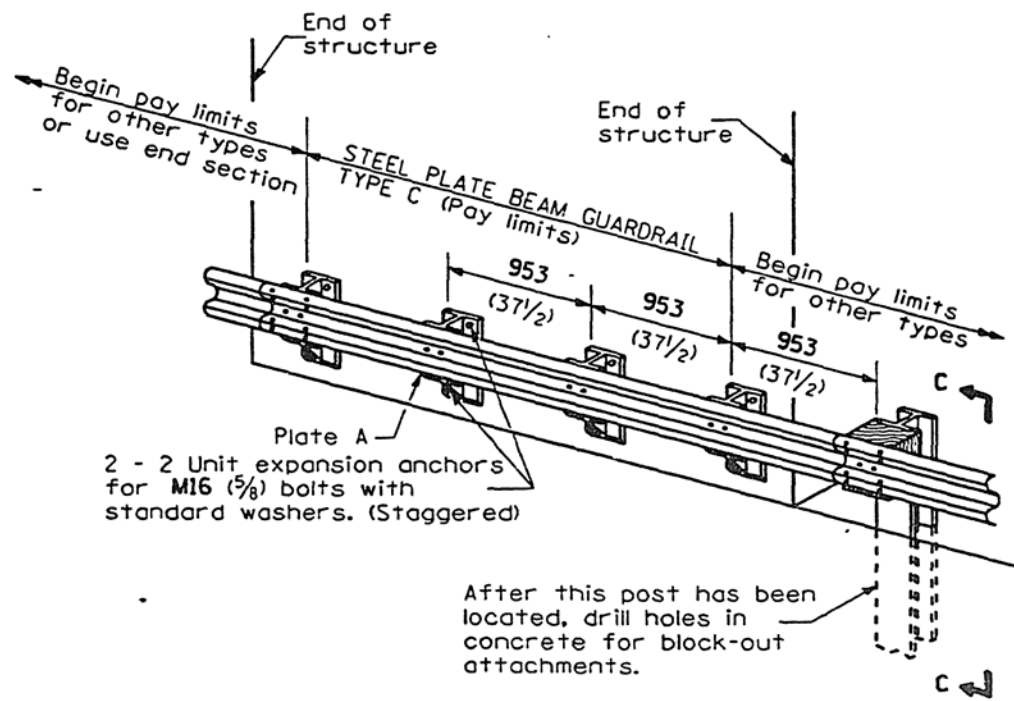


**TYPE C**

953 (37 1/2) Block-out spacing

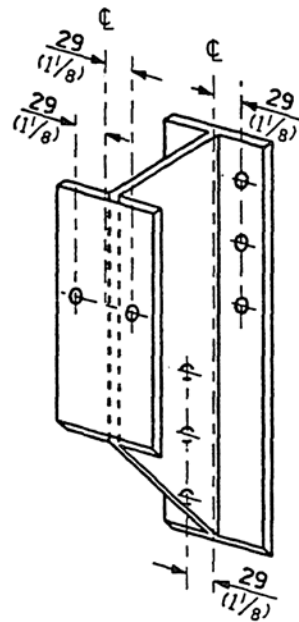


STEEL BLOCK-OUT DETAIL

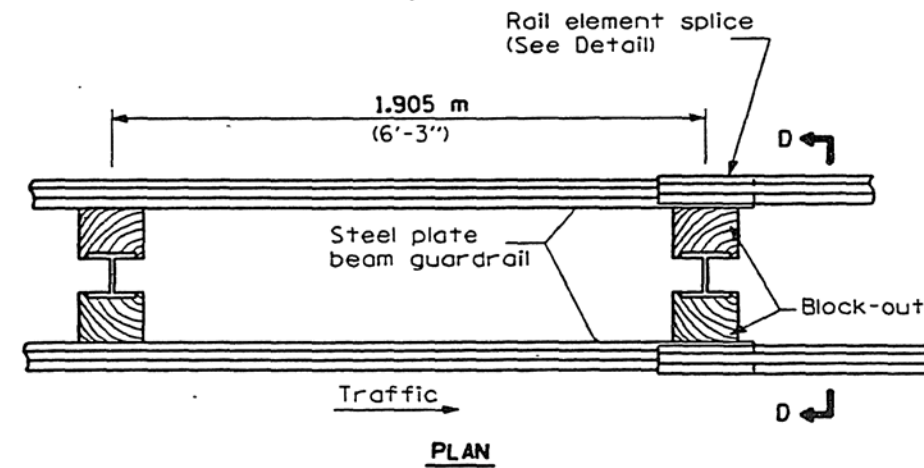


PLAN

**TYPE D**

Double steel plate beam guardrail  
1.905 m (6'-3") typical post spacing

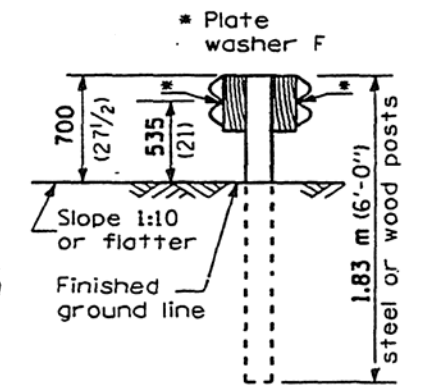

SECTION D-D

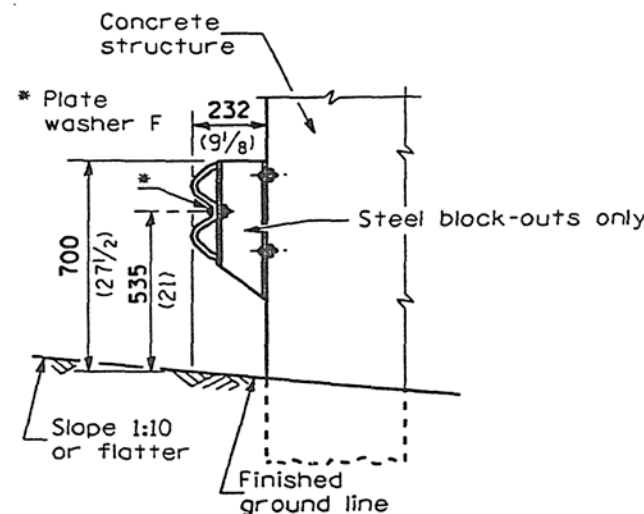

SECTION C-C

**GENERAL NOTE**

All slope ratios are expressed as units of vertical displacement to units of horizontal displacement (V:H).

All dimensions are in millimeters (inches) unless otherwise shown.

Illinois Department of Transportation

PASSED October 1, 1998  
Charles Kallflick  
ENGINEER OF POLICY AND PROCEDURES

APPROVED October 1, 1998  
Bill Swales  
ENGINEER OF DESIGN AND ENVIRONMENT

ISSUED 15-1-1 0305


DATE	REVISIONS
10-1-98	Revised block-outs to wood.
1-1-97	Renum. Standard 2230-18. Added opt. wood block-out details & notes.

**STEEL PLATE BEAM GUARDRAIL**


(Sheet 1 of 4)

**STANDARD 630001-01**



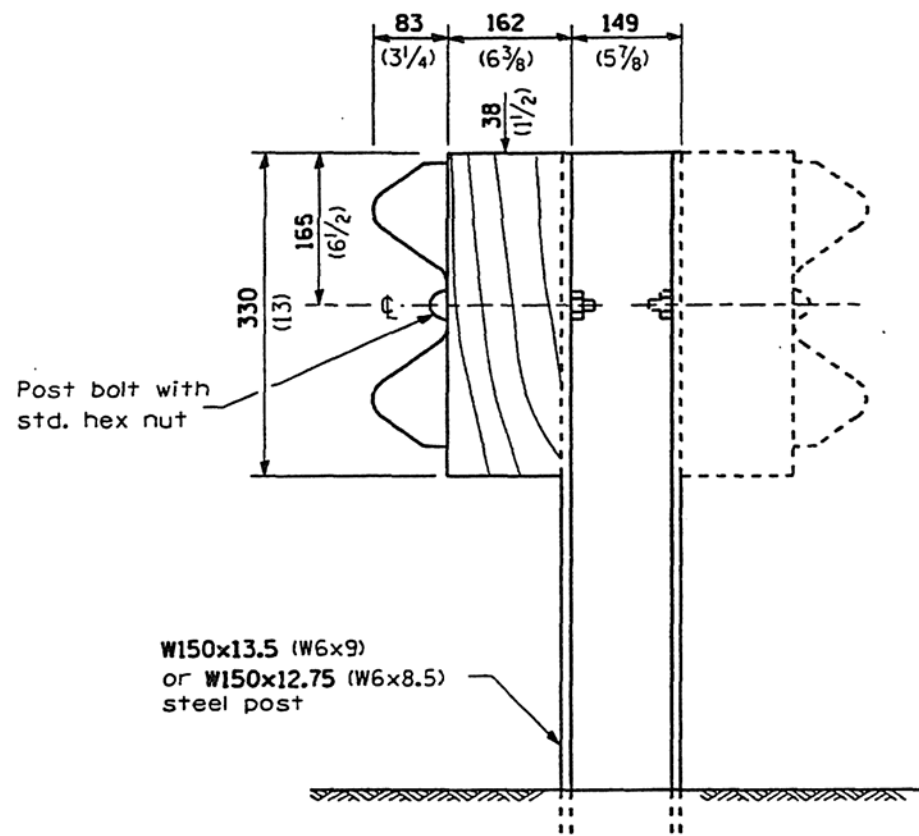


**STEEL POST CONSTRUCTION**

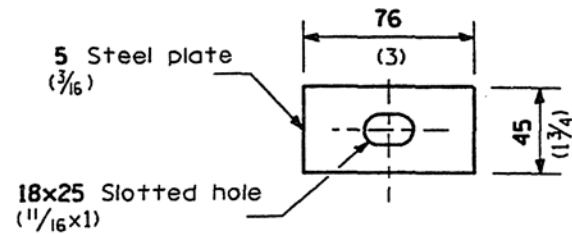


**NOTE**  
 Plate washer F shall be used on type A guardrail only where specified. Plate washer F shall be used at all other locations where rail element is bolted to a block-out unless otherwise noted.

**PLATE WASHER F**

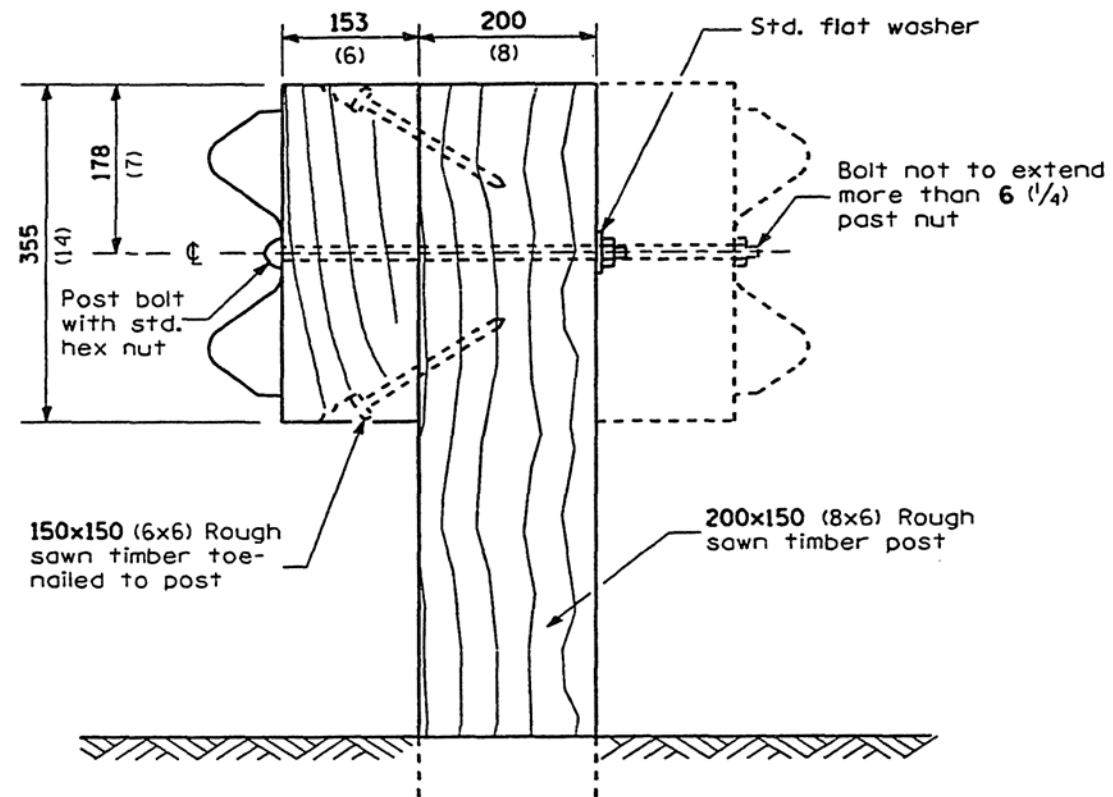


**WOOD POST CONSTRUCTION**

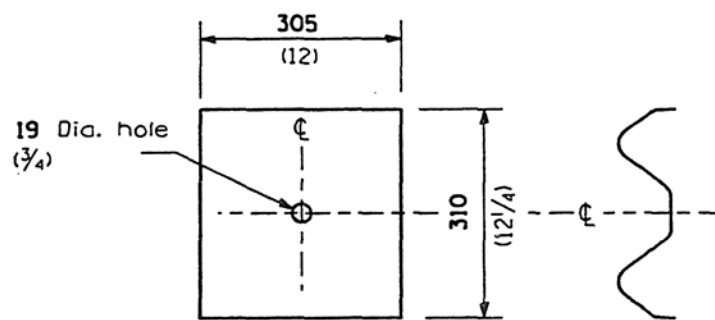

**NOTE**

Plate A shall be placed between rail element and block-out at non-splice mounting points only when steel block-outs are used.

**PLATE A**

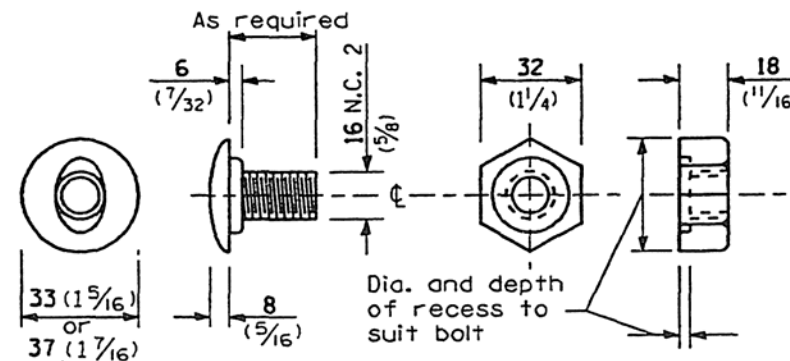

**POST OR SPLICE BOLT & NUT**

All dimensions are in millimeters (inches) unless otherwise shown.

Illinois Department of Transportation

PASSED October 1, 1998  
*Charles Kallfleck*  
 ENGINEER OF POLICY AND PROCEDURES

APPROVED October 1, 1998  
*Bill Sweeney*  
 ENGINEER OF DESIGN AND ENVIRONMENT


ISSUED 1-1-97

**STEEL PLATE BEAM  
 GUARDRAIL**


(Sheet 2 of 4)

**STANDARD 630001-01**


Place standard end shoe between splice plate and rail element

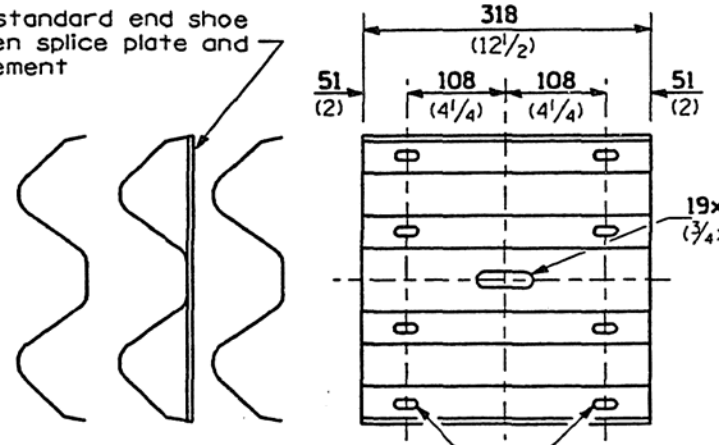

**SPLICE PLATE**

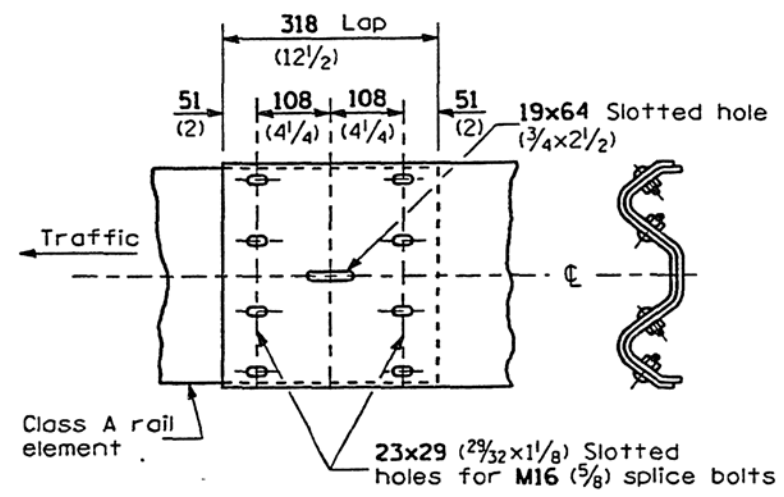


**RAIL ELEMENT SPLICE**

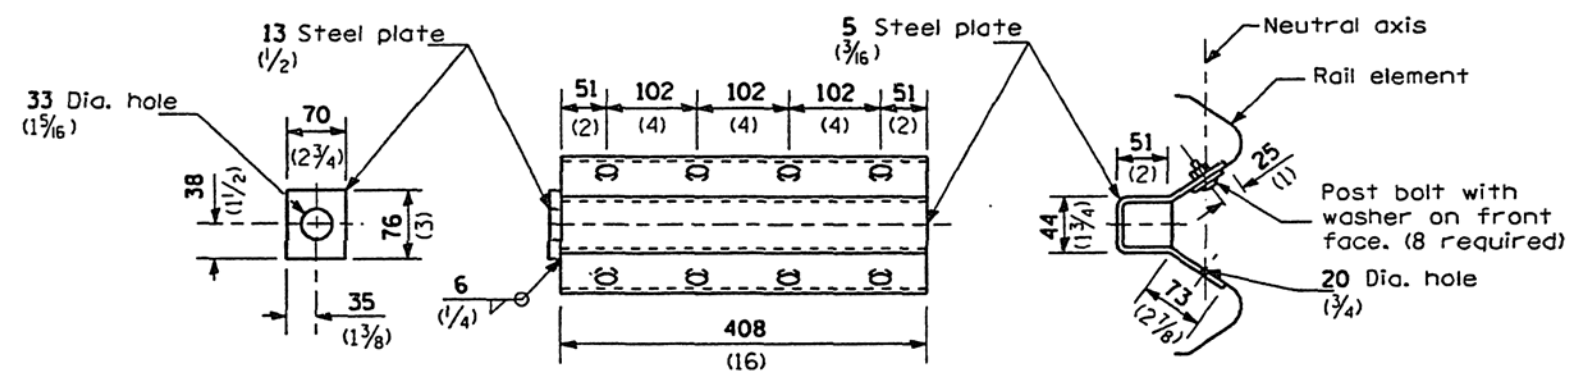


**NOTE**  
Anchor plate T shall be used to attach cable assembly to guardrail when required on traffic barrier terminals.


**ANCHOR PLATE T DETAILS**

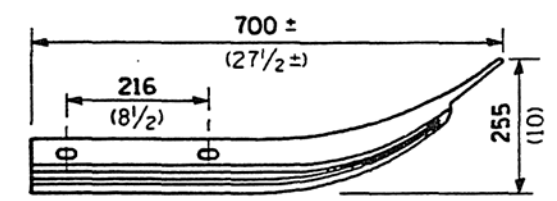

Class A rail element

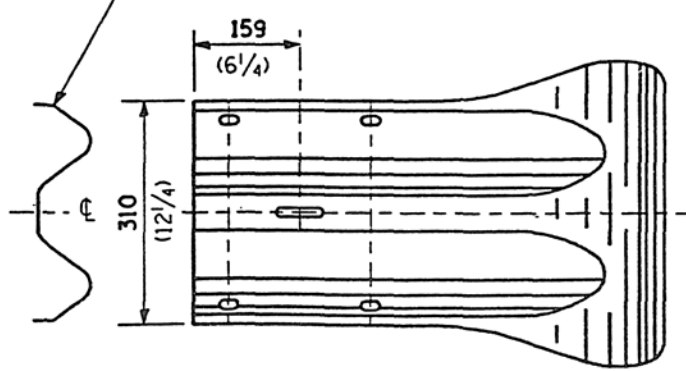

**END SECTION**

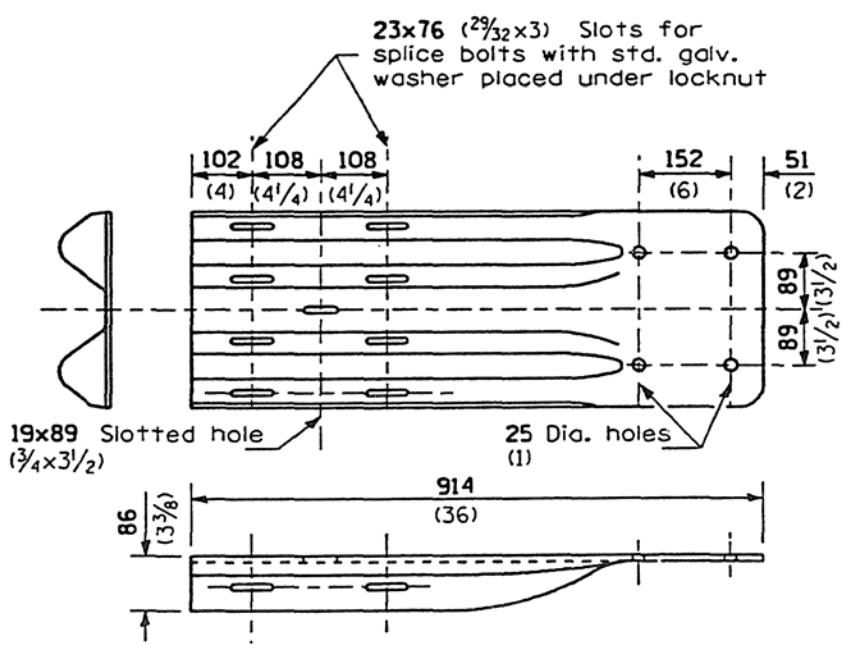


**NOTE**

When end shoe is attached to a bridge parapet which has an expansion joint, the bolts shall be provided with a locknut or double nut and shall be tightened only to a point that will allow guardrail movement.

The standard end shoe shall be attached to the concrete with pre-drilled or self-drilling anchor bolts. The anchor cone shall be set flush with the surface of the concrete.

Externally threaded studs protruding from the surface of the concrete will not be permitted.

**END SHOE**

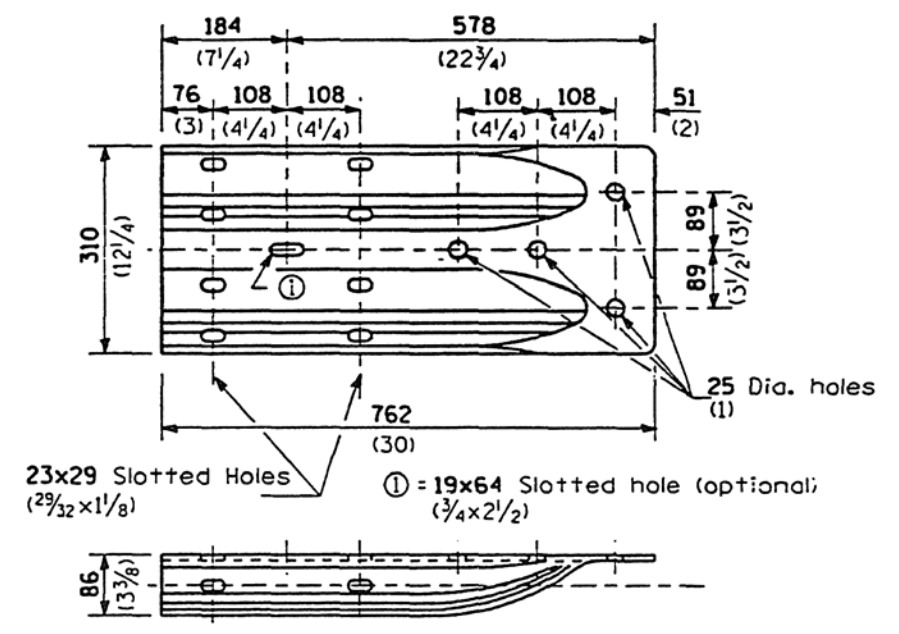

**ALTERNATE END SHOE**

All dimensions are in millimeters (inches) unless otherwise shown.

**STEEL PLATE BEAM GUARDRAIL**

(Sheet 3 of 4)

**STANDARD 630001-01**


Illinois Department of Transportation

PASSED October 1, 1998  
Charles Kelly  
ENGINEER OF POLICY AND PROCEDURES

APPROVED October 1, 1998  
Bill Dunbar  
ENGINEER OF DESIGN AND ENVIRONMENT

ISSUED 1-1-97



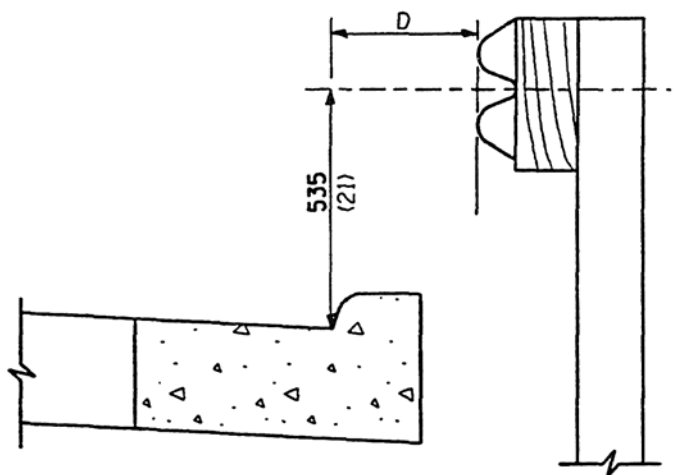


**NOTE**


If it is necessary for D to be more than 300 (12) and less than 3.0 m (10'-0") type M-5 (M-2) curb and gutter (Std. 606001) shall be used in front of and in advance of the guardrail.

**GUARDRAIL PLACED BEHIND CURB**

(D = 0 desirable to 300 (12) maximum)

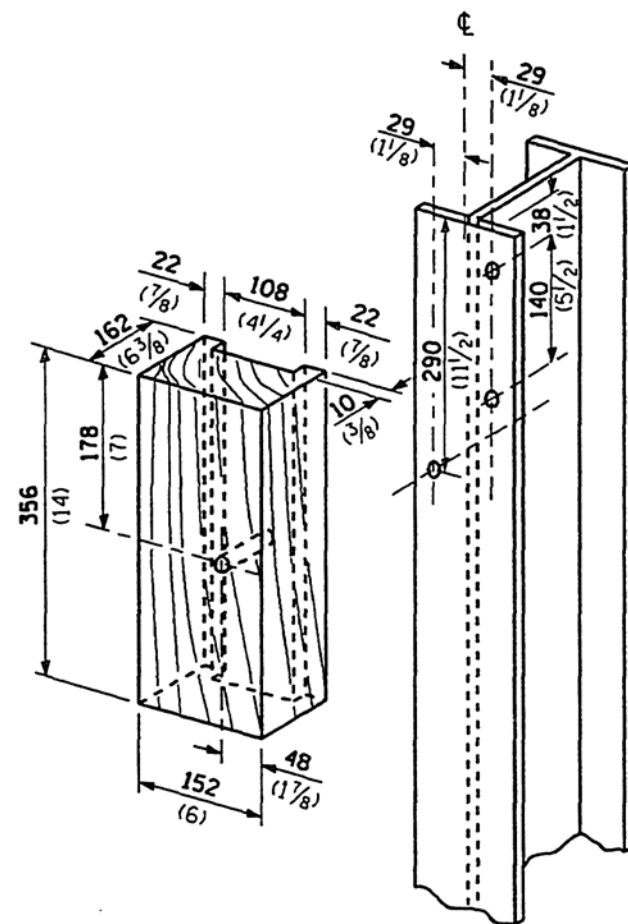

**WOOD BLOCK-OUT AND STEEL POST DETAILS**

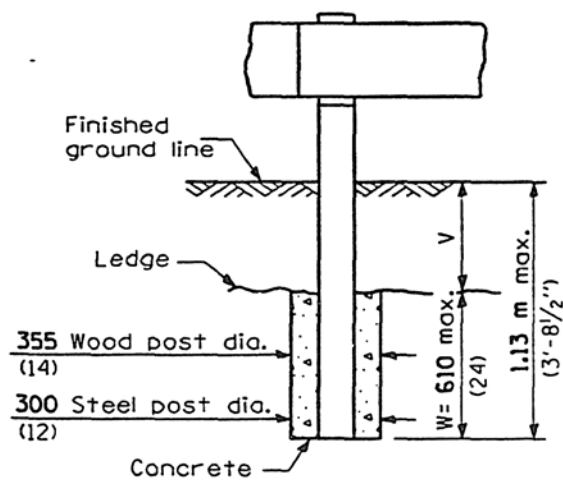


**NOTE**

When V is 0 to 520 (20 1/2), W = 600 (24).  
 When V is greater than 520 (20 1/2),  
 W = 1.13 m (3'-8 1/2") - V. When V is 150 (6) or less, post hole shall be filled to ground line with concrete.

Ledge line is top of rock ledge or hard slag fill.

**FOOTING FOR POST WHEN IMPERVIOUS MATERIAL IS ENCOUNTERED**

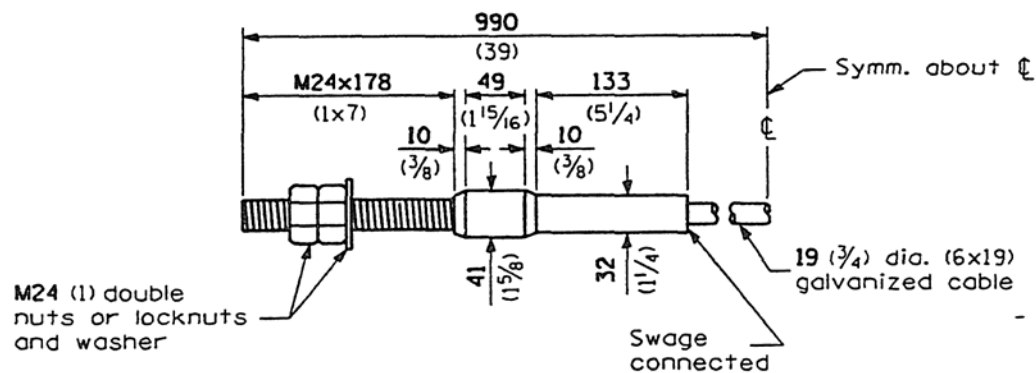

**CABLE ASSEMBLY**

(18,100 kg (40,000 lbs.) min. breaking strength)  
 Tighten to taut tension.

All dimensions are in millimeters (inches) unless otherwise shown.

Illinois Department of Transportation

PASSED October 1, 1998  
*Charles Kallfleck*  
 ENGINEER OF POLICY AND PROCEDURES


APPROVED October 1, 1998  
*Bill Sunkler*  
 ENGINEER OF DESIGN AND ENVIRONMENT

ISSUED 1-1-97

**STEEL PLATE BEAM GUARDRAIL**


(Sheet 4 of 4)

**STANDARD 630001-01**

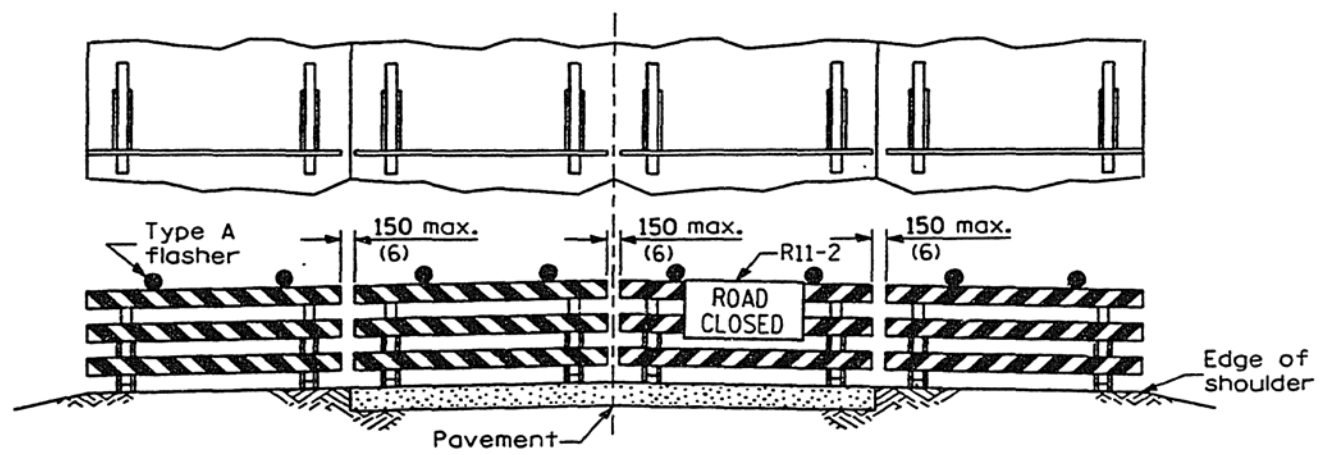

ROAD CLOSED TO ALL TRAFFIC

ReflectORIZED striping may be omitted on the back side of the barricades. The barricades shall be to the edge of the shoulders except when otherwise directed by the Engineer or shown on the detailed construction plans.

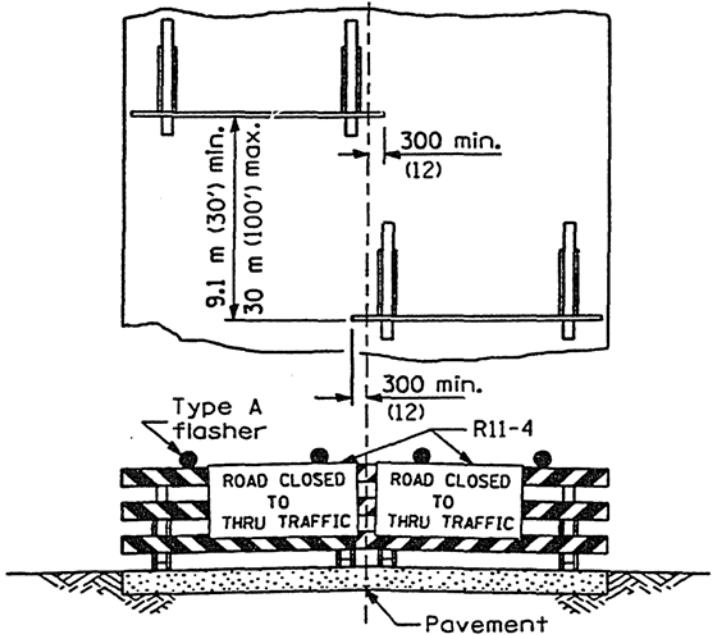

ROAD CLOSED TO ALL THRU TRAFFIC

ReflectORIZED striping shall appear on both sides of the barricades. The barricades shall be to the edge of the pavement except when otherwise directed by the Engineer or shown on the detailed construction plans.

ROAD  
CONSTRUCTION  
NEXT X MILES

G20-1(0)-6036

END  
CONSTRUCTION

G20-2a(0)-6024


This signing is required for all projects over 3200 m (2 miles) or more in length.

ROAD CONSTRUCTION NEXT X MILES sign shall be placed 150 m (500') in advance of project.


END CONSTRUCTION sign shall be erected at the of the job unless another job is within 3200 m (2 miles).

**WORK LIMIT SIGNING**


**TYPICAL APPLICATIONS OF TYPE III BARRICADES CLOSING A ROAD**

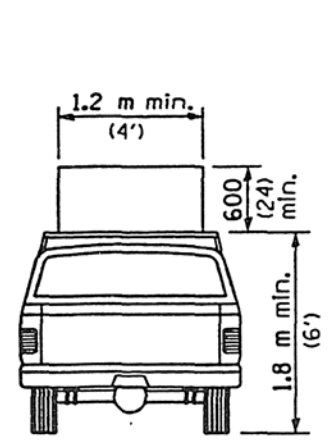

TYPE A  
ROOF MOUNTED


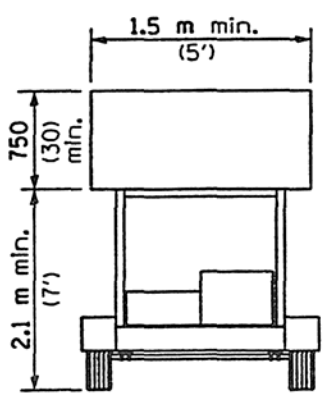


TYPE B  
ROOF OR TRAILER MOUNTED

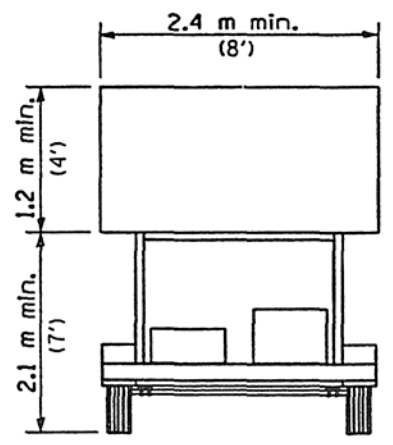

TYPE C  
TRAILER MOUNTED

**ARROW BOARDS**

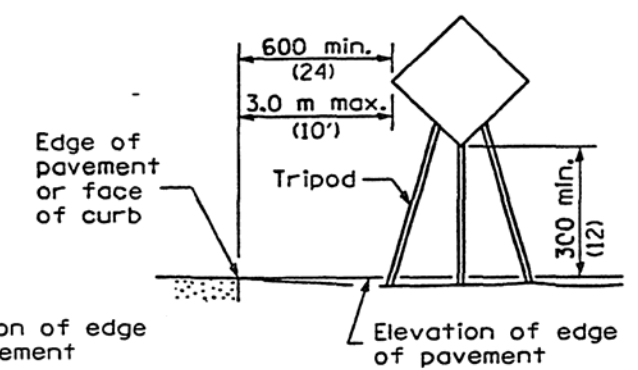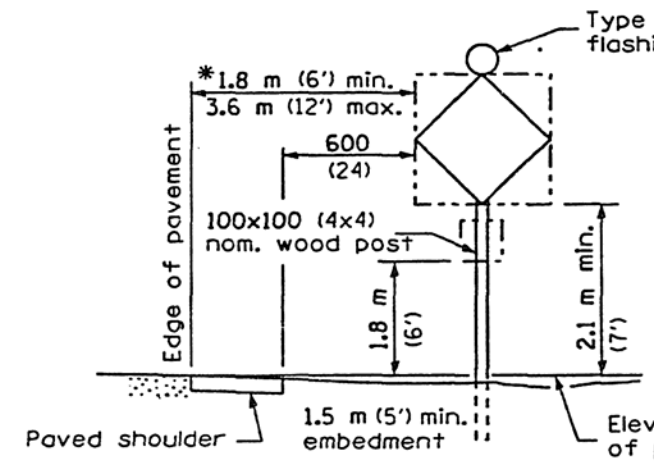

**TYPICAL SIGN INSTALLATIONS**

**GENERAL NOTES**

\* When curb or paved shoulder are present this dimension shall be 600 mm (24") to the face of curb or 1.8 m (6') to the outside edge of the paved shoulder.

All heights shown shall be measured above the pavement surface.

All dimensions are in millimeters (inches) unless otherwise shown.

Illinois Department of Transportation

APPROVED January 1, 2000  
ENGINEER OF OPERATIONS  
APPROVED January 1, 2000  
ENGINEER OF DESIGN AND ENVIRONMENT


ISSUED 1-1-16-17

DATE	REVISIONS
1-1-00	Rev. max. tripod sign height & END CONST. sign number.
10-1-97	Renum. Standard 2298-12. Revised construction speed limit sign.

**TRAFFIC CONTROL DEVICES**  
(Sheet 1 of 3)


**STANDARD 702001-01**



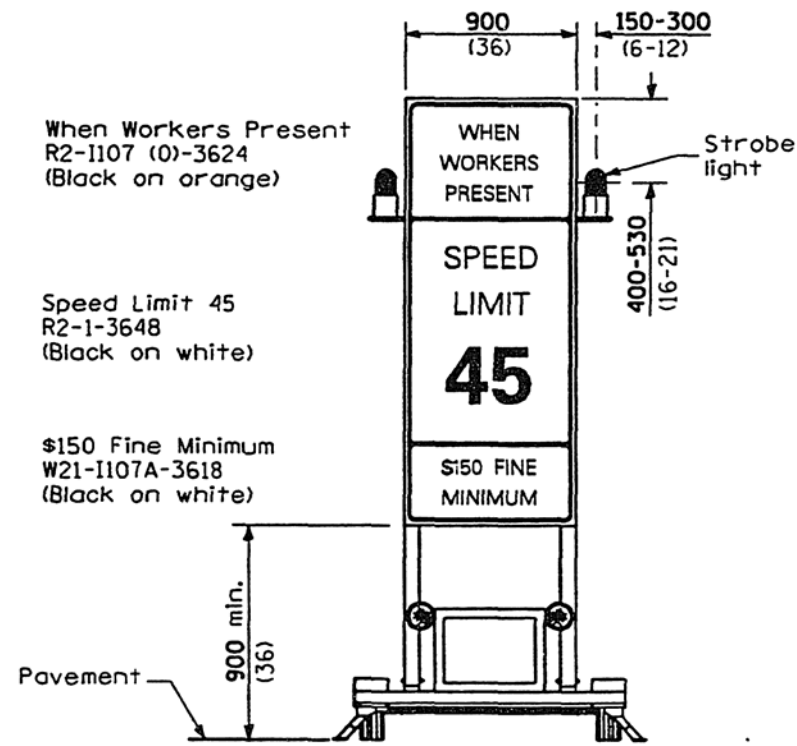

**CONSTRUCTION SPEED LIMIT SIGN**


Frames shall be no heavier than:  
100x100 (4x4) (nom. dim.) wood or  
50x50x3 (2x2x<sup>3</sup>/<sub>8</sub>) steel tubing or  
50x50x5 (2x2x<sup>5</sup>/<sub>16</sub>) steel angles

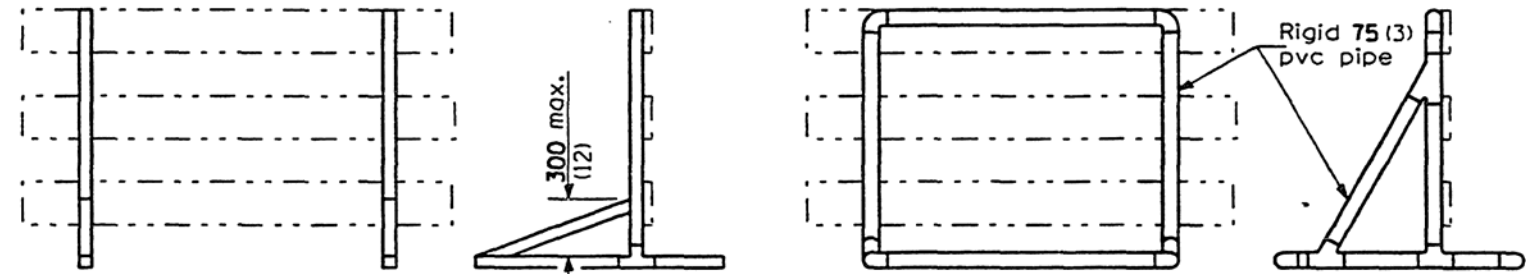


**WOOD OR METAL SUPPORTS**

**PVC PIPE SUPPORTS**


**WING BARRICADES**

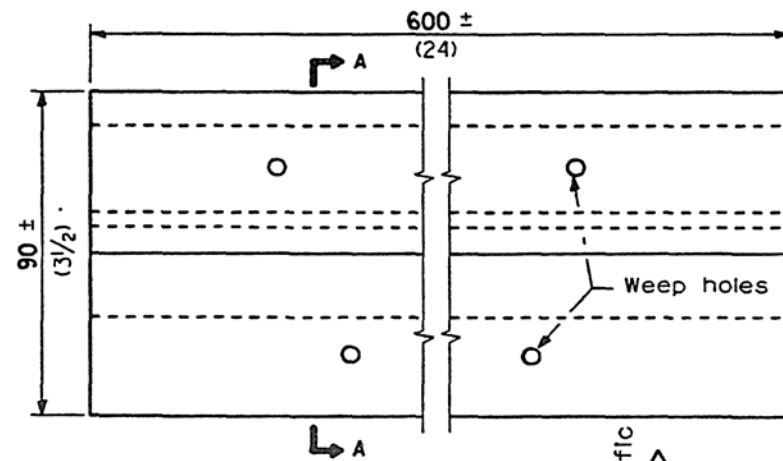

**PLAN**

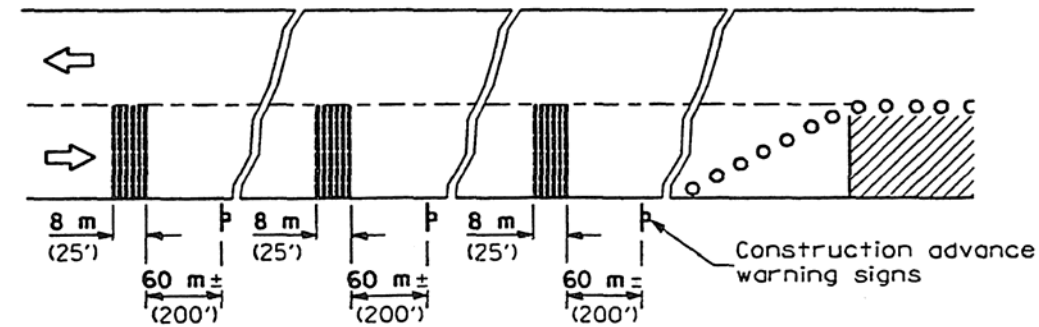


**TYPICAL INSTALLATION**

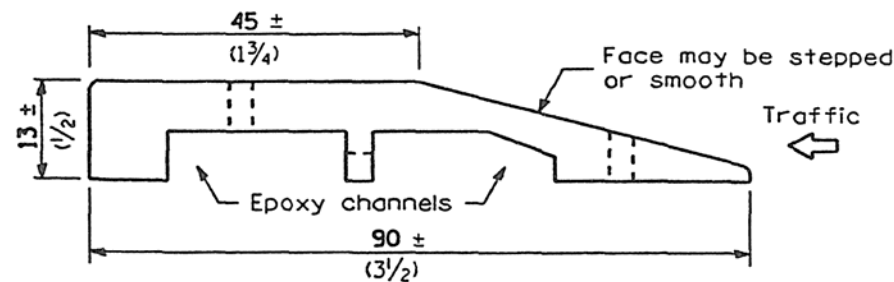

**SECTION A-A**

**TEMPORARY RUMBLE STRIPS**

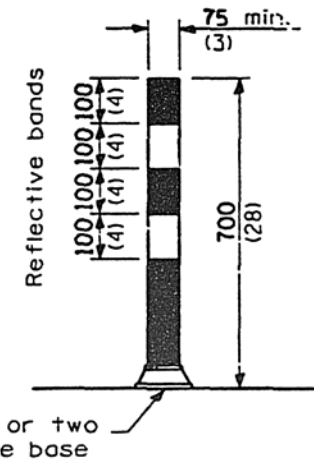

**FLEXIBLE DELINEATORS**

All dimensions are in millimeters (inches) unless otherwise shown.

**TRAFFIC CONTROL DEVICES**

(Sheet 2 of 3)

**STANDARD 702001**

Illinois Department of Transportation


APPROVED January 1, 1997

ENGINEER OF OPERATIONS *R. W. Jones*


APPROVED January 1, 1997

ENGINEER OF DESIGN AND ENVIRONMENT *Tom Gould*


ISSUED 1-1-1997

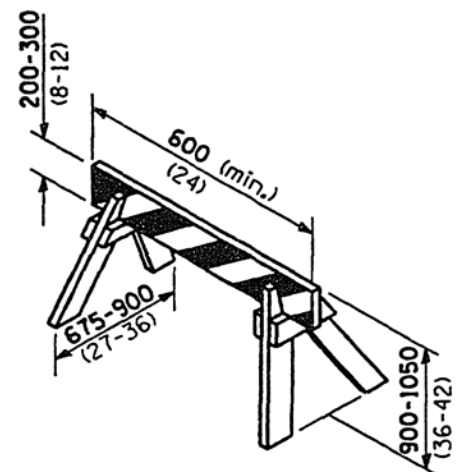


**TYPE 1A BARRICADE**

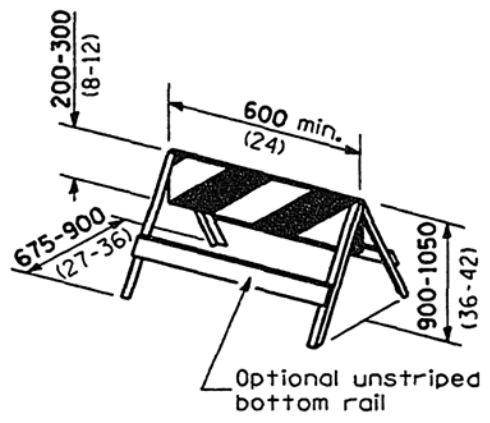


**TYPE 1 BARRICADE**

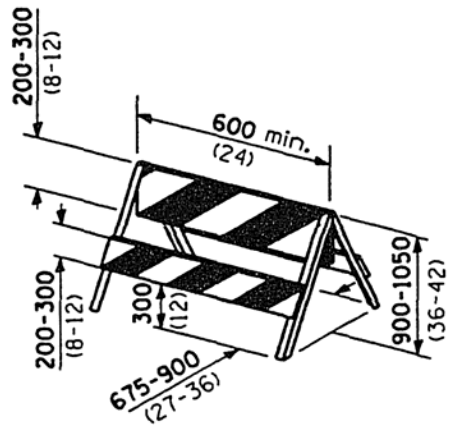


**TYPE II BARRICADE**

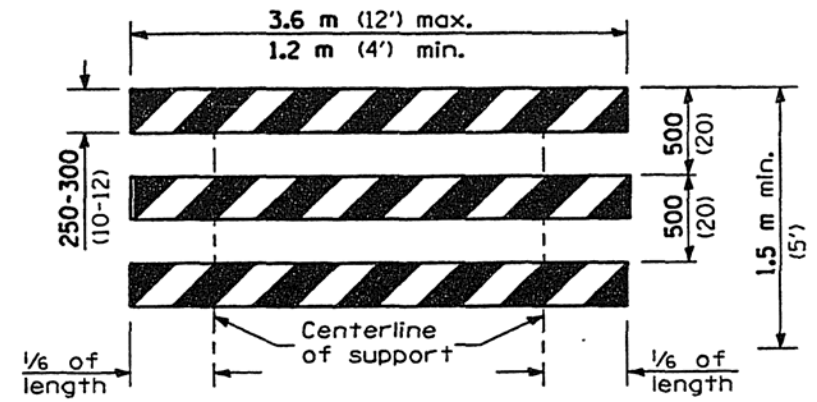


**TYPE III BARRICADES**

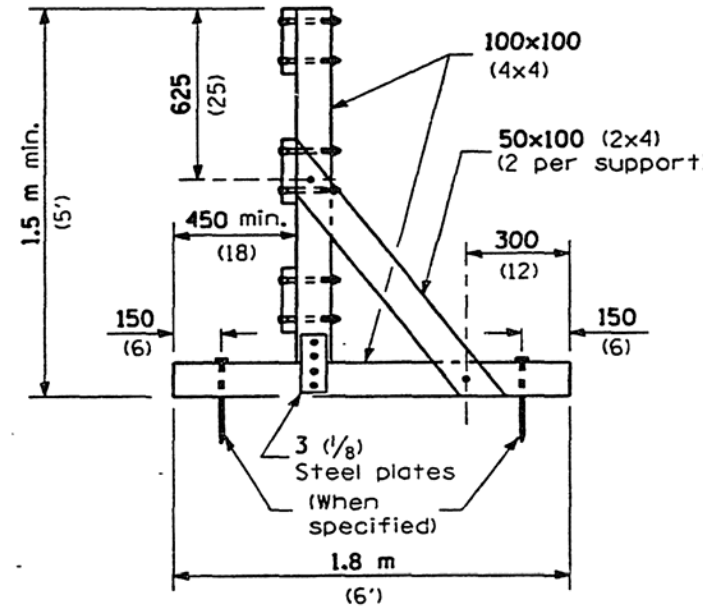


**TYPICAL WOOD SUPPORT**

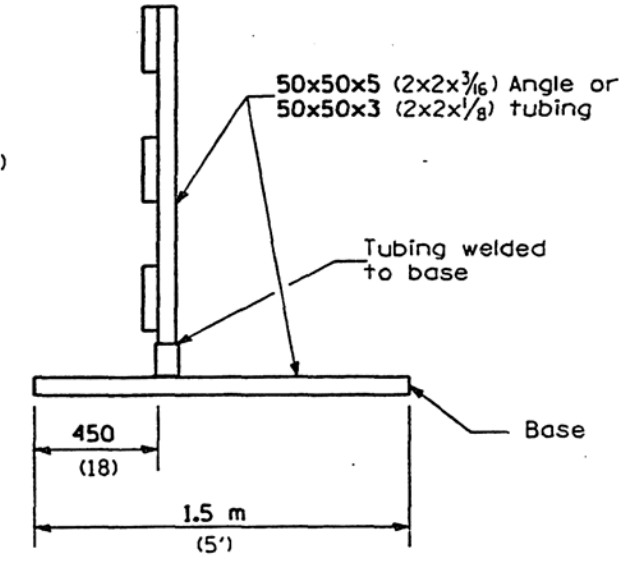

**TYPICAL STEEL SUPPORT**

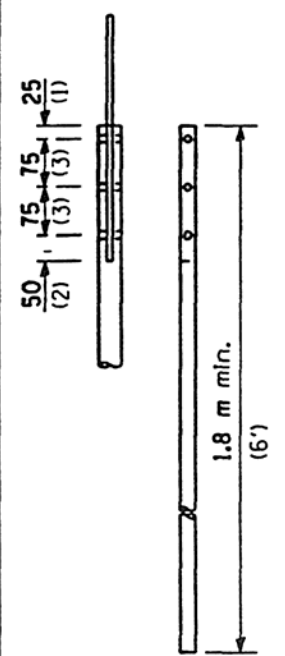


**STAFF**

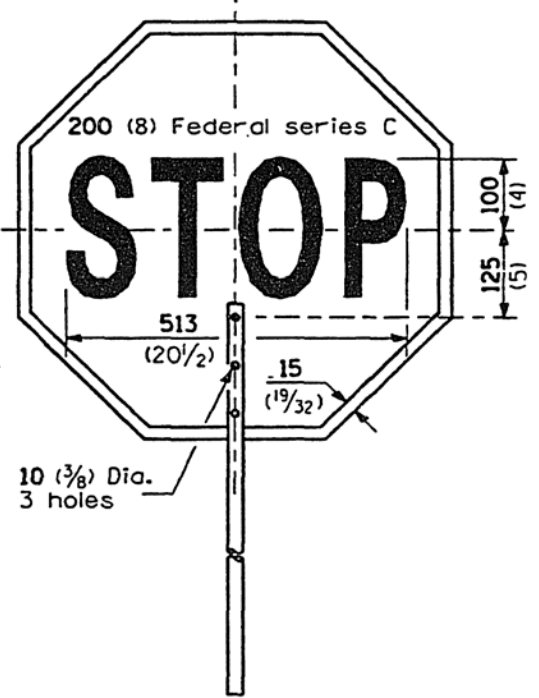


**FRONT SIDE**


**FLAGGER TRAFFIC CONTROL SIGN**

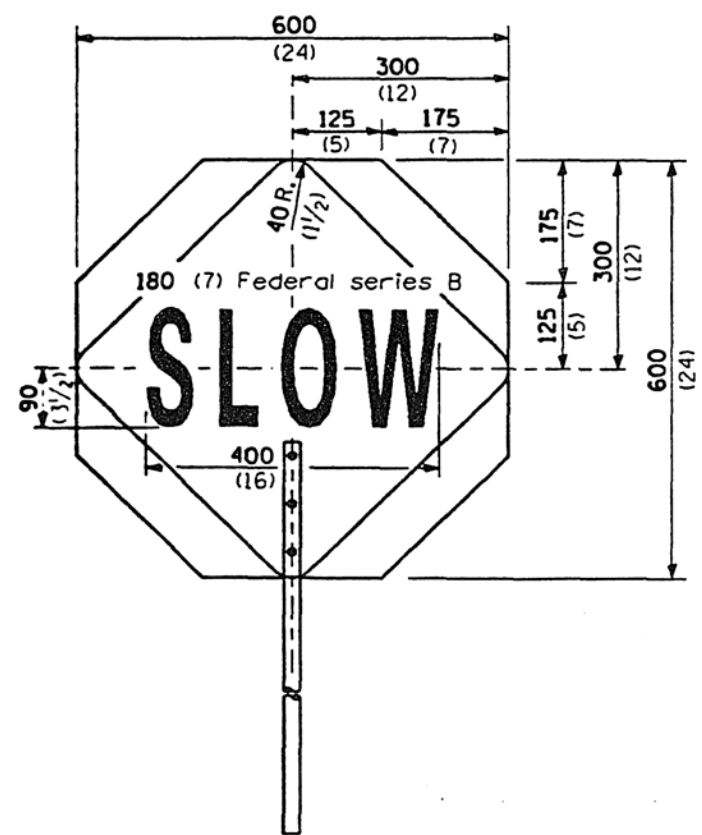


**REVERSE SIDE**

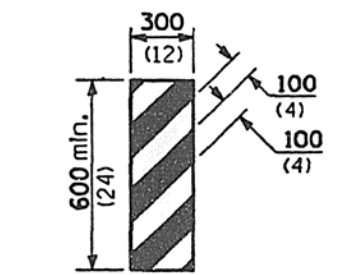


**VERTICAL PANELS**

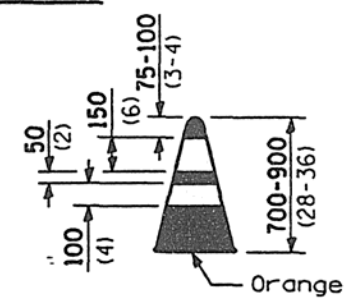


**REFLECTORIZED CONES**

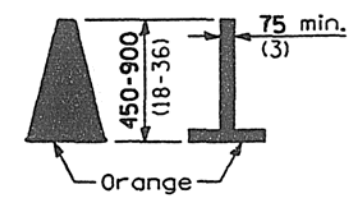

**CONES**

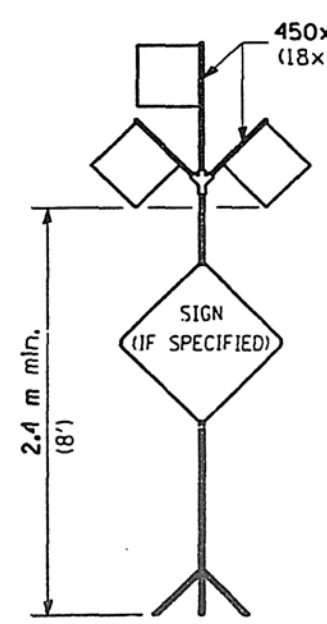

**HIGH LEVEL WARNING DEVICE**

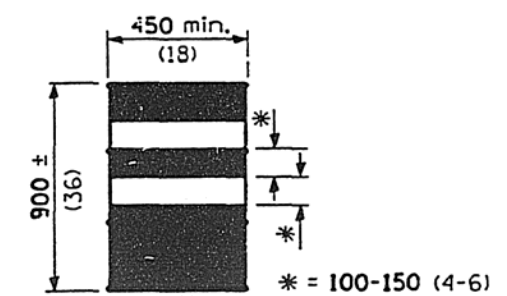

**DRUMS AND SAND MODULE  
IMPACT ATTENUATORS**


All dimensions are in millimeters (inches) unless otherwise shown.

**TRAFFIC CONTROL  
DEVICES**  
(Sheet 3 of 3)  
**STANDARD 702001**

Illinois Department of Transportation  
APPROVED January 1, 1997  
ENGINEER OF OPERATIONS  
APPROVED January 1, 1997  
ENGINEER OF DESIGN AND ENVIRONMENT  
ISSUED 16-1-1





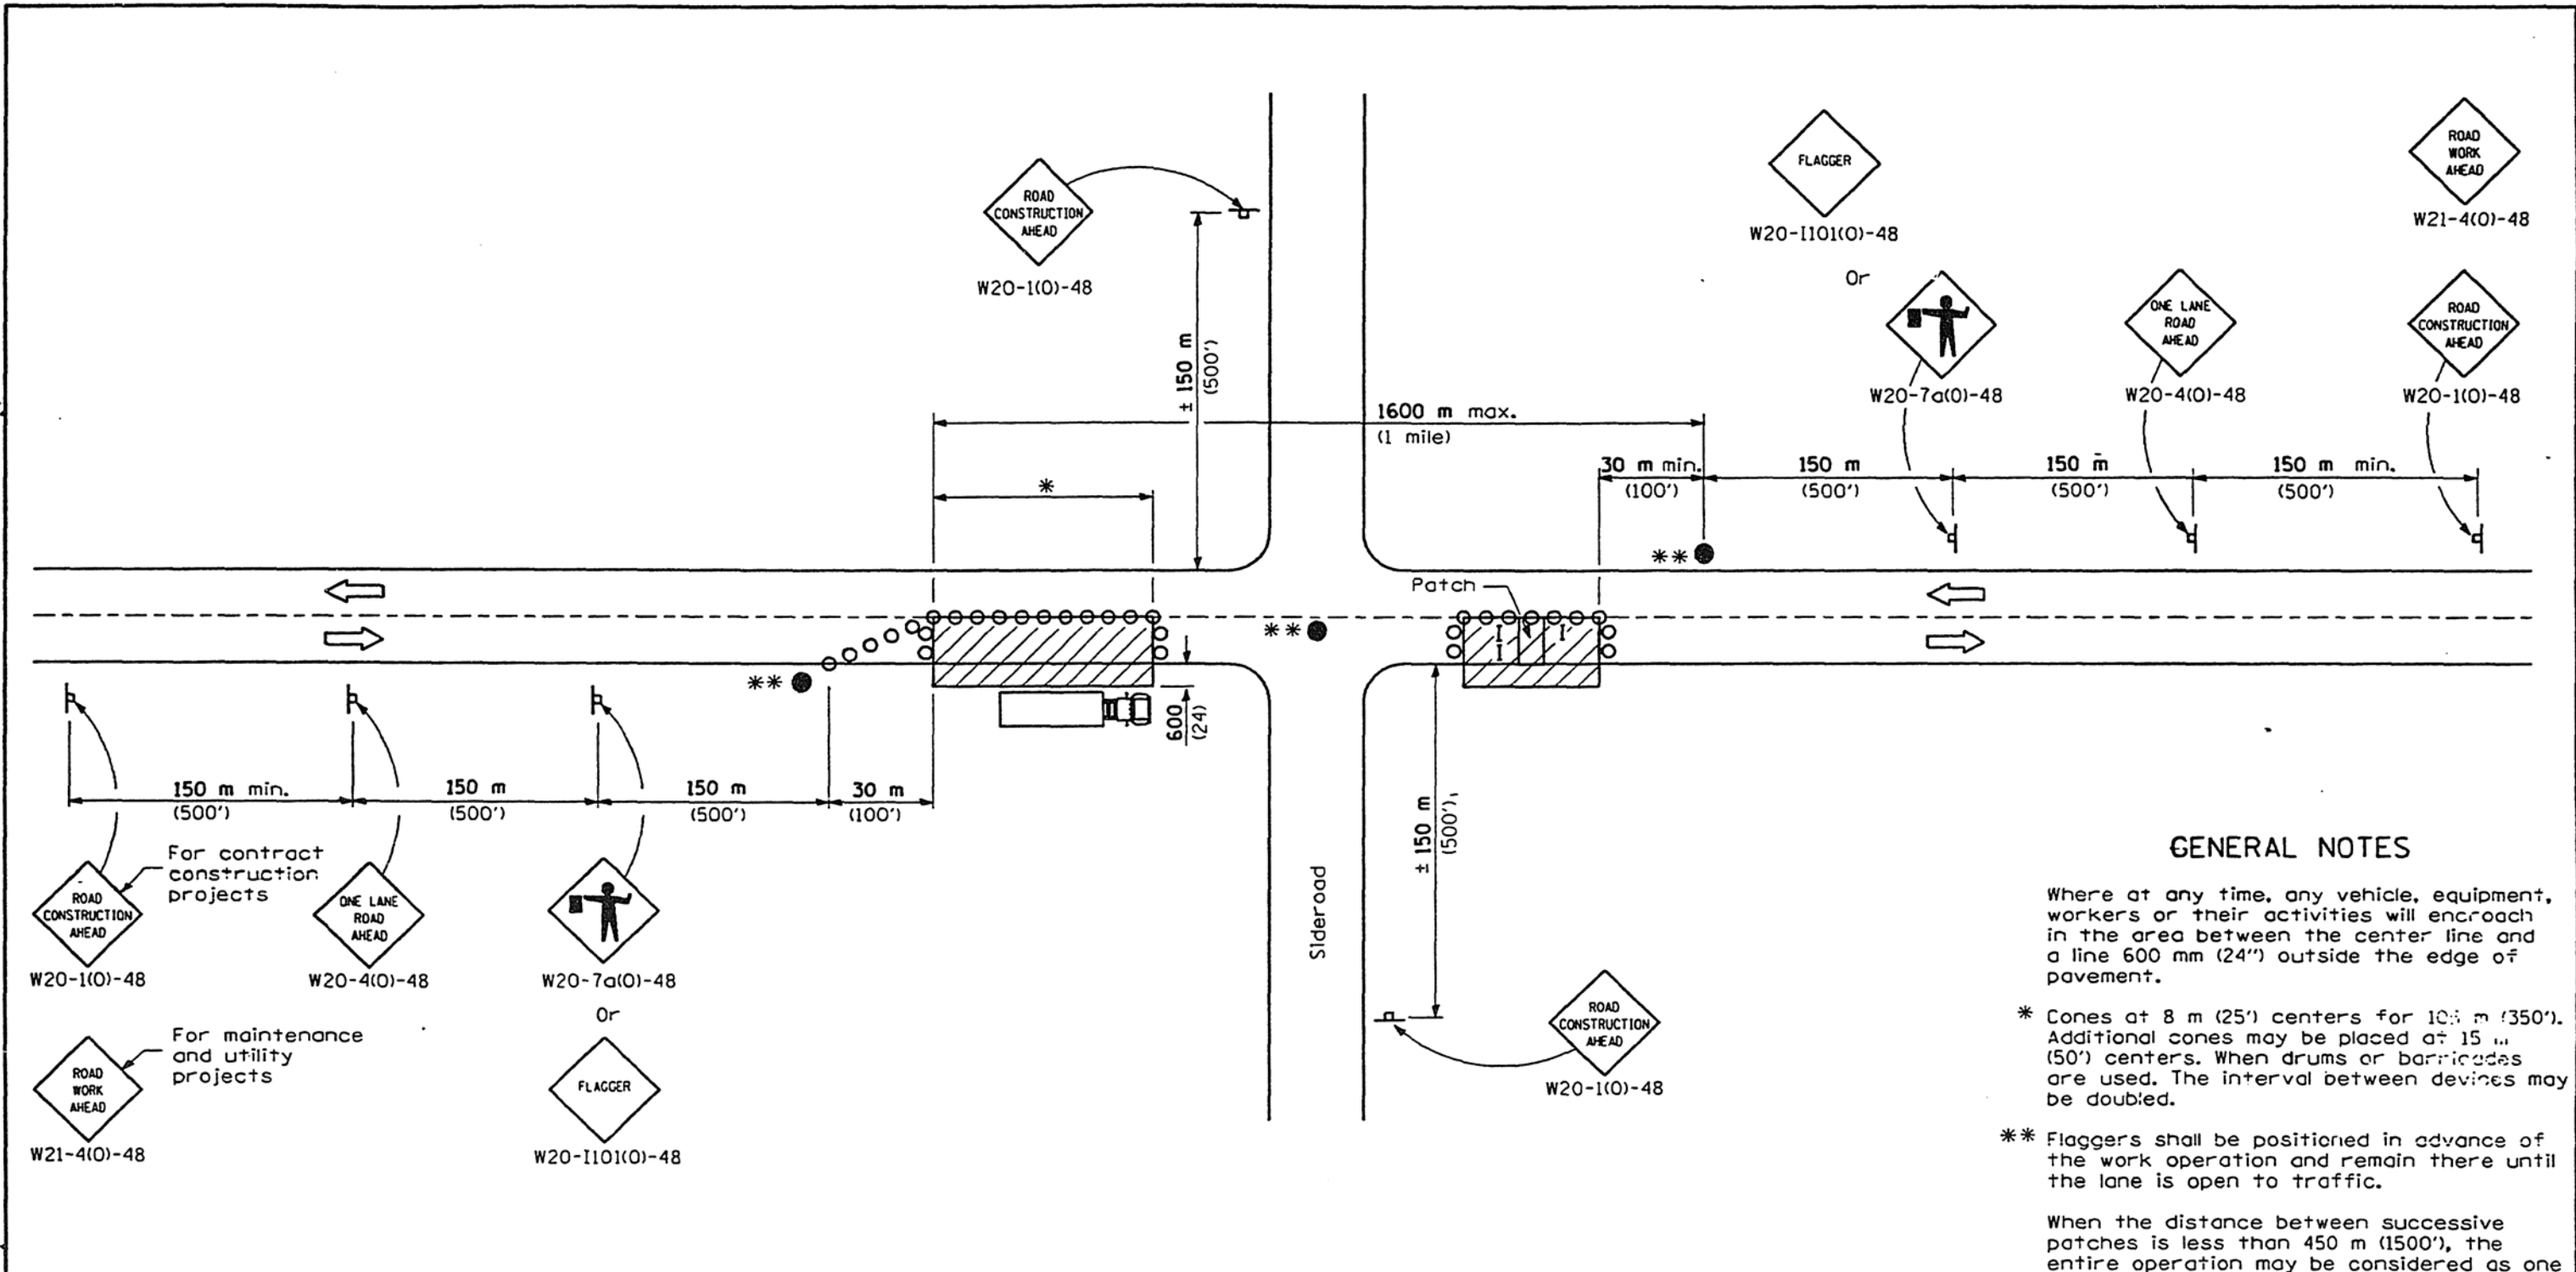

**GENERAL NOTES**

Where at any time, any vehicle, equipment, workers or their activities will encroach in the area between the center line and a line 600 mm (24") outside the edge of pavement.






\* Cones at 8 m (25') centers for 100 m (350'). Additional cones may be placed at 15 m (50') centers. When drums or barricades are used, the interval between devices may be doubled.

\*\* Flaggers shall be positioned in advance of the work operation and remain there until the lane is open to traffic.

When the distance between successive patches is less than 450 m (1500'), the entire operation may be considered as one work area for flagging and signing purposes. When the distance between successive patches exceeds 450 m (1500'), additional warning signs, flaggers, and taper shall be used.

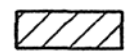All dimensions are in millimeters (inches) unless otherwise shown.

**SYMBOLS**

-  Work area
-  Sign
-  Barricade or drum
-  Cone, drum or barricade
-  Flagger with traffic control sign

**TYPICAL APPLICATIONS**

- Pavement patching
- Utility operations
- Storm sewer
- Culvert
- Cable placement

Illinois Department of Transportation

APPROVED January 1, 1997  
*R. W. James*  
 ENGINEER OF OPERATIONS

APPROVED January 1, 1997  
*Jim Field*  
 ENGINEER OF DESIGN AND ENVIRONMENT




ISSUED 1-1-97

DATE	REVISIONS
1-1-97	Renum. Standard 2303-10.
	Deleted orange flags.
	Revised 2nd GN.
5-1-95	Rev. FLAGGER sign and
	flagger symbols to be
	filled in.

**LANE CLOSURE, 2L, 2W, DAY ONLY  
 ON-RD TO 600 mm (24") OFF-RD  
 FOR SPEEDS ≥ 45 MPH**

**STANDARD 701201**



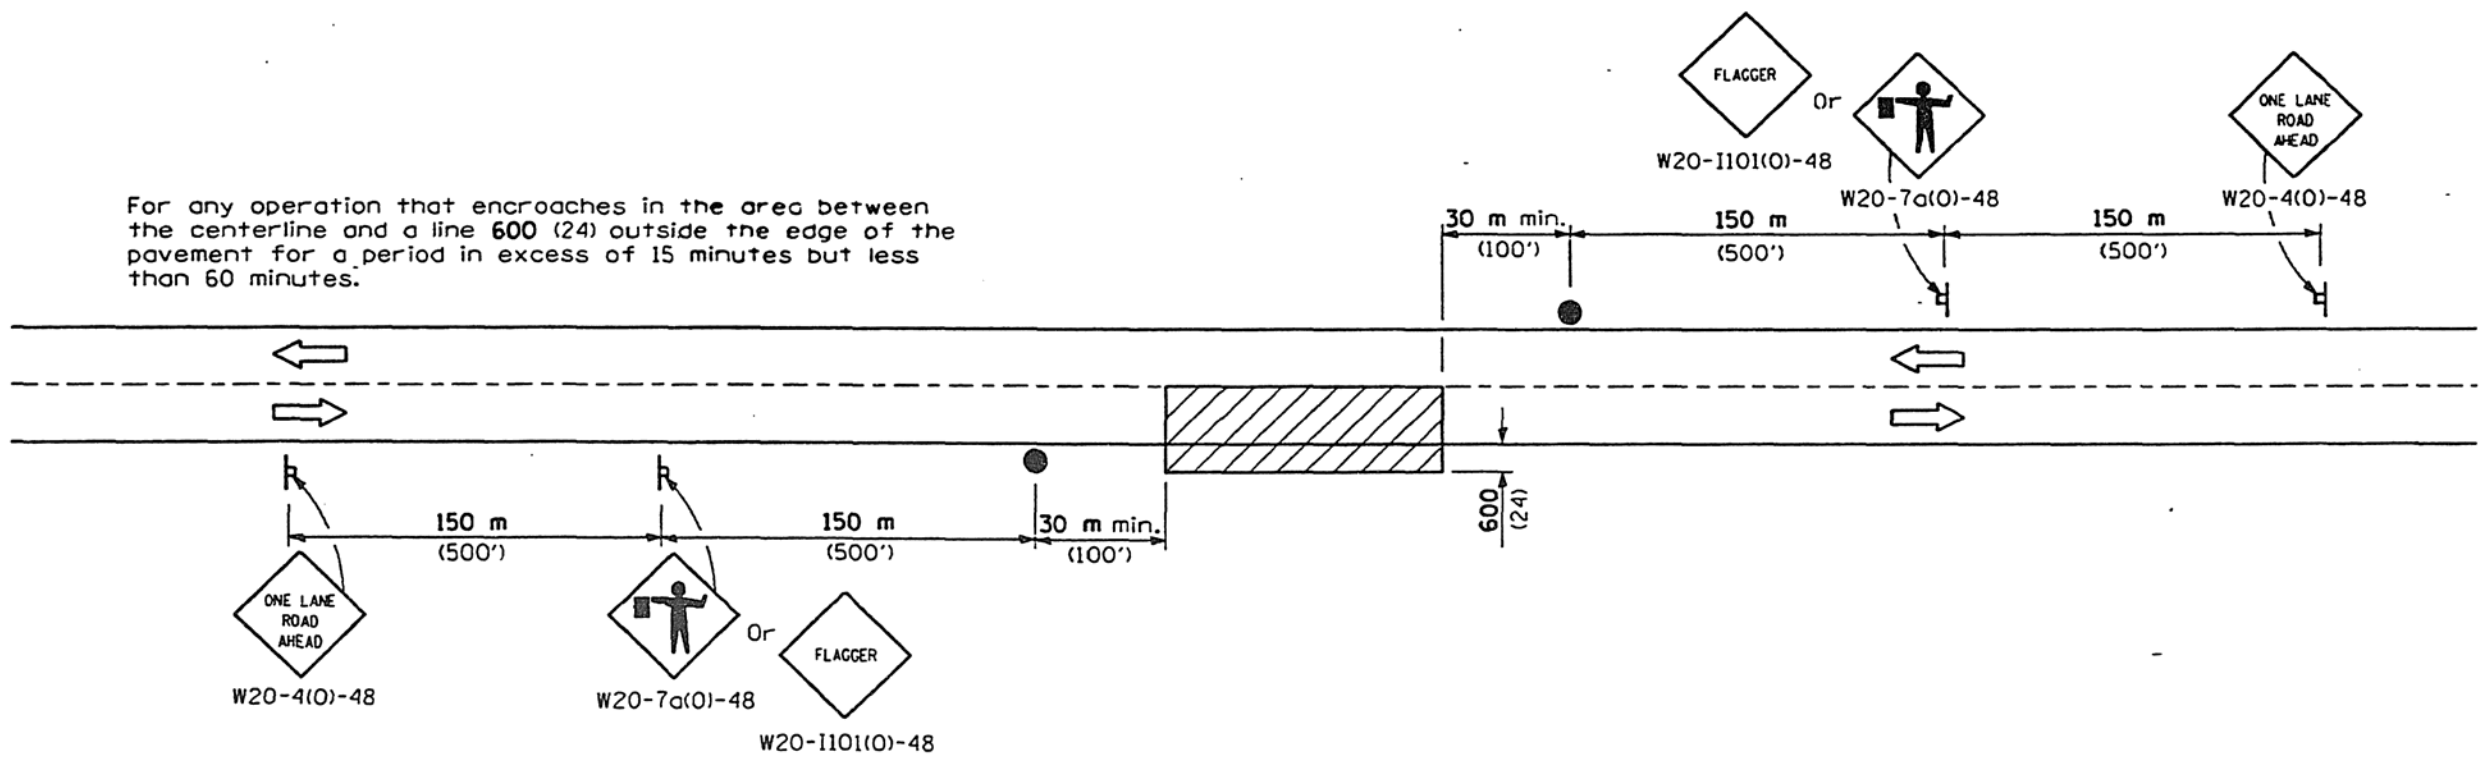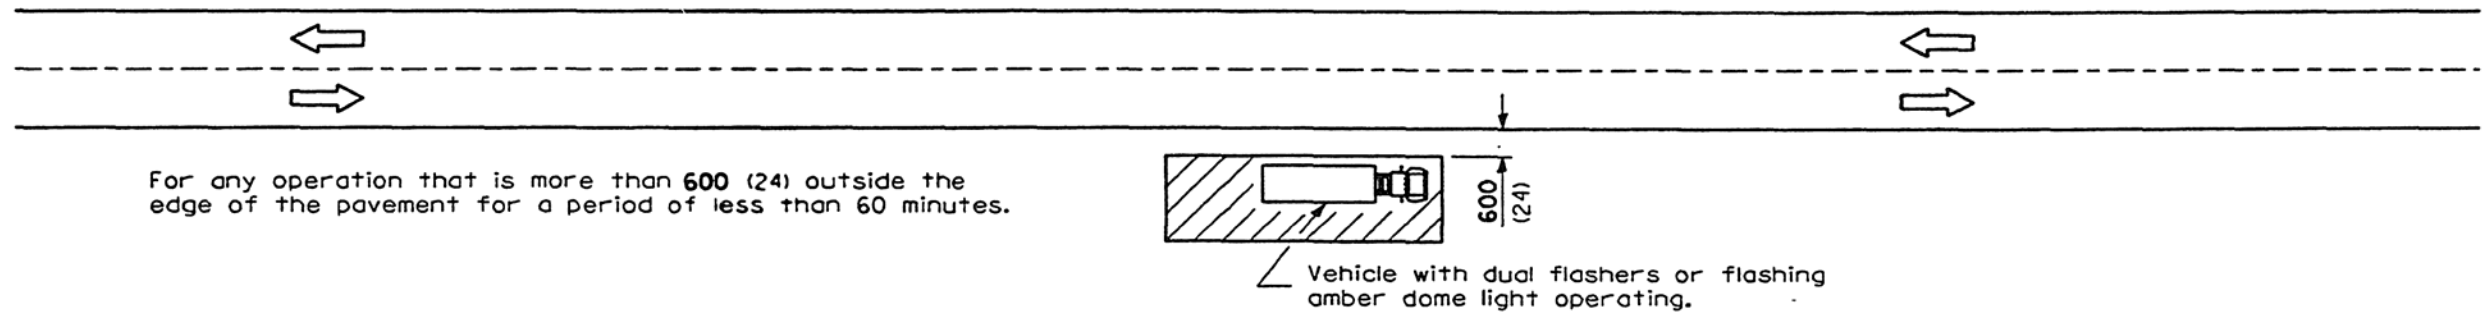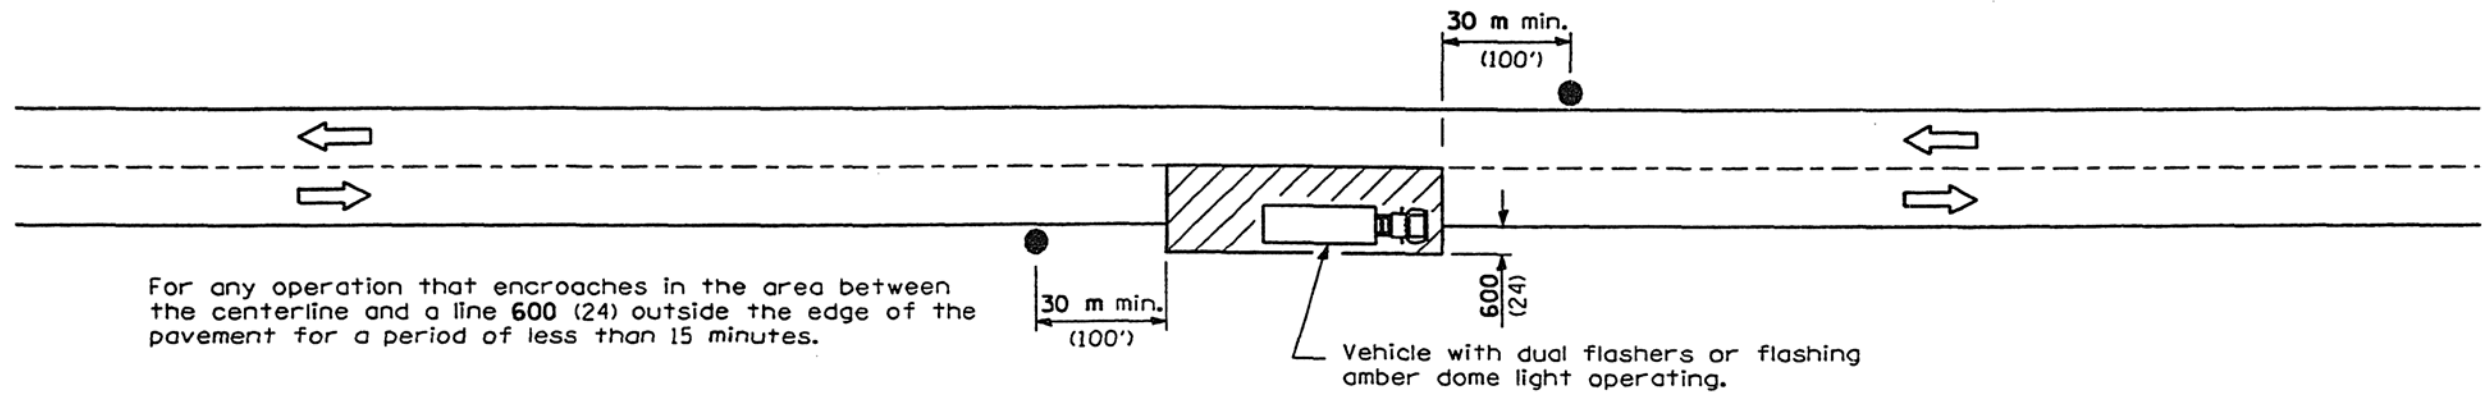

All dimensions are in millimeters (inches) unless otherwise shown.

**TYPICAL APPLICATIONS**

- Marking patches
- Field survey
- String line
- Utility operations
- Cleaning up debris on pavement

**SYMBOLS**

- Work area
- Sign on portable or permanent support
- Flagger with traffic control sign

DATE	REVISIONS
1-1-97	Renum. Standard 2307-10. Deleted orange flag.
5-1-95	Rev. FLAGGER sign and flagger symbols to be filled in.

**LANE CLOSURE 2L, 2W  
SHORT TIME OPERATIONS  
FOR SPEEDS ≥ 45 MPH**


**STANDARD 701301**

Illinois Department of Transportation

APPROVED January 1, 1997  
*R. W. Jones*  
ENGINEER OF OPERATIONS

ISSUED 1-1-97



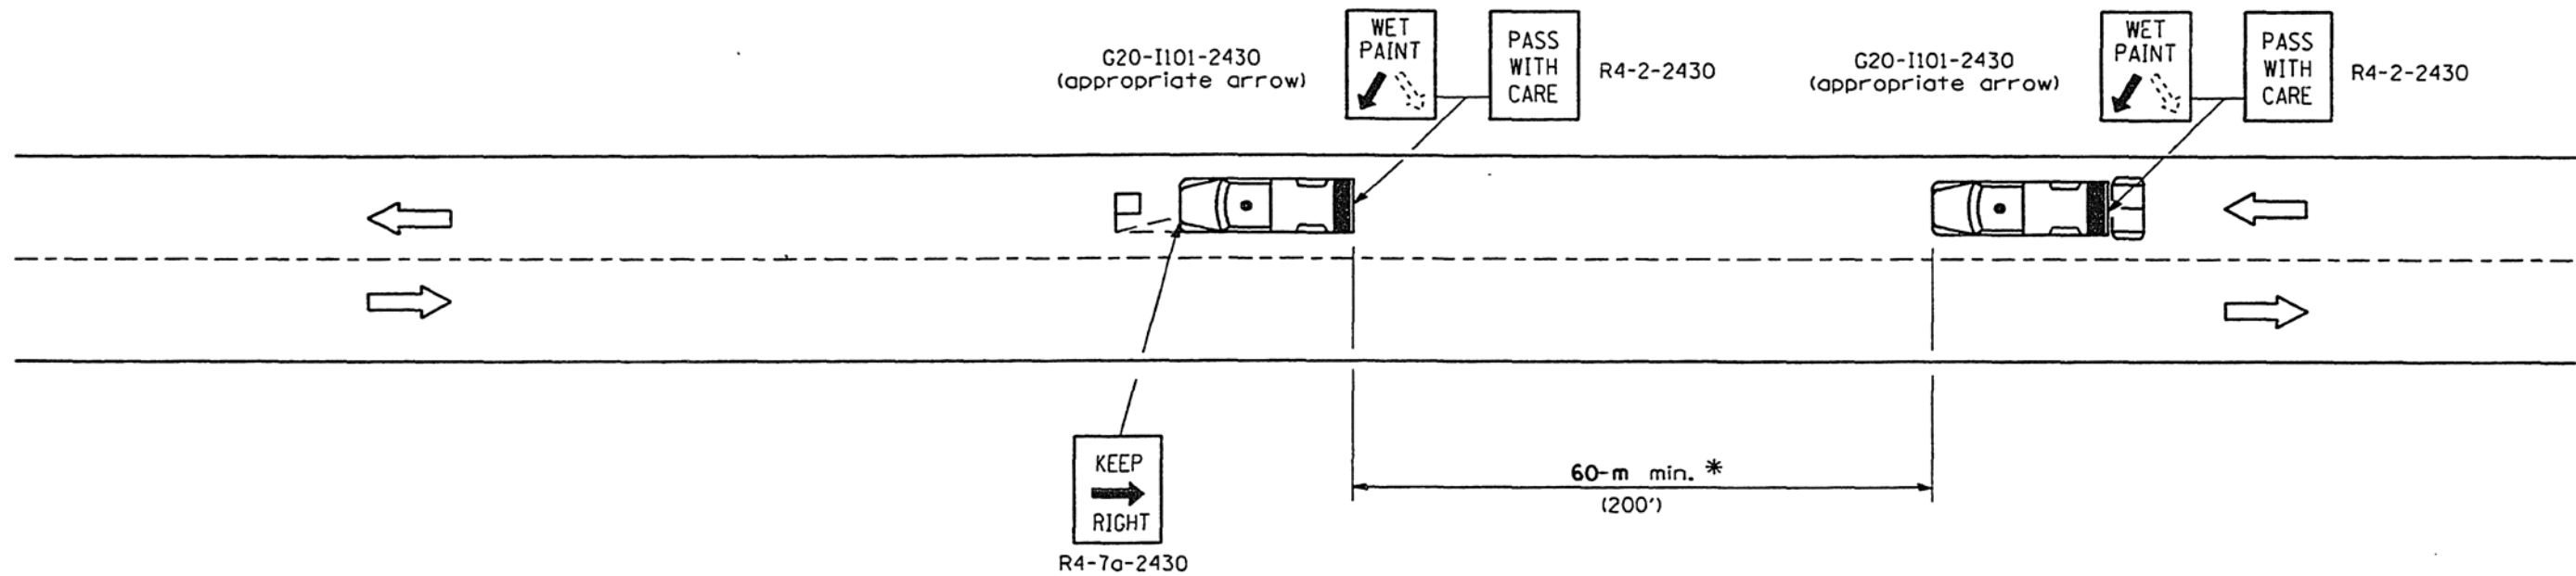

APPROVED January 1, 1997  
*Henry H. H. H.*  
ENGINEER OF DESIGN AND ENVIRONMENT



**TYPICAL APPLICATIONS**

- Landscaping work
- Utility work
- Pavement marking
- Weed spraying
- Roadometer measurements
- Debris cleanup
- Crack pouring

**SYMBOLS**

-  Arrow board (Hazard Mode only)
-  Truck with headlights, emergency flashers and flashing amber light. (visible from all directions)
-  450x450 (18x18) min. orange flag (use when guide wheel is used)
-  Truck mounted attenuator

**GENERAL NOTES**


This Standard is used where any vehicle, equipment, workers or their activities will require a continuous moving operation where the average speed is greater than 5 km/h (3 mph).

\* Distance varies depending on terrain and susceptibility of pavement marking or crack sealant to wheel tracking.


For shoulder operations not encroaching on the pavement, use DETAIL A, Standard 701426.

All dimensions are in millimeters (inches) unless otherwise shown.

Illinois Department of Transportation

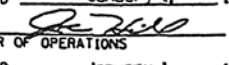APPROVED January 1, 1999  
  
 ENGINEER OF OPERATIONS


ISSUED 1-1-97

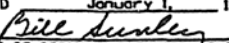APPROVED January 1, 1999  
  
 ENGINEER OF DESIGN AND ENVIRONMENT

DATE	REVISIONS	LANE CLOSURE 2L, 2W MOVING OPERATIONS-DAY ONLY FOR SPEEDS $\geq$ 45 MPH
1-1-99	Removed front truck TMA.	
1-1-97	Renum. Standard 2308-8. Revised text for truck symbol.	<b>STANDARD 701311-01</b>





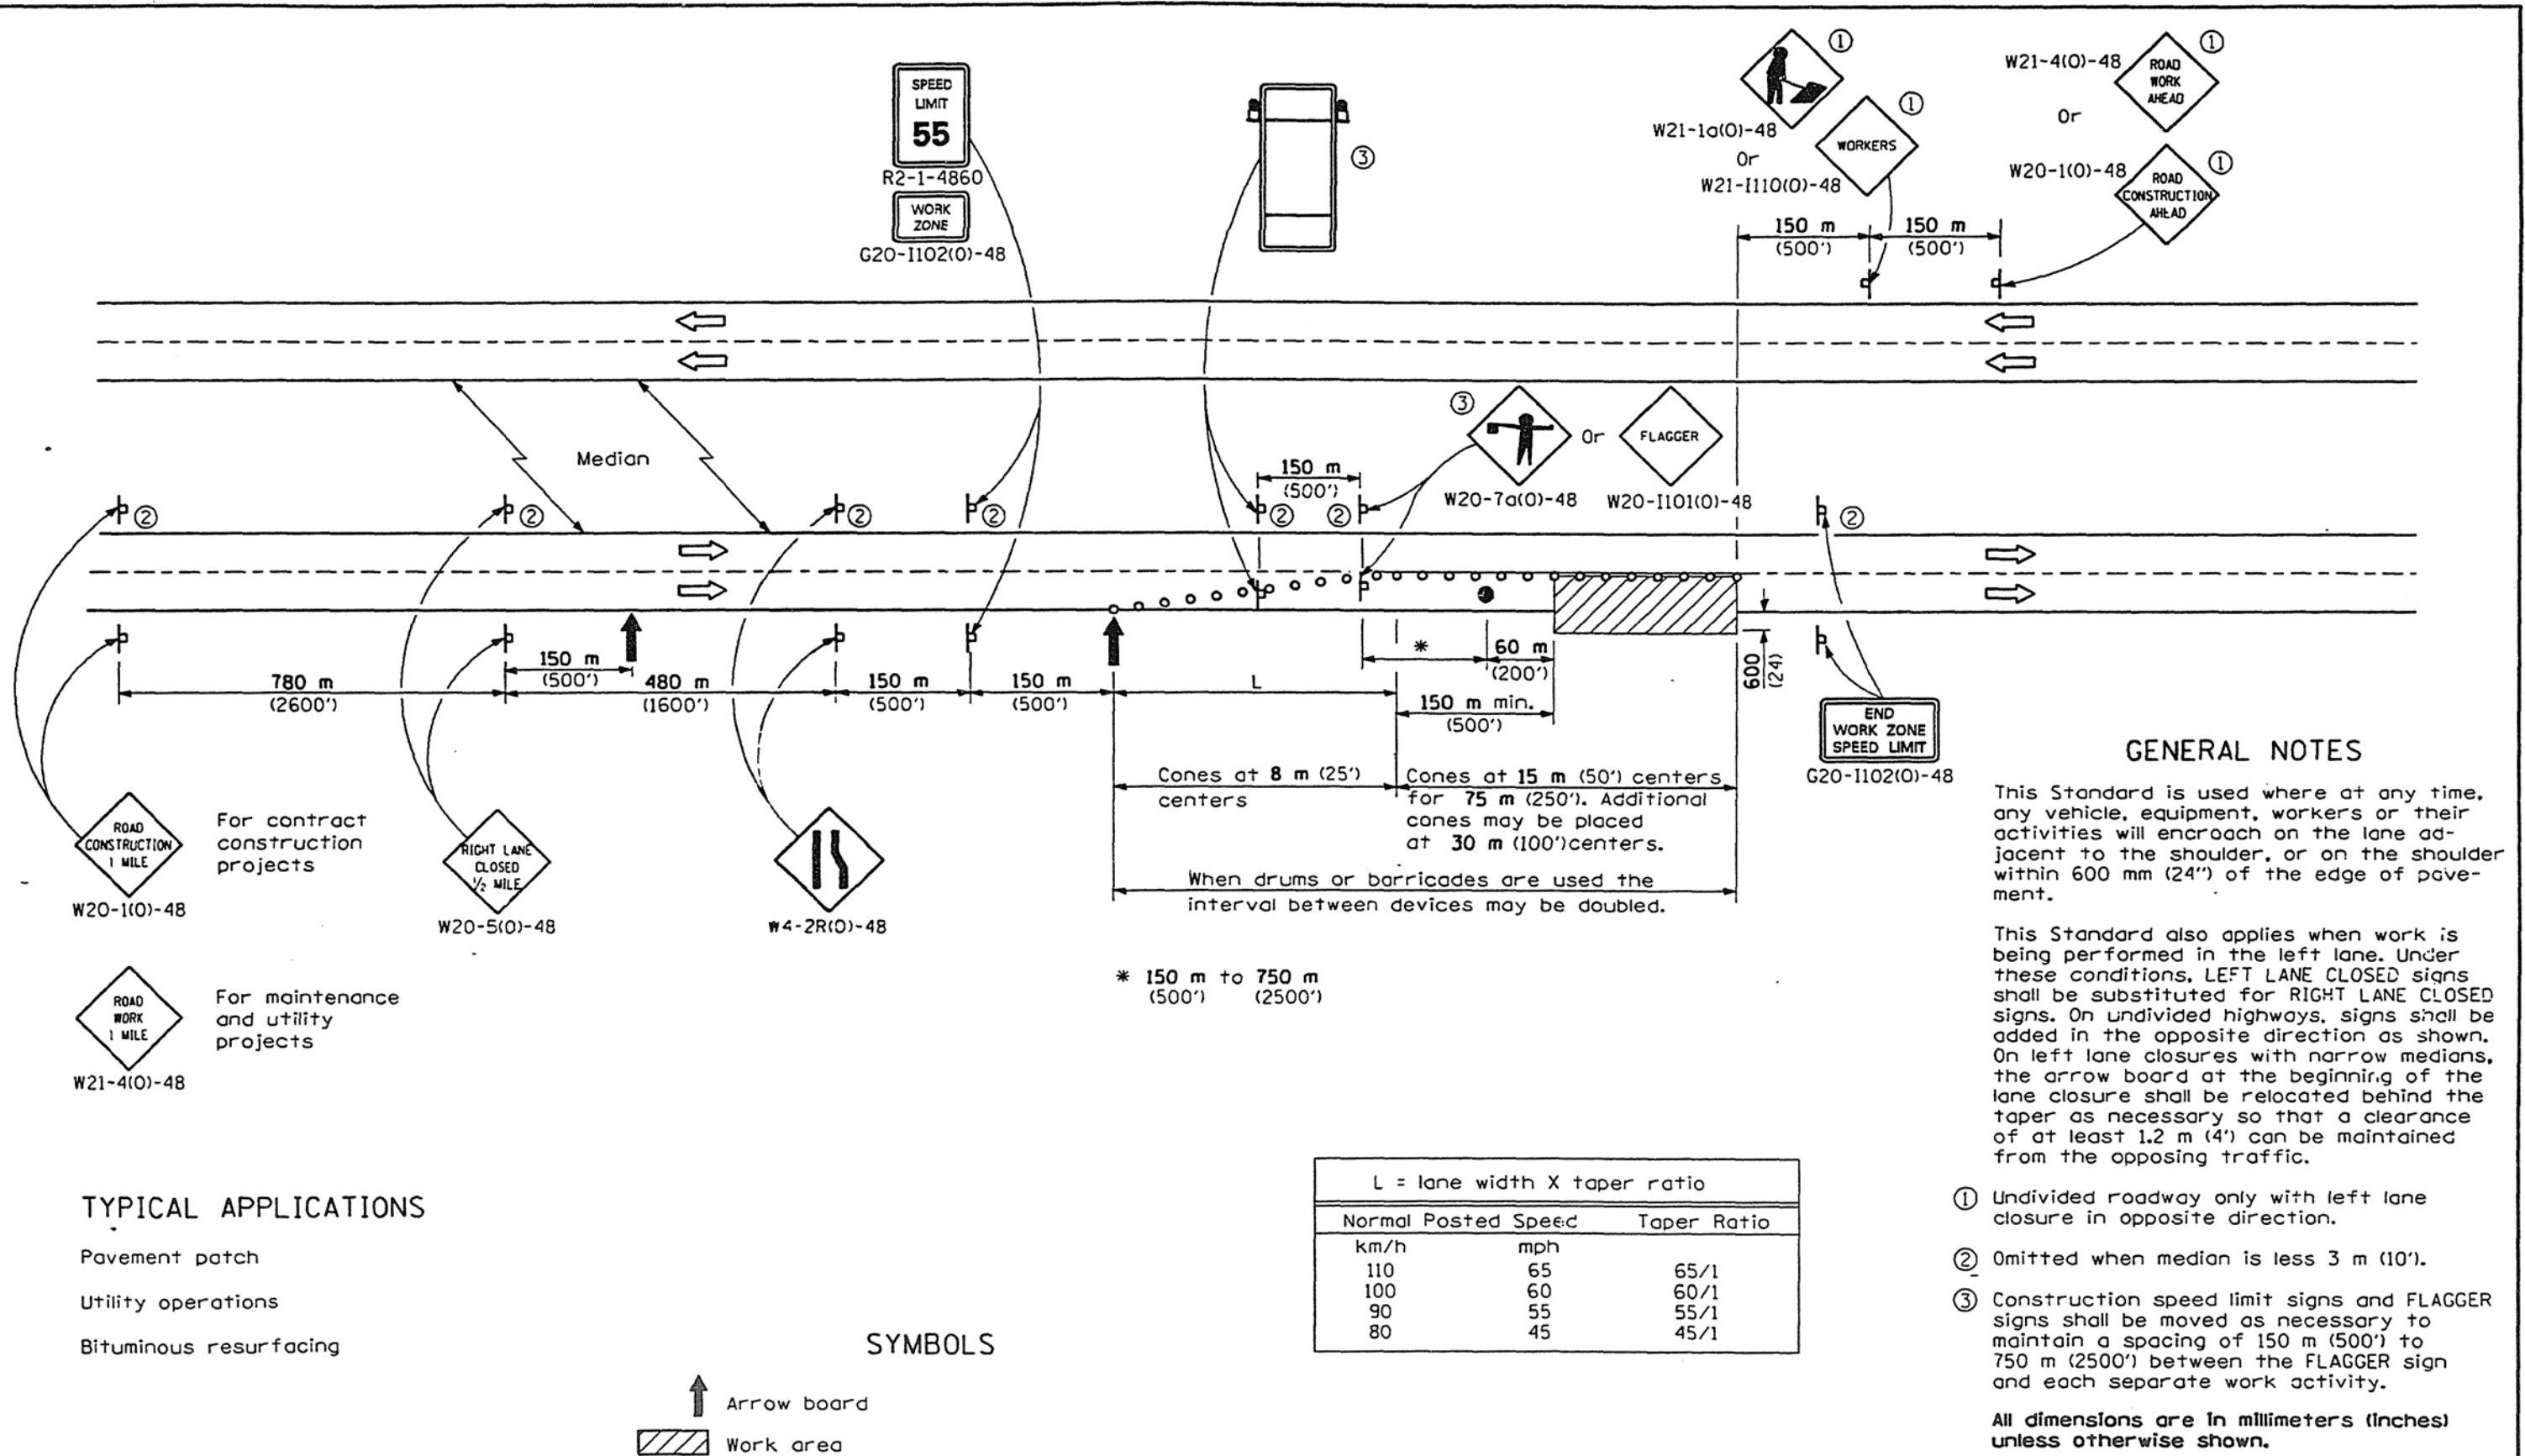

ROAD CONSTRUCTION 1 MILE  
W20-1(0)-48

For contract construction projects

ROAD WORK 1 MILE  
W21-4(0)-48

For maintenance and utility projects

RIGHT LANE CLOSED 1/2 MILE  
W20-5(0)-48

W4-2R(0)-48

**TYPICAL APPLICATIONS**

- Pavement patch
- Utility operations
- Bituminous resurfacing

**SYMBOLS**

- ↑ Arrow board
- ▨ Work area
- ⊥ Sign
- Cone, drum or barricade
- Flagger with traffic control sign
- ☐ Construction speed limit sign

\* 150 m to 750 m (500' to 2500')

L = lane width X taper ratio		
Normal Posted Speed		Taper Ratio
km/h	mph	
110	65	65/1
100	60	60/1
90	55	55/1
80	45	45/1

**GENERAL NOTES**

This Standard is used where at any time, any vehicle, equipment, workers or their activities will encroach on the lane adjacent to the shoulder, or on the shoulder within 600 mm (24") of the edge of pavement.

This Standard also applies when work is being performed in the left lane. Under these conditions, LEFT LANE CLOSED signs shall be substituted for RIGHT LANE CLOSED signs. On undivided highways, signs shall be added in the opposite direction as shown. On left lane closures with narrow medians, the arrow board at the beginning of the lane closure shall be relocated behind the taper as necessary so that a clearance of at least 1.2 m (4') can be maintained from the opposing traffic.

- ① Undivided roadway only with left lane closure in opposite direction.
- ② Omitted when median is less 3 m (10').
- ③ Construction speed limit signs and FLAGGER signs shall be moved as necessary to maintain a spacing of 150 m (500') to 750 m (2500') between the FLAGGER sign and each separate work activity.

All dimensions are in millimeters (inches) unless otherwise shown.

Illinois Department of Transportation

APPROVED January 1, 1999  
ENGINEER OF OPERATIONS  
APPROVED January 1, 1999  
ENGINEER OF DESIGN AND ENVIRONMENT

ISSUED 1-1-97


DATE	REVISIONS
1-1-99	Revised spelling in 2nd paragraph of GN.
1-1-97	Renum Standard 2315-11.
	Del. orange flags. Added GN & dim. for flagger.

**LANE CLOSURE MULTILANE DAY OPERATIONS ONLY FOR SPEEDS ≥ 45 MPH**

**STANDARD 701406-01**






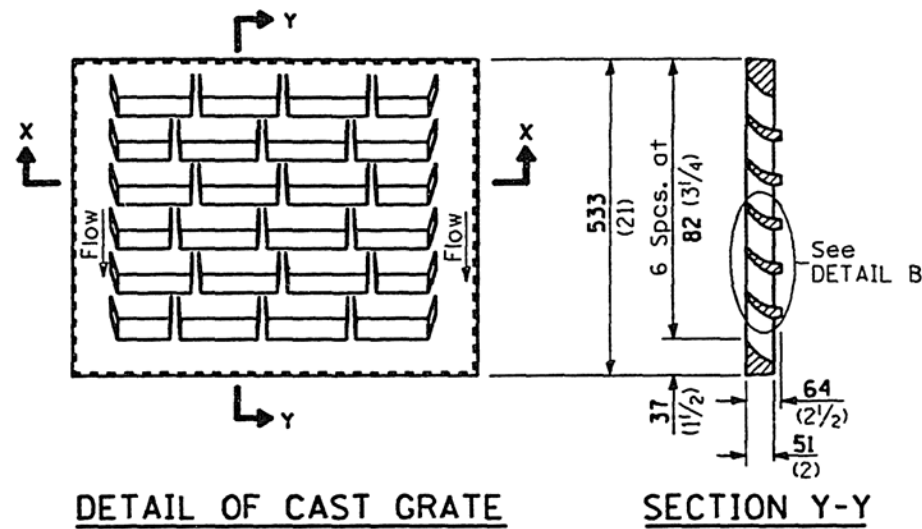


**DETAIL OF CAST GRATE**


Type E requires 2 grates  
Type F requires 3 grates

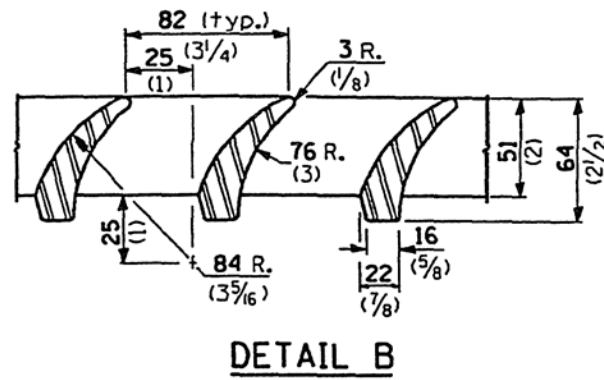


**DETAIL B**

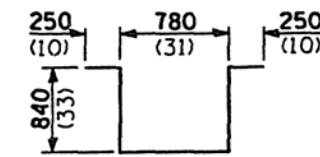

**BAR U**

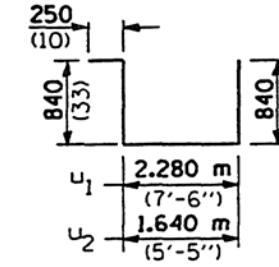

**BARS U<sub>1</sub>, U<sub>2</sub>**

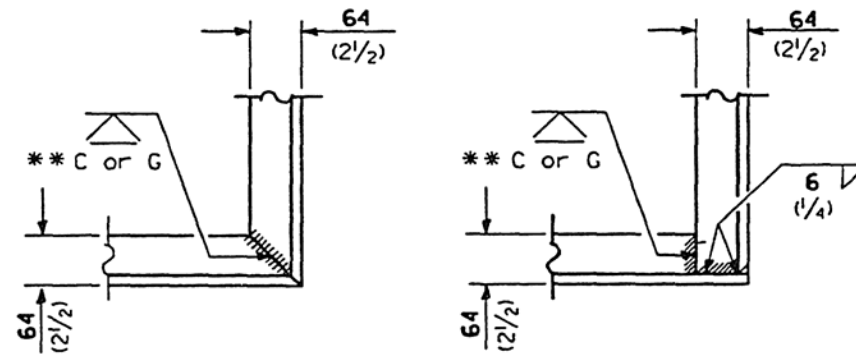


**ALT. 1**

**ALT. 2**


**TYPICAL CORNER of STEEL GRATING FRAME**

\*\* Cut or Grind flush

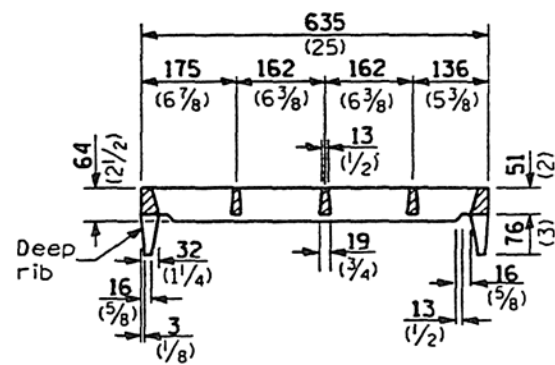


**SECTION X-X**

(Deep rib shall be omitted for end(s) resting on frame perimeter)

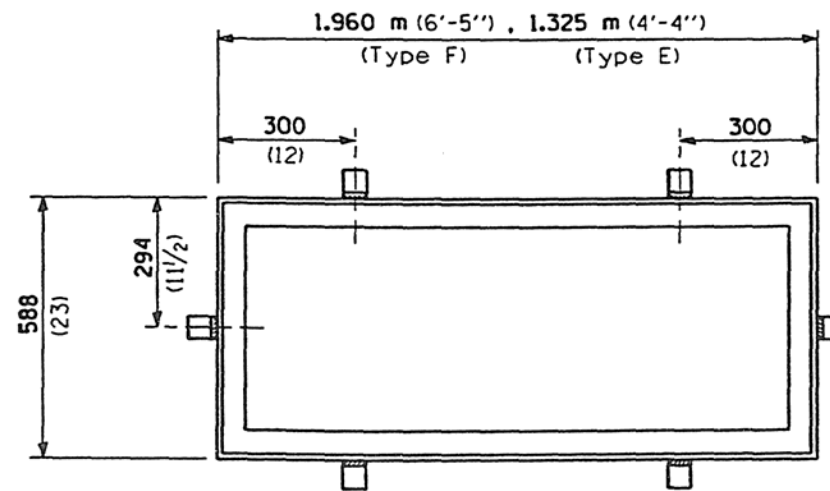

**DETAIL OF STEEL FRAME**

Cast frame to have same basic dimensions.

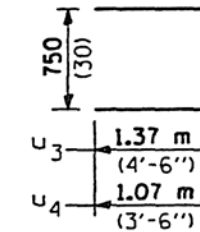

**Bars U<sub>3</sub>, U<sub>4</sub>**

**INLET BOX**

REQUIRED MATERIAL			
TYPE F			
Bar	Qty.	Size	Length
u	8	No. 15 (No. 4)	2.96 m (9'-9")
u <sub>1</sub>	3	No. 15 (No. 4)	4.21 m (13'-10")
u <sub>3</sub>	6	No. 15 (No. 4)	3.49 m (11'-6")
Concrete	m <sup>3</sup> (cu. yds.)		1.3 (1.7)
Reinf. bars	kg (lbs.)		89.9 (126)
Grating	m <sup>2</sup> (sq. ft.)		1.02 (10.9)
TYPE E			
Bar	Qty.	Size	Length
u	6	No. 15 (No. 4)	2.96 m (9'-9")
u <sub>2</sub>	3	No. 15 (No. 4)	3.57 m (11'-9")
u <sub>4</sub>	6	No. 15 (No. 4)	2.89 m (9'-6")
Concrete	m <sup>3</sup> (cu. yds.)		1.0 (1.3)
Reinf. bars	kg (lbs.)		71.9 (101)
Grating	m <sup>2</sup> (sq. ft.)		0.68 (7.3)

All dimensions are in millimeters (inches) unless otherwise shown.

**SHOULDER INLET WITH CURB**

(Sheet 2 of 2)

**STANDARD 610001-01**

Illinois Department of Transportation

PASSED January 1, 1998





ENGINEER OF POLICY AND PROCEDURES

APPROVED January 1, 1998

ENGINEER OF DESIGN AND ENVIRONMENT

ISSUED 16-1-1-97



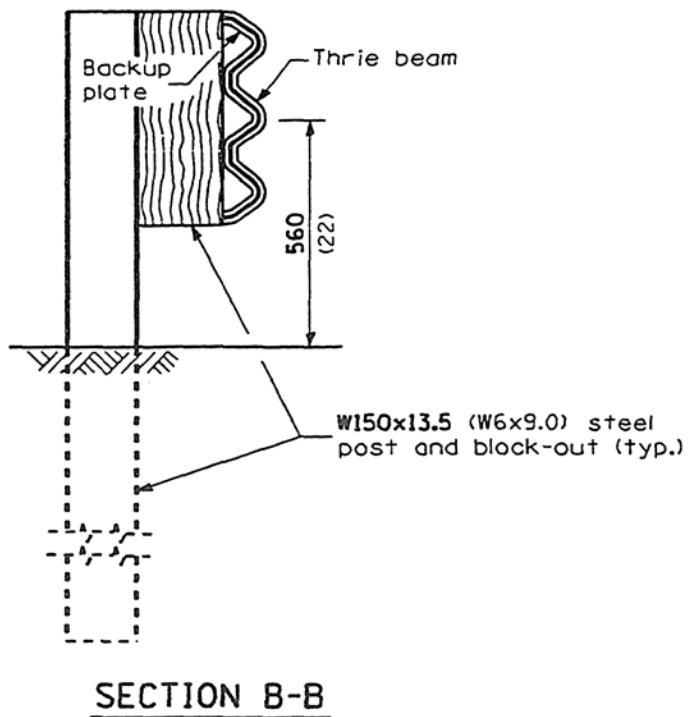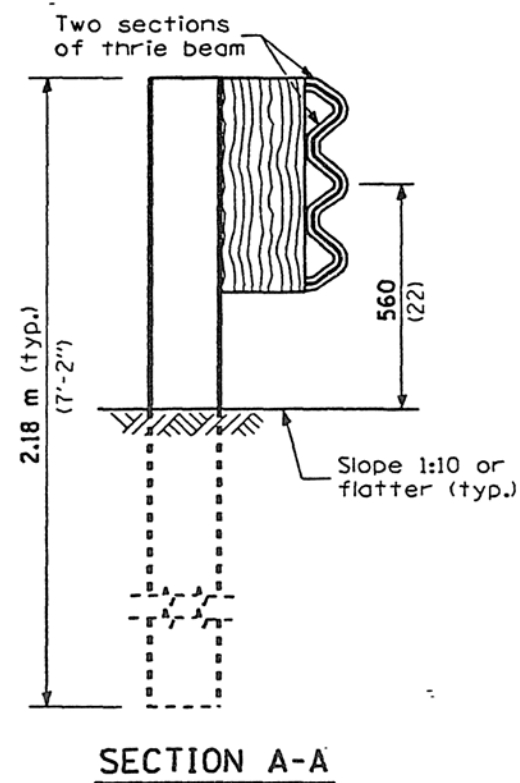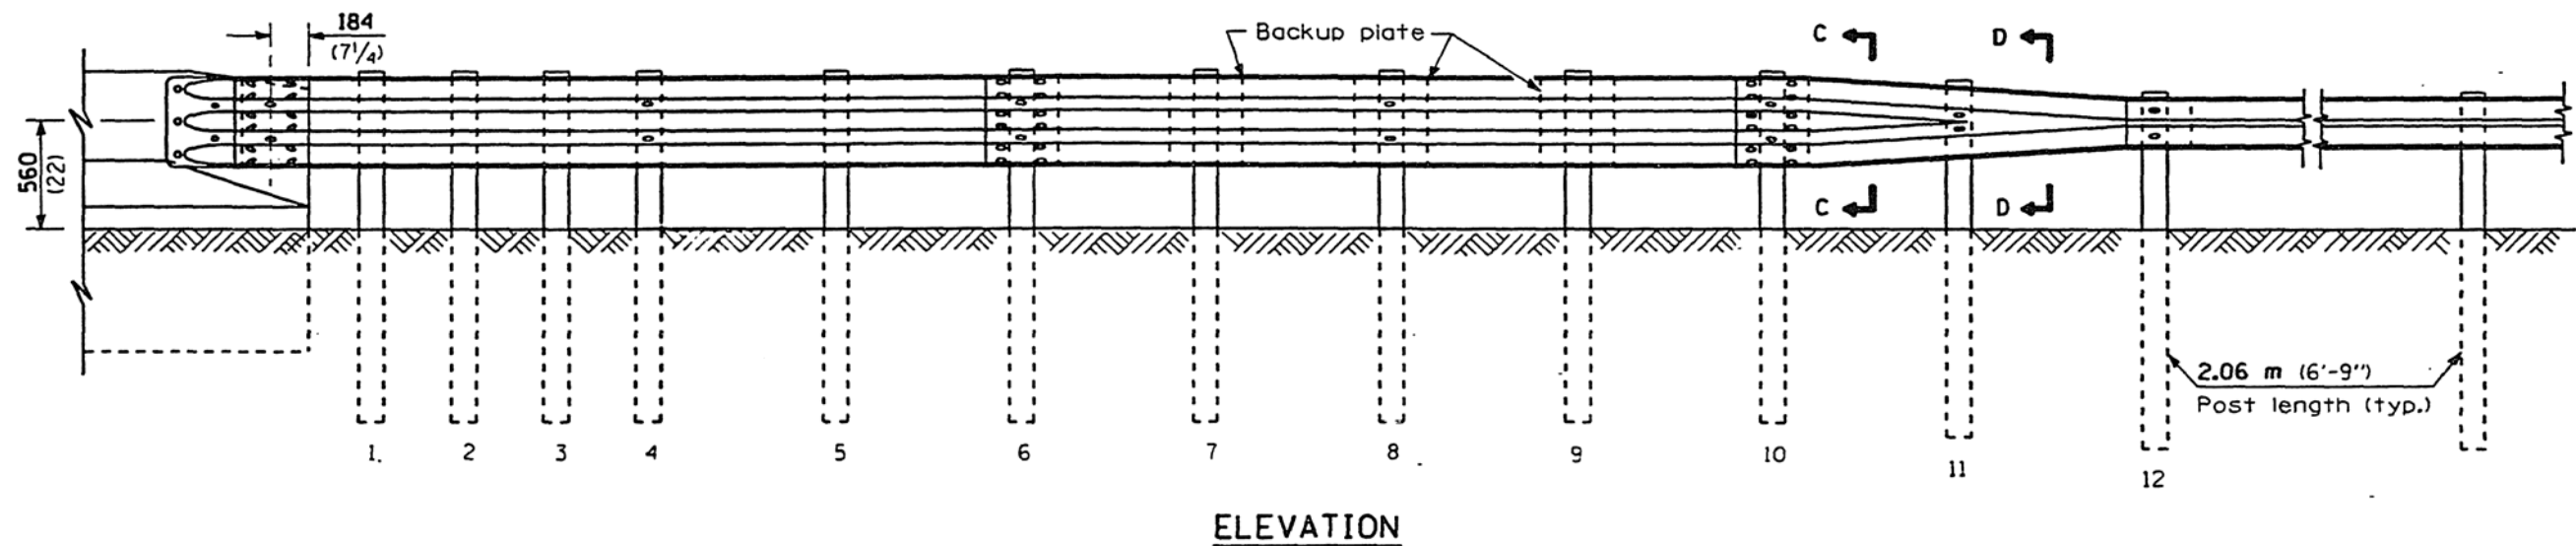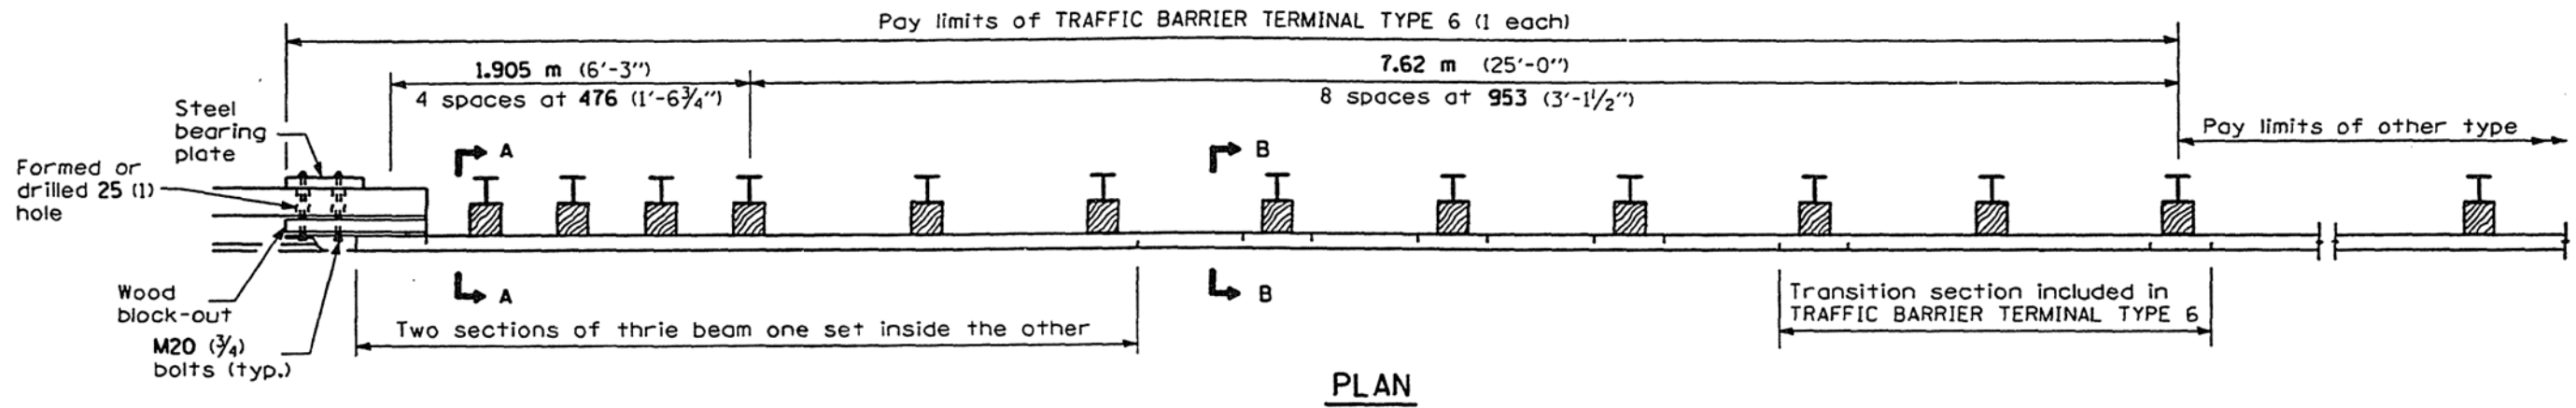

**GENERAL NOTES**

See Standard 630001 for details of guardrail not shown.

Thrie beam rail shall be bolted to block-out at posts 4, 6, 8 and 10.

Back-up plate shall be bolted to block-out only at posts 7 and 9.

All slope ratios are expressed as units of vertical displacement to units of horizontal displacement (V:H).

All dimensions are in millimeters (inches) unless otherwise shown.

DATE	REVISIONS
10-1-98	Revised to wooden block-out.
1-1-97	Renum. Standard 2341-10.

**TRAFFIC BARRIER TERMINAL TYPE 6**

(Sheet 1 of 2)


**STANDARD 631031-01**

Illinois Department of Transportation


PASSED October 1, 1998  
*Charles Kelly*  
ENGINEER OF POLICY AND PROCEDURES

APPROVED October 1, 1998  
*Bill Swales*  
ENGINEER OF DESIGN AND ENVIRONMENT


ISSUED 1-1-97

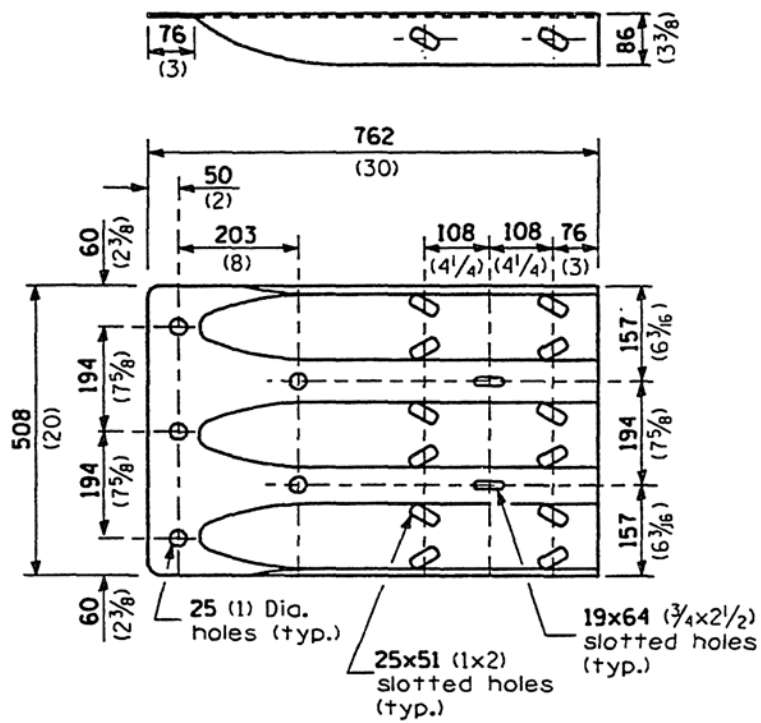


THRIE BEAM END SHOE

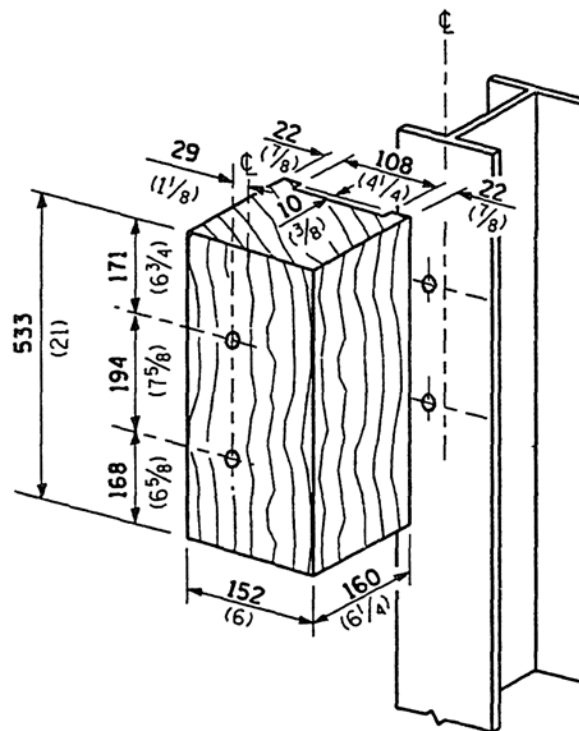


SECTION C-C

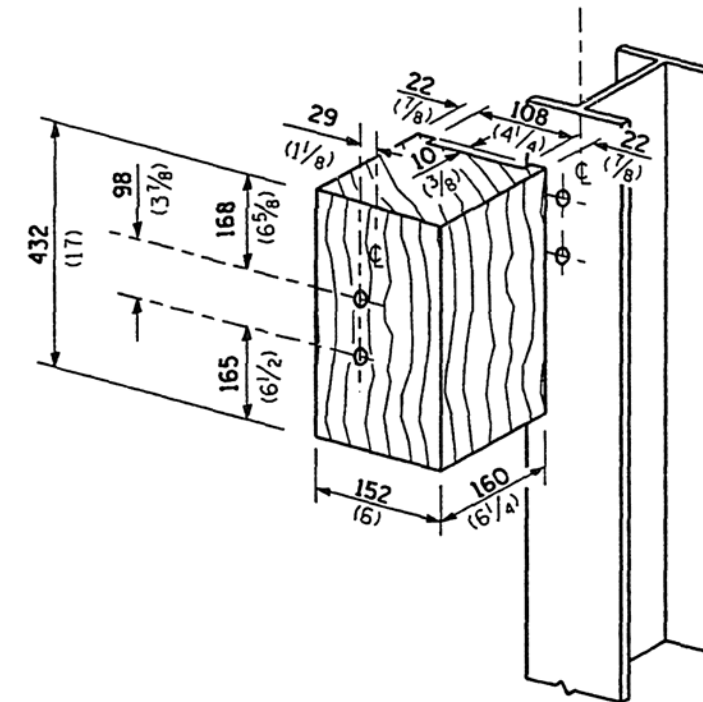


SECTION D-D

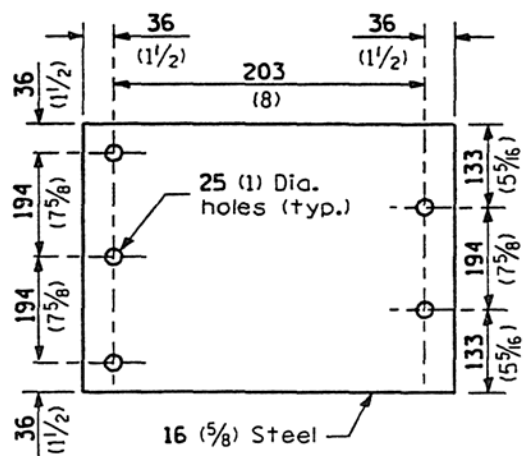

STEEL BEARING PLATE

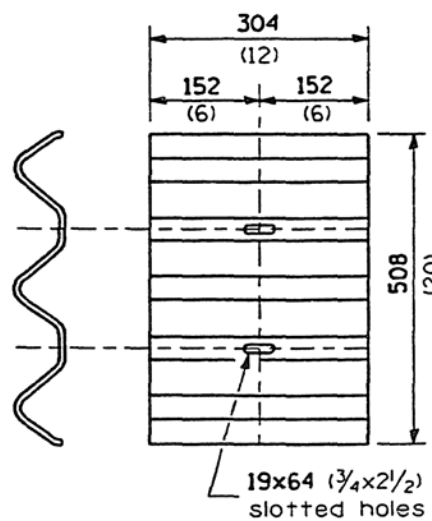

BACK UP PLATE

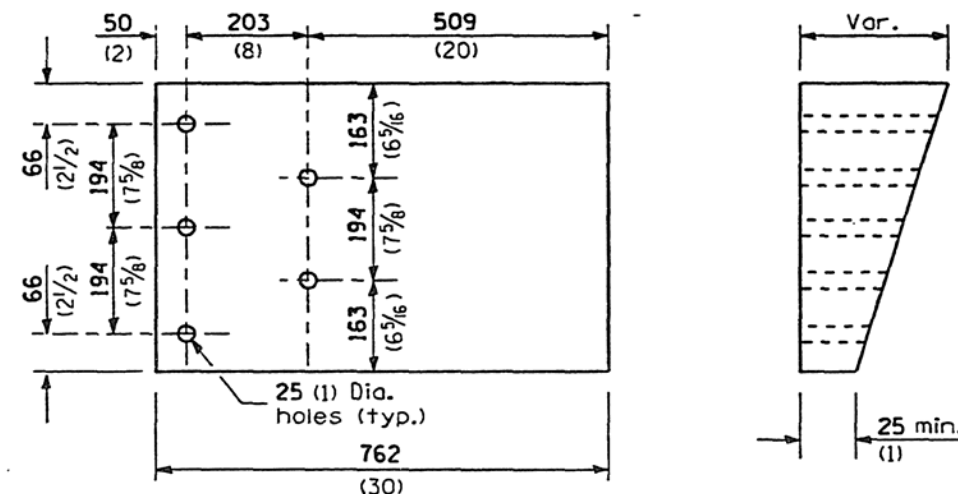

WOOD BLOCK-OUT

All dimensions are in millimeters (inches) unless otherwise shown.

Illinois Department of Transportation

PASSED October 1, 1998  
*Charles Kallfleck*  
 ENGINEER OF POLICY AND PROCEDURES

APPROVED October 1, 1998  
*Bill Swales*  
 ENGINEER OF DESIGN AND ENVIRONMENT



16-1-1 030551

TRAFFIC BARRIER  
 TERMINAL TYPE 6



(Sheet 2 of 2)

STANDARD 631031-01





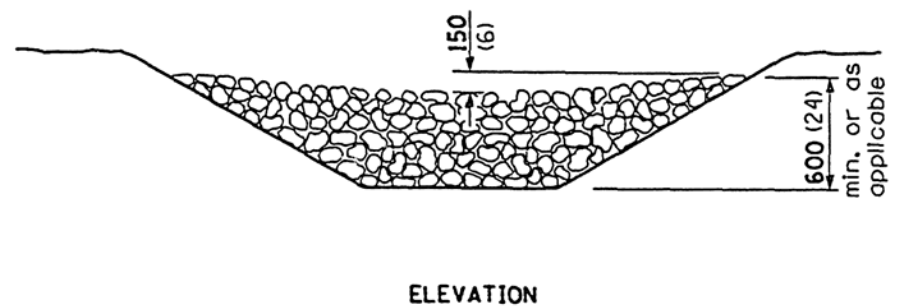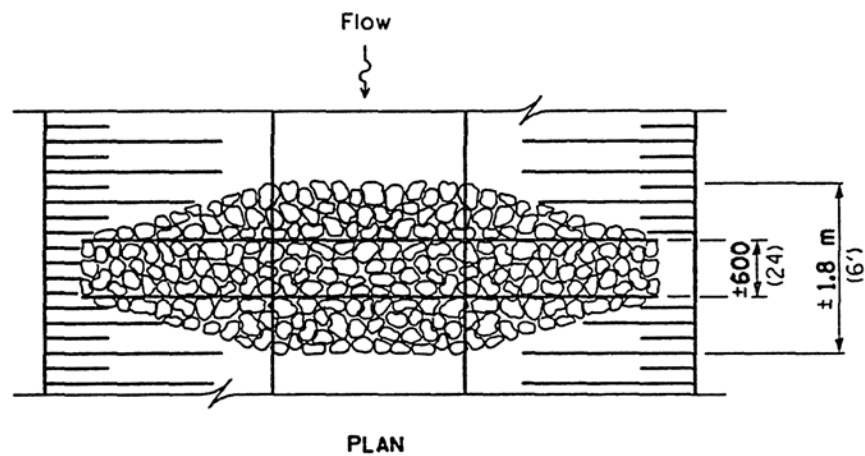

**AGGREGATE DITCH CHECK**

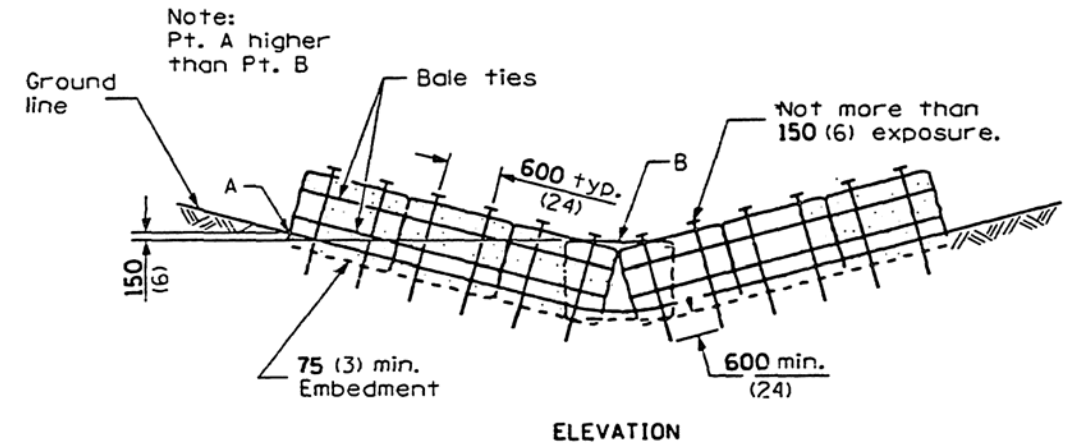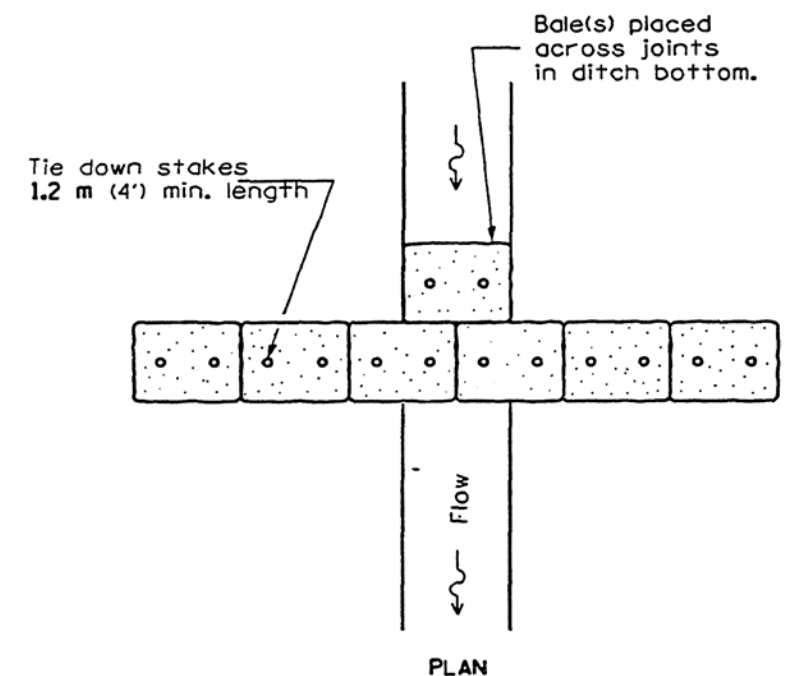

**ROLLED EXCELSIOR OR STRAW BALES FOR DITCH CHECK**

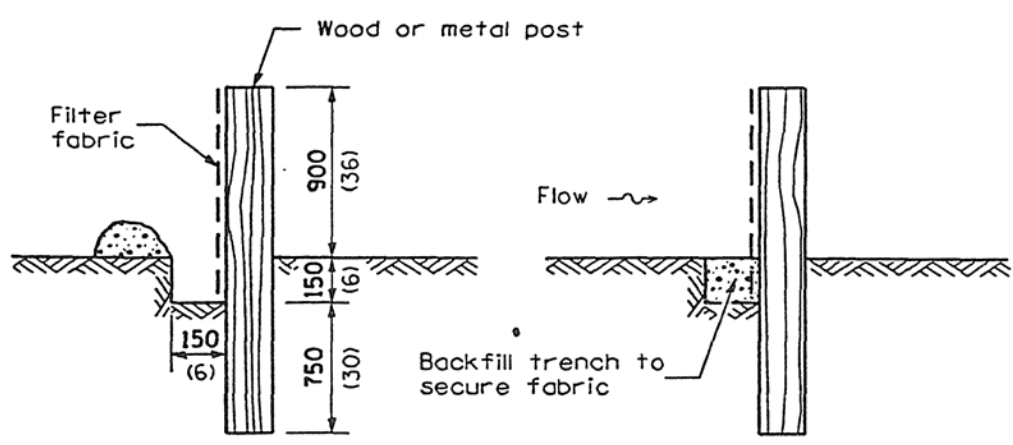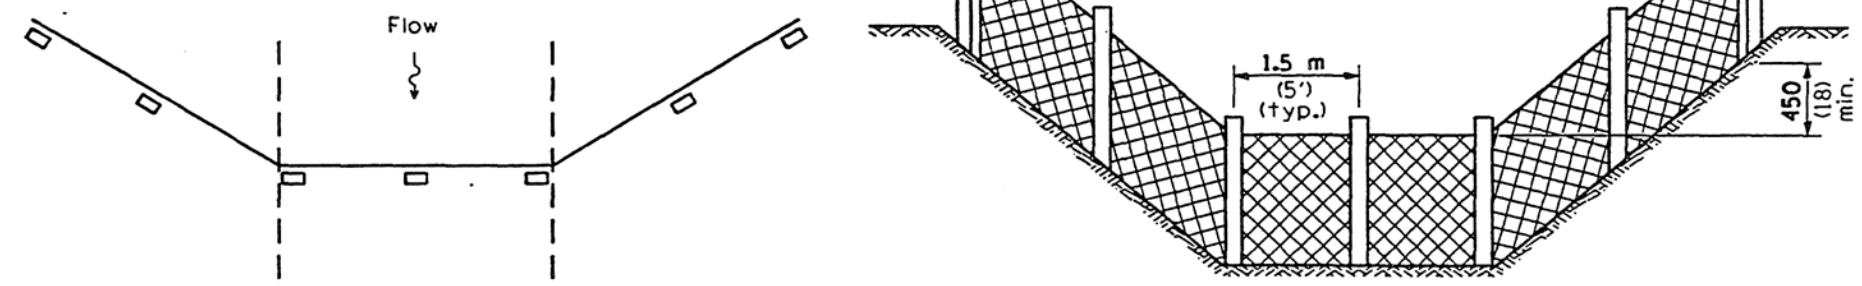

**SILT FILTER FENCE DITCH CHECK**

**GENERAL NOTES**

The dimensions and installation methods for ditch checks shall be the same for perimeter erosion barriers and inlet and outlet protection unless otherwise specified.

All dimensions are in millimeters (inches) unless otherwise shown.

Illinois Department of Transportation

PASSED January 1, 1999  
*Charles Kallflein*  
 ENGINEER OF POLICY AND PROCEDURES





APPROVED January 1, 1999  
*Bill Swales*  
 ENGINEER OF DESIGN AND ENVIRONMENT

ISSUED 26-1-1 03/99


DATE	REVISIONS
1-1-99	Clar. ditch check dimen.
	Rev. filter fence sym. & inlet & pipe prot. detail.
1-1-97	Renum. Standard 2381-2.
	Deleted DN Symbol. Decr. length of filter fabric.

**TEMPORARY EROSION CONTROL SYSTEMS**  
 (Sheet 1 of 2)

**STANDARD 280001-01**

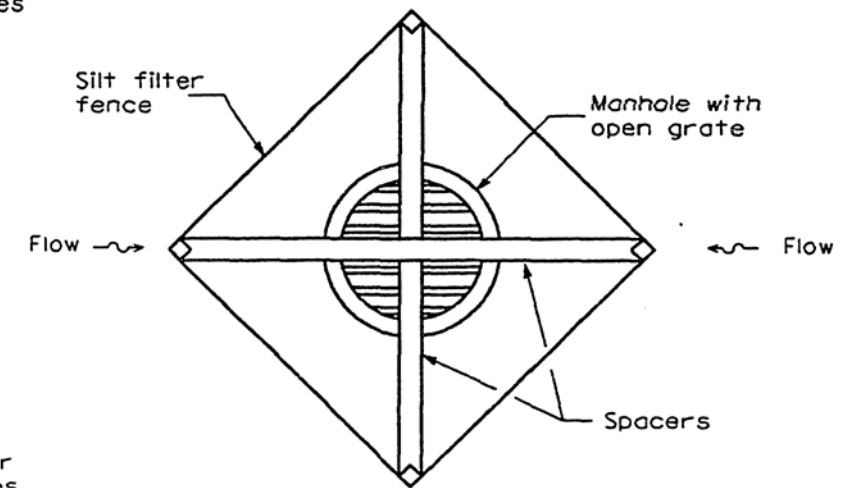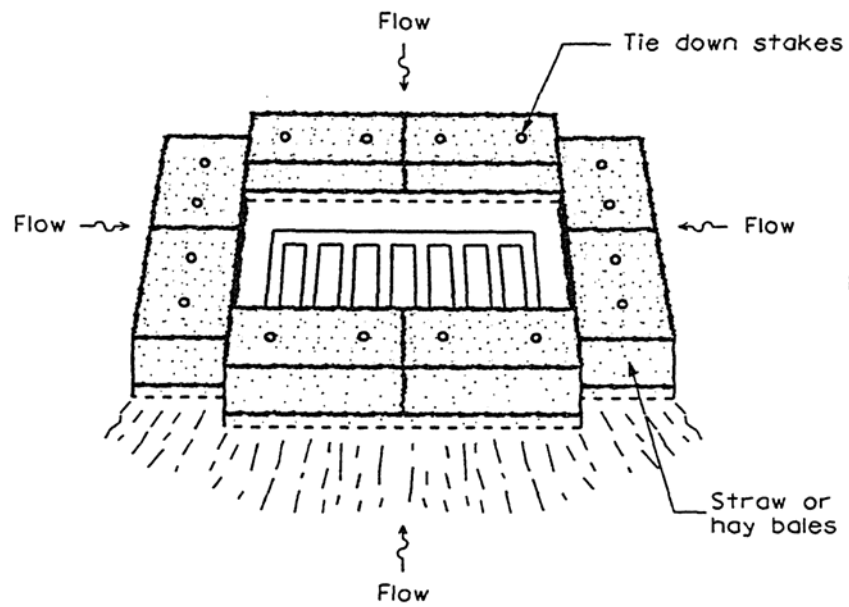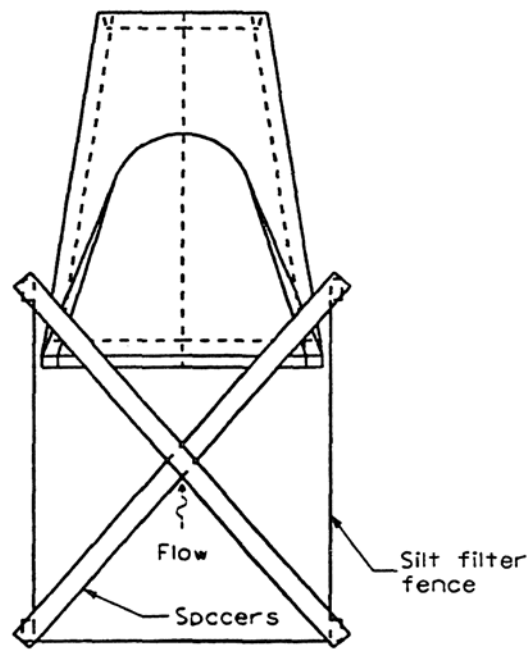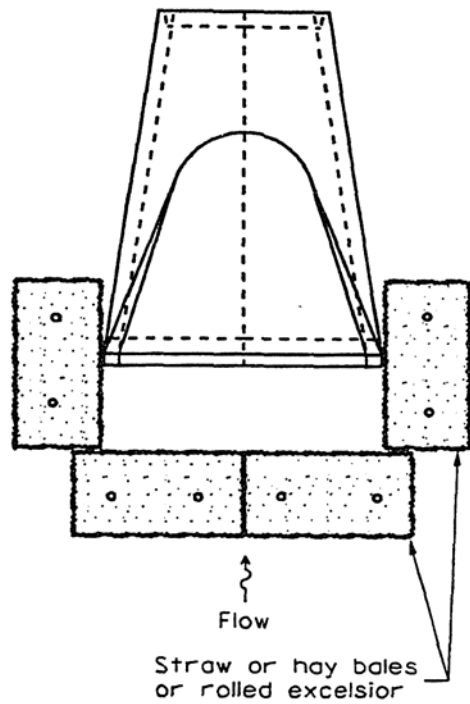


**INLET AND PIPE PROTECTION**

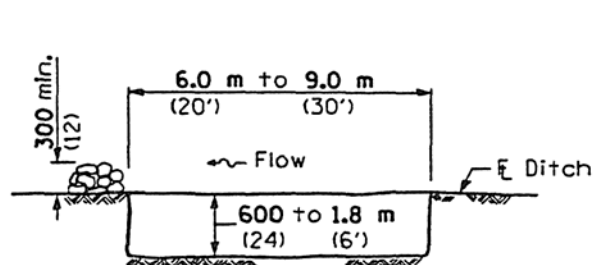

The performance of the basin will improve if put into a series.


ELEVATION

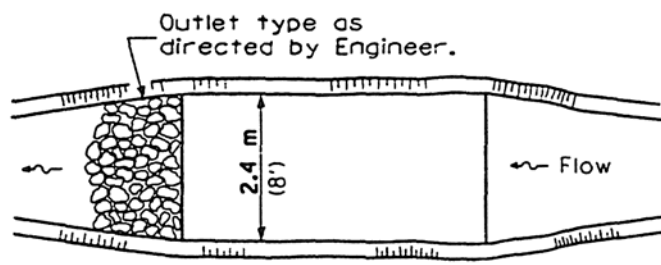


The long dimension should be parallel with the direction of the flow. Accumulated silt shall be removed anytime the basins become 75% filled.

PLAN

**SEDIMENT BASIN**

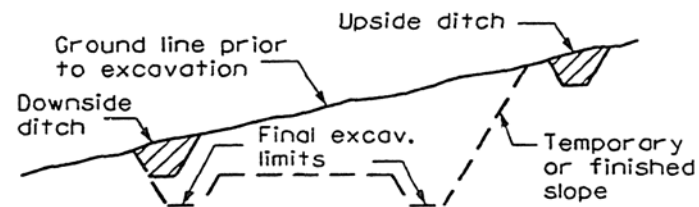

TYPICAL CUT CROSS SECTION

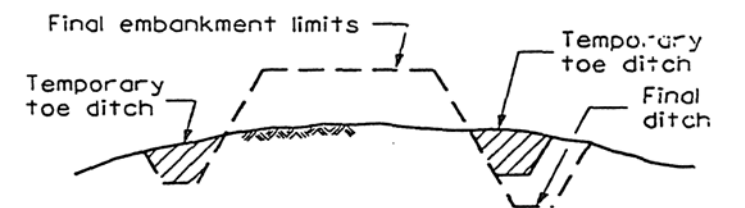

TYPICAL FILL CROSS SECTION

**TEMPORARY DITCHES FOR CUT & FILL SECTIONS**

Illinois Department of Transportation

PASSED January 1, 1999  
*Charles Kallfleiter*  
 ENGINEER OF POLICY AND PROCEDURES


APPROVED January 1, 1999  
*Bill Dunbar*  
 ENGINEER OF DESIGN AND ENVIRONMENT

ISSUED 1-1-97


TEMPORARY EROSION CONTROL SYSTEMS  
 (Sheet 2 of 2)

**STANDARD 280001-01**




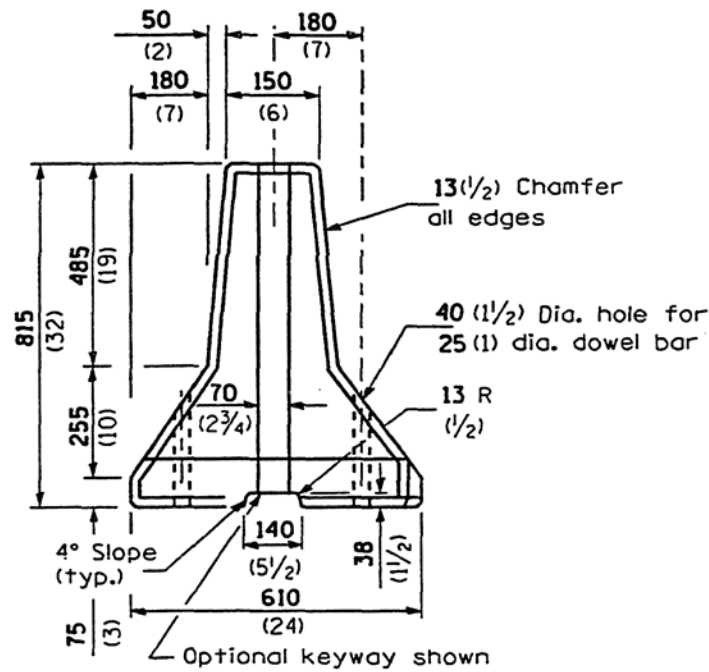

**END VIEW**

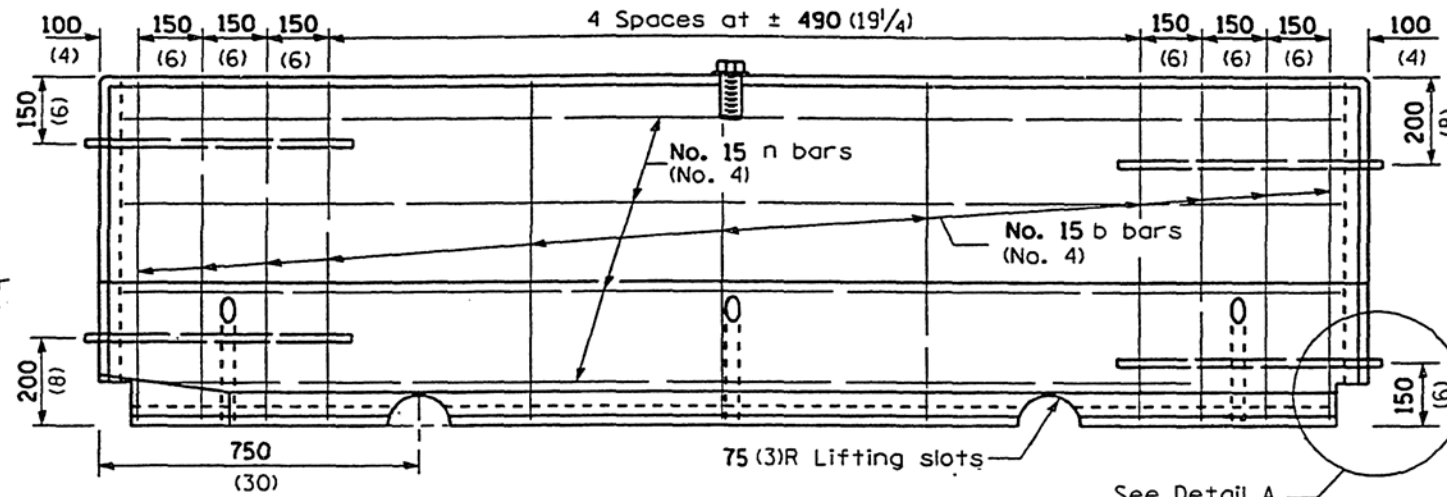


**ELEVATION**

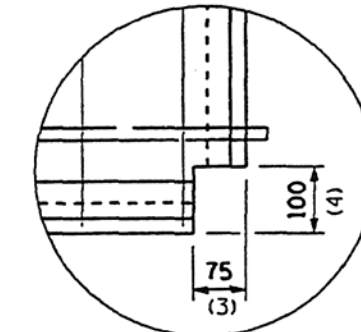


**DETAIL A**

(Typical for both ends of the barrier and the terminal section)

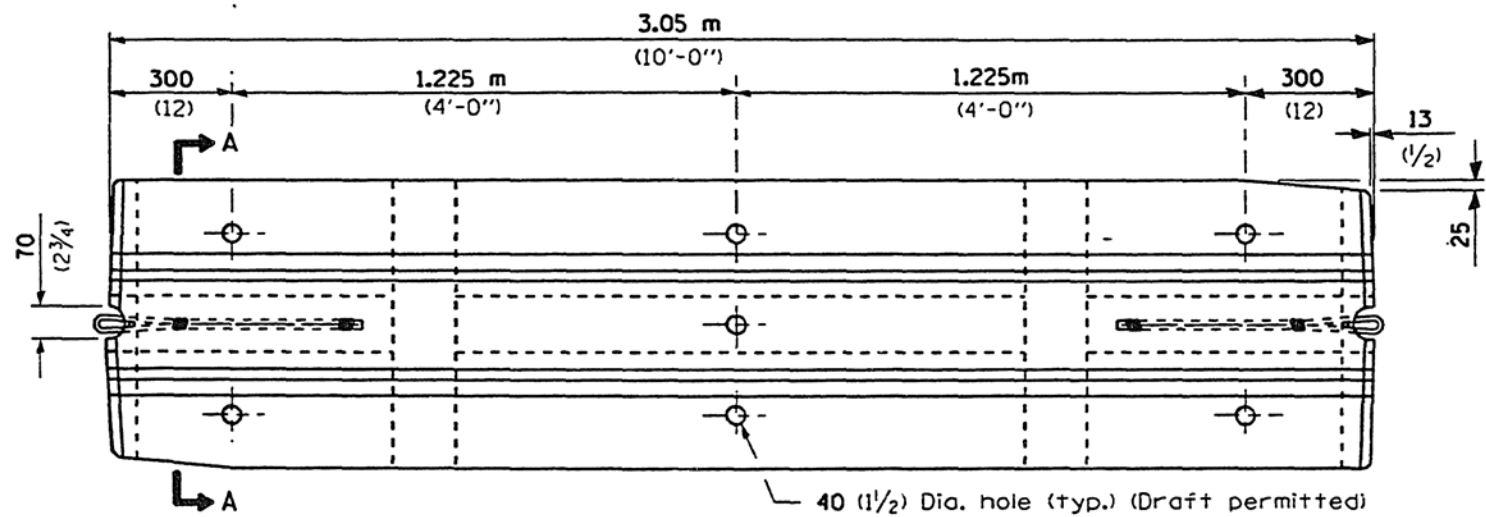


**PLAN**

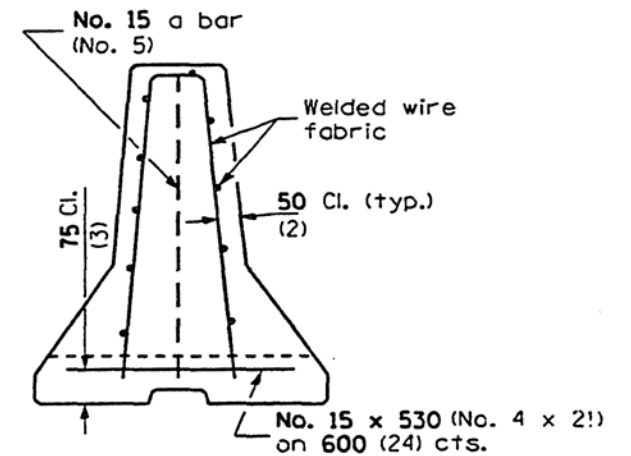


**SECTION A-A**

(Showing alternate welded wire reinforcement)

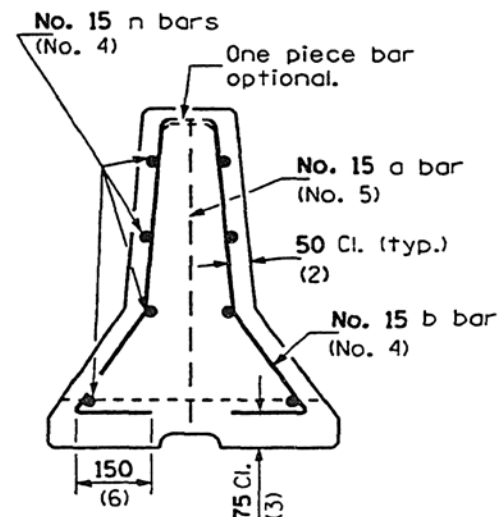

**SECTION A-A**

(Showing bar reinforcement)

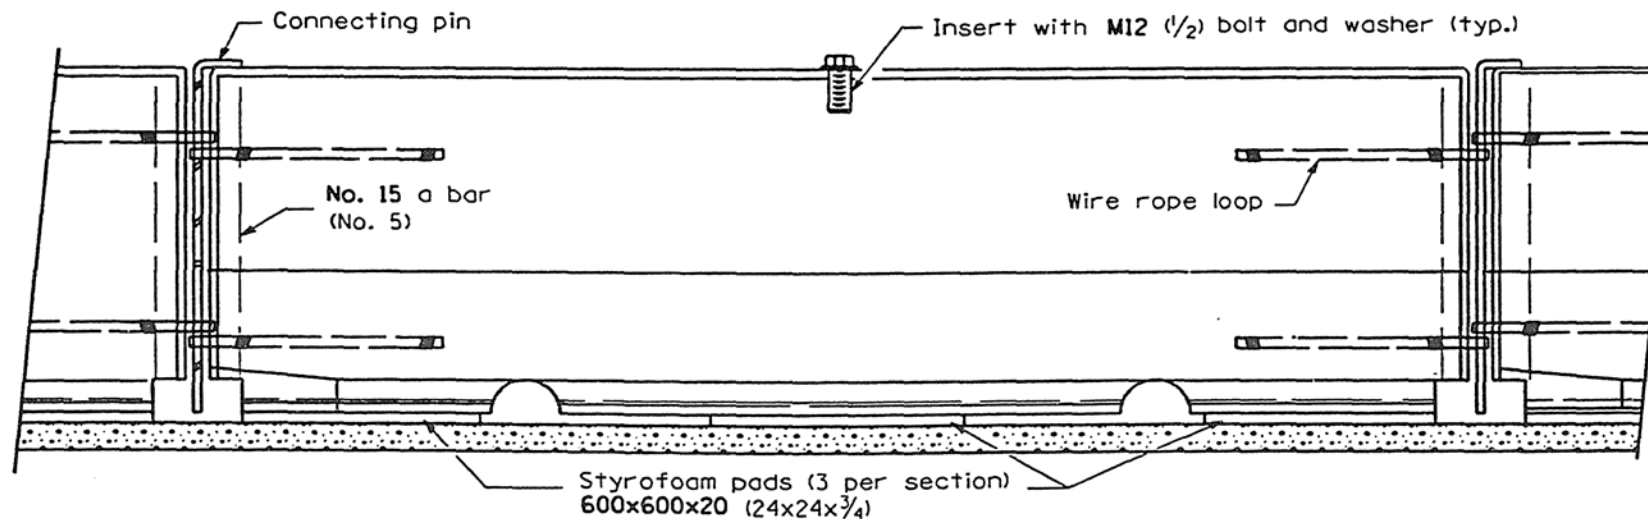

**TYPICAL INSTALLATION WITH STYROFOAM PADS**

**GENERAL NOTES**

Barriers manufactured before 1-1-98 according to IDOT standards 705001 and 2383 may be used.

Alternate lifting devices meeting the approval of the Engineer may be substituted for the lifting slots shown.

The #15 (#5) bar may be omitted if two continuous wire ropes are substituted for the four wire rope loops shown. The continuous ropes shall be looped and fastened on each end as shown in the WIRE ROPE LOOP DETAIL.

All dimensions are in millimeters (inches) unless otherwise shown.

Illinois Department of Transportation

PASSED January 1, 1998

ENGINEER OF POLICY AND PROCEDURES

APPROVED January 1, 1998

ENGINEER OF DESIGN AND ENVIRONMENT


ISSUED 86-1-1 (03/98)

DATE	REVISIONS
1-1-98	Renum. Standard 705001. Added block out.
1-1-97	Renum. Standard 2383-4. Deleted DN Symbol.
	Rev. hole dia. in PLAN.


**TEMPORARY CONCRETE BARRIER**

(Sheet 1 of 2)


**STANDARD 704001**

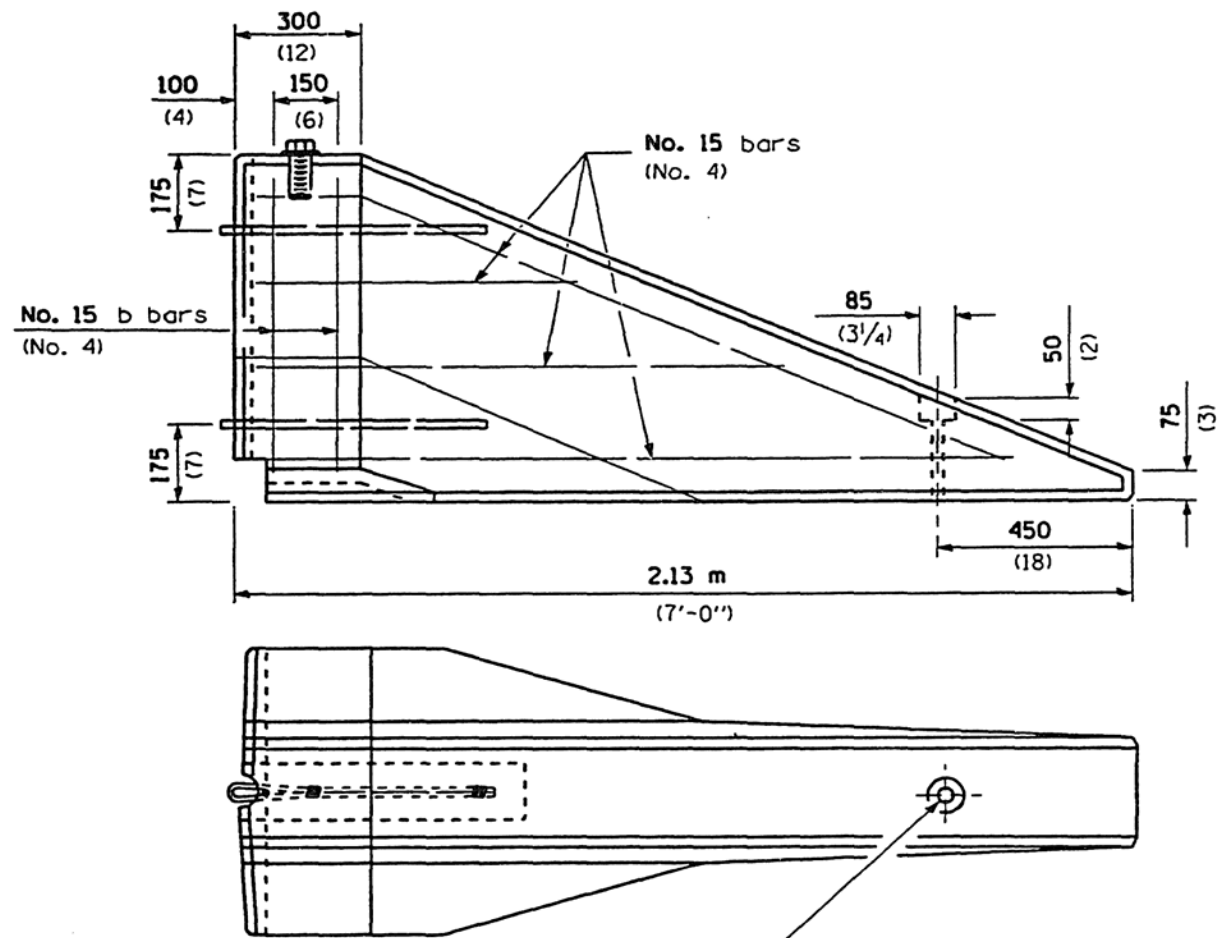


**TERMINAL SECTION**

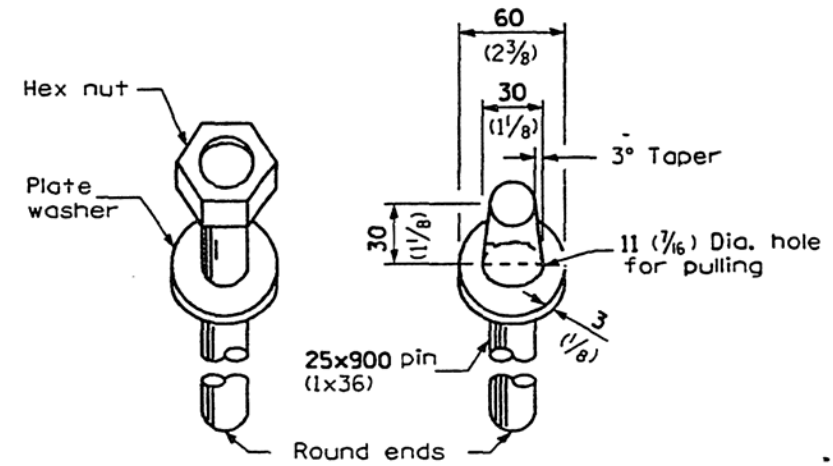

**ALTERNATE DRIFT PINS**

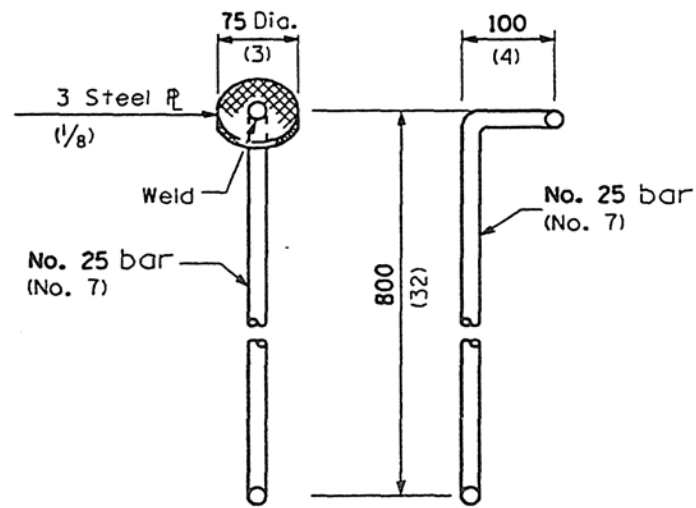

**ALTERNATE CONNECTING PINS**

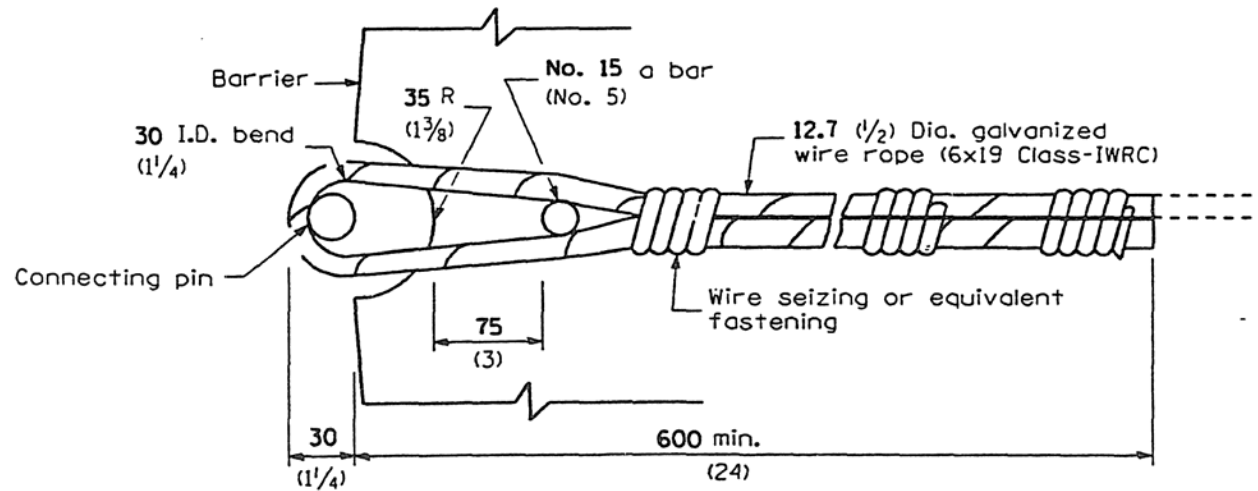

**WIRE ROPE LOOP DETAIL**  
9000 kg (20,000 lbs.) min. breaking strength

All dimensions are in millimeters (inches) unless otherwise shown.

**TEMPORARY CONCRETE BARRIER**  
(Sheet 2 of 2)

**STANDARD 704001**

Illinois Department of Transportation

PASSED January 1, 1998


ISSUED 86-1-1 03/98

ENGINEER OF POLICY AND PROCEDURES


APPROVED January 1, 1998

ENGINEER OF DESIGN AND ENVIRONMENT



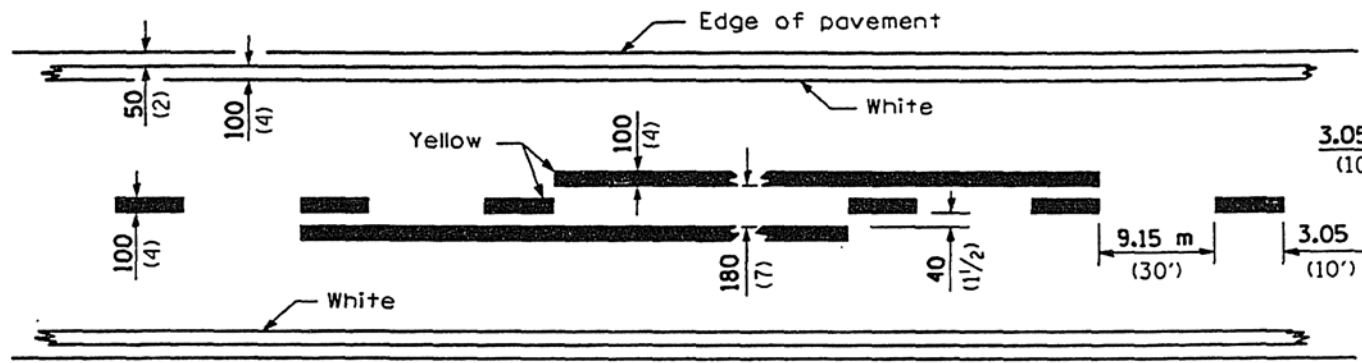

2 LANE

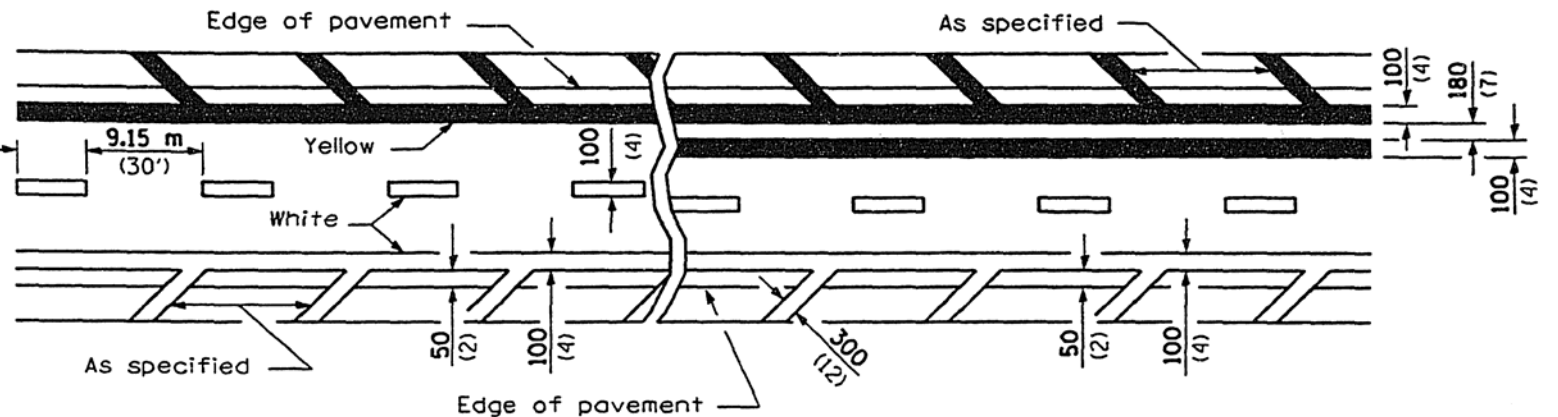


DIVIDED

MULTI LANE

UNDIVIDED

LANE AND EDGE LINES

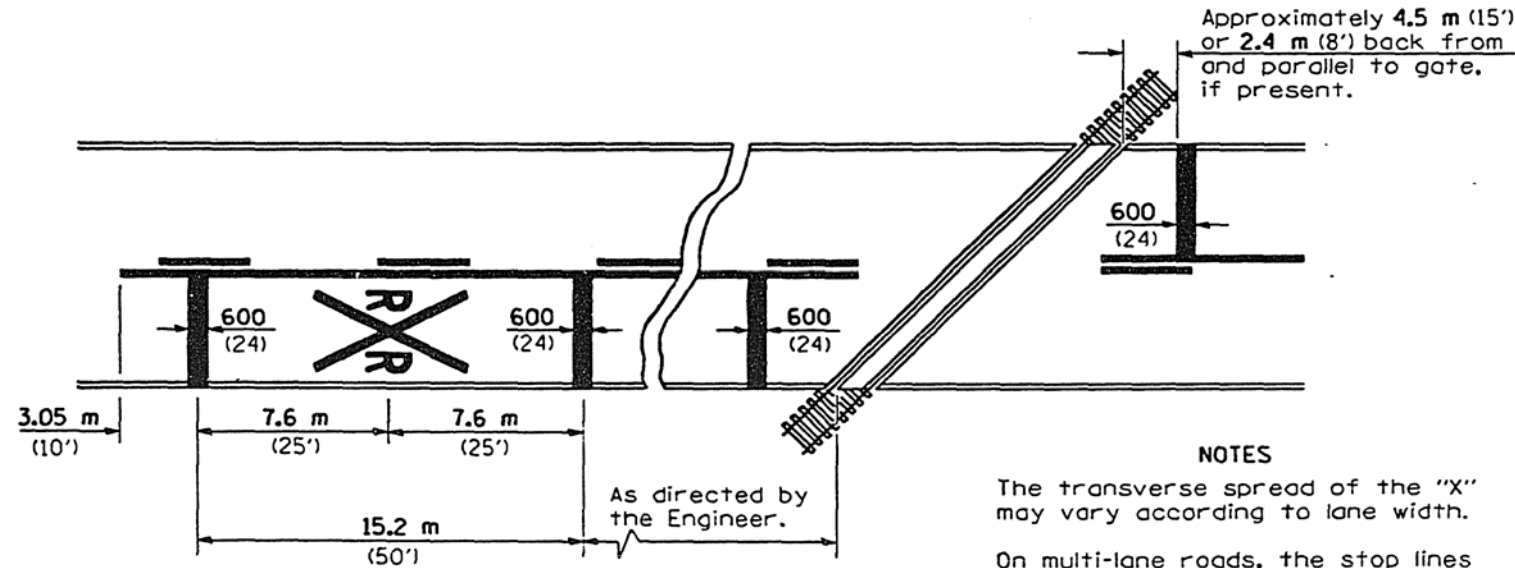


NOTES

The transverse spread of the "X" may vary according to lane width.

On multi-lane roads, the stop lines shall extend across all approach lanes and separate RXR symbols shall be placed adjacent to each other in each lane.

When the pavement marking symbol is used, a portion of the symbol should be located directly adjacent to the Advance Warning Sign (W10-1) as placed by Table II-1, condition B of the MUTCD.

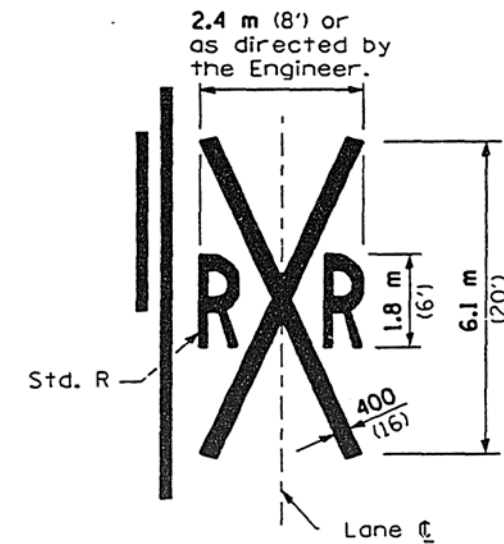

PAVEMENT MARKINGS AT RAILROAD-HIGHWAY GRADE CROSSING

All dimensions are in millimeters (inches) unless otherwise shown.

Illinois Department of Transportation

APPROVED January 1, 1999  
*[Signature]*  
 ENGINEER OF OPERATIONS

APPROVED January 1, 1999  
*[Signature]*  
 ENGINEER OF DESIGN AND ENVIRONMENT

ISSUED 1-1-97





DATE	REVISIONS
1-1-99	Rev. dimen. & added 3rd note to pav't markings @ RR-Hwy grade Xing.
1-1-97	Renum. Standard 2396-1. Revised metric values.

TYPICAL PAVEMENT MARKINGS

(Sheet 1 of 2)

STANDARD 780001-01




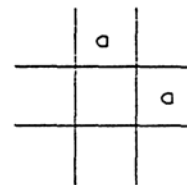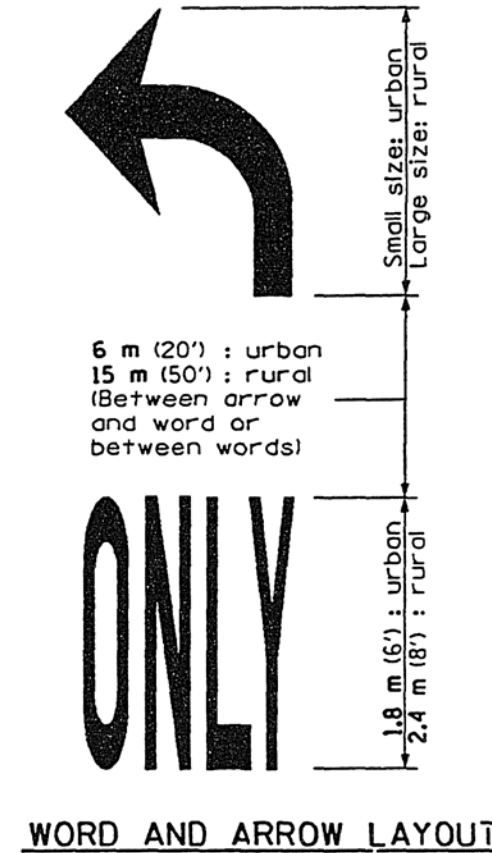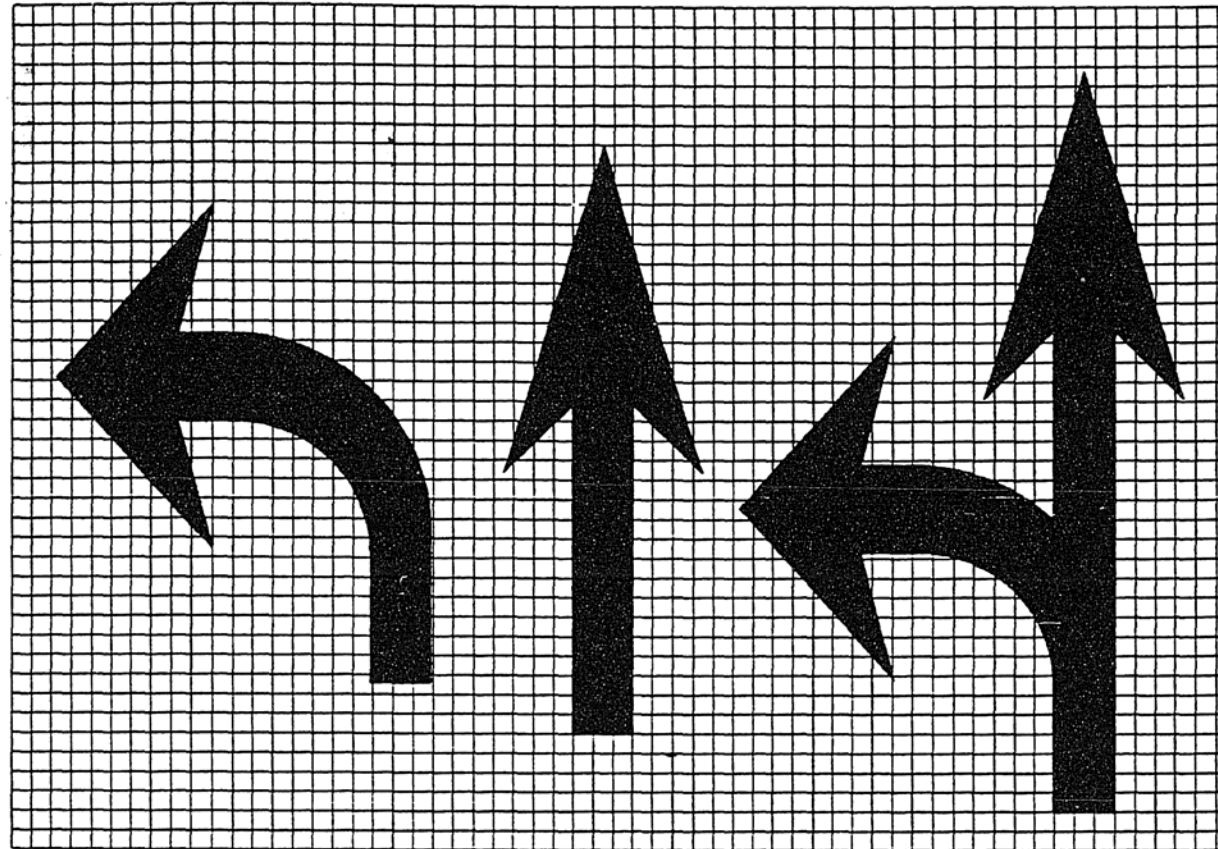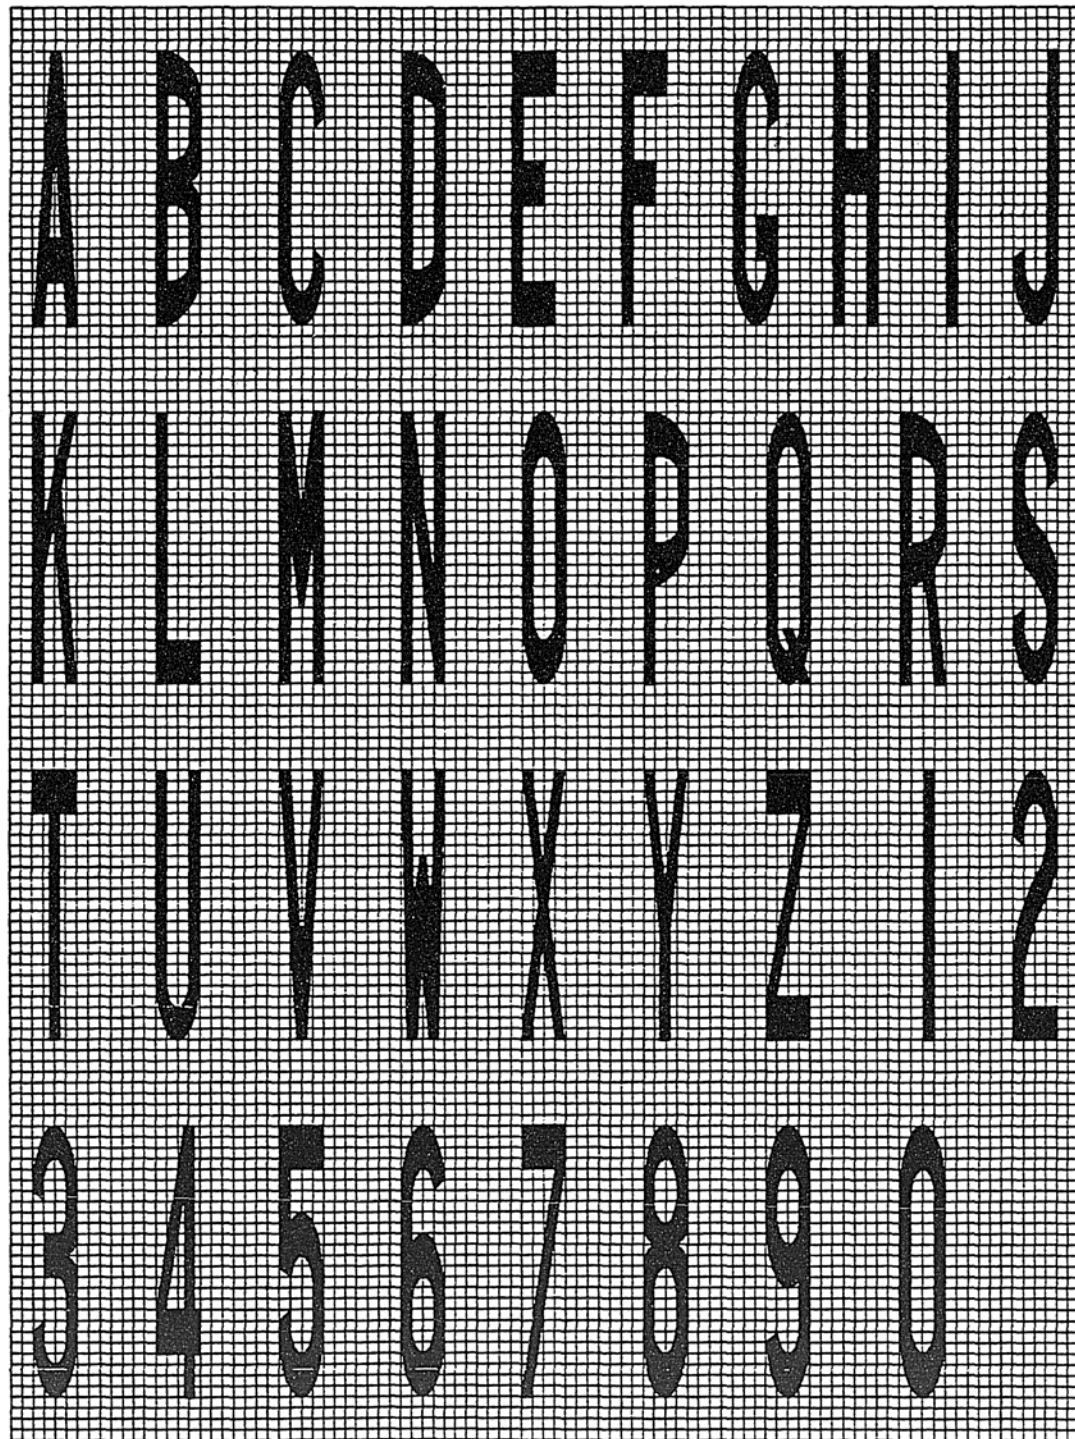

Legend Height	Arrow Size	a
1.8 m (6')	Small	74 (2.9)
2.4 m (8')	Large	96 (3.8)


The space between adjacent letters or numerals should be approximately 75 (3) for 1.8 m (6') legend and 100 (4') for 2.4 m (8') legend.

**LETTER AND ARROW GRID SCALE**

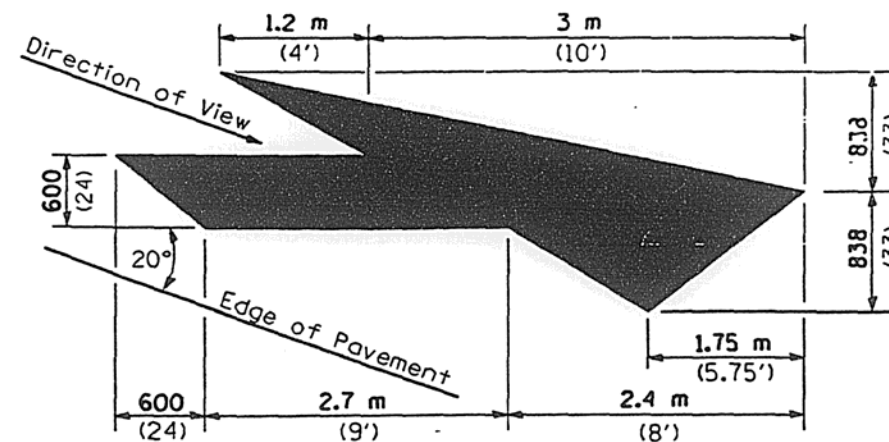

**LANE DROP ARROW**

Right lane drop arrow shown.  
Use mirror image for left lane.

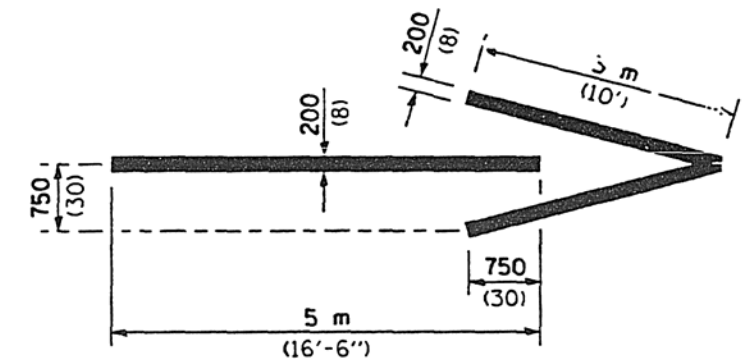

**WRONG WAY ARROW**

All dimensions are in millimeters (inches) unless otherwise shown.

**TYPICAL PAVEMENT MARKINGS**

(Sheet 2 of 2)

**STANDARD 780001-01**

Illinois Department of Transportation

APPROVED January 1, 1999

ENGINEER OF OPERATIONS

APPROVED January 1, 1999

ENGINEER OF DESIGN AND ENVIRONMENT


ISSUED 1-1-99



CONCRETE BARRIER WALL	
POSTED SPEED	TAPER RATE
70 km/h (40 mph) AND ABOVE	12:1
BELOW 70 km/h (40 mph)	8:1

SEQUENCE OF OPERATIONS						
PHASE	A			B		
	1	2	3	4	5	6
NORTHBOUND OR EASTBOUND	G	Y	R	R	R	R
SOUTHBOUND OR WESTBOUND	R	R	R	G	Y	R

Where temporary bridge rail is specified it shall be connected to the temporary concrete barrier using a Traffic Barrier Terminal Type 11.

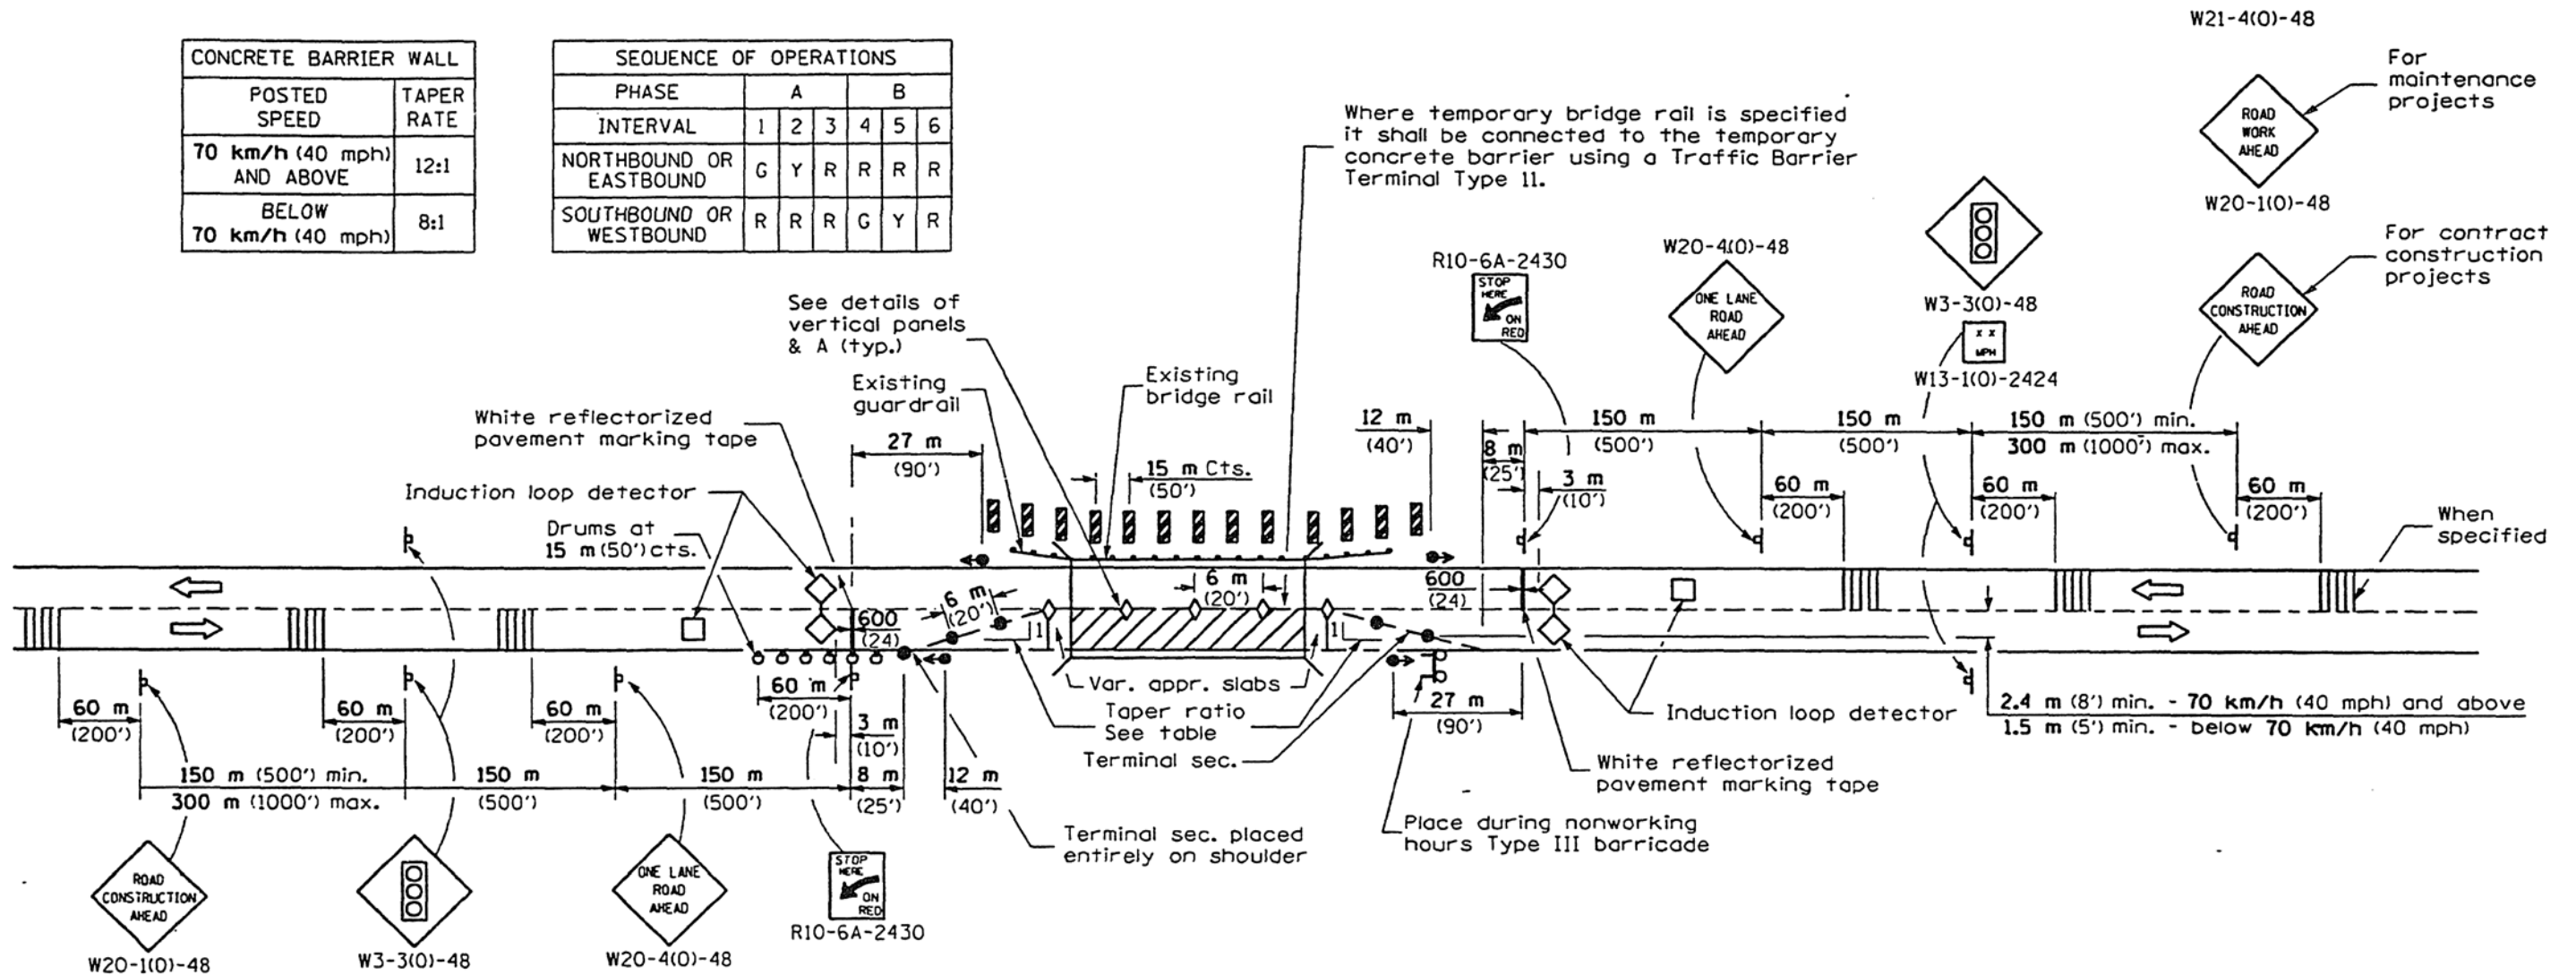

### SYMBOLS

- Work area
- Sign
- Drum with steady burning light
- Type III barricade with flashing lights
- Traffic signal
- Temporary rumble strip (when specified)
- Induction loop detector
- Double vertical panel
- Type C Bidirectional reflector
- Temporary concrete barrier
- Sand module impact attenuator
- Steady burning lights and double vertical panels

### GENERAL NOTES

This Standard is used where, at any time any vehicle, equipment, workers, or their activities will encroach on one lane of a bridge, traffic signals, and a positive barrier are required.

If flaggers are used instead of traffic signals, the traffic control devices shall conform to Standard 701201 or 701206.

Temporary concrete barrier shall be placed according to Standard 704001.

All dimensions are in millimeters (Inches) unless otherwise shown.

DATE	REVISIONS
1-1-99	Rev. Type III barr. symb. remvd. dbl. panels on tan., added 6 m spacing.
1-1-98	Clarified dimen. between rt. loop det. & traf. sig.
	Rev. 3rd GEN. NOTE.

**LANE CLOSURE 2L, 2W  
BRIDGE REPAIR WITH BARRIER**

(Sheet 1 of 2)


**STANDARD 701321-02**

Illinois Department of Transportation



APPROVED January 1, 1999  
ENGINEER OF OPERATIONS

APPROVED January 1, 1999  
ENGINEER OF DESIGN AND ENVIRONMENT

ISSUED 1-1-97

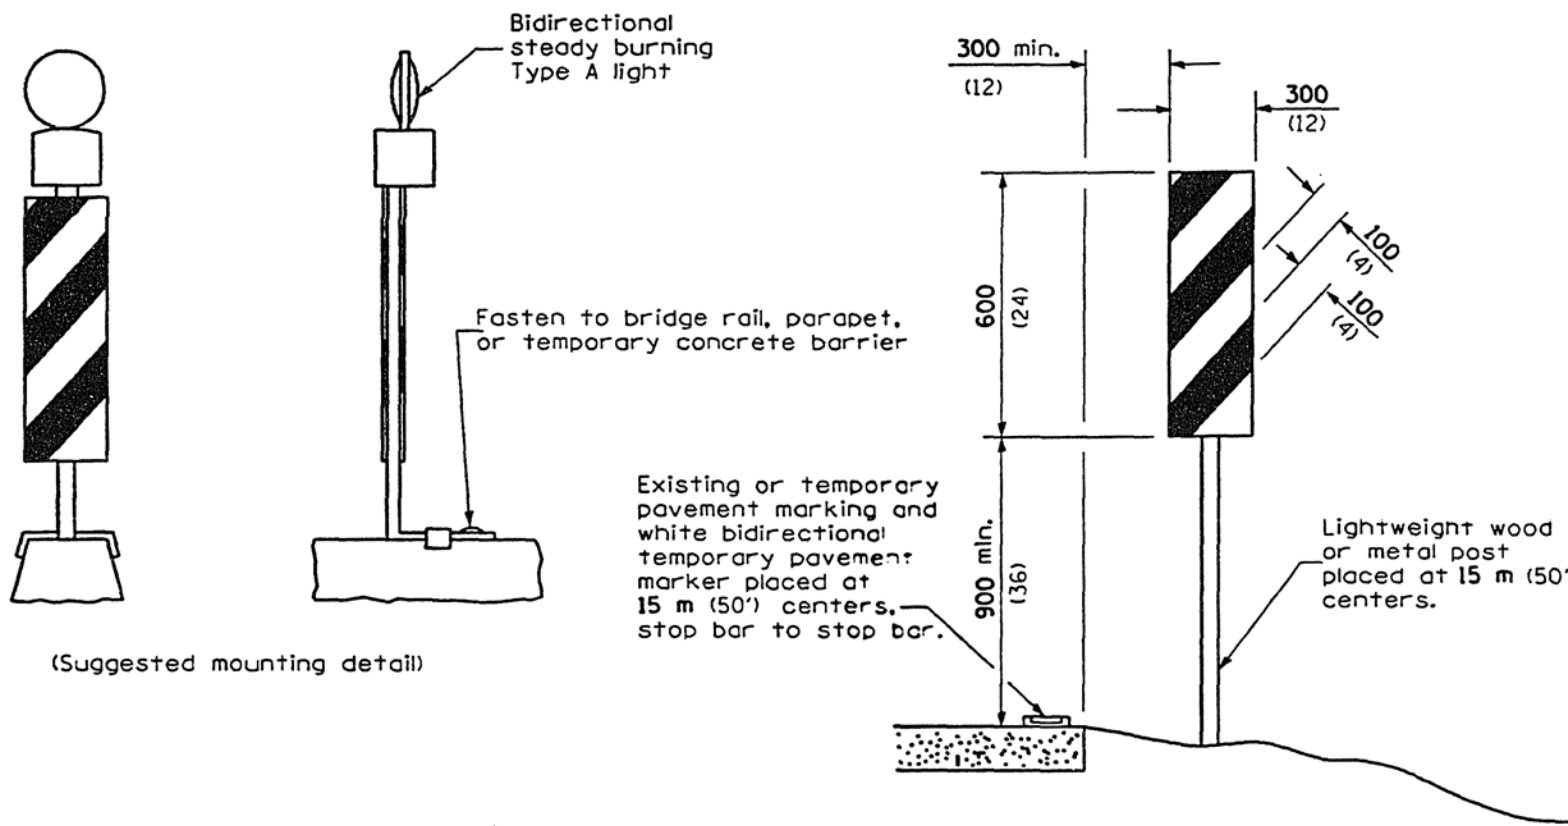

**PAVEMENT MARKERS AND VERTICAL PANELS**

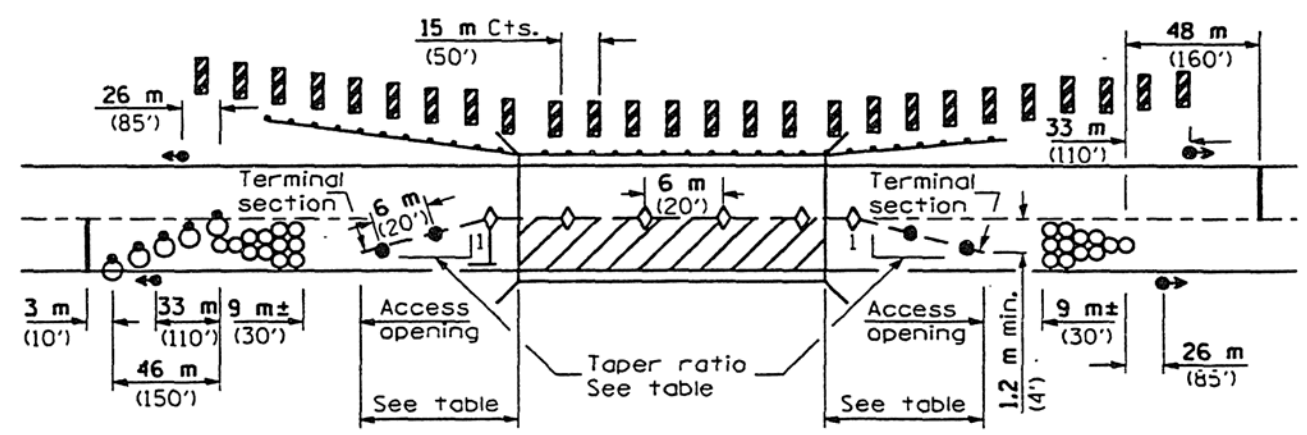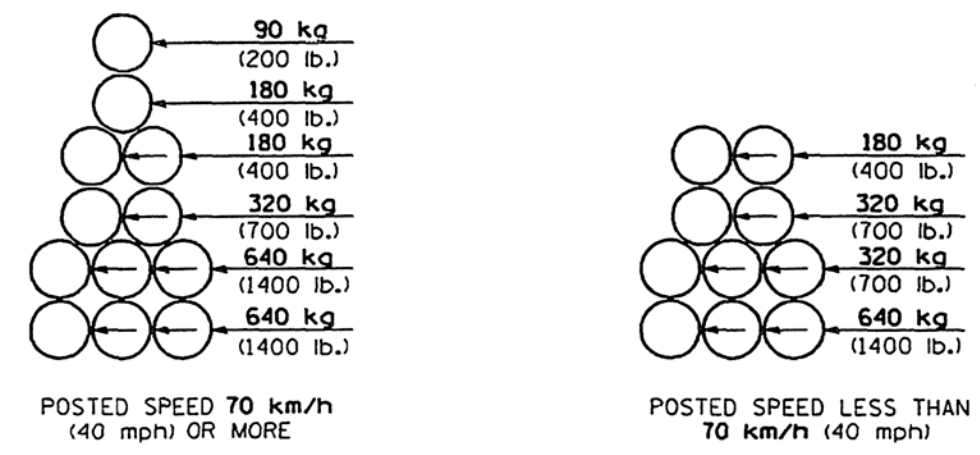

**NOTES**


The Contractor may use the details shown on this sheet for either or both approaches in lieu of details shown on sheet 1 of this Standard where greater access to the work area is needed.

The impact attenuators may be placed directly on the pavement or on pallets or skids. (Max pallet/skid height 60 (2 1/4))


The impact attenuators shall be striped in accordance with the requirements for drums in Standard 702001.

A minimum of 3 barricades or drums with bidirectional steady burning lights delineating the closed lane shall be placed in the access opening during nonworking hours.

**SAND MODULE IMPACT ATTENUATOR CONFIGURATION**

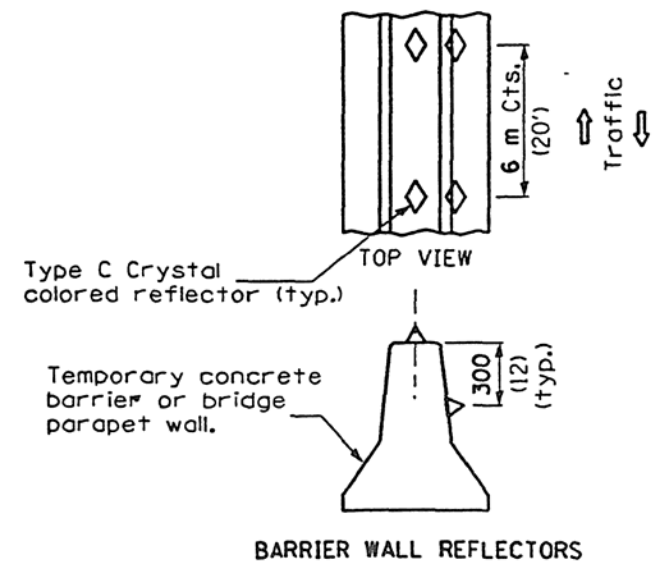

**DETAIL A**

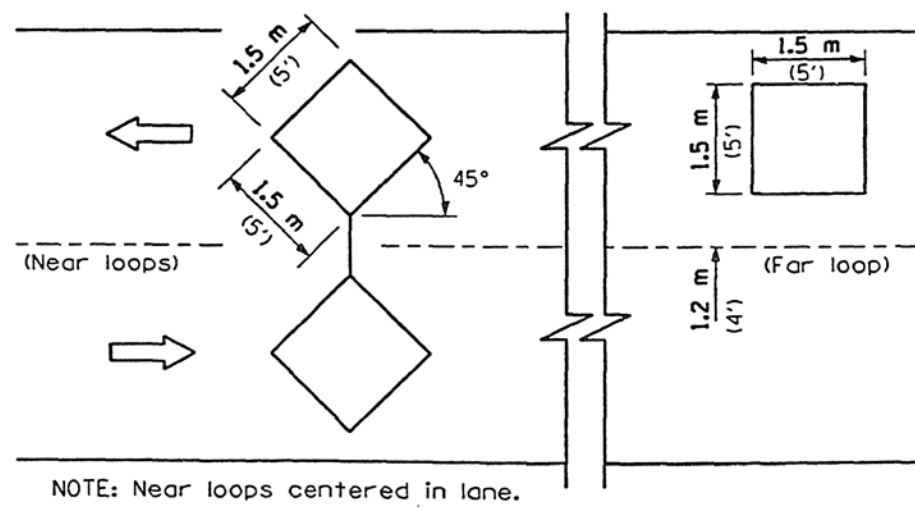

**INDUCTION LOOP DETECTOR (TYPICAL)**

(See traffic control plan for placement)

All dimensions are in millimeters (inches) unless otherwise shown.

Illinois Department of Transportation

APPROVED January 1, 1999  
 ENGINEER OF OPERATIONS

APPROVED January 1, 1999  
 ENGINEER OF DESIGN AND ENVIRONMENT


ISSUED 1-1-97

**LANE CLOSURE 2L, 2W  
 BRIDGE REPAIR WITH BARRIER**

(Sheet 2 of 2)



**STANDARD 701321-02**



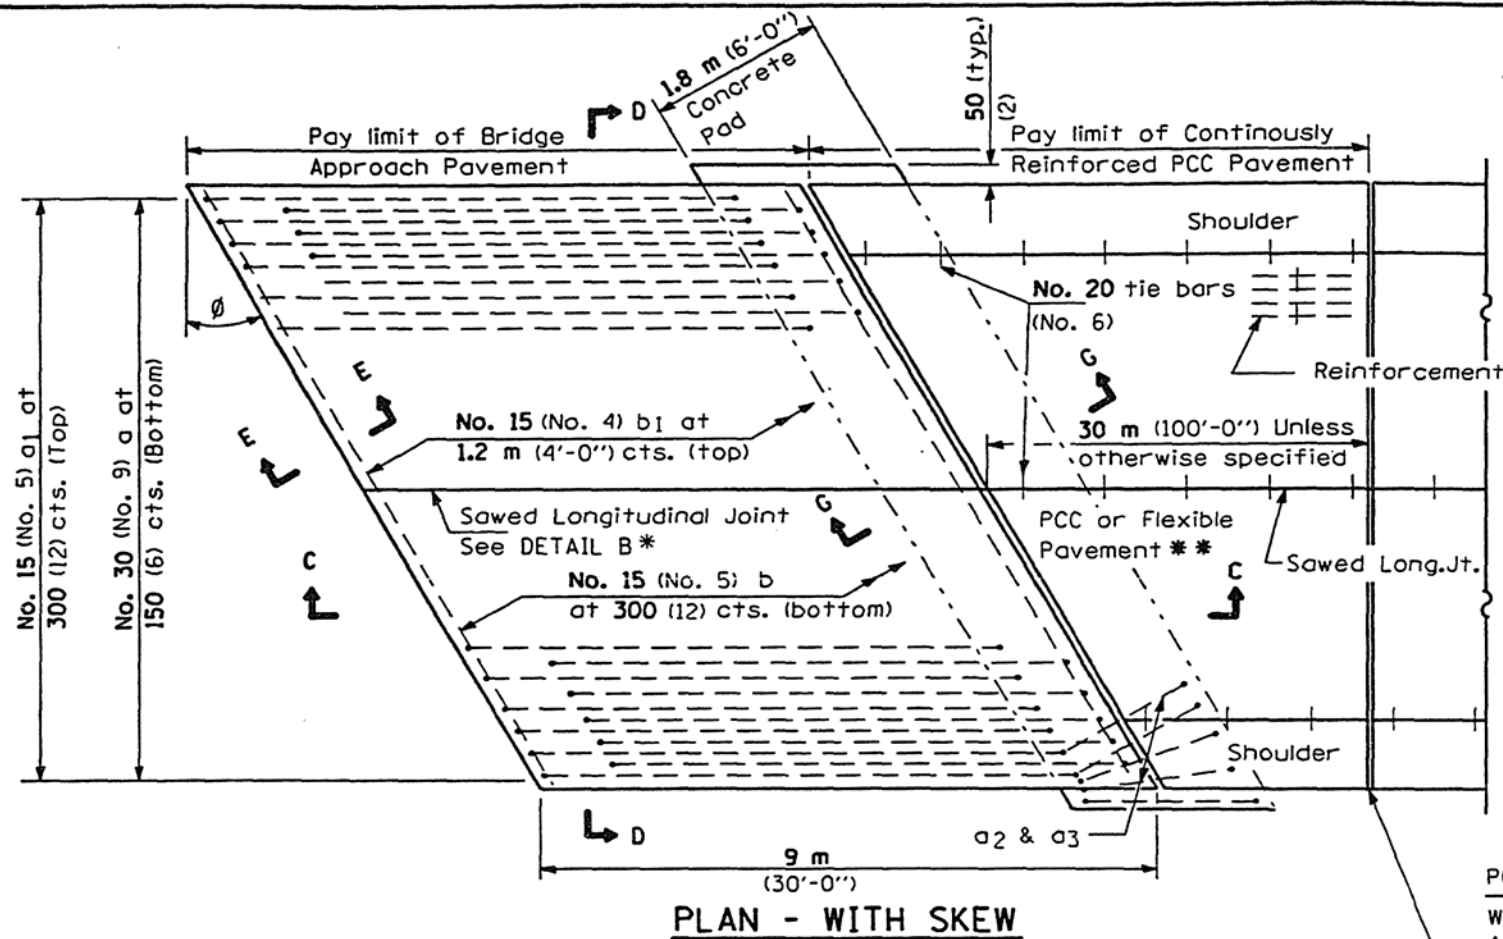



**NEW CONSTRUCTION**

**DETAIL B\***

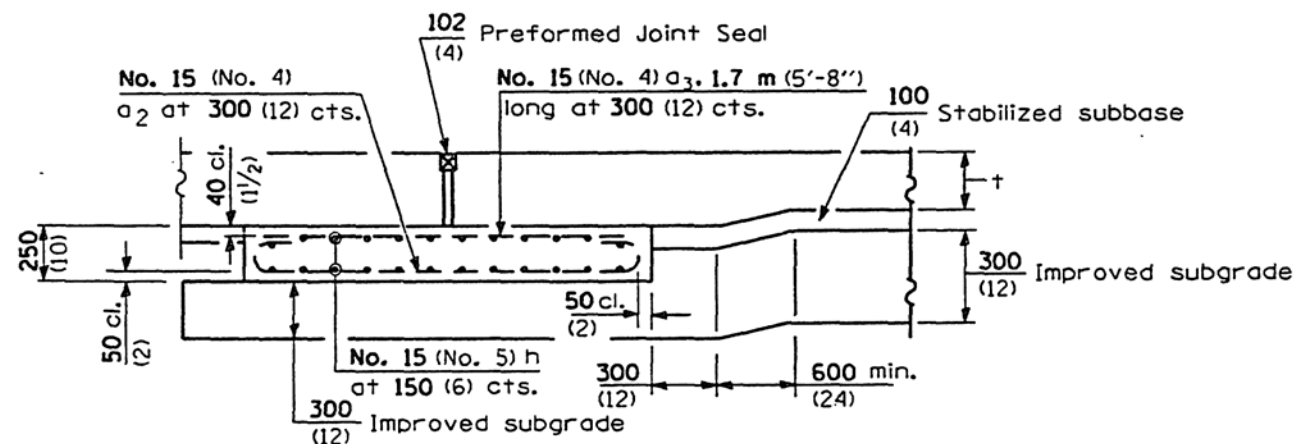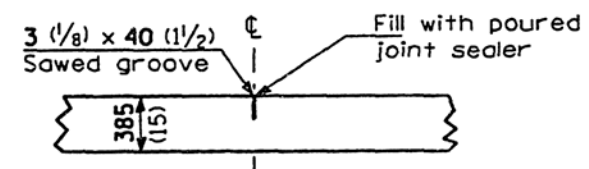

PCC Pavement only:

Wide Flange Beam Terminal Joint (See DETAIL AT BEAM - Standard 421101 or 421106) or 75 (3) Exp. Joint as detailed on Standard 420001.

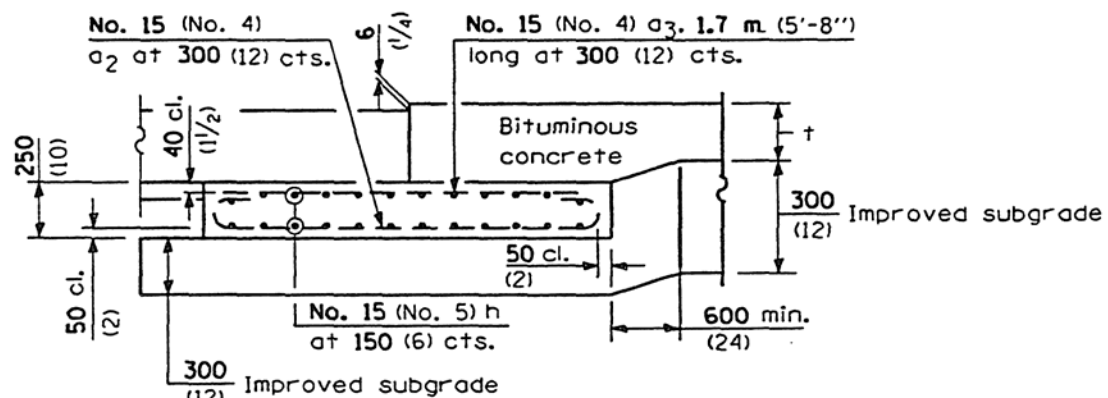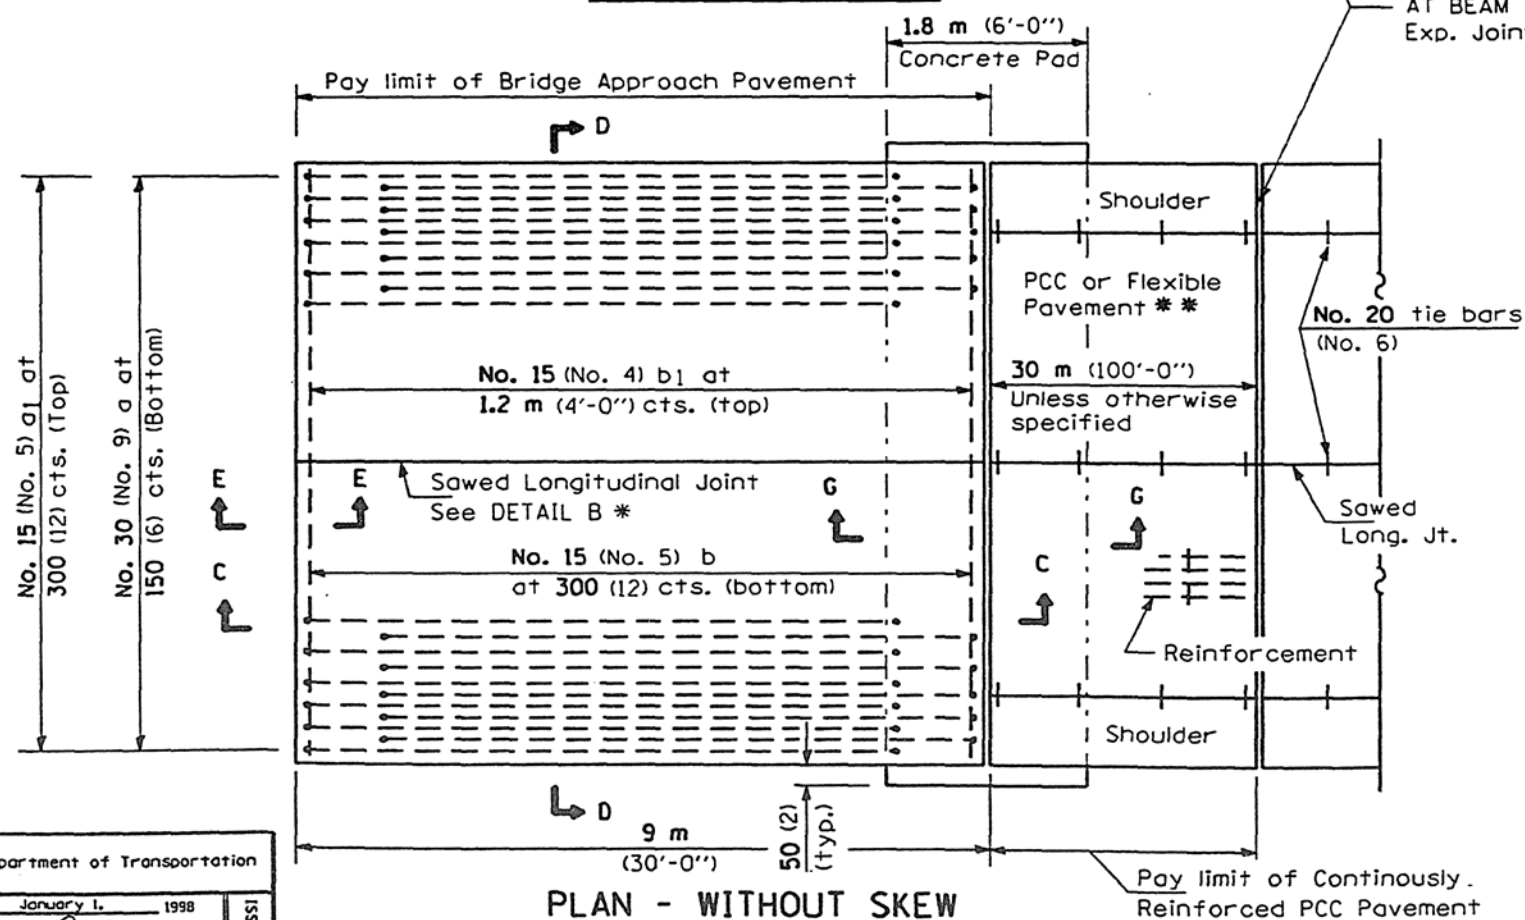

**GENERAL NOTES**

THICKNESS-"t"=Thickness of Pavement.  
 See Standard 421001 for reinforcement details not shown.  
 See Standard 420001 for details of joints not shown.  
 All dimensions are in millimeters (inches) unless otherwise shown.

Illinois Department of Transportation

APPROVED January 1, 1998

*Ralph E. Anderson*  
 ENGINEER OF BRIDGES AND STRUCTURES

APPROVED January 1, 1998

*Bill Swinley*  
 ENGINEER OF DESIGN AND ENVIRONMENT

ISSUED 1-1-97

DATE	REVISIONS
1-1-98	Rev. ref. to Std 2443 to 609006. Added "(top)" & "(bottom)" to pg. 1
1-1-97	Renum. Standard 2442-4.


**BRIDGE APPROACH PAVEMENT**

(Sheet 1 of 3)


**STANDARD 420401-01**

\* Saw  $\text{C}$  or lane edge if poured two or more lane widths at a time.  
 \*\* Omit Reinforcement, tie bars and sawed Long. Jt. for Flexible Pavement.


**EXISTING CONSTRUCTION**

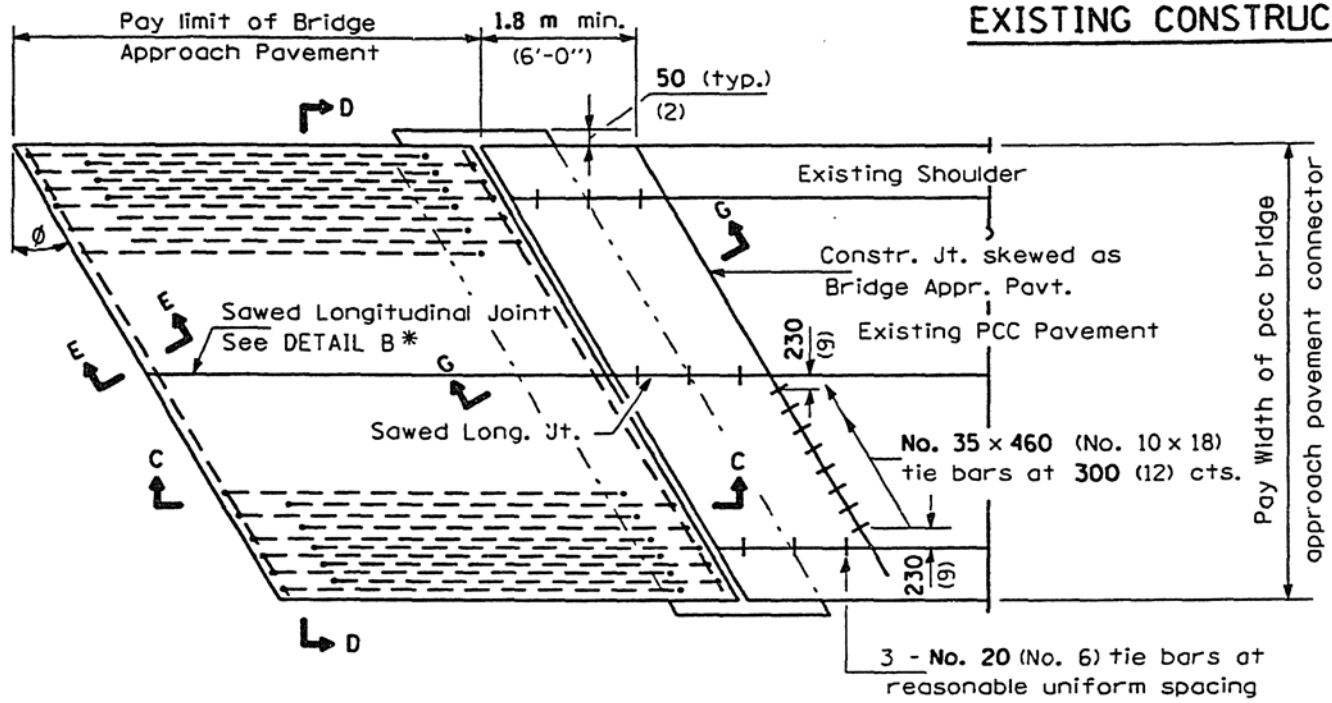


**BRIDGE APPROACH PAVEMENT CONNECTOR (PCC)**

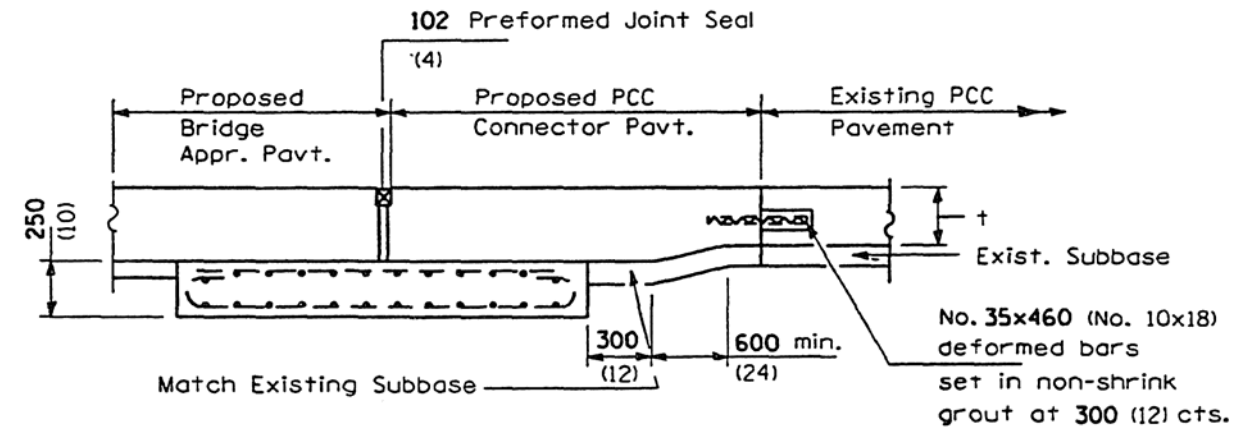

**SECTION G-G - RIGID PAVEMENT**

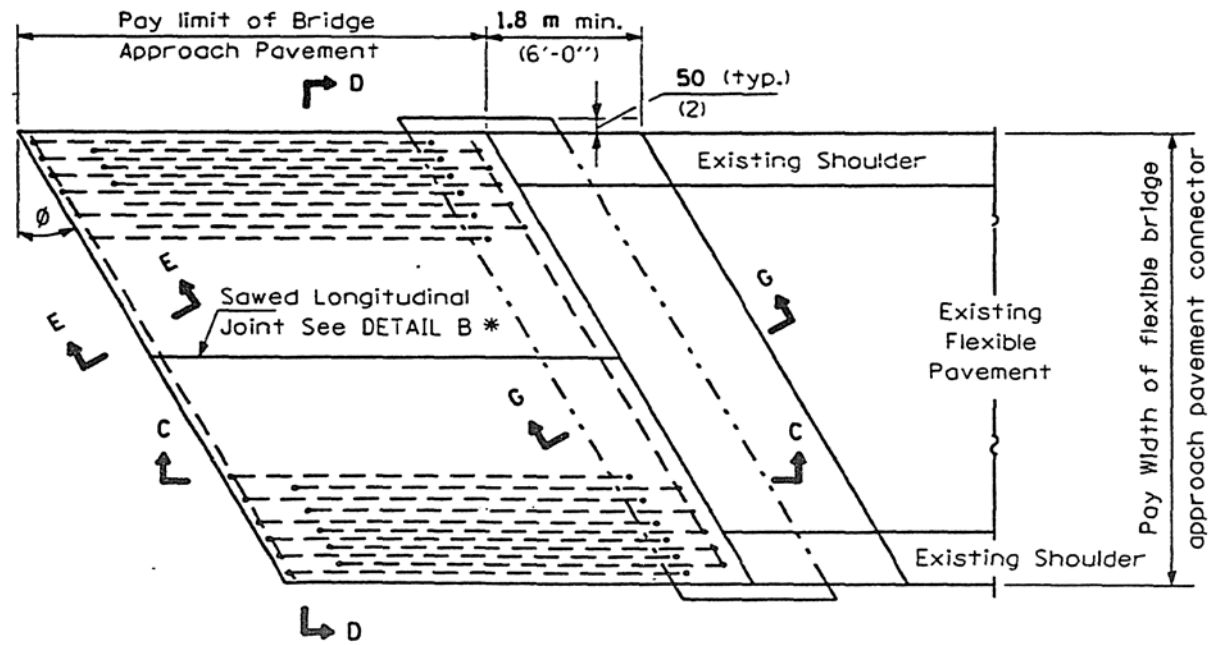

**BRIDGE APPROACH PAVEMENT CONNECTOR (FLEXIBLE)**

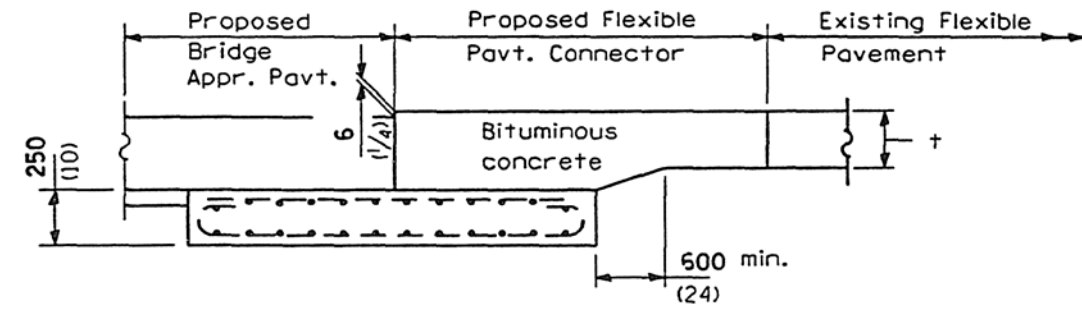

**SECTION G-G - FLEXIBLE PAVEMENT**

All dimensions are in millimeters (inches) unless otherwise shown.

Illinois Department of Transportation

APPROVED January 1, 1998  
*Ralph E. Anderson*  
 ENGINEER OF BRIDGES AND STRUCTURES

APPROVED January 1, 1998  
*Bill Swisher*  
 ENGINEER OF DESIGN AND ENVIRONMENT



ISSUED 1-1-97

**BRIDGE APPROACH PAVEMENT**


(Sheet 2 of 3)

**STANDARD 420401-01**



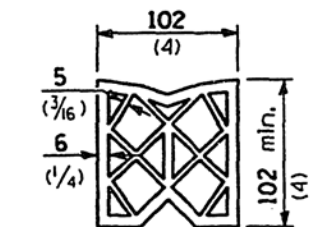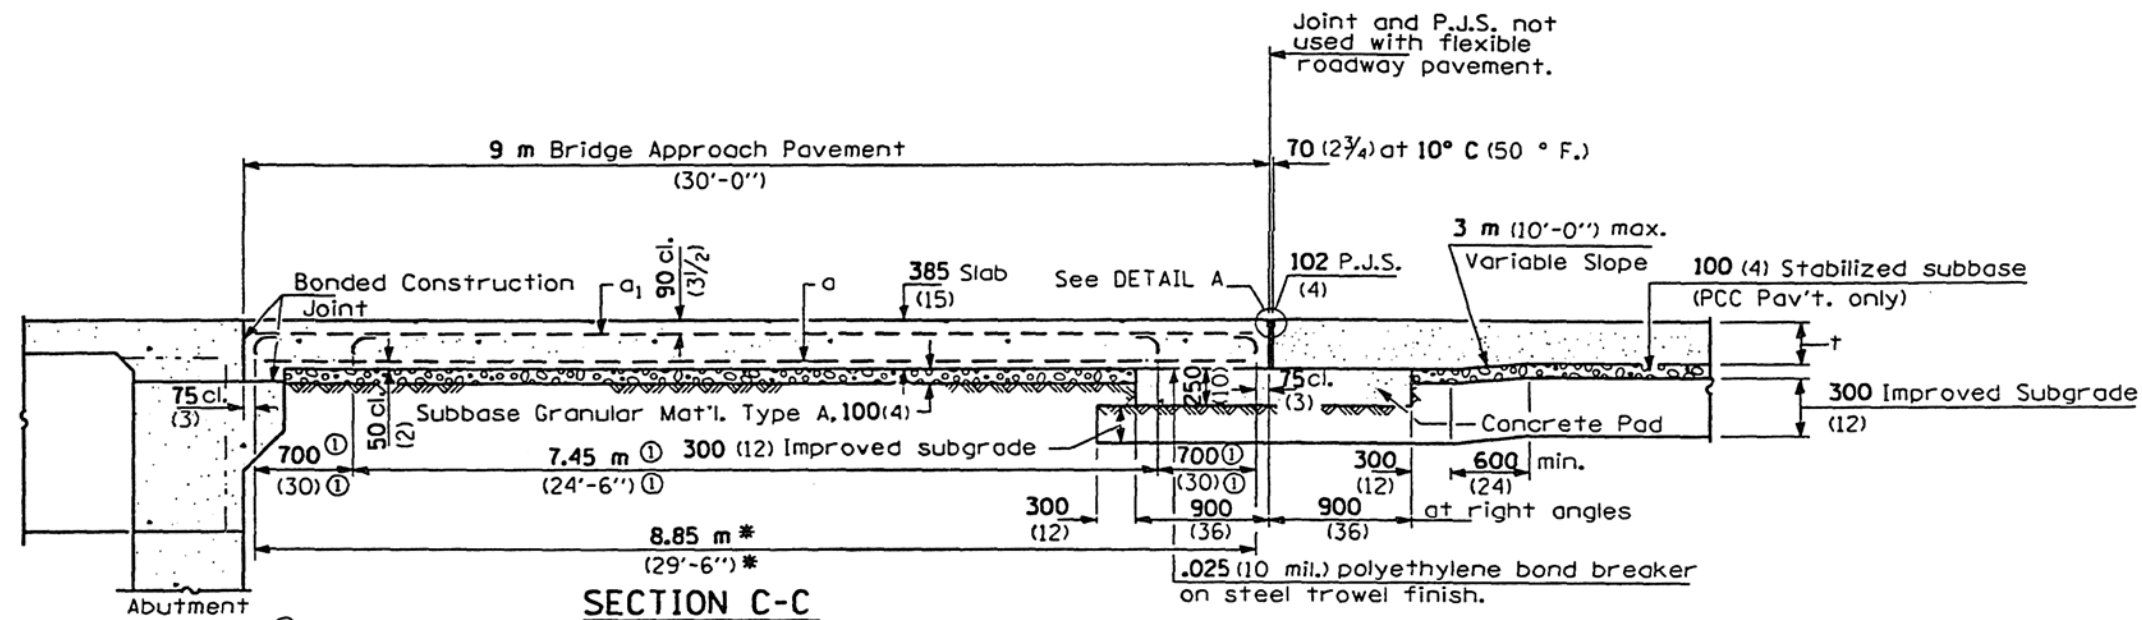


**PREFORMED JOINT SEAL**

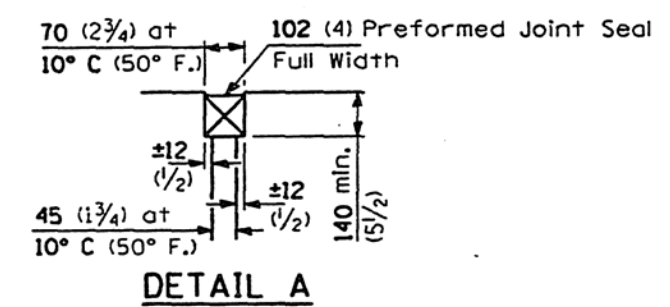


**SECTION C-C**

① Stagger No. 30 (No. 9) a bars as shown on plan - full width

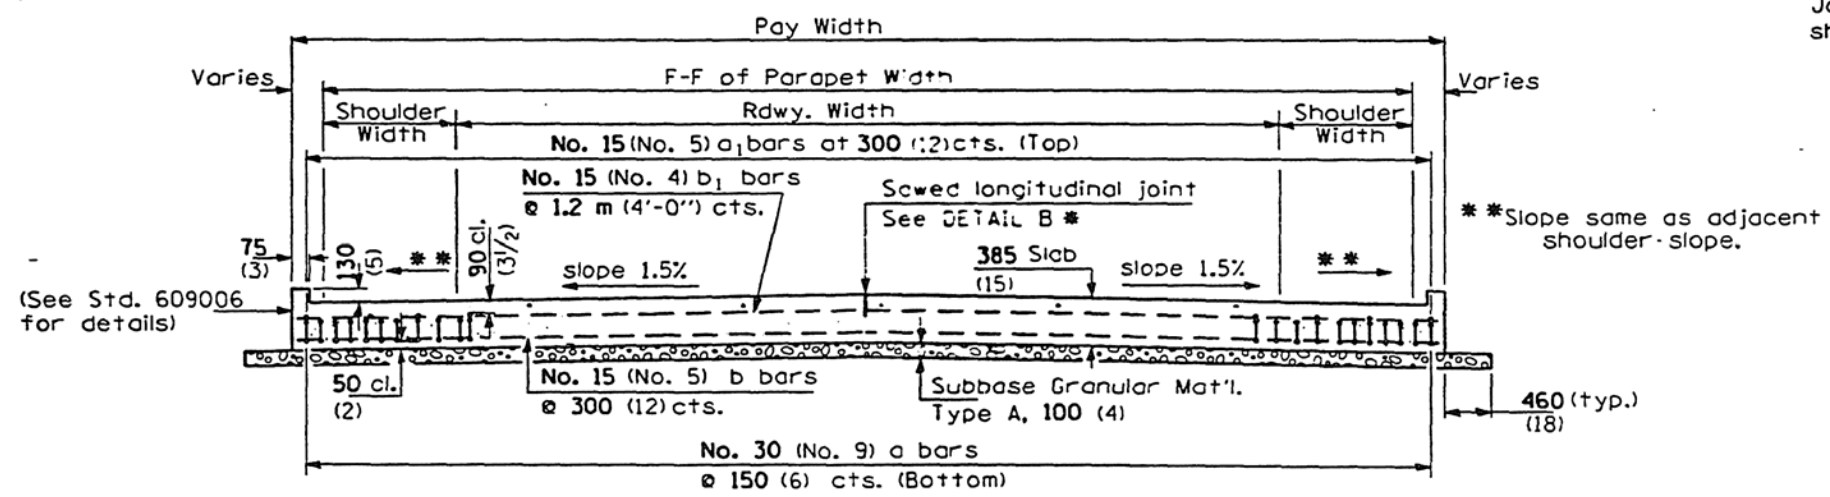


**SECTION D-D**

(See Plan for Dimensions not shown)  
All reinforcement bars shall be epoxy coated.

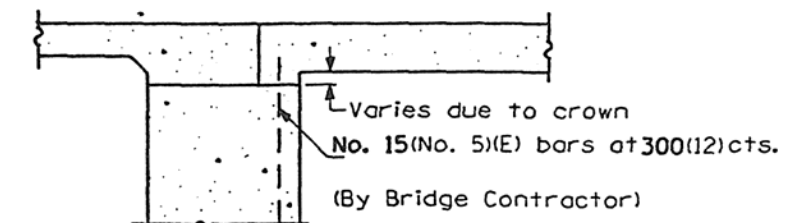

**SECTION E-E**


(Integral Abutments)

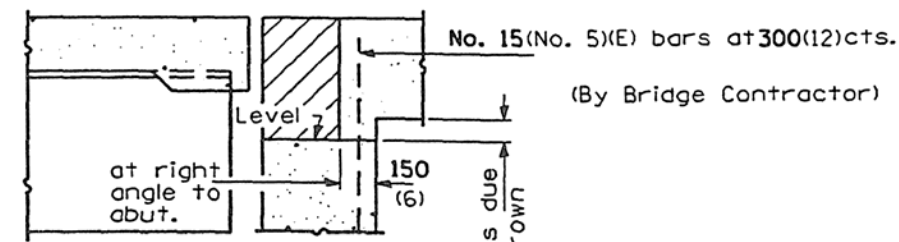

**SECTION E-E**


(Jointed Abutments)

Longitudinal Construction Joint in accordance with details shown on Standard 420001.

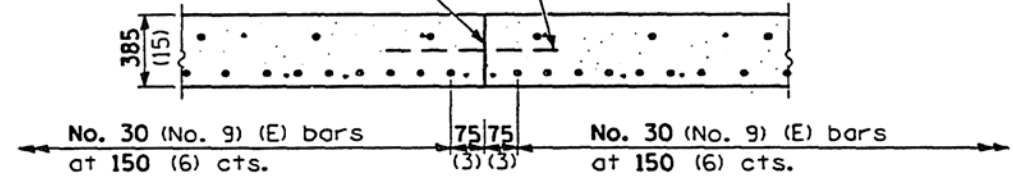


**OPTIONAL LONGITUDINAL CONSTRUCTION JOINT**

As approved by the Engineer, the Contractor may elect to reduce the widths of pour by use of the Optional Longitudinal Construction Joint shown. Joints shall be located at the edge of a traffic lane.

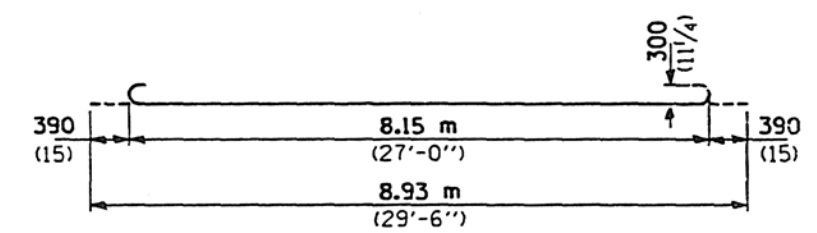

**No. 30 a BARS (No. 9)**

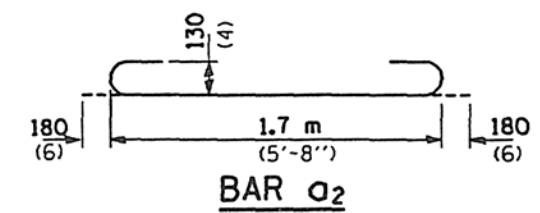

**BAR Ø2**

All dimensions are in millimeters (inches) unless otherwise shown.

**DESIGN STRESSES**  
 $f_y = 400 \text{ MPa (60,000 p.s.i.)}$   
 $f'_c = 24 \text{ MPa (3,500 p.s.i.)}$   
 $n = 8.5$

**BRIDGE APPROACH PAVEMENT**

(Sheet 3 of 3)


**STANDARD 420401-01**

Illinois Department of Transportation

APPROVED January 1, 1998  
*Ralph E. Anderson*  
 ENGINEER OF BRIDGES AND STRUCTURES


APPROVED January 1, 1998  
*Bill Hunter*  
 ENGINEER OF DESIGN AND ENVIRONMENT

ISSUED 1-1-97

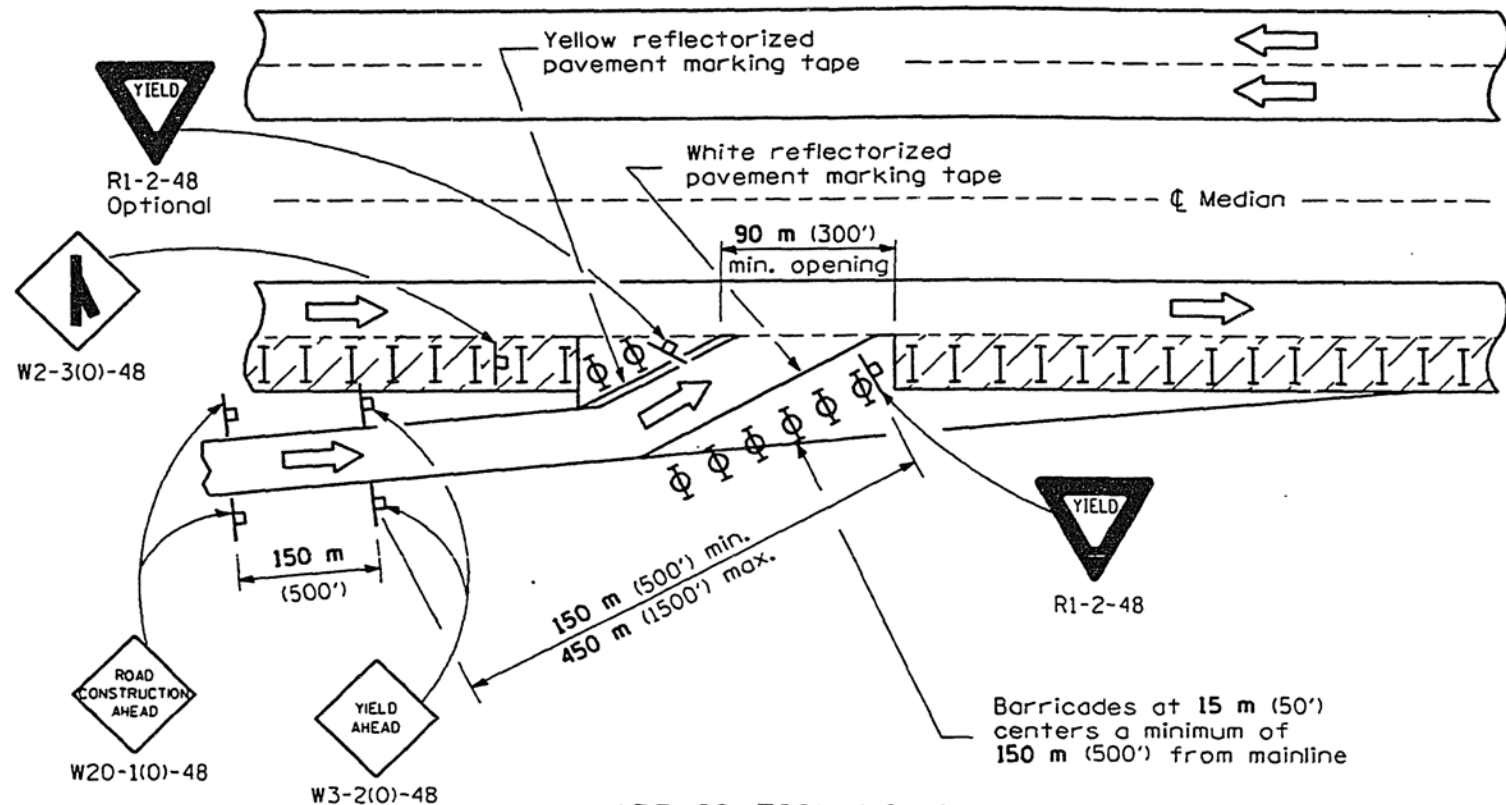


**APPLICATION NO. 1**

Application No. 1 depicts a modified entrance ramp. This method shall be utilized whenever existing entrance tapers cannot be retained due to the close proximity of the work zone. The entrance location may be shifted, with the approval of the Engineer, to perform work in the entrance area. Application No. 2 shall be put into effect as soon as possible.

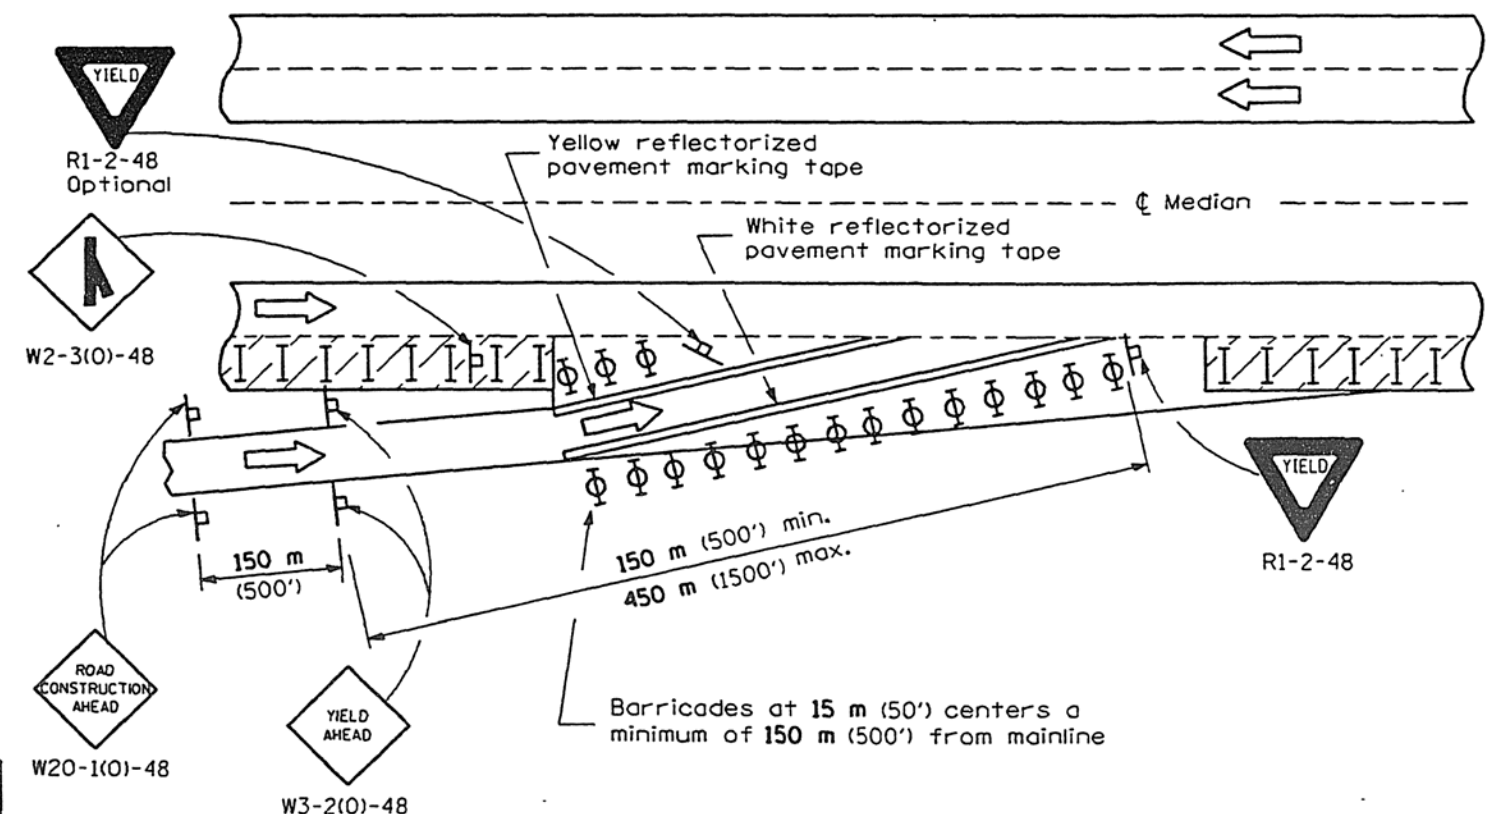

**APPLICATION NO. 2**

Application No. 2 depicts a shortening of the normal entrance ramp. This method shall be used whenever the existing geometric scan be retained. Consideration should be given to the entering motorists' line of sight, through, between, or over the delineation devices.

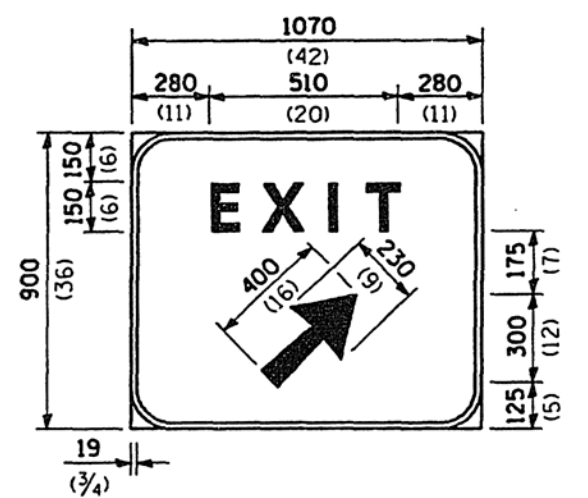

Background - Green  
Border and legend - White  
"D" size letters

**EXIT SIGN - SPECIAL**

**DETAIL A**

(To be utilized where distance between the two rows of channelizing devices is 1.8 m (6') in width.)

**SYMBOLS**

- Work area
- Sign
- Barricade, or drum with steady burning monodirectional light
- Barricade or drums
- Drums with steady burning monodirectional light

**GENERAL NOTES**

This Standard is used where, at any time any vehicle, equipment, workers or their activities require a lane closure in close proximity of an exit or entrance ramp and supplements other traffic control Standards for lane closures.

These applications also apply when work is being performed in the left lanes and the ramps enter and exit on the left. Under these conditions, the Exit sign arrow and the Side road symbol sign shall be changed.

All dimensions are in millimeters (inches) unless otherwise shown.

Illinois Department of Transportation

APPROVED January 1, 1999  
ENGINEER OF OPERATIONS

APPROVED January 1, 1999  
ENGINEER OF DESIGN AND ENVIRONMENT

ISSUED 1-1-99


DATE	REVISIONS
1-1-99	Revised barricade, or drum symbols, added exit sign.
1-1-97	Renum. Standard 2419-2.
	Deleted orange flags.
	Added optn. YIELD sign.

**LANE CLOSURE MULTILANE AT ENTRANCE OR EXIT RAMP FOR SPEEDS ≥ 45 MPH**

(Sheet 1 of 2)


**STANDARD 701411-01**



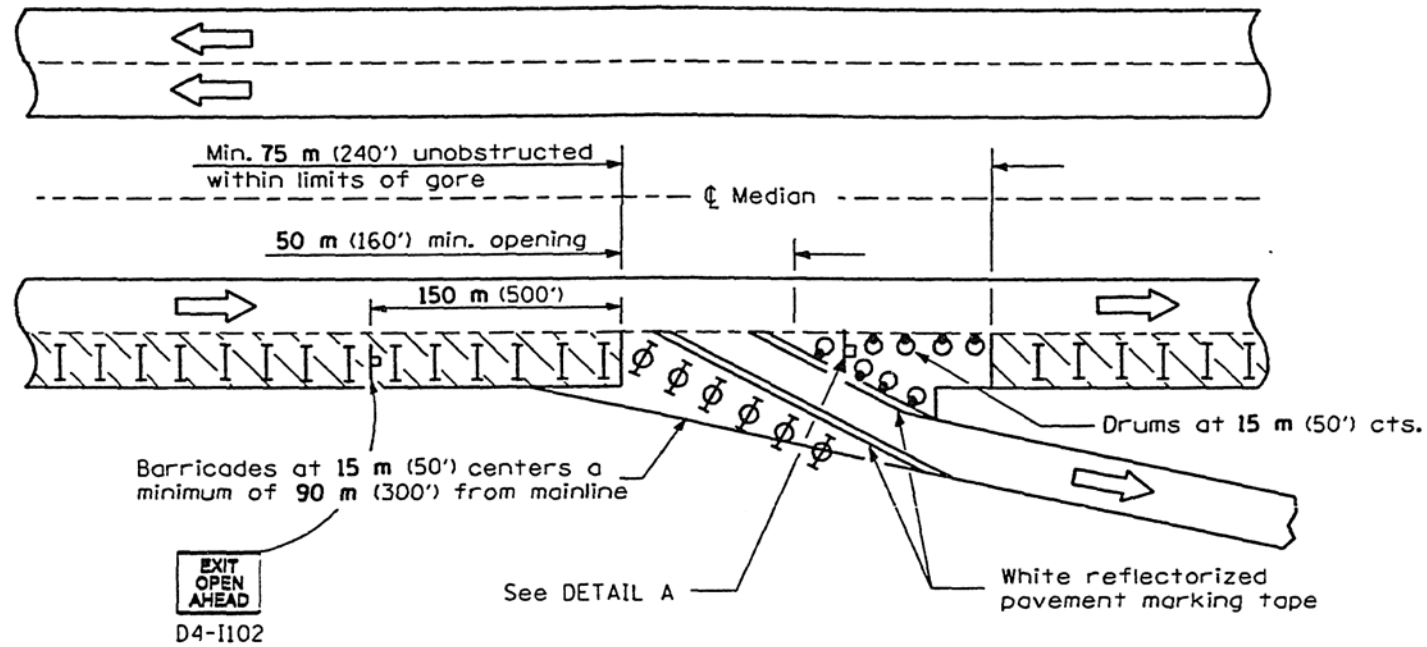

### APPLICATION NO. 3

Application No. 3 depicts a modified exit ramp. The channelizing devices shall provide a clearly defined path for the exiting motorists. The minimum dimensions shown shall be increased as soon as the progress of the work will permit. The open portion of the ramp may be shifted, with the approval of the Engineer, to perform work in stages on the area adjacent to the ramp exit. Application No. 4 shall be put into effect as soon as possible.

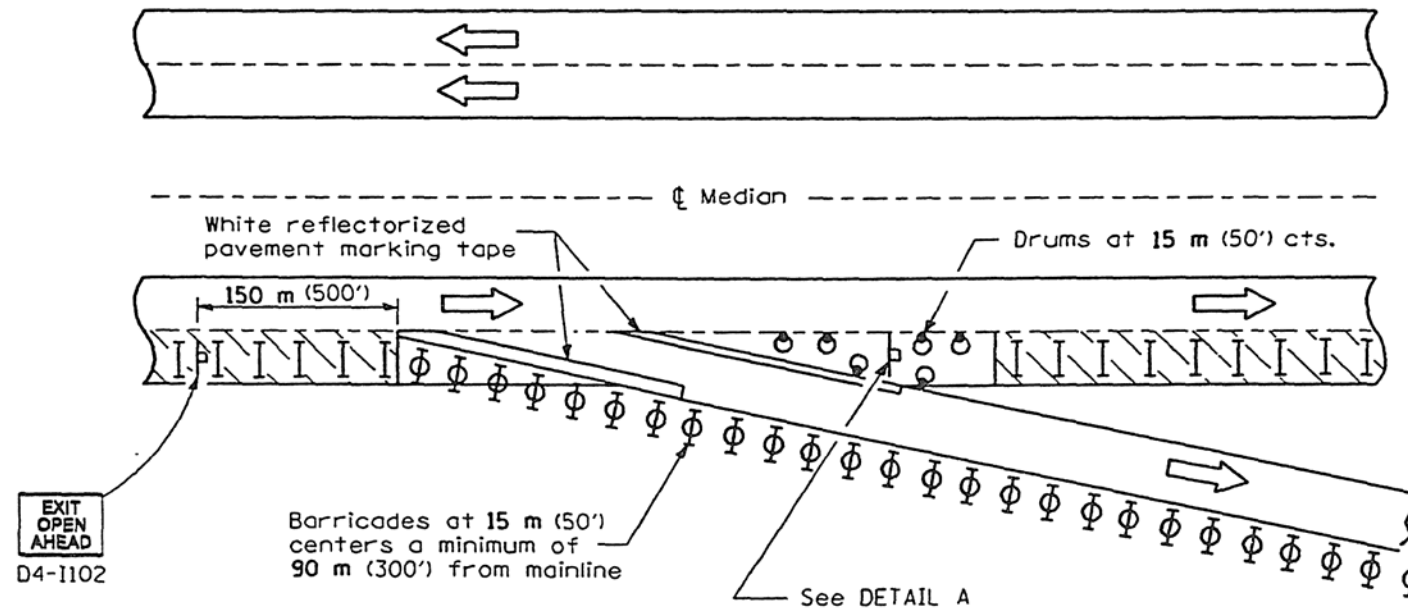

### APPLICATION NO. 4

Application No. 4 depicts an extension of the normal exit ramp. This method shall be used whenever existing geometrics can be retained. Consideration should be given to the exiting motorist's line of sight through, between or over the delineation devices.


All dimensions are in millimeters (inches) unless otherwise shown.

LANE CLOSURE MULTILANE  
AT ENTRANCE OR EXIT RAMP  
FOR SPEEDS  $\geq$  45 MPH

(Sheet 2 of 2)

STANDARD 701411-01

Illinois Department of Transportation	
APPROVED <u>January 1, 1999</u>  ENGINEER OF OPERATIONS	ISSUED 1-1-97
APPROVED <u>January 1, 1999</u>  ENGINEER OF DESIGN AND ENVIRONMENT	

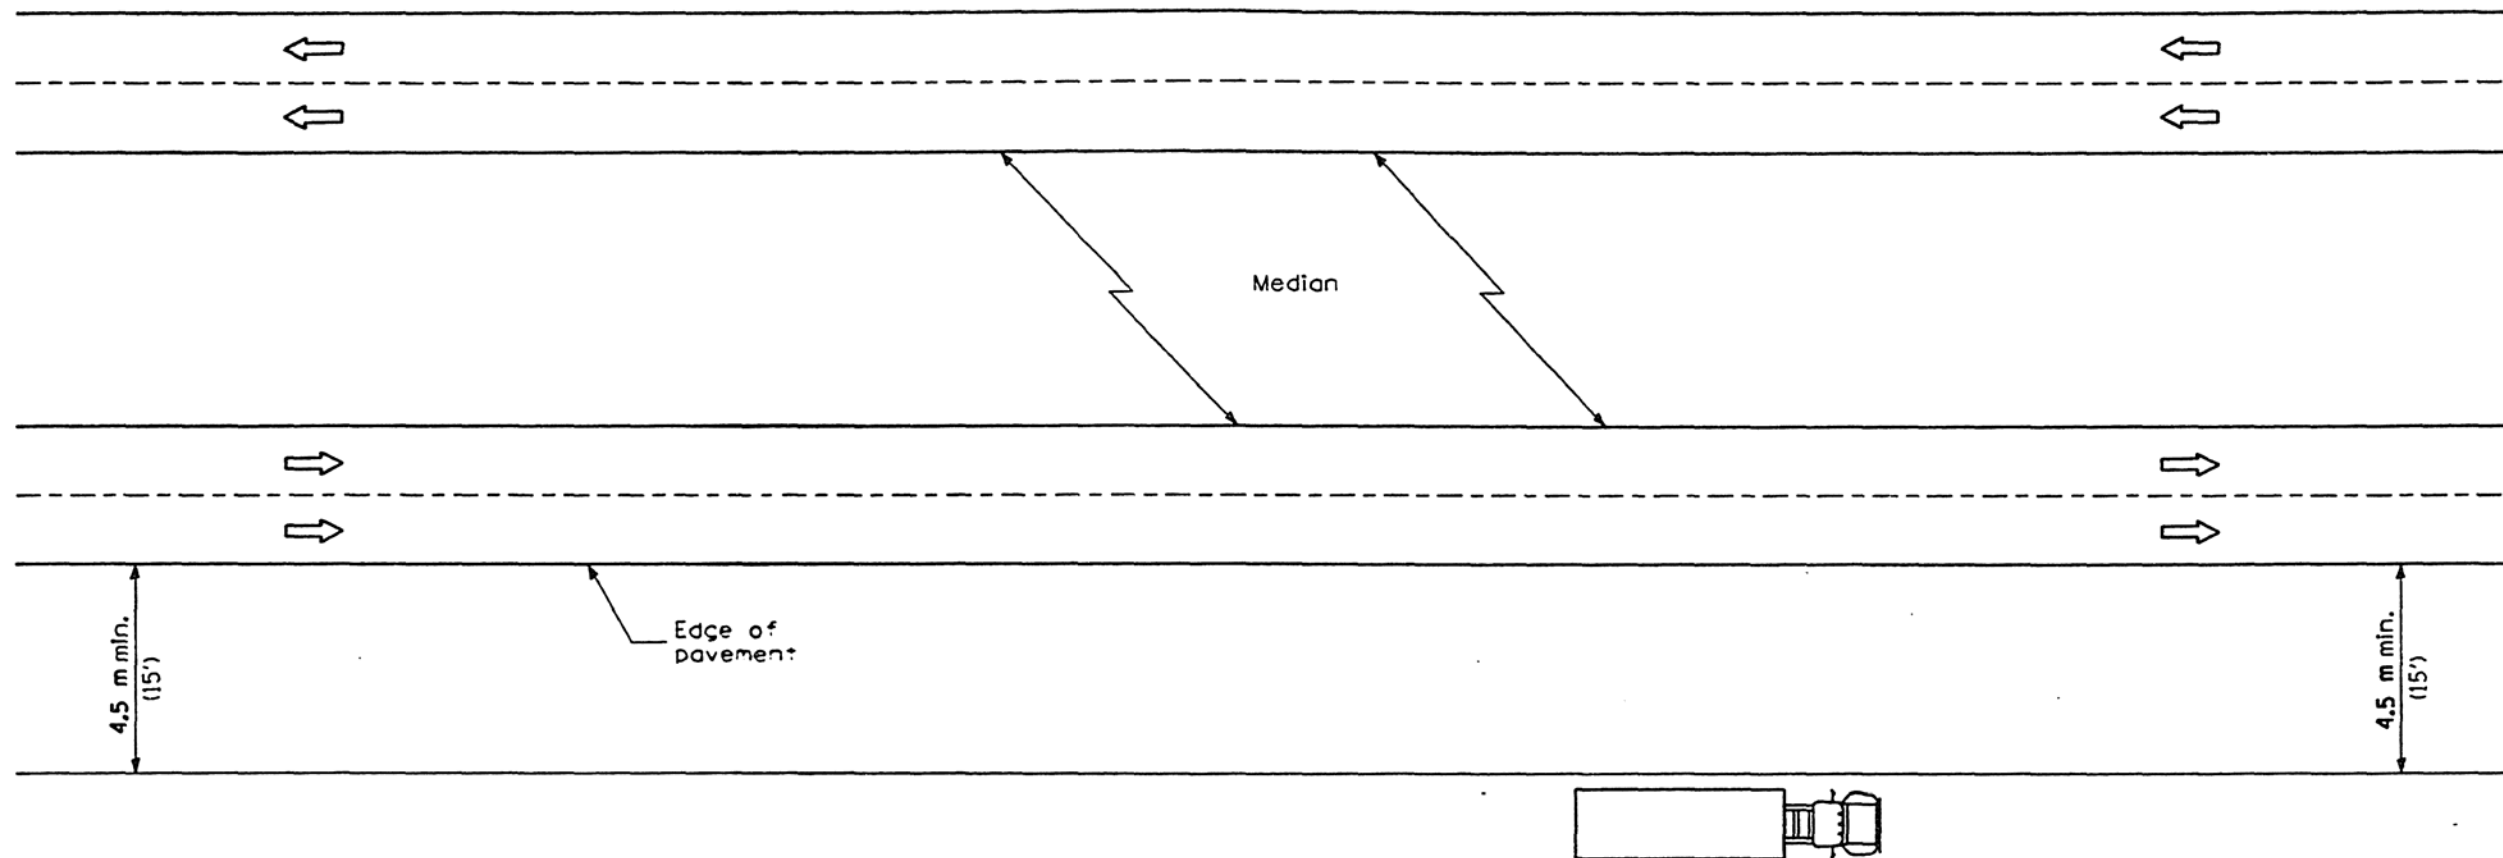

### TYPICAL APPLICATIONS

- Landscaping work
- Utility work
- Fencing contracts

### GENERAL NOTES

This Standard is used where at all times all vehicles, equipment, workers or their activities are more than 4.5 m (15') from the edge of pavement.

If the work operation requires that two or more work vehicles cross the 4.5 m (15') clear zone in any one hour, traffic control will be in conformance with Standard 701101.

This Standard also applies to work performed in the median more than 4.5 m (15') from either pavement.

All dimensions are in millimeters (inches) unless otherwise shown.

Illinois Department of Transportation

APPROVED January 1, 1997

ENGINEER OF OPERATIONS *R. W. Jones*

APPROVED January 1, 1997

ENGINEER OF DESIGN AND ENVIRONMENT *J. J. Gabel*


ISSUED 1-1-97

DATE	REVISIONS
1-1-97	Renum. Standard 2313-6.
2-1-95	Revised title.
	Deleted G.N. #1.
	Added metric.


OFF-RD OPERATIONS, MULTILANE  
MORE THAN 4.5 m (15') AWAY  
FOR SPEEDS  $\geq$  45 MPH

**STANDARD 701106**




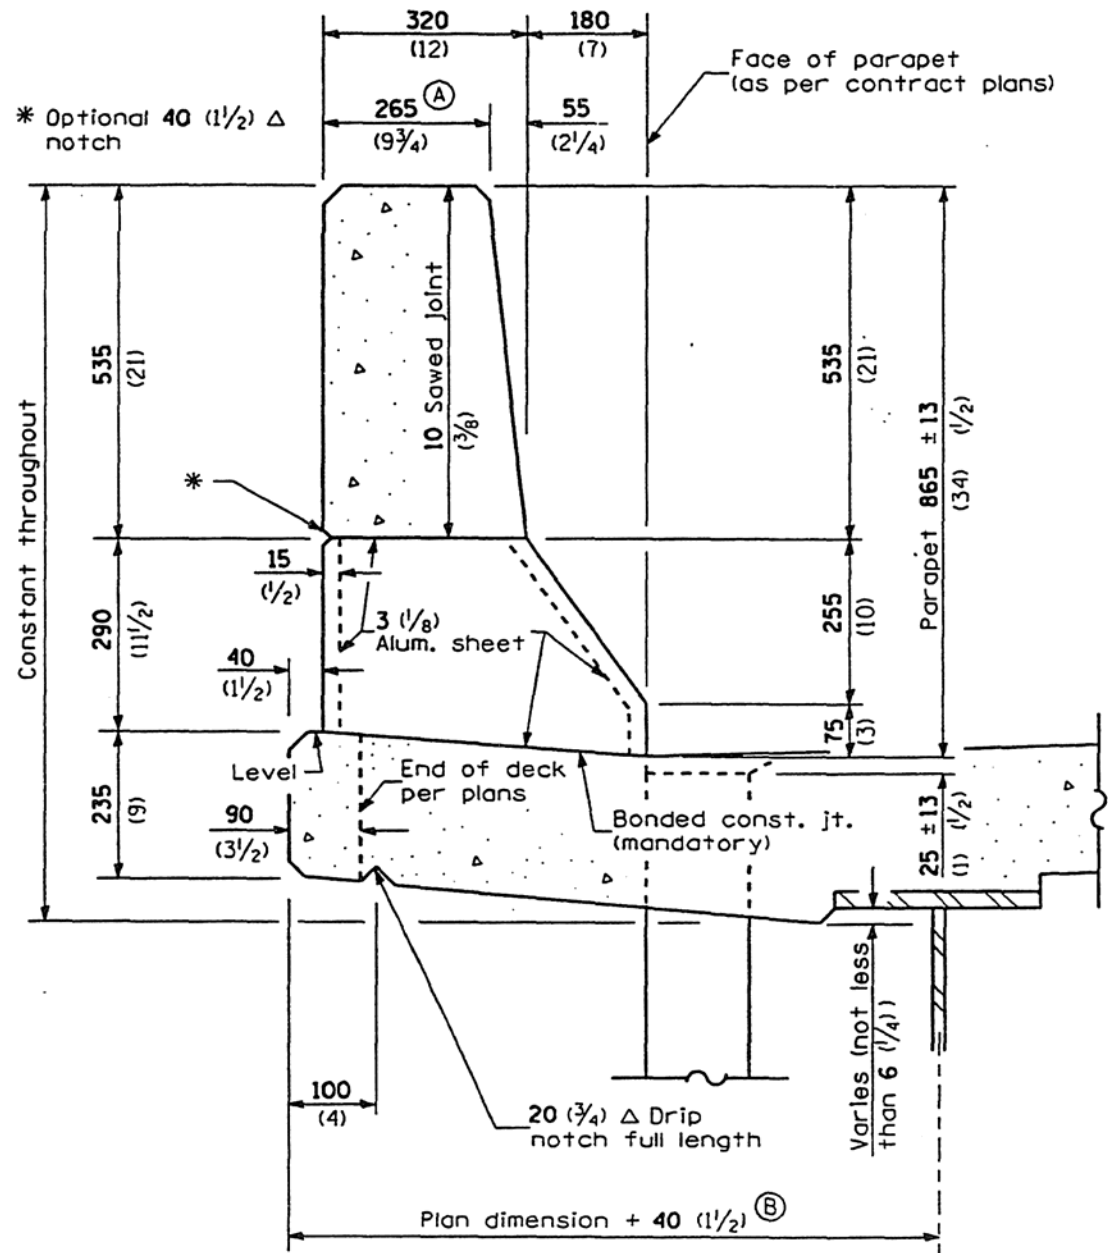


**SECTION**  
(Showing dimensions)

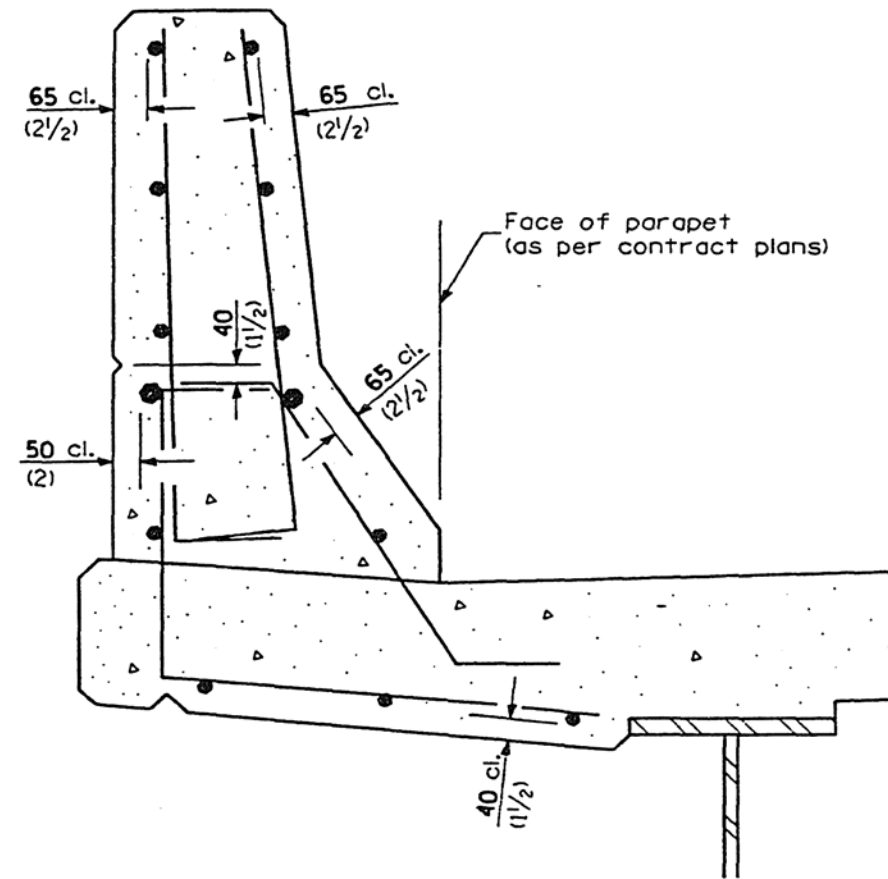

**SECTION**  
(Showing contract reinforcement)

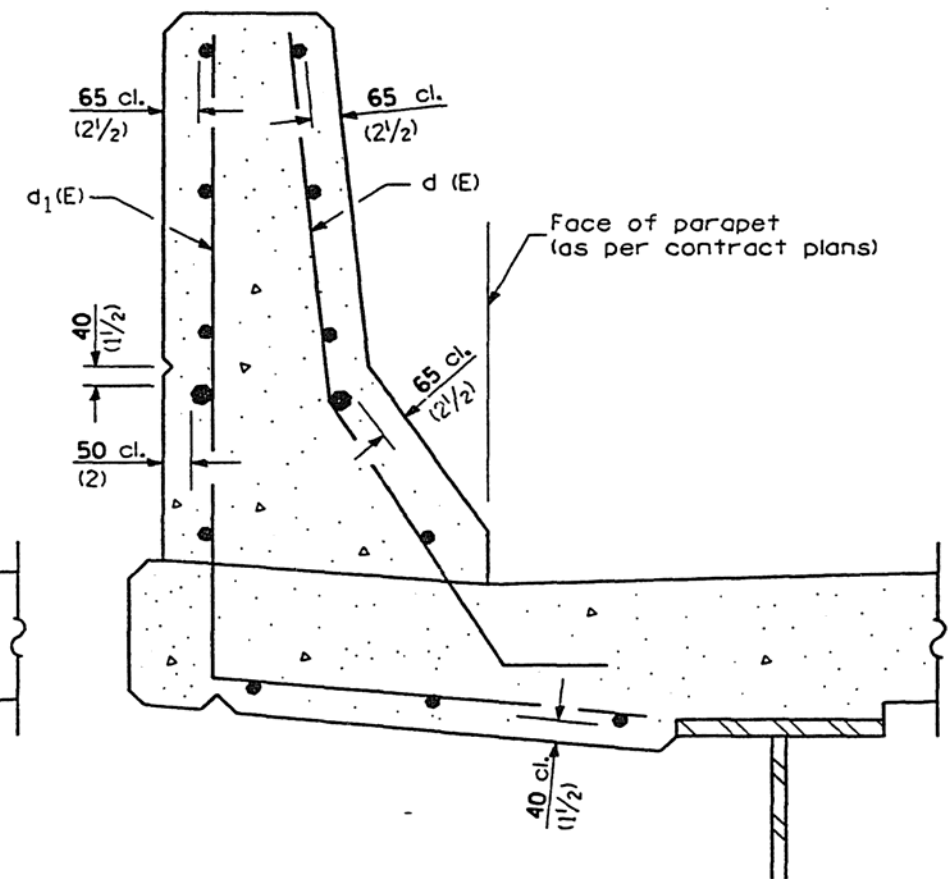

**SECTION**  
(Showing alternate reinforcement)

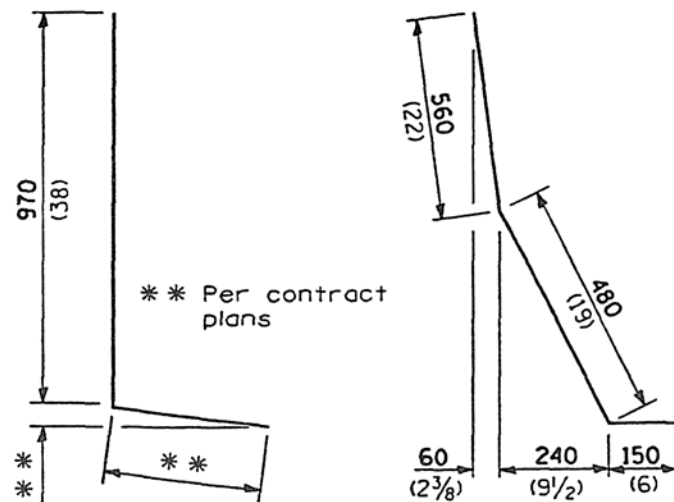

**BAR d<sub>1</sub>(E)**      **BAR d(E)**  
(Alternate reinforcement details)

**GENERAL NOTES**

All bars sizes, spacings, clearances and details are as per contract plans except for clearances in parapet.

All dimensions shall remain the same as shown on contract plans, except dimensions A and B which are to be revised as shown to allow for the 65 mm (2 1/2") bar clearance. Additional concrete needed to revise dimension A and B = 0.0480 m<sup>3</sup>/m (.0165 cu. yds./ft.) of parapet.

All dimensions are in millimeters (inches) unless otherwise shown.

DATE	REVISIONS
1-1-97	Renum. Standard 2452.
	Deleted DN Symbol.
11-1-94	New Standard.

**CONCRETE PARAPET  
SLIP-FORMING OPTION**


**STANDARD 503001**

Illinois Department of Transportation


APPROVED January 1, 1997  
*Ralph E. Anderson*  
ENGINEER OF BRIDGES AND STRUCTURES

ISSUED 1-1-97


APPROVED January 1, 1997  
*Henry Stodd*  
ENGINEER OF DESIGN AND ENVIRONMENT

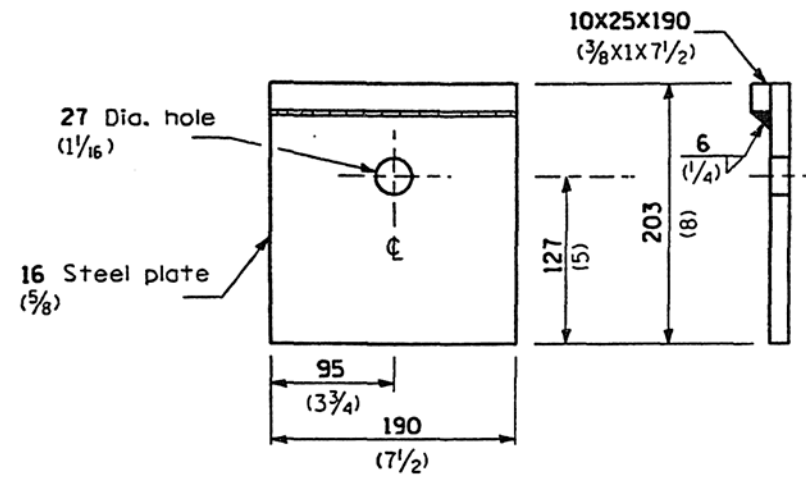


**BEARING PLATE K**

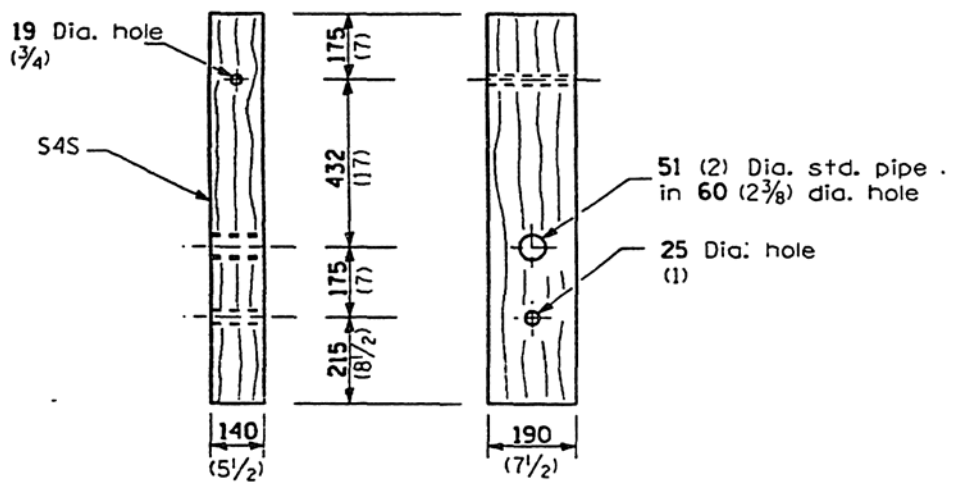


**WOOD POST**

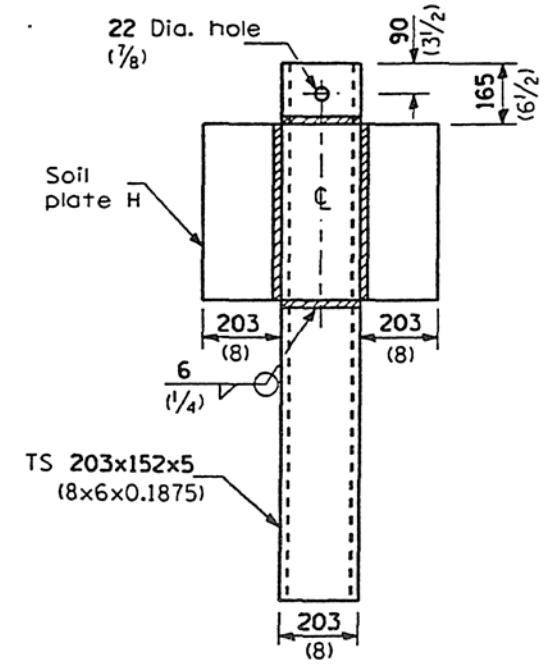


**ALTERNATE SOIL PLATE CONNECTION**

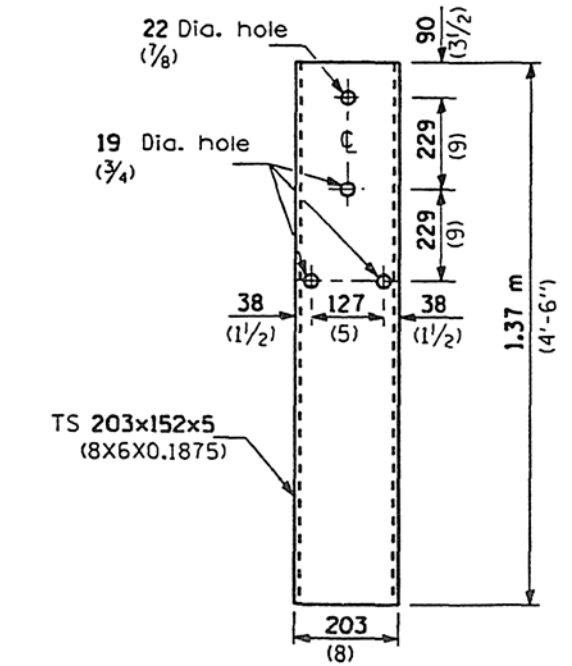


**STEEL TUBE**

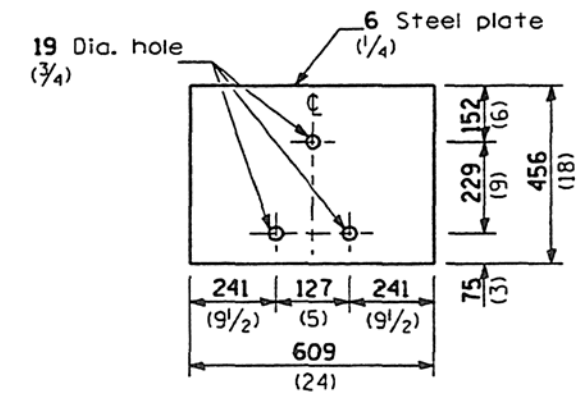

**SOIL PLATE H**

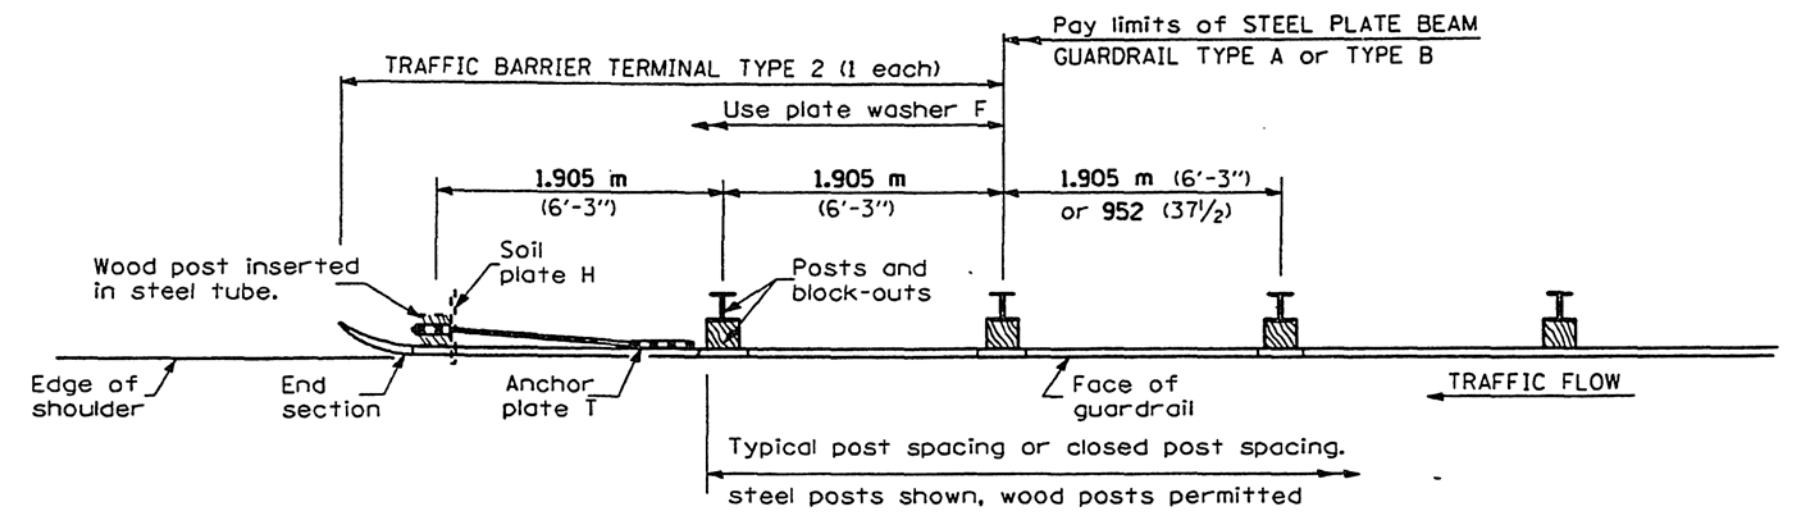

**PLAN**

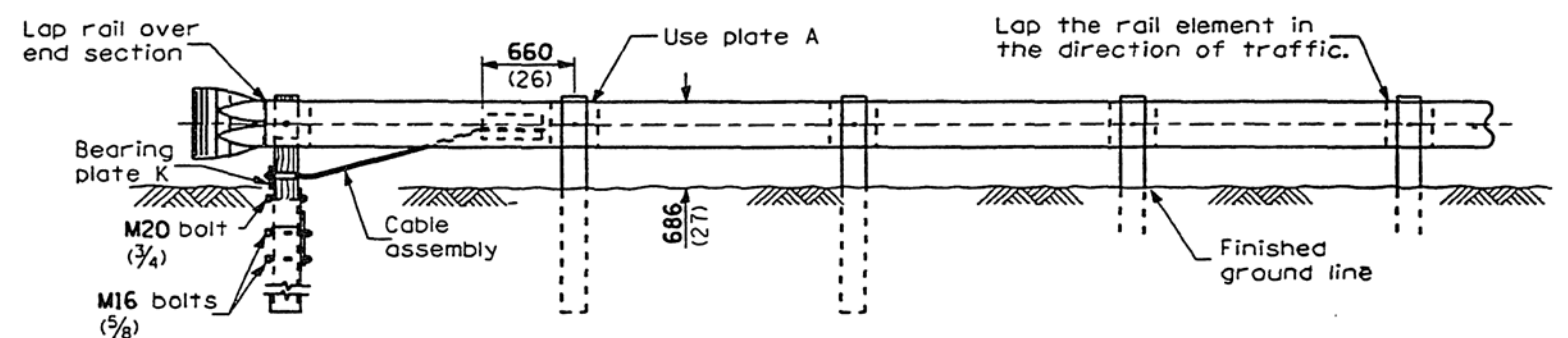

**ELEVATION**

**GENERAL NOTES**

- See Standard 630001 for details of guardrail not shown.
- Use plate washer F at all posts.
- The bearing plate K shall be held in position by (2) two eight penny nails driven into the post and bent over the top of the plate.
- All dimensions are in millimeters (inches) unless otherwise shown.

DATE	REVISIONS
10-1-98	Revised to wooden block-out.
1-1-97	Renum. Standard 2337-3.
	Deleted DN Symbol.

**TRAFFIC BARRIER TERMINAL TYPE 2**

**STANDARD 631011-01**

Illinois Department of Transportation

PASSED October 1, 1998

Charles Kallflein  
ENGINEER OF POLICY AND PROCEDURES

APPROVED October 1, 1998

Bill Swales  
ENGINEER OF DESIGN AND ENVIRONMENT

ISSUED 1-1-98