			CONSTRUCTION CODES									
					PAR	TICIPATI	NG URBAN	& RURAL	FUNDING	NON - PART		
		SUMMARY OF QUANTITIES				100% LOCAL						
SPECIALTY I TEM	CODE NO.	ITEM	UNIT	TOTAL QUANTITY	NEW ROAD 0001	ROAD RECON 0004	NEW BRIDGE 0008	SAFETY 0021	**SAFETY 0021	PUBLIC AGENCY		
*	78009000	MODIFIED URETHANE PAVEMENT MARKING - LETTERS AND SYMBOLS	SQ FT	1,154				1,154				
*	78009004	MODIFIED URETHANE PAVEMENT MARKING - LINE 4"	FOOT	19,563				19,563				
•	78009006	MODIFIED URETHANE PAVEMENT MARKING - LINE 6"	FOOT	4,260				4,260				
*	78009008	MODIFIED URETHANE PAVEMENT MARKING - LINE 8"	FOOT	971				971				
*	78009012	MODIFIED URETHANE PAVEMENT MARKING - LINE 12"	FOOT	1,537				1,537				
•	78009024	MODIFIED URETHANE PAVEMENT MARKING - LINE 24"	FOOT	569				569				
*	78100100	RAISED REFLECTIVE PAVEMENT MARKER	EACH	14				14				
*	78200005	GUARDRAIL REFLECTORS, TYPE A	EACH	14				14				
*	80400100	ELECTRIC SERVICE INSTALLATION	EACH	2				2				
*	80400200	ELECTRIC UTILITY SERVICE CONNECTION	L SUM	1				1				
*	81028200	UNDERGROUND CONDUIT, GALVANIZED STEEL, 2" DIA.	FOOT	1,566				1,240	326			
*	81028210	UNDERGROUND CONDUIT, GALVANIZED STEEL, 2 1/2" DIA.	FOOT	95				95				
*	81028220	UNDERGROUND CONDUIT, GALVANIZED STEEL, 3" DIA.	FOOT	396				379	17			
	81028240	UNDERGROUND CONDUIT, GALVANIZED STEEL, 4" DIA.	FOOT	1,137				1,137				
	81028340	UNDERGROUND CONDUIT, PVC, 1 1/2" DIA.	FOOT	125				125				
*	81028380	UNDERGROUND CONDUIT, PVC, 3 1/2" DIA.	FOOT	290				290				
•	81028740	UNDERGROUND CONDUIT, COILABLE NONMETALLIC CONDUIT, 1 1/2" DIA.	FOOT	760				760				
*	81028750	UNDERGROUND CONDUIT, COILABLE NONMETALLIC CONDUIT, 2" DIA.	FOOT	210				210				
*	81028770	UNDERGROUND CONDUIT, COILABLE NONMETALLIC CONDUIT, 3" DIA.	FOOT	210				210				



USER NAME = Ed Davis	DESIGNED	-	JMS/PFR	REVISED	- /1	4/15/2020
	DRAWN	-	PFR	REVISED	-	
PLOT SCALE = 2.0000 '/ in.	CHECKED	-	KDF	REVISED	-	
PLOT DATE = 4/15/2020	DATE	_	01/13/2020	REVISED	_	

STATI	E OI	FILLINOIS
DEPARTMENT	0F	TRANSPORTATION

SCALE: NTS

	SUMMARY OF QUANTITIES						F.A.U. RTE.	SECTION	COUNTY	TOTAL SHEETS	SHEET NO.
							2298	18-00215-21-BR	KANE	415	13
									CONTRACT	NO.	61G02
	SHEET 9	OF	20	SHEETS	STA.	TO STA.		ILLINOIS FED. A	ID PROJECT		

							CONSTRU	JCTION C	ODES	
					PAR	TICIPATI	NG URBAN	& RURAL	FUNDING	NON - PART
		SUMMARY OF QUANTITIES				STU (759	%/25%),	STR (80%	/ 20%)	100% LOCAL
SPECIALTY ITEM	CODE NO.	ITEM	UNIT	TOTAL QUANTITY	NEW ROAD 0001	ROAD RECON 0004	NEW BRIDGE 0008	SAFETY 0021	**SAFETY 0021	PUBLIC AGENCY
*	87301225	ELECTRIC CABLE IN CONDUIT, SIGNAL NO. 14 3C	FOOT	2,944				1,326	1,618	
*	87301245	ELECTRIC CABLE IN CONDUIT, SIGNAL NO. 14 5C	FOOT	5,892				3,736	2,156	
*	87301255	ELECTRIC CABLE IN CONDUIT, SIGNAL NO. 14 7C	FOOT	4,445				938	3,507	
*	87301305	ELECTRIC CABLE IN CONDUIT, LEAD-IN, NO. 14 1 PAIR	FOOT	9,720				3,905	5,815	
*	87301805	ELECTRIC CABLE IN CONDUIT, SERVICE, NO. 6 2 C	FOOT	107				30	77	
*	87301815	ELECTRIC CABLE IN CONDUIT, SERVICE, NO. 6 3 C	FOOT	754				754		
*	87301900	ELECTRIC CABLE IN CONDUIT, EQUIPMENT GROUNDING CONDUCTOR, NO. 6 1C	FOOT	3,031				1,488	1,543	
*	87502440	TRAFFIC SIGNAL POST, GALVANIZED STEEL 10 FT.	EACH	2					2	
*	87502500	TRAFFIC SIGNAL POST, GALVANIZED STEEL 16 FT.	EACH	7				4	3	
*	87702197	STEEL COMBINATION MAST ARM ASSEMBLY AND POLE WITH DUAL MAST ARMS, 16 FT. AND 44 FT.	EACH	1					1	
*	87702203	STEEL COMBINATION MAST ARM ASSEMBLY AND POLE WITH DUAL MAST ARMS, 18 FT. AND 46 FT.	EACH	1					1	
*	87702289	STEEL MAST ARM ASSEMBLY AND POLE WITH DUAL MAST ARMS, 58 FT. AND 30 FT. STEEL MAST ARM ASSEMBLY AND POLE WITH DUAL MAST ARMS, 22 FT. AND 60 FT.	EACH	1					1	
*	87702930	STEEL COMBINATION MAST ARM ASSEMBLY AND POLE 40 FT.	EACH	1				1		
*	87702960	STEEL COMBINATION MAST ARM ASSEMBLY AND POLE 46 FT.	EACH	1					1	
*	87702980	STEEL COMBINATION MAST ARM ASSEMBLY AND POLE 50 FT.	EACH	1				1		
*	87702990	STEEL COMBINATION MAST ARM ASSEMBLY AND POLE 54 FT.	EACH	2				2		
*	87800100	CONCRETE FOUNDATION, TYPE A	FOOT	20				16	4	
*	87800150	CONCRETE FOUNDATION, TYPE C	FOOT	4				4		
*	87800415	CONCRETE FOUNDATION, TYPE E 36-INCH DIAMETER	FOOT	58				58		



USER NAME = Jeff Sedig	DESIGNED	-	JMS/PFR	REVISED	- /i\	4/15/2020
	DRAWN	-	PFR	REVISED	-	
PLOT SCALE = 2.0000 '/ in.	CHECKED	-	KDF	REVISED	-	
PLOT DATE = 4/16/2020	DATE	-	01/13/2020	REVISED	_	

STATI	E OI	F ILLINOIS
DEPARTMENT	0F	TRANSPORTATION

		F.A.U. RTE.	SECTION	COUNTY	SHEETS	SHEET NO.				
	รบ	MIMAKY	OF QU	2298	18-00215-21-BR	KANE	415	15		
						CONTRACT	NO.	61G02		
SCALE: NTS	SHEET 11	0F 20	SHEETS	STA.	TO STA.		ILLINOIS FED. AI	D PROJECT		
	SCALE: NTS						SUMMARY OF QUANTITIES RTE. 2298	SUMMARY OF QUANTITIES RTE. SECTION 2298 18-00215-21-BR	SUMMARY OF QUANTITIES RTE. SECTION COUNTY	SUMMARY OF QUANTITIES RTE. SECTION COUNTY SHEETS 2298 18-00215-21-BR KANE 415 CONTRACT NO.

							CONSTR	JCTION C	ODES	
			PAR	TICIPATI	NG URBAN	I & RURAL	. FUNDING	NON - PART		
		SUMMARY OF QUANTITIES				STU (75	%/25%),	STR (80%		100% LOCAL
SPECIALTY ITEM	CODE NO.	ITEM	UNIT	TOTAL QUANTITY	NEW ROAD 0001	ROAD RECON 0004	NEW BRIDGE 0008	SAFETY 0021	**SAFETY 0021	PUBLIC AGENCY
*	87800420	CONCRETE FOUNDATION, TYPE E 42-INCH DIAMETER	FOOT	22					22	
*	88030020	SIGNAL HEAD, LED, 1-FACE, 3-SECTION, MAST-ARM MOUNTED	EACH	19				11	8	
*	88030050	SIGNAL HEAD, LED, 1-FACE, 3-SECTION, BRACKET MOUNTED	EACH	3				2	1	
*	88030070	SIGNAL HEAD, LED, 1-FACE, 4-SECTION, BRACKET MOUNTED	EACH	7				7		
*	88030080	SIGNAL HEAD, LED, 1-FACE, 4-SECTION, MAST ARM MOUNTED	EACH	2				2		
*	88030100	SIGNAL HEAD, LED, 1-FACE, 5-SECTION, BRACKET MOUNTED	EACH	3					3	
*	88030110	SIGNAL HEAD, LED, 1-FACE, 5-SECTION, MAST-ARM MOUNTED	EACH	13					13	
*	88102710	PEDESTRIAN SIGNAL HEAD, LED, 1-FACE, BRACKET MOUNTED	EACH	12				4	8	
*	88200110 88200510	TRAFFIC SIGNAL BACKPLATE, LOUVERED	EACH	18		<u></u>		13	18	
*	88500100	INDUCTIVE LOOP DETECTOR	EACH	28				16	12	
*	88600700	PREFORMED DETECTOR LOOP	FOOT	776				436	340	
*	88700090	CONFIRMATION BEACON	EACH	4						4
*	88700200	LIGHT DETECTOR	EACH	8						8
*	88700300	LIGHT DETECTOR AMPLIFIER	EACH	2						2
*	88800100	PEDESTRIAN PUSH-BUTTON	EACH	11				3	8	
	542A0229	PIPE CULVERTS, CLASS A, TYPE 1 24"	FOOT	181	181					
	542A5491	PIPE CULVERTS, CLASS A, TYPE 1 EQUIVALENT ROUND-SIZE 36"	FOOT	118	118					
	542JC036	PIPE CULVERTS, CLASS C 36" (JACKED)	FOOT	47		47				
	550A0340	STORM SEWERS, CLASS A, TYPE 2 12"	FOOT	4,267	3,533	734				



USER NAME = Ed Davis	DESIGNED	-	JMS/PFR	REVISED	- /i	4/15/2020
	DRAWN	-	PFR	REVISED	-	
PLOT SCALE = 2.0000 '/ in.	CHECKED	-	KDF	REVISED	-	
PLOT DATE = 4/15/2020	DATE	-	01/13/2020	REVISED	_	

STATE OI	F ILLINOIS
DEPARTMENT OF	TRANSPORTATION

					RTE.	SECTION	COUNTY	SHEETS	10	
SUMMARY OF QUANTITIES						2298	18-00215-21-BR	KANE	415	
								CONTRACT	NO. 6	510
SCALE: NTS	SHEET 12	0F 20	SHEETS	STA.	TO STA.		ILLINOIS FED. A	ID PROJECT		

							CONSTR	JCTION C	ODES	
					PAR	TICIPATI	NG URBAN	& RURAL	FUNDING	NON - PART
		SUMMARY OF QUANTITIES				STU (759	%/25%),	STR (80%	/20%)	100% LOCAL
SPECIALTY ITEM	CODE NO.	ITEM	TOTAL QUANTITY	NEW ROAD 0001	ROAD RECON 0004	NEW BRIDGE 0008	SAFETY 0021	**SAFETY 0021	PUBLIC AGENCY	
	X0324044	EROSION CONTROL, TEMPORARY PIPE SLOPE DRAIN	EACH	6	6					
*	X0324085	EMERGENCY VEHICLE PRIORITY SYSTEM LINE SENSOR CABLE, NO. 20 3/C	FOOT	817						817
*	X0325476	RADAR VEHICLE DETECTION SYSTEM	EACH	2				1	1	
	X0326447	FORCEMAIN CLEANOUT VAULT	EACH	1		1				
	X0326749	AIR RELEASE VALVE MANHOLE	EACH	1		1				
*	X0326810	WIRELESS COMMUNICATION DEVICE	EACH	2				2		
	X0327036	BIKE PATH REMOVAL	SQ YD	170		170				
	X0327078	REMOVE FIRE HYDRANT AND VALVE ASSEMBLY	EACH	4						4
	X0327369	SANITARY SEWER, DUCTILE IRON, 10"	FOOT	149						149
	X0327583	STAMPED COLORED PORTLAND CEMENT CONCRETE PAVEMENT 10" (JOINTED)	SQ YD	334	334					
*	X0327979	PAVEMENT MARKING REMOVAL - GRINDING	SQ FT	1,227				1,227		
	X0327999	ANTI-GRAFFITI COATING	SQ FT	7,974						7,974
	X1200068	FORCE MAIN BYPASS PUMPING	L SUM	1						1
								<u> </u>		
*	X1400101	NETWORK CONFIGURATION	L SUM	1					· · · · · · · · · · · · · · · · · · ·	
*	X1400081	FULL-ACTUATED CONTROLLER AND TYPE SUPER P CABINET (SPECIAL)	EACH	1		*****			1	
*	X1400107	FULL ACTUATED CONTROLLER AND TYPE SUPER P CABINET	EACH	1					1	\$
*	X1400150	SERVICE INSTALLATION, GROUND MOUNTED, METERED	EACH	2				1	1	
*	X1400238	LUMINAIRE, LED, SPECIAL	EACH	9				9		
	X1700034	FORM LINER TEXTURED SURFACE, SPECIAL	SQ FT	60			60			
	X1700045	REMOVE TEMPORARY CONCRETE BARRIER NO SALVAGE	FOOT	380				380		



USER NAME = Jeff Sedig	DESIGNED	-	JMS/PFR	REVISED	- /1	i\ 4/15/2020
	DRAWN	-	PFR	REVISED	-	
PLOT SCALE = 2.0000 '/ in.	CHECKED	-	KDF	REVISED	-	
PLOT DATE = 4/16/2020	DATE	-	01/13/2020	REVISED	-	

STATE (F ILLINOIS
DEPARTMENT O	TRANSPORTATION

			RTE.	SECTION	COUNTY	SHEETS					
SUMMARY OF QUANTITIES							18-00215-21-BR	KANE	415	20	
								CONTRACT	NO.	61G02	
SCALE: NTS	SHEET 16	0F 20	SHEETS	STA.	TO STA.	ILLINOIS FED. AID PROJECT					

						CONSTIN				
					PAR	TICIPATI	NG URBAN	& RURAL	FUNDING	NON - PART
		SUMMARY OF QUANTITIES				STU (75	%/25%),	STR (80%	/ 20%)	100% LOCAL
SPECIALTY ITEM	CODE NO.	ITEM	UNIT	TOTAL QUANTITY	NEW ROAD 0001	ROAD RECON 0004	NEW BRIDGE 0008	SAFETY 0021	**SAFETY 0021	PUBLIC AGENO
	XX006238	STORM SEWER DUCTILE IRON 15"	FOOT	41	41					
*	XX007251	INTERSECTION VIDEO TRAFFIC MONITORING SYSTEM WITH PTZ CAMERA	EACH	1				1		
*	XX008392	OUTDOOR RATED NETWORK CABLE	FOOT	357				357		
*	XX008453	ETHERNET SWITCH, TYPE 1	EACH	1				1		
*	XX008454	ETHERNET SWITCH, TYPE 2	EACH	1				1		
	XX008829	REMOVAL AND DISPOSAL OF EXISTING FORCE MAIN	FOOT	260						260
*	XX008865	PERMEABLE PLASTIC BERM	FOOT	3,350	3,003	347				
*	XX008963	THREE CELL FABRIC INNERDUCT	FOOT	4,329				4,329		
*	XX009297	LUMINAIRE, LED, HORIZONTAL MOUNT, SPECIAL	EACH	4				4		
	Z0012193	BRIDGE DECK THIN POLYMER OVERLAY 3/8"	SQ YD	800			800			
	Z0013796	SEDIMENT CONTROL, STABILIZED CONSTRUCTION ENTRANCE	SQ YD	667		667				
	Z0013798	CONSTRUCTION LAYOUT	L SUM	1	1					
	Z0018000	DRAINAGE SCUPPERS (SPECIAL)	EACH	2			2			
	Z0018004	DRAINAGE SCUPPERS, DS-12	EACH	8			8			
	Z0018800	DRAINAGE SYSTEM	L SUM	1			1			
	Z0019600	DUST CONTROL WATERING	UNIT	825	625	200				
*	Z0023202	SEDIMENT CONTROL, DRAINAGE STRUCTURE INLET FILTER CLEANING	EACH	180	158	22				
*	Z0030850	TEMPORARY INFORMATION SIGNING	SQ FT	115				115		
	Z0033040	ELECTRIC SERVICE DISCONNECT, LIGHTING AND TRAFFIC SIGNAL	EACH				<u> </u>		1	



USER NAME = Jeff Sedig	DESIGNED - JMS/PFR	REVISED - 1 4/15/2020
	DRAWN - PFR	REVISED -
PLOT SCALE = 2.0000 '/ in.	CHECKED - KDF	REVISED -
PLOT DATE = 4/16/2020	DATE - 01/13/2020	REVISED -

STATE	OF ILLINOIS	
DEPARTMENT	OF TRANSPORTATIO	N

				F.A.U. RTE.	SECTION	COUNTY	TOTAL SHEETS	SHEET NO.		
SUMMARY OF QUANTITIES							18-00215-21-BR	KANE	415	23
								CONTRACT	NO. (61G02
SCALE: NTS	SHEET 19	0F 20	SHEETS	STA.	TO STA.		ILLINOIS FED. AI	D PROJECT		

CONSTRUCTION CODES

EARTHWORK NOTES:


SCMT

- . THIS PROJECT HAS A LARGE NET EXCESS OF EXCAVATED MATERIALS. THE CONTRACTOR SHALL BE PAID FOR THE HANDLING OF EARTHWORK ONLY ONCE, REGARDLESS OF STAGING OPERATIONS. THE CONTRACOR SHALL BE RESPONSIBLE FOR HIS EARTHWORK OPERATIONS INCLUDING EXCAVATING AND STOCKPILING OF EXCAVATED MATERIALS FOR RE-HANDLING AT A LATER DATE (IF NECESSARY). THIS APPLIES TO ALL EXCAVATED MATERIALS TO BE USED ON SITE OR SURPLUS MATERIAL REMOVED FROM THE SITE.
- 2. A 15% SHRINKAGE FACTOR HAS BEEN APPLIED FOR EARTH EXCAVATION AND TOPSOIL EXCAVATION AND PLACEMENT.
- . AN ENVIRONMENTAL INVESTIGATION HAS BEEN CONDUCTED TO TEST FOR CLEAN CONSTRUCTION AND DEMOLITION DEBRIS (CCDD) COMPATIBILITY. THE INVESTIGATION CONCLUDED THAT ALL SOILS WITHIN THE PROJECT (WITH THE EXCEPTION OF MATERIALS WITHIN THE SOIL MANAGEMENT ZONES SEE MORE INFORMATION ON THIS SHEET) LIKELY MEETS THE PH REQUIREMENTS AS ENFORCED BY THE ILLINOIS ENVIRONMENTAL PROTECTION AGENCIES AND CCDD RECEIVING FACILITIES.
- 4. THE EARTHWORK CALCULATIONS INCLUDE AREA MEASUREMENTS PER CROSS SECTION. EACH MEASUREMENT IS CATEGORIZED BY AN ABBREVIATION IN PARENTHESIS STARTING WITH "C" FOR A CUT MEASUREMENT AND "F" FOR A FILL MEASUREMENT. EACH IS DESCRIBED BELOW:

SUITABLE MATERIAL EXCAVATION VOLUME (C1)	ALL EXCAVATION SUITABLE FOR USE AS ROADWAY EMBANKMENT. A GEOTECHNICAL STUDY INDICATES THAT ALL SOILS THAT ARE NEITHER TOPSOIL, NOR WITHIN UNDERCUT LIMITS ARE ANTICIPATED TO BE SUITABLE.
UNSUITABLE MATERIAL EXCAVATION VOLUME (C2)	EXCAVATION WITHIN UNDERCUT LIMITS. FOR INFORMATION ON THE FILL WITHIN UNDERCUT LIMITS, REFER TO NOTE 5.
ROADWAY EMBANKMENT VOLUME (F1)	EMBANKMENT SUITABLE FOR SUPPORTING THE ROADWAY AND MULTI-USE PATH,
ROADSIDE EMBANKMENT VOLUME (F2)	EMBANKMENT LIMITED TO AREAS NOT APPLICABLE TO ROADWAY EMBANKMENT. ROADSIDE EMBANKMENT MUST NOT BE USED FOR SUPPORTING THE ROADWAY OR MULTI-USE PATH.
ROCK FILL – FOUNDATION VOLUME (F4)	USED BENEATH MECHANICALLY STABILIZED EARTH RETAINING WALLS IN AREAS SPECIFIED IN THE PLANS.

5. EARTHWORK PAY ITEM QUANTITIES ARE DERIVED FROM THE MEASUREMENTS DESCRIBED IN NOTE 4 AND SHOWN IN THE SCHEDULE OF EARTHWORK.

EARTH EXCAVATION	INCLUDES ALL MATERIAL THAT IS EXCAVATED FROM ONSITE AND USED ONSITE AS ROADWAY EMBANKMENT OR ROADSIDE EMBANKMENT, EARTH EXCAVATION SHALL BE IN ACCORDANCE WITH SECTION 202 OF THE 1.D.O.T. STANDARD SPECIFICATIONS.
FURNISHED EXCAVATION	NOT REQUIRED FOR THIS CONTRACT AS SUFFICIENT QUANTITY OF FILL CAN BE FOUND ONSITE.
REMOVAL AND DISPOSAL OF UNSUITABLE MATERIAL	INCLUDES ALL SURPLUS MATERIAL THAT IS EXCAVATED FROM ONSITE AND IS NOT USED AS ONSITE FILL. THIS MATERIAL SHALL BE REMOVED AND DISPOSED OF OFF-SITE IN ACCORDANCE WITH SECTION 202 OF THE I.D.O.T. STANDARD SPECIFICATIONS. THE PLAN QUANTITY IS CALCULATED UNDER THE ASSUMPTION THAT SURPLUS EXCAVATED MATERIAL SHALL BE HANDLED ONE TIME BY THE CONTRACTOR.
AGGREGATE SUBGRADE IMPROVEMENT	APPLICABLE TO UNDERCUT LOCATIONS, EITHER AS SHOWN ON THE CROSS SECTIONS OR AS IDENTIFIED IN THE FIELD. UNDERCUT REPRESENTS LOCATIONS WHERE THE SOILS BELOW THE PROPOSED ROADWAY ARE UNSUITABLE TO SUPPORT THE ROADWAY. UNSUITABLE MATERIALS SHALL BE REMOVED UNTIL SUITABLE MATERIALS ARE ENCOUNTERED, EARTH EXCAVATION (ROADWAY EMBANKMENT) MAY BE SUBSTITUTED AS FILL WITHIN UNDERCUT AREAS WHERE APPROVED BY THE ENGINEER. THE RESIDENT ENGINEER SHALL APPROVE THE UNDERCUT AREAS AND DEPTH TO REMEDY THE UNSUITABLE MATERIALS.
TOPSOIL FURNISH AND PLACE	ALL TOPSOIL FOR THIS PROJECT SHALL BE FURNISHED AND PLACED AT THE DEPTHS INDICATED IN THE PLANS.

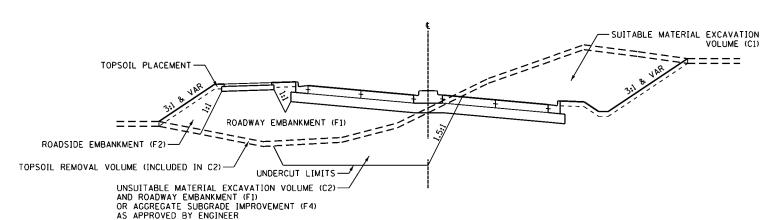


EXAMPLE TYPICAL SECTION FOR EARTHWORK DEFINITIONS

EXAMPLE THICKE DESTROY FOR EARTHWORK DEFINITION

USER NAME = Ed Davis	DESIGNED	-	PFR	REVISED	- /	4/15/2020
	DRAWN	-	PFR	REVISED	-	
PLOT SCALE = 2,0000 ' / in.	CHECKED	-	KDF	REVISED	-	
PLOT DATE = 4/15/2020	DATE	-	01/13/2020	REVISED	-	

STATE OF ILLINOIS DEPARTMENT OF TRANSPORTATION

	EARTHWORK SCHEDULES									F.A.U. RTE.	SEC	TION		COUNTY	TOTAL SHEETS	SHEET NO.
		E	AKII	IWC	JRK SCH	IEDULES	S			2298	18-0021	15-21-BR	:	KANE	415	26
														CONTRACT	NO.	61G02
SCALE: NTS	SHEET	2	0F	2	SHEETS	STA.		TO STA.				ILLINOIS	FED. AII	D PROJECT		

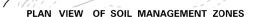

LONGMEADOW PARKWAY

LONGMEADOW STATION	OFFSET 1		OFFSET 2		OFFSET 3		OFFSET 4		OFFSET 5		OFFSET 6	
	OFFSET	BOTTOM ELEV.	OFFSET	BOTTOM ELEV.	OFFSET	BOTTOM ELEV.	OFFSET	BOTTOM ELEV.	OFFSET	BOTTOM ELEV.	OFFSET	BOTTON ELEV.
2227+77.98	52.44' RT	813.47										
2228+00.00	66.73' LT	807.92	31.43' LT	808.00	37.26' RT	810.00	65.93' RT	811.00	81.50' RT	815.21		
2228+22.39	85.58' LT	807.97	50.00' LT	807.90	1.87' LT	808.00	42.11' RT	811.00	70.56' RT	814.00	76.80' RT	814.00
2228+50.00	86.09' LT	808.00	37.52' RT	808.00	78.43' RT	814.87						
2228+75.00	85.65' LT	808.00	51.80' RT	808.00	80.25' RT	810.00	86.12' RT	811.97				
2229+00.00	85.21' LT	808.00	54.62' RT	808.00	75.38' RT	809.00	94.04' RT	810.00				
2229+25.00	84.77' LT	808.00	51.97' RT	808.00	98.92' RT	810.00						
2229+50.00	84.33' LT	808.00	48.62' LT	808.00	29.36' RT	809.00	95.23' RT	809.00	102.11' RT	812.69		
2229+75.00	83.89' LT	808.00	54.45' LT	808.00	27.91' RT	809.00	80.75' RT	809.00	96.63' RT	810.00	105.30' RT	814.3
2230+00.00	83.45' LT	807.14	34.36' LT	808.00	7.25' RT	809.00	21.67' RT	810.00	57.53' RT	816.50	96.93' RT	816.50
2230+25.00	83.01' LT	808.00	75.47' LT	808.00	50.01' LT	812.50	103.14' RT	812.50				
2230+50.00	82.57' LT	814.36	22.97' LT	820.00	24.13' RT	826.00	66.42' RT	825.00	98.50' RT	830.10		
2230+75.00	82.14' LT	825.60	46.83' LT	828.74	11.52' LT	837.23	23.78' RT	839.76	59.09' RT	839.31	94.39' LT	838.4

NON-SPECIAL

WASTE DISPOSAL AREA (IDOT

2669.05 A(5) SOI

NOTE: ALL SOIL WITHIN THE HORIZONTAL LIMITS AND ABOVE THE BOTTOM SURFACE ELEVATION LISTED IN THE TABLE SHALL

BE PROCESSED AS HAZARDOUS WASTE DISPOSAL, AND IT IS QUANTIFIED AS SUCH. TOTAL PLAN QUANTITY WITHIN

THIS LIMIT IS 38,695 CU YD. THIS VOLUME IS ALSO QUANTIFIED IN THIS CONTRACT AS EARTH EXCAVATION.


HAZARDOUS WASTE DISPOSAL AREA (IDOT 669.05 A(6) SOILS) - NOTES


- 1. A SIGNIFICANT NUMBER OF SAMPLES HAVE BEEN COLLECTED FROM WITHIN THE HAZARDOUS WASTE AREA TO CHARACTERIZE THE MATERIAL FOR PROPER DISPOSAL CONSIDERATIONS, CONSISTENT WITH CHARACTERIZATION REQUIREMENTS PROVIDED BY A FIRM THAT CAN HANDLE THE TREATMENT AND DISPOSAL. THIS INFORMATION IS INCLUDED IN TWO WASTE CHARACTERIZATION DOCUMENTS AVAILABLE TO BIDDERS ON FILE WITH KANE COUNTY DIVISION OF TRANSPORTATION.
- THE DESIGN TEAM IDENTIFIED HAZARDOUS LEVELS OF LEAD-IMPACTED SOIL WITHIN THE HAZARDOUS WASTE DISPOSAL AREA. THE ASSUMED OPTION FOR HANDLING AND DISPOSAL OF SPOILS WITHIN THE HAZARDOUS WASTE DISPOSAL AREA INCLUDES EXCAVATION AND TRANSPORT TO AN OFF-SITE FACILITY FOR BATCH TREATMENT TO RENDER THE SPOILS NON-HAZARDOUS AND ULTIMATE DISPOSAL IN A FACILITY THAT ACCEPTS SUCH POST-TREATED SOILS.
- 4. THE COUNTY AND COUNTY ENVIRONMENTAL REPRESENTATIVES WILL BE ON SITE TO MANAGE AND MONITOR OPERATIONS ASSOCIATED WITH THE REMOVAL OF THE HAZARDOUS WASTE TO ENSURE COMPLIANCE WITH AND APPROVAL BY THE IEPA. THE CONTRACTOR IS EXPECTED TO WORK IN COOPERATION WITH THESE INDIVIDUALS. TEMPORARY WELLS MAY BE INSTALLED (BY OTHERS) TO FACILITATE THE MONITORING OF GROUNDWATER QUALITY PRIOR TO AND/OR AFTER THE REMOVAL OF THE HAZARDOUS WASTE. CONTRACTOR SHALL BE AWARE OF AND PROTECT EXISITING GROUNDWATER MONITORING WELLS UNTIL THEY ARE NO LONGER NEEDED, AT WHICH POINT THE CONTRACTOR SHALL REMOVE THE WELLS IF NECESSARY.


NON-SPECIAL WASTE DISPOSAL AREA - IDOT 669.05 A(5) SOILS

THE NON-SPECIAL WASTE DISPOSAL AREA IS FROM STATION 2234+50 TO STATION 2235+75 AND IS BOUND BY THE PROPOSED RIGHT-OF-WAY TO THE NORTH AND THE FORMER EXISTING BOLZ ROAD RIGHT-OF-WAY TO THE SOUTH, ALL EXCAVATED SOIL WITHIN THIS AREA SHALL BE PROCESSED AS NON-SPECIAL WASTE DISPOSAL, AND IT IS QUANTIFIED AS SUCH. TOTAL PLAN QUANTITY WITHIN THIS LIMIT IS 6,191 CU YD. THIS VOLUME IS ALSO QUANTIFIED IN THIS CONTRACT AS EARTH EXCAVATION.

REFER TO THE PROJECT SPECIFICATION FOR REMOVAL AND DISPOSAL OF REGULATED SUBSTANCES FOR MORE INFORMATION INCLUDING WITH REPORTS AVAILABLE TO THE CONTRACTOR PERTAINING TO MATERIALS WITHIN THE HAZARDOUS WASTE DISPOSAL AREA AND THE NON-SPECIAL WASTE DISPOSAL AREA SOIL MANAGEMENT ZONES.

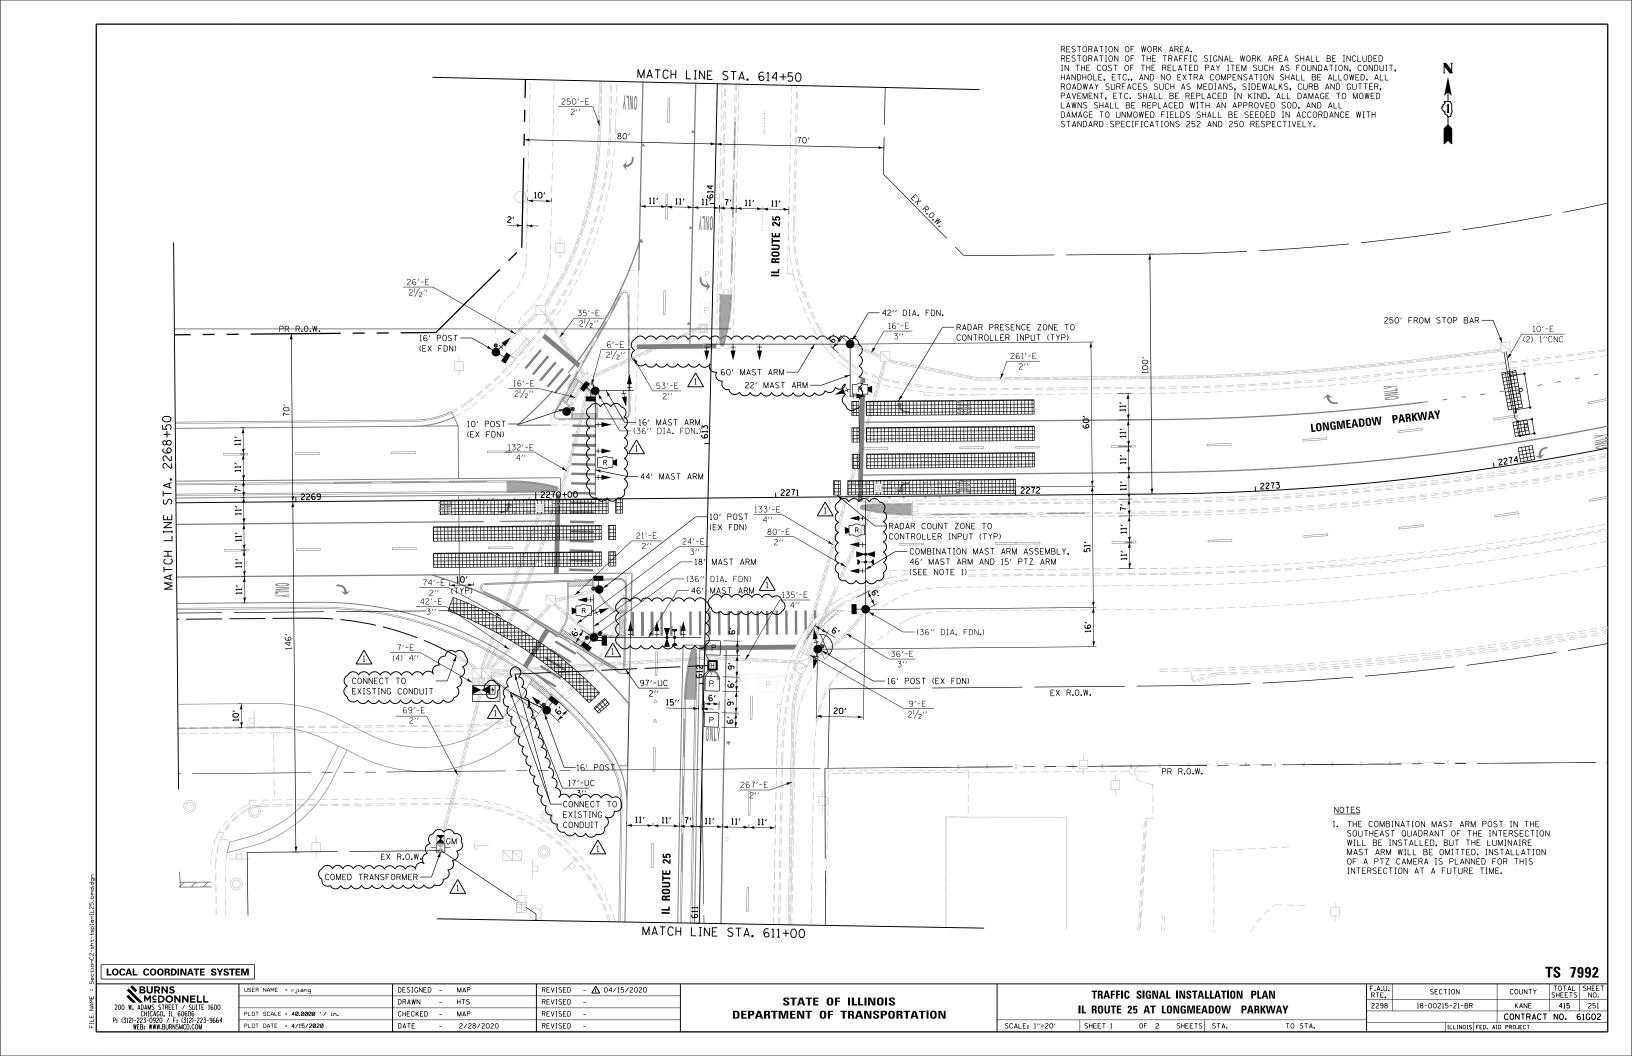

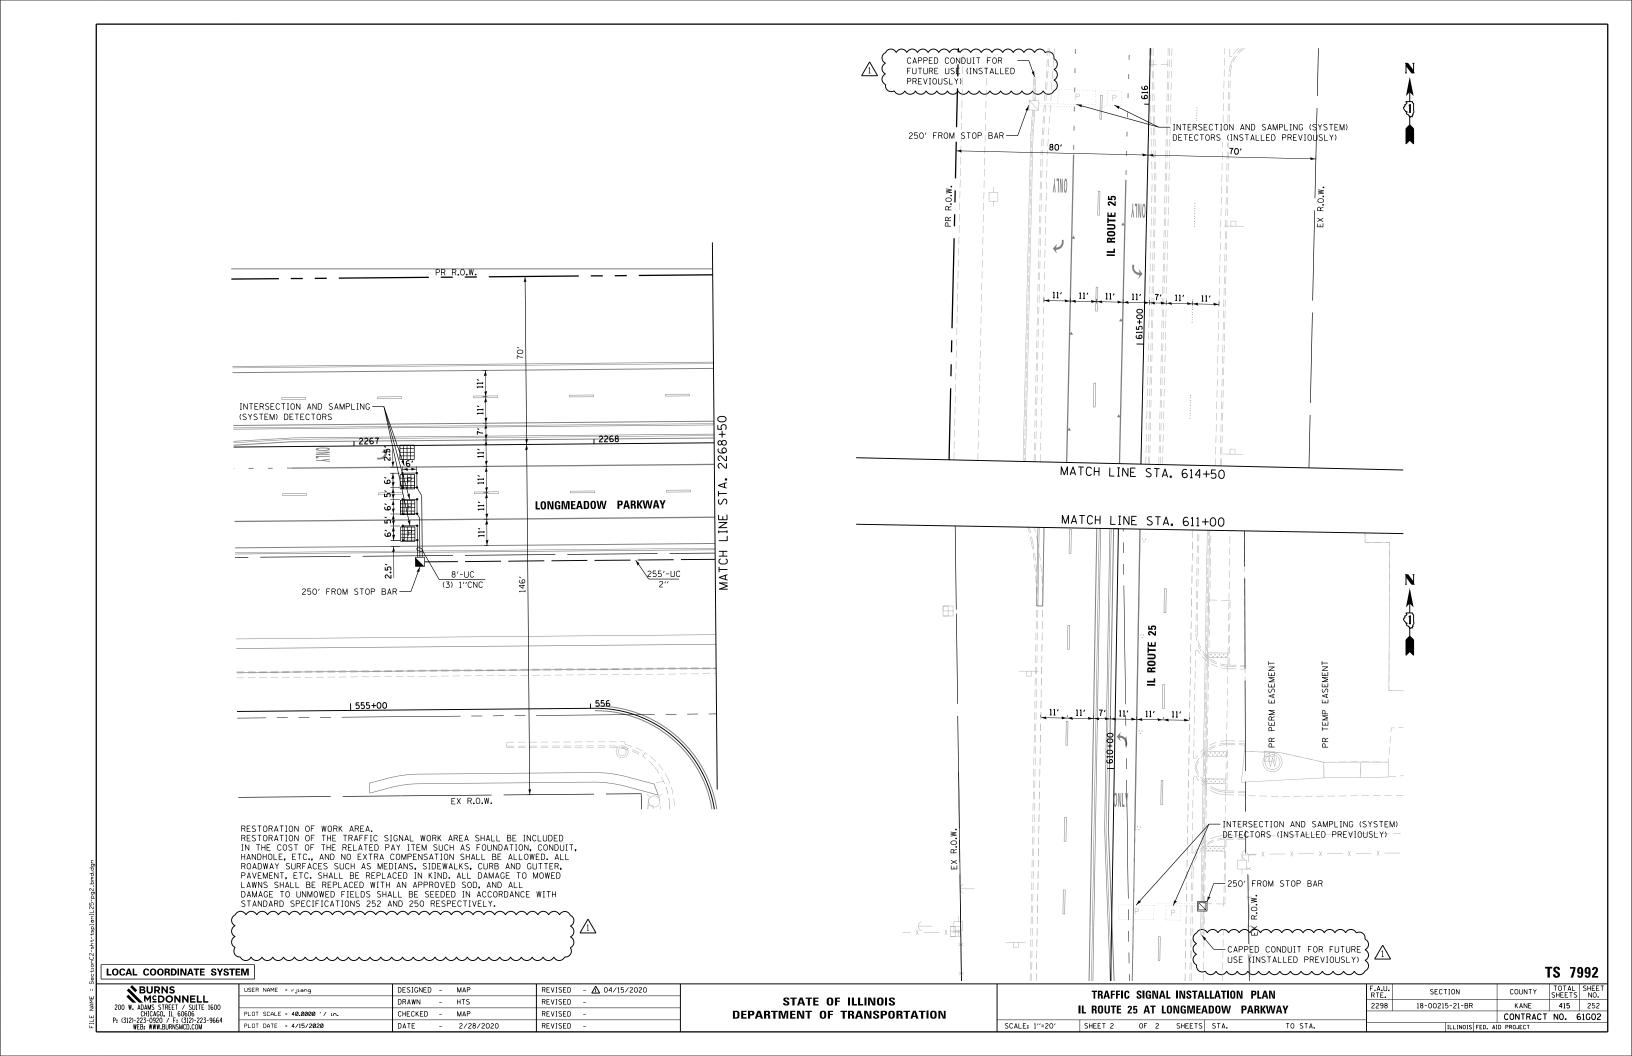

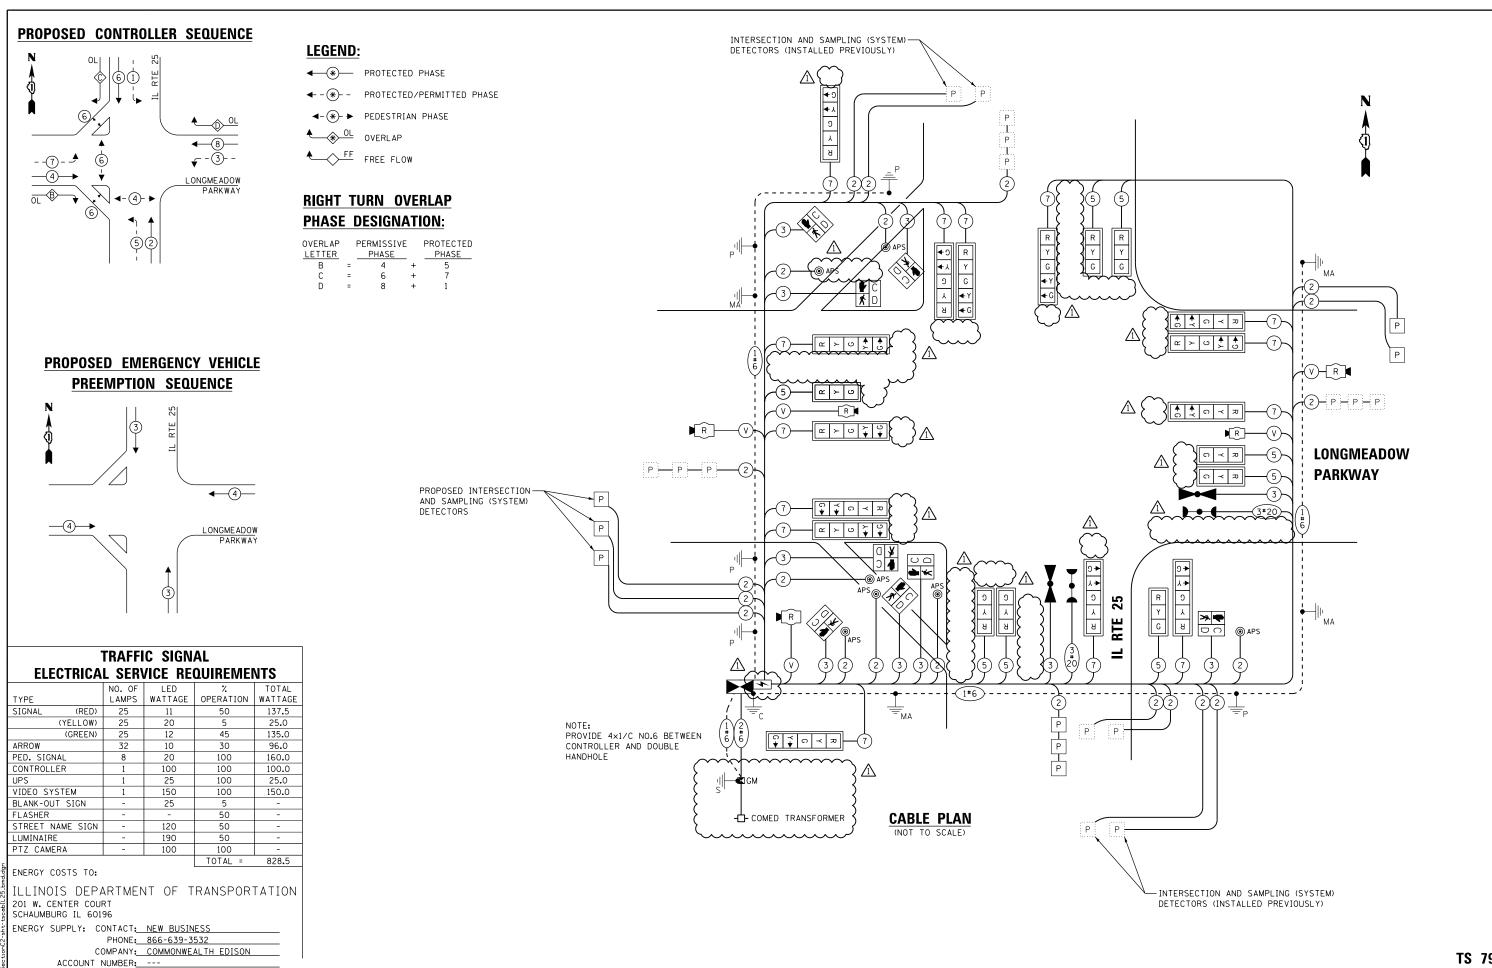

TS 7992

BURNS
MEDONNELL

200 W. ADAMS STREET / SUITE 1600
CHICACO, IL 60606
P: (312)-223-9664
WEB: WWW.BURNSMCD.COM


DESIGNED - MAP REVISED - 🛆 04/15/2020 USER NAME = rjiang DRAWN - HTS REVISED PLOT SCALE = 100.0000 '/ in. CHECKED -MAP REVISED PLOT DATE = 4/15/2020 DATE REVISED 2/28/2020

STATE OF ILLINOIS **DEPARTMENT OF TRANSPORTATION**

SCHEDULE OF QUANTITIES, CABLE PLAN, PHASE DESIGNATION DIAGRAM AND EMERGENCY VEHICLE PREEMPTION SEQUENCE IL ROUTE 25 AT LONGMEADOW PARKWAY SCALE: NONE SHEET 1 OF 1 SHEETS STA.

SECTION COUNTY KANE 415 253 2298 18-00215-21-BR CONTRACT NO. 61G02


SUMMARY OF QUANTITIES

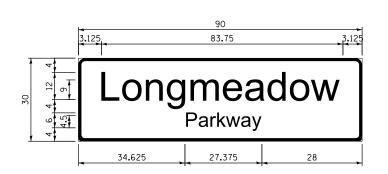

DESIGN	AREA	SIGN PANEL	SHEETING	QTY.
SERIES	(SQ FT)	TYPE	TYPE	REQUIRED
С	18.75	2	ZZ	2

SIGN PANELS - TYPE 1 OR TYPE 2

STYLE (e) PER IDOT STD 720016-04

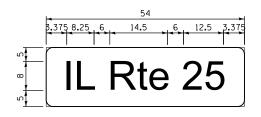

DESIGN	AREA	SIGN PANEL	SHEETING	QTY.
SERIES	(SQ FT)	TYPE	TYPE	REQUIRED
D	15.0	1	ZZ	2

NOTE: SUPPORTING CHANNELS SHALL BE INSTALLED ON ALL STREET NAME SIGNS.

	CODED PAY ITEM	DESCRIPTION	UNIT OF MEASURE	TOTAL QUANTITY
	NUMBER	CICN DANIEL TYPE 1	CO FT	20
	72000100	SIGN PANEL - TYPE 1	SQ FT	30
\wedge	~~72000200 ~~	SIGN PANEL TYRE?	~~~~~~~~~~~~~~~~~~~~~~~~~~~~~~~~~~~~~~	\cdots
	80500020	ELECTRIC UTILITY SERVICE CONNECTION	EACH A A A A A A	A A A 2002A A A A
7	~81028200~	WHOERGROUND CONDUIT, GALVANIZED STEEL, 2"DIA	THE FOOTH	
	81028220	UNDERGROUND CONDUIT, GALVANIZED STEEL, 3" DIA.	FOOT	17
	81400100	HANDHOLE	EACH	1
	81400200	HEAVY-DUTY HANDHOLE	EACH	1
	85000205	MAINTENANCE OF EXISTING TRAFFIC SIGNAL INSTALLATION (SPECIAL)	EACH	1
	87301215	ELECTRIC CABLE IN CONDUIT, SIGNAL NO. 14 2C	FOOT	1160
	87301225	ELECTRIC CABLE IN CONDUIT, SIGNAL NO. 14 3C	FOOT	1618
	87301245	ELECTRIC CABLE IN CONDUIT, SIGNAL NO. 14 5C	FOOT	2156
		ELECTRIC CABLE IN CONDUIT, SIGNAL NO. 14 7C	FOOT	3507
	87301305	ELECTRIC CABLE IN CONDUIT, LEAD-IN, NO. 14 1 PAIR	FOOT	5815
		ELECTRIC CABLE IN CONDUIT, SERVICE, NO. 6 2C	FOOT	77
	87301900	ELECTRIC CABLE IN CONDUIT, EQUIPMENT GROUNDING CONDUCTOR, NO. 6, 1C	FOOT	1543
	87502440	TRAFFIC SIGNAL POST, GALVANIZED STEEL 10 FT.	EACH	2
_		TRAFFIRS-SIGNAL-ROST, GALVANHZED-STEELV-16-FT.	EACH	3
△1\ \	87702289	STEEL MAST ARM ASSEMBLY AND POLE WITH DUAL MAST ARMS, 22 FT. AND 60 FT.	EACH	1
٦		STEEL-COMBINATION-MAST/ARM/ASSEMBLY-AND-POLE, 40-PT.	EACH	1
	87702197	STEEL MAST ARM ASSEMBLY AND POLE WITH DUAL MAST ARMS, 16 FT. AND 44 FT.	EACH	1
	87702203	STEEL MAST ARM ASSEMBLY AND POLE WITH DUAL MAST ARMS, 18 FT. AND 46 FT.	EACH	1
	87800100	CONCRETE FOUNDATION, TYPE A	FOOT	4
	87800420	CONCRETE FOUNDATION, TYPE E 42-INCH DIAMETER	FOOT	22 A
	88030020	SIGNAL HEAD, LED, 1-FACE, 3-SECTION, MAST-ARM MOUNTED	EACH	(7 } <u>∠1\</u>
	88030050	SIGNAL HEAD, LED, 1-FACE, 3-SECTION, BRACKET MOUNTED	EACH	}
	88030100	SIGNAL HEAD, LED, 1-FACE, 5-SECTION, BRACKET MOUNTED	EACH	~~ ∧
	88030110	SIGNAL HEAD, LED, 1-FACE, 5-SECTION, MAST-ARM MOUNTED	EACH	<u> </u>
	~~\$8\627\6~~	PEDESTRIAN SIGNAL HEAD, LED 1. FACE, BRACKET MOUNTED	EACH	,
Λ	88200110	TRAFFIC SIGNAL BACKPLATE, LOUVERED \	EACH	(18) (1)
- 4	~~88500100~~	INDUSTIVE COOP DETECTOR	EACH	12
	88600700	PREFORMED DETECTOR LOOP	FOOT	340
	88700200	LIGHT DETECTOR	EACH	4
İ	88700300	LIGHT DETECTOR AMPLIFIER	EACH	1
	88800100	PEDESTRIAN PUSH BUTTON	EACH	7
ļ	X0324085	EMERGENCY VEHICLE PRIORITY SYSTEM LINE SENSOR CABLE, NO. 20 3/C	FOOT	404
4	~~×0325476~~	BADAR-VEHICLE-DETECTION-SYSTEM	~~~EAGH~~~	~~~
_ (NETWORK CONFIGURATION	L SUM	```
△ (FULL-ACTUATED CONTROLLER AND TYPE SUPER P CABINET (SPECIAL)	turação de la composição de la composiçã	
Ч		SERVICE INSTACLATION, OROUND MOONTED, METERED	EACH	1
ار	~X8620200~	UNINTERRURTABLE-ROWER-SUPRIX-SPECIAL	~~~~~~~~~~~~~~~~~~~~~~~~~~~~~~~~~~~~~~	~~~~~~~~~~~~~~~~~~~~~~~~~~~~~~~~~~~~~~
Λ	Z0033040	ELECTRIC SERVICE DISCONNECT. LIGHTING AND TRAFFIC SIGNAL	FACH	* * * * * * * * * * * * * * * * * * *
		LECTION STATE DISCONNECT, EIGHT WAS THAT TO SHOW.		

LOCAL COORDINATE SYSTEM

BURNS MEDONNELL 200 W. ADAMS STREET / SUITE 1600 CHICAGO, IL 60606 P: 312)-223-920 / F: 312)-223-9664 WEE: HWH.BURNSMCD.COM

USER NAME = rjiang	DESIGNED	-	MAP	REVISED - ▲ 04/15/2020
	DRAWN	-	HTS	REVISED -
PLOT SCALE = 100.0000 '/ in.	CHECKED	-	MAP	REVISED -
PLOT DATE = 4/15/2020	DATE	-	2/28/2020	REVISED -

TRAFFIC SIGNAL INSTALLATION SUMMARY OF QUANTITIES							
. ROUTE	25 AT L	ONGMEA	DOW	PARKWAY			
SHEET 1	OF 1	SHEETS	STA.	TO STA.			

SCALE: NONE

	1	TS 7	992
	COUNTY	TOTAL SHEETS	SHEET NO.
	KANE	415	254
	CONTRACT	NO.	61G02
ì	D DDO IECT		

SECTION

18-00215-21-BR

2298