



F.A.P. RTE.	SECTION	COUNTY	TOTAL SHEETS	SHEET NO.
313	103N-1,TS	WARREN		6
STA.		TO STA.		
FED. ROAD DIST. NO. 4		ILLINOIS FED. AID PROJECT		


### TIE POINTS

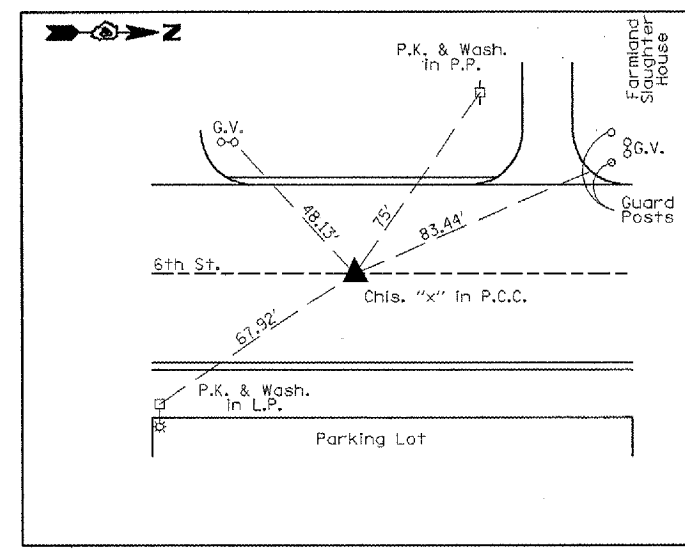


STA. 15+50

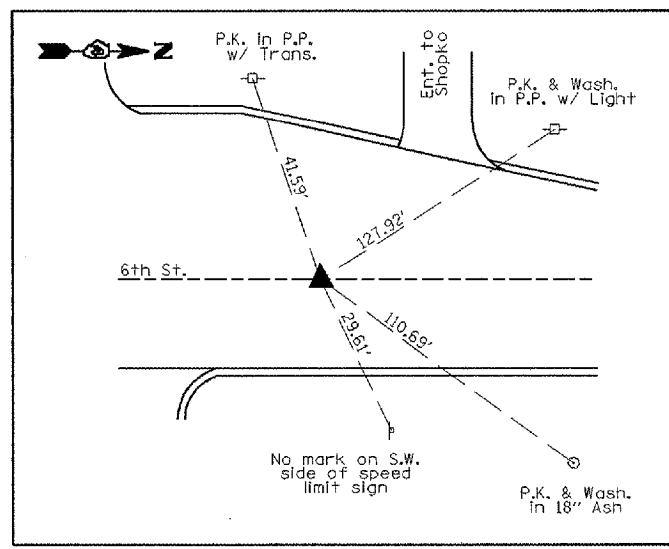

STA. 12+61

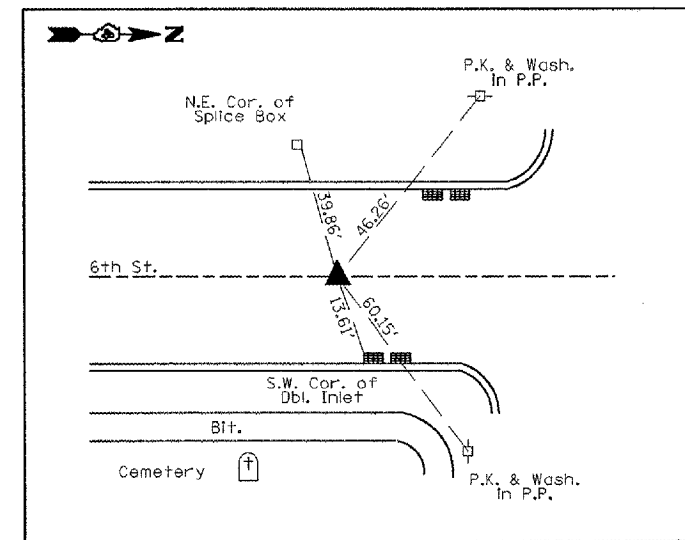

STA. 3+70

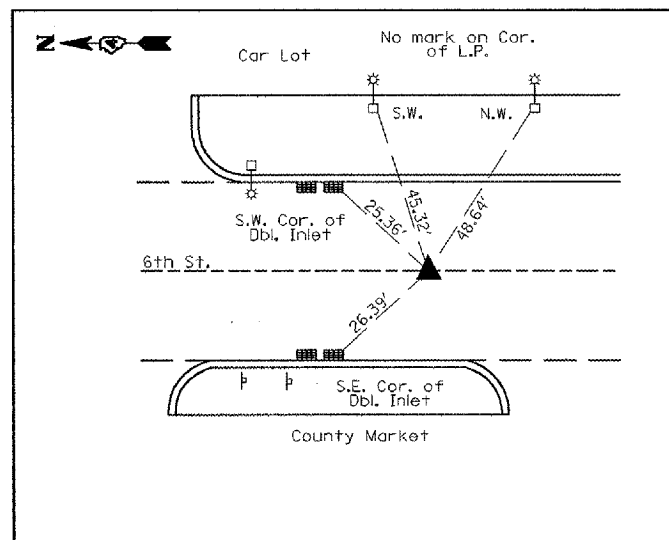

STA. 7+50

### BENCHMARKS

#### TBM 51

Chis. "L" on S.E. corner of handhole on the island in the S.W. Quadrant of the Intersection of U.S. 34 / 6th St.

ELEVATION = 755.37

### SURVEY MARKERS

32.6' Lt. Sta. 4+27.1  
30.1' Lt. Sta. 15+63.1

PLOT DATE = 2/18/2006  
 FILE NAME = c:\pvc\pca\mmonn\02\mmonn\stwdgn  
 PLOT SCALE = 1/8"=1'-0"  
 USER NAME = jwagner

REVISIONS	
NAME	DATE

ILLINOIS DEPARTMENT OF TRANSPORTATION

### TIE POINTS, BENCHMARKS & SURVEY MARKERS

SCALE: VERT.      DRAWN BY: jw  
 HORIZ.              CHECKED BY:  
 DATE