


F.A. RTE. 338/IL 59	SECTION	COUNTY	TOTAL SHEETS	SHEET NO.
	2011-030	DUPAGE	0	3
STA.		TO STA.		
FED. ROAD DIST. NO.	ILLINOIS	CONTRACT 60P42		

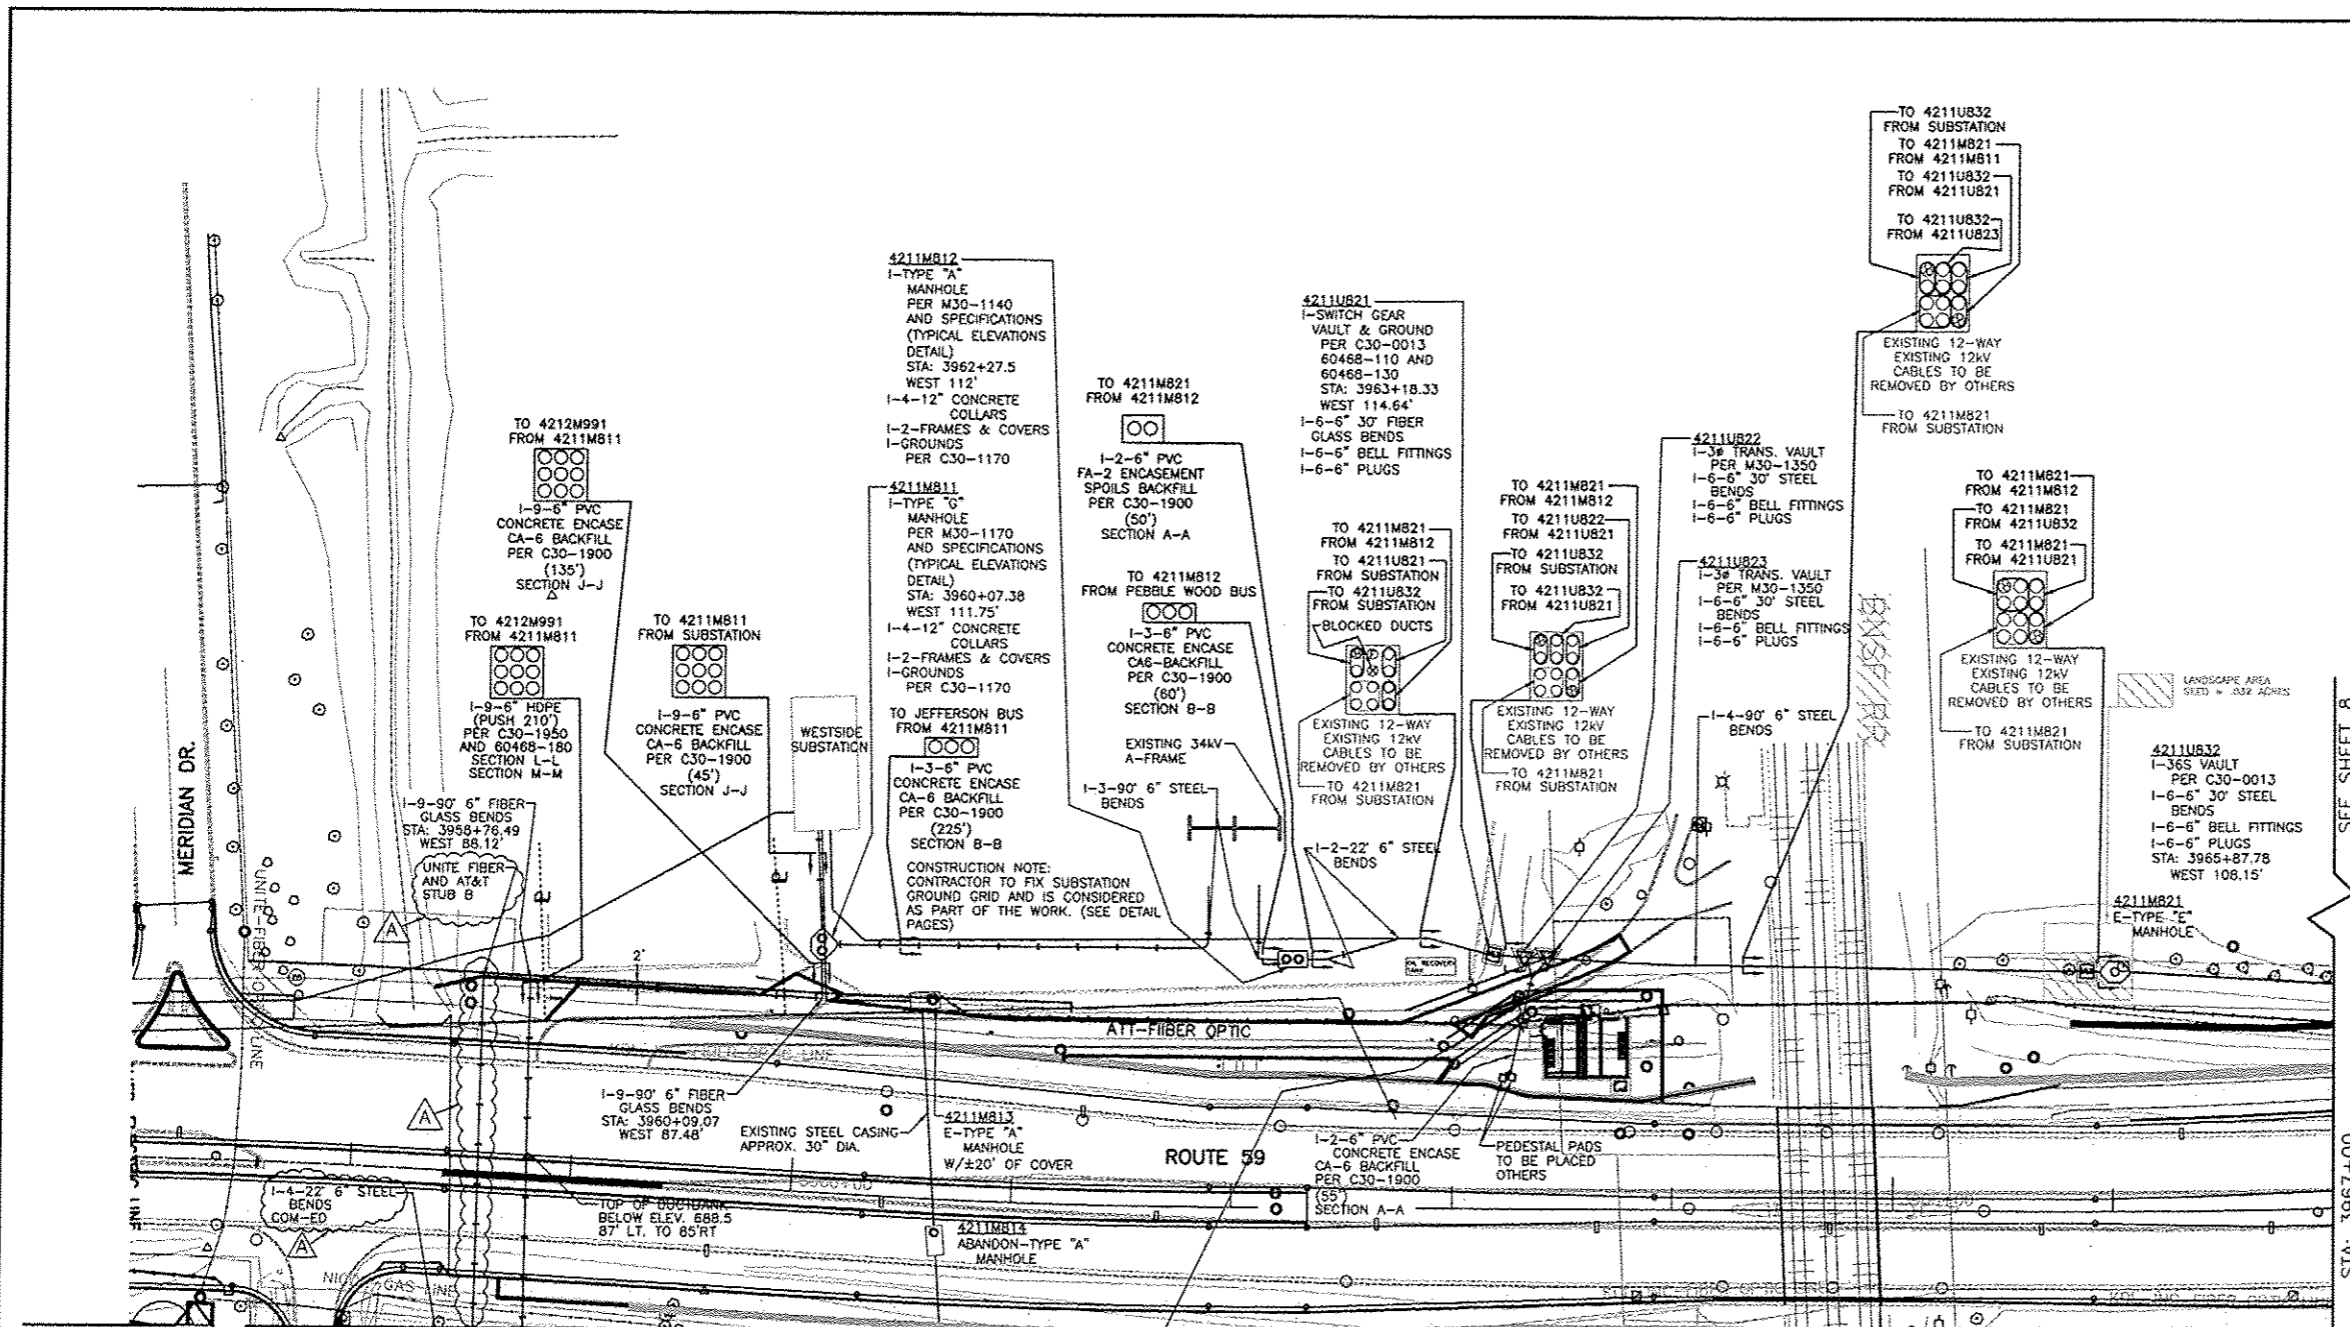

LEGEND

- EXISTING UNDERGROUND**
- MLT E-SW. VAULT
 - E-SW. MOD.
 - E-TRANSFORMER
 - E-TYPE "A" MANHOLE
 - E-TYPE "C" MANHOLE
 - E-TYPE "C" DOUBLE OPENING MANHOLE
 - E-TYPE "D" MANHOLE
 - E-TYPE "E" MANHOLE
 - E-CONDUIT
- OVERHEAD**
- E-DISTRIBUTION/TRANSMISSION POLE
- INSTALL UNDERGROUND**
- I-SW. VAULT
 - I-TRANSFORMER VAULT
 - I-TYPE "A" MANHOLE
 - I-TYPE "E" DOUBLE OPENING MANHOLE
 - I-TYPE "C" DOUBLE OPENING MANHOLE
 - I-TYPE "C" SINGLE OPENING MANHOLE
 - I-CONDUIT
- ABANDON UNDERGROUND**
- A-CONDUIT

CONSTRUCTION NOTE:
 CONTRACTOR IS TO BE AWARE
 OF 36" AND 30" PROPOSED STORM
 SEWERS. PRIOR TO CROSSING WITH
 2-6" CONDUITS.

CALL JULIE 48 HRS. PRIOR TO CONSTRUCTION
 1 - 800 - 892 - 0123 OR CALL 811

NOTES:

- THE PROJECT ENGINEER FOR THIS JOB IS BRIAN CHAMBERLAIN AT (830)420-0853.
- THE PROJECT COORDINATOR FOR THIS PROJECT IS PAUL MICHALOWSKI AT (830)305-5227.
- CONTRACTOR IS RESPONSIBLE FOR MANHOLE PHOTOS TAKEN OF ALL CLEARLY MARKED CABLE AND ALL WALLS OF MANHOLES. PHOTOS WILL BE GIVEN TO THE GIS GROUP WITH THE AS-BUILTS.

PROJECT TITLE	ADDENDUM A 7-16-12
PROJECT DESCRIPTION	ROUTE 59 ROAD IMPROVEMENTS
TO RELOCATE AND INSTALL NEW DUCTBANK AND 34KV FEEDERS	
DESIGNED BY	BCC
DRAWN BY	DL
CHECKED BY	PSM
DATE	5-11-12
PROJECT NO.	4211.4212.4223
SCALE	1 = 40
DATE	N/A
PROJECT	EU-12
FILE	0060468001C3.DWG
SHEET	3 OF 63

Naperville Department of Public Utilities
 Electric Division

SEE SHEET 4

SEE SHEET 4

SEE SHEET 8