


| | | | | |
|------------------------|--------------------------------|-------------------------|-------------------|----------------|
| F.A. RTE. 338/IL 59 | SECTION 2011-030 | COUNTY DUPAGE | TOTAL SHEETS 0 | SHEET NO. 3 |
| STA. | | TO STA. | | |
| FED. ROAD DIST. NO. | | ILLINOIS CONTRACT 60P42 | | |

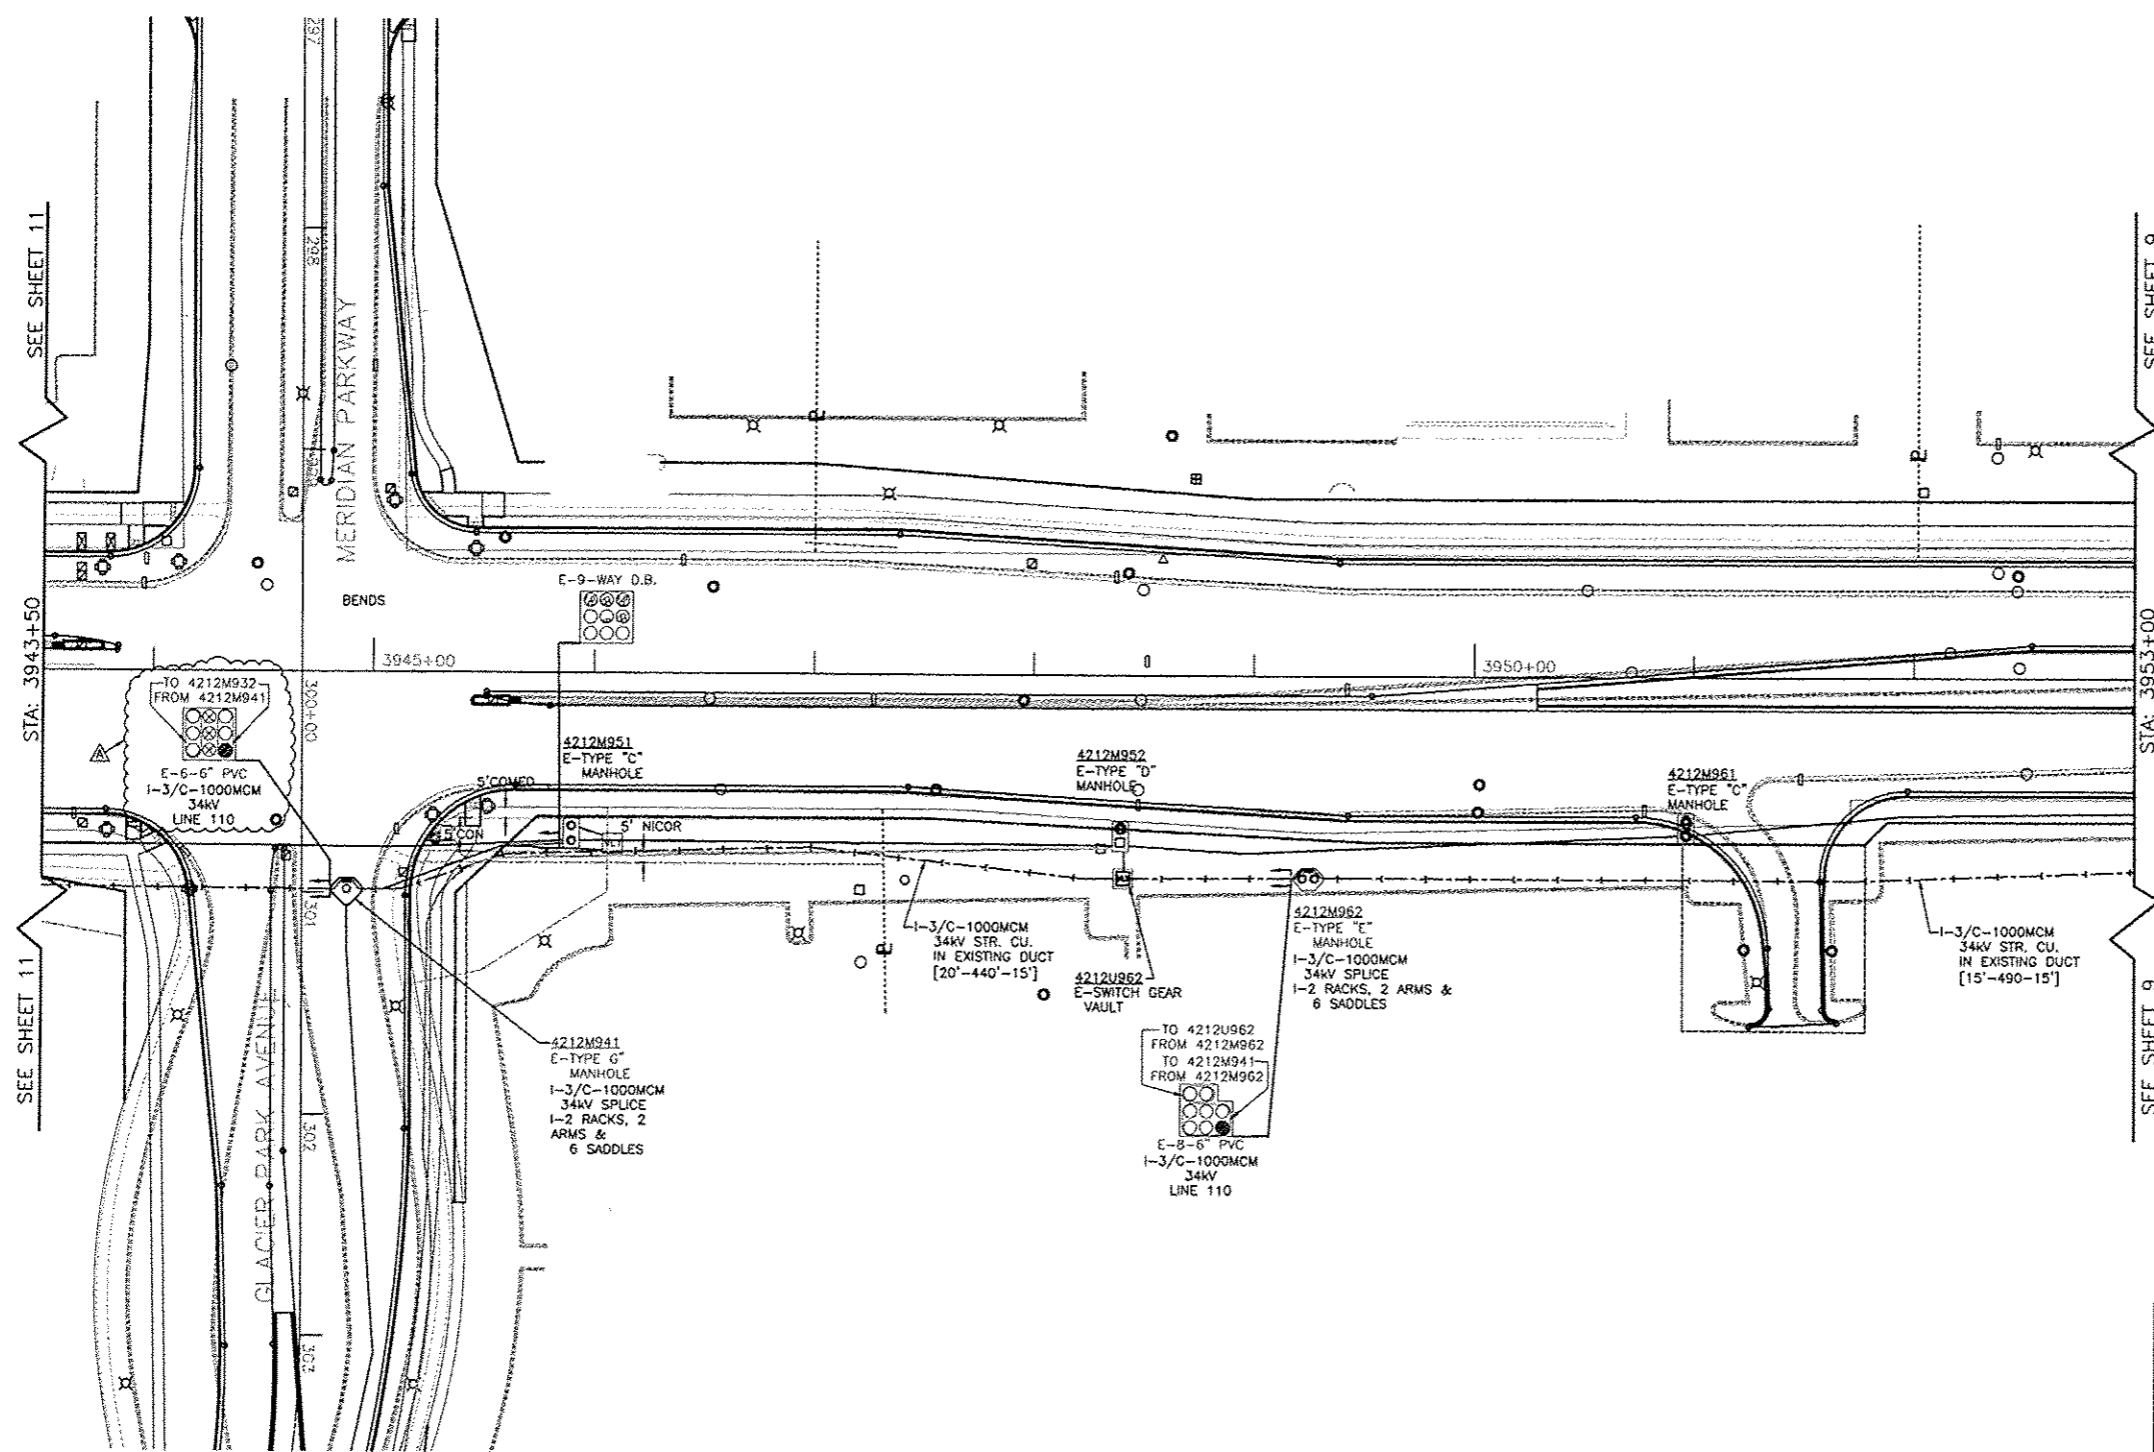

LEGEND

- EXISTING UNDERGROUND**
- E-SW. VAULT
 - E-SW. MOD.
 - E-TRANSFORMER
 - E-TYPE "A" MANHOLE
 - E-TYPE "C" MANHOLE
 - E-TYPE "C" DOUBLE OPENING MANHOLE
 - E-TYPE "D" MANHOLE
 - E-TYPE "E" MANHOLE
 - E-CONDUIT
 - E-TYPE "E" DOUBLE OPENING MANHOLE
 - E-TYPE "G" DOUBLE OPENING MANHOLE
- INSTALL UNDERGROUND**
- E-DISTRIBUTION/TRANSMISSION POLE
 - E-3/C-1000MCM 34KV STR. CU. W/JKT.
 - I-3/C-1000MCM 34KV STR. CU. W/JKT.
 - I-SPLICE PER MFR. OR SPECS. PER C30-0460

CALL JULIE 48 HRS. PRIOR TO CONSTRUCTION
1-800-892-0123 OR CALL 811

NOTES:
 1. THE PROJECT ENGINEER FOR THIS JOB IS BRIAN CHAMBERLAIN AT (630)420-2653.
 2. THE PROJECT COORDINATOR FOR THIS PROJECT IS PAUL MICHALOWSKI AT (630)306-8227.
 3. CONTRACTOR IS RESPONSIBLE FOR MANHOLE PHOTOS TAKEN OF ALL CLEARLY MARKED CABLE AND ALL WALLS OF MANHOLES. PHOTOS WILL BE GIVEN TO THE GIS GROUP WITH THE AS-BUILTS.

| | | | |
|---|-------------------------|--------------------|---|
| TE 59 | MERIDIAN P GLACIER P | ADDENDUM A 7-16-12 | |
| | | LOCATION MAP | DESIGN REVISION DATES |
| PROJECT TITLE ROUTE 59 ROAD IMPROVEMENTS | | | |
| PROJECT DESCRIPTION TO RELOCATE AND INSTALL NEW DUCTBANK AND 34KV FEEDERS | | | |
| ENGINEER | DRAWING DATE | APP # | SCALE |
| BCC | 5-11-12 | 4211,4212,4223 | 1 = 40 |
| DESIGNED BY | DATE | PROJECT # | |
| DL | PSM | N/A | EU-12 |
| CHECKED BY | APPROVED BY | DWG FILE | SHEET # |
| | | 0060648001C10.DWG | 10 OF 63 |
| Naperville | | | Department of Public Utilities Electric Division |
| | | | WORK REQUEST # 60468 |