


F.A. RTE. 338/IL 59	SECTION 204-036	COUNTY DUPAGE	TOTAL SHEETS 0	SHEET NO. 3
STA.		TO STA.		
FED. ROAD DIST. NO.	ILLINOIS	CONTRACT 60P42		

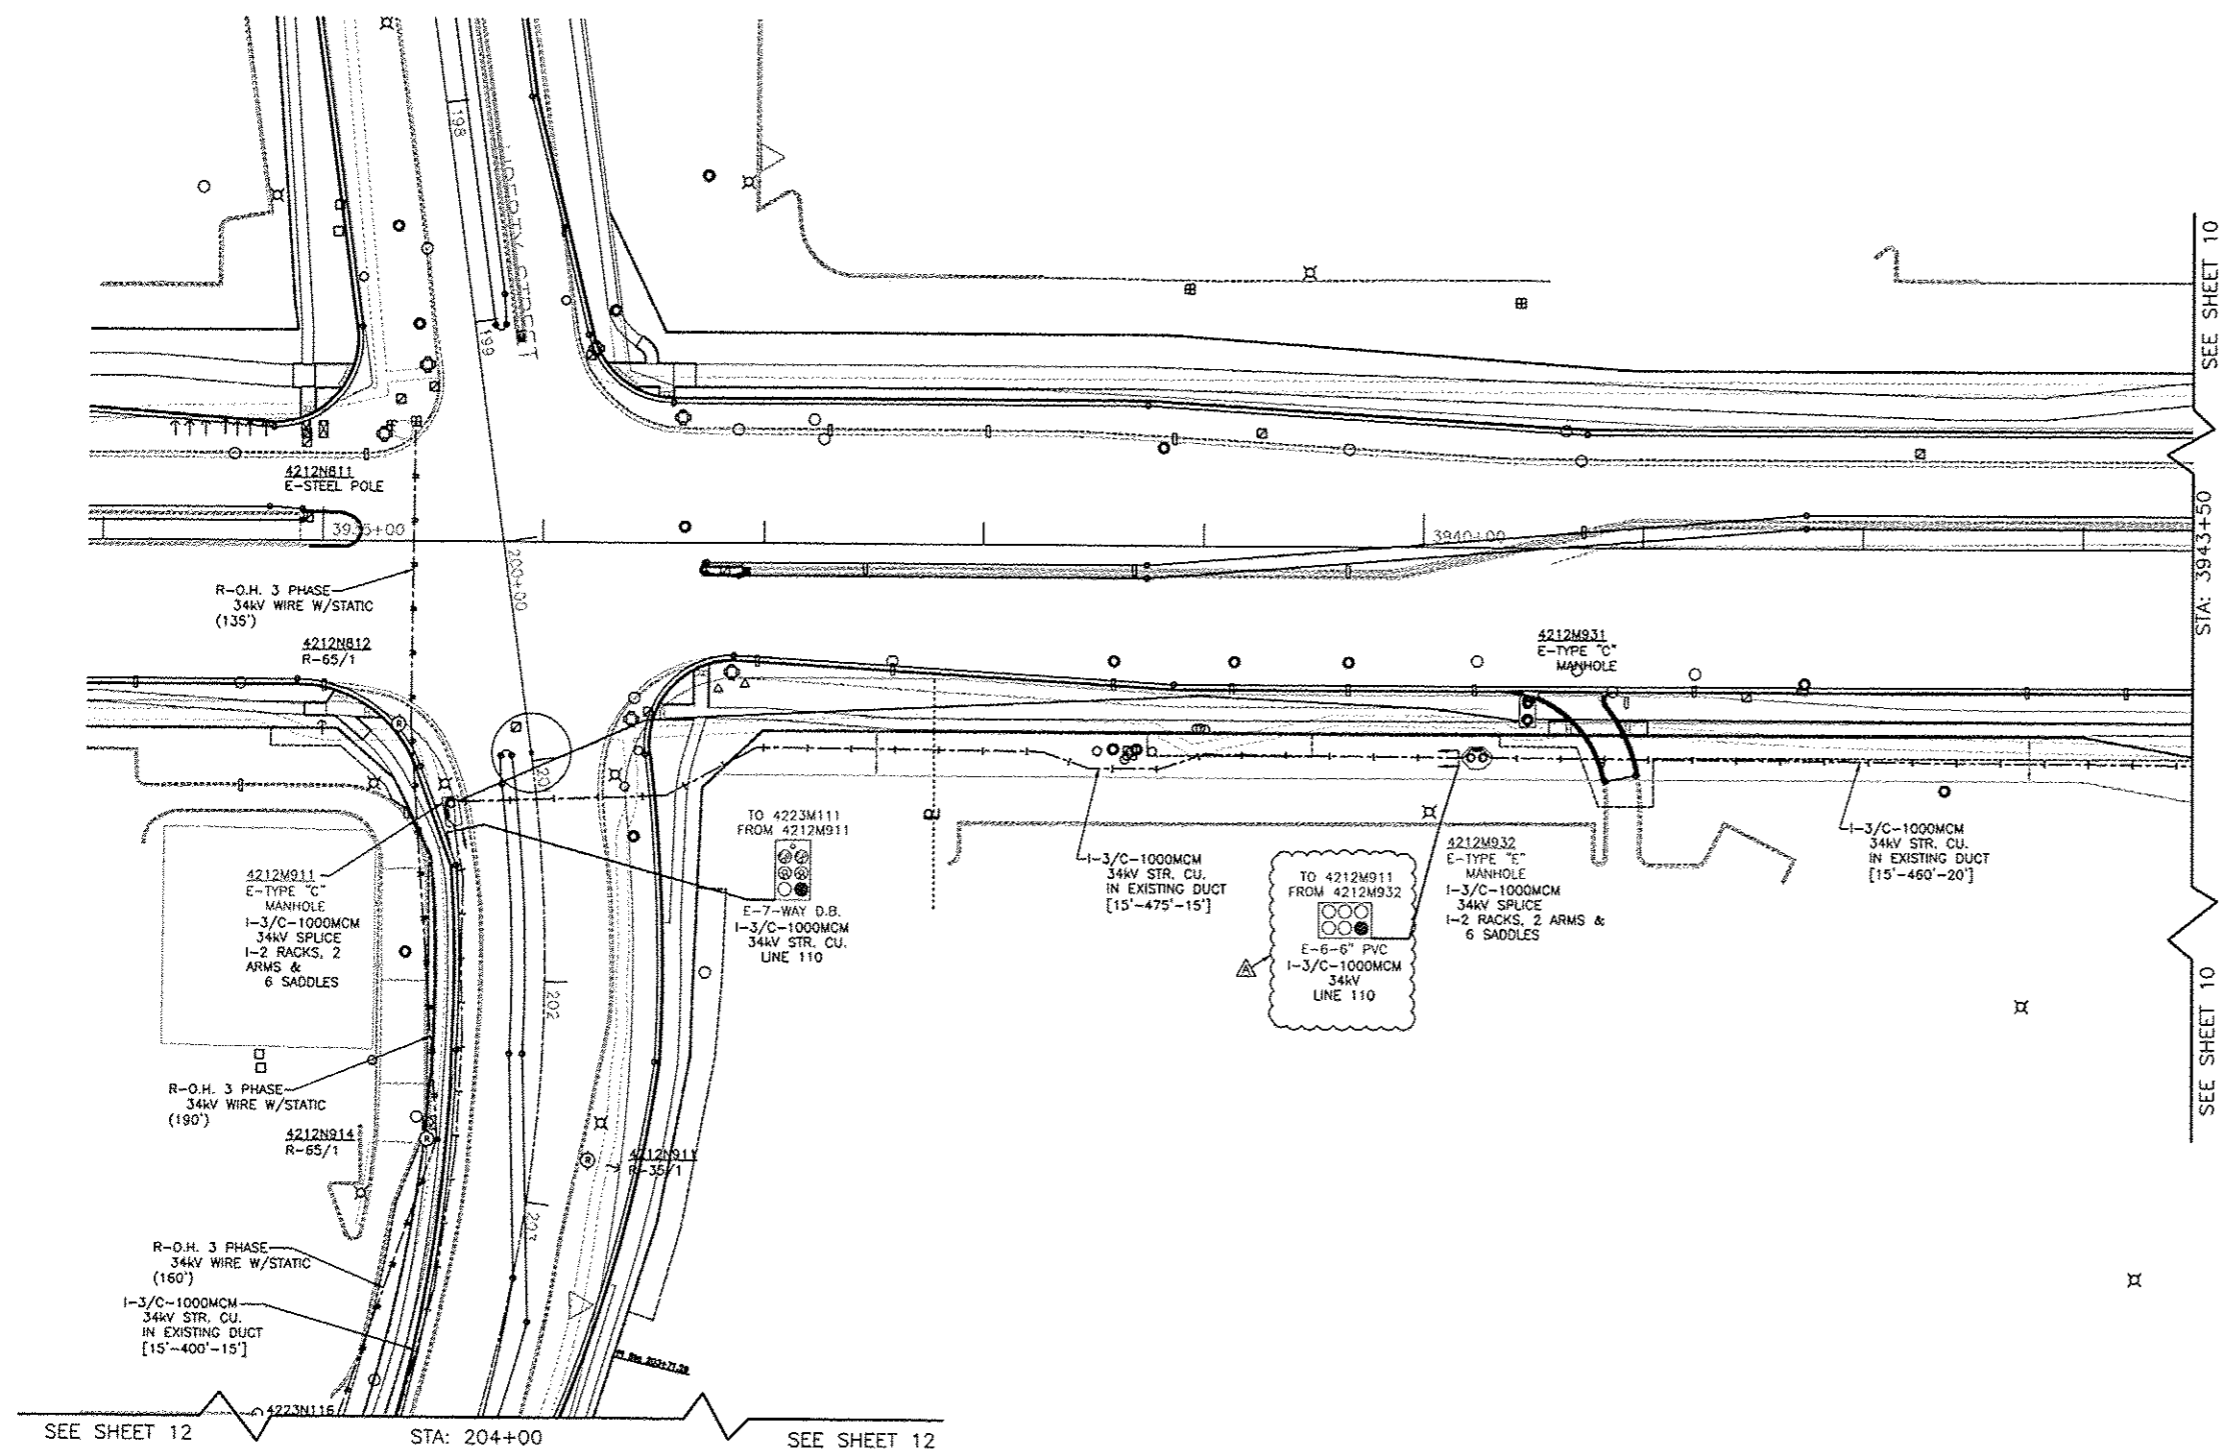

LEGEND

- EXISTING UNDERGROUND**
- E-SW. VAULT
 - E-SW. MOD.
 - E-TRANSFORMER
 - E-TYPE "A" MANHOLE
 - E-TYPE "C" MANHOLE
 - E-TYPE "C" DOUBLE OPENING MANHOLE
 - E-TYPE "D" MANHOLE
 - E-TYPE "E" MANHOLE
 - E-CONDUIT
 - E-TYPE "E" DOUBLE OPENING MANHOLE
 - E-TYPE "G" DOUBLE OPENING MANHOLE
- EXISTING OVERHEAD**
- E-DISTRIBUTION/TRANSMISSION POLE
 - E-3/C-1000MCM 34kV STR. CU. W/JKT.
- INSTALL UNDERGROUND**
- I-3/C-1000MCM 34kV STR. CU. W/JKT.
 - I-SPLICE PER MFR. OR SPECS. PER C30-0460
- REMOVE OVERHEAD**
- R-DISTRIBUTION/TRANSMISSION POLE 65/1 THRU 65/3 POLES
 - R-3/C-1000MCM 34kV STR. CU. W/JKT.
 - R-O.H. 3 PHASE 34kV WIRE W/STATIC

CALL JULIE 48 HRS. PRIOR TO CONSTRUCTION
1-800-892-0123 OR CALL 811

NOTES:

1. THE PROJECT ENGINEER FOR THIS JOB IS BRIAN CHAMBERLAIN AT (630)420-8853.
2. THE PROJECT COORDINATOR FOR THIS PROJECT IS PAUL MICHALOWSKI AT (630)300-8227.
3. CONTRACTOR IS RESPONSIBLE FOR MANHOLE PHOTO TAKEN OF ALL CLEARLY MARKED CHBLE AND ALL WALLS OF MANHOLES. PHOTOS WILL BE GIVEN TO THE GIS GROUP WITH THE AS-BUILTS.

	ADDENDUM A 7-16-12
	DESIGN REVISION DATES
PROJECT TITLE ROUTE 59 ROAD IMPROVEMENTS	
PROJECT DESCRIPTION TO RELOCATE AND INSTALL NEW DUCTBANK AND 34kV FEEDERS	
DESIGNED BY BCC	DRAWING DATE 5-11-12
DATE DESIGNED BY DL	DATE JOINT AGREEMENT N/A
DESIGNED BY PSM	DATE 11 OF 63
Naperville Department of Public Utilities Electric Division	
60468	