


F.A. RTE. 338/IL 59	SECTION 2044-030	COUNTY DUPAGE	TOTAL SHEETS 4	SHEET NO. 3
STA. TO STA.		FED. ROAD DIST. NO. ILLINOIS CONTRACT 60R30		

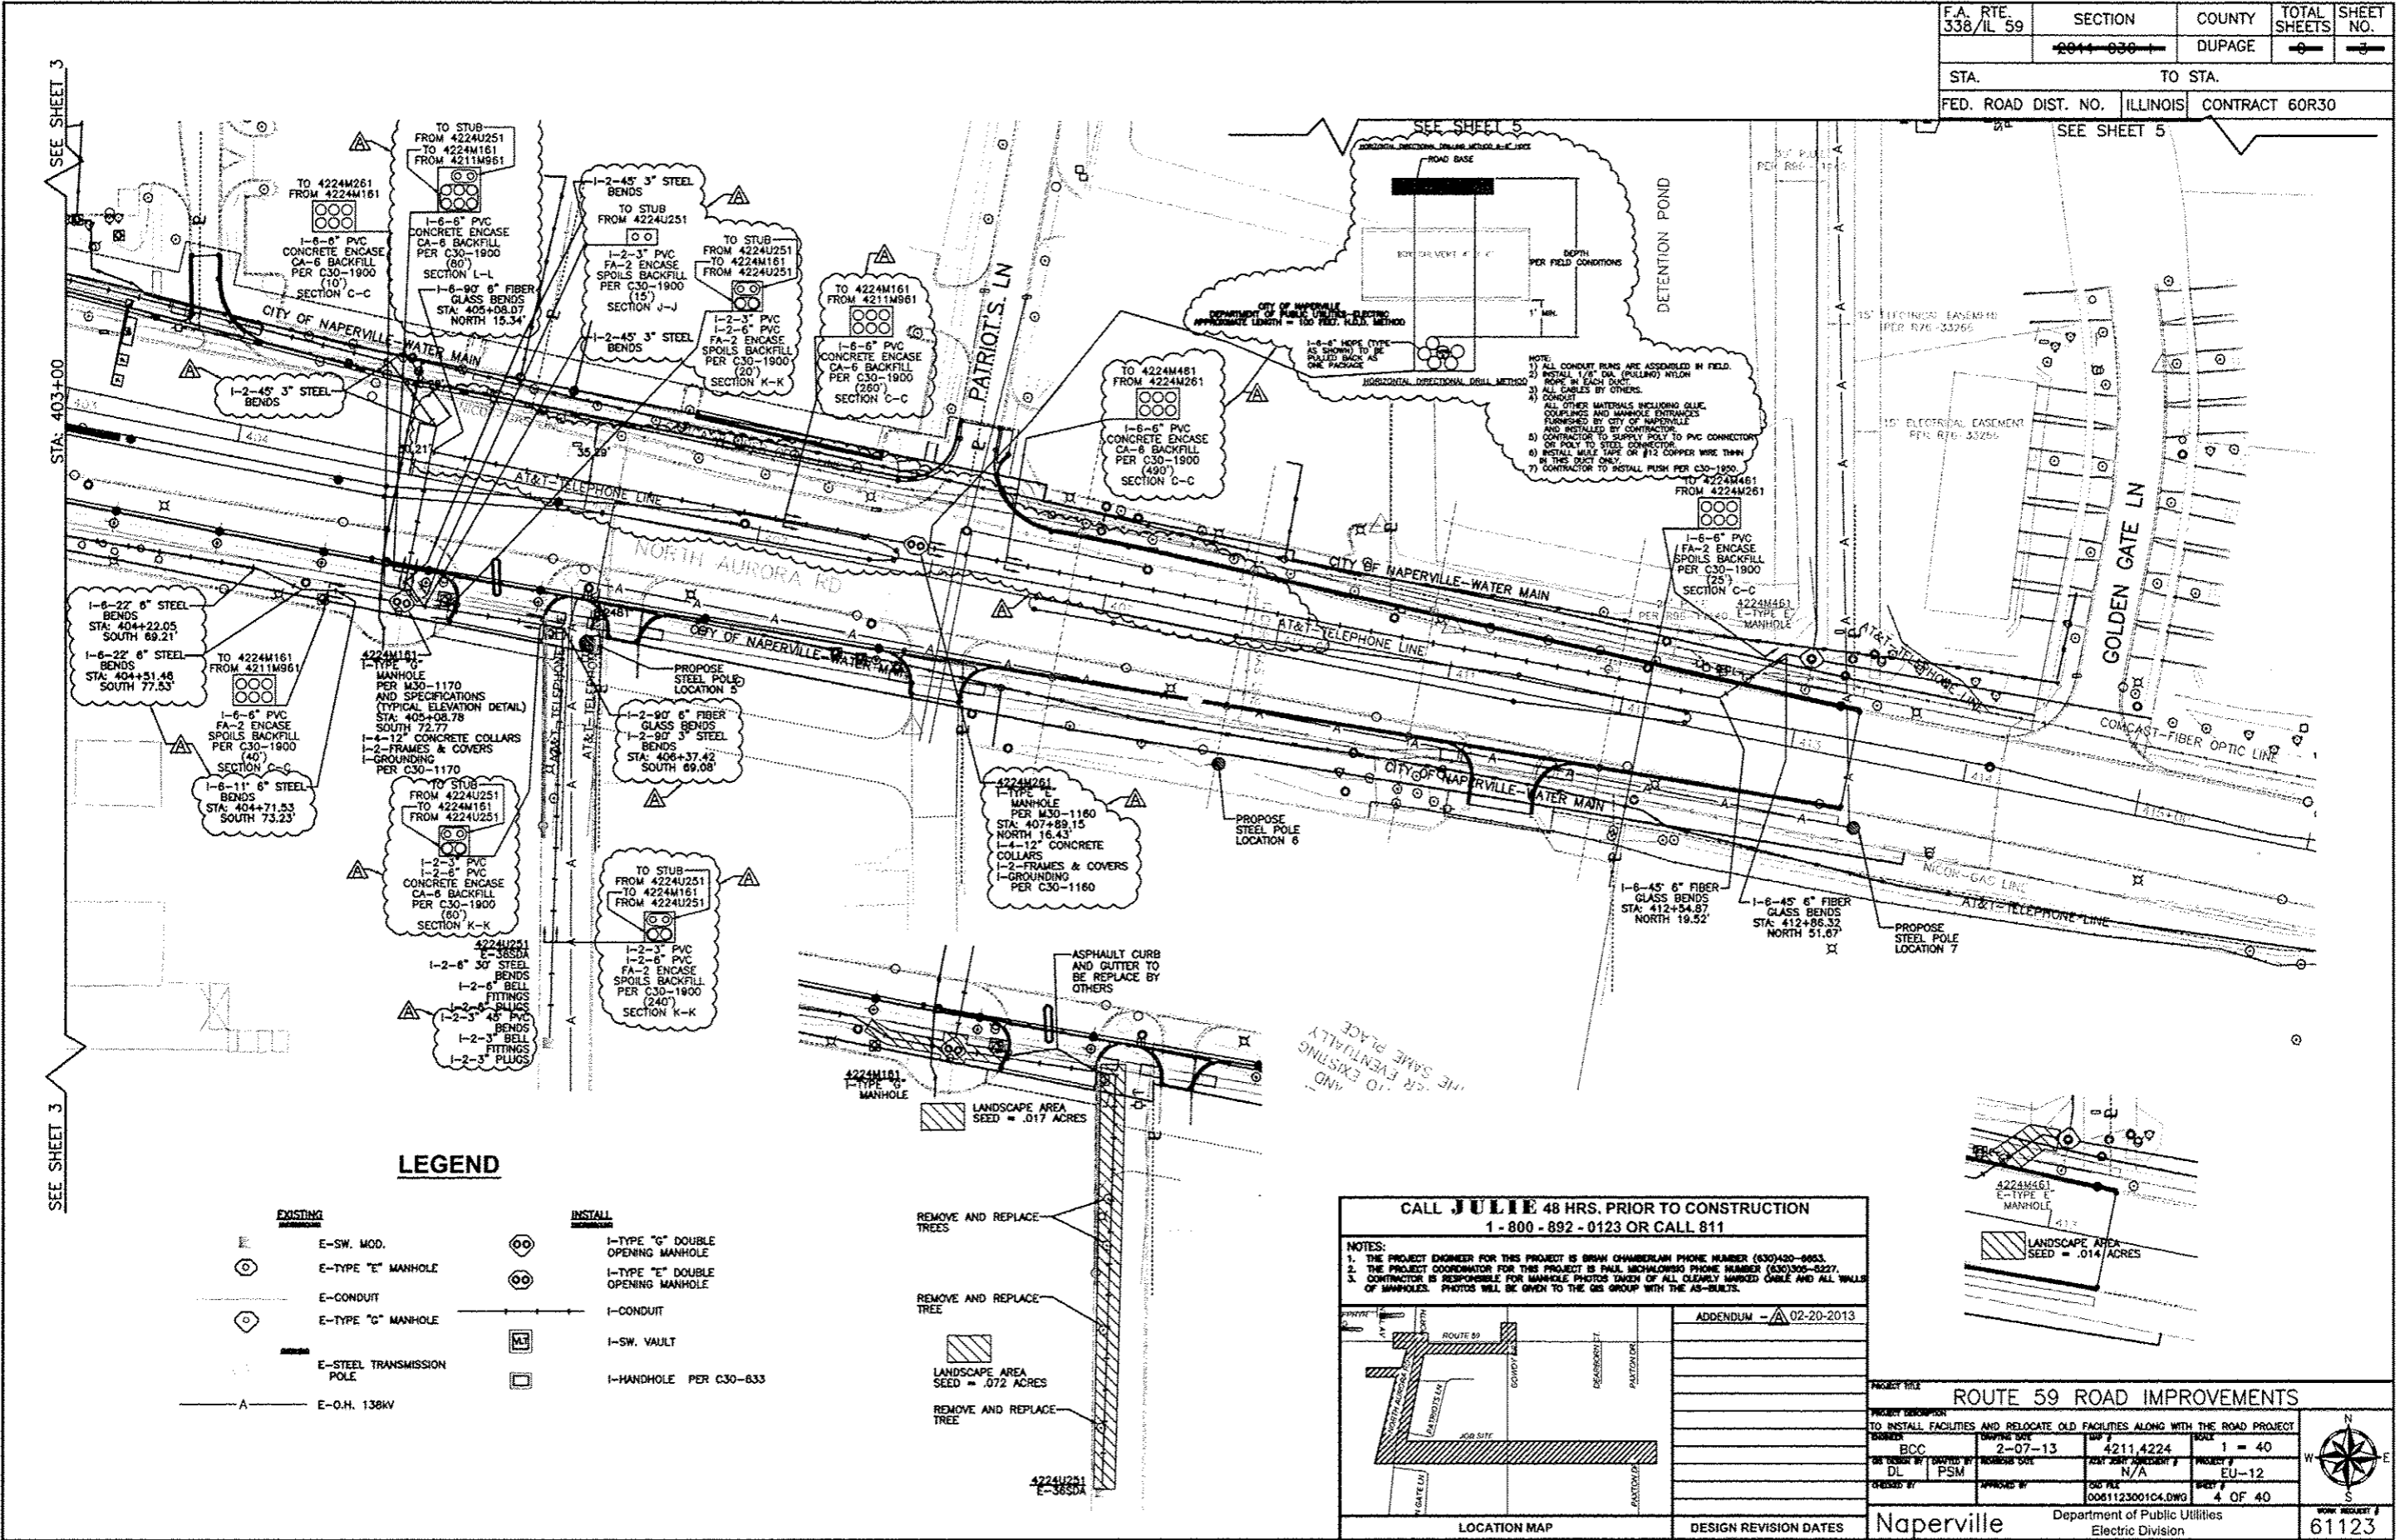

SEE SHEET 3

SEE SHEET 5

**NOTE:**  
 1) ALL CONDUIT RINGS ARE ASSEMBLED IN FIELD.  
 2) INSTALL 1/8" DIA. (PULLING) NYLON ROPE IN EACH DUCT.  
 3) ALL CABLES BY OTHERS.  
 4) CONDUIT ALL OTHER MATERIALS INCLUDING GLUE, COUPLERS AND MANHOLE ENTRANCES FURNISHED BY CITY OF NAPERVILLE AND INSTALLED BY CONTRACTOR.  
 5) CONTRACTOR TO SUPPLY PLY TO PVC CONNECTOR OR POLY TO STEEL CONNECTOR.  
 6) INSTALL WIRE TIE OR #12 COPPER WIRE TIE IN THE DUCT ONLY.  
 7) CONTRACTOR TO INSTALL PUSH PER C30-1900 FROM 4224M461 TO 4224M261.

**LEGEND**

EXISTING		INSTALL	
	E-SW. MOD.		I-TYPE "G" DOUBLE OPENING MANHOLE
	E-TYPE "E" MANHOLE		I-TYPE "E" DOUBLE OPENING MANHOLE
	E-CONDUIT		I-CONDUIT
	E-TYPE "G" MANHOLE		I-SW. VAULT
	E-STEEL TRANSMISSION POLE		I-HANDHOLE PER C30-633
	E-O.H. 138kW		

REMOVE AND REPLACE TREES

REMOVE AND REPLACE TREE

REMOVE AND REPLACE TREE

LANDSCAPE AREA SEED = .017 ACRES

LANDSCAPE AREA SEED = .072 ACRES

REMOVE AND REPLACE TREE

TO EXISTING AND THE SAME PLACE


**CALL JULIE 48 HRS. PRIOR TO CONSTRUCTION**  
 1-800-892-0123 OR CALL 811

**NOTES:**  
 1. THE PROJECT ENGINEER FOR THIS PROJECT IS BRIAN CHAMBERLAIN PHONE NUMBER (630)450-0953.  
 2. THE PROJECT COORDINATOR FOR THIS PROJECT IS PAUL MICHALOWSKI PHONE NUMBER (630)905-6227.  
 3. CONTRACTOR IS RESPONSIBLE FOR MANHOLE PHOTOS TAKEN OF ALL CLEARLY MARKED CABLE AND ALL WALLS OF MANHOLES. PHOTOS WILL BE GIVEN TO THE GIS GROUP WITH THE AS-BUILTS.

**ADDENDUM - 02-20-2013**

**LOCATION MAP**

**DESIGN REVISION DATES**

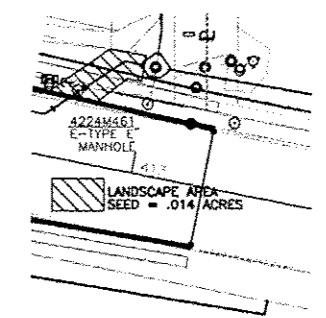

PROJECT TITLE <b>ROUTE 59 ROAD IMPROVEMENTS</b>			
PROJECT DESCRIPTION TO INSTALL FACILITIES AND RELOCATE OLD FACILITIES ALONG WITH THE ROAD PROJECT			
OWNER BCC	DATE 2-07-13	DWG NO. 42114224	SCALE 1 = 40
DESIGNED BY DL	DRAWN BY PSM	CHECKED BY N/A	PROJECT # EU-12
CREATED BY	APPROVED BY	DWG FILE 0061123001C4.DWG	SHEET # 4 OF 40
Naperville		Department of Public Utilities Electric Division	
		WORK REQUIRED # 61123	