
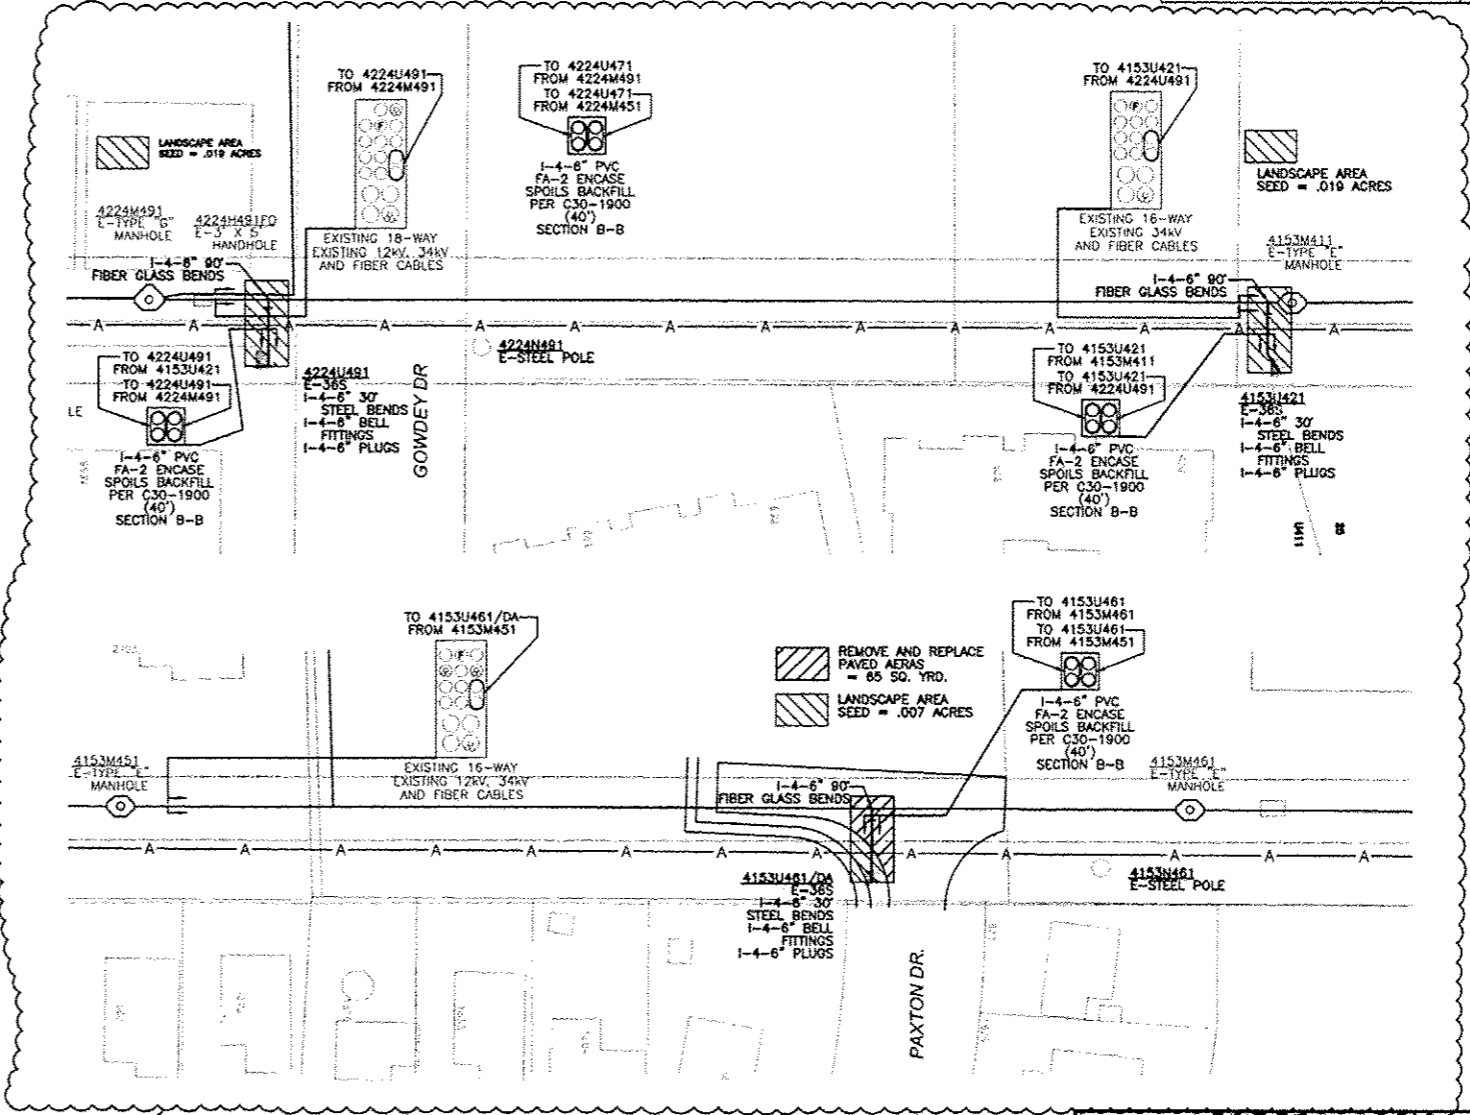


SEE SHEET 4

SEE SHEET 4

F.A. RTE. 338/IL 59	SECTION 2011-030	COUNTY DUPAGE	TOTAL SHEETS 10	SHEET NO. 10
STA.		TO STA.		
FED. ROAD DIST. NO.		ILLINOIS	CONTRACT 60R30	

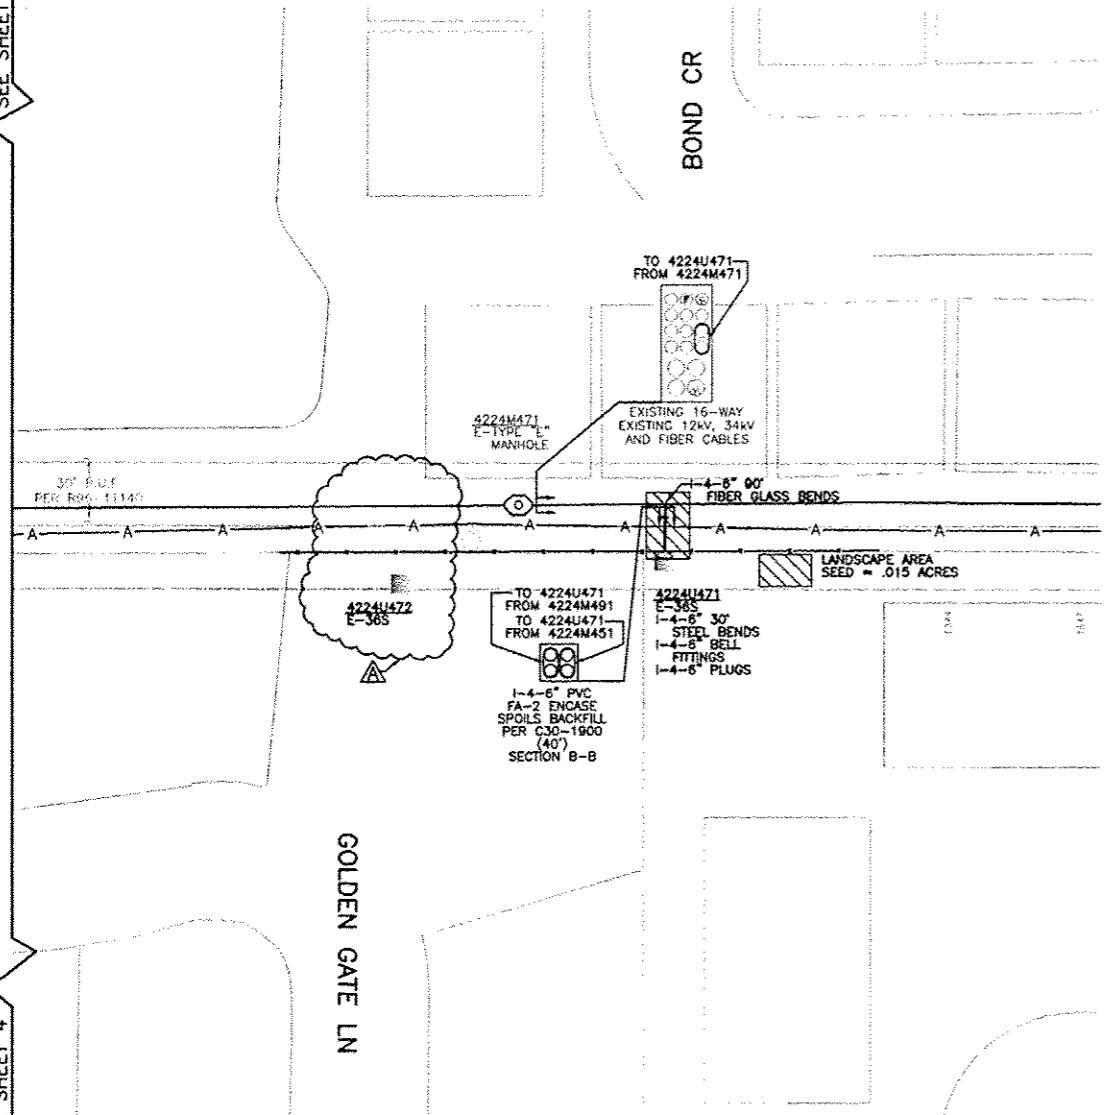

**LEGEND**

EXISTING		INSTALL	
	E-SW. MOD.		I-CONDUIT
	E-TYPE "E" MANHOLE		I-SW. VAULT
	E-CONDUIT		I-HANDHOLE
	E-TYPE "G" MANHOLE		
	E-STEEL TRANSMISSION POLE		

**CALL JULIE 48 HRS. PRIOR TO CONSTRUCTION**  
1-800-892-0123 OR CALL 811

**NOTES:**  
 1. THE PROJECT ENGINEER FOR THIS PROJECT IS BRYAN CHAMBERLAIN PHONE NUMBER (630)430-0665.  
 2. THE PROJECT COORDINATOR FOR THIS PROJECT IS PAUL MICHALOWSKI PHONE NUMBER (630)305-0227.  
 3. CONTRACTOR IS RESPONSIBLE FOR MANHOLE PHOTOS TAKEN OF ALL CLEARLY MARKED CABLE AND ALL WALLS OF MANHOLES. PHOTOS WILL BE OWEN TO THE O&E GROUP WITH THE AS-BUILTS.

**ADDENDUM - 02-20-201**

**LOCATION MAP**

**DESIGN REVISION DATES**

PROJECT TITLE	ROUTE 59 ROAD IMPROVEMENTS		
PROJECT DESCRIPTION	TO INSTALL NEW FACILITIES AND RELOCATE OLD FACILITIES ALONG WITH ROAD PROJECT		
DRAWN BY	DATE	BY	SCALE
BCC	2-07-13	4211,4224	1 = 40
DESIGNED BY	DATE	PROJECT #	
DL / PSM	N/A	EU-12	
CHECKED BY	DATE	SHEET #	
	0061123001C5.DWG	5 OF 40	

**Naperville** Department of Public Utilities  
Electric Division

61123