


**TRAFFIC SIGNAL LEGEND**

	PROPOSED	EXISTING
DETECTOR LOOP		
SIGNAL HEAD		
G.S. CONDUIT IN TRENCH OR PUSHED		
SIGNAL HEAD WITH BACKPLATE		
RACEWAY FOR MAGNETIC DETECTOR, TYPE I OR II		
VEHICLE DETECTOR, NON-COMPENSATED MAGNETIC TYPE		

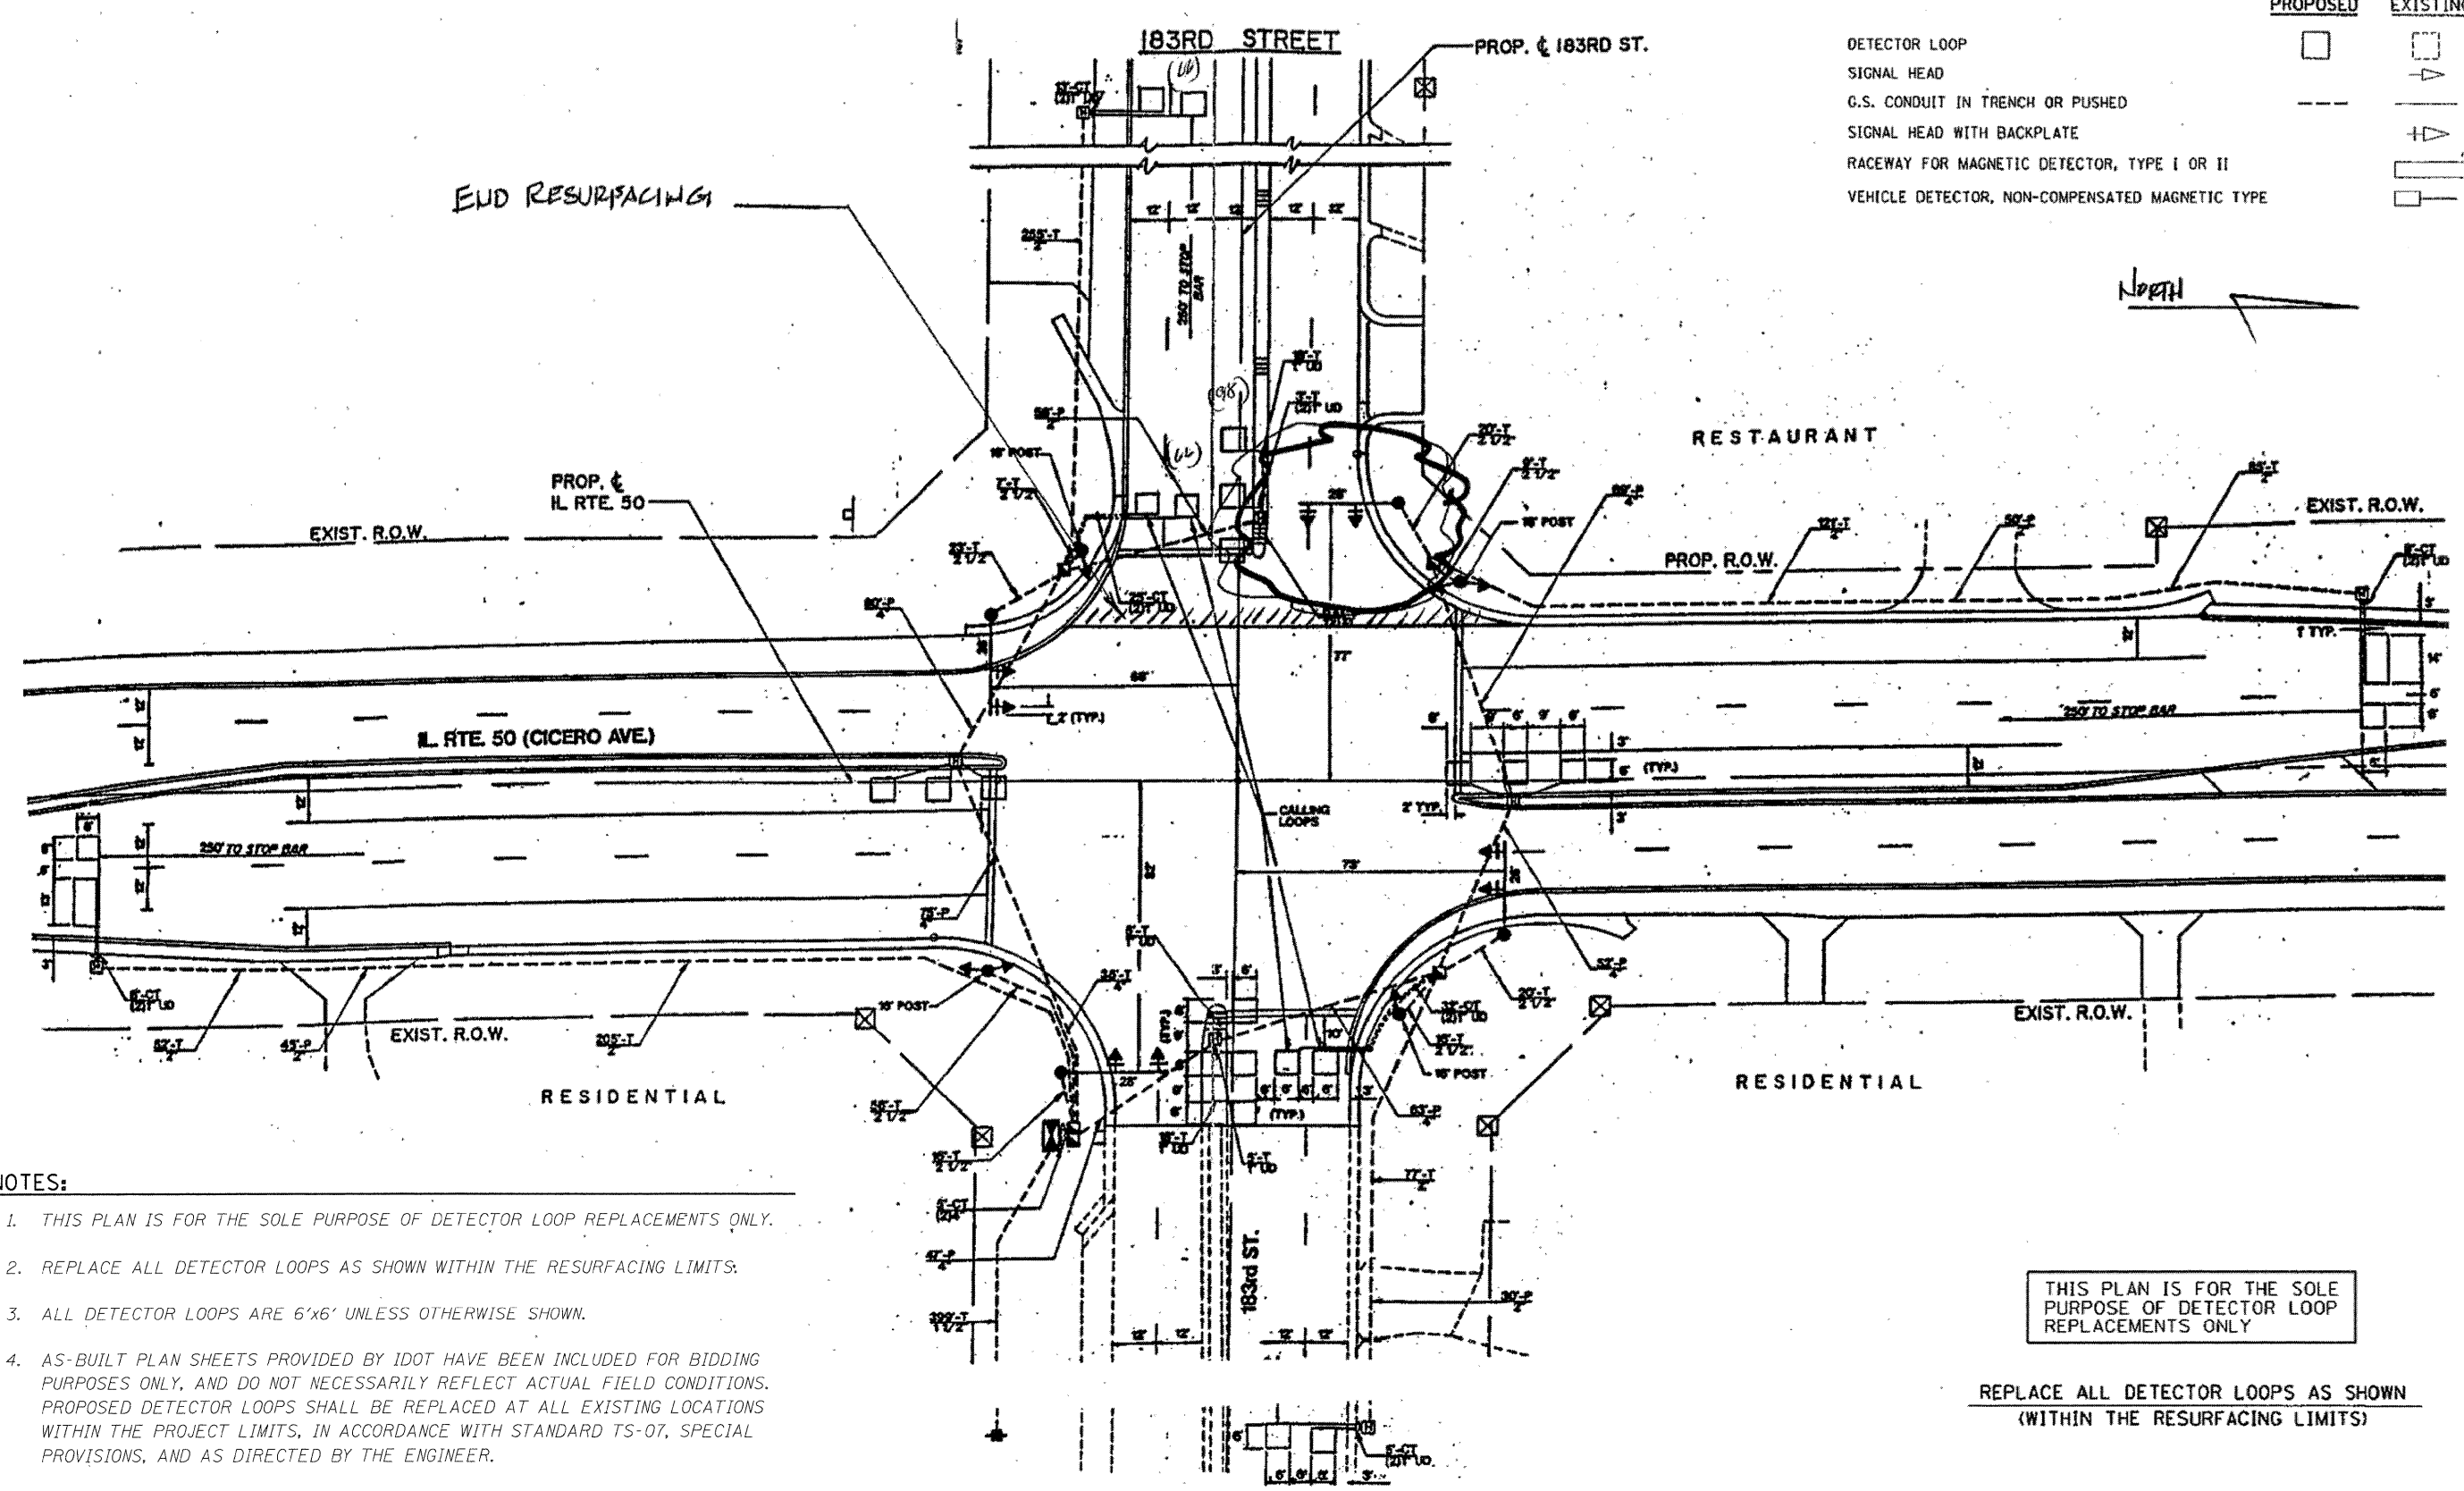

**NOTES:**

1. THIS PLAN IS FOR THE SOLE PURPOSE OF DETECTOR LOOP REPLACEMENTS ONLY.
2. REPLACE ALL DETECTOR LOOPS AS SHOWN WITHIN THE RESURFACING LIMITS.
3. ALL DETECTOR LOOPS ARE 6'x6' UNLESS OTHERWISE SHOWN.
4. AS-BUILT PLAN SHEETS PROVIDED BY IDOT HAVE BEEN INCLUDED FOR BIDDING PURPOSES ONLY, AND DO NOT NECESSARILY REFLECT ACTUAL FIELD CONDITIONS. PROPOSED DETECTOR LOOPS SHALL BE REPLACED AT ALL EXISTING LOCATIONS WITHIN THE PROJECT LIMITS, IN ACCORDANCE WITH STANDARD TS-07, SPECIAL PROVISIONS, AND AS DIRECTED BY THE ENGINEER.

THIS PLAN IS FOR THE SOLE PURPOSE OF DETECTOR LOOP REPLACEMENTS ONLY

REPLACE ALL DETECTOR LOOPS AS SHOWN (WITHIN THE RESURFACING LIMITS)

**LONCO, INC.**  
CONSULTING ENGINEERS  
1560 WALL STREET  
NAPERVILLE, ILLINOIS 60563 PH 630/577-9100

USER NAME = #USER#	DESIGNED - MJY	REVISED -
	DRAWN - ZDA & ST	REVISED -
PLOT SCALE = #SCALE#	CHECKED - MJY	REVISED -
PLOT DATE = #DATE#	DATE - 04/15/2009	REVISED -

**STATE OF ILLINOIS  
DEPARTMENT OF TRANSPORTATION**

**DETECTOR LOOP PLAN - (IL ROUTE 50) CICERO AVENUE INTERSECTION  
183RD STREET**  
SCALE: 1" = 50' SHEET NO. 12 OF 23 SHEETS STA. 21+50 TO STA. 160+00

F.A.U. RTE. 1622	SECTION 3075 RS-1	COUNTY COOK	TOTAL SHEETS 23	SHEET NO. 12
D-91-575-09		CONTRACT NO. 60H19		
FED. ROAD DIST. NO.		ILLINOIS FED. AID PROJECT		