

MODEL: SOQ (Sheet) - 1
FILE NAME: c:\p\work\p\work\caleb.ardis@illinois.gov\1100620\468C93-sht-SOQ.dgn

				CONSTR. CODE	
				80 % FEDERAL	
				20% STATE	
CODE NO.	ITEM	UNIT	TOTAL QUANTITY	ROADWAY	
				0005	
				URBAN	
20200500	EARTH EXCAVATION (WIDENING)	CU YD	55.4	55.4	
25000750	MOWING	ACRE	40	40	
31100100	SUBBASE GRANULAR MATERIAL, TYPE A	TON	95.2	95.2	
35501301	HOT-MIX ASPHALT BASE COURSE, 4 1/4"	SQ YD	54954	54954	
35501324	HOT-MIX ASPHALT BASE COURSE, 10"	SQ YD	952.1	952.1	
40600295	POLYMERIZED BITUMINOUS MATERIALS (TACK COAT)	POUND	208905	208905	
40600405	MATERIAL TRANSFER DEVICE	TON	31292	31292	
40600982	HOT-MIX ASPHALT SURFACE REMOVAL - BUTT JOINT	SQ YD	1158.1	1158.1	
40600985	PORTLAND CEMENT CONCRETE SURFACE REMOVAL - BUTT JOINT	SQ YD	875	875	
40600990	TEMPORARY RAMP	SQ YD	1344.4	1344.4	
40603208	POLYMERIZED HOT-MIX ASPHALT BINDER COURSE, IL-9.5, N70	TON	8927	8927	
40604010	HOT-MIX ASPHALT SURFACE COURSE, IL-9.5FG, MIX "D", N50	TON	6594	6594	
40605034	POLYMERIZED HOT-MIX ASPHALT SURFACE COURSE, STONE MATRIX ASPHALT, 12.5, MIX "E", N80	TON	10202	10202	
40800050	INCIDENTAL HOT-MIX ASPHALT SURFACING	TON	142.4	142.4	

	USER NAME = caleb.ardis	DESIGNED -	REVISED -	STATE OF ILLINOIS DEPARTMENT OF TRANSPORTATION	SUMMARY OF QUANTITIES			F.A.P RTE.	SECTION	COUNTY	TOTAL SHEETS	SHEET NO.
		DRAWN -	REVISED -					318	72-[6RS;(6-1)RS-1]	PEORIA	59	4
		CHECKED -	REVISED -					CONTRACT NO. 68C93				
	PLOT DATE = 3/20/2026	DATE -	REVISED -		SCALE:	SHEET 1	OF 5 SHEETS	STA.	TO STA.	ILLINOIS FED. AID PROJECT		

MODEL: SOQ (Sheet) - 2
FILE NAME: c:\p\work\p\work\caleb.ardis@illinois.gov\1100620\468C93-shr-SOQ.dgn

CODE NO.	ITEM	UNIT	TOTAL QUANTITY	CONSTR. CODE
				80 % FEDERAL
				20% STATE
				ROADWAY
				0005
				URBAN
44000152	HOT-MIX ASPHALT SURFACE REMOVAL, 3/4"	SQ YD	1577	1577
44000164	HOT-MIX ASPHALT SURFACE REMOVAL, 3 3/4"	SQ YD	3518.3	3518.3
44000166	HOT-MIX ASPHALT SURFACE REMOVAL, 4 1/4"	SQ YD	52685	52685
44004250	PAVED SHOULDER REMOVAL	SQ YD	785.5	785.5
44200553	CLASS A PATCHES, TYPE II, 10 INCH	SQ YD	88	88
44200557	CLASS A PATCHES, TYPE III, 10 INCH	SQ YD	80	80
44200559	CLASS A PATCHES, TYPE IV, 10 INCH	SQ YD	3096.9	3096.9
44200583	CLASS A PATCHES, TYPE IV, 12 INCH	SQ YD	186.67	186.67
44213000	PATCHING REINFORCEMENT	SQ YD	4478.1	4478.1
44213200	SAW CUTS	FOOT	5735.6	5735.6
44213204	TIE BARS 3/4"	EACH	1638	1638
48101200	AGGREGATE SHOULDERS, TYPE B	TON	1706	1706
48203100	HOT-MIX ASPHALT SHOULDERS	TON	5769	5769
50300225	CONCRETE STRUCTURES	CU YD	14	14
50800205	REINFORCEMENT BARS, EPOXY COATED	POUND	1110	1110

USER NAME = caleb.ardis	DESIGNED -	REVISED -
	DRAWN -	REVISED -
	CHECKED -	REVISED -
PLOT DATE = 3/20/2026	DATE -	REVISED -

STATE OF ILLINOIS
DEPARTMENT OF TRANSPORTATION

SUMMARY OF QUANTITIES

SCALE: SHEET 2 OF 5 SHEETS STA. TO STA.

F.A.P. RTE.	SECTION	COUNTY	TOTAL SHEETS	SHEET NO.
318	72-[6RS;(6-1)RS-1]	PEORIA	59	5
CONTRACT NO. 68C93				
ILLINOIS FED. AID PROJECT				

MODEL: SOQ (Sheet) - 3
FILE NAME: c:\p\work\pwr\do\caleb.ardis@illinois.gov\1100620\468C93-shr-SOQ.dgn

CODE NO.	ITEM	UNIT	TOTAL QUANTITY	CONSTR. CODE
				80 % FEDERAL
				20% STATE
				ROADWAY
				0005
				URBAN
63000001	STEEL PLATE BEAM GUARDRAIL, TYPE A, 6 FOOT POSTS	FOOT	11925	11925
63000030	STRONG POST GUARDRAIL ATTACHED TO CULVERT	FOOT	68.75	68.75
63100045	TRAFFIC BARRIER TERMINAL, TYPE 2	EACH	13	13
63100085	TRAFFIC BARRIER TERMINAL, TYPE 6	EACH	2	2
63100167	TRAFFIC BARRIER TERMINAL, TYPE 1 (SPECIAL) TANGENT	EACH	13	13
64200108	SHOULDER RUMBLE STRIPS, 8 INCH	FOOT	51331	51331
64300260	IMPACT ATTENUATORS (FULLY REDIRECTIVE, NARROW), TEST LEVEL 3	EACH	1	1
67100100	MOBILIZATION	L SUM	1	1
70107025	CHANGEABLE MESSAGE SIGN	CAL DA	720	720
70300100	SHORT TERM PAVEMENT MARKING	FOOT	5415.0	5415.0
70300150	SHORT TERM PAVEMENT MARKING REMOVAL	SQ FT	1805	1805
70300241	TEMPORARY PAVEMENT MARKING - LINE 6"- PAINT	FOOT	73845	73845
70300251	TEMPORARY PAVEMENT MARKING - LINE 8"- PAINT	FOOT	549.24	549.24
72501000	TERMINAL MARKER - DIRECT APPLIED	EACH	28	28
78004630	PREFORMED PLASTIC PAVEMENT MARKING, TYPE D - STANDARD - LINE 6"	FOOT	73845	73845

1

	USER NAME = caleb.ardis	DESIGNED -	REVISED -	STATE OF ILLINOIS DEPARTMENT OF TRANSPORTATION	SUMMARY OF QUANTITIES				F.A.P RTE.	SECTION	COUNTY	TOTAL SHEETS	SHEET NO.
		DRAWN -	REVISED -						318	72-[6RS;(6-1)RS-1]	PEORIA	59	6
		CHECKED -	REVISED -						CONTRACT NO. 68C93				
	PLOT DATE = 3/23/2026	DATE -	REVISED -		SCALE:	SHEET 3	OF 5	SHEETS	STA.	TO STA.	ILLINOIS FED. AID PROJECT		

MODEL: SOQ (Sheet) - 4
FILE NAME: c:\p\work\pwr\cal\caleb.ardis@illinois.gov\110620\468C93-sht-SOQ.dgn

CODE NO.	ITEM	UNIT	TOTAL QUANTITY	CONSTR. CODE	
				80 % FEDERAL	
				20% STATE	
				ROADWAY	
				0005	
				URBAN	
78004640	PREFORMED PLASTIC PAVEMENT MARKING, TYPE D - STANDARD - LINE 8"	FOOT	549.24		549.24
78011035	GROOVING FOR RECESSED PAVEMENT MARKING 7"	FOOT	73845		73845
78011045	GROOVING FOR RECESSED PAVEMENT MARKING 9"	FOOT	549.24		549.24
78100100	RAISED REFLECTIVE PAVEMENT MARKER	EACH	323		323
78300200	RAISED REFLECTIVE PAVEMENT MARKER REMOVAL	EACH	323		323
* X600002	RECOVERABLE DELINEATORS	EACH	233		233
* X4400196	HOT-MIX ASPHALT SURFACE REMOVAL (SPECIAL)	SQ YD	7411.0		7411.0
* X4420559	CLASS A PATCHES, TYPE IV, 10 INCH (SPECIAL)	SQ YD	1026.5		1026.5
* 63200310	GUARDRAIL REMOVAL	FOOT	12360		12360
* X6350204	LINEAR DELINEATOR PANELS, 4 INCH	EACH	156		156
* X6370101	CONCRETE BARRIER WALL REMOVAL AND REPLACEMENT, LOCATION 1	L SUM	1		1
* X7010216	TRAFFIC CONTROL AND PROTECTION, (SPECIAL)	L SUM	1		1
* XZ013798	CONSTRUCTION STATION LAYOUT	L SUM	1		1
* Z0001002	GUARDRAIL AGGREGATE EROSION CONTROL	TON	2418.0		2418.0



USER NAME = caleb.ardis	DESIGNED -	REVISED -
	DRAWN -	REVISED -
	CHECKED -	REVISED -
PLOT DATE = 3/23/2026	DATE -	REVISED -

STATE OF ILLINOIS
DEPARTMENT OF TRANSPORTATION

SUMMARY OF QUANTITIES

SCALE: SHEET 4 OF 5 SHEETS STA TO STA.

F.A.P. RTE.	SECTION	COUNTY	TOTAL SHEETS	SHEET NO.
318	72-[6RS;(6-1)RS-1]	PEORIA	59	7
CONTRACT NO. 68C93				
ILLINOIS FED. AID PROJECT				

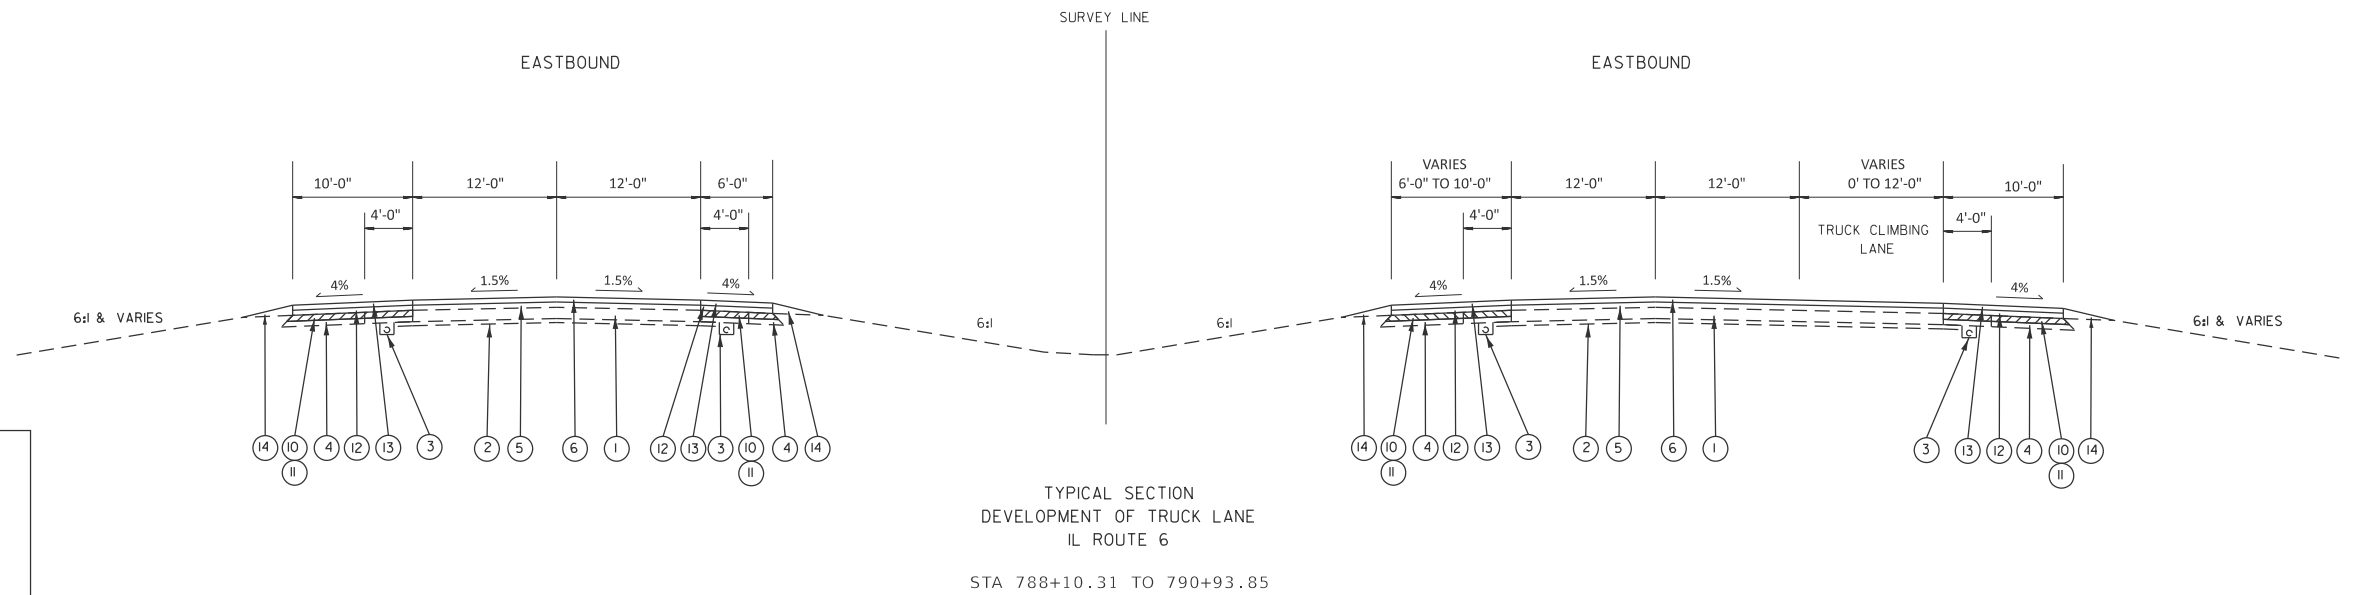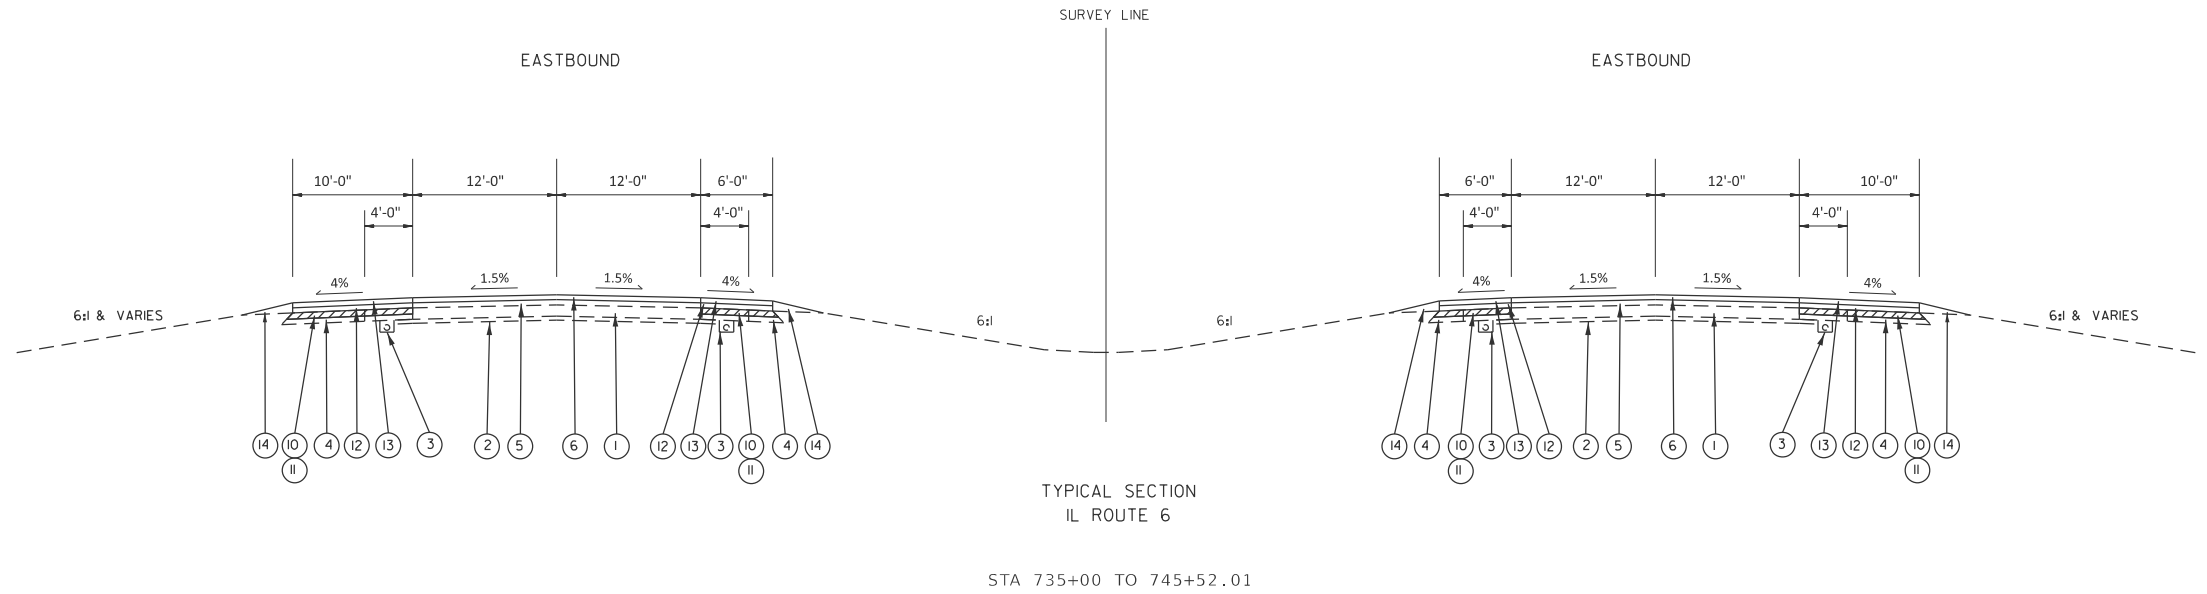

LEGEND

EXISTING ITEMS

- 1 EXISTING 10" C.R.C.P. PAVEMENT
2 EXISTING 4" STABILIZED SUB-BASE
3 EXISTING 4" PIPE UNDERDRAIN
4 EXISTING BITUMINOUS SHOULDERS

PROPOSED ITEMS

- 5 POLYMERIZED HOT-MIX ASPHALT BINDER COURSE, IL-9.5, N70, 1 3/4"
6 POLYMERIZED HOT-MIX ASPHALT SURFACE COURSE, SMA 180, 2"
9 HOT-MIX ASPHALT SURFACE REMOVAL, 3/4"
10 HOT-MIX ASPHALT SURFACE REMOVAL, ~~VARIABLE DEPTH~~
11 HOT-MIX ASPHALT SHOULDERS, 4 1/4"
12 HOT MIX ASPHALT SHOULDERS BINDER
13 HOT MIX ASPHALT SHOULDERS SURFACE
15 AGGREGATE SHOULDERS, TYPE B


4.25"

STATE OF ILLINOIS
DEPARTMENT OF TRANSPORTATION


TYPICAL SECTIONS

SCALE: SHEET 1 OF 6 SHEETS STA. TO STA.

F.A.P. RTE.	SECTION	COUNTY	TOTAL SHEETS	SHEET NO.
318	72-6RS-(6-1)RS-1	PEORIA	59	9
CONTRACT NO. 68C93				
ILLINOIS FED. AID PROJECT				

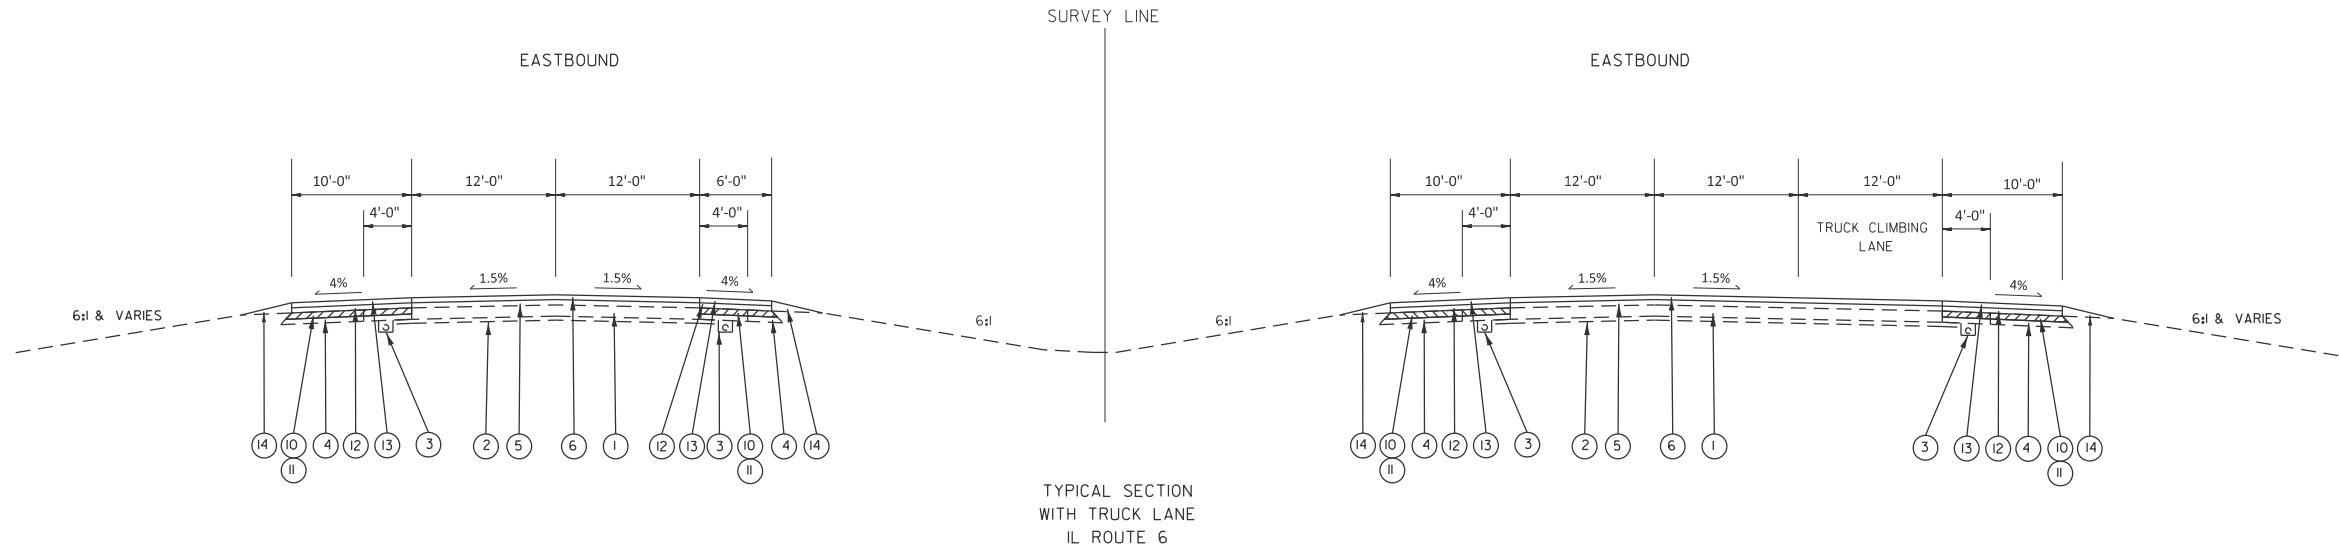

STA 790+94.07 TO 808+61.36
STA 820+19.21 TO 823+08.34
STA 849+70.10 TO 852+72.23

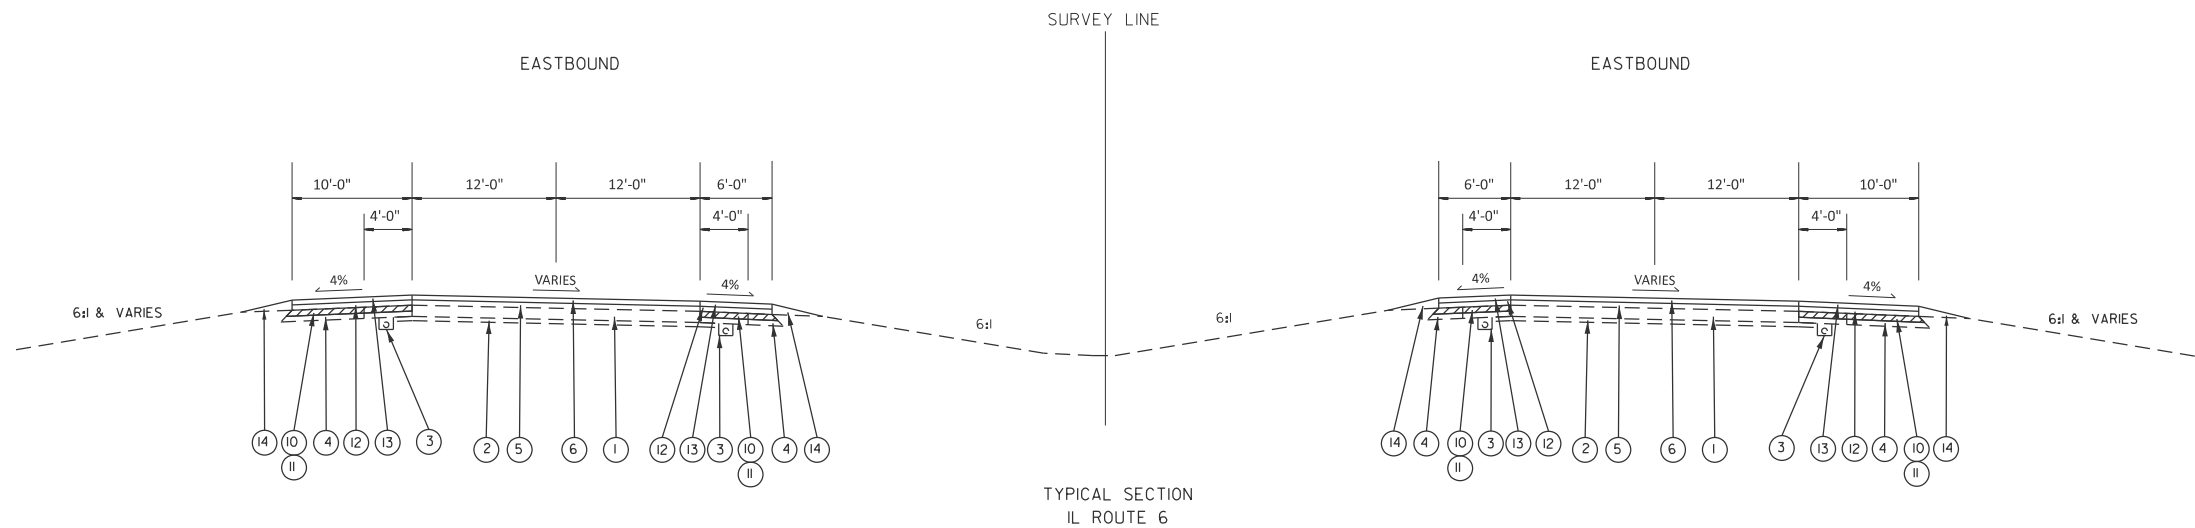

STA 735+00 TO 745+52.01

LEGEND

EXISTING ITEMS

- ① EXISTING 10" C.R.C.P. PAVEMENT
② EXISTING 4" STABILIZED SUB-BASE
③ EXISTING 4" PIPE UNDERDRAIN
④ EXISTING BITUMINOUS SHOULDERS

PROPOSED ITEMS

- ⑤ POLYMERIZED HOT-MIX ASPHALT BINDER COURSE, IL-9.5, N70, 1 3/4"
⑥ POLYMERIZED HOT-MIX ASPHALT SURFACE COURSE, SMA N80, 2"
⑨ HOT-MIX ASPHALT SURFACE REMOVAL, 3/4"
⑩ HOT-MIX ASPHALT SURFACE REMOVAL, ~~VARIABLE DEPTH~~
⑪ HOT-MIX ASPHALT SHOULDERS, 4 1/4"
⑫ HOT MIX ASPHALT SHOULDERS BINDER
⑬ HOT MIX ASPHALT SHOULDERS SURFACE
⑮ AGGREGATE SHOULDERS, TYPE B



4.25"

STATE OF ILLINOIS
DEPARTMENT OF TRANSPORTATION

TYPICAL SECTIONS

SCALE: SHEET 2 OF 6 SHEETS STA. TO STA.

F.A.P. RTE.	SECTION	COUNTY	TOTAL SHEETS	SHEET NO.
318	72-6RS-(6-1)RS-1]	PEORIA	59	10
CONTRACT NO. 68C93				
ILLINOIS FED. AID PROJECT				

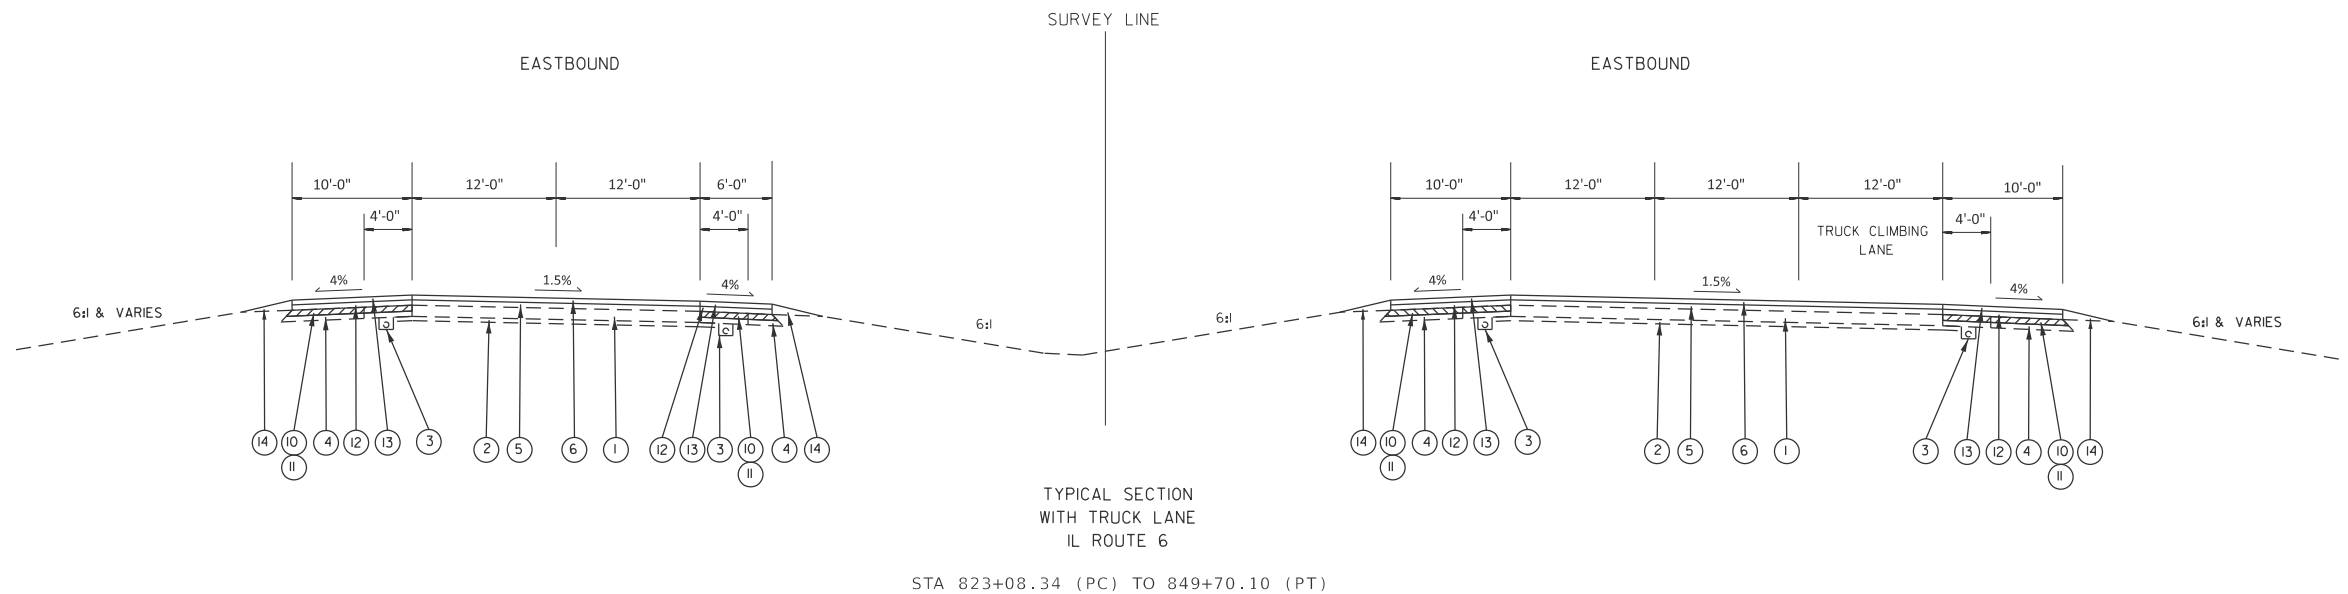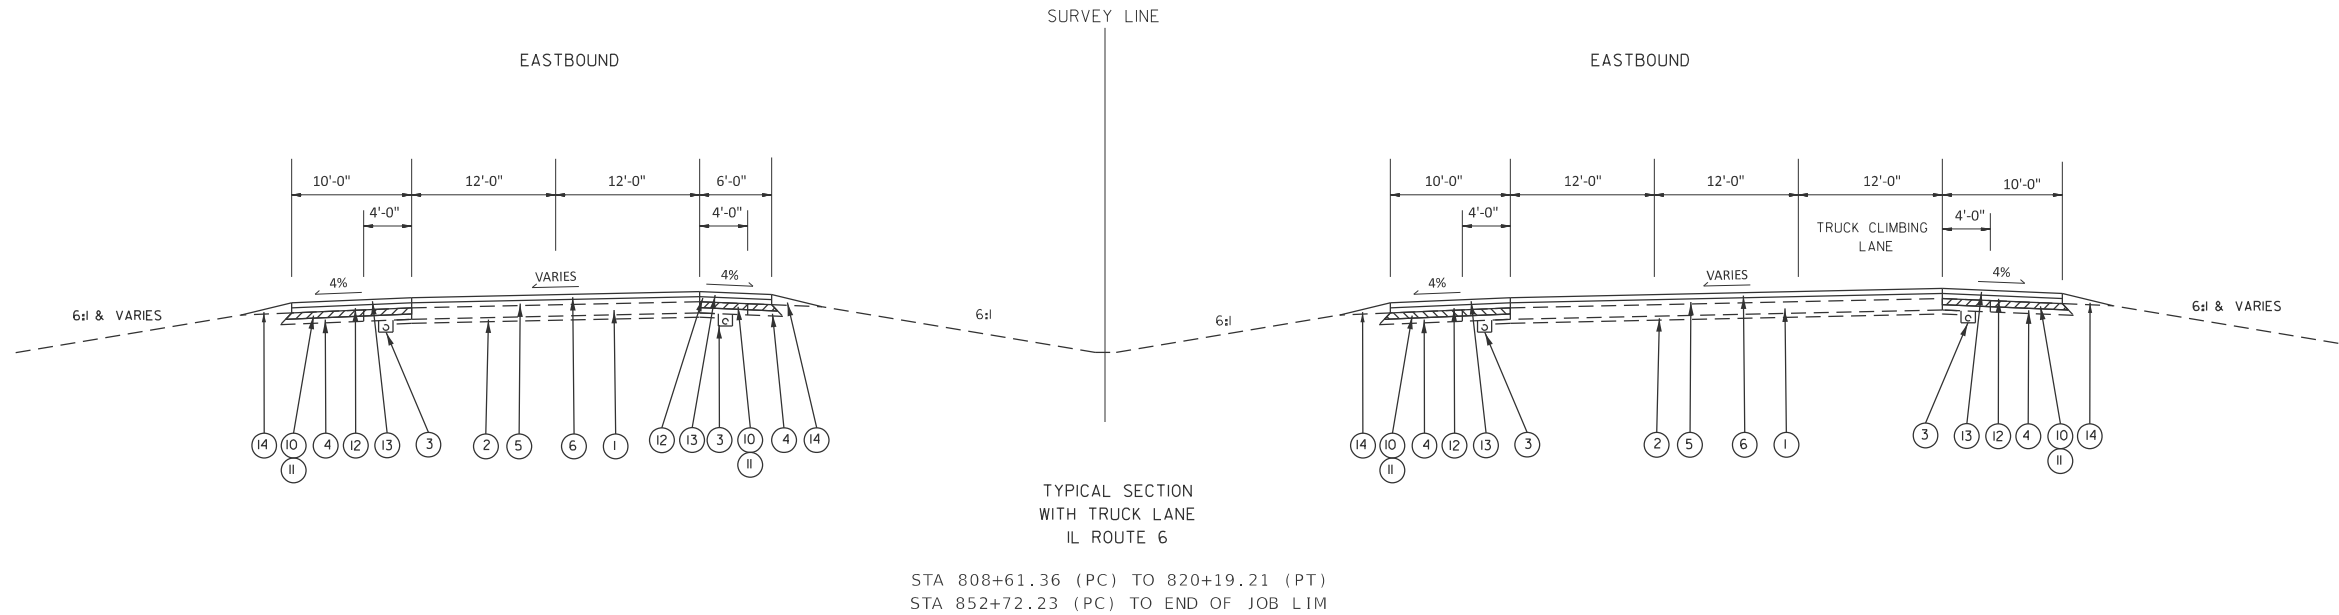

LEGEND

EXISTING ITEMS

- 1 EXISTING 10" C.R.C.P. PAVEMENT
- 2 EXISTING 4" STABILIZED SUB-BASE
- 3 EXISTING 4" PIPE UNDERDRAIN
- 4 EXISTING BITUMINOUS SHOULDERS

PROPOSED ITEMS

- 5 POLYMERIZED HOT-MIX ASPHALT BINDER COURSE, IL-9.5, N70, 1 3/4"
- 6 POLYMERIZED HOT-MIX ASPHALT SURFACE COURSE, SMA N80, 2"
- 9 HOT-MIX ASPHALT SURFACE REMOVAL, 3/4"
- 10 HOT-MIX ASPHALT SURFACE REMOVAL, VARIABLE DEPTH
- 11 HOT-MIX ASPHALT SHOULDERS, 4 1/4"
- 12 HOT MIX ASPHALT SHOULDERS BINDER
- 13 HOT MIX ASPHALT SHOULDERS SURFACE
- 15 AGGREGATE SHOULDERS, TYPE B


4.25"

STATE OF ILLINOIS
DEPARTMENT OF TRANSPORTATION

TYPICAL SECTIONS


SCALE: SHEET 3 OF 6 SHEETS STA. TO STA.

F.A.P. RTE.	SECTION	COUNTY	TOTAL SHEETS	SHEET NO.
318	72-6RS-(6-1)RS-1	PEORIA	59	11
CONTRACT NO. 68C93				
ILLINOIS FED. AID PROJECT				

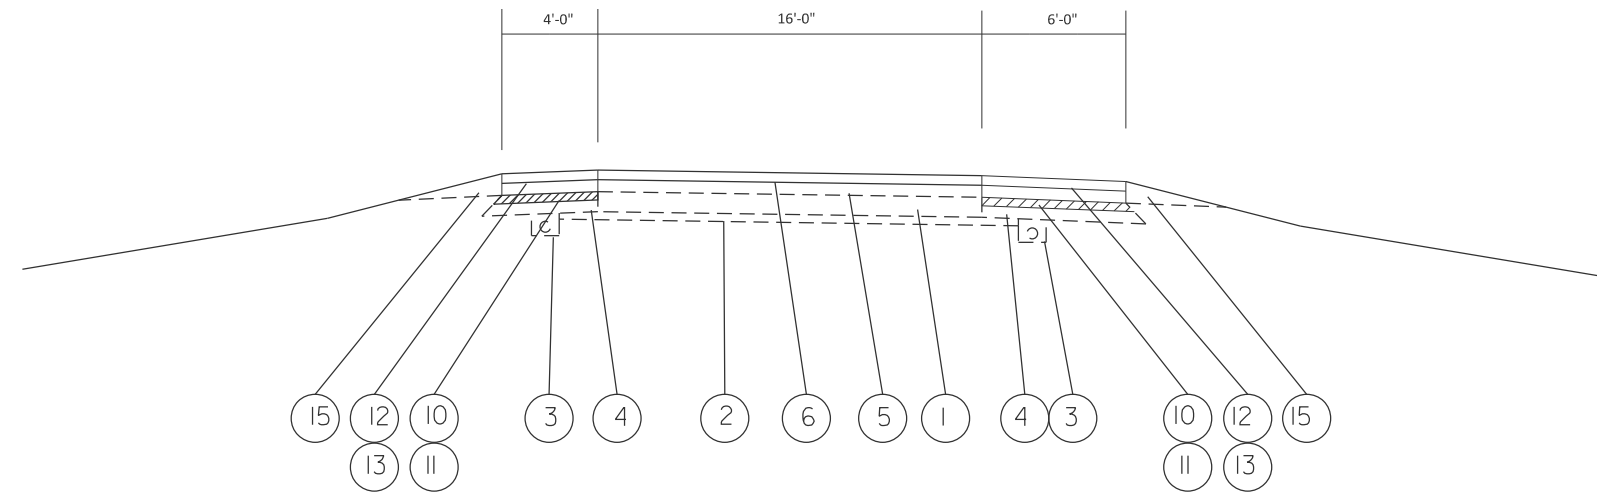

TYPICAL SECTION
RAMP B PCC EXISTING

STA 6+78.80 TO 20+00

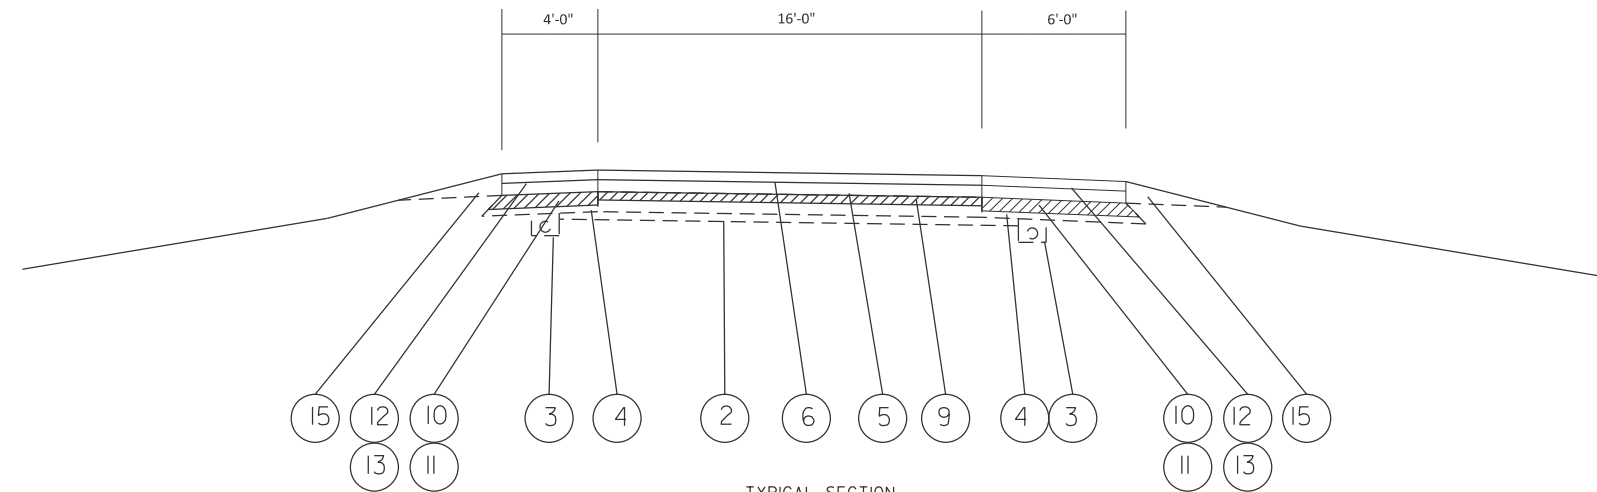

TYPICAL SECTION
RAMP B HMA EXISTING
IL ROUTE 6

STA 20+00 TO 28+50

LEGEND

EXISTING ITEMS

- 1 EXISTING 10" C.R.C.P. PAVEMENT
- 2 EXISTING 4" STABILIZED SUB-BASE
- 3 EXISTING 4" PIPE UNDERDRAIN
- 4 EXISTING BITUMINOUS SHOULDERS

PROPOSED ITEMS

- 5 POLYMERIZED HOT-MIX ASPHALT BINDER COURSE, IL-9.5, N70, 1 3/4"
- 6 POLYMERIZED HOT-MIX ASPHALT SURFACE COURSE, SMA N80, 2"
- 7 HOT-MIX ASPHALT SURFACE REMOVAL, 3/4"
- 8 HOT-MIX ASPHALT SURFACE REMOVAL, VARIABLE DEPTH
- 9 HOT-MIX ASPHALT SHOULDERS, 4 1/4"
- 10 HOT MIX ASPHALT SHOULDERS BINDER
- 11 HOT MIX ASPHALT SHOULDERS SURFACE
- 12 AGGREGATE SHOULDERS, TYPE B



4.25"

STATE OF ILLINOIS
DEPARTMENT OF TRANSPORTATION

TYPICAL SECTIONS

F.A.P. RTE.	SECTION	COUNTY	TOTAL SHEETS	SHEET NO.
318	72-6RS-(6-1)RS-1	PEORIA	59	12
CONTRACT NO. 68C93				
ILLINOIS FED. AID PROJECT				

SCALE: SHEET 4 OF 6 SHEETS STA. TO STA.

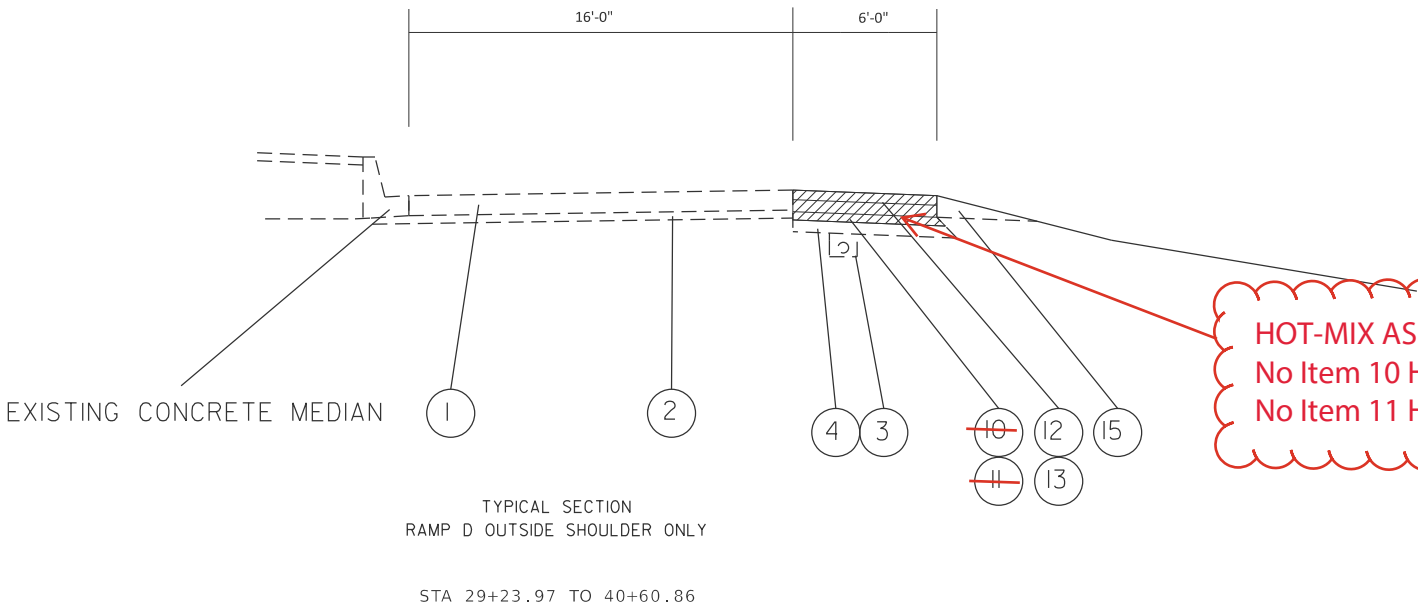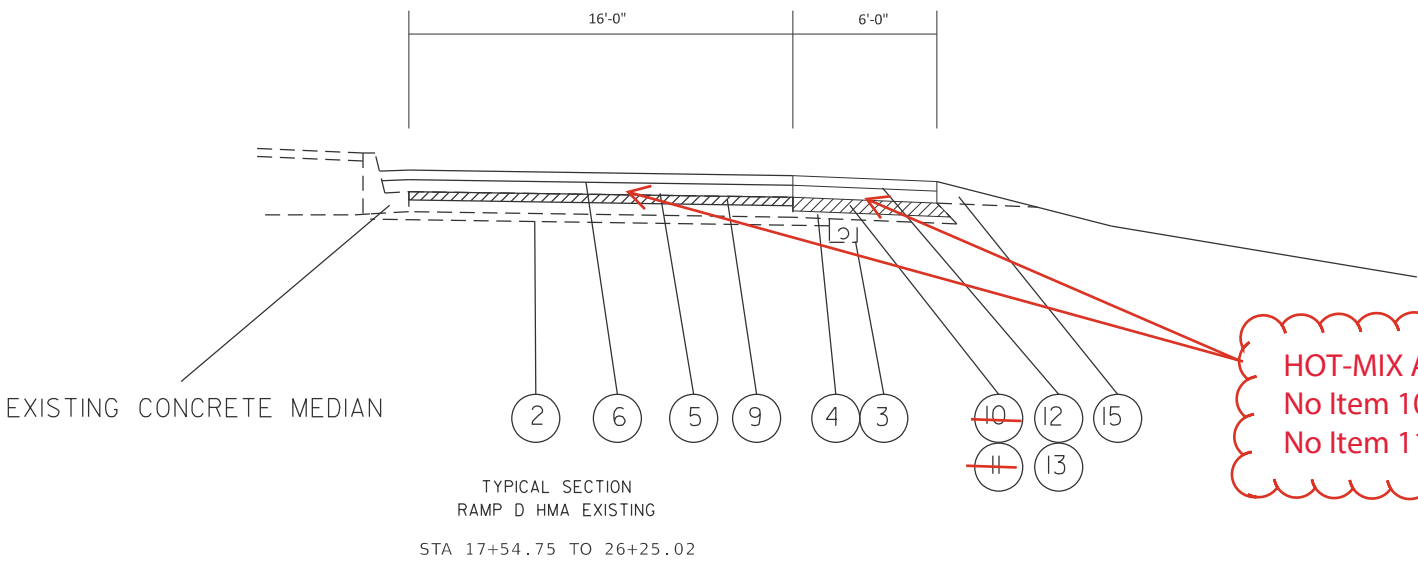

LEGEND

EXISTING ITEMS

1

EXISTING 10" C.R.C.P. PAVEMENT

2

EXISTING 4" STABILIZED SUB-BASE

3

EXISTING 4" PIPE UNDERDRAIN

4

EXISTING BITUMINOUS SHOULDERS

PROPOSED ITEMS

5

POLYMERIZED HOT-MIX ASPHALT BINDER COURSE, IL-9.5, N70, 1 3/4"

6

POLYMERIZED HOT-MIX ASPHALT SURFACE COURSE, SMA N80, 2"

9

HOT-MIX ASPHALT SURFACE REMOVAL, 3/4"

10

HOT-MIX ASPHALT SURFACE REMOVAL, ~~VARIABLE DEPTH~~ 4.25"

11

HOT-MIX ASPHALT SHOULDERS, 4 1/4"

12

HOT MIX ASPHALT SHOULDERS BINDER

13

HOT MIX ASPHALT SHOULDERS SURFACE



15

AGGREGATE SHOULDERS, TYPE B

MODEL: Typical Sections (Sheet) 5
FILE NAME: c:\p\p_work\p\work\caleb.ardis@illinois.gov\1100620\468C93-sh-typical.dgn

	USER NAME = caleb.ardis		DESIGNED -	REVISED -	STATE OF ILLINOIS DEPARTMENT OF TRANSPORTATION	TYPICAL SECTIONS			F.A.P RTE.	SECTION	COUNTY	TOTAL SHEETS	SHEET NO.
			DRAWN -	REVISED -					318	72-6RS-(6-1)RS-1	PEORIA	59	13
			CHECKED -	REVISED -					CONTRACT NO. 68C93				
	PLOT DATE = 3/20/2026		DATE -	REVISED -		SCALE:	SHEET 5	OF 6 SHEETS	STA.	TO STA.	ILLINOIS FED. AID PROJECT		

MODEL: Typical Sections (Sheet) - 6
FILE NAME: c:\p\p\work\p\work\caleb.ardis@illinois.gov\1100620\468C93-sh-typical.dgn

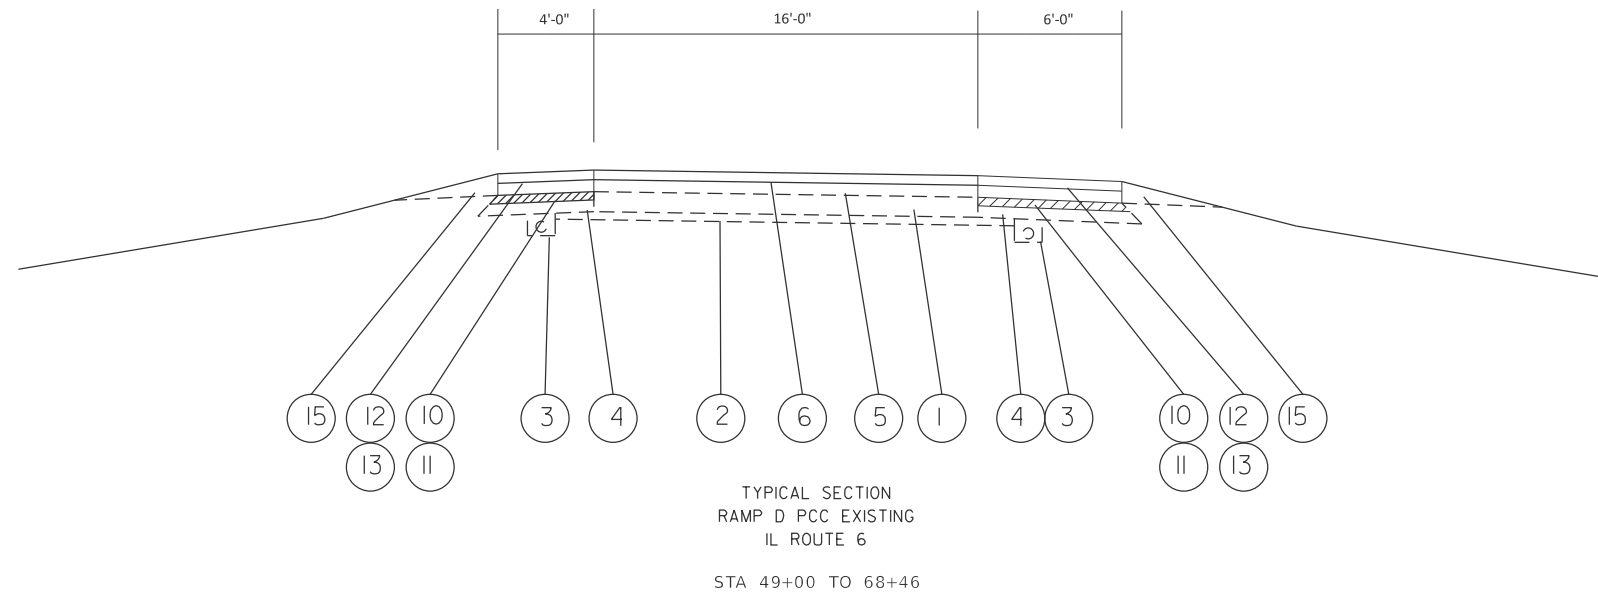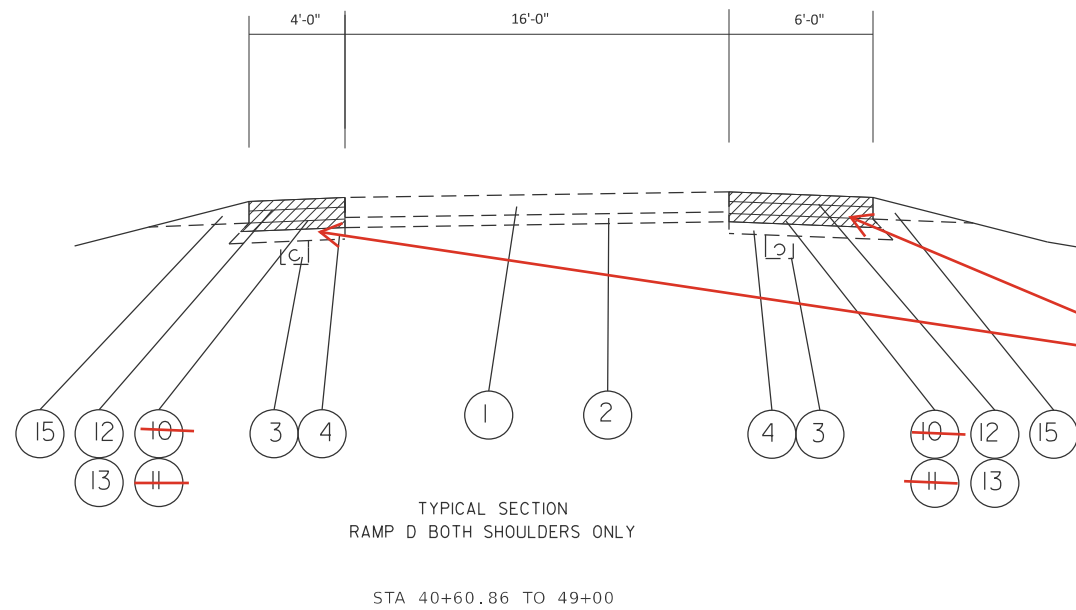

LEGEND	
EXISTING ITEMS	
1	EXISTING 10" C.R.C.P. PAVEMENT
2	EXISTING 4" STABILIZED SUB-BASE
3	EXISTING 4" PIPE UNDERDRAIN
4	EXISTING BITUMINOUS SHOULDERS
PROPOSED ITEMS	
5	POLYMERIZED HOT-MIX ASPHALT BINDER COURSE, IL-9.5, N70, 1 3/4"
6	POLYMERIZED HOT-MIX ASPHALT SURFACE COURSE, SMA N80, 2"
9	HOT-MIX ASPHALT SURFACE REMOVAL, 3/4"
10	HOT-MIX ASPHALT SURFACE REMOVAL, 4 1/4"
11	HOT-MIX ASPHALT SHOULDERS, 4 1/4"
12	HOT MIX ASPHALT SHOULDERS BINDER
13	HOT MIX ASPHALT SHOULDERS SURFACE
15	AGGREGATE SHOULDERS, TYPE B

4.25"
VARIABLE DEPTH

USER NAME = caleb.ardis	DESIGNED -	REVISED -
	DRAWN -	REVISED -
	CHECKED -	REVISED -
PLOT DATE = 3/20/2026	DATE -	REVISED -

STATE OF ILLINOIS
DEPARTMENT OF TRANSPORTATION

TYPICAL SECTIONS

SCALE: SHEET 6 OF 6 SHEETS STA. TO STA.

F.A.P. RTE.	SECTION	COUNTY	TOTAL SHEETS	SHEET NO.
318	72-6RS-(6-1)RS-1	PEORIA	59	14
CONTRACT NO. 68C93				
ILLINOIS FED. AID PROJECT				

MODEL: Schedule [Sheet] - 2
FILE NAME: c:\pw_work\pwtdot\caleb.ardis@illinois.gov\4100620\468xx-shi-schedule.dgn

HMA RESURFACING SCHEDULE 2 OF 2 RAMPS																
LOCATION				LENGTH	WIDTH	AREA	40600295		40600405	40600982	40600990	40603208	40605034	40800050	44000164	44000152
							POLY BIT. MATERIALS (TACK COAT)		MATERIAL TRANSFER DEVICE	HMA SURFACE REMOVAL - BUTT JOINT	TEMPORARY RAMP	POLY HMA BINDER CRS, N70	POLY HMA SURF. CRS, SMA N80	INCIDENTAL RESURFACING	HMA SURFACE REMOVAL, 3 3/4"	HMA SURFACE REMOVAL, 3/4"
							0.08 LB / SQ FT	0.08 LB / SQ FT								
						L*W/9	SURFACE	HMA LIFTS								
STATION	TO	STATION		FT	FT	SQ YD	LB	LB	TON	SQ YD	SQ YD	TON	TON	TON	SQ YD	SQ YD
IL 29 SPUR INTERCHANGE																
RAMP B																
6+78.80		10+81.78		402.98	0-16	358.20	257.91	257.91	75.22			35.10	40.12			
10+81.78		20+00.00		918.22	16.00	1,632.39	1,175.32	1,175.32	342.80			159.97	182.83	85.37		
20+00.00		20+15.00		15.00	16.00	26.67	19.20	19.20	5.60	26.67		2.61	2.99			
20+15.00		27+90.00		775.00	16.00	1,377.78	992.00	992.00	289.33			135.02	154.31			1,377.78
27+90.00		28+50.00		60.00	16.00	106.67	76.80	76.80	22.40	106.67	17.78	10.45	11.95			
SUBTOTAL 1:							2,521.23	2,521.23	735.36	133.33	17.78	343.17	392.19	85.37		1,377.78
RAMP D																
17+54.75		18+14.75		60.00	16.00	106.67	76.80	76.80	24.40		17.78	11.39	13.01			
18+14.75		25+17.15		702.40	16.00	1,248.71	899.07	899.07	285.64			133.30	152.34		1,248.71	0.00
48+99.22		49+49.22		50.00	16.00	88.89	64.00	64.00	20.33			9.49	10.84			
49+49.22		59+46.42		997.20	16.00	1,772.80	1,276.42	1,276.42	405.53			189.25	216.28	23.57		
59+46.42		68+46.00		899.58	0-16	799.63	575.73	575.73								
SUBTOTAL 2:							2,892.02	2,892.02	735.90	0.00	17.78	343.42	392.48	23.57	1,248.71	0.00
PAGE 2 TOTAL :								10,826.50	1,471.26	133.33	35.56	686.59	784.67	108.94	1,248.71	1,377.78
PAGE 1 TOTAL :								118,945.34	17,657.46	1,024.72	1,308.89	8,240.15	9,417.31	0.00	0.00	0.00
PAGE 1 & 2 TOTAL :								129,771.84	19,128.72	1,158.06	1,344.44	8,926.74	10,201.98	108.94	1,248.71	1,377.78

PLOT DATE = 3/20/2026	USER NAME = caleb.ardis	DESIGNED -	REVISED -
		DRAWN -	REVISED -
		CHECKED -	REVISED -
		DATE -	REVISED -

STATE OF ILLINOIS
DEPARTMENT OF TRANSPORTATION

SCHEDULE OF QUANTITIES

SCALE: SHEET 2 OF 9 SHEETS STA. TO STA.

F.A.P RTE.	SECTION	COUNTY	TOTAL SHEETS	SHEET NO.
318	72-6RS;[6-1]RS-1]	PEORIA	59	16
CONTRACT NO. 68C93				
ILLINOIS FED. AID PROJECT				

SHOULDER SCHEDULE RAMPS

LOCATION				LENGTH	WIDTH	AREA	40600295		40600405	44000164	44000166	35501301	48203100	40604010
							POLY BIT. MATERIALS (TACK COAT)		MATERIAL TRANSFER DEVICE	HMA SURFACE REMOVAL, 3 3/4"	HMA SURFACE REMOVAL, 4.25"	HMA BASE CRS, 4.25", N50, IL 19.0	HMA SHOULDER, (LOWER LIFT) 1.75" [IL 9.5]	HMA SHOULDER, (SURFACE LIFT) 2" [IL 9.5 FG]
							0.08 LB / SQ FT	0.08 LB / SQ FT						
STATION	TO	STATION		Sta2 - Sta1		L*W/9	SURFACE	HMA LIFTS						
IL 29 SPUR INTERCHANGE							LB	LB	TON	SQ YD	SQ YD	SQ YD	TON	TON
RAMP B														
13+53.16		20+00.00		646.84	10.00	359.36	258.74	258.74	75.46		359.36	359.36	35.22	40.25
20+00.00		20+15.00		15.00	10.00	8.33	6.00	6.00	1.75		8.33	8.33	0.82	0.93
20+15.00		27+90.00		775.00	10.00	430.56	310.00	310.00	90.42		430.56	430.56	42.19	48.22
27+90.00		28+50.00		60.00	10.00	33.33	24.00	24.00	7.00		33.33	33.33	3.27	3.73
SUBTOTAL 1:							598.74	598.74	174.63		831.58	831.58	81.49	93.14
RAMP D														
17+54.75		18+14.75		60.00	6.00	40.00	28.80	28.80	8.40	40.00	0	40.00	3.92	4.48
18+14.75		25+17.15		702.40	6.00	468.27	337.15	337.15	98.34	468.27	0	468.27	45.89	52.45
25+17.15		26+25.02		107.87	6.00	71.91	51.78	51.78	15.10	71.91	0	71.91	7.05	8.05
29+23.97		30+20.59		96.62	6.00	64.41	46.38	46.38	13.53	64.41	0	64.41	6.31	7.21
30+20.59		40+60.86		1,040.27	6.00	693.51	499.33	499.33	145.64	693.51	0	693.51	67.96	77.67
40+60.86		48+99.22		838.36	10.00	931.51	670.69	670.69	195.62	931.51	0	931.51	91.29	104.33
48+99.22		49+49.22		50.00	10.00	55.56	40.00	40.00	11.67		55.56	55.56	5.44	6.22
49+49.22		56+27.22		678.00	10.00	753.33	542.40	542.40	158.20		753.33	753.33	73.83	84.37
SUBTOTAL 2:							2,216.52	2,216.52	646.49	2,269.62	808.89	3,078.51	301.69	344.79
TOTALS :								5,630.52	821.12	2,269.62	1,640.47	3,910.08	383.19	437.93

EMERGENCY CROSS OVER

LOCATION				40800050	35501324	48203100	40604010	31100100	44000152	44004250	20200500
				INCIDENTAL RESURFACING	HMA BASE CRS, 10", N50, IL 19.0	HMA SHOULDER, (LOWER LIFT) 1.75" [IL 9.5]	HMA SHOULDER, (SURFACE LIFT) 2" [IL 9.5 FG]	SUB-BASE GRAN. MAT., TYPE A	HMA SURFACE REMOVAL, 3/4"	PAVED SHOULDER REMOVAL	EARTH EX. WIDENING
STATION	TO	STATION		TON	SQ YD	TON	TON	TON	SQ YD	SQ YD	CU YD
757+93.00		762+22.00			473.00	46.35	52.98	47.30		392.40	26.80
762+22.00		762+63.60		33.50					199.50		
762+63.60		766+92.60			479.10	46.95	53.66	47.90		393.10	28.60
TOTALS :				33.50	952.10	93.31	106.64	95.20	199.50	785.50	55.40

MODEL: Schedule [Sheet] - 4
FILE NAME: c:\pw_work\pwtdotcaleb.ardis@illinois.gov\1100620\0468xx-sh-schedule.dgn

PLOT DATE	USER NAME = caleb.ardis		DESIGNED -	REVISED -
			DRAWN -	REVISED -
			CHECKED -	REVISED -
	DATE = 3/20/2026		DATE -	REVISED -

STATE OF ILLINOIS
DEPARTMENT OF TRANSPORTATION

SCHEDULE OF QUANTITIES

SCALE: SHEET 4 OF 9 SHEETS STA. TO STA.

F.A.P RTE.	SECTION	COUNTY	TOTAL SHEETS	SHEET NO.
318	72-6RS;(6-1)RS-1]	PEORIA	59	18
CONTRACT NO. 68C93				
ILLINOIS FED. AID PROJECT				