

06-12-2026 LETTING ITEM 118

ATLAS TECHNICAL CONSULTANTS LLC
KYLE J. CHAMBERLAIN, P.E.
#065461192



DATE: 02/20/2026
SIGNATURE AND SEAL


EXPIRATION DATE: 11-30-2027

FOR INDEX OF SHEETS, SEE SHEET NO. 2

ROADWAY CLASSIFICATION - INTERSTATE
AVERAGE DAILY TRAFFIC - YEAR 2025

I-72:
ADT = 8,450
SU = 3.25%
MU = 31.95%
PV = 64.79%

I-172:
ADT = 12,500
SU = 3.20%
MU = 13.20%
PV = 83.60%

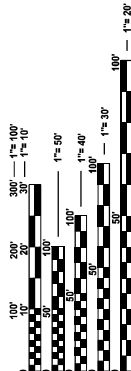

JULIE E.
JOINT UTILITY LOCATION INFORMATION FOR EXCAVATION
1-800-492-0723
OR 811

PROJECT ENGINEER JON KELLEY (217) 785-2739
PROJECT MANAGER CHRIS SIEFERT (217) 524-7940


CONTRACT NO. 72639

STATE OF ILLINOIS
DEPARTMENT OF TRANSPORTATION

PROPOSED
HIGHWAY PLANS


FAI ROUTE 72, 172 (I 72, 172)
SECTION (1-2)SR, (75-1)SR-1
PROJECT NHPP-VI6W (201)
SHOULDER REPAIR
ADAMS, PIKE COUNTY

C-96-047-26

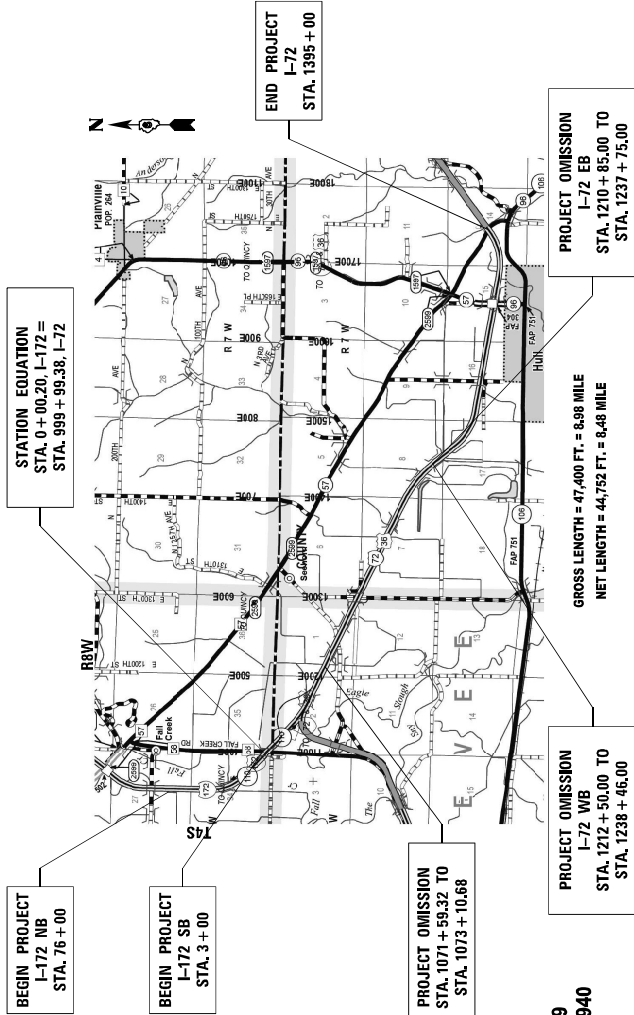

CAL. SHEET	SECTION	COUNTY	TOTAL SHEET
72-172	C-96-047-26	ADAMS, PIKE	26
NAME: CONTRACT NO. 72639			
TOTAL SHEETS=28+2=30 SHEETS			

D-96-017-26

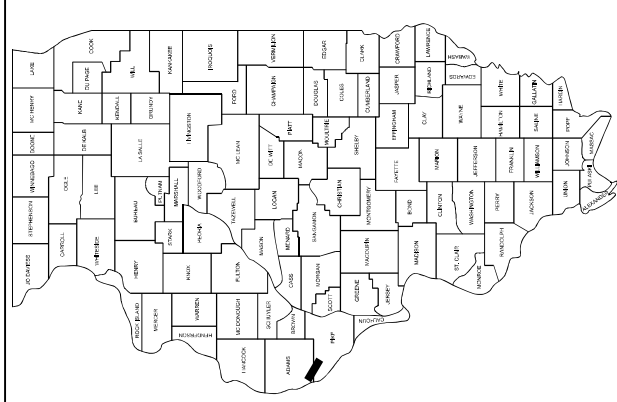

LOCATION OF SECTION INDICATED THUS: -

STATE OF ILLINOIS
DEPARTMENT OF TRANSPORTATION

SUBMITTED March 20, 2026
Teresa C. Price
REGIONAL ENGINEER

May 8, 2026
Chris Siefert
ENGINEER OF DESIGN AND EXCAVATION

May 8, 2026
Jon Kelley
DIRECTOR OF HIGHWAYS PROJECT IMPLEMENTATION

PRINTED BY THE AUTHORITY
OF THE STATE OF ILLINOIS

REV. 6-2-2026

PPSW 6-01466-0000			
NHPP FUNDING			
90% FED/10% STATE/90% FED/10% STATE			
ADAMS COUNTY		PIKE COUNTY	
ROADWAY		ROADWAY	
0021		0021	
RURAL		RURAL	
0.1		0.9	
67100100	MOBILIZATION	L SUM	1
70100420	TRAFFIC CONTROL AND PROTECTION, STANDARD 701411	EACH	6
70100450	TRAFFIC CONTROL AND PROTECTION, STANDARD 701201	L SUM	1
70100800	TRAFFIC CONTROL AND PROTECTION, STANDARD 701401	L SUM	1
70100820	TRAFFIC CONTROL AND PROTECTION, STANDARD 701451	L SUM	1
70107025	CHANGEABLE MESSAGE SIGN	CAL DA	172
78009006	MODIFIED URETHANE PAVEMENT MARKING-LINE 6"	FOOT	177961
78009007	MODIFIED URETHANE PAVEMENT MARKING-LINE 5"	FOOT	177961
78009008	MODIFIED URETHANE PAVEMENT MARKING-LINE 8"	FOOT	10893
X4820110	HOT-MIX ASPHALT SHOULDER REMOVAL AND REPLACEMENT	SO YD	7500
78009012	MODIFIED URETHANE PAVEMENT MARKING-LINE 12"	FOOT	979
X8010100	CLEANING UNDERDRAIN OUTLETS	EACH	160
X16570201	OUTLET MARKER	EACH	164
X7202023	DETOUR SIGNING	L SUM	1
Z0076600	TRAINEES	HOURL	2500
Z0076604	TRAINEES TRAINING PROGRAM/ GRADUATE	HOURL	2500

* SPECIALTY ITEM Ø 0042

~~ATLAS~~

	USER NAME	maliglynn	DESIGNED	REVISED
			DRAWN	REVISED
			CHECKED	REVISED
	PLT DATE	3/19/2026	DATE	REVISED

STATE OF ILLINOIS
DEPARTMENT OF TRANSPORTATION

SUMMARY OF QUANTITIES

SUMMARY OF QUANTITIES									
				F.A.I. RATE.		SECTION		COUNTY	
				72.172		(1-2)SR. (75-1)SR-1		ADAMS, PIKE	
								TOTAL SHEETS NO.	
								28	
								4	
								CONTRACT NO. 72639	
								FURNISH LEDA APPROVE	
SCALE: N.T.S.		SHEET 2 OF 2		SHEETS		STA.		TO STA.	

REV - MS

1 REV. 6-2-2026

MODEL: Named Boundary Sheet H
FILE NAME: c:\msps\pwe-ueast-007\main\glyn\dms41886\D672639-sh-SOC-02.dgn

CONTRACT.

CONTRACT.

~~ATLAS~~

NOTES:
1. SEE SHEET 16 FOR IL 96 INTERCHANGE RAMP'S RADIUS RETURN DETAILS.



USER NAME = Malik, Glynn	DESIGNED =	REVISED =
	DRAWN =	REVISED =
	CHECKED =	REVISED =
DATE = 8/20/2006	DATE =	REVISED =

STATE OF ILLINOIS
DEPARTMENT OF TRANSPORTATION

SCHEDULE OF QUANTITIES

LOCAL RTE.	SECTION	COUNTY	TOTAL SHEET NO.
2, 172	(1-2)SR, (75-1)SR-1	ADAMS, PIKE	28 6
			CONTRACT NO. 72639

REV 6-2-2026

[illegible]

MEASURED IN CADD ALONG RADIUS RETURN

* MEASURED IN CADD ALONG RADIUS RETURN

** NOTE - QUANTITY IS FOR EDGE LINE STRIPES ONLY. LANE LINE SKIP DASHES TO BE APPLIED ON A SEPARATE CONTRACT

* MEASURED IN CADD ALONG RADIUS RETURN

** NOTE - QUANTITY IS FOR EDGE LINE STRIPES ONLY. LANE LINE SKIP DASHES TO BE APPLIED ON A SEPARATE CONTRACT

ROADWAY	BEGIN STATION	END STATION	DIRECTION	SHOULDER	LENGTH (FOOT)	BITUMINOUS MATERIALS (TACK COAT)		EMERGENCY MEDIAN CROSSOVER SCHEDULE										25000700	25000800	25100115
						AREA (SQ FT)	APPLICATION (LBS/SQ FT)	46080280 BITUMINOUS SPHALT (TACK COAT)	46091605 HOT-MIX SPHALT REMOVAL 4" (SQ YD)	46102100 AGGREGATE WEDGE TYPE B	46203100 HOT-MIX ASPHALT SHOULDERS 4" (SQ YD)	46203100 HOT-MIX ASPHALT SHOULDERS (TON)	70000000 MODIFIED URETHANE MARKING LINE 6"	70000000 EARTH EXPOSURE (CU YD)	25000200	25000400	25000500			
I-72	0+84.00	7+69.00	NB	INSIDE	665	2,264	0.075	545	625	24	196	181	685	44	0.156	13.5	0.3	0.156		
I-72	110+485.00	111+700.00	VB	INSIDE	895	8,421	0.075	482	541	22	174	160	685	44	0.156	13.5	0.3	0.156		
I-72	1104+70.00	111+450.00	NB	INSIDE	895	8,421	0.075	482	541	22	174	160	685	44	0.156	13.5	0.3	0.156		
I-72	1305+485.00	1312+500.00	WB	INSIDE	665	2,264	0.075	482	541	22	174	160	685	44	0.156	13.5	0.3	0.156		
I-72	1305+485.00	1312+500.00	VB	INSIDE	895	8,421	0.075	482	541	22	174	160	685	44	0.156	13.5	0.3	0.156		
TOTAL	1299+650.00	1306+520.00	WB	INSIDE	665	2,471	2.769	2,471	2,769	113	884	820	3,426*	219	0.8	68	1.5	0.68		

* NOTE - QUANTITY IS FOR EDGE LINE STRIPES ONLY. LANE LINE SKIP DASHES TO BE APPLIED ON A SEPARATE CONTRACT

SCHEDULE	SCHEDULE GRAND TOTALS										25100115			
	40000290	44000165	48102100	48203100	48203110	64200116	76000010	76000012	20200100	25000200		25000400	25000500	25000600
BITUMINOUS SURFACING (TACK COAT)	40000290	HOT-MIX ASPHALT REMOVAL, 4" (SQ YD)	AGGREGATE WEDGE SHOULDER, 4" (TON)	HOT-MIX SHOULDER STRIPS, 16" (FOOT)	HOT-MIX SHOULDER STRIPS, 16" (FOOT)	MODIFIED URETHANE MARKING, LINE 8" (FOOT)	MODIFIED URETHANE MARKING, LINE 8" (FOOT)	MODIFIED URETHANE MARKING, LINE 12" (FOOT)	EARTH EXCAVATION (CU YD)	SEEDED, CLASS 2 (ACRES)	NITROGEN FERTILIZER NUTRIENT (POUND)	PHOSPHORUS FERTILIZER NUTRIENT (POUND)	POTASSIUM FERTILIZER NUTRIENT (POUND)	AGRICULTURAL LIMESTONE (TON)
H-172/H-72 MAINLINE, NB&WB	48,671	72,105		16,152	79,622	83,116								
H-172/H-72 MAINLINE, SB&WB	40,418	59,878		69,348	13,413									
INTERCHANGE RAMPS	9,210	13,645		3,056	22,071	22,071	10,893	979		0.8	69	68	68	1.5
EMERGENCY MEDIANS	2,476	2,783	113	884	820	168,735	15,893	570			55	55	55	0.8

TOTAL	100,770	140,517	113	504	53,141	100,210
-------	---------	---------	-----	-----	--------	---------

NOTE - QUANTITY IS FOR EDGING STRIPES ONLY. LANE LINE SKID DASHES TO BE APPLIED ON A SEPARATE CONTRACT.

SCHEDULE GRAND TOTALS

3009006 7800908

MODIFIED	MODIFIED
----------	----------

URETHANE	URETHANE
PAVEMENT	PAVEMENT

	MARKING -	MARKING -
QUESTION	ANSWER	MARKS
1.		
2.		
3.		
LINE 6"	LINE 8"
FEET	FEET

FOOT)	(FOOT)	
33,116		

	69,348	40,000	60,000
--	--------	--------	--------



22,071	10,893
3,425	

77,961^	10,893
---------	--------

STATE OF ILLINOIS

STATE OF ILLINOIS DEPARTMENT OF TRANSPORTATION

1000000

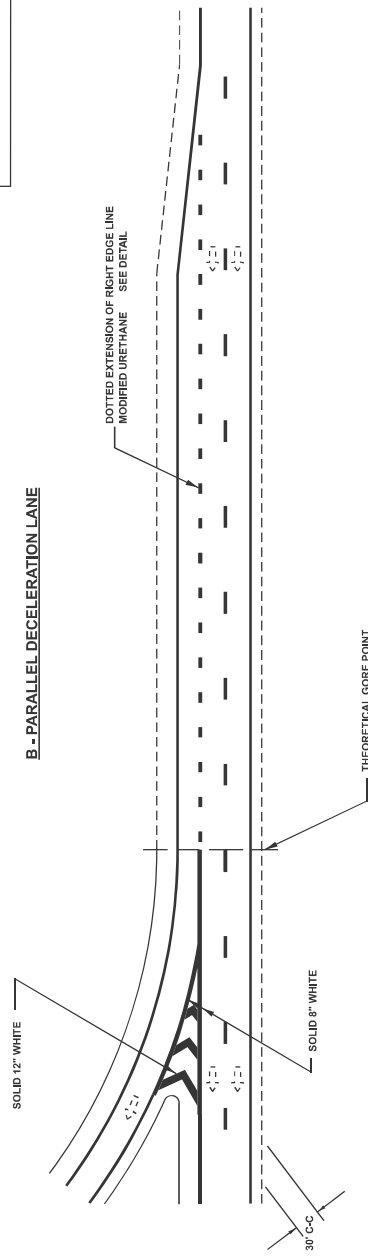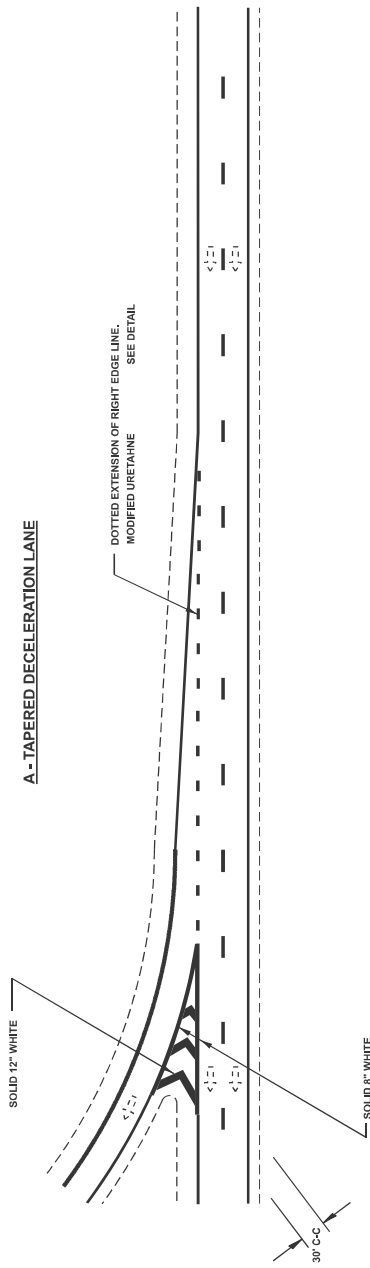

3' 9' 3' 9' 3' 3'

INTERSTATE 6" SKIP-DASH WHITE
NON-INTERSTATE 5" SKIP-DASH WHITE

300"
OPTIONAL

DETAIL

EXIT RAMP MARKINGS

[illegible]