


ATCT EXISTING AND PROPOSED CONTROL WIRES

N.T.S.

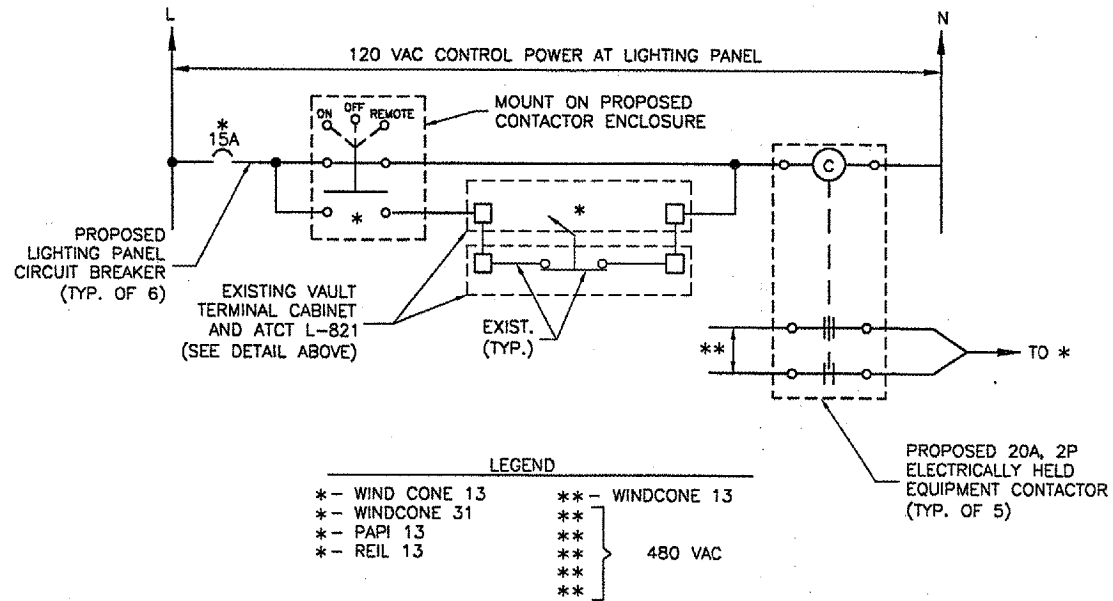

ATCT CONTROL WIRING WINDCONE, PAPI AND REIL

N.T.S.

REVISIONS		
NUMBER	BY	DATE

0 1 2
 THIS BAR IS EQUAL TO 2"
 AT FULL SCALE (34X22).



SPRINGFIELD AIRPORT AUTHORITY
 ABRAHAM LINCOLN CAPITAL AIRPORT
 SPRINGFIELD, ILLINOIS

CONSTRUCT RUNWAY 13/31 RSA IMPROVEMENTS

RECORD DRAWING 5

© Copyright CMT, Inc.

CMT
 CRAWFORD, MURPHY & TILLY, INC.
 CONSULTING ENGINEERS
 License No. 184-000633

DESIGN BY: WDP
 DRAWN BY: CMT
 CHECKED BY: RLW
 APPROVED BY: RLW
 DATE: 04/24/07
 JOB No: 05035-03

IL PROJ. NO. SPI-3488
 AIP PROJ. NO. 3-17-0096-42

RECORD DRAWING
 THIS PLAN SHEET IS PROVIDED FOR INFORMATION ONLY TO ASSIST THE CONTRACTOR IN MAKING THE MODIFICATIONS SHOWN ON THE PLANS AND IN THE SPECIFICATIONS. THE INFORMATION PROVIDED IS BASED ON BEST-AVAILABLE RECORD DRAWINGS OF EXISTING CONDITIONS IN THE VAULT. THE CONTRACTOR SHALL VERIFY ALL EXISTING CONDITIONS PRIOR TO COMMENCING WORK.