THE LOCATION OF BURIED AND ABOVE GROUND UTILITIES SHOWN IS FOR THE CONTRACTOR'S INFORMATION ONLY AND IS NOT TO BE REFERENCED FOR CONSTRUCTION PURPOSES. THE IMPLIED PRESENCE OR ABSENCE OF LITTLITIES IS NOT TO BE CONSTRUED BY THE OWNER, ENGINEER, CONTRACTOR OR SUB-CONTRACTOR TO BE AN ACCURATE AND COMPLETE REPRESENTATION OF UTILITIES THAT MAY OR MAY NOT EXIST ON THE CONSTRUCTION SITE. IT SHALL BE THE CONTRACTOR'S RESPONSIBILITY TO COORDINATE HIS CONSTRUCTION ACTIVITIES WITH THE VARIOUS UTILITY OWNERS. ALL POTENTIAL CONFLICTS SHALL BE INVESTIGATED AND REMEDIAL ACTION TAKEN PRIOR TO INTERRUPTION OF THE CONTRACTOR'S PROGRESS.

UTILITY FACILITIES THAT REQUIRE RELOCATION WITHIN STATE R.O.W. SHALL BE COMPLETED BY THE UTILITY COMPANY UNLESS OTHERWISE SHOWN ON THE PLANS.

- 2. IN ADDITION TO FIELD SURVEYS AND AERIAL SURVEYS. PLAN DIMENSIONS AND DETAILS RELATIVE TO EXISTING FACILITIES HAVE BEEN TAKEN FROM EXISTING PLANS AND ARE SUBJECT T CONSTRUCTION VARIATIONS. IT SHALL BE THE CONTRACTOR'S RESPONSIBILITY TO VERIFY SUCH DIMENSIONS AND DETAILS IN THE FIELD. SUCH VARIATIONS SHALL NOT BE CAUSE FOR ADDITIONAL COMPENSATION DUE TO A CHANGE IN THE SCOPE OF WORK. HOWEVER, THE CONTRACTOR WILL BE PAID FOR THE QUANTITY ACTUALLY FURNISHED AT THE AGREED UNIT PRICE BID FOR THE WORK.
- 3. ALL STATION AND OFFSET REFERENCES ARE TO THE ROADWAY CENTERLINE UNLESS OTHERWISE NOTED. THE STATE PLANE COORDINATE SYSTEM HAS BEEN USED FOR THE HORIZONTAL CONTROL.
- 4. ALL ELEVATIONS SHOWN ON THE PLANS ARE BASED ON U.S.G.S. MEAN SEA LEVEL DATUM.
- ANY REFERENCE WITHIN THESE PLANS TO A STANDARD SHALL BE INTERPRETED TO MEAN THE EDITION INDICATED BY THE SUB-NUMBER LISTED ON THE PREVIOUS SHEET OR THE COPY INCLUDED IN THESE PLANS.
- 6. THE ENGINEER SHALL BE THE SOLE JUDGE CONCERNING CURING TIME FOR THE VARIOUS BITUMINOUS LIFTS.
- 7. IF SO DIRECTED BY THE ENGINEER, DITCHES ADJACENT TO EMBANKMENTS SHALL BE CONSTRUCTED PRIOR TO STARTING THE CONSTRUCTION OF THE EMBANKMENT FILL.
- 8. GRADING SHALL BE DONE BY HAND AROUND LIGHT POLES, LITILITY POLES, SIGN POSTS, SHRUBS, TREES OR OTHER NATURAL OR MAN-MADE OBJECTS WHERE SHALLOW FILLS OR CUTS ARE ADJACENT TO THE ITEMS. IT IS THE INTENT THAT THE LIMITS OF CONSTRUCTION BE SUCH AS TO PRESERVE IN THE ORIGINAL STATE AS MUCH AREA OF TEMPORARY EASEMENTS AS POSSIBLE. THE DECISION AS TO ITEMS TO REMAIN IN PLACE SHALL BE DIRECTED BY THE ENGINEER. THIS WORK WILL NOT BE PAID FOR SEPARATELY, BUT SHALL BE CONSIDERED INCLUDED IN THE CONTRACT UNIT PRICE PER CUBIC YARD FOR EARTH EXCAVATION, AND NO ADDITIONAL COMPENSATION WILL BE ALLOWED.
- SEEDING SHALL BE DONE ON ALL AREAS THAT ARE DISTURBED BY CONSTRUCTION OPERATIONS AS DIRECTED BY THE ENGINEER. SEEDING SHALL BE PAID FOR ONLY WITHIN THE PROPOSED RIGHT-OF-WAY OR EASEMENT LIMITS. ALL AREAS DISTURBED BY THE CONTRACTOR OUTSIDE THE PROPOSED CONSTRUCTION LIMITS SHALL BE SEEDED, AS DIRECTED BY THE ENGINEER, AT THE CONTRACTOR'S EXPENSE.

FACTORS LISED FOR ESTIMATING PLAN QUANTITIES OR LISAGE ARE AS FOLLOWS AND SHALL NOT BE USED FOR THE BASIS OF FINAL QUANTITIES:

> HMA CONCRETE LEVELING BINDER HMA CONCRETE BASE COURSE 112 LBS./SO. YD.-IN. 112 LBS./SO. YD.-IN. HMA CONCRETE BINDER COURSE 112 LBS./SQ. YD.-IN HMA CONCRETE SURFACE COURSE 112 LBS./SQ. YD.-IN. HMA SHOULDERS 112 LBS./SO. YD.-IN. SO. YD. OF SUBGRADE

> > 110 LBS./CU. FT.

2.05 TONS/CILYD.

1.89 TONS/CU. YD.

0.00038 TON/SO. YD. (0.1 GAL/SQ. YD.)

0.00019 TON/SQ. YD. (0.05 GAL/SQ. YD.)

0.0014 TON/SO, YD

(0.35 GAL/ SQ. YD.)

SOIL (DRY DENSITY) AGGREGATE

- PUGGED AGGREGATE - ALL OTHER AGGREGATE BITUMINOUS MATERIALS: ON PAVEMENT
- INTERMEDIATE LIFTS (FOG COAT) - ON AGGREGATE SURFACE
- AGGREGATE (PRIME COAT)
- 4 LRS /S0 YD SEEDING FERTILIZER RATIO (NIT:PHOS:POT) 90:90:90 LBS./AC. AGRICULTURAL GROUND LIMESTONE 2.00 TONS/AC.
- THE QUANTITY OF SHORT TERM PAVEMENT MARKING SHOWN IN THE PLANS IS BASED ON ONE APPLICATION EACH FOR THE BINDER COURSE AND SURFACE COURSE.
- ACCESS TO ALL PRIVATE ENTRANCES SHALL BE MAINTAINED AT ALL TIMES. OUANITIES FOR TEMPORARY ACCESS (PRIVATE ENTRANCE)-EACH, TEMPORARY ACCESS (FIELD ENTRANCE)-EACH, TEMPORARY ACCESS (COMMERCIAL ENTRANCE)-EACH, AND TEMPORARY ACCES (COMMERCIAL ENTRANCE)-EACH, AND TEMPORARY ACCES (ROAD)-EACH HAVE BEEN ESTIMATED FOR THIS WORK, THESE QUANTITIES SHALL BE USED AS DIRECTED BY THE ENGINEER FOR MAINTAINING ACCESS.
- FOR STABILIZATION. ALL TYPE III BARRICADES SHALL REQUIRE A MINIMUM OF EIGHT SAND BAGS PER BARRICADE.
- PROPOSED LIGHT POLE FOUNDATIONS SHALL BE CONSTRUCTED FLUSH WITH THE PROPOSED FINISHED SURFACE.
- THE DISTRICT BUREAU OF OPERATIONS SHALL BE NOTIFIED AT LEAST 14 DAYS PRIOR TO PLACEMENT OF FINAL AND TEMPORARY PAVEMENT MARKINGS PH: (217) 782-7314. THE BUREAU OF OPERATIONS WILL THEN DETERMINE THE ACTUAL LIMITS TO BE STRIPED AS "NO PASSING
- ONLY THOSE TREES LISTED IN THE TREE REMOVAL SCHEDULE SHALL BE REMOVED. THE CONTRACTOR SHALL PROTECT ALL REMAINING TREES, PLANTS, AND WETLANDS FROM DAMAGE. ALL TREES AND STUMPS INDICATED ON THE PLANS FOR REMOVAL SHALL BE REMOVED AND DISPOSED OF BY THE CONTRACTOR.
- WHERE PROPOSED CONSTRUCTION ABUTS EXISTING APPURTENCES, A SAW CUT SHALL BE MADE TO ACHIEVE A NEAT BUTT JOINT. SAW CUTS FOR PAVEMENT PATCHES WILL NOT BE MEASURED FOR PAYMENT. ALL OTHER SAWED JOINTS FOR REMOVALS AND BUTT JOINTS SHALL BE CONSIDERED INCLUDED IN ITEM BEING REMOVED OR CONSTRUCTED.
- GUARDRAIL MARKERS SHALL NOT BE ATTACHED TO PROPOSED "TRAFFIC BARRIER TERMINAL TYPE 1 SPECIAL" RAIL ELEMENTS.
 MARKERS IN THE AREA OF THE TRAFFIC BARRIER TERMINAL TYPE 1 SPECIAL SHALL BE MOUNTED ON THE NEAREST POST.
- CONNECT UNDERDRAINS TO MEDIAN STRUCTURES THRU PRECAST BLOCKOUTS. THE PRECAST BLOCKOUTS SHALL BE INCLUDED IN THE COST FOR PAY ITEM- UNDERDRAINS 4 INCH.
- BEFORE ORDERING PIPE CULVERTS, PIPE DRAINS OR MANHOLES, THE CONTRACTOR SHALL CONTACT THE ENGINEER FOR EXACT LENGTHS. 20.
- ALL OPENINGS IN PRECAST STRUCTURES, INCLUDING BOX CULVERTS, SHALL BE PRECAST TO THE PROPER SIZE. THIS INCLUDES OPENINGS FOR PIPE STRUCTURES, MANHOLE OPENINGS AND OPENINGS FOR PIPE UNDERDRAIN. COSTS FOR THESE OPENINGS AND THE CONNECTIONS SHALL BE CONSIDERED INCLUDED IN THE VARIOUS PAY ITEMS FOR THE STRUCTURES INVOLVED.
- ALL DRAINAGE STRUCTURES SHALL BE DELIVERED TO THE STATE WITHOUT SILT, DEBRIS OR OTHER SUCH OBSTRUCTIONS AT THE TIME OF FINAL INSPECTION. THE CLEANING OF THESE DRAINAGE STRUCTURES SHALL BE INCLUDED IN THE VARIOUS PAY ITEMS INVOLVED.

WHERE SECTION OR SUB-SECTION MARKERS ARE ENCOUNTERED THE ENGINEER SHALL BE NOTIFIED BEFORE SUCH MONUMENTS ARE REMOVED. THE CONTRACTOR SHALL PROJECT AND CAREFULLY PRESERVE ALL PROPERTY MARKERS AND MONUMENTS UNTIL THE OWNER, AN AUTHORIZED AGENT OR LAND SURVEYOR HAS WITNESSED OR OTHERWISE REFERENCED

- ALL EXISTING CMP CULVERTS IDENTIFIED FOR REMOVAL WITHIN THE REMOVAL PLANS SHALL BE INCLUDED IN THE COST FOR EARTH EXCAVATION AS NOTED.
- ANY REFERENCE OR CALLOUTS IN THESE PLANS TO "BITUMINOUS CONCRETE" SHALL BE INTERPRETED TO MEAN "HOT-MIX ASPHALT" ANY REFERENCE OR CALLOUTS IN THESE PLANS TO "ACCRECATE SHOULDERS, TYPE A" OR "AGGREGATE SHOULDERS, TYPE A 8" SHALL BE INTERPRETED TO MEAN " AGGREGATE SHOULDERS, TYPE B"

COMMITMENTS

- THE CONTRACTOR SHALL BE REQUIRED TO COMPLY WITH THE PROVISIONS OF THE NATIONAL POLLUTANT DISCHARGE ELIMINATION SYSTEM (NPDES) STORM WATER PERMIT AND IMPLEMENT THE EROSION CONTROL PLAN INCLUDED IN THESE PLANS AND SPECIFIED HEREIN.
 AS SPECIFIED IN ARTICLE 107.23, THE ENGINEER MUST GIVE PRIOR APPROVAL BEFORE DISTURBANCE OF ANY AREA CAN BEGIN.
- AN ENVIRONMENTAL SURVEY HAS IDENTIFIED PRAIRIE GRASS WITHIN THE PROJECT LIMITS ON THE WESTERLY SIDE OF IL. RTE. 29 ALONG THE EXISTING RAILROAD BED FROM STA. 1664+35±. STA. 73+07+ IT. AND STA 82+67+ IT TO STA 92+74+ IT PRAIRIE GRASS AREAS WITHIN THE PROPOSED CONSTRUCTION LIMITS
 SHALL HAVE THE SOIL STRIPPED STOCKPILED, AND THEN RESPREAD IN ACCORDANCE WITH THE PLANS AND SPECIFICATIONS. PRAIRIE GRASS AREAS OUTSIDE THE PROPOSED CONSTRUCTION LIMITS SHALL BE PROTECTED WITH TEMPORARY FENCING AND PERMANENT SIGNAGE ALONG THE OUTSIDE BOUNDARY AS SHOWN IN THE PLANS OR AS DIRECTED

JOHN WILKER OF ILLINOIS DEPARTMENT OF NATURAL RESOURCES (IDNR) SHALL BE NOTIFIED (217) 785-5500 TO ATTEND THE PRECONSTRUCTION

- CLIFF FRYE- CHRISTIAN COUNTY ENGINEER, TIMOTHY ZAHRN- SANGAMON COUNTY ENGINEER, SAM BOWSHER- BUCKHART TOWNSHIP ROAD DISTRICT COMMISSIONER, AND JOE TAYLOR COOPER TOWNSHIP ROAD DISTRICT COMMISSIONER SHALL BE NOTIFIED TO ATTEND THE PRECONSTRUCTION
- 4. DURING STAGED CONSTRUCTION OPERATIONS, CLOSURE OF SIDE ROADS SHALL BE LIMITED TO ONE ROAD CLOSURE AT A TIME. SIDE ROAD CLOSURES SHALL NOT BBE ALLOWED BEFORE JUNE 15+ OR AFTER
- VILLAGE OF EDINBURG IDDT WILL CONDUCT PAVEMENT PATCHING, MILLING, CONSTRUCTION OF NEW FOUR-FOOT HMA SHOULDERS, 21/4", HMA RESURFACING AND PAVEMENT STRIPING FROM THE NORTH CONNECTOR AT TR 88 (725E) TO THE SOUTH CONNECTOR AT TR 73 (2050N).

CONTRACT NO. 72829 RTE. SECTION COUNTY TOTAL SHEETS NO. 75 84-12; 11-3 • 729 3 STA. N/A TO STA, N/A FED. ROAD DIST. NO. 5 ILLINOIS FED. AID PROJECT SANGAMON AND CHRISTIAN

LAND ACQUISITION COMMITMENTS

- PARCEL 6041334 (HUNSLEY)
 ENTRANCES WILL BE PROVIDED @ TR 74 NORTH STA 102+70 LT. AND IL RTE 29 STA. 0+10 RT.
- 24' WIDE FIELD ENTRANCES WILL BE PROVIDED AT CH 21 STA. 397+20 RT. AND IL RTE 29 STA. 1478+70 LT.
- PARCEL 6041315 (VINCENT)
 AVOID DAMAGE TO 1 OAK TREE AND 2 MAPLE TREES AS WELL AS TREE ROOTS LOCATED TO THE EAST OF THE PRIVATE DRIVE TR 73 STA. 195+50, 43' LT., STA. 195+96, 43' LT., 196+22, 43' LT.. DITCH GRADING MAY CAUSE ROOT DAMAGE TO THE LARGE ELM TREE WHICH WAS PREVIOUSLY COMPENSATED.
- PARCEL 6041337 (BROCKELSBY)
 CROSS ROAD CULYERT IL ROUTE 29 STATION 1627+00 LOWERED 2.8' FEET
 ALONG WITH UPSTREAM RIGHT DITCH ALONG IL 29. PROPERTY OWNER WILL
 REGRADE OUTLET TO THE MEST PRIOR TO CONSTRUCTION. BACK SLOPES OF DITCHES ALONG TR 63/74 SOUTH STA. 94+75 TO STA. 97+40 AND TR 63/74 NORTH STA. 98+00 TO STA. 94+75 UPON THIS PARCEL FLATTENED TO 5:1 OR AS RIGHT OF WAY LIMITS ALLOW.
- PARCEL 6041331 (REISCH)
 RECONNECT FIELD TILE AND CONSOLIDATE STANDPIPE ALONG TR 88 ADJACENT TO PAVEMENT REMOVAL LOCATED APPROXIMATELY 600' SOUTH OF PROPOSED IL 29 ALICNMENT, IL 29 STA. 1581+64, 479' LT.
- 6. PARCEL 6041332 (DAMBACHER-PUCHETTI) CUT A ROADSIDE DITCH ALONG EAST SIDE OF TR 88 NORTH OF PROPOSED FF TO DRAIN TO THE SOUTH, (STA, 604+00 TO 607+00)
- 7. PARCEL 6041336 (LANHAM) AN ENTRANCE WILL BE PROVIDED ALONG TR 63/74 NORTH STA. 96+22.58 RT.
- 8. PARCEL 6041349 (WEISER)
 AN ENTRANCE WILL BE PROVIDED ALONG TR 321 STA. 94+50 LT.
- 9. PARCEL 6041365 (ANKER-HILL)
 AN ENTRANCE WILL BE PROVIDED ALONG THE NORTH SIDE OF EXISTING TR 299 ACROSS FROM BRECKENRIDGE, IL RTE STA 82+50, 298.7' LT.
- 10. PARCEL 6041312 (OLLER)
 THE PROPERTY OWNER REQUESTED THAT THE DEPARTMENT MOVE THE FIELD ENTRANCE ON TR 73 TO LINE UP WITH HIS BARN, IT WAS AGREED UPON THAT A 24' FIELD ENTRANCE WOULD BE MOVED FROM 196+00 RT. TO STA. 197+15 RT. ON TR 73.
- LOT 7 AND 8 (BRECKENRIDGE)
 LIMIT GRADING TO A/C LIMITS ALONG IL 29 STA. 76+60, LT. TO 78+03, LT. MINIMIZE FRONT YARD DISTURBANCE

ILLINOIS DEPARTMENT OF TRANSPORTATION

GENERAL NOTES, COMMITMENTS LAND ACQUISITION COMMITMENTS

SCALE: N/A DATE: 03/06/2012 CHECKED BY: J.M.M.

-(11)

BAM -11

CONTRACT NO. 72829
OUNTY TOTAL SHEET NO. F.A. SECTION COUNTY
75 84-12; 11-3 COUNTY 729 4

STA. N/A TO STA. N/A FED. ROAD DIST. NO. 5 ILLINOIS FED. AID PROJECT

* SANGAMON AND CHRISTIAN

MIXTURE REQUIREMENTS


WINTOIL REGUI	ILIVILIAIO					4				
MIXTURE NUMBER:	No. 1	No. 2	No. 3	No. 4	No. 5	No. 6	No. 7	No. 8	No. 9	No. 10
MIXTURE USE(S):	HMA SURFACE (IL 29)	HMA TOP LIFT BINDER (IL 29)	HMA LOWER LIFTS BINDER (IL 29)	HMA SURFACE (SIDE ROADS)	HMA TOP LIFT BINDER (SIDE ROADS)	HMA LOWER LIFTS BINDER (SIDE ROADS)	HMA SURFACE (TEMPORARY PAVEMENT)	HMA BINDER (TEMPORARY PAVEMENT)	HMA SHOULDERS TOP LIFT (IL 29)	HMA SHOULDERS LOWER LIFTS (IL 29)
AC/PG:	SBS PG 70-28	SBS PG 70-28	PG 64-22	SBS-PG 64-28	SBS-PG 64-28	PG 64-22	SBS PG 64-22	PG 64-22	PG 64-22	PG 64-22
DESIGN AIR VOIDS:	4.0% @ N70	4.0% @ N70	4.0% @ N70	4.0% @ N50	4.0% @ N50	4.0% @ N50	4.0% @ N70	4.0% @ N70	4.0% @ N50	4.0% @ N50
MIXTURE COMPOSITION: (GRADATION MIXTURE)	M (IL- 9.5 OR IL-12.5)	IL-19.0	IL-19.0	IL-9.5 OR IL-12.5	IL-19.0	IL-19.0	IL-9.5 OR IL-12.5	IL-19.0	IL-9.5 OR IL-12.5	IL-19.0
FRICTION AGGREGATE:		N/A	N/A	MIX "C"	N/A	N/A	(MIX "C")	N/A	MIX "C"	N/A
						_				
MIXTURE NUMBER:	No. 11	No. 12	No. 13	No. 14	No. 15					
MIXTURE USE(S):	HMA SHOULDERS (SIDE ROADS)	PATCHING	SURFACE (IL 29 RESURFACING)	SURFACE (SIDE ROADS)	LEVEL BINDER (EXIST. IL 29)					


IL-9.5

N/A

PG 58-22 PG 64-22 PG 64-22 PG 64-22 PG 64-22 2.0% @ N30 4.0% @ N70 4.0% @ N50 4.0% @ N50 4.0% @ N50 DESIGN AIR VOIDS: MIXTURE COMPOSITION: IL 9.5 OR IL 12.5 IL-9.5 OR IL-12.5 IL 19.0 (GRADATION MIXTURE) MIX "C" MIX "C" N/A N/A FRICTION AGGREGATE:

DESIGN THIS MIXTURE & 4.0% AIR VOIDS.
ADDITIONAL AC SHALL BE ADDED TO REDUCE AIR VOIDS TO 2.5%.

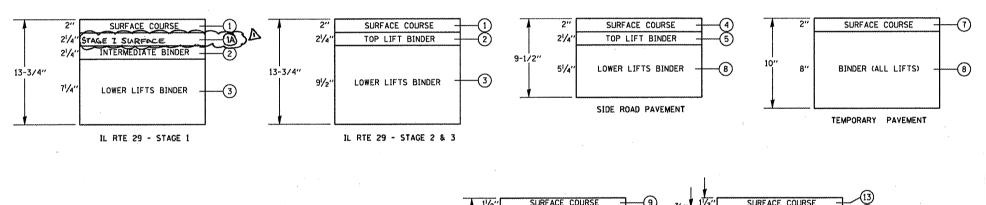

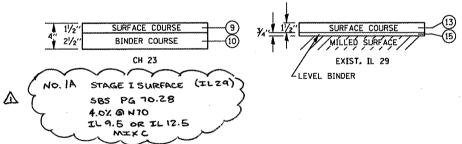

FULL DEPTH BITUMINOUS CONCRETE PAVING LIFT DIAGRAMS

NOTE : MIXTURE IA WILL BE CONSIDERED WITH THE SURFACE COURSE MIXTURE NO. 1 FOR PFP-PWL CALCULATION

HMA SHOULDERS IL RTE 29 (MAINLINE)	HMA SHOULDERS SIDE ROADS (EXIST. IL 29)
DISTRICT S	SIX
EXAMINED // /3	20 / کـــــــــــــــــــــــــــــــــــ
OPERATIONS ENGINEER	
EXAMINED FEB 29	20 12
PROJECT IMPLEMENTATIO	N ENGINEER
EXAMINED MARCH	28 20 12
PROGRAM DEVELOPMENT	ENGINEER

-10

REVISIONAME	DATE
A NH	DATE
· · · · · · · · · · · · · · · · · · ·	

SURFACE COURSE

HMA SHOULDER

ILLINOIS DEPARTMENT OF TRANSPORTATION

PAVEMENT MIXTURE REQUIREMENTS

SCALE: N/A DATE: 03/06/2012

DRAWN BY: R.A.H. CHECKED BY: J.M.M.

PAVEMENT MIXTURE REQUIREMENTS

CONTRACT NO. 72829

F.A.	SECTION	COUNTY	TOTAL	SHEETS	NO.
75	84-12; 11-3	• 729	8		
STA.	TO STA.				
FED. ROAD DIST. NO. 5	ILLINOIS	FED. AID	PROJECT		
• SANGAMON AND CHRISTIAN					

				CHRISTI	IAN COUNTY	SANGAMON COUNTY
				80% FEDERA	L / 20% STATE	80% FEDERAL / 20% STATE
		ROADWAY	STRUCTURES	ROADWAY		
	LOCATION OF WORK	STA, 1415+00.00 TO STA, 1665+04.46	SN011-2514 SN011-2515 SN011-7052 SN011-7053 MINOR CIP STRUCTURES	STA. 0+00.00 TO STA. 130+00.00		
	SUMMARY OF QUANTITIES				CONSTRUCTION TYPE COD	E
CODE NO.	ITEM DESCRIPTION	UNIT	TOTAL QUANTITY	0001	0008	0001
40600200	BITUMINOUS MATERIALS (PRIME COAT)	TON	514.7	288.5		226. 2
40600300	AGGREGATE (PRIME COAT)	TON	65.8	65.8		
40600625	LEVELING BINDER (MACHING METHOD), N50	TON	1, 126. 3	1, 126. 3		
40600895	CONSTRUCTING TEST STRIP	EACH	6	3		3
40600990	TEMPORARY RAMP	SQ YD	436	258		178
40603080	HOT-MIX ASPHALT BINDER COURSE, IL-19.0, N50	TON	969. 7	969. 7		
40603310	HOT-MIX ASPHALT SURFACE COURSE, MIX "C", N50	TON	2, 834, 3	2, 834, 3		·
40701871	HOT-MIX ASPHALT PAVEMENT (FULL-DEPTH), 9 1/2"	SQ YD	35, 072	30, 240		4, 832
40701881	HOT-MIX ASPHALT PAVEMENT (FULL-DEPTH). 10"	SQ YD	7, 922	1,011		6, 911
40701956	HOT-MIX ASPHALT PAVEMENT (FULL-DEPTH), 13 3/4"	SQ YD	215, 383	148, 214		67, 169
44000100	PAVEMENT REMOVAL	SQ YD	85, 715	44. 904		40.811
44000157	HOT-MIX ASPHALT SURFACE REMOVAL, 2"	SQ YD	1,859	507		1, 352
44004250	PAVED SHOULDER REMOVAL	SQ YD	6, 897	2, 164		4, 733
~~~		50 YD	1,500	1,500		
44200970	CLASS B PATCHES, TYPE II, 10 INCH	30 10	1, 300	.,500		

REVISIONAME	DATE	ILLINOIS DEPARTMENT O	F TRANSPORTATION
Δ νH	जीविट		
		SUMMARY OF	QUANTITIES
······································		SCALE: N/A	DRAWN BY: B.J.D.
		DATE: 03/06/2012	CHECKED BY: J.M.M.

CONTRACT NO. 72829

F.A.	SECTION	COUNTY	TOTAL	SHEET	NO.
75	84-12; 11-3	•	729	9	
STA.	TO STA.				
FED. ROAD DIST. NO. 5	ILLINOIS	FED. AID	PROJECT		
• SANGAMON AND CHRISTIAN					

			·····			
				CHRISTIA	AN COUNTY	SANGAMON COUNTY
				80% FEDERAL	/ 20% STATE	80% FEDERAL / 20% STATE
				ROADWAY	STRUCTURES	ROADWAY
	LOCATION OF WORK		STA. 1415+00.00 TO STA. 1665+04.46	SN011-2514 SN011-2515 SN011-7052 SN011-7053 MINOR CIP STRUCTURES	STA. 0+00.00 TO STA. 130+00.00	
	SUMMARY OF QUANTITIES				CONSTRUCTION TYPE COL	DE
			TOTAL			2001
CODE NO.	ITEM DESCRIPTION	UNIT	QUANTITY	0001	0008	0001
44201765	CLASS D PATCHES, TYPE II, 10 INCH	SQ YD	1,572	1,538		34
44201769	CLASS D PATCHES, TYPE III. 10 INCH	SQ YD	82	82		
44201771	CLASS D PATCHES, TYPE IV, 10 INCH	SQ YD	100	100		
		~	\\\\\\\\\\\\\\\\\\\\\\\\\\\\\\\\\\\\\\		~~~~~	
48100100	AGGREGATE-SHOULDERS, TYPE-A	TON	19,044.6	12,954.6		6,090,0
48101200	AGGREGATE SHOULDERS, TYPE B	TON	27,139.8	18,461.2		8,678.6
48100700	ACCRECATE SHOULDERS, TYPE A 8"	SO-YD	19, 265	12,930		6,-335
48203005	HOT-MIX ASPHALT SHOULDERS, 2"	SO YD	1, 904	507		1, 397
48203029	HOT-MIX ASPHALT SHOULDERS, 8"	SO YD	115, 163	79,888		35. 275
40203023	TOT WIN ASTRACT SHOOLDERAY C					
50100100	REMOVAL OF EXISTING STRUCTURES	EACH	15	10		5
50800105	REINFORCEMENT BARS	POUND	132, 780		132, 780	
30800103	NEIN ONCEMENT BANG					
50800205	REINFORCEMENT BARS, EPOXY COATED	POUND	230		230	
5 400 7000	CONCRETE BOX CULVERTS	CU YD	640		640	
54003000	CONCRETE BOX COLVERTS					
54010402	PRECAST CONCRETE BOX CULVERTS 4' X 2'	FOOT	168		168	
54010503	PRECAST CONCRETE BOX CULVERTS 5' X 3'	FOOT	450		450	
54011005	PRECAST CONCRETE BOX CULVERTS 10' X 5'	FOOT	336		336	
1		1			1	


REVISIONS NAME DATE	ILLINOIS DEPARTMENT O	F TRANSPORTATION
ZNH 6-1-12		
	SUMMARY OF	QUANTITIES
		DRAWN BY: B.J.D.
	SCALE: N/A DATE: 03/06/2012	CHECKED BY: J.M.M.


CONTRACT NO. 72829

| F.A. | SECTION | COUNTY | TOTAL | SHEET | NO. 75 | 84-12; 11-3 | • 729 | 21 |
| STA. | TO STA. | FED. ROAD DIST. NO. 5 | ILLINOIS | FED. AID | PROJECT |
| • SANGAMON AND CHRISTIAN

				CHRISTIA	N COUNTY	SANGAMON COUNTY
				80% FEDERAL	/ 20% STATE	80% FEDERAL / 20% STATE
		ROADWAY	STRUCTURES	ROADWAY		
	LOCATION OF WORK	STA. 1415+00.00 TO STA. 1665+04.46	STA. 0+00.00 TO STA. 130+00.00			
	SUMMARY OF QUANTITIES				MINOR CIP STRUCTURES  CONSTRUCTION TYPE CO	DE
CODE NO.	ITEM DESCRIPTION	UNIT	TOTAL QUANTITY	0001	0008	0001
Z0026305	FURNISHING AND MAINTAINING AUTOMOTIVE VEHICLES	CAL MO	60	30		30
Z0030260	IMPACT ATTENUATORS, TEMPORARY (FULLY REDIRECTIVE, NARROW), TEST LEVEL 3	EACH	2	2		
Z0034105	MATERIAL TRANSFER DEVICE	TON	46,072.0	31, 163. 0		14, 909. 0
Z0041500	PLUG EXISTING CULVERTS	EACH	1			1
Z0049901	REMOVAL AND DISPOSAL OF NON - FRIABLE ASBESTOS, BUILDING NO. 1	L SUM	1			1
<b>~</b>	\\\\\\\\\\\\\\\\\\\\\\\\\\\\\\\\\\\\\\				~~~ <u>~</u>	
Z0054515	ROCK-FILL EMBANKMENT	TON	5, 150, 0	2,575.0	A .	2,575.0
Z0054517	ROCK FILL - FOUNDATION	TON	4,875.0	1,015.0	3, 860. 0	
Z0073002	TEMPORARY SOIL RETENTION SYSTEM	SO FT	364		364	
20054530	ROCK FILL - SUBGRADE	TON	5,150	2,575		2,575
					:	
		<u> </u>				
		1	-	1		1

REVISIONAME	NS DATE	ILLINOIS DEPARTMENT OF TRANSPORTATION						
V hr	6-1-12							
			CHMMADY	OE.	QUANTITIES			
			SUMMANI	ŲP	COANTITIES			
					DOLUM DV.	0.15		
		SCALE	N/A		DRAWN BY:	B.J.D.		
		DATE	03/06/2012		CHECKED BY:	J.M.M.		

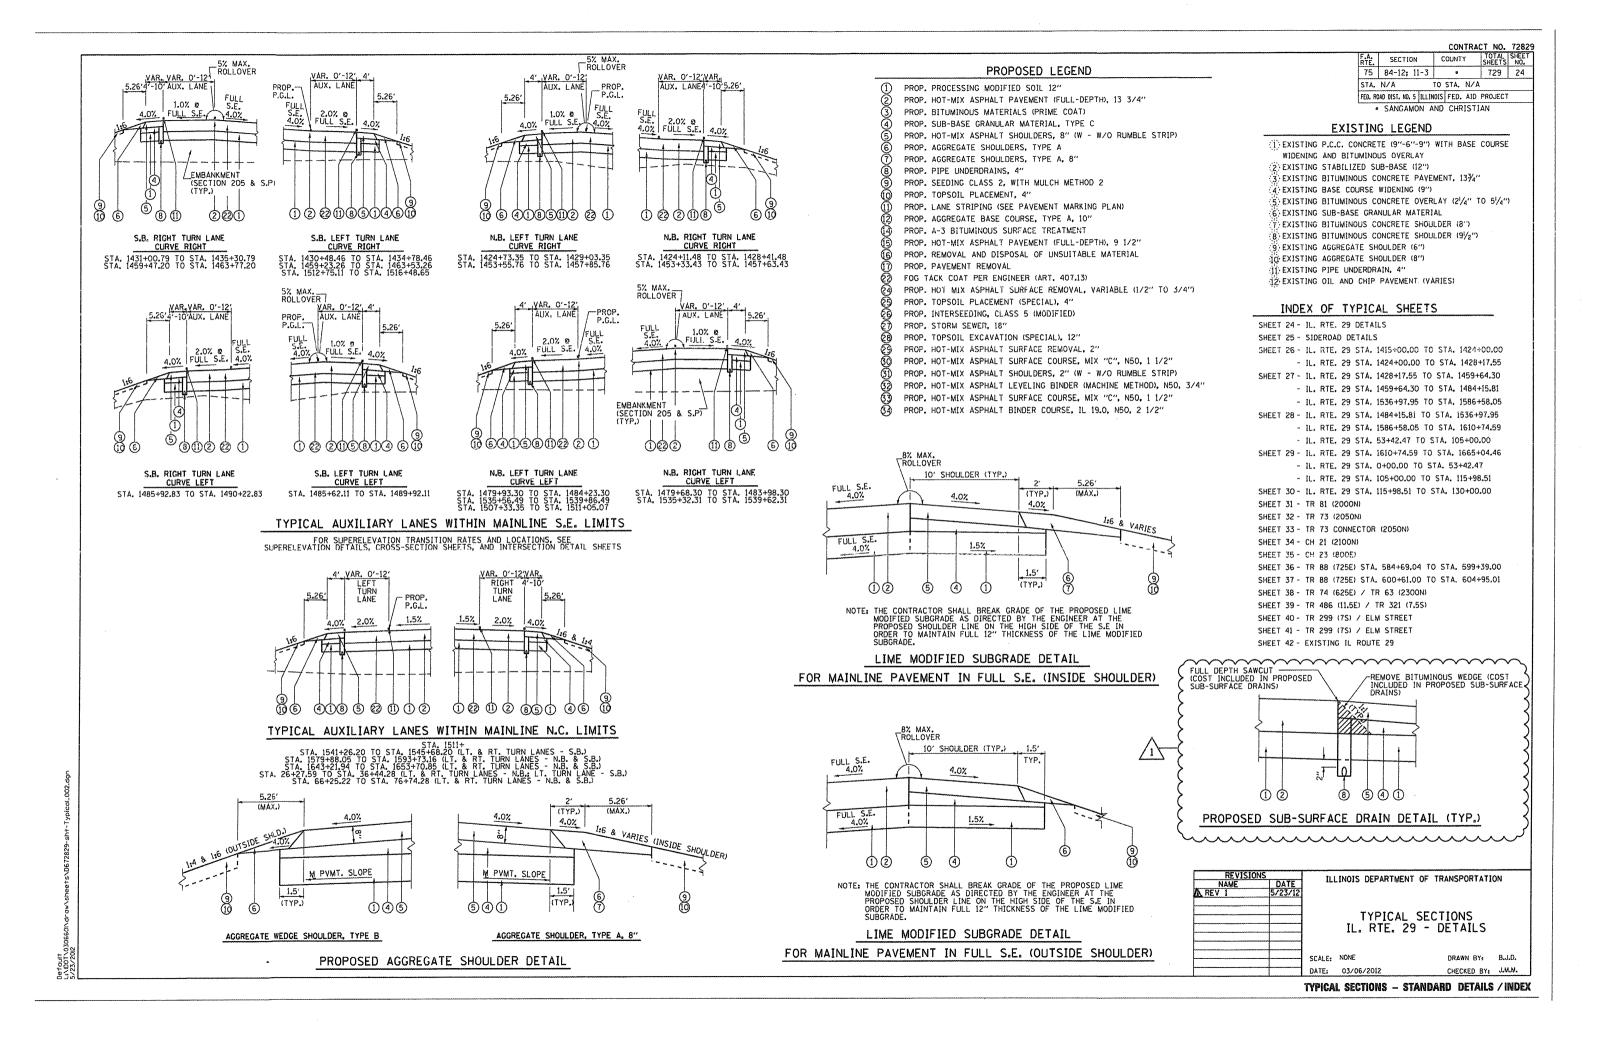

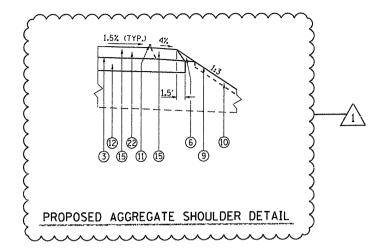

	PROPOSED LEGEND
1	PROP. PROCESSING MODIFIED SOIL 12"
<u> </u>	PROP. HOT-MIX ASPHALT PAYEMENT (FULL-DEPTH), 13 3/4"
(3)	PROP. BITUMINOUS MATERIALS (PRIME COAT)
٩	PROP. SUB-BASE GRANULAR MATERIAL, TYPE C
(5)	PROP. HOT-MIX ASPHALT SHOULDERS, 8" (W - W/O RUMBLE STRIP)
6	PROP. AGGREGATE SHOULDERS, TYPE A
$\bigcirc$	PROP. AGGREGATE SHOULDERS, TYPE A, 8"
(8)	PROP. PIPE UNDERDRAINS, 4"
(9)	PROP. SEEDING CLASS 2, WITH MULCH METHOD 2
மு	PROP. TOPSOIL PLACEMENT, 4"
<u>m</u>	PROP. LANE STRIPING (SEE PAVEMENT MARKING PLAN)
(12)	PROP. AGGREGATE BASE COURSE, TYPE A, 10"
(3)	NOT USED PROP. A-3 BITUMINOUS SURFACE TREATMENT
(14)	PROP. HOT-MIX ASPHALT PAYEMENT (FULL-DEPTH), 9 1/2"
9	PROP. REMOVAL AND DISPOSAL OF UNSUITABLE MATERIAL
(3)	PROP. PAVEMENT REMOVAL
	NOT USED
<u>~</u>	NOT USED
ă	NOT USED
മ്	NOT USED
éà	FOG TACK COAT PER ENGINEER (ART. 407.13)
<b>23</b>	NOT USED
<b>É</b>	PROP. HOT MIX ASPHALT SURFACE REMOVAL, VARIABLE (1/2" TO 3/4")
<b>Ē</b>	PROP. TOPSOIL PLACEMENT (SPECIAL), 4"
<b>®</b>	PROP. INTERSEEDING, CLASS 5 (MODIFIED)
Ø	PROP. STORM SEWER, 18"
<b>®</b>	PROP. TOPSOIL EXCAVATION (SPECIAL), 12"
<b>(9</b> )	PROP. HOT-MIX ASPHALT SURFACE REMOVAL, 2"
(2) (1) (1) (1) (1) (1) (1) (1) (1) (1) (1	PROP. HOT-MIX ASPHALT SURFACE COURSE, MIX "C", N50, 1 1/2"
(31)	PROP. HOT-MIX ASPHALT SHOULDERS, 2" (W - W/O RUMBLE STRIP)
<u>@</u>	PROP. HOT-MIX ASPHALT LEVELING BINDER (MACHINE METHOD), N50, 3/4"
<u> </u>	PROP. HOT-MIX ASPHALT SURFACE COURSE, MIX "C", N50, 1 1/2"
(34)	PROP. HOT-MIX ASPHALT BINDER COURSE, IL 19.0, N50, 2 1/2"

					CON	TRA	CT NO.	
_	F.A. RTE.	SECTION		С	COUNTY		TOTAL SHEETS	SHEET NO.
	75	84-12; 11-3		•		729	25	
	STA. N/A				STA.	N/A		
	FED. ROAD DIST. NO. 5 ILLINOIS FED. AID PROJECT							
		SANGAMO	N A	ND	CHR	ISTI	AN	

## EXISTING LEGEND

: EXISTING	P.C.C. CONCRETE (9"-6"-9") WITH BASE COURSE
WIDENING	AND BITUMINOUS OVERLAY
(2) EXISTING	STABILIZED SUB-BASE (12")
(3) EXISTING	BITUMINOUS CONCRETE PAVEMENT, 133/4"
(4) EXISTING	BASE COURSE WIDENING (9")
5 EXISTING	BITUMINOUS CONCRETE OVERLAY (21/4" TO 51/4")
6 FXISTING	SHB-BASE GRANHLAR MATERIAL
7 EXISTING	BITUMINOUS CONCRETE SHOULDER (8")
R EXISTING	BITUMINOUS CONCRETE SHOULDER (91/2")
1177	AGGREGATE SHOULDER (6")
EXISTING	AGGREGATE SHOULDER (8")
14,57	PIPE UNDERDRAIN, 4"
	OIL AND CHIP PAVEMENT (VARIES)
44. 2	

REVISIONS
NAME
DATE
AREV 1

5/23/12

TYPICAL SECTIONS
SIDEROADS - DETAILS

SCALE: NONE
DATE: 03/06/2012

CHECKED BY: J.M.M.

TYPICAL SECTIONS - STANDARD DETAILS

L:\IDOT\030660I\draw\sheets\D672829-sht-Typical_0 6.73.73013

	STAT	ION / L	OCATION		SUBBASE GRANULAR MATERIAL, TYPE C	SUBBASE GRANULAR MATERIAL, TYPE B, 4"	AGGREGATE BASE COURSE, TYPE A 12"	AGGREGATE BASE COURSE. TYPE A 10'	AGGREGATE SHOULDERS, TYPE B	
71 1	RTE 29				(TON)	(SQ YD)	(SO YD)	(SO YD)	(TON)	
STA	1403+00.00	TO	1418+00.00	LT	128.4	T	T	· · · · · · · · · · · · · · · · · · ·	168.3	
STA	1403+00.00	TO	1418+00.00	RT	120.7		<del> </del>	<del></del>	170.6	
STA	1418 :00.00	TO	1433+00.00	LT	579.8		<del> </del>	<del></del>	443.7	
STA	1418+00.00	TO	1433+00,00	RT	297.7		<del> </del>	<del> </del>	248,6	
STA	1433+00.00	TO	1448+00.00	L.T	628.3	<del> </del>	<del> </del>		496.6	
STA	1433+00.00	TO	1448+00.00	RT	654.2	<b> </b>	<b>†</b>	(	505.0	
STA	1448+00.00	TO	1463+00.00	LT	563.5			<u> </u>	438.8	
STA	1448+00.00	TO	1463+00.00	RT	562.9			(	432.4	
STA	1463+00.00	TO	1478+00.00	LT	640.5			<u>}</u>	505.1	
STA	1463+00.00	TO	1478+00.00	RT	642.0			7	501.3	
STA	1478+00.00	TO	1493+00.00	L,T	557.7				426.8	
STÀ	1479+00.00	TO	1493+00.00	RT	559.3			<u> </u>	434.4	
STA	1493+00.00	TO	1508+00.00	LT	654.2			( )	500.7	
STA	1493+00.00	TO	1508+00,00	RT	647.3			7	507-1	
STA	1508+00.00	TO	1523+00.00	L.T	646.3			7	446.9	
STA	1508+00.00	TO	1523+00.00	RT	638.6				457.1	
STA	1523+00.00	TO	1538+00.00	LT	637.2	ndiki nimih min di minyi di manjapipa manyapipa mya himnin		7	505.2	
STA	1523+00.00	TO	1538+00.00	RT	624.2				492.2	
STA	1538+00.00	TO	1553+00.00	LT	562.3			7	435.5	
STA	1538+00.00	TO	1553+00.00	RT	581.2			7	456.1	
STA	1553+00.00	ТО	1568+00.00	LT	642.0			(	506.5	
STA	1553+00.00	TO	1568+00.00	RT	642.0			7	508.2	
STA	1568+00.00	TO	1583+00.00	LT	642.0				506.5	
5TA	1568+00.00	TO	1583+00.00	RT	630.0			7	476.7	
STA	1583+00.00	TO	1598+00.00	LT	529.6			>	918.7	
STA	1583+00.00	TO	1598+00.00	RT	565.7			( )	442.4	
STA	1598+00.00	TO	1613+00.00	LT	648.8			>	508.2	
STA	1598+00.00	TO	1613+00.00	RT	642.0				508.2	
STA	1613+00.00	TO	1628+00.00	LT	656.9			7	508.4	
STA	1613+00.00	TO	1628+00.00	RT	641.8			>	508.1	
STA	1628+00.00	TO	1643+00,00	LT	659.2			(1	509.1	
STA	1628+00.00	TO	1643+00.00	RT	640.6			7	507.4	
STA	1643+00.00	TO	1658+00.00	LT	565.2				436.1	
STA	1643+00.00	TO	1658+00.00	RT	563.1			(	436.9	
ATA	1658+00.00	TO	1665+04.46	LT	301.5				238.7	
STA	1658+00.00	TO	1665+04.46	RT	301.5			(	238.2	
TA	0+00.00	TO	8+00.00	LT	342.4			<u> </u>	271.1	
STA	0+00.00	TO	8+00.00	RT	342.4				268.1	
TA	8+00,00	TO	23+00,00	LT	428.7			71	508.2	
TA	8+00.00	TO	23+00.00	RT	642.0			$\overline{\Sigma}$	508.2	
TA	23+00.00	TO	38+00.00	LT	635.7		I		448.4	
TA	23+00.00	ТО	38+00.00	RT	561.4				436.8	
TA	38+00.00	70	53+00.00	LT	641.1				507.7	
TÀ	38+00.00	TO	53+00.00	RT	642.9			(	508.8	
TA	53+00,00	TO	68+00.00	LT	642.3			\	508.4	
TA	53+00.00	то	68+00.00	RT	637.4				496.4	
TA	68+00.00	TO	83+00.00	LT	562.8				436.8	
TA	68+00.00	TO	83+00.00	RT	571.4				446.9	
TÀ	83+00.00	<u> 70</u>	98+00.00	LT	641.9			(	508.2	
TA	83+00.00	TO	98+00.00	RT	642.0				508.2	
TA	98+00.00	TO	113+00.00	LT	299.6				316.1	
TA	98+00.00	TO	113+00.00	RT	642.0				503.3	
TA	113+00.00	TO	128+00.00	LT					37.8	
TA	113+00.00	TO	128+00.00	RT	637.8			(	505.6	
TA	128+00.00	70	143+00,00	LT				<u>}</u> ↓	140.6	
TA	128+00.00	TO	143+00.00	RT	84.9			(	132.0	
íΛ	143+00.00	TO	158+00.00	LT	I			71	35.3	

AGGREGATE SCHEDULE

STATION / LOCATION	SUBBASE GRANULAR MATERIAL, TYPE C	SUBBASE GRANULAR MATERIAL, TYPE B, 4"	AGGREGATE BASE COURSE, TYPE A 12"	AGGREGATE BASE COURSE. TYPE A 10'	AGGREGATE SHOULDERS. TYPE B
TD 01	(TON)	(SQ YD)	(SQ YD)	(SO YD) (	(TON)
TR 81 STA 91+67,21 TO 99+36,87	<del></del>		· · · · · · · · · · · · · · · · · · ·	2005	T 510
STA 100+63,18 TO 104+04,87				2,885 (	51.8 87.0
TR 73		L	L	1,463	1 81.0
STA 180+00.00 TO 199+38.99	T	<u> </u>	J	6,385	169.9
STA 200+61.02 TO 203+88.47				1,386	83,6
TR 73 CONNECTOR		L	L	(	00.0
STA 294+76.65 TO 299+87.58				2,112	26.6
CH 21					1
STA 396+75.50 TO 399+39.00				1,285	66.8
STA 400+61.57 TO 404+50.00				1,719	97.8
CH 23					
STA 479+36.32 TO 499+39.00				7,699 >	633.6
STA 500+61.00 TO 508+52.37				3,143	224.1
BOX CULVERT CROSSING AT MASONIC DR.				144	0.0
TR 88					
STA 584+74.00 TO 599+39.00					184.4
STA 600+61.00 TO 604+95.01					133.1
TR 74/63 CONNECTOR STA 696+93.00 TO 699+39.00	<del></del>			1600	92.1
STA 700+61.00 TO 703+08.59				1,690	88.9
TR 74/63 N	_1			1,670	56.9
STA 95+47.13 TO 105+40.83	T			3,209	40,2
TR74/63 S				3,203	70,2
STA 95+29.07 TO 108+44.94				4,288	41.1
TR 486 CONNECTOR				·····	L
STA 800+61.00 TO 801+80.50	T			1,140	25.1
TR 321/486				<u> </u>	
STA 93+56.31 TO 106+05.38				4,128	33.1
TR 299				7	
STA 890+39.89 TO 899+39.00				3,716	40.9
STA 900+61.00 TO 907+67.03				7,268	88.7
ENTRÂNCE @ STA. 112+40.49				496	
MOT STAGE 1 (Subject to Change)				<u>\</u> ,	
TR 299 INTERSECTION			254	(_)	
MOT STAGE 2 (Subject to Change)	- <del></del>			<u>&gt;</u> ,	
TR 81 INTERSECTION			253		
TR 73 INTERSECTION			616	81 >	
CH 21 INTERSECTION			616		
CH 23 INTERSECTION TR 88 INTERSECTION	<del> </del>		616	(-	
TR 74/63 INTERSECTION	<del> </del>		616 254	<del>}</del>	•••••
TR 321/486 INTERSECTION	+		253		
TR 299 INTERSECTION	+		254	<del>(</del>	
MOT STAGE 3 (Subject to Change)	-li			<del></del>	
TR 81 INTERSECTION	T		427		
TR 74/63 INTERSECTION	†		383		
TR 321/486 INTERSECTION	† <del>-</del>		323	<del></del>	
FOR USE WITH TEMPORARY PAVEMENT		L		(-1	
IL. RTE. 29 (MOT STAGE 1)				$\longrightarrow$	
STA. 1406+23.99 TO 1413+25.53	T	1,149	T	<del>(</del> 1	30,3
STA. 56+16.50 TO 66+42.85		2,742		(1	336.0
STA. 136+50.00 TO 144+00.00	T	3,051		<del></del>	
STA 152+23.24 TO 154+19.78		1,539		1,016	125.8
	·*			<del></del>	
TOTALS	29,676.7	8,481	4,865	56,922	27,139.8

ATE ILLINOIS DEPARTM	MENT OF TRANSPORTATION
***************************************	OF QUANTITIES
	AGGREGATE
SCALE: N/A	DRAWN BY: K.E.U.
DATE: 03/06/2012	CHECKED BY: J.M.M.

## PERMANENT SIGNING SCHEDULE

STATION / LOCATION  NUMBER (MUTCD)  PANEL   PANEL   PANEL   TYPE   TYPE   SIGN   SUPP   STEEL SIGN   TYPE   STEEL SIGN   TYPE   SIGN   SUPP   ORT   SUPPORT   TYPE   SIGN   SUPPORT   SUPP			FACING	SIGN	SIZE	SIGN	SIGN	MESSAGE	NUMBER	WOODEN	POST I	ENGTH
S99422   RT   EAST   R6-IL   36" X 12"   3.0   ONE WAY   1   26.0	STATION / LOC	CATION	1 401110	NUMBER		PANEL TYPE	PANEL	,,,,,,,,,,,,,,,,,,,,,,,,,,,,,,,,,,,,,,,	OF	SIGN	STEEL SIGN	METAL POST TYPE A
G994/22   RTT   WEST   R6-IR   36" X 12"   3.0   ONE MAY   1   26.0						rso	ısa		(EACH)	(FOOT)	(FOOT)	(FOOT)
Sep-12	699+22	RT	EAST	R6-1L	36" X 12"	3.0		ONE WAY				
G99+22   RT   WEST   R1-1   36" X 36"   3.0.   DIVIDED HIGHWAY CROSSING	699+22	RT	WEST	R6-1R	36" X 12"	3.0		ONE WAY	1 ,		36.0	
TOOL-78	699+22	RT	WEST	R1-1	36" X 36"	9.0		STOP	] '		20.0	
TOO+76		RT	WEST	R6-3	24" X 18"	3.0		DIVIDED HIGHWAY CROSSING	1			
T00+78			**** *******		36" X 12"	3.0		ONE WAY		i		
T00+78						4		ONE WAY	1.		25.0	
T00+76								STOP	1 1		26.0	
TR32  1486   CSANCAMON COUNTY    Section   S									1	l i		
94+23				1		1						
99+65				W3-1	36" X 36"	9.0		STOP AHEAD	1		19.8	
99-955 RT SE W4-4AP 36" X 18" 4.5 TRAFFIC FROM LET DOES NOT 1 100-90 RT SW W1-7 48" X 24" 8.0 TWO DIRECTION LET DOES NOT 1 100-90 LT NW R1-1 36" X 36" 9.0 STOP 1 100-90 LT NW W4-4AP 56" X 18" 4.5 TRAFFIC FROM RIGHT DOES NOT 1 20.3 100-90 LT NW W4-4AP 56" X 18" 4.5 TRAFFIC FROM RIGHT DOES NOT 1 20.3 100-90 LT NORTH W5-1 36" X 36" 9.0 STOP ANEAD 1 19.8 109-90 LT NORTH W5-1 56" X 18" 4.5 TRAFFIC FROM RIGHT DOES NOT 1 20.3 17832L/486 CONNECTOR ISRAMON COUNTY) 1800-76 LT SW R6-1L 36" X 36" 9.0 CURVE 1 19.8 1800-778 LT NE R6-1R 36" X 12" 3.0 ONE WAY 1 800-78 LT NE R6-13 36" X 36" 9.0 STOP 1 800-78 LT NE R6-13 36" X 36" 9.0 STOP 1 800-78 LT NE R6-3 24" X 18" 3.0 DIVIDED HIGHWAY CROSSING 1 18.3 1891-50 RT WEST W1-2L 36" X 36" 9.0 STOP 1 18.3 1891-50 RT WEST W1-2L 36" X 36" 9.0 STOP 1 19.8 1893-50 RT WEST W1-2L 36" X 36" 9.0 STOP ANEAD 1 19.8 1893-50 RT WEST W3-1 36" X 36" 9.0 STOP ANEAD 1 19.8 1893-921 RT NE R6-11 36" X 36" 9.0 STOP ANEAD 1 19.8 1893-921 RT SW R6-11 36" X 36" 9.0 STOP ANEAD 1 19.8 1893-921 RT SW R6-13 36" X 12" 3.0 ONE WAY 1 1899-121 RT SW R6-13 36" X 12" 3.0 ONE WAY 1 1899-121 RT SW R6-13 36" X 12" 3.0 ONE WAY 1 1990-0480 LT NE R6-18 36" X 12" 3.0 ONE WAY 1 1900-480 LT NE R6-18 36" X 12" 3.0 ONE WAY 1 1900-480 LT NE R6-18 36" X 12" 3.0 ONE WAY 1 1900-480 LT NE R6-18 36" X 12" 3.0 ONE WAY 1 1900-480 LT NE R6-18 36" X 12" 3.0 ONE WAY 1 1900-480 LT NE R6-18 36" X 12" 3.0 ONE WAY 1 1900-480 LT NE R6-18 36" X 12" 3.0 ONE WAY 1 1900-480 LT NE R6-18 36" X 12" 3.0 ONE WAY 1 1900-480 LT NE R6-18 36" X 12" 3.0 ONE WAY 1 1900-480 LT NE R6-18 36" X 12" 3.0 ONE WAY 1 1900-480 LT NE R6-18 36" X 12" 3.0 ONE WAY 1 1900-480 LT NE R6-18 36" X 12" 3.0 ONE WAY 1 1900-480 LT NE R6-18 36" X 12" 3.0 ONE WAY 1 1900-480 LT NE R6-18 36" X 12" 3.0 ONE WAY 1 1900-480 LT NE R6-18 36" X 12" 3.0 ONE WAY 1 1900-480 LT NE R6-18 36" X 12" 3.0 ONE WAY 1 1900-480 LT NE R6-18 36" X 12" 3.0 ONE WAY 1 1900-480 LT NE R6-18 36" X 12" 3.0 ONE WAY 1 1900-480 LT NE R6-18 36" X 12" 3.0 ONE WAY 1 1900-480 LT NE R6-18 X 18" X 18" X 18" X 18" X 18"									7	i		
100+00									1 1		20.3	
100+90									2		29.7	
100+90						-			1			***************************************
105-90									1 1		20.3	
109-50									1		19-8	
TR321/486 CONNECTOR ISANGAMON COUNTY)  800+78									<u> </u>	<del>  </del>		
BOO+78					36 × 30	1 3.0		CONTE	<u> </u>	l		L
BOO+78					36" V 12"	30		ONE WAY	T	ΙΙ		
BOO+78									1			
ROU-FB									1		26.0	
TR 299 (SANGAMON COUNTY)  890+68									1			
Second			NŁ	K6-3	24" X 18"	3.0		DIVIDED HIGHWAT CROSSING	L	L		L
891+50   RT   WEST   WI-2L   36" x 36"   9.0   CURVE   1   19.8					764 4 764			CTOD	T 1	TT	10 7	
893+50   RT   WEST   W3-1   36" X 36"   9.0   STOP AHEAD   1   19.8						I			ļ	<del>  </del>		
S99+21   RT   NE   R6-1L   36" X 12"   3.0   ONE WAY   1   26.0												
Sep   21									1		19.0	
System   S						<del> </del>			-			
System   S									1		26.0	
900+80 LT SW R6-IL 36" X 12" 3.0 ONE WAY 900+80 LT NE R6-IR 36" X 12" 3.0 ONE WAY 900+80 LT NE R6-IR 36" X 36" 9.0 STOP 900+80 LT NE R6-3 24" X 18" 3.0 DIVIDED HIGHWAY CROSSING 906+50 LT EAST W3-1 36" X 36" 9.0 STOP AHEAD 1 19.8 911+50 LT EAST W1-2L 36" X 36" 9.0 CURVE 1 19.8  TR 299 NORTH FRONTAGE RD. (SANGAMON COUNTY) 100+50 RT SE W14-2 36" X 36" 9.0 STOP 1 18.3 100+50 RT SE W14-2 36" X 36" 9.0 NO OUTLET 1 19.8  EXISTING TR 299 (SANGAMON COUNTY)  WEST R11-I100 36" X 36" 9.0 TURN 1 19.8  WEST W1-IR 36" X 36" 9.0 TURN 1 19.8  EXISTING TR 299 (SANGAMON COUNTY)  WEST E.O.R. RED 18" X 18" 2.3 END OF ROAD  2ND STREET (SANGAMON COUNTY)  SOUTH W14-1 36" X 36" 9.0 DEAD END 1 19.8  SOUTH R11-I100 36" X 36" 9.0 DEAD END 1 19.8  SOUTH R11-I100 36" X 36" 9.0 DEAD END 1 19.8  SOUTH R11-I100 36" X 36" 9.0 DEAD END 2 30.7						I			4			
900+80 LT NE R6-IR 36" X 12" 3.0 ONE WAY  900+80 LT NE R1-1 36" X 36" 9.0 STOP  900+80 LT NE R6-3 24" X 18" 3.0 DIVIDED HIGHWAY CROSSING  900+80 LT NE R6-3 24" X 18" 3.0 DIVIDED HIGHWAY CROSSING  906+50 LT EAST W3-1 36" X 36" 9.0 CURVE 1 19.8  911+50 LT EAST W1-2L 36" X 36" 9.0 CURVE 1 19.8  TR 299 NORTH FRONTAGE RD. (SANGAMON COUNTY)  100+50 LT NW R1-1 36" X 36" 9.0 STOP 1 18.3  100+50 RT SE W14-2 36" X 36" 9.0 NO OUTLET 1 19.8  EXISTING TR 299 (SANGAMON COUNTY)  WEST W1-1R 36" X 36" 9.0 TURN 1 19.8  EXISTING TR 299 (SANGAMON COUNTY)  WEST R11-1100 36" X 36" 9.0 TURN 1 19.8  WEST R11-1100 36" X 36" 9.0 TURN 1 19.8  WEST R11-1100 36" X 36" 9.0 TURN 1 19.8  WEST E.O.R. RED 18" X 18" 2.3 END OF ROAD  2ND STREET (SANGAMON COUNTY)  SOUTH W14-1 36" X 36" 9.0 DEAD END 1 19.8  SOUTH R11-1100 36" X 30" 7.5 ROAD ENDS 2 30.7  SOUTH R11-1100 36" X 30" 7.5 ROAD ENDS 2 30.7	899+21	RT	SW	R6-3		<del></del>						
300+80	900+80					-			4			
900+80 LT NE RI-1 36" X 36" 9.0 STOP 9.0 STOP HIGHWAY CROSSING 906+50 LT EAST W3-1 36" X 36" 9.0 CURVE 1 19.8 19.8 19.1 19.8 19.1 19.8 19.1 19.8 19.1 19.8 19.1 19.8 19.1 19.8 19.1 19.8 19.1 19.8 19.1 19.8 19.1 19.8 19.1 19.8 19.1 19.8 19.1 19.8 19.1 19.8 19.1 19.8 19.1 19.8 19.1 19.8 19.1 19.8 19.1 19.8 19.1 19.1	900+80	LT	NE	R6-1R					1		26.0	
906+50 LT EAST W3-1 36" X 36" 9.0 STOP AHEAD 1 19.8  911+50 LT EAST W1-2L 36" X 36" 9.0 CURVE 1 19.8  TR 299 NORTH FRONTAGE RD. (SANGAMON COUNTY)  100+50 LT NW R1-1 36" X 36" 9.0 STOP 1 19.3  100+50 RT SE W14-2 36" X 36" 9.0 NO OUTLET 1 19.8  EXISTING TR 299 (SANGAMON COUNTY)  WEST W1-1100 36" X 36" 9.0 TURN 1 19.8  WEST R11-1100 36" X 36" 9.0 TURN 1 19.8  WEST R11-1100 36" X 30" 7.5 ROAD ENDS 30.7  WEST E.O.R. RED 18" X 18" 2.3 END OF ROAD 2 30.7  2ND STREET (SANGAMON COUNTY)  SOUTH W14-1 36" X 36" 9.0 DEAD END 1 19.8  SOUTH R11-1100 36" X 30" 7.5 ROAD ENDS 2 30.7	900+80	LT	NE	R1-1					1 .			
SOUTH   SOUT	900+80	LT	NE	R6-3								
TR 299 NORTH FRONTAGE RD. (SANGAMON COUNTY)  100+50	906+50	LT	EAST	W3-1	36" X 36"							
100+50	911+50	LT	EAST	W1~2L	36" X 36"	9.0		CURYE	1 1	<u> </u>	19.8	
100+50	TR 299 NORTH FRO	ONTAGE RD.	(SANGAMON	COUNTY)					***************************************		***************************************	
100+50   RT   SE   W14-2   36" X 36"   9.0   NO OUTLET   1   19.8					36" X 36"	9.0			1			
EXISTING TR 299 (SANGAMON COUNTY)		RT	SE	W14-2	36" X 36"	9.0		NO OUTLET	1		19.8	
WEST   W1-1R   36" X 36"   9.0   TURN   1   19.8	EXISTING TR 299	(SANGAMON	COUNTY)									
WEST   RI1-II00   36" X 30"   7.5   ROAD ENDS   2   30.7   30.7   W1-1R	36" X 36"	9.0		TURN	1		19.8	
WEST   E.O.R. RED   18" X 18"   2.3   END OF ROAD   2   30.7									T			
WEST E.O.R. RED 18" X 18" 2.3   END OF ROAD									2		30.7	
2ND STREET (SANGAMON COUNTY)									1			
SOUTH   W14-1   36" X 36"   9.0   DEAD END   1   19.8	ZND STREET IS AND	ZAMON COLIN	·····						<b></b>	·	***************************************	
SOUTH R11-1100 36" X 30" 7.5 ROAD ENDS   SOUTH E.O.R. RED 18" X 18" 2.3 END 0F ROAD 2 30.7	END STREET ISANL	AUSTOIA CODI		W14-1	36" X 36"	9.0		DEAD END	Ι 1		19.8	
SOUTH   E.O.R. RED   18" X 18"   2.3   END OF ROAD   2   30.7			~~~						<del> </del>			
300111 [210111 1120 ] 10 11 12									2		30.7	
30010 [2001, 020 ] 0 / 10   200 ] [200 ] [200 ]						-			1 -			
	L		300111	Lavana NED	10 / 10	1 2.0		L19 01 110110	J	L		h

## GEOTECHNICAL SCHEDULE

THE ENGINEER. ESTIMATES BASED ON A		EST. QUANTITY
ROCK FILL-EMBANKMENT	SPECIAL PROVISION: ROCKFILL SUBGRADE	5150 TONS
EARTH EXCAVATION (ROCKFILL)	ROCKFILL SUBGRADE	2670 CU YD 7
ESTIMATED STATION LIMITS:		
1646+00 TO 1648+00 NBL		
40+00 TO 43+00 SBL		
66+00 TO 70+00 SBL		
PROCESSING LIME MODIFIED SOIL	NONE	8005 S0 YD
EARTH EXCAVATION	NONE	2670 CU YD
IME	NONE	160 TONS
ESTIMATED STATION LIMITS:	MONE	100 10.10
1646+00 TO 1648+00 NBL		
40+00 TO 43+00 NBL		
66+00 TO 70+00 SBL		
NOTE THAT REMOVING AND REPLACING	UNSTABLE SUBGRADE TO FACILITAT	E DEEP LIME MODIFICATION
ARE TWO SEPARATE OPERATIONS AND EA	ARTH EXCAVATION WILL BE PAID FOR	R EACH OPERATION.
STIMATED QUANTITIES FOR GROUND IM	PROVEMENTS TO BE MADE PRIOR TO	PLACING PRE-CAST BOX
CULVERTS MAY BE REDUCED, INCREASED	, OR DELETED BY THE ENGINEER BAS	SED ON ACTUAL FIELD
CONDITIONS. THE ENGINEER WILL DETE		
EXCAVATION TO THE THEORETICAL BOTT	OM OF BEDDING ELEVATION. ESTIM	
PAY ITEM:	SPECIAL PROVISION:	EST. QUANTITY
ROCKFILL - FOUNDATION	ROCKFILL-FOUNDATION	1015 TONS
LOCATION:		
1479+04.7		
1525+66.91		
1656+15•		

| CONTRACT NO. 72829
F.A.	SECTION	COUNTY	SHEETS	NO. 75	84-12; 11-3	a	729	61
STA. N/A	TO STA. N/A	FED. ROAD DIST. NO. 5	ILLINOIS	FED. AID	PROJECT			
SANGAMON	AND	CHRISTIAN						

REVISIONS
NAME
DATE
REV.-1
5/25

SCHEDULE OF QUANTITIES
PERMANENT SIGNING
GEOTECH

SCALE: N/A
DATE: 03/06/2012
CHECKED BY: J.M.M.