



F.A.I. RTE.	SECTION	COUNTY	TOTAL SHEETS	SHEET NO.
57	10-32HB-3K,K	CHAMPAIGN	352	100

CONTRACT NO. 90758

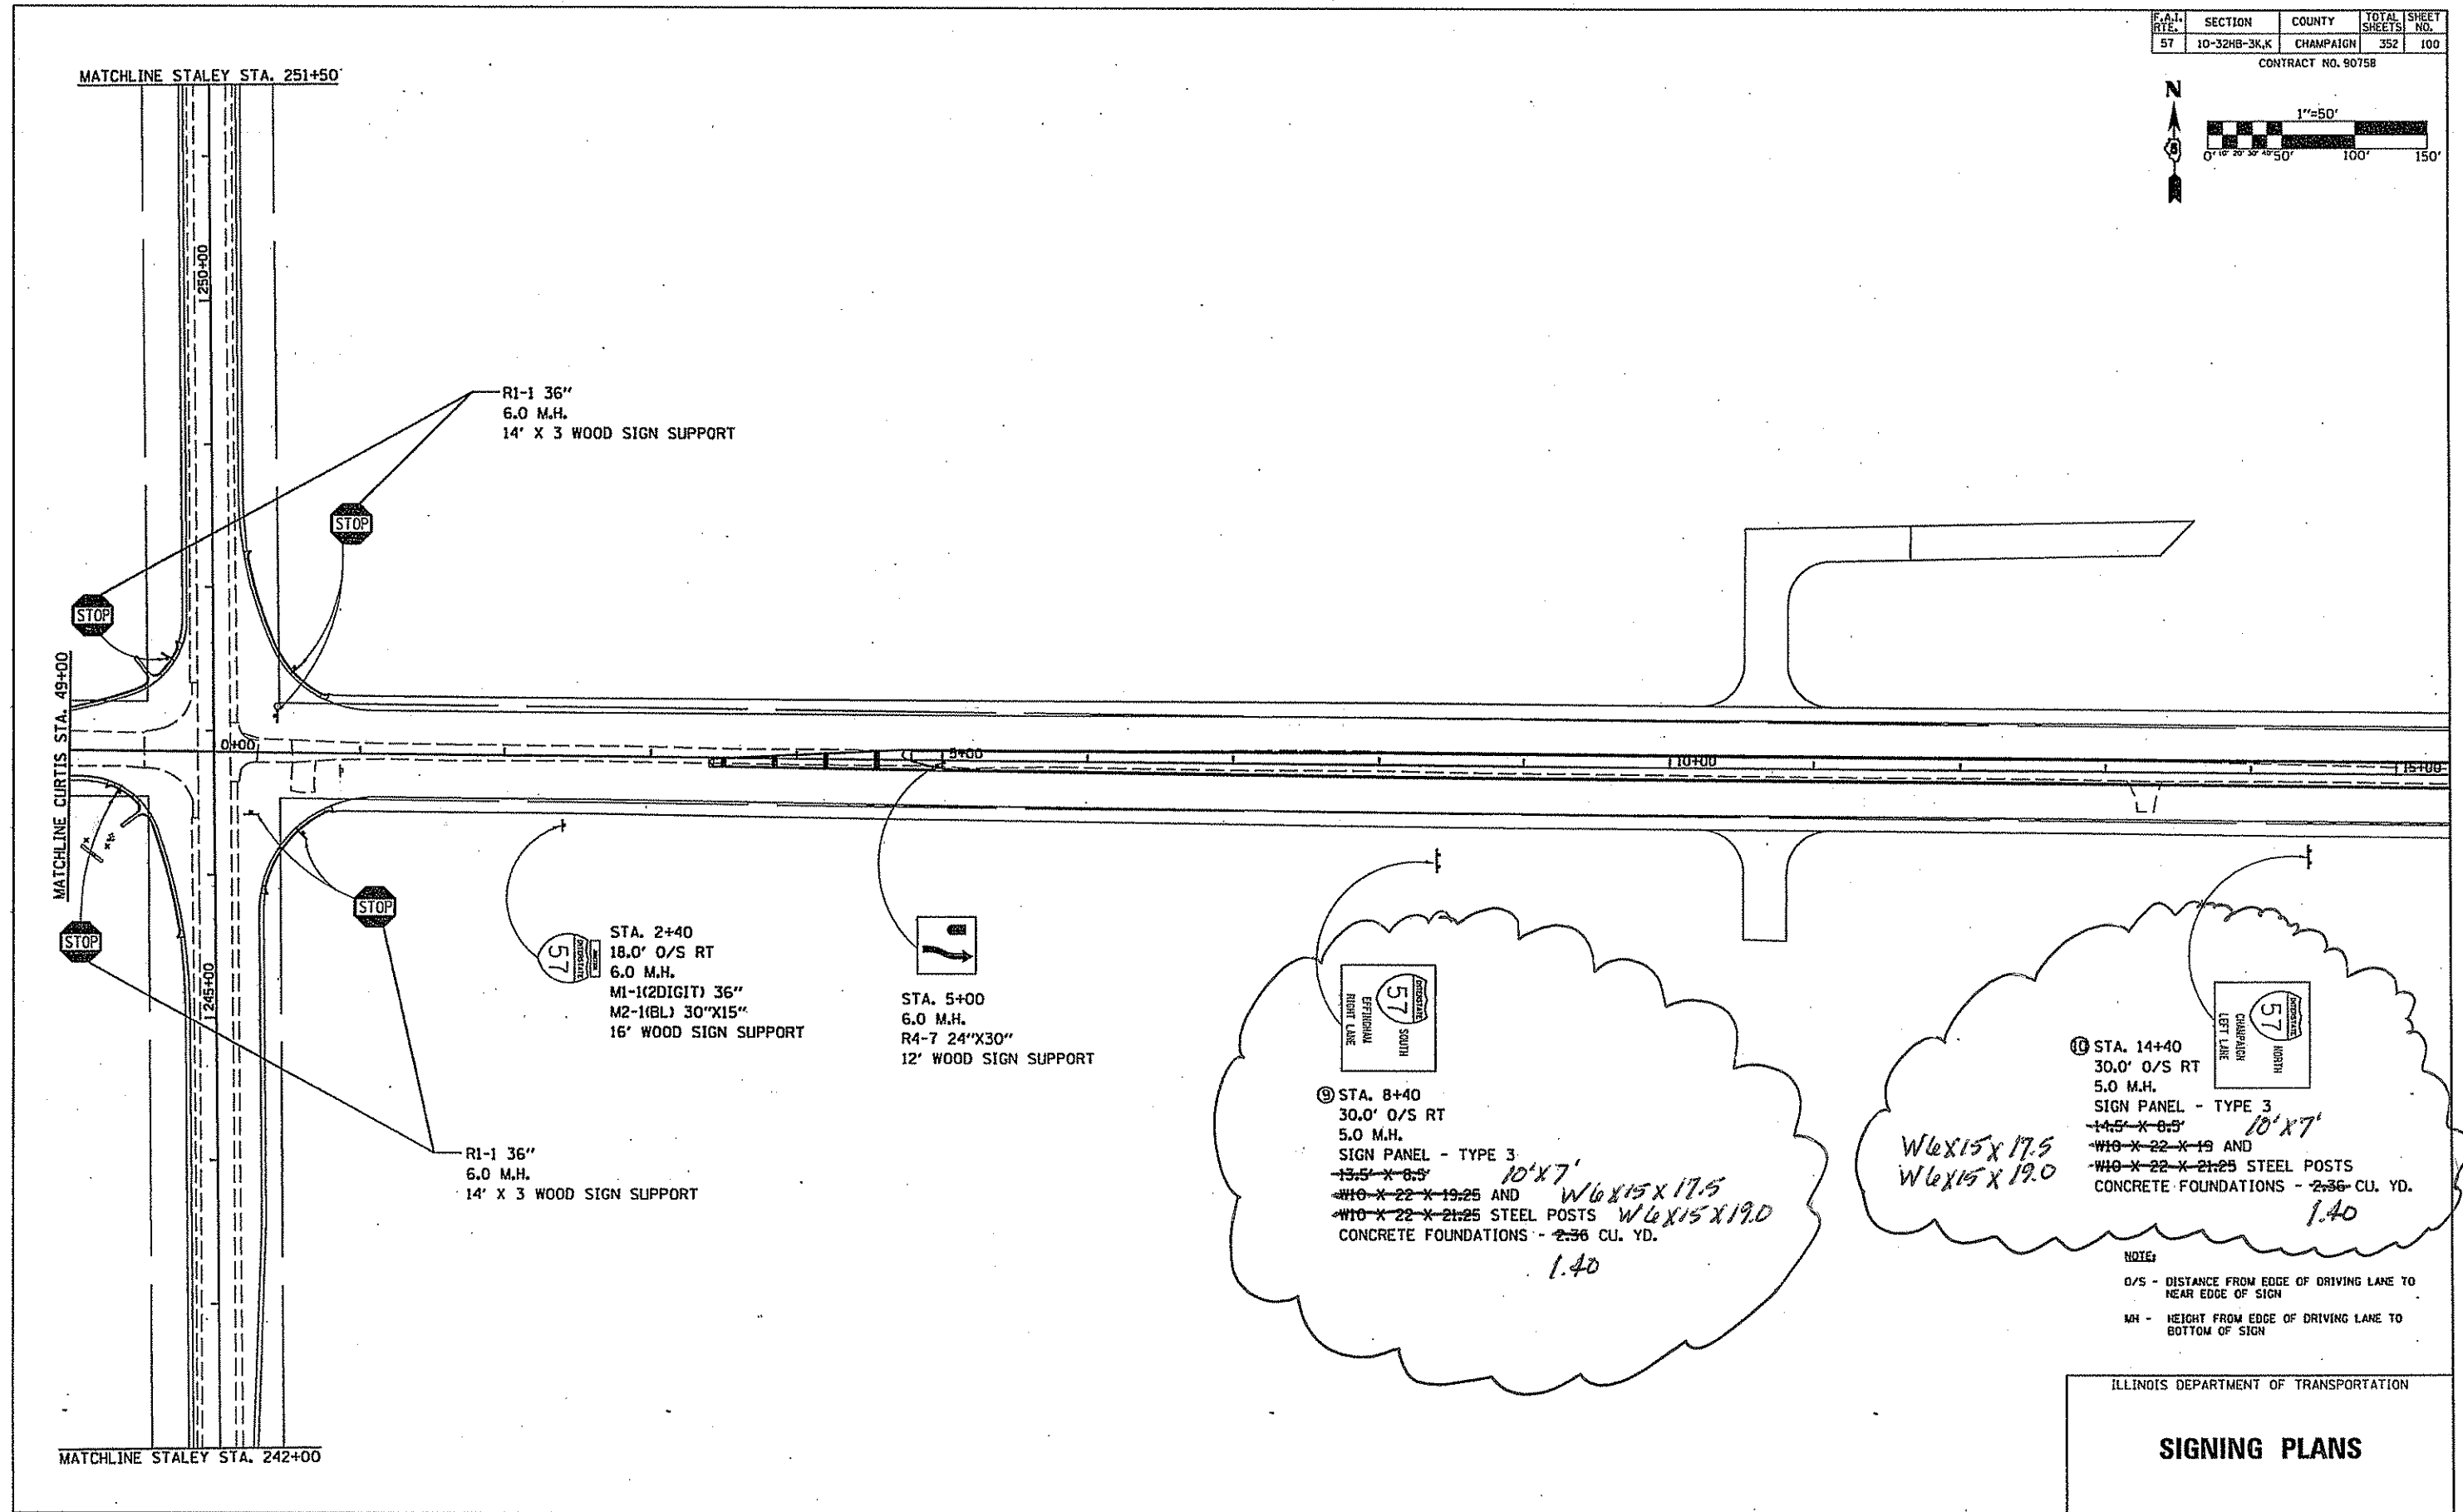

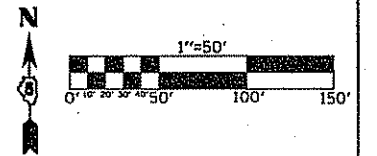

R1-1 36"
6.0 M.H.
14' X 3 WOOD SIGN SUPPORT

STA. 2+40
18.0' O/S RT
6.0 M.H.
M1-1(2DIGIT) 36"
M2-1(BL) 30"X15"
16' WOOD SIGN SUPPORT

STA. 5+00
6.0 M.H.
R4-7 24"X30"
12' WOOD SIGN SUPPORT

R1-1 36"
6.0 M.H.
14' X 3 WOOD SIGN SUPPORT


 © STA. 8+40
 30.0' O/S RT
 5.0 M.H.
 SIGN PANEL - TYPE 3
~~13.5' X 8.5'~~ 10' X 7'
~~W10 X 22 X 19.25 AND~~ W6 X 15 X 17.5
~~W10 X 22 X 21.25 STEEL POSTS~~ W6 X 15 X 19.0
 CONCRETE FOUNDATIONS - 2.36 CU. YD.
 1.40


 © STA. 14+40
 30.0' O/S RT
 5.0 M.H.
 SIGN PANEL - TYPE 3
~~14.5' X 8.5'~~ 10' X 7'
~~W10 X 22 X 19 AND~~ W6 X 15 X 17.5
~~W10 X 22 X 21.25 STEEL POSTS~~ W6 X 15 X 19.0
 CONCRETE FOUNDATIONS - 2.36 CU. YD.
 1.40

NOTE:
 O/S - DISTANCE FROM EDGE OF DRIVING LANE TO NEAR EDGE OF SIGN
 MH - HEIGHT FROM EDGE OF DRIVING LANE TO BOTTOM OF SIGN

ILLINOIS DEPARTMENT OF TRANSPORTATION

SIGNING PLANS