


F.A.I. RTE.	SECTION	COUNTY	TOTAL SHEETS	SHEET NO.
74	(72-7)R-3	PEORIA	1360	13
STA.		TO STA.		
FED. ROAD DIST. NO.		ILLINOIS FED. AID PROJECT		

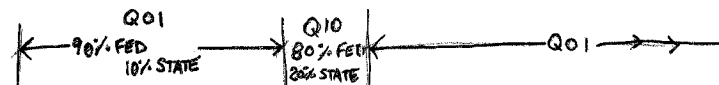

SUMMARY OF QUANTITIES

CODE NO.	PAY ITEM	UNIT	TOTAL QUANTITY	CONSTRUCTION TYPE CODE														
				ROADWAY 1000-2A	ROADWAY J000-2A	BRIDGE (1) X271-2A	BRIDGE (2) X281-2A	BRIDGE (3) X781-2A	BRIDGE (4) X028-2A	MINOR STRUCTURES (5) Y007	OVERHEAD SIGNS Y002-1C	LIGHTING Y030-1E	ITS Y035	TRAFFIC SIGNAL INTERCONNECT Y031-1F	TRAFFIC SIGNALS (6) Y031-1F	TRAFFIC SIGNALS (7) Y031-1F	TRAFFIC SIGNALS (8) Y031-1F	
M7030550	PAVEMENT MARKING TAPE, TYPE III 200MM	METER	1,088		1,088													
M7031000	WORK ZONE PAVEMENT MARKING REMOVAL	SO M	7,186	2,075	5,111													
M7040300	RELOCATE TEMPORARY CONCRETE BARRIER (STATE OWNED)	METER	2,134.85		2,134.85													
M7040400	TEMPORARY CONCRETE BARRIER (STATE OWNED)	METER	<del>3,206.00</del> 3,670		<del>3,206.00</del> 3,670													
M7200100	SIGN PANEL - TYPE 1	SO M	14	14														
M7200200	SIGN PANEL - TYPE 2	SO M	20	20														
M7200300	SIGN PANEL - TYPE 3	SO M	262	92	16						154							
M7210105	SIGN PANEL OVERLAY, SPECIAL	SO M	51.06	40.84	10.22													
M7270100	STRUCTURAL STEEL SIGN SUPPORT - BREAKAWAY	KG	3,450	3,050	400													
M7290100	METAL POST - TYPE A	METER	8.5	8.5														
M7290200	METAL POST - TYPE B	METER	17.0	13.0	4.0													
M7300100	WOOD SIGN SUPPORT	METER	265.5	239.5	26.0													
M7330050	OVERHEAD SIGN STRUCTURE - SPAN, TYPE I-S (1.22M X 1.37M)	METER	63.5								63.5							
M7330255	OVERHEAD SIGN STRUCTURE - CANTILEVER, TYPE III-C-A (0.90M x 2.14M)	METER	22.6								22.6							
M7340100	CONCRETE FOUNDATIONS	CU M	11.9	9.8	2.1													
M7340200	DRILLED SHAFT CONCRETE FOUNDATIONS	CU M	64.4								64.4							
M7800105	THERMOPLASTIC PAVEMENT MARKING - LINE 100 MM	METER	6,015	5,991	24													
M7800115	THERMOPLASTIC PAVEMENT MARKING - LINE 150 MM	METER	1,334	1,334														
M7800120	THERMOPLASTIC PAVEMENT MARKING - LINE 200 MM	METER	2,949	2,909	40													
M7800125	THERMOPLASTIC PAVEMENT MARKING - LINE 300 MM	METER	523	523														
M7800140	THERMOPLASTIC PAVEMENT MARKING - LINE 600 MM	METER	151	151														
M7800600	EPOXY PAVEMENT MARKING - LETTERS AND SYMBOLS	SO M	13	6	7													
M7802010	POLYUREA PAVEMENT MARKING TYPE I - LINE 100MM	METER	34,412	4,140	30,272													
M7802015	POLYUREA PAVEMENT MARKING TYPE I - LINE 150MM	METER	4,014	526	3,488													
M7802020	POLYUREA PAVEMENT MARKING TYPE I - LINE 200MM	METER	4,691	103	4,588													
M7802030	POLYUREA PAVEMENT MARKING TYPE I - LINE 300MM	METER	425	46	379													
M7802060	POLYUREA PAVEMENT MARKING TYPE I - LINE 600 MM	METER	40	29	11													
M8080150	TEMPORARY WOOD POLE, 15.24M, CLASS 4	EACH	10								10							
M8100240	CONDUIT IN TRENCH, 30 MM DIA., PVC	METER	39	39														
M8100260	CONDUIT IN TRENCH, 50 MM DIA., PVC	METER	3,400.0								1,723.0	204.0	1,265.0		118.0	90.0		
M8100270	CONDUIT IN TRENCH, 65 MM DIA., PVC	METER	22												10	12		
M8100280	CONDUIT IN TRENCH, 75MM DIA., PVC	METER	4,069.0								4,069.0							
M8100290	CONDUIT IN TRENCH, 90 MM DIA., PVC	METER	130													85	45	
M8100300	CONDUIT IN TRENCH, 100 MM DIA., PVC	METER	61													25	36	

- \* SPECIALTY ITEMS
- + FUND CODE SFTY-3N
- ++ FUND CODE Y080
- +++ FUND CODE SFTY-3C
- Δ NON PARTICIPATING

- (1) RAMP A-3 OVER RAMP B-5, SN 072-0172
- (2) RAMPS B-3 & B-5 OVER US 150 & RAMP B-6, SN 072-0190 ~~PROPOSED (SUBMIT 072-0026)~~
- (3) RAMPS B-1 & B-4 OVER RAMPS A-3, B-3 & I-74, SN 072-0183 ~~PROPOSED (SUBMITTING 072-0027)~~
- (4) NORTH AND SOUTH CULVERT EXTENSION, SN 072-2005 (072-2005); ~~SN 072-2030, SN 072-2032~~
- (5) WALL 8, SN 072-8556, WALL 8A, SN 072-8557, WALL 9, SN 072-8558, WALL 10, SN 072-8559, WALL 11, SN 072-8560, WALL 12, SN 072-8561, SN 072-2504, WALL 12B, DIFFERENTIAL HEIGHT BARRIER, BOX CULVERT, WALL 18B, SN 072-8618 (072-2005); WALL 18C, SN 072-8619 (072-2005)
- (6) WAR MEMORIAL DRIVE / STERLING / GLEN
- (7) WAR MEMORIAL DRIVE / SCENIC DRIVE
- (8) SCENIC DRIVE / MALL ENTRANCE

REVISIONS	
NAME	DATE
REVISED	
ADDENDUM 1	5/27/05

ILLINOIS DEPARTMENT OF TRANSPORTATION

SUMMARY OF QUANTITIES  
FAI ROUTE 74 (I-74)

DRAWN BY ROY  
CHECKED BY LSA

DATE 11/23/04

