


COOK COUNTY (SOUTH)

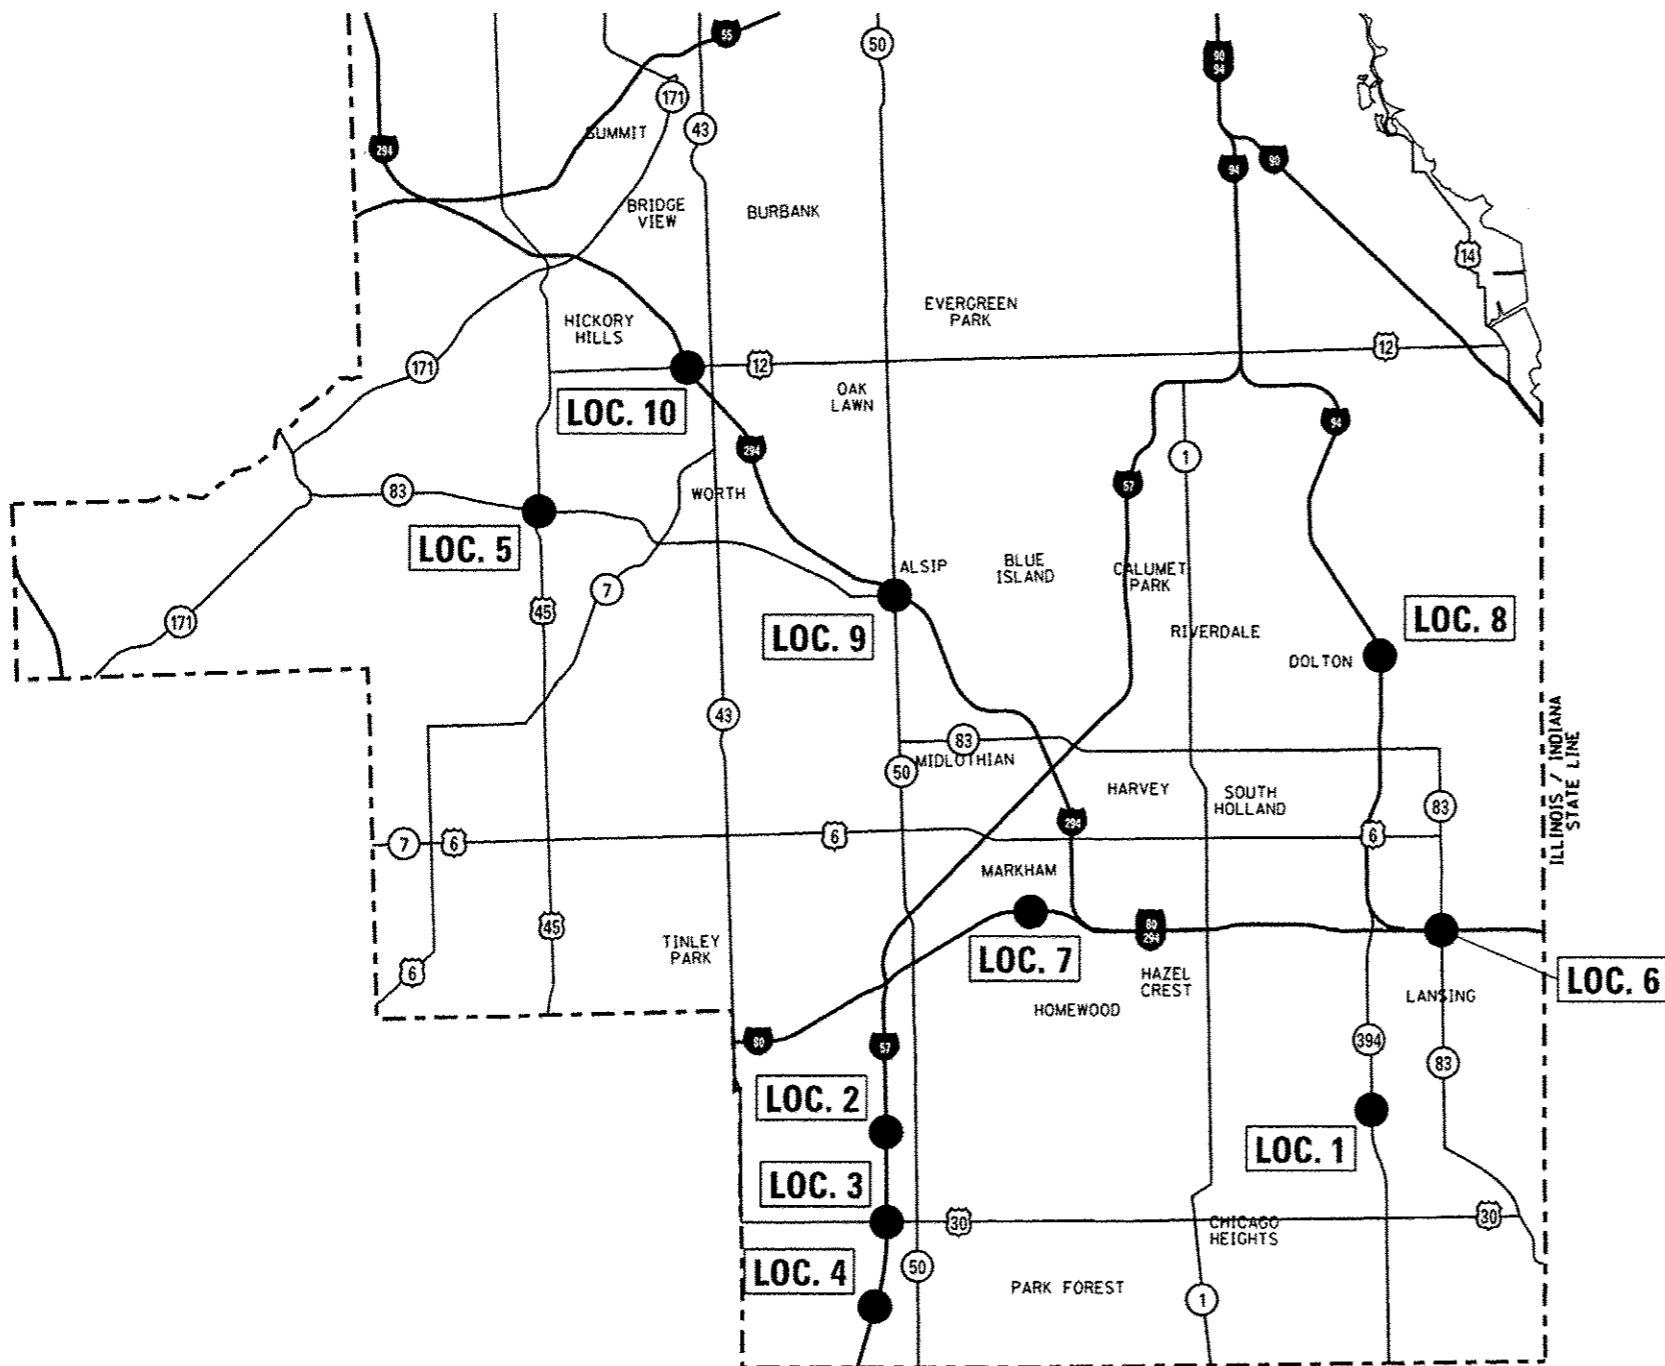

- LOC. NO. COOK COUNTY (SOUTH) LOCATIONS**
1. IL RTE 394 AND GLENWOOD DYER RD
 2. I-57 AND VOLLMER RD
 3. I-57 AND US RTE 30 (LINCOLN HIGHWAY)
 4. I-57 AND SAUK TRAIL
 5. US RTE 45 AND IL RTE 83 (CALUMET SAG RD)
 6. I-80 /94 AND US RTE 6 /IL RTE 83 (TORRENCE AVE)
 7. I-80 AND KEDZIE AVE
 8. I-94 (BISHOP FORD FREEWAY) AND DOTY AVE (137TH ST)
 - * ~~9. I-294 (TRI-STATE TOLLWAY) AND 127TH ST~~
 - * ~~10. I-294 (TRI-STATE TOLLWAY) AND US RTE 12 (95TH ST)~~

*** LOCATIONS NO. 9 AND 10 ELIMINATED**



Rev. Sheet 7-17-13

FILE NAME :	USER NAME : SMITHCJ	DESIGNED -	REVISED -
c:\p\work\p\dott\smithc\j\8340445\Design\Sheet-RampSignage-DupPageCo.dgn		DRAWN -	REVISED -
Default	PLOT SCALE : 100,0000 / 100	CHECKED -	REVISED -
	PLDT DATE : 7/9/2013	DATE -	REVISED -

**STATE OF ILLINOIS
DEPARTMENT OF TRANSPORTATION**

COOK COUNTY (SOUTH) LOCATION MAP			
SCALE:	SHEET	OF SHEETS	STA. TO STA.

P.A. RTE.	SECTION	COUNTY	TOTAL SHEETS	SHEET NO.
	2013-025-SG	COOK/WILL	57	4
CONTRACT NO. 60W51				
ILLINOIS FED. AID PROJECT				