


F.A. RTE.	SECTION	COUNTY	TOTAL SHEETS	SHEET NO.
	14-B-R-1 & 15N-3	WILL	143	50
STA.		TO STA.		
FED. ROAD DIST. NO.	ILLINOIS	FED. AID PROJECT		
CONTRACT NO. 62098				



FOR INFORMATION ONLY

PLEASE NOTE: SBC WILL NOT PROVIDE TBE AS-BUILT DRAWINGS FOR REVIEW PURPOSES ONLY.

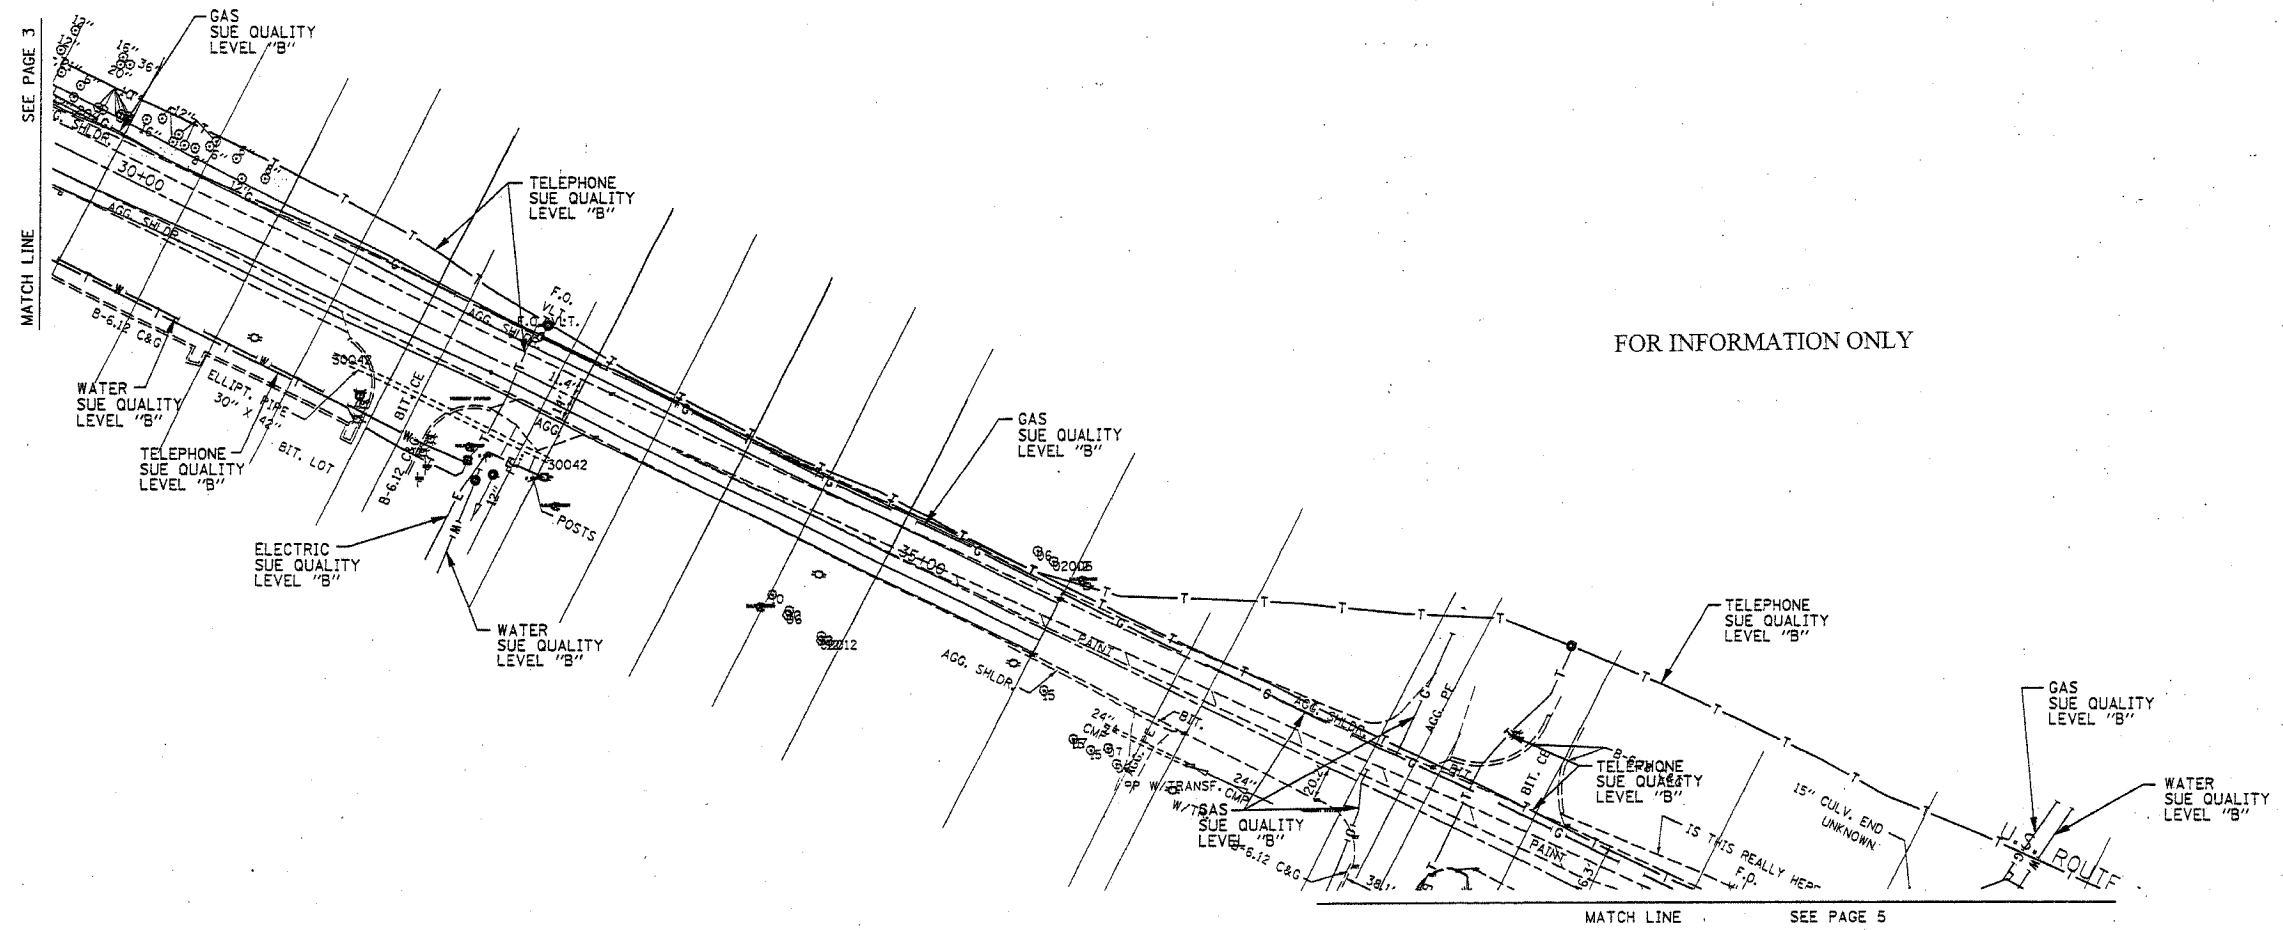


**TBE GROUP, INC.**  
 CIVIL ENGINEERING • TRANSPORTATION • ENVIRONMENTAL  
 • PLANNING • UTILITY ENGINEERING/LOCATING  
 SOUTHERN REGION: FL, GA, SC, NC  
 NORTHERN REGION: IL, IN, MI, OH, MD, NJ, NY  
 PA, VA, CANADA  
 WESTERN REGION: AZ, NV, NM, TX, CA, OR, UT, WA

IL09500202  
 TBE SUE PAGE NO: 4 of 5  
 Checked by: *[Signature]*  
 SUE Quality Level "A" : Test Holes  
 SUE Quality Level "B" : Designating

— T — T —	TELEPHONE
— W —	WATER
— G —	GAS
— CTV — CTV —	CABLE TELEVISION
— FO — FO —	FIBER OPTIC
— E — E —	ELECTRIC
⊙	TEST HOLE

Utilities shown on these plans as depicted in the legend have been investigated by TBE Group, Inc in accordance with SUE Industry Standards. All other information shown has been provided to TBE Group, Inc by others.

  
 205 W. WACKER DRIVE  
 SUITE 1020  
 CHICAGO, IL 60606  
 (312) 704-1970

REVISIONS	
NAME	DATE

ILLINOIS DEPARTMENT OF TRANSPORTATION  
 SUE Investigation of Underground Utilities  
 US ROUTE 30 (PLAINFIELD ROAD)  
 AT LILY CACHE ROAD  
 Contract Number: 62098  
 DATE - SOL "B" 6/09/04  
 DRAWN BY : KLC  
 SCALE : 1" = 50'