

BENCHMARKS






PROPOSED S.N. 010-2028

- B.M. 4592-1** CHISELED SQUARE
 0.4 MILE NORTH OF THE INTERSECTION OF MAIN STREET AND U.S. ROUTE 150 TO THE MARK ON THE EAST SIDE OF MAIN STREET. MARK IS LOCATED ON THE WEST CONCRETE FOUNDATION OF CHAMPAIGN/DANVILLE I-74 SIGN. SIGN IS LOCATED 0.1 MILE SOUTH OF INTERSTATE BRIDGE.
 ELEV. = 681.97
- B.M. 4592-2** CHISELED SQUARE
 MARK IS LOCATED 0.6 MILE NORTH OF INTERSECTION OF MAIN STREET AND U.S. ROUTE 150 ON THE EAST SIDE OF MAIN STREET. MARK IS LOCATED ON THE NORTH CORNER OF A CONCRETE ISLAND LOCATED AT THE INTERSECTION OF MAIN STREET AND THE WEST BOUND OFF RAMP OF I-74. MARK IS 0.1 MILE NORTH OF I-74 BRIDGE.
 ELEV. = 689.67
- B.M. 4592-3** CHISELED SQUARE
 MARK IS LOCATED 0.25 MILE EAST OF THE INTERSTATE BRIDGE AT ST JOSEPH. IT IS A CHISELED SQUARE LOCATED ON WEST SIDE OF A BOX CULVERT 25 FEET NORTH OF A STATION MARK 778+00 NORTH OF THE WEST BOUND LANES OF I-74.
 ELEV. = 670.10
- B.M. 4592-4** CHISELED SQUARE
 MARK IS LOCATED 50 FEET WEST OF CENTERLINE OF INTERSTATE BRIDGE AT ST JOSEPH. MARK IS A CHISELED SQUARE LOCATED ON THE SOUTHWEST CORNER OF CONCRETE PAD LOCATED IN THE CENTER OF THE MEDIAN. MARK IS ROUGHLY 13.5 FEET NORTH OF THE NORTH EDGE OF PAVEMENT OF THE EAST BOUND LANES ON I-74.
 ELEV. = 672.73
- B.M. 4372-1** STATION 137+79.72 (17.0' RT)
 CHISELED SQUARE
 MARK IS LOCATED ON NORTHEAST WING OF STRUCTURE NO. 010-0087.
 ELEV. = 670.405
- B.M. 4372-2** STATION 133+87.96 (243.0' RT)
 CHISELED SQUARE
 MARK IS LOCATED ON SOUTHWEST CORNER OF CONCRETE PIPE CULVERT WINGWALL.
 ELEV. = 667.36

TIE POINTS

PROPOSED S.N. 010-2028

F.A.S. RTE.	SECTION	COUNTY	TOTAL SHEETS	SHEET NO.
516	241BR & 56BR	CHAMPAIGN	82	44
STA. TO STA.		ILLINOIS FED. AID PROJECT		

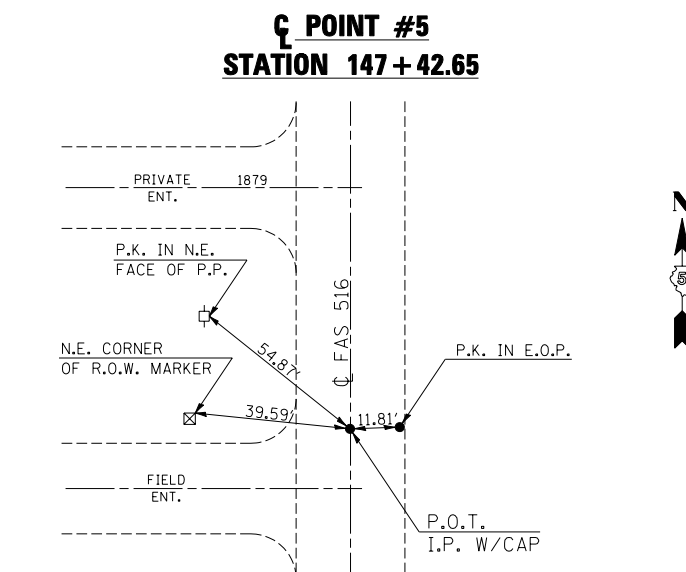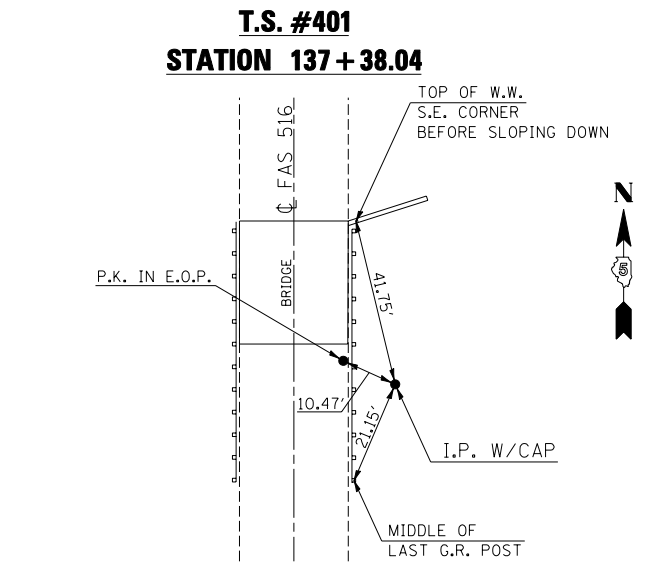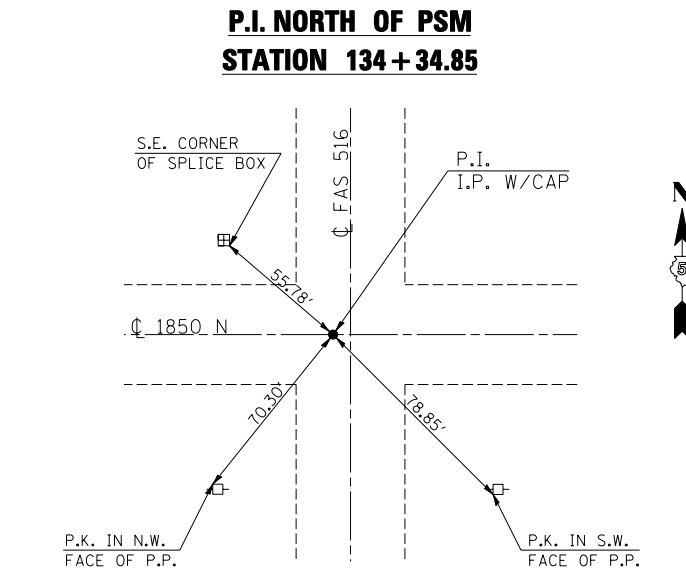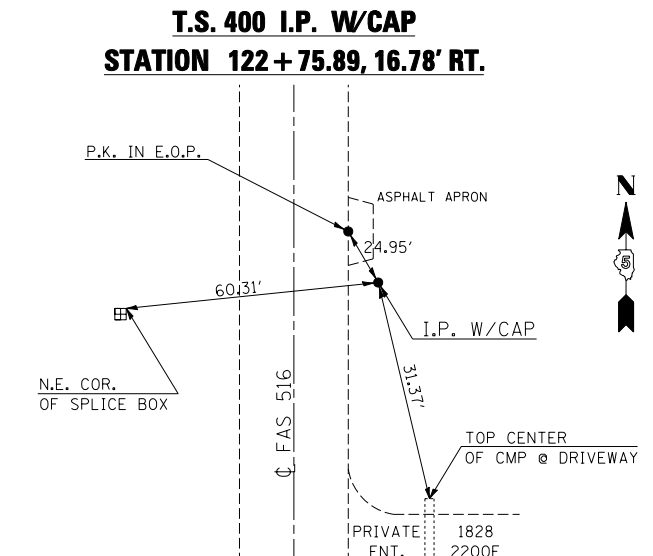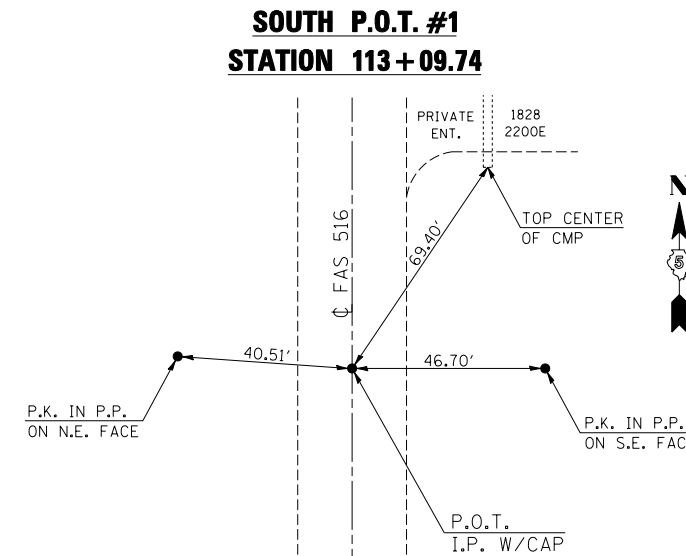

ILLINOIS DEPARTMENT OF TRANSPORTATION
DETAILS
 PROPOSED S.N. 010-2028
 F.A.S. 516/(C.H. 12)
 SECTION 241BR & 56BR
 CHAMPAIGN COUNTY
 SCALE: NOT TO SCALE DRAWN BY: B.B.P.
 DATE: 05/15/06 CHECKED BY: G.A.E.

PLOT DATE = 7/6/2006
 FILE NAME = c:\projects\0101304 (v8)\2028details.dgn
 PLOT SCALE = 42.3529' / IN.
 USER NAME = piersebr