


CONSTRUCTION CODE			
90% FED 10% STATE WILL COUNTY	90% FED 10% STATE COOK COUNTY		
TRAFFIC SIGNALS			
0021			
URBAN			

CODE NO.	ITEM	UNIT	TOTAL QUANTITY	90% FED 10% STATE WILL COUNTY	90% FED 10% STATE COOK COUNTY				
* 66900200	NON-SPECIAL WASTE DISPOSAL	CU YD	78 <del>60</del>	13 <del>20</del>	65 <del>40</del>				
* 66900530	SOIL DISPOSAL ANALYSIS	EACH	6 <del>2</del>	1	5 <del>1</del>				
* 66901001	REGULATED SUBSTANCES PRE-CONSTRUCTION PLAN	L SUM	1	0.20	0.80				
* 66901003	REGULATED SUBSTANCES FINAL CONSTRUCTION REPORT	L SUM	1	0.20	0.80				
* 66901006	REGULATED SUBSTANCES MONITORING	CAL DA	18	3	15				
67100100	MOBILIZATION	L SUM	1	0.20	0.80				
70102620	TRAFFIC CONTROL AND PROTECTION, STANDARD 701501	L SUM	1	0.20	0.80				
70102625	TRAFFIC CONTROL AND PROTECTION, STANDARD 701606	L SUM	1	0.20	0.80				
70102635	TRAFFIC CONTROL AND PROTECTION, STANDARD 701701	L SUM	1	0.20	0.80				
70102640	TRAFFIC CONTROL AND PROTECTION, STANDARD 701801	L SUM	1	0.20	0.80				
72000100	SIGN PANEL - TYPE 1	SQ FT	93	31.5	61.5				
72000200	SIGN PANEL - TYPE 2	SQ FT	108.75	52.5	56.25				
81028200	UNDERGROUND CONDUIT, GALVANIZED STEEL, 2" DIA.	FOOT	732	233	499				
81028220	UNDERGROUND CONDUIT, GALVANIZED STEEL, 3" DIA.	FOOT	408	62	346				

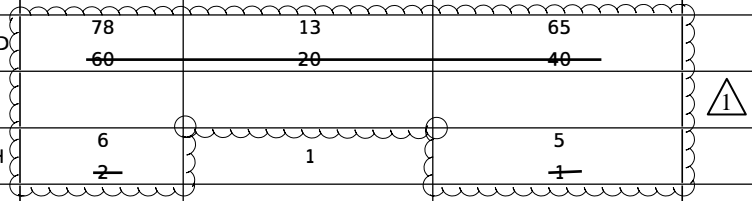

\* SPECIALTY ITEM

REVISION 1 REVISED SHEET 9/8/2023

MODEL: D:\default... FILE NAME: S:\WP\Design\Iovan\08\_MastArm\Contract\08\_62U32 - September 2023\CADD\082U32-sht-general.dgn

USER NAME = Iovan.Plascencia	DESIGNED - IP	REVISED -
DRAWN - IP	CHECKED - NB	REVISED -
PLOT SCALE = 100.0000' / in.	DATE - 6/30/2023	REVISED -
PLOT DATE = 6/30/2023		

**STATE OF ILLINOIS  
DEPARTMENT OF TRANSPORTATION**

SUMMARY OF QUANTITIES (SHEET 1 OF 6)			
SCALE:	SHEET	OF	SHEETS
	STA.		TO STA.

F.A. RTE.	SECTION	COUNTY	TOTAL SHEETS	SHEET NO.
VAR	2023 TRAFFIC MAST	VARIOUS	47	5
			CONTRACT NO. 62U32	
ILLINOIS FED. AID PROJECT				