

CONTRACT NO. 72501

| CODE NO.   | ITEM  | UNIT  | TOTAL QUANTITY | CONSTRUCTION CODE        |                   |                                 |                                      |                                     |                         |                                   |  |  |  |
|------------|---|-------|----------------|--------------------------|-------------------|---------------------------------|--------------------------------------|-------------------------------------|-------------------------|-----------------------------------|--|--|--|
|            |   |       |                | 80% FEDERAL<br>20% STATE | 80% FED<br>20% ST | 80% FED<br>20% ST               | 80% FEDERAL<br>10% STATE<br>10% CITY | 80% FEDERAL<br>15% STATE<br>5% CITY | 80% FEDERAL<br>20% CITY | 80% STATE<br>20% TOWNSHIP         |  |  |  |
|            |   |       |                | ROADWAY/<br>STORM SEWER  | SIDEWALK<br>CITY  | CAPITAL<br>TOWNSHIP<br>SIDEWALK | TRAFFIC<br>SIGNALS<br>ELM            | TRAFFIC<br>SIGNALS<br>RIDGE         | BIKE LANES<br>CITY      | BIKE LANES<br>CAPITAL<br>TOWNSHIP |  |  |  |
|            |   |       |                | 0003<br>URBAN            | 0021<br>URBAN     | 0021<br>URBAN                   | 0021<br>URBAN                        | 0021<br>URBAN                       | 0028<br>URBAN           | 0028<br>URBAN                     |  |  |  |
| M6060500   | COMBINATION CONCRETE CURB AND GUTTER, TYPE B-15.30                        | METER | 1138.9         | 1138.9                   |                   |                                 |                                      |                                     |                         |                                   |  |  |  |
| M6060700   | COMBINATION CONCRETE CURB AND GUTTER, TYPE B-15.60                        | METER | 409.2          | 409.2                    |                   |                                 |                                      |                                     |                         |                                   |  |  |  |
| M6061600   | COMBINATION CONCRETE CURB AND GUTTER, TYPE B-22.60                        | METER | 30.9           | 30.9                     |                   |                                 |                                      |                                     |                         |                                   |  |  |  |
| M6690100   | BACKFILL PLUGS  | CU M  | 20.0           | 20.0                     |                   |                                 |                                      |                                     |                         |                                   |  |  |  |
| M6690200   | NON-SPECIAL WASTE DISPOSAL  | CU M  | 8000.0         | 8000.0                   |                   |                                 |                                      |                                     |                         |                                   |  |  |  |
| * M7200200 | SIGN PANEL - TYPE 2   | SO M  | 2.1            |                          |                   |                                 | 2.1                                  |                                     |                         |                                   |  |  |  |
| * M7800200 | PAINT PAVEMENT MARKING - LETTERS AND SYMBOLS                              | SQ M  | 93             | 93                       |                   |                                 |                                      |                                     |                         |                                   |  |  |  |
| * M7800350 | PREFORMED PLASTIC PAVEMENT MARKING, TYPE B - INLAID - LETTERS AND SYMBOLS | SO M  | 89             | 89                       |                   |                                 |                                      |                                     |                         |                                   |  |  |  |
| * M7800360 | PREFORMED PLASTIC PAVEMENT MARKING, TYPE B - INLAID - LINE 125MM          | METER | 735            | 735                      |                   |                                 |                                      |                                     |                         |                                   |  |  |  |
| * M7800390 | PREFORMED PLASTIC PAVEMENT MARKING, TYPE B - INLAID - LINE 600MM          | METER | 113            | 113                      |                   |                                 |                                      |                                     |                         |                                   |  |  |  |
| * M7809125 | MODIFIED URETHANE PAVEMENT MARKING - LINE 125MM                           | METER | 7442           | 7442                     |                   |                                 |                                      |                                     |                         |                                   |  |  |  |
| * M7809150 | MODIFIED URETHANE PAVEMENT MARKING - LINE 150MM                           | METER | 1081           | 1081                     |                   |                                 |                                      |                                     |                         |                                   |  |  |  |
| * M7809200 | MODIFIED URETHANE PAVEMENT MARKING - LINE 200MM                           | METER | 47             | 47                       |                   |                                 |                                      |                                     |                         |                                   |  |  |  |
| * M7809300 | MODIFIED URETHANE PAVEMENT MARKING - LINE 300MM                           | METER | 32             | 32                       |                   |                                 |                                      |                                     |                         |                                   |  |  |  |
| M7830100   | PAVEMENT MARKING REMOVAL  | SO M  | 387.0          | 387.0                    |                   |                                 |                                      |                                     |                         |                                   |  |  |  |

1

\*SPECIALTY ITEM

REV. 10/31/13

| REVISIONS |      |
|-----------|------|
| NAME      | DATE |
|           |      |
|           |      |
ILLINOIS DEPARTMENT OF TRANSPORTATION  
 SUMMARY OF QUANTITIES  
 F.A.P. ROUTE 668 (DIRKSEN PARKWAY)  
 SECTION 28R-1  
 SANGAMON COUNTY  
 SCALE: NONE  
 DATE: 06/2013  
 DRAWN BY: GE  
 CHECKED BY: FML

|          |         |          |              |           |
|----------|---------|----------|--------------|-----------|
| FAP RTE. | SECTION | COUNTY   | TOTAL SHEETS | SHEET NO. |
| 668      | 28R-1   | SANGAMON | 354          | 18        |

CONTRACT NO. 72501

| CODE NO.             | ITEM  | UNIT            | TOTAL QUANTITY | CONSTRUCTION CODE        |                   |                                 |                                      |                                     |                         |                                   |  |  |
|----------------------|---|-----------------|----------------|--------------------------|-------------------|---------------------------------|--------------------------------------|-------------------------------------|-------------------------|-----------------------------------|--|--|
|                      |   |                 |                | 80% FEDERAL<br>20% STATE | 80% FED<br>20% ST | 80% FED<br>20% ST               | 80% FEDERAL<br>10% STATE<br>10% CITY | 80% FEDERAL<br>15% STATE<br>5% CITY | 80% FEDERAL<br>20% CITY | 80% STATE<br>20% TOWNSHIP         |  |  |
|                      |   |                 |                | ROADWAY/<br>STORM SEWER  | SIDEWALK<br>CITY  | CAPITAL<br>TOWNSHIP<br>SIDEWALK | TRAFFIC<br>SIGNALS<br>ELM            | TRAFFIC<br>SIGNALS<br>RIDGE         | BIKE LANES<br>CITY      | BIKE LANES<br>CAPITAL<br>TOWNSHIP |  |  |
|                      |   |                 |                | 0003                     | 0021              |                                 |                                      | 0028                                |                         |                                   |  |  |
|                      | URBAN   | URBAN           | URBAN          | URBAN                    | URBAN             | URBAN                           | URBAN                                |                                     |                         |                                   |  |  |
| *MX030457            | STORM SEWER (WATER MAIN REQUIREMENTS) TYPE 1, 375MM     | METER           | 13.0           | 13.0                     |                   |                                 |                                      |                                     |                         |                                   |  |  |
| *MX030579            | STORM SEWER (WATER MAIN REQUIREMENTS) TYPE 2, 375MM     | METER           | 133.0          | 133.0                    |                   |                                 |                                      |                                     |                         |                                   |  |  |
| <del>*MX032178</del> | <del>TEMPORARY INFORMATION SIGNING</del>                | <del>SO M</del> | <del>300</del> | <del>300</del>           |                   |                                 |                                      |                                     |                         |                                   |  |  |
| MX032200             | ENGINEERED BARRIER                                      | SO M            | 125            | 125                      |                   |                                 |                                      |                                     |                         |                                   |  |  |
| MX440050             | ISLAND PAVEMENT REMOVAL                                 | SO M            | 102            | 102                      |                   |                                 |                                      |                                     |                         |                                   |  |  |
| MX440950             | HOT-MIX ASPHALT SURFACE REMOVAL, VARIABLE DEPTH         | SQ M            | 23559          | 23559                    |                   |                                 |                                      |                                     |                         |                                   |  |  |
| MX606360             | COMBINATION CONCRETE CURB AND GUTTER, TYPE B (SPECIAL)  | METER           | 46.9           | 46.9                     |                   |                                 |                                      |                                     |                         |                                   |  |  |
| *MX783072            | GROOVING FOR RECESSED PAVEMENT MARKING 152MM            | METER           | 7442           | 7442                     |                   |                                 |                                      |                                     |                         |                                   |  |  |
| *MX783074            | GROOVING FOR RECESSED PAVEMENT MARKING 178MM            | METER           | 1081           | 1081                     |                   |                                 |                                      |                                     |                         |                                   |  |  |
| *MX783076            | GROOVING FOR RECESSED PAVEMENT MARKING 229MM            | METER           | 47             | 47                       |                   |                                 |                                      |                                     |                         |                                   |  |  |
| *MX783078            | GROOVING FOR RECESSED PAVEMENT MARKING 330MM            | METER           | 32             | 32                       |                   |                                 |                                      |                                     |                         |                                   |  |  |
| MX871055             | FIBER OPTIC CABLE IN CONDUIT, NO. 62.5/125, MM12F SM12F | METER           | 1895.5         |                          |                   |                                 | 1389.3                               | 506.2                               |                         |                                   |  |  |
| X0322936             | REMOVE EXISTING FLARED END SECTION                      | EACH            | 9              | 9                        |                   |                                 |                                      |                                     |                         |                                   |  |  |
| X0326820             | INLETS, SPECIAL, TYPE E, 4' X 4'                        | EACH            | 8              | 8                        |                   |                                 |                                      |                                     |                         |                                   |  |  |



14


\*SPECIALTY ITEM

Rev. 10/31/13

| REVISIONS |      |
|-----------|------|
| NAME      | DATE |
|           |      |
|           |      |
ILLINOIS DEPARTMENT OF TRANSPORTATION  
SUMMARY OF QUANTITIES  
F.A.P. ROUTE 668 (DIRKSEN PARKWAY)  
SECTION 28R-1  
SANGAMON COUNTY  
SCALE: NONE  
DATE: 06/2013  
DRAWN BY: GE  
CHECKED BY: FML

| LOCATION        |         | SHORT TERM PAVEMENT MARKING | TEMPORARY PAVEMENT MARKING LETTERS AND SYMBOLS | TEMPORARY PAVEMENT MARKING - LINE 5" | TEMPORARY PAVEMENT MARKING - LINE 24" | WORK ZONE PAVEMENT MARKING REMOVAL | RAISED REFLECTIVE PAVEMENT MARKER | RAISED REFLECTIVE PAVEMENT MARKER REMOVAL | PREFORMED PLASTIC PAVEMENT MARKING, TYPE B - INLAID - LETTERS AND SYMBOLS | PREFORMED PLASTIC PAVEMENT MARKING, TYPE B - INLAID - LINE 125MM | PREFORMED PLASTIC PAVEMENT MARKING, TYPE B - INLAID - LINE 600MM | MODIFIED URETHANE PAVEMENT MARKING - LINE 125MM | MODIFIED URETHANE PAVEMENT MARKING - LINE 150MM | MODIFIED URETHANE PAVEMENT MARKING - LINE 200MM | MODIFIED URETHANE PAVEMENT MARKING - LINE 300MM | GROOVING FOR RECESSED PAVEMENT MARKING 152MM | GROOVING FOR RECESSED PAVEMENT MARKING 178MM | GROOVING FOR RECESSED PAVEMENT MARKING 229MM | GROOVING FOR RECESSED PAVEMENT MARKING 330MM | PAVEMENT MARKING REMOVAL | PAINT PAVEMENT MARKING - LETTERS & SYMBOLS |          |
|-----------------|---------|-----------------------------|--|--------------------------------------|---------------------------------------|------------------------------------|-----------------------------------|---|---|--|--|---|---|---|---|--|--|--|--|--------------------------|--|----------|
| STATION         | STATION | O/S                         | FOOT   | SQ. FT                               | FOOT                                  | FOOT                               | SQ. FT                            | EACH                                      | EACH  | SQ. M  | METER  | METER   | METER   | METER   | METER   | METER  | METER  | METER  | METER  | METER                    | SQ. M                                      | SQ. M    |
| DIRKSEN PARKWAY |         |                             | 70300100                                       | 70300210                             | 70300230                              | 70300280                           | 70301000                          | 78100100                                  | 78300200  | M7800350   | M7800360   | M7800390  | M7809125  | M7809150  | M7809200  | M7809300                                     | MX783072                                     | MX783074                                     | MX783076                                     | MX783078                 | M7830100                                   | M7800200 |
| 1+666           | 1+670   | N/A                         |  |                                      | 45                                    |                                    |                                   |   |   |  |  |   |   |   |   |  |  |  |  |                          |  |          |
| 1+666           | 6+785   | N/A                         |  |                                      |                                       | 10775                              |                                   |   |   |  |  |   |   |   |   |  |  |  |  |                          |  |          |
| 1+670           | 5+214   | N/A                         |  | 26                                   | 961                                   |                                    |                                   |   |   |  |  |   |   |   |   |  |  |  |  |                          |  |          |
| 5+214           | 5+390   | N/A                         |  | 152                                  | 2526                                  |                                    |                                   |   |   |  |  |   |   |   |   |  |  |  |  |                          |  |          |
| 5+214           | 5+236   | CL                          |  |                                      |                                       |                                    |                                   |   |   |  |  |   | 91.2  |   |   | 91.2   |  |  |  |                          |  |          |
| 5+215           | 5+217   | CL                          |  |                                      |                                       |                                    |                                   |   |   |  |  |   |   |   | 3.7   |  |  |  |  |                          | 3.7  |          |
| 5+223           | 5+227   | CL                          |  |                                      |                                       |                                    |                                   |   |   |  |  |   |   |   | 5.5   |  |  |  |  |                          | 5.5  |          |
| 5+225           | 5+431   | RT                          |  |                                      |                                       |                                    |                                   | 9   |   |  |  |   |   |   |   |  |  |  |  |                          |  |          |
| 5+225           | 5+431   | LT                          |  |                                      |                                       |                                    |                                   | 9   |   |  |  |   |   |   |   |  |  |  |  |                          |  |          |
| 5+225           | 5+361   | LT                          |  |                                      |                                       |                                    |                                   | 11  |   |  |  |   |   |   |   |  |  |  |  |                          |  |          |
| 5+225           | 5+361   | RT                          |  |                                      |                                       |                                    |                                   | 11  |   |  |  |   |   |   |   |  |  |  |  |                          |  |          |
| 5+225           | 5+375   | N/A                         |  |                                      |                                       |                                    |                                   |   |   |  |  |   |   |   |   |  |  |  |  |                          | 116  |          |
| 5+225           | 5+431   | RT                          |  |                                      | 5+225           | 5+431   | LT                          |  |                                      |                                       |                                    |                                   |   |   |  | 51.5   |   |   |   |   |  |  |  |  |                          |  |          |
| 5+225           | 5+420   | LT                          |  |                                      |                                       |                                    |                                   |   |   |  | 51.5   |   |   |   |   |  |  |  |  |                          |  |          |
| 5+225           | 5+422   | RT                          |  |                                      |                                       |                                    |                                   |   |   |  |  |   | 195.0   |   |   | 195.0  |  |  |  |                          |  |          |
| 5+225           | 5+430   | N/A                         |  |                                      |                                       |                                    |                                   |   |   |  |  |   | 197.0   |   |   | 197.0  |  |  |  |                          |  |          |
| 5+226           | N/A     | RT                          |  |                                      |                                       |                                    |                                   |   |   |  |  |   |   |   |   |  |  |  |  |                          |  | 1.16     |
| 5+230           | N/A     | RT                          |  |                                      |                                       |                                    |                                   |   |   |  |  |   |   |   |   |  |  |  |  |                          |  | 1.16     |
| 5+232           | 5+236   | CL                          |  |                                      |                                       |                                    |                                   |   |   |  |  |   |   |   |   | 5.4  |  |  |  |                          | 5.4  |          |
| 5+236           | 5+361   | RT                          |  |                                      | 5+236           | 5+361   | LT                          |  |                                      |                                       |                                    |                                   |   |   |  |  |   | 155.4   |   |   | 155.4  |  |  |  |                          |  |          |
| 5+250           | N/A     | LT                          |  |                                      |                                       |                                    |                                   |   |   |  |  |   |   |   |   |  |  |  |  |                          |  | 1.16     |
| 5+250           | 6+785   | N/A                         |  |                                      | 5+264           | N/A     | LT                          |  |                                      | 80216                                 |                                    | 12590                             |   |   |  |  |   |   |   |   |  |  |  |  |                          |  | 1.16     |
| 5+270           | N/A     | CL                          |  |                                      | 5+281           | N/A     | CL                          |  |                                      | 5+318           | N/A     | RT                          |  |                                      |                                       |                                    |                                   |   |   |  |  |   |   |   |   |  |  |  |  |                          |  | 1.16     |
| 5+322           | N/A     | RT                          |  |                                      |                                       |                                    |                                   |   |   |  |  |   |   |   |   |  |  |  |  |                          |  | 1.16     |
| 5+331           | N/A     | CL                          |  |                                      |                                       |                                    |                                   |   |   |  |  |   |   |   |   |  |  |  |  |                          |  | 1.16     |
| 5+338           | N/A     | LT                          |  |                                      |                                       |                                    |                                   |   |   |  |  |   |   |   |   |  |  |  |  |                          |  | 1.16     |
| 5+342           | N/A     | LT                          |  |                                      |                                       |                                    |                                   |   |   |  |  |   |   |   |   |  |  |  |  |                          |  | 1.16     |
| 5+342           | N/A     | CL                          |  |                                      |                                       |                                    |                                   |   |   |  |  |   |   |   |   |  |  |  |  |                          |  | 1.16     |
| 5+361           | 5+391   | LT                          |  |                                      |                                       |                                    |                                   | 3   |   |  |  |   |   |   |   |  |  |  |  |                          |  |          |
| 5+361           | 5+391   | RT                          |  |                                      |                                       |                                    |                                   | 3   |   |  |  |   |   |   |   |  |  |  |  |                          |  |          |
| 5+361           | 5+426   | CL                          |  |                                      |                                       |                                    |                                   |   |   |  |  |   |   | 184.4   |   | 184.4  |  |  |  |                          |  |          |
| 5+375           | 5+530   | N/A                         |  |                                      | 5+390           | 5+575   | N/A                         |  | 137                                  | 2008                                  |                                    |                                   |   |   |  |  |   |   |   |   |  |  |  |  |                          |  | 31       |
| 5+391           | 5+426   | RT                          |  |                                      |                                       |                                    |                                   | 3   |   |  |  |   |   |   | 35.0  |  |  |  |  |                          |  |          |
| 5+391           | 5+426   | LT                          |  |                                      |                                       |                                    |                                   | 6   |   |  |  |   |   |   |   |  |  |  |  |                          |  |          |
| 5+392           | N/A     | CL                          |  |                                      | 5+410           | N/A     | RT                          |  |                                      |                                       |                                    |                                   |   |   |  |  |   |   |   |   |  |  |  |  |                          |  | 1.16     |
| 5+414           | N/A     | RT                          |  |                                      |                                       |                                    |                                   |   |   |  |  |   |   |   |   |  |  |  |  |                          |  | 1.16     |
| 5+418           | N/A     | LT                          |  |                                      |                                       |                                    |                                   |   |   |  |  |   |   |   |   |  |  |  |  |                          |  | 1.16     |
| 5+418           | N/A     | CL                          |  |                                      |                                       |                                    |                                   |   |   |  |  |   |   |   |   |  |  |  |  |                          |  | 1.16     |
| 5+420           | N/A     | LT                          |  |                                      |                                       |                                    |                                   |   |   |  |  |   |   |   |   |  |  |  |  |                          |  | 1.16     |
| 5+424           | 5+451   | LT                          |  |                                      | 5+427           | 5+453   | RT                          |  |                                      | 5+427           | 5+448   | LT                          |  |                                      | 5+430           | 5+450   | RT                          |  |                                      | 5+440           | 5+448   | RT                          |  |                                      | 5+449           | 5+540   | RT                          |  |                                      | 5+449           | 5+540   | LT                          |  |                                      | 5+450           | 5+541   | LT                          |  |                                      | 5+450           | 5+541   | RT                          |  |                                      |                                       |                                    |                                   |   |   |  | 22.0   |   | 113.8   |   |   |  |  |  |  |                          | 113.8                                      |          |
| 5+452           | 5+542   | N/A                         |  |                                      |                                       |                                    |                                   |   |   |  | 22.0   |   | 113.8   |   |   |  |  |  |  |                          | 113.8                                      |          |

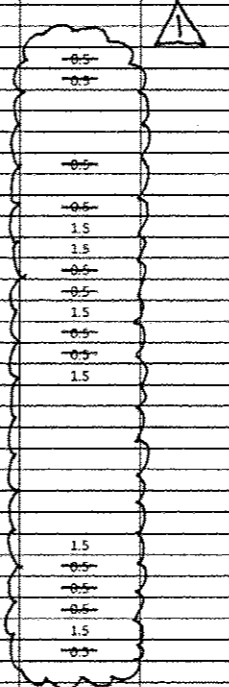

△ REV. 10/31/13

\* - THE PAY ITEM FOR PAINT PAVEMENT MARKING - LETTERS & SYMBOLS IS USED FOR BIKE LANE SYMBOLOGY.

| REVISIONS |      |
|-----------|------|
| NAME      | DATE |
|           |      |
|           |      |
ILLINOIS DEPARTMENT OF TRANSPORTATION  
 SCHEDULE OF QUANTITIES  
 F.A.P. ROUTE 668 (DIRKSEN PARKWAY)  
 SECTION 28R-1  
 SANGAMON COUNTY

SCALE: NONE DRAWN BY: RC  
 DATE: 6/2013 CHECKED BY: FML

|                     |         |                           |              |           |
|---------------------|---------|---------------------------|--------------|-----------|
| F.A.P. RTE          | SECTION | COUNTY                    | TOTAL SHEETS | SHEET NO. |
| 668                 | 28R-1   | SANGAMON                  | 354          | 34        |
| STA. TO STA.        |         | ILLINOIS FED. AID PROJECT |              |           |
| FED. ROAD DIST. NO. |         | CONTRACT NO. 72501        |              |           |

PAVEMENT MARKING SCHEDULE

| LOCATION        |         |     | SHORT TERM PAVEMENT MARKING | TEMPORARY PAVEMENT MARKING LETTERS AND SYMBOLS | TEMPORARY PAVEMENT MARKING - LINE 5" | TEMPORARY PAVEMENT MARKING - LINE 24" | WORK ZONE PAVEMENT MARKING REMOVAL | RAISED REFLECTIVE PAVEMENT MARKER | RAISED REFLECTIVE PAVEMENT MARKER REMOVAL | PREFORMED PLASTIC PAVEMENT MARKING, TYPE B - INLAID - LETTERS AND SYMBOLS | PREFORMED PLASTIC PAVEMENT MARKING, TYPE B - INLAID - LINE 125MM | PREFORMED PLASTIC PAVEMENT MARKING, TYPE B - INLAID - LINE 600MM | MODIFIED URETHANE PAVEMENT MARKING - LINE 125MM | MODIFIED URETHANE PAVEMENT MARKING - LINE 150MM | MODIFIED URETHANE PAVEMENT MARKING - LINE 200MM | MODIFIED URETHANE PAVEMENT MARKING - LINE 300MM | GROOVING FOR RECESSED PAVEMENT MARKING 152MM | GROOVING FOR RECESSED PAVEMENT MARKING 178MM | GROOVING FOR RECESSED PAVEMENT MARKING 229MM | GROOVING FOR RECESSED PAVEMENT MARKING 330MM | PAVEMENT MARKING REMOVAL | PAINT PAVEMENT MARKING - LETTERS & SYMBOLS |
|-----------------|---------|-----|-----------------------------|--|--------------------------------------|---------------------------------------|------------------------------------|-----------------------------------|---|---|--|--|---|---|---|---|--|--|--|--|--------------------------|--|
| DIRKSEN PARKWAY |         |     | 70300100                    | 70300210                                       | 70300230                             | 70300280                              | 70301000                           | 78100100                          | 78300200                                  | M7800350  | M7800360   | M7800390   | M7809125  | M7809150  | M7809200  | M7809300  | MX783072                                     | MX783074                                     | MX783076                                     | MX783078                                     | M7830100                 | M7800200                                   |
| STATION         | STATION | O/S | FOOT                        | SQ. FT   | FOOT                                 | FOOT                                  | SQ. FT                             | EACH                              | EACH                                      | SQ. M   | METER  | METER  | METER   | METER   | METER   | METER   | METER  | METER  | METER  | METER  | SQ. M                    | SO. M                                      |
| 5+455           | 5+535   | LT  |                             |  |                                      |                                       |                                    |                                   |   | 0.5   |  |  |   |   |   |   |  |  |  |  |                          | 1.16                                       |
| 5+456           | N/A     | LT  |                             |  |                                      |                                       |                                    |                                   |   | 1.5   |  |  |   |   |   |   |  |  |  |  |                          |  |
| 5+457           | N/A     | CL  |                             |  | 5+458           | 5+536   | RT  |                             |  |                                      |                                       |                                    |                                   |   |   |  |  | 78.0  |   |   |   | 78.0   |  |  |  |                          |  |
| 5+458           | N/A     | RT  |                             |  |                                      |                                       |                                    |                                   |   | 0.5   |  |  |   |   |   |   |  |  |  |  |                          | 1.16                                       |
| 5+459           | N/A     | LT  |                             |  |                                      |                                       |                                    |                                   |   | 0.5   |  |  |   |   |   |   |  |  |  |  |                          | 1.16                                       |
| 5+462           | N/A     | RT  |                             |  |                                      |                                       |                                    |                                   |   | 0.5   |  |  |   |   |   |   |  |  |  |  |                          | 1.16                                       |
| 5+468           | N/A     | CL  |                             |  |                                      |                                       |                                    |                                   |   | 1.5   |  |  |   |   |   |   |  |  |  |  |                          |  |
| 5+523           | N/A     | CL  |                             |  |                                      |                                       |                                    |                                   |   | 1.5   |  |  |   |   |   |   |  |  |  |  |                          |  |
| 5+530           | 5+705   | N/A |                             |  |                                      |                                       |                                    |                                   |   |   |  |  |   |   |   |   |  |  |  |  | 35                       | 1.16                                       |
| 5+532           | N/A     | LT  |                             |  |                                      |                                       |                                    |                                   |   | 0.5   |  |  |   |   |   |   |  |  |  |  |                          | 1.16                                       |
| 5+533           | N/A     | RT  |                             |  |                                      |                                       |                                    |                                   |   | 0.5   |  |  |   |   |   |   |  |  |  |  |                          | 1.16                                       |
| 5+534           | N/A     | CL  |                             |  |                                      |                                       |                                    |                                   |   | 1.5   |  |  |   |   |   |   |  |  |  |  |                          | 1.16                                       |
| 5+536           | N/A     | LT  |                             |  |                                      |                                       |                                    |                                   |   | 0.5   |  |  |   |   |   |   |  |  |  |  |                          | 1.16                                       |
| 5+537           | N/A     | RT  |                             |  |                                      |                                       |                                    |                                   |   | 0.5   |  |  |   |   |   |   |  |  |  |  |                          | 1.16                                       |
| 5+540           | 5+565   | LT  |                             |  |                                      |                                       |                                    |                                   |   |   |  |  |   | 25.0  |   |   |  |  |  |  |                          |  |
| 5+541           | 5+566   | RT  |                             |  |                                      |                                       |                                    |                                   |   |   |  |  |   | 25.0  |   |   |  |  |  |  |                          |  |
| 5+543           | 5+563   | LT  |                             |  |                                      |                                       |                                    |                                   |   |   |  |  |   | 19.8  |   |   |  |  |  |  |                          |  |
| 5+544           | 5+563   | RT  |                             |  |                                      |                                       |                                    |                                   |   |   |  |  |   | 19.7  |   |   |  |  |  |  |                          |  |
| 5+553           | 5+562   | RT  |                             |  |                                      | 29                                    |                                    |                                   |   |   |  |  |   |   |   |   |  |  |  |  |                          |  |
| 5+565           | 5+918   | N/A |                             |  |                                      |                                       |                                    |                                   | 76  |   |  |  |   |   |   |   |  |  |  |  |                          |  |
| 5+566           | 5+910   | RT  |                             |  |                                      |                                       |                                    | 14                                |   |   |  |  |   |   |   |   |  |  |  |  |                          |  |
| 5+566           | 5+910   | LT  |                             |  |                                      |                                       |                                    | 14                                |   |   |  |  |   |   |   |   |  |  |  |  |                          |  |
| 5+566           | 5+616   | LT  |                             |  |                                      |                                       |                                    | 9                                 |   |   |  |  |   |   |   |   |  |  |  |  |                          |  |
| 5+566           | 5+616   | RT  |                             |  |                                      |                                       |                                    | 10                                |   |   |  |  |   |   |   |   |  |  |  |  |                          |  |
| 5+566           | 5+575   | RT  |                             |  |                                      |                                       |                                    |                                   |   |   | 86.1   |  |   |   |   |   |  |  |  |  |                          |  |
| 5+566           | 5+575   | LT  |                             |  |                                      |                                       |                                    |                                   |   |   | 86.0   |  |   |   |   |   |  |  |  |  |                          |  |
| 5+571           | 5+575   | LT  |                             |  |                                      |                                       |                                    |                                   |   |   |  |  |   |   | 4.5   |   |  |  |  |  |                          |  |
| 5+571           | 5+575   | RT  |                             |  |                                      |                                       |                                    |                                   |   |   |  |  |   | 4.0   |   |   |  |  |  |  |                          |  |
| 5+571           | N/A     | RT  |                             |  |                                      |                                       |                                    |                                   |   |   |  |  |   |   |   |   |  |  |  |  |                          | 1.16                                       |
| 5+573           | N/A     | CL  |                             |  | 5+575           | 5+750   | N/A |                             | 159  |                                      | 2587                                  |                                    |                                   |   |   |  |  |   |   |   |   |  |  |  |  |                          | 1.16                                       |
| 5+575           | N/A     | RT  |                             |  | 5+575           | 5+652   | CL  |                             |  |                                      |                                       |                                    |                                   |   |   |  |  |   |   | 218.7   |   |  |  |  |  |                          |  |
| 5+575           | 5+910   | LT  |                             |  |                                      |                                       |                                    |                                   |   |   |  |  |   |   | 335.0   |   |  |  |  |  |                          |  |
| 5+575           | 5+910   | RT  |                             |  |                                      |                                       |                                    |                                   |   |   |  |  |   |   | 335.0   |   |  |  |  |  |                          |  |
| 5+575           | 5+616   | LT  |                             |  |                                      |                                       |                                    |                                   |   |   |  |  |   |   |   | 40.5  |  |  |  |  |                          |  |
| 5+611           | N/A     | CL  |                             |  | 5+616           | 5+652   | LT  |                             |  |                                      |                                       |                                    | 3                                 |   |   |  |  |   |   |   |   |  |  |  |  |                          |  |
| 5+616           | 5+652   | RT  |                             |  |                                      |                                       |                                    | 3                                 |   |   |  |  |   |   |   |   |  |  |  |  |                          |  |
| 5+647           | N/A     | LT  |                             |  |                                      |                                       |                                    |                                   |   |   |  |  |   |   |   |   |  |  |  |  |                          | 1.16                                       |
| 5+651           | N/A     | LT  |                             |  |                                      |                                       |                                    |                                   |   |   |  |  |   |   |   |   |  |  |  |  |                          | 1.16                                       |
| 5+652           | 5+821   | LT  |                             |  |                                      |                                       |                                    | 13                                |   |   |  |  |   |   |   |   |  |  |  |  |                          |  |
| 5+652           | 5+821   | RT  |                             |  |                                      |                                       |                                    | 13                                |   |   |  |  |   |   | 211.6   |   |  |  |  |  |                          |  |
| 5+653           | N/A     | CL  |                             |  |                                      |                                       |                                    |                                   |   |   |  |  |   |   |   |   |  |  |  |  |                          | 1.16                                       |
| 5+662           | N/A     | RT  |                             |  | 5+664           | N/A     | CL  |                             |  |                                      |                                       |                                    |                                   |   |   |  |  |   |   |   |   |  |  |  |  |                          | 1.16                                       |
| 5+666           | N/A     | RT  |                             |  | 5+705           | 5+880   | N/A |                             |  |                                      |                                       |                                    |                                   |   |   |  |  |   |   |   |   |  |  |  |  |                          | 35   |
| 5+724           | N/A     | LT  |                             |  |                                      |                                       |                                    |                                   |   |   |  |  |   |   |   |   |  |  |  |  |                          | 1.16                                       |
| 5+728           | N/A     | LT  |                             |  |                                      |                                       |                                    |                                   |   |   |  |  |   |   |   |   |  |  |  |  |                          | 1.16                                       |
| 5+734           | N/A     | CL  |                             |  | 5+745           | N/A     | CL  |                             |  | 5+750           | 5+910   | N/A |                             | 174  |                                      | 2362                                  |                                    |                                   |   |   |  |  |   |   |   |   |  |  |  |  |                          | 1.16                                       |
| 5+755           | N/A     | RT  |                             |  |                                      |                                       |                                    |                                   |   |   |  |  |   |   |   |   |  |  |  |  |                          | 1.16                                       |
| 5+759           | N/A     | RT  |                             |  


10/31/13 REV.

\* - THE PAY ITEM FOR PAINT PAVEMENT MARKING - LETTERS & SYMBOLS IS USED FOR BIKE LANE SYMBOLOGY.

| REVISIONS |      |
|-----------|------|
| NAME      | DATE |
|           |      |
|           |      |
ILLINOIS DEPARTMENT OF TRANSPORTATION  
 SCHEDULE OF QUANTITIES  
 F.A.P. ROUTE 668 (DIRKSEN PARKWAY)  
 SECTION 28R-1  
 SANGAMON COUNTY  
 SCALE: NONE  
 DATE: 6/2013  
 DRAWN BY: RC  
 CHECKED BY: FML

|                       |         |                           |                  |           |
|-----------------------|---------|---------------------------|------------------|-----------|
| F.A.P. RTE            | SECTION | COUNTY                    | TOTAL SHEETS NO. | SHEET NO. |
| 668                   | 28R-1   | SANGAMON                  | 354              | 35        |
| STA. TO STA.          |         | ILLINOIS FED. AID PROJECT |                  |           |
| FED. ROAD DIST. NO. - |         | CONTRACT NO. 72501        |                  |           |

| PAVEMENT MARKING SCHEDULE |         |     |---------------------------|---------|-----|-----------------------------|--|--------------------------------------|---------------------------------------|------------------------------------|-----------------------------------|---|---|--|--|---|---|---|---|--|--|--|--|--------------------------|--|--------|
| LOCATION                  |         |     | SHORT TERM PAVEMENT MARKING | TEMPORARY PAVEMENT MARKING LETTERS AND SYMBOLS | TEMPORARY PAVEMENT MARKING - LINE 5" | TEMPORARY PAVEMENT MARKING - LINE 24" | WORK ZONE PAVEMENT MARKING REMOVAL | RAISED REFLECTIVE PAVEMENT MARKER | RAISED REFLECTIVE PAVEMENT MARKER REMOVAL | PREFORMED PLASTIC PAVEMENT MARKING, TYPE B - INLAID - LETTERS AND SYMBOLS | PREFORMED PLASTIC PAVEMENT MARKING, TYPE B - INLAID - LINE 125MM | PREFORMED PLASTIC PAVEMENT MARKING, TYPE B - INLAID - LINE 600MM | MODIFIED URETHANE PAVEMENT MARKING - LINE 125MM | MODIFIED URETHANE PAVEMENT MARKING - LINE 150MM | MODIFIED URETHANE PAVEMENT MARKING - LINE 200MM | MODIFIED URETHANE PAVEMENT MARKING - LINE 300MM | GROOVING FOR RECESSED PAVEMENT MARKING 152MM | GROOVING FOR RECESSED PAVEMENT MARKING 178MM | GROOVING FOR RECESSED PAVEMENT MARKING 229MM | GROOVING FOR RECESSED PAVEMENT MARKING 330MM | PAVEMENT MARKING REMOVAL | PAINT PAVEMENT MARKING - LETTERS & SYMBOLS |        |
| DIRKSEN PARKWAY           |         |     | 70300100                    | 70300210                                       | 70300230                             | 70300280                              | 70301000                           | 78100100                          | 78300200                                  | M7800350  | M7800360   | M7800390   | M7809125  | M7809150  | M7809200  | M7809300  | MX783072                                     | MX783074                                     | MX783076                                     | MX783078                                     | M7830100                 | M7800200                                   |        |
| STATION                   | STATION | Q/S | FOOT                        | SQ. FT.  | FOOT                                 | FOOT                                  | SQ. FT.                            | EACH                              | EACH                                      | SQ. M.  | METER  | METER  | METER   | METER   | METER   | METER   | METER  | METER  | METER  | METER  | METER                    | SQ. M.                                     | SQ. M. |
| 5+809                     | N/A     | CL  |                             |  |                                      |                                       |                                    |                                   |   | 1.5   |  |  |   |   |   |   |  |  |  |  |                          |  |        |
| 5+816                     | N/A     | LT  |                             |  |                                      |                                       |                                    |                                   |   | 0.5   |  |  |   |   |   |   |  |  |  |  |                          |  | 1.16   |
| 5+819                     | N/A     | CL  |                             |  |                                      |                                       |                                    |                                   |   | 1.5   |  |  |   |   |   |   |  |  |  |  |                          |  |        |
| 5+820                     | N/A     | LT  |                             |  |                                      |                                       |                                    |                                   |   | 0.5   |  |  |   |   |   |   |  |  |  |  |                          |  | 1.16   |
| 5+821                     | 5+857   | LT  |                             |  |                                      |                                       |                                    | 3                                 |   |   |  |  |   |   |   |   |  |  |  |  |                          |  |        |
| 5+821                     | 5+857   | RT  |                             |  |                                      |                                       |                                    | 3                                 |   |   |  |  |   |   |   |   |  |  |  |  |                          |  |        |
| 5+821                     | 5+907   | CL  |                             |  |                                      |                                       |                                    |                                   |   |   |  |  | 23.2  | 8.6   |   |   | 23.2   | 8.6  |  |  |                          |  |        |
| 5+848                     | N/A     | RT  |                             |  |                                      |                                       |                                    |                                   |   | 0.5   |  |  |   |   |   |   |  |  |  |  |                          |  | 1.16   |
| 5+851                     | N/A     | RT  |                             |  |                                      |                                       |                                    |                                   |   | 0.5   |  |  |   |   |   |   |  |  |  |  |                          |  | 1.16   |
| 5+857                     | 5+907   | LT  |                             |  |                                      |                                       |                                    | 10                                |   |   |  |  |   |   |   |   |  |  |  |  |                          |  |        |
| 5+857                     | 5+913   | RT  |                             |  |                                      |                                       |                                    | 5                                 |   |   |  |  |   | 53.2  |   |   | 53.2   |  |  |  |                          |  |        |
| 5+861                     | N/A     | CL  |                             |  |                                      |                                       |                                    |                                   |   | 1.5   |  |  |   |   |   |   |  |  |  |  |                          |  |        |
| 5+880                     | 6+055   | N/A |                             |  |                                      |                                       |                                    |                                   |   |   |  |  |   |   |   |   |  |  |  |  |                          | 36   |        |
| 5+901                     | N/A     | CL  |                             |  |                                      |                                       |                                    |                                   |   | 1.5   |  |  |   |   |   |   |  |  |  |  |                          |  |        |
| 5+907                     | N/A     | CL  |                             |  |                                      |                                       |                                    |                                   |   |   |  | 3.6  |   |   |   |   |  |  |  |  |                          |  |        |
| 5+908                     | N/A     | LT  |                             |  |                                      |                                       |                                    |                                   |   | 0.5   |  |  |   |   |   |   |  |  |  |  |                          |  | 1.16   |
| 5+910                     | 6+085   | N/A |                             | 143  | 2274                                 |                                       |                                    |                                   |   | 0.5   |  |  |   |   |   |   |  |  |  |  |                          |  | 1.16   |
| 5+910                     | N/A     | RT  |                             |  |                                      |                                       |                                    |                                   |   | 0.5   |  |  |   |   |   |   |  |  |  |  |                          |  | 1.16   |
| 5+910                     | 5+912   | LT  |                             |  |                                      |                                       |                                    |                                   |   |   |  |  | 2.0   |   |   |   | 2.0  |  |  |  |                          |  |        |
| 5+910                     | 5+913   | RT  |                             |  |                                      |                                       |                                    |                                   |   |   |  |  | 3.0   | 3.0   |   |   | 3.0  | 3.0  |  |  |                          |  |        |
| 5+912                     | N/A     | LT  |                             |  |                                      |                                       |                                    |                                   |   | 0.5   |  |  |   |   |   |   |  |  |  |  |                          |  | 1.16   |
| 5+913                     | N/A     | RT  |                             |  |                                      |                                       |                                    |                                   |   | 0.5   |  |  | 8.3   |   |   |   |  |  |  |  |                          |  | 1.16   |
| 5+914                     | 5+914   | N/A |                             |  |                                      |                                       |                                    |                                   |   |   |  |  |   |   | 20.7  |   |  | 20.7   |  |  |                          |  |        |
| 5+916                     | 5+916   | N/A |                             |  |                                      |                                       |                                    |                                   |   |   |  |  |   |   | 21.9  |   |  | 21.9   |  |  |                          |  |        |
| 5+918                     | 5+941   | LT  |                             |  |                                      |                                       |                                    |                                   |   |   |  |  |   |   | 23.0  |   |  | 23.0   |  |  |                          |  |        |
| 5+918                     | 5+941   | RT  |                             |  |                                      |                                       |                                    |                                   |   |   |  |  |   |   | 22.8  |   |  | 22.8   |  |  |                          |  |        |
| 5+920                     | 5+938   | LT  |                             |  |                                      |                                       |                                    |                                   |   |   |  |  |   |   | 18.5  |   |  | 18.5   |  |  |                          |  |        |
| 5+920                     | 5+939   | RT  |                             |  |                                      |                                       |                                    |                                   |   |   |  |  |   |   | 18.5  |   |  | 18.5   |  |  |                          |  |        |
| 5+930                     | 5+938   | RT  |                             |  |                                      | 29                                    |                                    |                                   |   |   |  |  |   |   |   |   |  |  |  |  |                          |  |        |
| 5+941                     | 6+234   | N/A |                             |  | 5+943                     | 5+943   | N/A |                             |  |                                      |                                       |                                    |                                   | 52  |   |  |  |   |   |   |   |  |  |  |  |                          |  |        |
| 5+945                     | 5+945   | N/A |                             |  |                                      |                                       |                                    |                                   |   |   |  |  |   |   | 21.5  |   |  | 21.5   |  |  |                          |  |        |
| 5+946                     | 6+002   | LT  |                             |  |                                      |                                       |                                    | 5                                 |   |   |  |  |   |   | 20.5  |   |  | 20.5   |  |  |                          |  |        |
| 5+947                     | 6+263   | LT  |                             |  |                                      |                                       |                                    | 13                                |   |   |  |  |   |   | 55.9  |   |  | 55.9   |  |  |                          |  |        |
| 5+947                     | 6+230   | RT  |                             |  |                                      |                                       |                                    | 12                                |   |   | 70.8   |  |   |   |   |   |  |  |  |  |                          |  |        |
| 5+947                     | 6+226   | RT  |                             |  |                                      |                                       |                                    |                                   |   |   |  |  |   |   | 279.3   |   |  | 279.3  |  |  |                          |  |        |
| 5+947                     | N/A     | RT  |                             |  |                                      |                                       |                                    |                                   |   | 0.5   |  |  |   |   |   |   |  |  |  |  |                          |  | 1.16   |
| 5+948                     | N/A     | LT  |                             |  |                                      |                                       |                                    |                                   |   |   |  |  | 8.3   |   |   |   |  |  |  |  |                          |  |        |
| 5+950                     | 6+263   | LT  |                             |  |                                      |                                       |                                    |                                   |   |   | 78.4   |  |   |   |   |   |  |  |  |  |                          |  |        |
| 5+951                     | N/A     | RT  |                             |  |                                      |                                       |                                    |                                   |   | 0.5   |  |  |   |   |   |   |  |  |  |  |                          |  | 1.16   |
| 5+952                     | 6+002   | RT  |                             |  |                                      |                                       |                                    | 10                                |   |   |  |  |   |   |   |   |  |  |  |  |                          |  |        |
| 5+952                     | N/A     | C/L |                             |  | 5+952                     | 6+030   | CL  |                             |  |                                      |                                       |                                    |                                   |   |   |  |  |   |   | 207.9   |   |  | 207.9  |  |  |                          |  |        |
| 5+958                     | N/A     | LT  |                             |  |                                      |                                       |                                    |                                   |   | 0.5   |  |  |   |   |   |   |  |  |  |  |                          |  | 1.16   |
| 5+960                     | N/A     | CL  |                             |  |                                      |                                       |                                    |                                   |   | 1.5   |  |  |   |   |   |   |  |  |  |  |                          |  |        |
| 5+962                     | N/A     | LT  |                             |  |                                      |                                       |                                    |                                   |   | 0.5   |  |  |   |   |   |   |  |  |  |  |                          |  | 1.16   |
| 5+997                     | N/A     | CL  |                             |  |                                      |                                       |                                    |                                   |   | 1.5   |  |  |   |   |   |   |  |  |  |  |                          |  |        |
| 6+002                     | 6+030   | LT  |                             |  |                                      |                                       |                                    | 2                                 |   |   |  |  |   |   | 6.7   |   |  | 6.7  |  |  |                          |  |        |
| 6+002                     | 6+030   | RT  |                             |  |                                      |                                       |                                    | 2                                 |   |   |  |  |   |   |   |   |  |  |  |  |                          |  |        |
| 6+030                     | 6+231   | LT  |                             |  |                                      |                                       |                                    | 17                                |   |   |  |  |   |   | 254.3   |   |  | 254.3  |  |  |                          |  |        |
| 6+030                     | 6+231   | RT  |                             |  |                                      |                                       |                                    | 17                                |   |   |  |  |   |   | 254.3   |   |  | 254.3  |  |  |                          |  |        |
| 6+032                     | N/A     | CL  |                             |  |                                      |                                       |                                    |                                   |   | 1.5   |  |  |   |   |   |   |  |  |  |  |                          |  |        |
| 6+039                     | N/A     | RT  |                             |  |                                      |                                       |                                    |                                   |   | 0.5   |  |  |   |   |   |   |  |  |  |  |                          |  | 1.16   |
| 6+042                     | N/A     | CL  |                             |  |                                      |                                       |                                    |                                   |   | 1.5   |  |  |   |   |   |   |  |  |  |  |                          |  |        |
| 6+043                     | N/A     | RT  |                             |  |                                      |                                       |                                    |                                   |   | 0.5   |  |  |   |   |   |   |  |  |  |  |                          |  | 1.16   |
| 6+055                     | 6+230   | N/A |                             |  |                                      |                                       |                                    |                                   |   |   |  |  |   |   |   |   |  |  |  |  |                          | 35   |        |

1

REV. 10/31/13

• - THE PAY ITEM FOR PAINT PAVEMENT MARKING - LETTERS & SYMBOLS IS USED FOR BIKE LANE SYMBOLOLOGY.

| REVISIONS | NAME | DATE |
|-----------|------|------|
|           |      |      |
|           |      |      |
ILLINOIS DEPARTMENT OF TRANSPORTATION  
 SCHEDULE OF QUANTITIES  
 F.A.P. ROUTE 668 (DIRKSEN PARKWAY)  
 SECTION 28R-1  
 SANGAMON COUNTY

SCALE: NONE  
 DATE: 6/2013  
 DRAWN BY: RC  
 CHECKED BY: FML

| PAVEMENT MARKING SCHEDULE |         |     |---------------------------|---------|-----|-----------------------------|--|--------------------------------------|---------------------------------------|------------------------------------|-----------------------------------|---|---|--|--|---|---|---|---|--|--|--|--|--------------------------|--|------|
| LOCATION                  |         |     | SHORT TERM PAVEMENT MARKING | TEMPORARY PAVEMENT MARKING LETTERS AND SYMBOLS | TEMPORARY PAVEMENT MARKING - LINE 5" | TEMPORARY PAVEMENT MARKING - LINE 24" | WORK ZONE PAVEMENT MARKING REMOVAL | RAISED REFLECTIVE PAVEMENT MARKER | RAISED REFLECTIVE PAVEMENT MARKER REMOVAL | PREFORMED PLASTIC PAVEMENT MARKING, TYPE B - INLAID - LETTERS AND SYMBOLS | PREFORMED PLASTIC PAVEMENT MARKING, TYPE B - INLAID - LINE 125MM | PREFORMED PLASTIC PAVEMENT MARKING, TYPE B - INLAID - LINE 600MM | MODIFIED URETHANE PAVEMENT MARKING - LINE 125MM | MODIFIED URETHANE PAVEMENT MARKING - LINE 150MM | MODIFIED URETHANE PAVEMENT MARKING - LINE 200MM | MODIFIED URETHANE PAVEMENT MARKING - LINE 300MM | GROOVING FOR RECESSED PAVEMENT MARKING 152MM | GROOVING FOR RECESSED PAVEMENT MARKING 178MM | GROOVING FOR RECESSED PAVEMENT MARKING 229MM | GROOVING FOR RECESSED PAVEMENT MARKING 330MM | PAVEMENT MARKING REMOVAL | PAINT PAVEMENT MARKING - LETTERS & SYMBOLS |      |
| DIRKSEN PARKWAY           |         |     | 70300100                    | 70300210                                       | 70300230                             | 70300280                              | 70301000                           | 78100100                          | 78300200                                  | M7800350  | M7800360   | M7800390   | M7809125  | M7809150  | M7809200  | M7809300  | MX783072                                     | MX783074                                     | MX783076                                     | MX783078                                     | M7830100                 | M7800200                                   |      |
| STATION                   | STATION | O/S | FOOT                        | SQ FT  | FOOT                                 | FOOT                                  | SQ.FT                              | EACH                              | EACH                                      | SQ.M  | METER  | METER  | METER   | METER   | METER   | METER   | METER  | METER  | METER  | METER  | METER                    | SQ.M                                       | SQ.M |
| 6+085                     | 6+263   | N/A |                             | 143  | 2200                                 |                                       |                                    |                                   |   | 1.5   |  |  |   |   |   |   |  |  |  |  |                          |  |      |
| 6+090                     | N/A     | CL  |                             |  |                                      |                                       |                                    |                                   |   | 1.5   |  |  |   |   |   |   |  |  |  |  |                          |  |      |
| 6+100                     | N/A     | CL  |                             |  |                                      |                                       |                                    |                                   |   | 1.5   |  |  |   |   |   |   |  |  |  |  |                          |  |      |
| 6+129                     | N/A     | RT  |                             |  |                                      |                                       |                                    |                                   |   | 1.16  |  |  |   |   |   |   |  |  |  |  |                          |  |      |
| 6+129                     | N/A     | LT  |                             |  |                                      |                                       |                                    |                                   |   | 1.16  |  |  |   |   |   |   |  |  |  |  |                          |  |      |
| 6+133                     | N/A     | RT  |                             |  |                                      |                                       |                                    |                                   |   | 1.16  |  |  |   |   |   |   |  |  |  |  |                          |  |      |
| 6+133                     | N/A     | LT  |                             |  |                                      |                                       |                                    |                                   |   | 1.16  |  |  |   |   |   |   |  |  |  |  |                          |  |      |
| 6+150                     | N/A     | CL  |                             |  |                                      |                                       |                                    |                                   |   | 1.5   |  |  |   |   |   |   |  |  |  |  |                          |  |      |
| 6+162                     | N/A     | CL  |                             |  |                                      |                                       |                                    |                                   |   | 1.5   |  |  |   |   |   |   |  |  |  |  |                          |  |      |
| 6+220                     | N/A     | RT  |                             |  |                                      |                                       |                                    |                                   |   | 1.16  |  |  |   |   |   |   |  |  |  |  |                          |  |      |
| 6+220                     | N/A     | LT  |                             |  |                                      |                                       |                                    |                                   |   | 1.16  |  |  |   |   |   |   |  |  |  |  |                          |  |      |
| 6+224                     | N/A     | RT  |                             |  |                                      |                                       |                                    |                                   |   | 1.16  |  |  |   |   |   |   |  |  |  |  |                          |  |      |
| 6+224                     | N/A     | LT  |                             |  |                                      |                                       |                                    |                                   |   | 1.16  |  |  |   |   |   |   |  |  |  |  |                          |  |      |
| 6+231                     | 6+257   | RT  |                             |  |                                      |                                       |                                    |                                   |   | 1.16  |  |  |   |   |   |   |  |  |  |  |                          |  |      |
| 6+234                     | 6+254   | RT  |                             |  |                                      |                                       |                                    |                                   |   | 1.16  |  |  |   |   |   |   |  |  |  |  |                          |  |      |
| 6+243                     | 6+252   | RT  |                             |  |                                      | 29                                    |                                    |                                   |   | 1.16  |  |  |   |   |   |   |  |  |  |  |                          |  |      |
| 6+255                     | 6+541   | N/A |                             |  |                                      |                                       |                                    |                                   | 58  |   |  |  |   |   |   |   |  |  |  |  |                          |  |      |
| 6+256                     | 6+291   | LT  |                             |  |                                      |                                       |                                    | 3                                 |   |   |  |  |   |   |   |   |  |  |  |  |                          |  |      |
| 6+256                     | 6+291   | RT  |                             |  |                                      |                                       |                                    | 6                                 |   |   |  |  |   |   |   |   |  |  |  |  |                          |  |      |
| 6+256                     | 6+263   | CL  |                             |  |                                      |                                       |                                    |                                   |   |   |  |  | 14.7  |   |   |   | 14.7   |  |  |  |                          |  |      |
| 6+256                     | 6+263   | LT  |                             |  |                                      |                                       |                                    |                                   |   |   |  |  | 42.4  |   |   |   | 42.4   |  |  |  |                          |  |      |
| 6+256                     | 6+538   | RT  |                             |  |                                      |                                       |                                    |                                   |   |   | 70.7   |  |   |   |   |   |  |  |  |  |                          |  |      |
| 6+256                     | N/A     | LT  |                             |  |                                      |                                       |                                    |                                   |   | 1.16  |  |  |   |   |   |   |  |  |  |  |                          |  |      |
| 6+260                     | N/A     | LT  |                             |  |                                      |                                       |                                    |                                   |   | 1.16  |  |  |   |   |   |   |  |  |  |  |                          |  |      |
| 6+261                     | 6+263   | RT  |                             |  |                                      |                                       |                                    |                                   |   |   |  |  | 2.0   |   |   |   | 2.0  |  |  |  |                          |  |      |
| 6+262                     | N/A     | RT  |                             |  |                                      |                                       |                                    |                                   |   | 1.16  |  |  |   |   |   |   |  |  |  |  |                          |  |      |
| 6+263                     | 6+438   | N/A |                             | 143  | 2583                                 |                                       |                                    |                                   |   | 1.16  |  |  |   |   |   |   |  |  |  |  |                          |  |      |
| 6+263                     | 6+620   | LT  |                             |  |                                      |                                       |                                    | 14                                |   |   | 89.3   |  | 357.0   |   |   |   | 357.0  |  |  |  |                          |  |      |
| 6+263                     | 6+539   | RT  |                             |  |                                      |                                       |                                    | 11                                |   |   |  |  | 270.6   |   |   |   | 270.6  |  |  |  |                          |  |      |
| 6+263                     | 6+327   | CL  |                             |  |                                      |                                       |                                    |                                   |   |   |  |  | 193.0   |   |   |   | 193.0  |  |  |  |                          |  |      |
| 6+263                     | 6+291   | LT  |                             |  |                                      |                                       |                                    |                                   |   |   |  |  | 27.6  |   |   |   | 27.6   |  |  |  |                          |  |      |
| 6+264                     | N/A     | CL  |                             |  |                                      |                                       |                                    |                                   |   | 1.5   |  |  |   |   |   |   |  |  |  |  |                          |  |      |
| 6+266                     | N/A     | RT  |                             |  |                                      |                                       |                                    |                                   |   | 1.5   |  |  |   |   |   |   |  |  |  |  |                          |  |      |
| 6+289                     | N/A     | CL  |                             |  |                                      |                                       |                                    |                                   |   | 1.5   |  |  |   |   |   |   |  |  |  |  |                          |  |      |
| 6+291                     | 6+327   | LT  |                             |  |                                      |                                       |                                    | 3                                 |   |   |  |  | 8.6   |   |   |   | 8.6  |  |  |  |                          |  |      |
| 6+291                     | 6+327   | RT  |                             |  |                                      |                                       |                                    | 3                                 |   |   |  |  |   |   |   |   |  |  |  |  |                          |  |      |
| 6+327                     | 6+539   | LT  |                             |  |                                      |                                       |                                    | 18                                |   |   |  |  | 265.2   |   |   |   | 265.2  |  |  |  |                          |  |      |
| 6+327                     | 6+539   | RT  |                             |  |                                      |                                       |                                    | 18                                |   |   |  |  | 265.2   |   |   |   | 265.2  |  |  |  |                          |  |      |
| 6+328                     | N/A     | CL  |                             |  |                                      |                                       |                                    |                                   |   | 1.5   |  |  |   |   |   |   |  |  |  |  |                          |  |      |
| 6+339                     | N/A     | CL  |                             |  |                                      |                                       |                                    |                                   |   | 1.5   |  |  |   |   |   |   |  |  |  |  |                          |  |      |
| 6+347                     | N/A     | LT  |                             |  |                                      |                                       |                                    |                                   |   | 1.16  |  |  |   |   |   |   |  |  |  |  |                          |  |      |
| 6+351                     | N/A     | LT  |                             |  |                                      |                                       |                                    |                                   |   | 1.16  |  |  |   |   |   |   |  |  |  |  |                          |  |      |
| 6+354                     | N/A     | RT  |                             |  |                                      |                                       |                                    |                                   |   | 1.16  |  |  |   |   |   |   |  |  |  |  |                          |  |      |
| 6+358                     | N/A     | RT  |                             |  |                                      |                                       |                                    |                                   |   | 1.16  |  |  |   |   |   |   |  |  |  |  |                          |  |      |
| 6+389                     | N/A     | CL  |                             |  |                                      |                                       |                                    |                                   |   | 1.16  |  |  |   |   |   |   |  |  |  |  |                          |  |      |
| 6+400                     | N/A     | CL  |                             |  |                                      |                                       |                                    |                                   |   | 1.5   |  |  |   |   |   |   |  |  |  |  |                          |  |      |
| 6+405                     | 6+580.0 | N/A |                             |  |                                      |                                       |                                    |                                   |   | 1.5   |  |  |   |   |   |   |  |  |  |  |                          |  |      |
| 6+438                     | 6+615   | N/A |                             | 143  | 2120                                 |                                       |                                    |                                   |   |   |  |  |   |   |   |   |  |  |  |  | 35                       |  |      |
| 6+439                     | N/A     | LT  |                             |  |                                      |                                       |                                    |                                   |   | 1.16  |  |  |   |   |   |   |  |  |  |  |                          |  |      |
| 6+443                     | N/A     | LT  |                             |  |                                      |                                       |                                    |                                   |   | 1.16  |  |  |   |   |   |   |  |  |  |  |                          |  |      |
| 6+446                     | N/A     | RT  |                             |  |                                      |                                       |                                    |                                   |   | 1.16  |  |  |   |   |   |   |  |  |  |  |                          |  |      |
| 6+450                     | N/A     | RT  |                             |  |                                      |                                       |                                    |                                   |   | 1.16  |  |  |   |   |   |   |  |  |  |  |                          |  |      |
| 6+450                     | N/A     | CL  |                             |  |                                      |                                       |                                    |                                   |   | 1.16  |  |  |   |   |   |   |  |  |  |  |                          |  |      |
| 6+461                     | N/A     | CL  |                             |  |                                      |                                       |                                    |                                   |   | 1.5   |  |  |   |   |   |   |  |  |  |  |                          |  |      |
| 6+521                     | N/A     | CL  |                             |  |                                      |                                       |                                    |                                   |   | 3.0   |  |  |   |   |   |   |  |  |  |  |                          |  |      |
| 6+531                     | N/A     | RT  |                             |  |                                      |                                       |                                    |                                   |   | 1.16  |  |  |   |   |   |   |  |  |  |  |                          |  |      |



REV. 10/31/13

\* - THE PAY ITEM FOR PAINT PAVEMENT MARKING - LETTERS & SYMBOLS IS USED FOR BIKE LANE SYMBOLOLOGY.

| REVISIONS |      |
|-----------|------|
| NAME      | DATE |
|           |      |
|           |      |
ILLINOIS DEPARTMENT OF TRANSPORTATION  
 SCHEDULE OF QUANTITIES  
 F.A.P. ROUTE 668 (DIRKSEN PARKWAY)  
 SECTION 28R-1  
 SANGAMON COUNTY  
 SCALE: NONE  
 DATE: 6/2013  
 DRAWN BY: RC  
 CHECKED BY: FML

| LOCATION        |         |      | PAVEMENT MARKING SCHEDULE   |  |                                      |-----------------|---------|------|-----------------------------|--|--------------------------------------|---------------------------------------|------------------------------------|-----------------------------------|---|---|--|--|---|---|---|---|--|--|--|--|--------------------------|--|-------|
| STATION         | STATION | O/S  | SHORT TERM PAVEMENT MARKING | TEMPORARY PAVEMENT MARKING LETTERS AND SYMBOLS | TEMPORARY PAVEMENT MARKING - LINE 5" | TEMPORARY PAVEMENT MARKING - LINE 24" | WORK ZONE PAVEMENT MARKING REMOVAL | RAISED REFLECTIVE PAVEMENT MARKER | RAISED REFLECTIVE PAVEMENT MARKER REMOVAL | PREFORMED PLASTIC PAVEMENT MARKING, TYPE B - INLAID - LETTERS AND SYMBOLS | PREFORMED PLASTIC PAVEMENT MARKING, TYPE B - INLAID - LINE 125MM | PREFORMED PLASTIC PAVEMENT MARKING, TYPE B - INLAID - LINE 600MM | MODIFIED URETHANE PAVEMENT MARKING - LINE 125MM | MODIFIED URETHANE PAVEMENT MARKING - LINE 150MM | MODIFIED URETHANE PAVEMENT MARKING - LINE 200MM | MODIFIED URETHANE PAVEMENT MARKING - LINE 300MM | GROOVING FOR RECESSED PAVEMENT MARKING 152MM | GROOVING FOR RECESSED PAVEMENT MARKING 178MM | GROOVING FOR RECESSED PAVEMENT MARKING 229MM | GROOVING FOR RECESSED PAVEMENT MARKING 330MM | PAVEMENT MARKING REMOVAL | PAINT PAVEMENT MARKING - LETTERS & SYMBOLS |       |
| FOOT            | FOOT    | FOOT | FOOT                        | SQ. FT   | FOOT                                 | FOOT                                  | SQ. FT                             | EACH                              | EACH                                      | SQ. M   | METER  | METER  | METER   | METER   | METER   | METER   | METER  | METER  | METER  | METER  | METER                    | SQ. M                                      | SQ. M |
| DIRKSEN PARKWAY |         |      | 70300100                    | 70300210                                       | 70300230                             | 70300280                              | 70301000                           | 78100100                          | 78300200                                  | M7800350  | M7800360   | M7800390   | M7809125  | M7809150  | M7809200  | M7809300  | MX783072                                     | MX783074                                     | MX783076                                     | MX783078                                     | M7830100                 | M7800200                                   |       |
| 6+531           | N/A     | LT   |                             |  1.16  |
| 6+532           | N/A     | CL   |                             |  | 6+534           | N/A     | RT   |                             |  1.16  |
| 6+535           | N/A     | LT   |                             |  1.16  |
| 6+538           | 6+564   | RT   |                             |  |                                      |                                       |                                    |                                   |   |   |  |  |   | 25.2  |   |   |  | 25.2   |  |  |                          |  |       |
| 6+541           | 6+561   | RT   |                             |  |                                      |                                       |                                    |                                   |   |   |  |  |   | 19.9  |   |   |  | 19.9   |  |  |                          |  |       |
| 6+551           | 6+560   | RT   |                             |  |                                      | 29                                    |                                    |                                   |   |   |  |  |   |   |   |   |  |  |  |  |                          |  |       |
| 6+563           | 6+620   | CL   |                             |  |                                      |                                       |                                    |                                   |   |   |  |  |   | 154.4   |   |   |  | 154.4  |  |  |                          |  |       |
| 6+563           | 6+598   | LT   |                             |  |                                      |                                       |                                    |                                   |   |   |  |  |   | 55.9  |   |   |  | 55.9   |  |  |                          |  |       |
| 6+563           | 6+598   | CL   |                             |  |                                      |                                       |                                    | 3                                 |   |   |  |  |   |   |   |   |  |  |  |  |                          |  |       |
| 6+563           | 6+598   | RT   |                             |  |                                      |                                       |                                    | 6                                 |   |   |  |  |   |   |   |   |  |  |  |  |                          |  |       |
| 6+563           | 6+840   | N/A  |                             |  |                                      |                                       |                                    |                                   | 30  |   |  |  |   |   |   |   |  |  |  |  |                          |  |       |
| 6+568           | 6+782   | RT   |                             |  |                                      |                                       |                                    | 9                                 |   |   |  |  |   |   |   |   |  |  |  |  |                          |  |       |
| 6+568           | N/A     | LT   |                             |  1.16  |
| 6+569           | 6+620   | RT   |                             |  |                                      |                                       |                                    |                                   |   |   |  |  | 12.8  |   |   |   |  |  |  |  |                          |  |       |
| 6+569           | N/A     | RT   |                             |  |                                      |                                       |                                    |                                   |   |   |  |  |   | 51.3  |   |   |  |  |  |  |                          |  | 1.16  |
| 6+571           | N/A     | CL   |                             |  1.16  |
| 6+572           | N/A     | LT   |                             |  1.16  |
| 6+573           | N/A     | RT   |                             |  1.16  |
| 6+580           | 6+755.0 | N/A  |                             |  |                                      |                                       |                                    |                                   |   |   |  |  |   |   |   |   |  |  |  |  |                          | 35   |       |
| 6+596           | N/A     | CL   |                             |  | 6+598           | 6+628   | RT   |                             |  |                                      |                                       |                                    | 3                                 |   |   |  |  |   |   |   |   |  |  |  |  |                          |  |       |
| 6+598           | 6+628   | LT   |                             |  |                                      |                                       |                                    | 3                                 |   |   |  |  |   | 7.2   |   |   |  | 7.2  |  |  |                          |  |       |
| 6+615           | 6+785   | N/A  |                             | 335  | 2320                                 |                                       |                                    |                                   |   |   |  |  |   |   |   |   |  |  |  |  |                          |  |       |
| 6+620           | 6+783   | LT   |                             |  |                                      |                                       |                                    | 7                                 |   |   |  |  | 40.6  |   |   |   |  |  |  |  |                          |  |       |
| 6+620           | 6+781   | RT   |                             |  |                                      |                                       |                                    |                                   |   |   |  |  | 40.3  |   |   |   |  |  |  |  |                          |  |       |
| 6+620           | 6+628   | CL   |                             |  |                                      |                                       |                                    |                                   |   |   |  |  |   | 162.0   |   |   |  | 162.0  |  |  |                          |  |       |
| 6+620           | 6+757   | LT   |                             |  |                                      |                                       |                                    |                                   |   |   |  |  |   | 30.4  |   |   |  | 30.4   |  |  |                          |  |       |
| 6+628           | 6+693   | LT   |                             |  |                                      |                                       |                                    |                                   |   |   |  |  |   | 137.3   |   |   |  | 137.3  |  |  |                          |  |       |
| 6+628           | 6+693   | RT   |                             |  |                                      |                                       |                                    | 5                                 |   |   |  |  |   | 81.2  |   |   |  | 81.2   |  |  |                          |  |       |
| 6+628           | 6+693   | CL   |                             |  |                                      |                                       |                                    | 5                                 |   |   |  |  |   | 81.2  |   |   |  | 81.2   |  |  |                          |  |       |
| 6+659           | N/A     | CL   |                             |  1.16  |
| 6+660           | N/A     | LT   |                             |  1.16  |
| 6+661           | N/A     | RT   |                             |  1.16  |
| 6+663           | N/A     | LT   |                             |  1.16  |
| 6+665           | N/A     | RT   |                             |  1.16  |
| 6+670           | N/A     | CL   |                             |  | 6+693           | 6+723   | LT   |                             |  |                                      |                                       |                                    | 6                                 |   |   |  |  |   |   |   |   |  |  |  |  |                          |  |       |
| 6+693           | 6+783   | CL   |                             |  |                                      |                                       |                                    |                                   |   |   |  |  |   | 235.0   |   |   |  | 235.0  |  |  |                          |  |       |
| 6+694           | 6+723   | RT   |                             |  |                                      |                                       |                                    |                                   |   |   |  |  |   | 7.2   |   |   |  | 7.2  |  |  |                          |  |       |
| 6+723           | 6+783   | LT   |                             |  |                                      |                                       |                                    | 10                                |   |   |  |  |   | 9.6   |   |   |  | 9.6  |  |  |                          |  |       |
| 6+723           | 6+782   | RT   |                             |  |                                      |                                       |                                    | 5                                 |   |   |  |  |   | 59.7  |   |   |  | 59.7   |  |  |                          |  |       |
| 6+725           | N/A     | CL   |                             |  | 6+750           | N/A     | CL   |                             |  | 6+752           | N/A     | LT   |                             |  1.16  |
| 6+755           | 6+900.0 | N/A  |                             |  |                                      |                                       |                                    |                                   |   |   |  |  |   |   |   |   |  |  |  |  |                          | 29   |       |
| 6+756           | N/A     | LT   |                             |  1.16  |
| 6+774           | 6+783   | LT   |                             |  |                                      |                                       |                                    |                                   |   |   |  |  |   | 9.3   |   |   |  | 9.3  |  |  |                          |  |       |
| 6+775           | N/A     | CL   |                             |  | 6+776           | 6+789   | LT   |                             |  |                                      |                                       |                                    |                                   |   |   |  |  |   |   | 46.1  | 16.6  |  |  | 46.1   | 16.6   |                          |  |       |
| 6+777           | N/A     | RT   |                             |  1.16  |
| 6+780           | N/A     | RT   |                             |  1.16  |
| 6+782           | N/A     | RT   |                             |  | 6+783           | 6+785   | N/A  |                             |  |                                      |                                       |                                    |                                   |   |   |  |  | 12.0  |   |   |   |  |  |  |  |                          |  |       |
| 6+785           | 6+787   | N/A  |                             |  |                                      |                                       |                                    |                                   |   |   |  |  |   | 19.9  |   |   |  | 19.9   |  |  |                          |  |       |
| 6+785           | 6+787   | N/A  |                             |  |                                      |                                       |                                    |                                   |   |   |  |  |   | 20.3  |   |   |  | 20.3   |  |  |                          |  |       |
| 6+786           | 6+800   | LT   |                             |  |                                      |                                       |                                    |                                   |   |   |  |  |   | 14.7  |   |   |  | 14.7   |  |  |                          |  |       |
| 6+787           | 6+802   | LT   |                             |  |                                      |                                       |                                    |                                   |   |   |  |  |   | 15.4  |   |   |  | 15.4   |  |  |                          |  |       |




REV. 10/31/13

\* - THE PAY ITEM FOR PAINT PAVEMENT MARKING - LETTERS & SYMBOLS IS USED FOR BIKE LANE SYMBOLOLOGY.

| REVISIONS | NAME | DATE |
|-----------|------|------|
|           |      |      |
|           |      |      |
ILLINOIS DEPARTMENT OF TRANSPORTATION  
 SCHEDULE OF QUANTITIES  
 F.A.P. ROUTE 668 (DIRKSEN PARKWAY)  
 SECTION 28R-1  
 SANGAMON COUNTY  
 SCALE: NONE  
 DATE: 6/2013  
 DRAWN BY: RC  
 CHECKED BY: FML

| PAVEMENT MARKING SCHEDULE |             |        |---------------------------|-------------|--------|-----------------------------|--|--------------------------------------|---------------------------------------|------------------------------------|-----------------------------------|---|---|--|--|---|---|---|---|--|--|--|--|--------------------------|--|----|
| LOCATION                  | STATION     | O/S    | SHORT TERM PAVEMENT MARKING | TEMPORARY PAVEMENT MARKING LETTERS AND SYMBOLS | TEMPORARY PAVEMENT MARKING - LINE 5" | TEMPORARY PAVEMENT MARKING - LINE 24" | WORK ZONE PAVEMENT MARKING REMOVAL | RAISED REFLECTIVE PAVEMENT MARKER | RAISED REFLECTIVE PAVEMENT MARKER REMOVAL | PREFORMED PLASTIC PAVEMENT MARKING, TYPE B - INLAID - LETTERS AND SYMBOLS | PREFORMED PLASTIC PAVEMENT MARKING, TYPE B - INLAID - LINE 125MM | PREFORMED PLASTIC PAVEMENT MARKING, TYPE B - INLAID - LINE 600MM | MODIFIED URETHANE PAVEMENT MARKING - LINE 125MM | MODIFIED URETHANE PAVEMENT MARKING - LINE 150MM | MODIFIED URETHANE PAVEMENT MARKING - LINE 200MM | MODIFIED URETHANE PAVEMENT MARKING - LINE 300MM | GROOVING FOR RECESSED PAVEMENT MARKING 152MM | GROOVING FOR RECESSED PAVEMENT MARKING 178MM | GROOVING FOR RECESSED PAVEMENT MARKING 229MM | GROOVING FOR RECESSED PAVEMENT MARKING 330MM | PAVEMENT MARKING REMOVAL | PAINT PAVEMENT MARKING - LETTERS & SYMBOLS |    |
|                           |             |        | FOOT                        | SQ FT  | FOOT                                 | FOOT                                  | SQ FT                              | EACH                              | EACH                                      | SQ M  | METER  | METER  | METER   | METER   | METER   | METER   | METER  | METER  | METER  | METER  | SQ M                     | SQ M                                       |    |
| <b>DIRKSEN PARKWAY</b>    |             |        |                           | 6+795       | 6+818  | RT                          |  |                                      |                           | 6+797       | 6+816  | RT                          |  |                                      |                           | 6+811       | 6+840  | LT                          |  |                                      |                                       |                                    | 1                                 |   |   | 7.0  |  |   |   |   |   |  |  |  |  |                          |  |    |
|                           | 6+811       | 6+840  | CL                          |  |                                      |                                       |                                    | 3                                 |   |   |  |  |   |   | 28.8  |   |  |  |  |  |                          |  |    |
|                           | 6+811       | N/A    | LT                          |  |                                      |                                       |                                    |                                   |   |   |  | 8.4  |   |   |   |   |  |  |  |  |                          |  |    |
|                           | 6+815       | N/A    | RT                          |  |                                      |                                       |                                    |                                   |   |   |  | 3.8  |   |   |   |   |  |  |  |  |                          |  |    |
|                           | 6+815       | 6+840  | RT                          |  |                                      |                                       |                                    | 7                                 |   |   | 6.0  |  |   |   |   |   |  |  |  |  |                          |  |    |
|                           | 6+815       | 6+840  | CL                          |  |                                      |                                       |                                    |                                   |   |   |  |  | 50.0  |   |   |   |  |  | 50.0   |  |                          |  |    |
|                           | 6+823       | N/A    | CL                          |  |                                      |                                       |                                    |                                   |   | 1.5   |  |  |   |   |   |   |  |  |  |  |                          |  |    |
| <b>CARPENTER STREET</b>   |             |        |                           | 0+934       | 0+986  | CL                          |  |                                      |                                       |                                    |                                   |   |   |  |  |   | 105.0   |   |   |  |  | 105.0  |  |                          |  |    |
|                           | 0+986       | N/A    | RT                          |  |                                      |                                       |                                    |                                   |   |   |  | 4.1  |   |   |   |   |  |  |  |  |                          |  |    |
|                           | 1+014       | N/A    | LT                          |  |                                      |                                       |                                    |                                   |   |   |  | 4.3  |   |   |   |   |  |  |  |  |                          |  |    |
|                           | 1+014       | 1+081  | CL                          |  |                                      |                                       |                                    |                                   |   |   |  |  | 134.0   |   |   |   |  |  | 134.0  |  |                          |  |    |
| <b>ENOS AVENUE</b>        |             |        |                           | 0+919       | 0+986  | CL                          |  |                                      |                                       |                                    |                                   |   |   |  |  |   | 133.2   |   |   |  |  | 133.2  |  |                          |  |    |
|                           | 0+986       | N/A    | RT                          |  |                                      |                                       |                                    |                                   |   |   |  | 3.2  |   |   |   |   |  |  |  |  |                          |  |    |
|                           | 1+014       | N/A    | LT                          |  |                                      |                                       |                                    |                                   |   |   |  | 3.0  |   |   |   |   |  |  |  |  |                          |  |    |
|                           | 1+014       | 1+092  | CL                          |  |                                      |                                       |                                    |                                   |   |   |  |  | 155.6   |   |   |   |  |  | 155.6  |  |                          |  |    |
| <b>ELM STREET</b>         |             |        |                           | 0+919       | 0+984  | CL                          |  |                                      |                                       |                                    |                                   |   |   |  |  |   | 130.0   |   |   |  |  | 130.0  |  |                          |  |    |
|                           | 0+984       | N/A    | RT                          |  |                                      |                                       |                                    |                                   |   |   |  | 7.4  |   |   |   |   |  |  |  |  |                          |  |    |
|                           | 1+015       | N/A    | LT                          |  |                                      |                                       |                                    |                                   |   |   |  | 7.7  |   |   |   |   |  |  |  |  |                          |  |    |
|                           | 1+015       | 1+074  | CL                          |  |                                      |                                       |                                    |                                   |   |   |  |  | 118.0   |   |   |   |  |  | 118.0  |  |                          |  |    |
| <b>DIVISION STREET</b>    |             |        |                           | 1+014       | N/A    | LT                          |  |                                      |                                       |                                    |                                   |   |   |  | 8.0  |   |   |   |   |  |  |  |  |                          |  |    |
|                           | 1+014       | 1+055  | CL                          |  |                                      |                                       |                                    |                                   |   |   |  |  | 82.8  |   |   |   |  |  | 82.8   |  |                          |  |    |
| <b>N. GRAND STREET</b>    |             |        |                           | 1+016       | N/A    | LT                          |  |                                      |                                       |                                    |                                   |   |   |  | 7.8  |   |   |   |   |  |  |  |  |                          |  |    |
|                           | 1+016       | 1+059  | CL                          |  |                                      |                                       |                                    |                                   |   |   |  |  | 86.6  |   |   |   |  |  | 86.6   |  |                          |  |    |
| <b>RIDGE AVENUE</b>       |             |        |                           | 0+945       | 0+970  | RT                          |  |                                      |                                       |                                    |                                   |   |   |  |  |   | 25.0  |   |   |  |  | 25.0   |  |                          |  |    |
|                           | 0+945       | 0+982  | CL                          |  |                                      |                                       |                                    |                                   |   |   |  |  | 74.0  |   |   |   |  |  | 74.0   |  |                          |  |    |
|                           | 0+946       | N/A    | RT                          |  |                                      |                                       |                                    |                                   |   | 1.5   |  |  |   |   |   |   |  |  |  |  |                          |  |    |
|                           | 0+946       | N/A    | CL                          |  |                                      |                                       |                                    |                                   |   | 2.5   |  |  |   |   |   |   |  |  |  |  |                          |  |    |
|                           | 0+970       | N/A    | RT                          |  |                                      |                                       |                                    |                                   |   | 1.5   |  |  |   |   |   |   |  |  |  |  |                          |  |    |
|                           | 0+974       | N/A    | RT                          |  |                                      |                                       |                                    |                                   |   |   |  | 6.2  |   |   |   |   |  |  |  |  |                          |  |    |
|                           | 0+975       | N/A    | CL                          |  |                                      |                                       |                                    |                                   |   | 2.5   |  |  |   |   |   |   |  |  |  |  |                          |  |    |
|                           | 0+982       | N/A    | RT                          |  |                                      |                                       |                                    |                                   |   |   |  | 3.6  |   |   |   |   |  |  |  |  |                          |  |    |
|                           | 1+022       | N/A    | LT                          |  |                                      |                                       |                                    |                                   |   |   |  | 9.7  |   |   |   |   |  |  |  |  |                          |  |    |
|                           | 1+022       | 1+050  | LT                          |  |                                      |                                       |                                    |                                   |   |   |  |  |   | 27.4  |   |   |  |  | 27.4   |  |                          |  |    |
|                           | 1+022       | 1+050  | CL                          |  |                                      |                                       |                                    |                                   |   |   |  |  | 27.6  |   |   |   |  |  | 27.6   |  |                          |  |    |
|                           | 1+030       | N/A    | LT                          |  |                                      |                                       |                                    |                                   |   | 1.5   |  |  |   |   |   |   |  |  |  |  |                          |  |    |
|                           | 1+030       | N/A    | CL                          |  |                                      |                                       |                                    |                                   |   | 2.5   |  |  |   |   |   |   |  |  |  |  |                          |  |    |
| <b>CLEARLAKE AVENUE</b>   |             |        |                           | 129+00      | 130+50 | N/A                         |  |                                      | 100                                   |                                    | 42                                |   |   |  |  |   |   |   |   |  |  |  |  |                          |  |    |
|                           | STAGE 2B    |        |                             | 2209   |                                      |                                       |                                    |                                   |   |   |  |  |   |   |   |   |  |  |  |  |                          |  |    |
|                           | STAGE 3A/3B |        |                             | 2798   |                                      |                                       |                                    |                                   |   |   |  |  |   |   |   |   |  |  |  |  |                          |  |    |
|                           | TOTAL       |        |                             | 5007   | 1554                                 | 52302                                 | 145                                | 23407                             | 406                                       | 263   | 124<br>89  | 725  | 113   | 7442  | 1081  | 47  | 32   | 7442   | 1081   | 47   | 32                       | 387  | 93 |

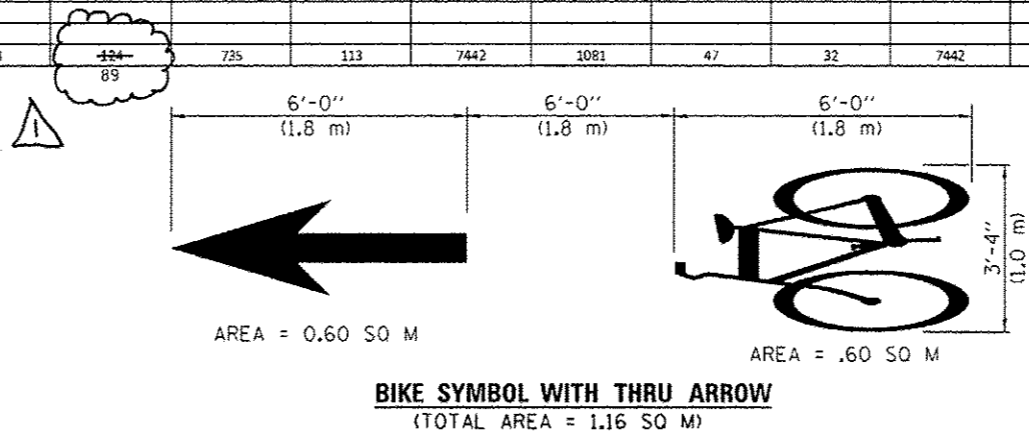

\* - THE PAY ITEM FOR PAINT PAVEMENT MARKING - LETTERS & SYMBOLS IS USED FOR BIKE LANE SYMBOLOGY.

REV. 10/31/13

| REVISIONS | NAME | DATE |
|-----------|------|------|
|           |      |      |
|           |      |      |
ILLINOIS DEPARTMENT OF TRANSPORTATION  
SCHEDULE OF QUANTITIES  
F.A.P. ROUTE 668 (DIRKSEN PARKWAY)  
SECTION 28R-1  
SANGAMON COUNTY

SCALE: NONE  
DATE: 6/2013

DRAWN BY: RC  
CHECKED BY: FML