


F.A.S. RTE.	SECTION	COUNTY	TOTAL SHEETS	SHEET NO.
1279	(P-10)BR	LASALLE	34	22
STA. N/A		TO STA. N/A		
FED. ROAD DIST. NO. 7 ILLINOIS FED. AID PROJECT				

**CONTRACT NO. 66661**

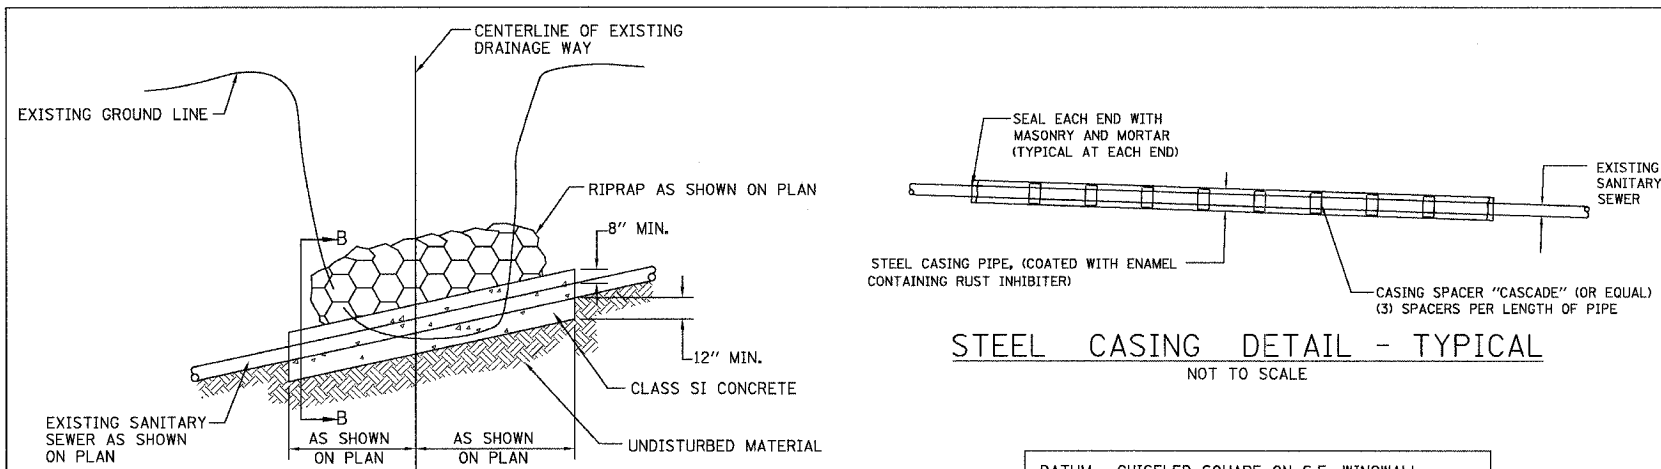


**CONCRETE ENCASEMENT DETAIL**

NOT TO SCALE

**STEEL CASING DETAIL - TYPICAL**

NOT TO SCALE


DATUM: CHISELED SQUARE ON S.E. WINGWALL OF BRIDGE STRUCTURE NO. 050-0085 ELEV.= 504.10 (I.D.O.T. DATUM)

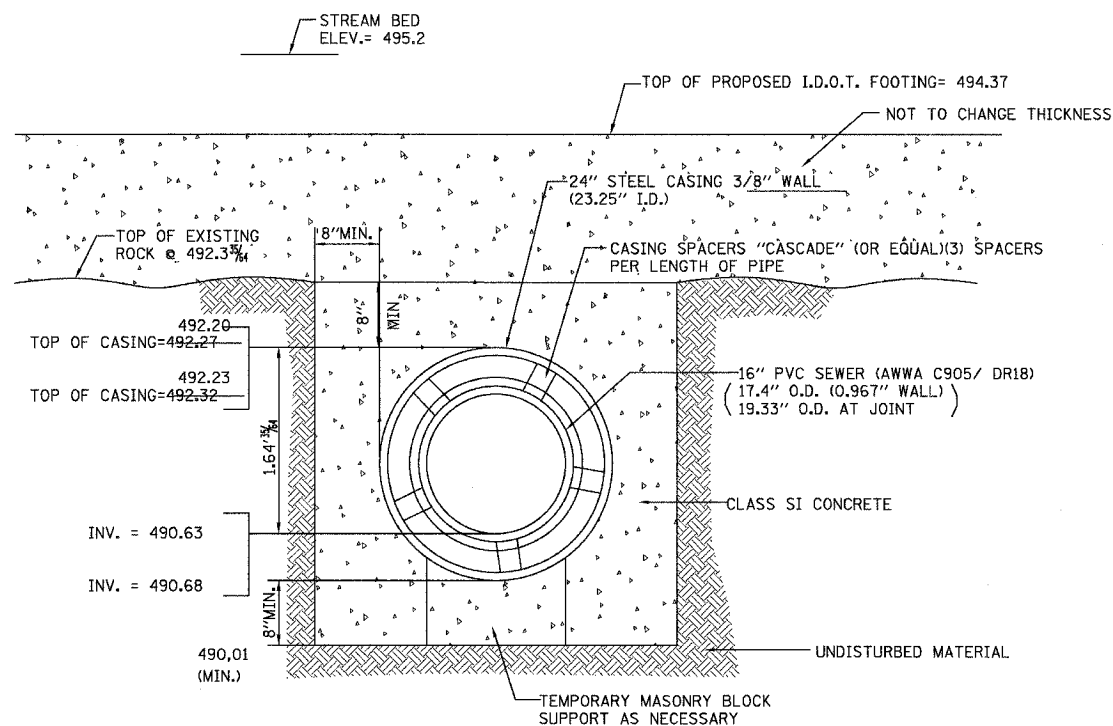

**DETAIL-24\"/>**

NOT TO SCALE


**EXISTING SANITARY SEWER ASBUILTS**

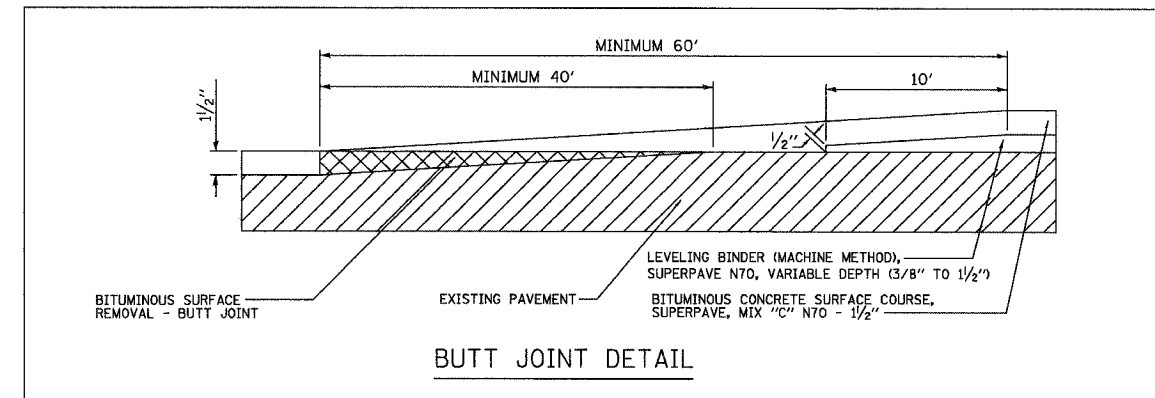

**BUTT JOINT DETAIL**

**NOTES:**

1. REFER TO ARTICLE 406.18 OF THE STANDARD SPECIFICATIONS.
2. THE PAVEMENT SURFACE TO BE REMOVED IN THE DETAIL MAY BE BITUMINOUS OR CONCRETE, REGARDLESS OF THE TYPE OF MATERIAL, THE WORK SHALL BE DONE IN ACCORDANCE WITH ARTICLE 440.03 OF THE STANDARD SPECIFICATIONS.
3. BITUMINOUS SURFACE REMOVAL - BUTT JOINT WILL BE PAID FOR AT THE CONTRACT UNIT PRICE PER SQ. YD. FOR BITUMINOUS SURFACE REMOVAL - BUTT JOINT.

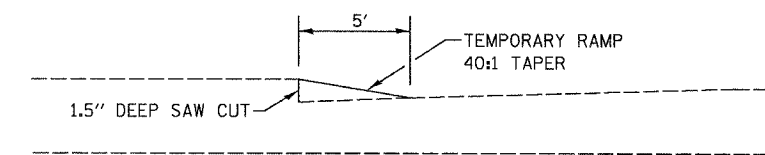

**TEMPORARY RAMP DETAIL**

REVISIONS		ILLINOIS DEPARTMENT OF TRANSPORTATION
NAME	DATE	
		<b>MISC. DETAILS</b>

SCALE: VERT. NONE  
HORIZ. NONE  
DATE: JULY 3, 2006  
DRAWN BY: DAC  
CHECKED BY: SMK