


# AS-BUILT PLANS FOR INFORMATION ONLY

STATE OF ILLINOIS  
DEPARTMENT OF PUBLIC WORKS & BUILDINGS  
DIVISION OF HIGHWAYS

ROUTE NO.	SECTION	COUNTY	TOTAL SHEETS	SHEET NO.
11	38BR-1	VERMILION	116	35
1/3 SHEETS				

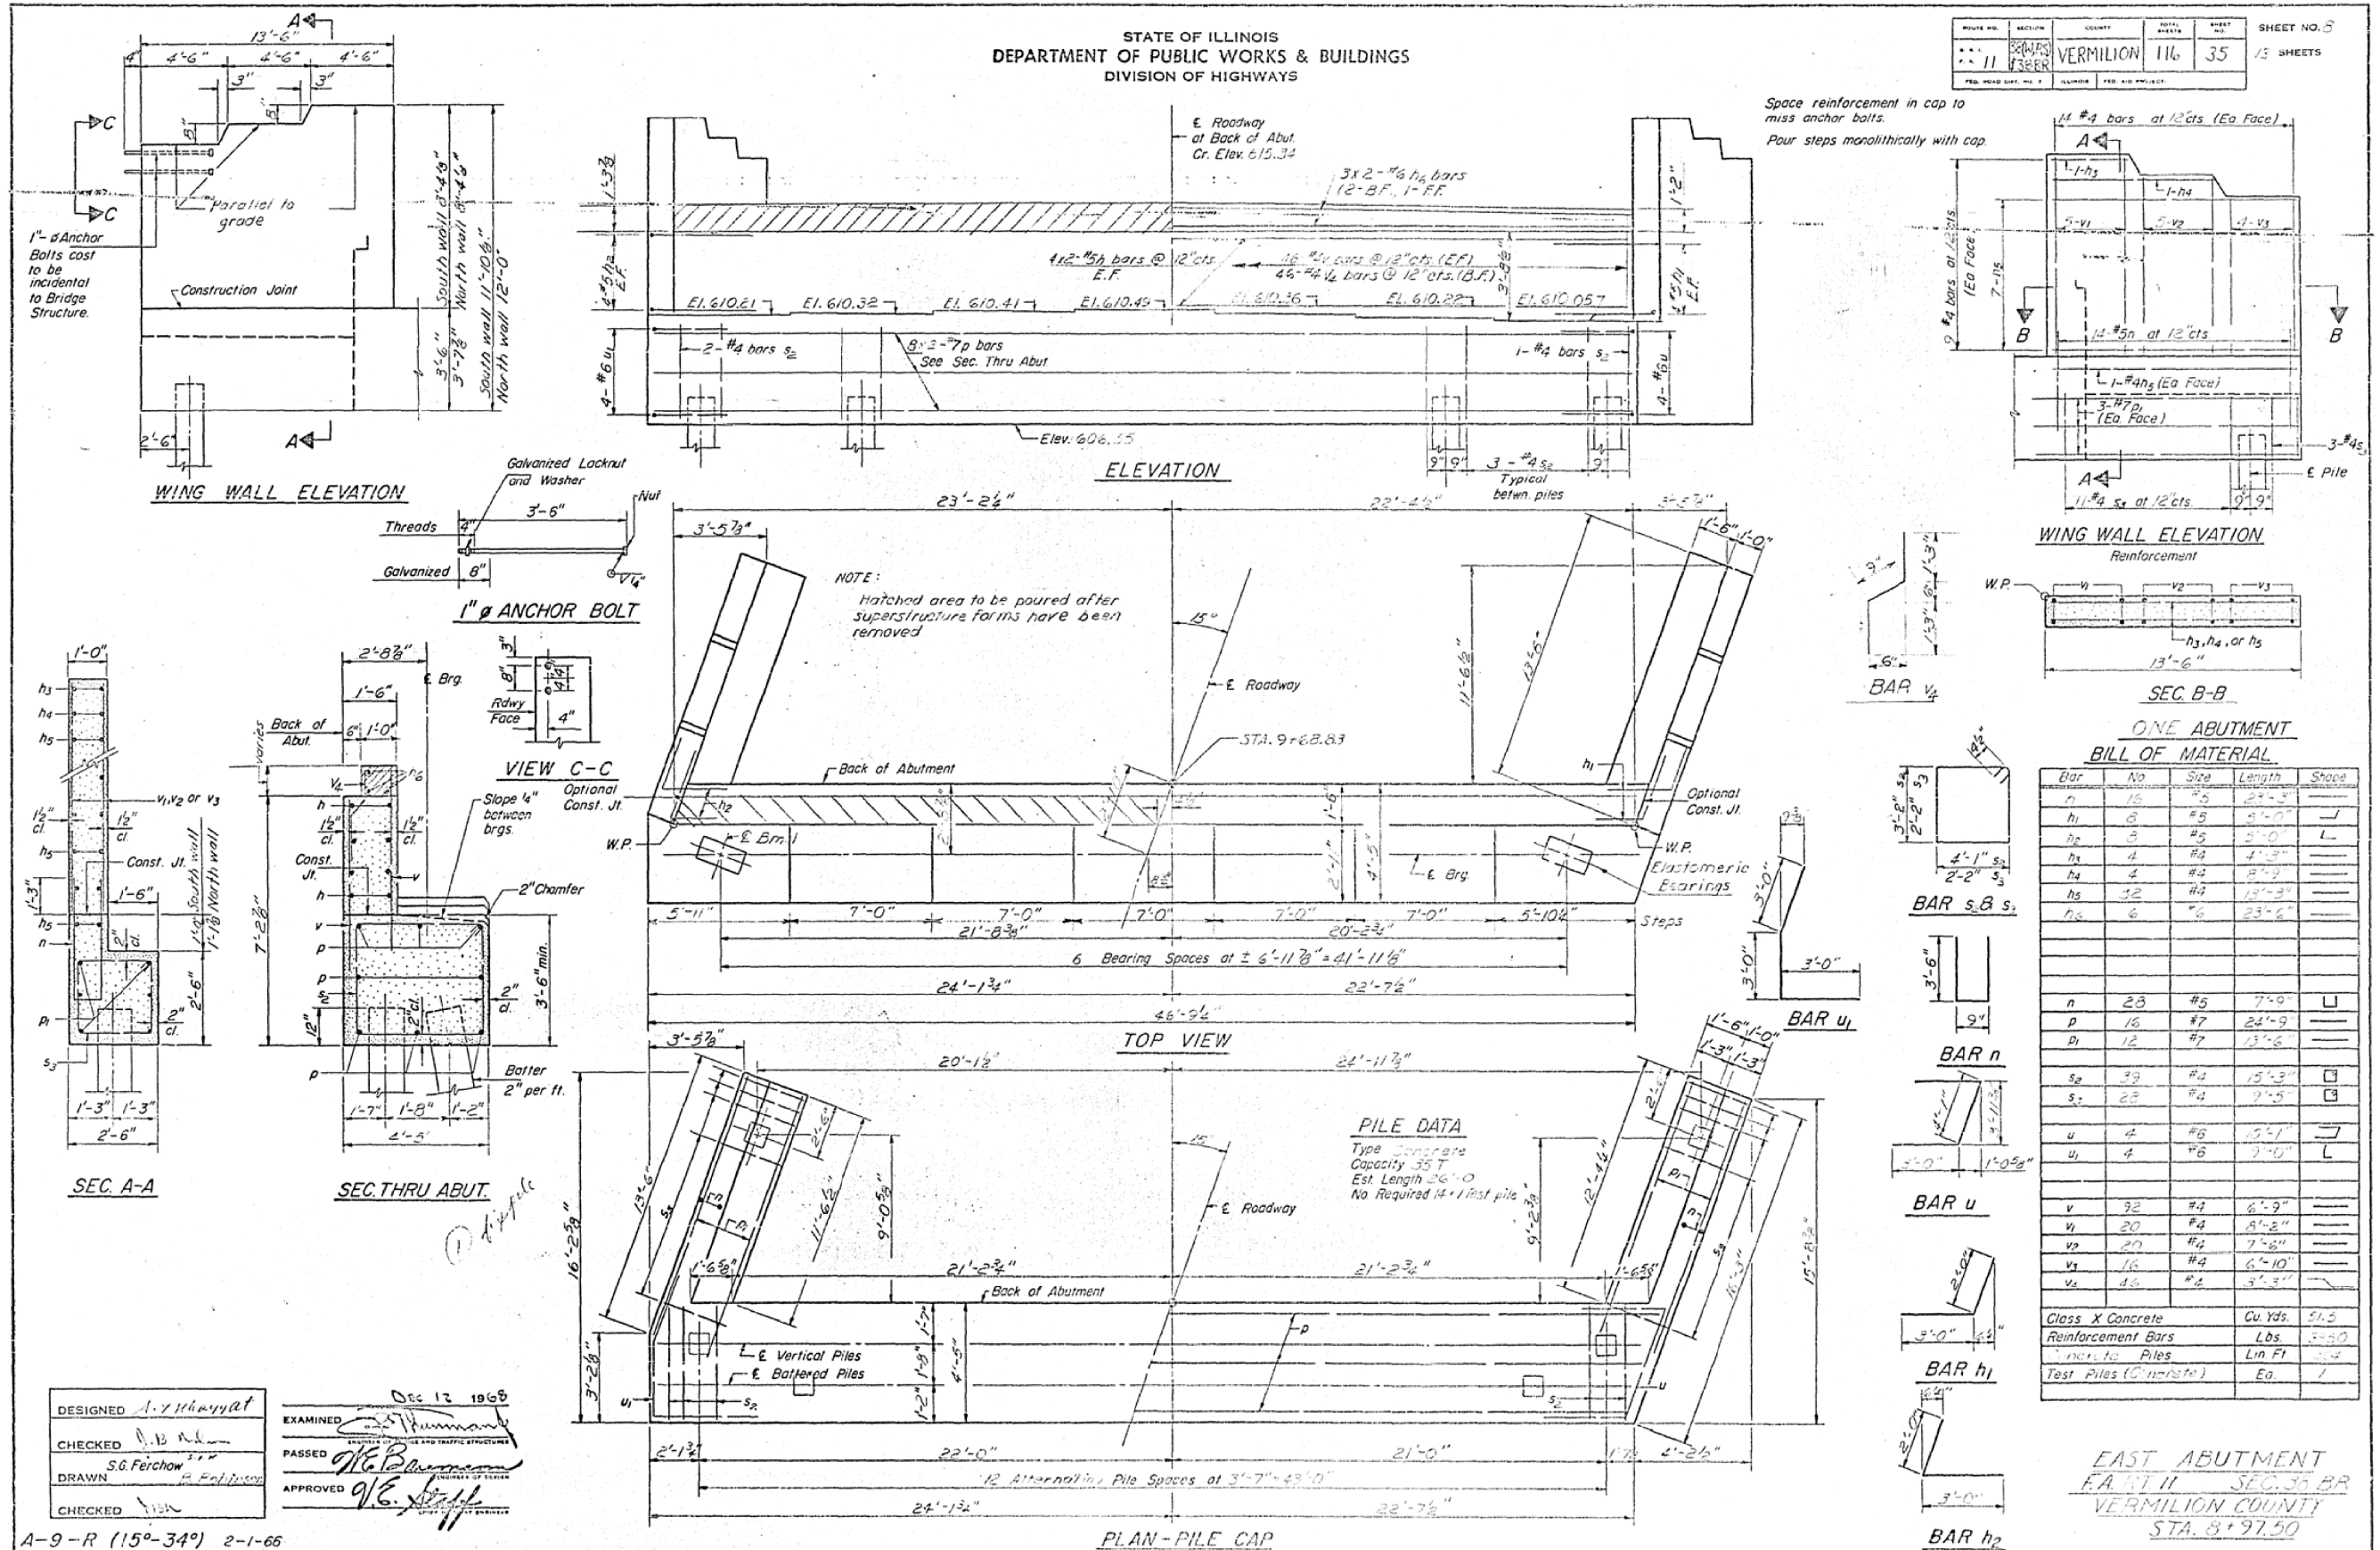

DESIGNED *A. V. Khayat*  
 CHECKED *A. B. Nelson*  
 DRAWN *S. G. Ferchow*  
 EXAMINED *[Signature]*  
 PASSED *[Signature]*  
 APPROVED *[Signature]*

Dec 12 1968

A-9-R (15°-34°) 2-1-66