


FOR INDEX OF SHEETS AND HIGHWAY STANDARDS, SEE SHEET NO. 2

STATE OF ILLINOIS
DEPARTMENT OF TRANSPORTATION
DIVISION OF HIGHWAYS


PLANS FOR PROPOSED
FEDERAL AID HIGHWAY
VILLAGE OF BETHALTO
FAU ROUTE 8959
WEST CORBIN STREET (PHASE 2)
SECTION 05-00016-03-BR
PROJECT NO. HPP-0863 (003)
MADISON COUNTY
C-98-365-06

FAP ROUTE	SECTION	COUNTY	TOTAL SHEETS	SHEET NO.
05-00016-03-BR		MADISON	123	1

FEDERAL AID PROJECT
CONTRACT NUMBER 97351
Revised 1-6-09

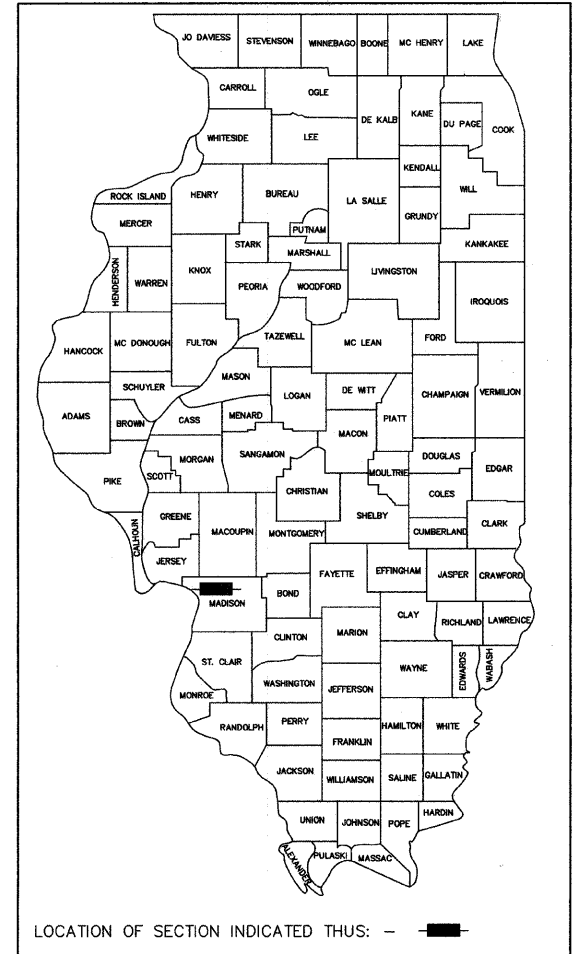

MICROFILMED _____
REEL NUMBER _____
AWARDED _____
RESIDENT ENGINEER _____
AS BUILT CHANGES WERE MADE
ON THE FOLLOWING SHEETS

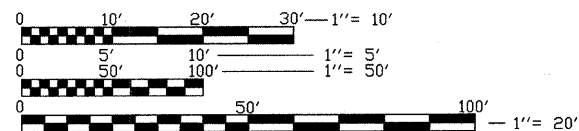


FULL SIZE PLANS HAVE BEEN PREPARED USING STANDARD ENGINEERING SCALES. REDUCED SIZED PLANS WILL NOT CONFORM TO STANDARD SCALES. IN MAKING MEASUREMENTS ON REDUCED PLANS, THE ABOVE SCALES MAY BE USED.

JOINT UTILITY LOCATION INFORMATION FOR EXCAVATION (J.U.L.I.E.)
CALL TOLL FREE 1-800-892-0123

CONTRACT NO. 97351

DESIGN DESIGNATION
FUNCTIONAL CLASSIFICATION = ARTERIAL
DESIGN TRAFFIC = 4800 (2028)
DESIGN SPEED = 35

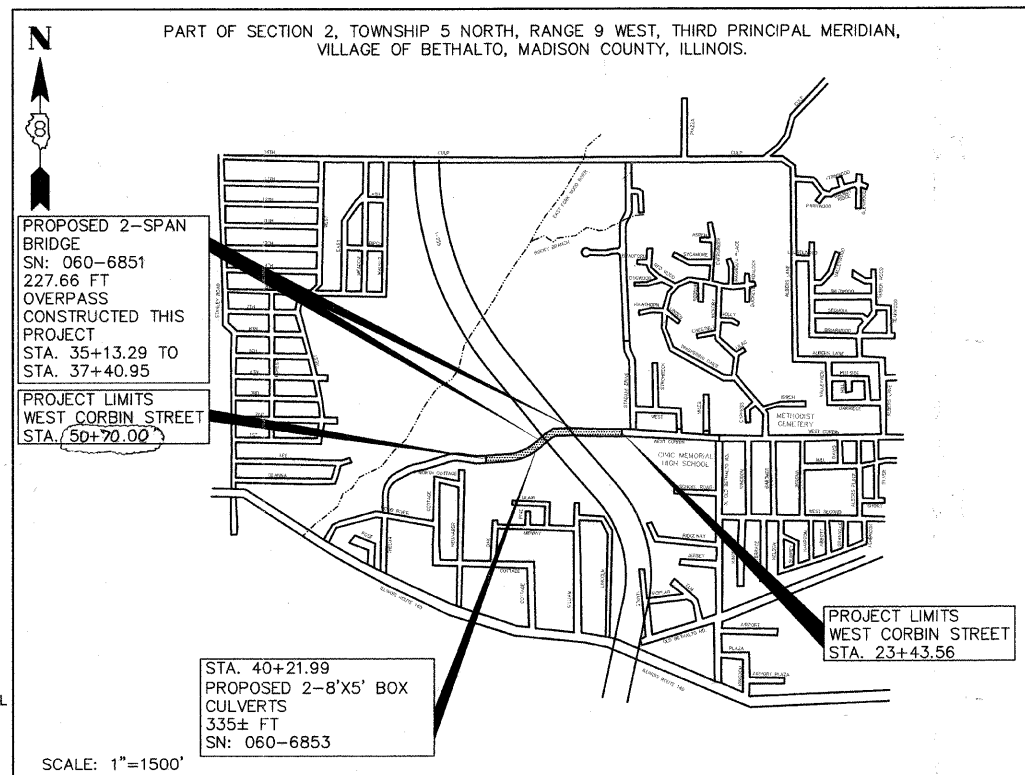

DATE: 9/17/08
LICENSE EXP. 11/30/09

GROSS LENGTH OF PROJECT
WEST CORBIN ST. = 2726.44' (0.520 MI)
NET LENGTH = 2726.44' (0.520 MI)

REVISED 1-6-09

ILLINOIS DEPARTMENT OF TRANSPORTATION

Approved: *Steve A. Bryant*
SEP 17 2008
Steven Bryant, Mayor

Passed: *[Signature]*
District 8 Engineer of Local Roads & Streets

Releasing for Bid Based on Limited Review: *[Signature]*
Deputy Director of Highways, Region #5 Engineer

Hoelscher Engineering, P.C.
11 Executive Drive, Suite 12
Fairview Heights, Illinois 62208
(618)824-8610 FAX: (618)824-8611

PRINTED BY THE AUTHORITY OF THE STATE OF ILLINOIS