


WIRING DIAGRAMS

NOTE ALL LOOP LEAD-IN WIRE IS 2C-NO.14

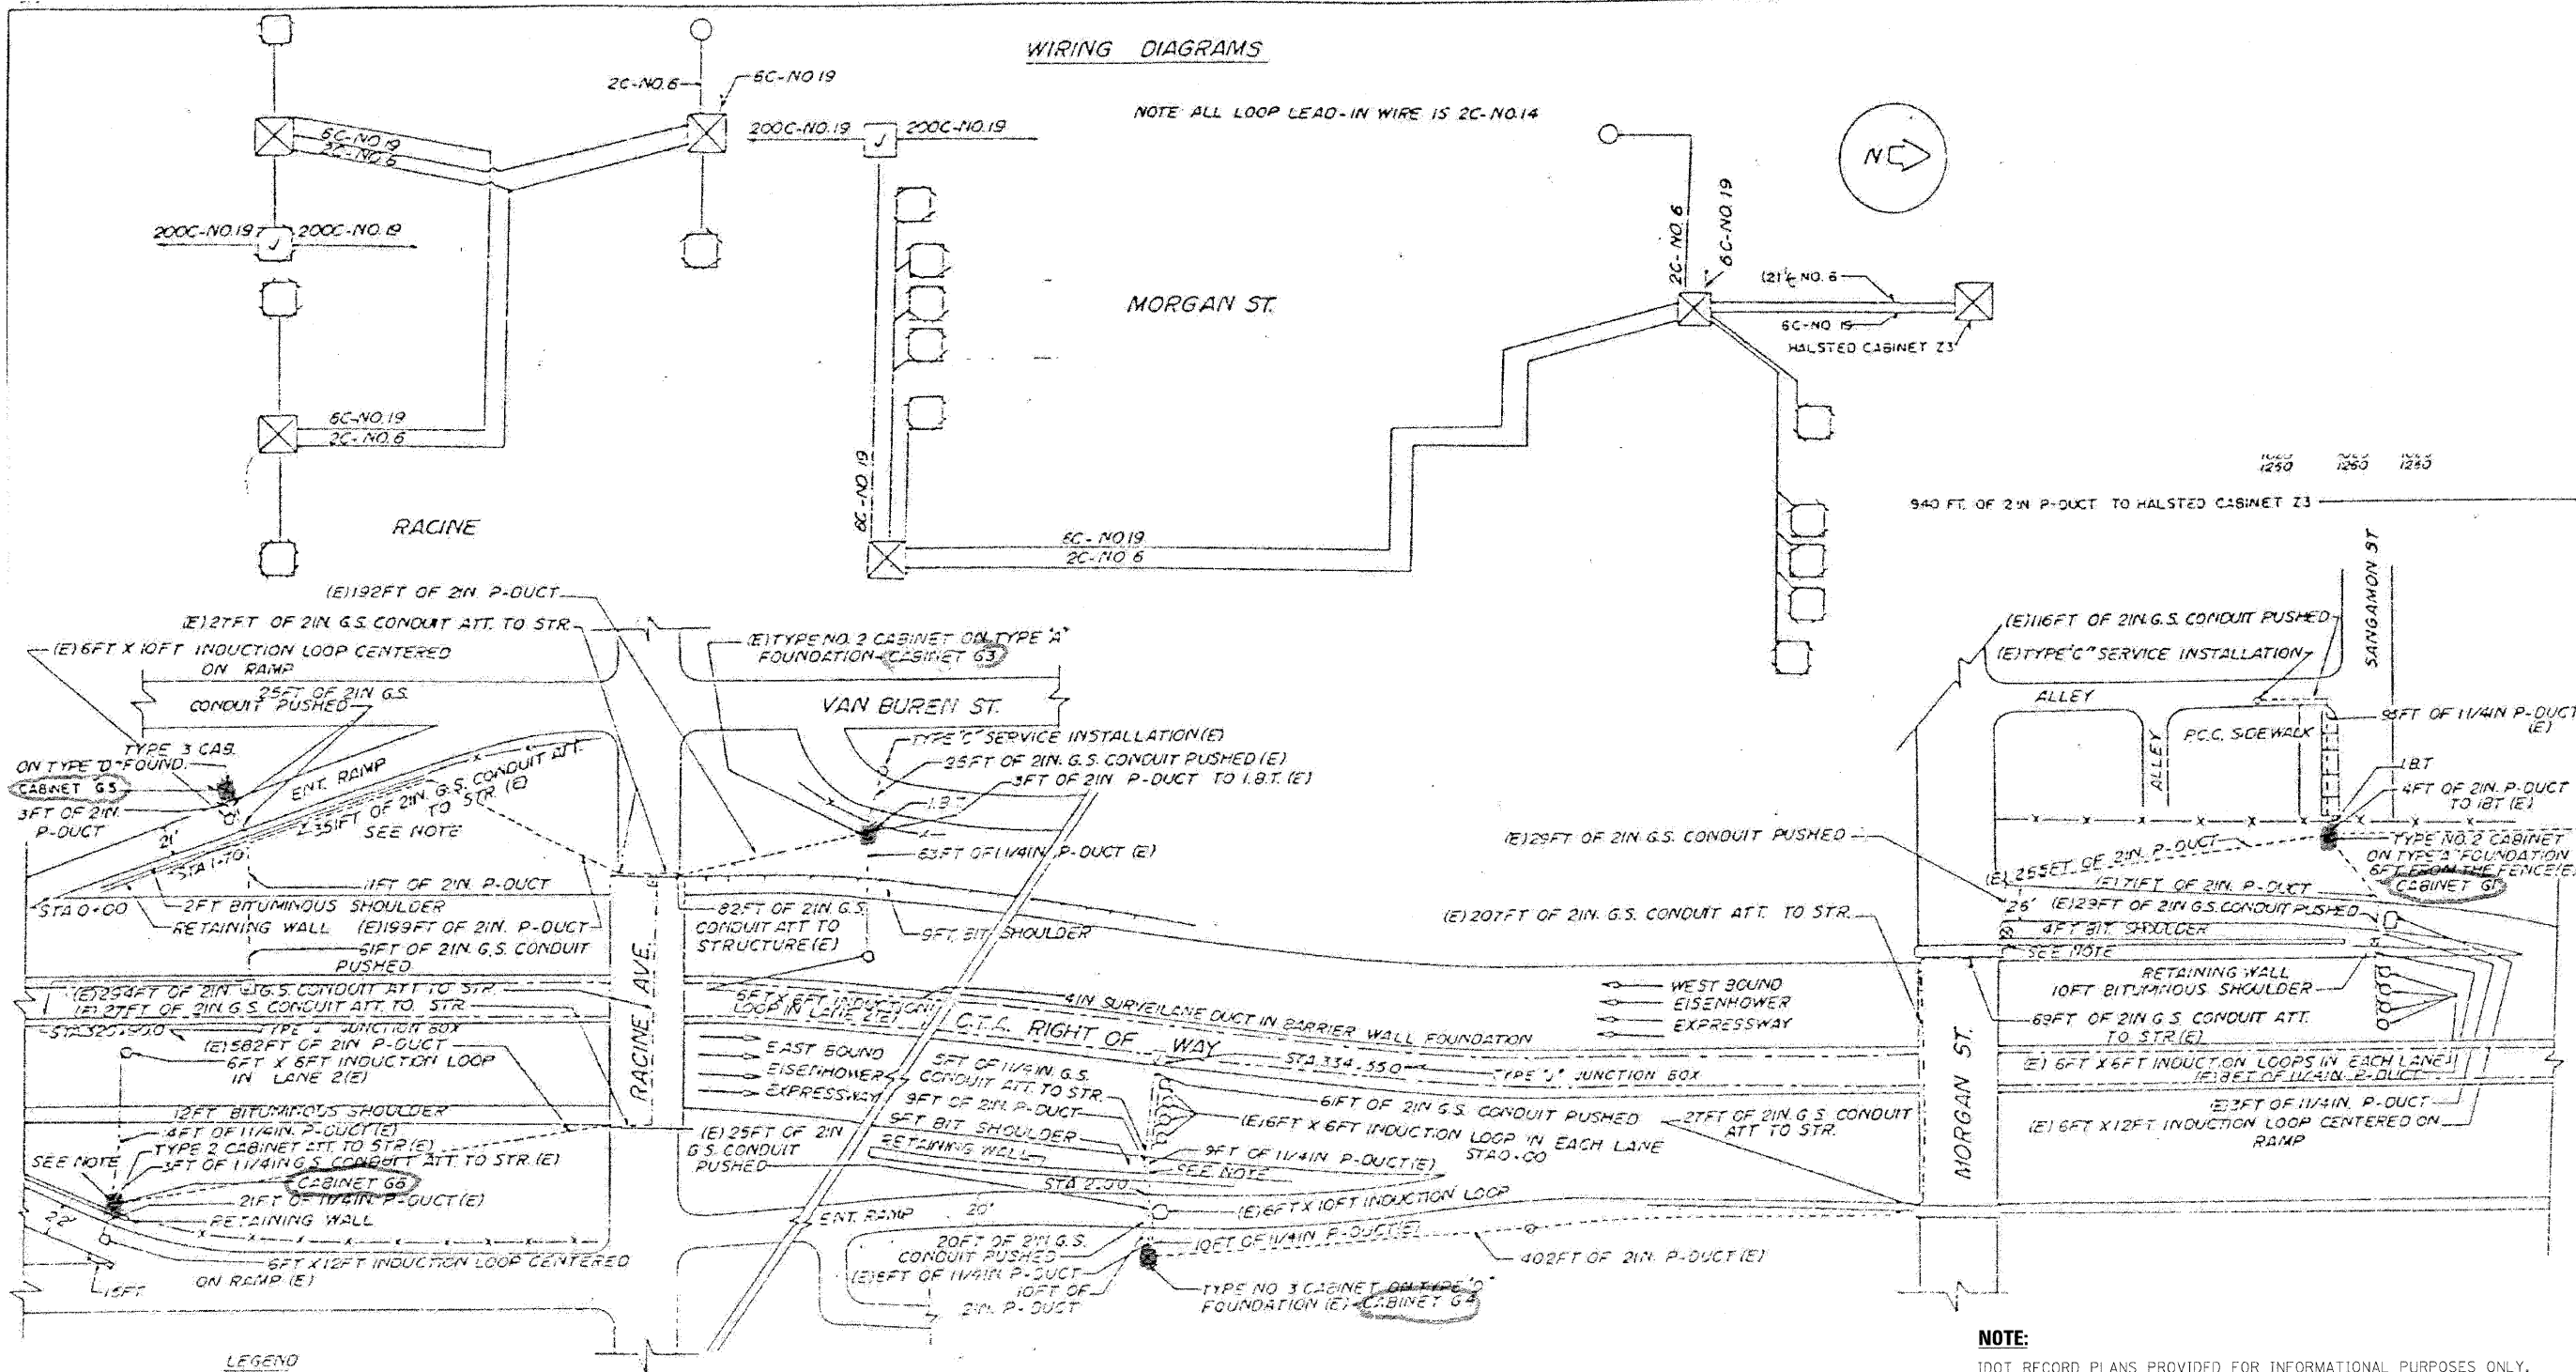

- LEGEND**
- CABINET
 - INDUCTION LOOP
 - JUNCTION BOX
 - HANGHOLE
 - PULL POINT
 - SERVICE INSTALLATION
 - DUCT
 - CONDUIT
 - x- FENCE
 - x- GUARD RAIL
 - (E) EXISTING
 - (RL) RELOCATE EXISTING FACILITIES

PLAN
NO SCALE

NOTE
1. HOLES SHALL BE DRILLED THROUGH RETAINING WALLS TO ACCOMMODATE 2IN. G.S. CONDUIT & CONDUITS PUSHED

NOTE:
IDOT RECORD PLANS PROVIDED FOR INFORMATIONAL PURPOSES ONLY. THE CONTRACTOR IS RESPONSIBLE FOR VERIFYING THE LOCATION AND EXTENT OF WORK ASSOCIATED WITH REPLACEMENT OF INDUCTION LOOPS, LEAD-IN CABLE AND RELATED WORK.

SUMMARY OF QUANTITIES (THIS SHEET)		
DESCRIPTION	UNIT	QUANTITY
ELECTRIC CABLE IN CONDUIT, LEAD-IN, NO. 18 4/C, TWISTED, SHIELDED	LF	820
INDUCTION LOOP	LF	603

FILE NAME =	DESIGNED - GHT	REVISED -
...\\signala\prp\in_abc\c3.ta.05.dgn	DRAWN - DMS	REVISED -
USER NAME = jmajewski	CHECKED - MPM	REVISED -
PLDT DATE = 1/25/2010	DATE - 1/25/10	REVISED -

benesch

STATE OF ILLINOIS
DEPARTMENT OF TRANSPORTATION

TRAFFIC SURVEILLANCE
MORGAN ST & RACINE AVE INSTALLATION

SCALE: N.T.S. SHEET NO. 2 OF 23 SHEETS STA. TO STA.

F.A.I. RTE.	SECTION	COUNTY	TOTAL SHEETS	SHEET NO.
290	(2525, ETC., 2727)RS-8	COOK	201	160
FED. ROAD DIST. NO.		ILLINOIS FED. AID PROJECT		
		CONTRACT NO. 60K11		