



SUMMARY OF QUANTITIES (THIS SHEET)		
DESCRIPTION	UNIT	QUANTITY
ELECTRIC CABLE IN CONDUIT, LEAD-IN, NO. 18 4/C, TWISTED, SHIELDED	LF	108
INDUCTION LOOP	LF	263

NOTE:
 IDOT RECORD PLANS PROVIDED FOR INFORMATIONAL PURPOSES ONLY. THE CONTRACTOR IS RESPONSIBLE FOR VERIFYING THE LOCATION AND EXTENT OF WORK ASSOCIATED WITH REPLACEMENT OF INDUCTION LOOPS, LEAD-IN CABLE AND RELATED WORK.

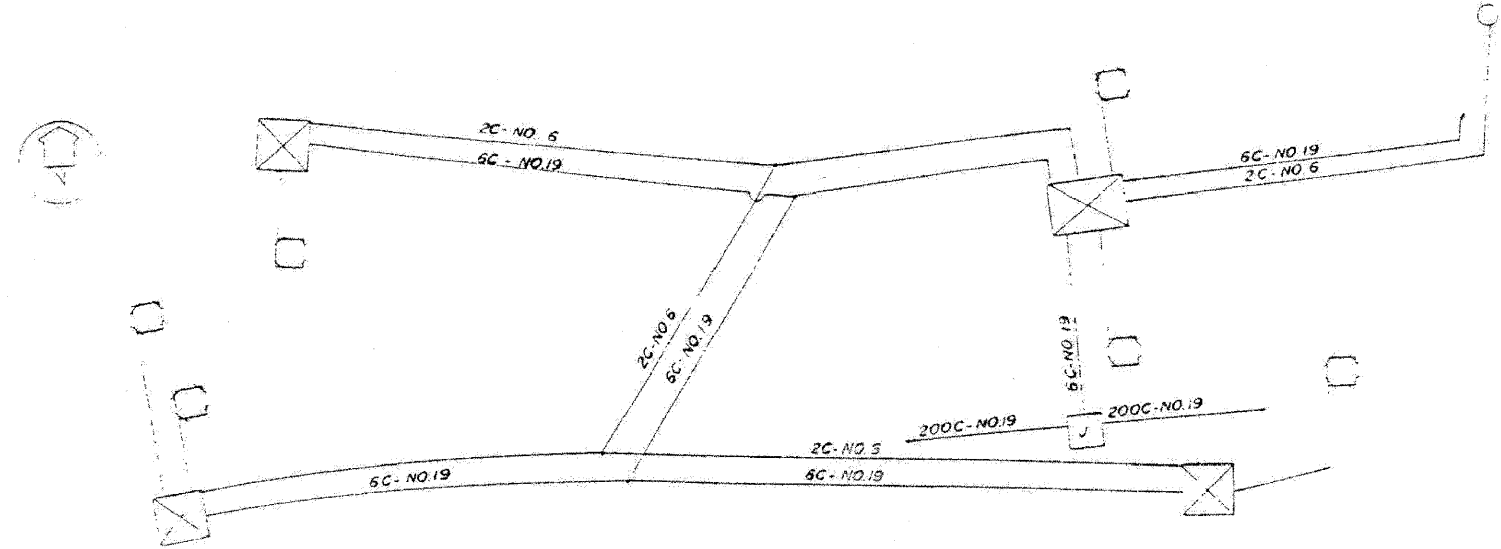

WIRING DIAGRAM

NOTE: ALL LOOP LEAD-IN WIRE IS 2-C NO. 14.

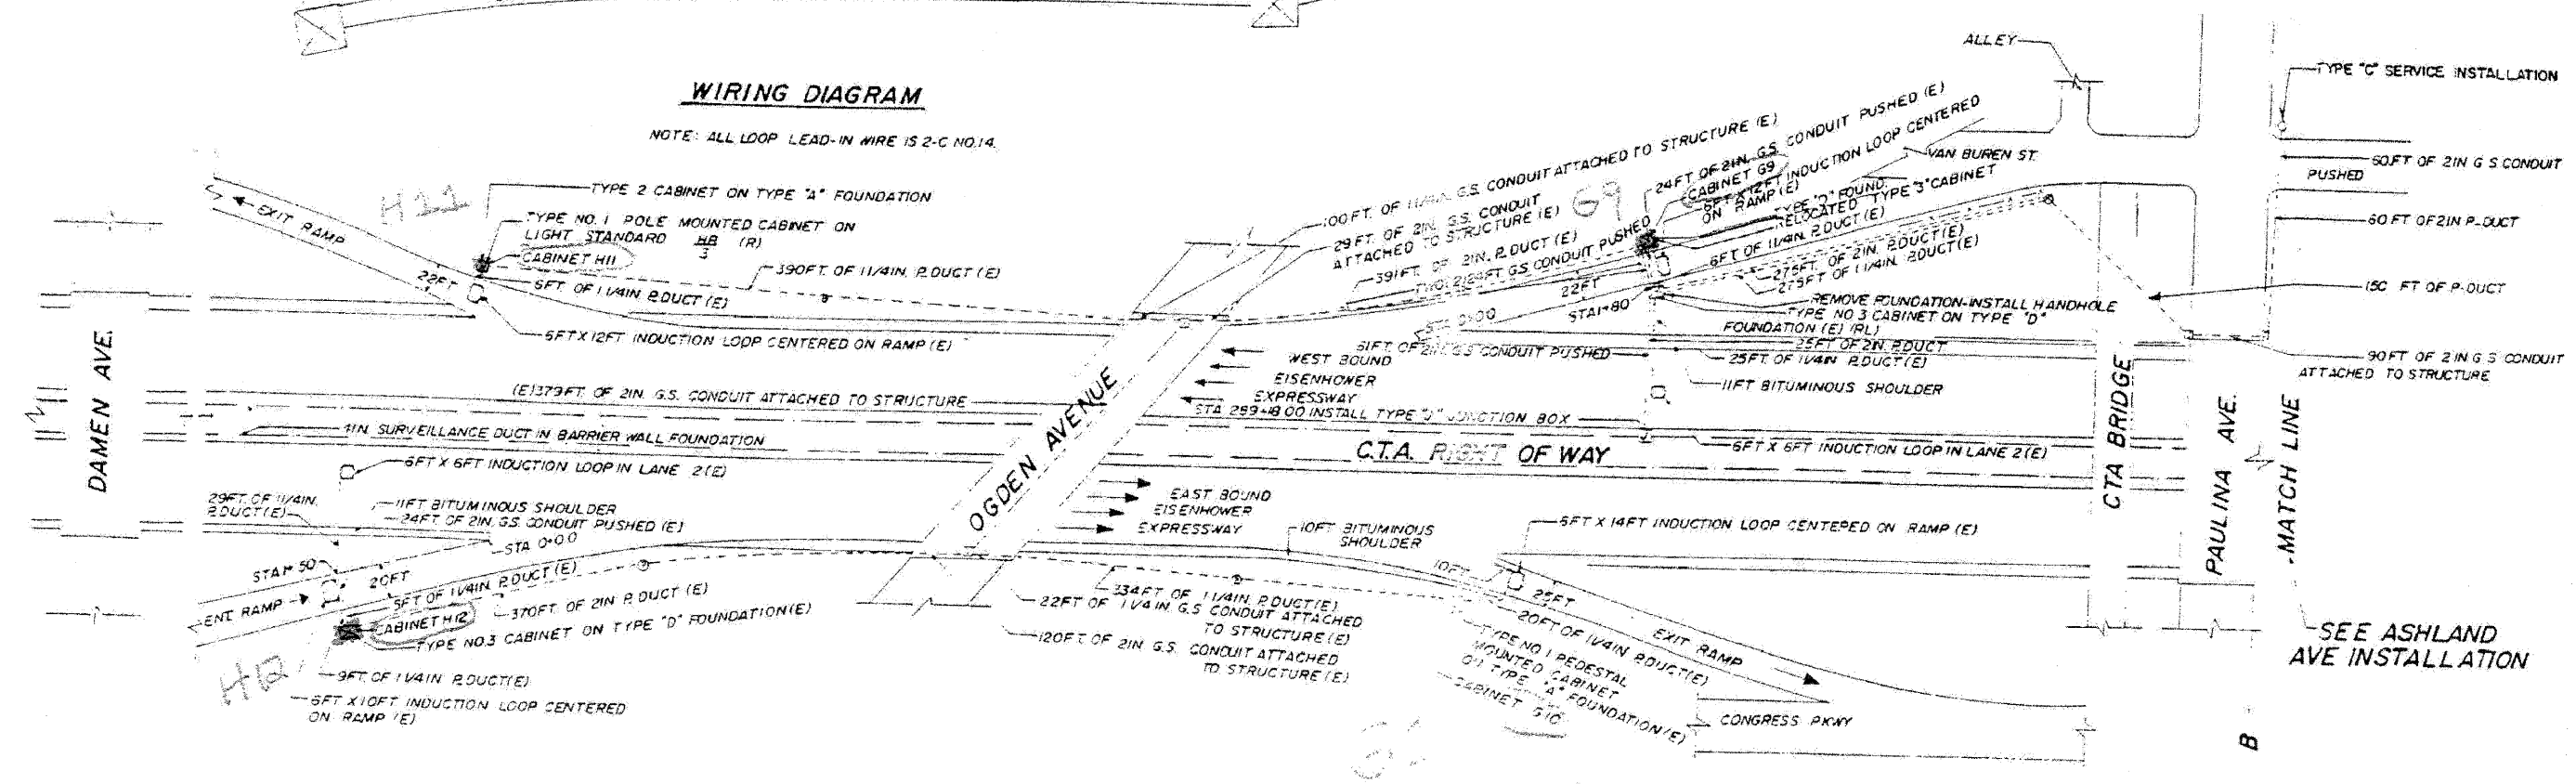

PLAN

- LEGEND**
- INDUCTION LOOP
 - CABINET
 - ⊠ JUNCTION BOX
 - ⊞ PULL POINT
 - ⊟ HANDHOLE
 - SERVICE INSTALLATION
 - CONDUIT
 - - - DUCT
 - - - FENCE
 - (E) EXISTING FACILITIES
 - (R) REMOVE EXISTING FACILITIES
 - (RL) RELOCATE EXISTING FACILITIES

FOR INFORMATION ONLY

INBOUND S4

FILE NAME =	DESIGNED - GHT	REVISED -
...\\Signal\proj\ABC_C3_ts_07.dgn	DRAWN - DMS	REVISED -
USER NAME = jmajewski	CHECKED - MPM	REVISED -
PLOT DATE = 1/25/2010	DATE - 1/25/10	REVISED -

benesch

**STATE OF ILLINOIS
 DEPARTMENT OF TRANSPORTATION**

**TRAFFIC SURVEILLANCE
 DAMEN AVE AND PAULINA ST INSTALLATION**

F.A.I. RTE.	SECTION	COUNTY	TOTAL SHEETS	SHEET NO.
290	(2525, ETC., 2727)RS-8	COOK	201	162
FED. ROAD DIST. NO.			ILLINOIS FED. AID PROJECT	

SCALE: N.T.S. SHEET NO. 4 OF 23 SHEETS STA. TO STA.