

STATE OF ILLINOIS
DEPARTMENT OF TRANSPORTATION

F.A.I. RTE.	SECTION	COUNTY	TOTAL SHEETS	SHEET NO.
55	(57-10HB)BR	MCLEAN	19	1
		ILLINOIS	CONTRACT NO. 70F57	

D-95-003-22



FOR INDEX OF SHEETS, SEE SHEET NO. 2

F.A.I. 55 SOUTHBOUND

CURRENT TRAFFIC DATA
STR. 057-0154 SB

2021 ADT = 11,500
2041 ADT = 12,700
PU+PC % = 65.9
SU % = 2.8
MU% = 31.3

DESIGN DESIGNATION

INTERSTATE

F.A.P. 315 (US 136)

CURRENT TRAFFIC DATA
UNDER STR. 057-0154

2021 ADT = 4,900
2041 ADT = 5,400
PU+PC % = 70.4
SU % = 13.3
MU% = 16.3

DESIGN DESIGNATION


OTHER PRINCIPAL ARTERIAL

PROPOSED
HIGHWAY PLANS

F.A.I. ROUTE 55 (I-55)
SECTION (57-10HB)BR
PROJECT
BRIDGE DECK OVERLAY
MCLEAN COUNTY

C-95-020-22

PROPOSED STRUCTURE REPAIRS
S.N. 057-0154
F.A.I. 55 OVER U.S. 136
MCLEAN INTERCHANGE
STATION 753+54.41

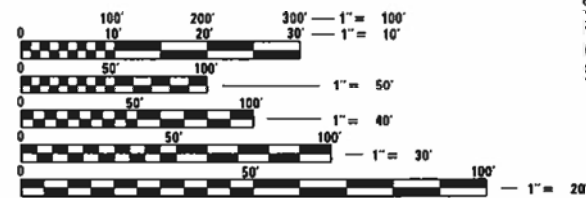


FULL SIZE PLANS HAVE BEEN PREPARED USING STANDARD ENGINEERING SCALES. REDUCED SIZED PLANS WILL NOT CONFORM TO STANDARD SCALES. IN MAKING MEASUREMENTS ON REDUCED PLANS, THE ABOVE SCALES MAY BE USED.

J.U.L.I.E.
JOINT UTILITY LOCATION INFORMATION FOR EXCAVATORS
1-800-892-0123
OR 811

TOWNSHIP: MOUNT HOPE

PROJECT ENGINEER TIM BRANDENBURG
PROJECT MANAGER ERIC SHAWLER

CONTRACT NO. 70F57

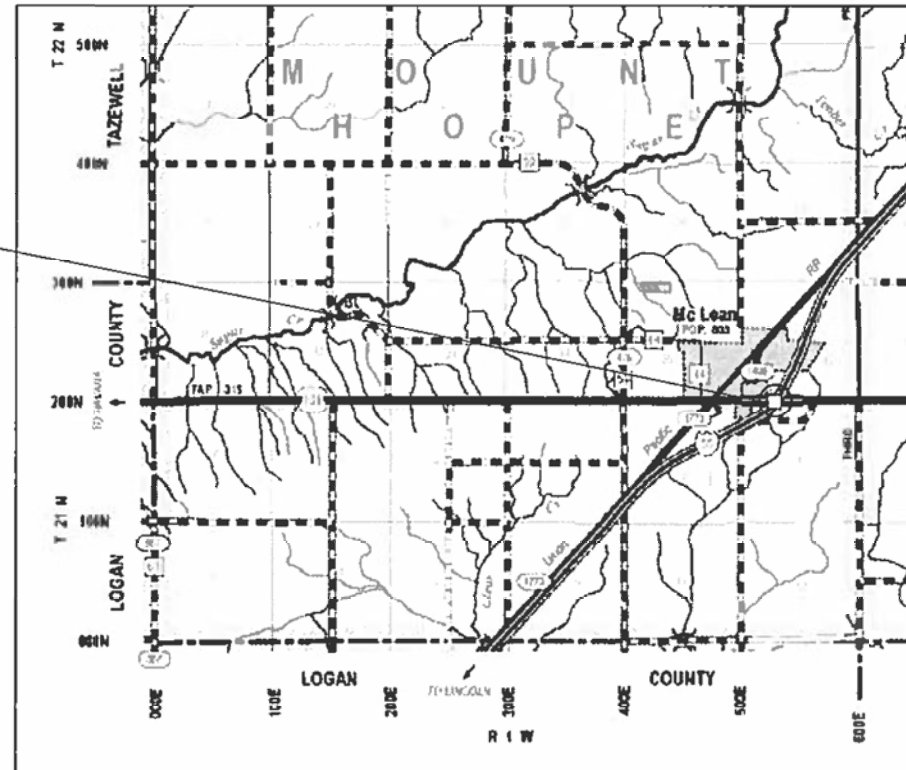

R 1 W | R 1 E

GROSS LENGTH = 610.00 FT. = 0.015 MILE
NET LENGTH = 610.00 FT. = 0.015 MILE

STATE OF ILLINOIS
DEPARTMENT OF TRANSPORTATION

SUBMITTED 11/16 2021
Kennel A. Barnett
REGIONAL ENGINEER

February 4 2022
[Signature]
ENGINEER OF DESIGN AND ENVIRONMENT

February 4 2022
Stephen M. Smith
DIRECTOR OF HIGHWAYS PROJECT IMPLEMENTATION

PRINTED BY THE AUTHORITY
OF THE STATE OF ILLINOIS

INDEX OF SHEETS

SHEET NO.	ITEM
1	COVER SHEET
2	INDEX OF SHEETS
2	LIST OF STANDARDS
2	GENERAL NOTES
3-4	SUMMARY OF QUANTITIES
5-14	STRUCTURE PLANS S.N. 057-0154
15	STRIPING DETAIL
16	STAGE CONSTRUCTION DETAILS
17	TEMPORARY RUMBLE STRIPS
18	DETAILS FOR WIDTH RESTRICTION SIGNING
19	PAVEMENT MARKINGS (INTERSTATE & MULTI-LANE APPLICIONS)

LIST OF HIGHWAY STANDARDS

STANDARD NO.	DESCRIPTION
000001-08	STANDARD SYMBOLS, ABBREVIATIONS AND PATTERNS
001001-02	AREAS OF REINFORCEMENT BARS
001006	DECIMAL OF AN INCH AND FOOT
701006-05	OFF ROAD OPERATIONS, 2L,2W, 15' TO 24" FROM EDGE OF PAVEMENT
701101-05	OFF ROAD OPERATIONS, MULTILANE, 15' TO 24" FROM EDGE OF PAVEMENT
701400-11	APPROACH TO LANE CLOSURE, FREEWAY / EXPRESSWAY
701401-13	LANE CLOSURE, FREEWAY / EXPRESSWAY
701402-12	LANE CLOSURE, FREEWAY / EXPRESSWAY WITH BARRIER
701411-09	LANE CLOSURE, MULTILANE, AT ENTRANCE OR EXIT RAMP FOR SPEEDS > 45MPH
701426-09	LANE CLOSURE, MULTILANE, INTERMITTENT, OR MOVING OPER. FOR SPEEDS > 45MPH
701601-09	URBAN LANE CLOSURE, MULTILANE, 1W OR 2W, WITH NONTRASVERSABLE MEDIAN
701901-08	TRAFFIC CONTROL DEVICES
704001-08	TEMPORARY CONCRETE BARRIER
D5 7800BBBB	PAVEMENT MARKINGS (INTERSTATE & MULTI-LANE APPLICIONS)

GENERAL NOTES

G.N.-100

ENGLISH UNITS OF MEASUREMENT SHALL GOVERN OVER AND SUPERSEDE ANY METRIC UNITS SHOWN IN THIS CONTRACT. WHERE INCLUDED, METRIC UNITS ARE FOR INFORMATION ONLY.

G.N.-105.09A

ALL ELEVATIONS SHOWN IN THE PLANS ARE BASED ON NORTH AMERICAN VERTICAL DATUM OF 1988. (NAVD 88)

G.N.-406H

MIXTURE REQUIREMENTS CONTRACT 70F57

THE FOLLOWING MIXTURE REQUIREMENTS ARE APPLICABLE FOR THIS PROJECT:

Location	I-55
Mixture Use	Surface
AC/PG	SBS PG 70-22
Design Air Voids	4.0% @ Ndes=90
Mix Comp(Gradation)	IL 9.5
Friction Aggregate	Mix D
Mixture Weight	112
Quality Management Program	QC/QA
Sublot Size	N.A.
Material Transfer Device (Required?)	No

SEE R.E. FILE FOR CALCULATIONS AND SCHEDULES.

THERE ARE NO COMMITMENTS ASSOCIATED WITH THIS PROJECT.

**STATE OF ILLINOIS
DEPARTMENT OF TRANSPORTATION**

**INDEX OF SHEETS, STANDARDS, GENERAL NOTES
S.N. 057-0154**

SCALE: SHEET 1 OF 1 SHEETS STA. TO STA.

F.A.I. RTE.	SECTION	COUNTY	TOTAL SHEETS	SHEET NO.
55	(57-10H)BR	MCLEAN	19	2
CONTRACT NO. 70F57			ILLINOIS FED. AID PROJECT	

MCLEAN CO.
FAI 55 (I-55)
INTERSTATE
BRIDGE DECK REPAIR
S.N. 057-0154
100% STATE
0059

CODE NO.	ITEM	UNIT	QUANTITY
40600290	BITUMINOUS MATERIALS (TACK COAT)	POUND	545.0
40604164	POLYMERIZED HOT-MIX ASPHALT SURFACE COURSE, IL-9.5, MIX "D", N90	TON	152.5
50157300	PROTECTIVE SHIELD	SQ YD	279.0
50500505	STUD SHEAR CONNECTORS	EACH	72.0
67000400	ENGINEER'S FIELD OFFICE, TYPE A	CAL MO	3.0
67100100	MOBILIZATION	L SUM	1.0
70100207	TRAFFIC CONTROL AND PROTECTION, STANDARD 701402	EACH	1.0
70100420	TRAFFIC CONTROL AND PROTECTION, STANDARD 701411	EACH	1.0
70100800	TRAFFIC CONTROL AND PROTECTION, STANDARD 701401	L SUM	1.0
70102630	TRAFFIC CONTROL AND PROTECTION, STANDARD 701601	L SUM	1.0
70107025	CHANGEABLE MESSAGE SIGN	CAL DA	14.0
70400100	TEMPORARY CONCRETE BARRIER	FOOT	537.5
70400125	PINNING TEMPORARY CONCRETE BARRIER	EACH	24.0
70400200	RELOCATE TEMPORARY CONCRETE BARRIER	FOOT	537.5

* SPECIALTY ITEM

MODEL: \\MODEL\MAME
 FILE: MAME: \\pub\c:\paw\bea\fy.com\PIV\DOT\Documents\DOT\Office\Dir\dir: S:\Project\057057\CAD\Drawn\CAD\sheet\057057.dwg

USER NAME = shawleres	DESIGNED -	REVISED -
	DRAWN -	REVISED -
PLOT SCALE = 40,0000 * / in.	CHECKED -	REVISED -
PLOT DATE = 12/16/2021	DATE -	REVISED -

**STATE OF ILLINOIS
DEPARTMENT OF TRANSPORTATION**

**SUMMARY OF QUANTITIES
S.N. 057-0154**

SCALE: SHEET 1 OF 2 SHEETS STA. TO STA.

F.A.I. RTE.	SECTION	COUNTY	TOTAL SHEETS	SHEET NO.
55	(57-10HB)BR	MCLEAN	19	3
			CONTRACT NO. 70F57	
		ILLINOIS FED. AID PROJECT		

MCLEAN CO.
FAI 55 (II-55)
INTERSTATE
BRIDGE DECK REPAIR
S.N. 057-0154
100% STATE
0059

CODE NO.	DESCRIPTION	UNIT	QUANTITY
70600250	IMPACT ATTENUATORS, TEMPORARY (NON- REDIRECTIVE), TEST LEVEL 3	EACH	1.0
70600350	IMPACT ATTENUATORS, RELOCATE (NON- REDIRECTIVE), TEST LEVEL 3	EACH	1.0
* 78008330	POLYUREA PAVEMENT MARKING TYPE II - LINE 6"	FOOT	1,380.0
* 78011035	GROOVING FOR RECESSED PAVEMENT MARKING 7"	FOOT	1,380.0
X2700001	TEMPORARY RUMBLE STRIPS (SPECIAL)	EACH	8.0
X7200201	WIDTH RESTRICTION SIGNING	L SUM	1.0
Z0001800	APPROACH SLAB REPAIR (PARTIAL DEPTH)	SQ YD	16.1
Z0004560	BRIDGE WEARING SURFACE REMOVAL	SQ YD	1,207.8
Z0016001	DECK SLAB REPAIR (FULL DEPTH, TYPE I)	SQ YD	3.6
Z0016002	DECK SLAB REPAIR (FULL DEPTH, TYPE II)	SQ YD	93.2
Z0016200	DECK SLAB REPAIR (PARTIAL)	SQ YD	12.1
Z0021908	SILICONE JOINT SEALER, 2"	FOOT	106.0
Z0041895	POLYMER CONCRETE	CU FT	12.5

* SPECIALTY ITEM

MODEL: \\MODEL\MAME
FILE: MAME_Plan\\Subcontract\\com\\P\\W\\DOT Documents\\DOT Office\\District 5\\Project\\057057\\CAD\\Data\\CAD sheets\\057057_0154.dgn



USER NAME = shawleres	DESIGNED -	REVISED -
PLOT SCALE = 40,0000 * / in.	DRAWN -	REVISED -
PLOT DATE = 12/16/2021	CHECKED -	REVISED -
	DATE -	REVISED -

STATE OF ILLINOIS
DEPARTMENT OF TRANSPORTATION

SUMMARY OF QUANTITIES
S.N. 057-0154

SCALE: SHEET 2 OF 2 SHEETS STA. TO STA.

F.A.I. RTE.	SECTION	COUNTY	TOTAL SHEETS	SHEET NO.
55	(57-10HB)BR	MCLEAN	19	4
			CONTRACT NO. 70F57	
			ILLINOIS FED. AID PROJECT	

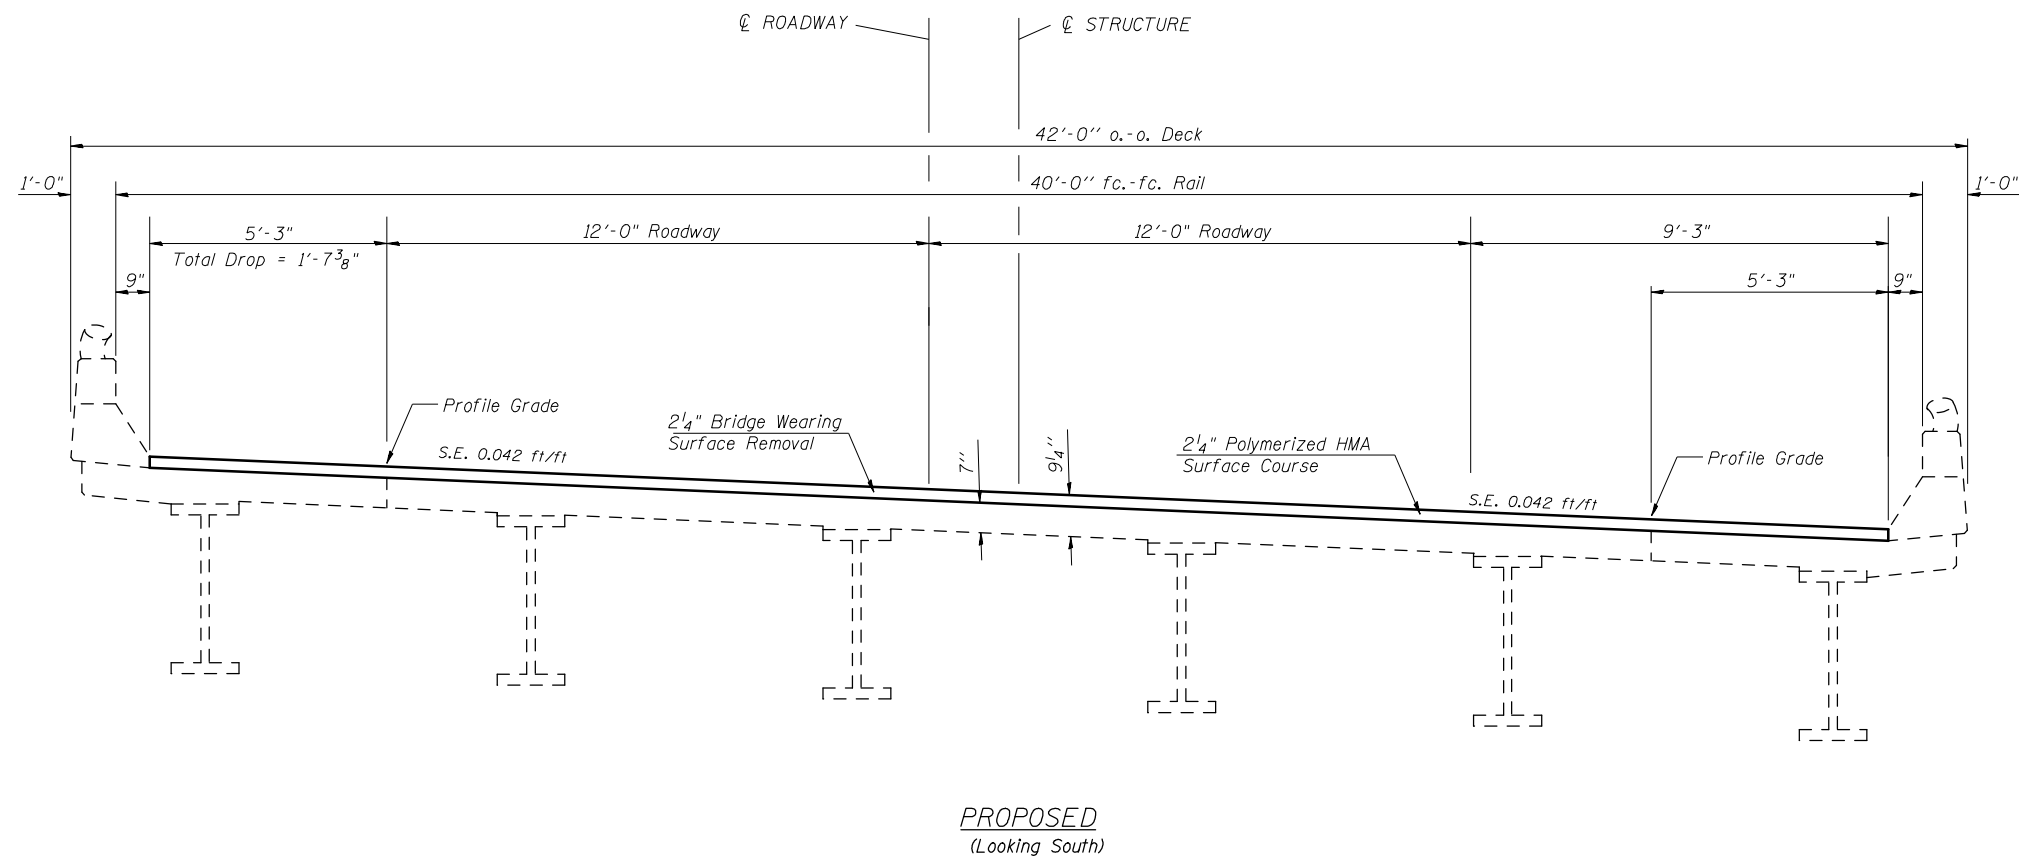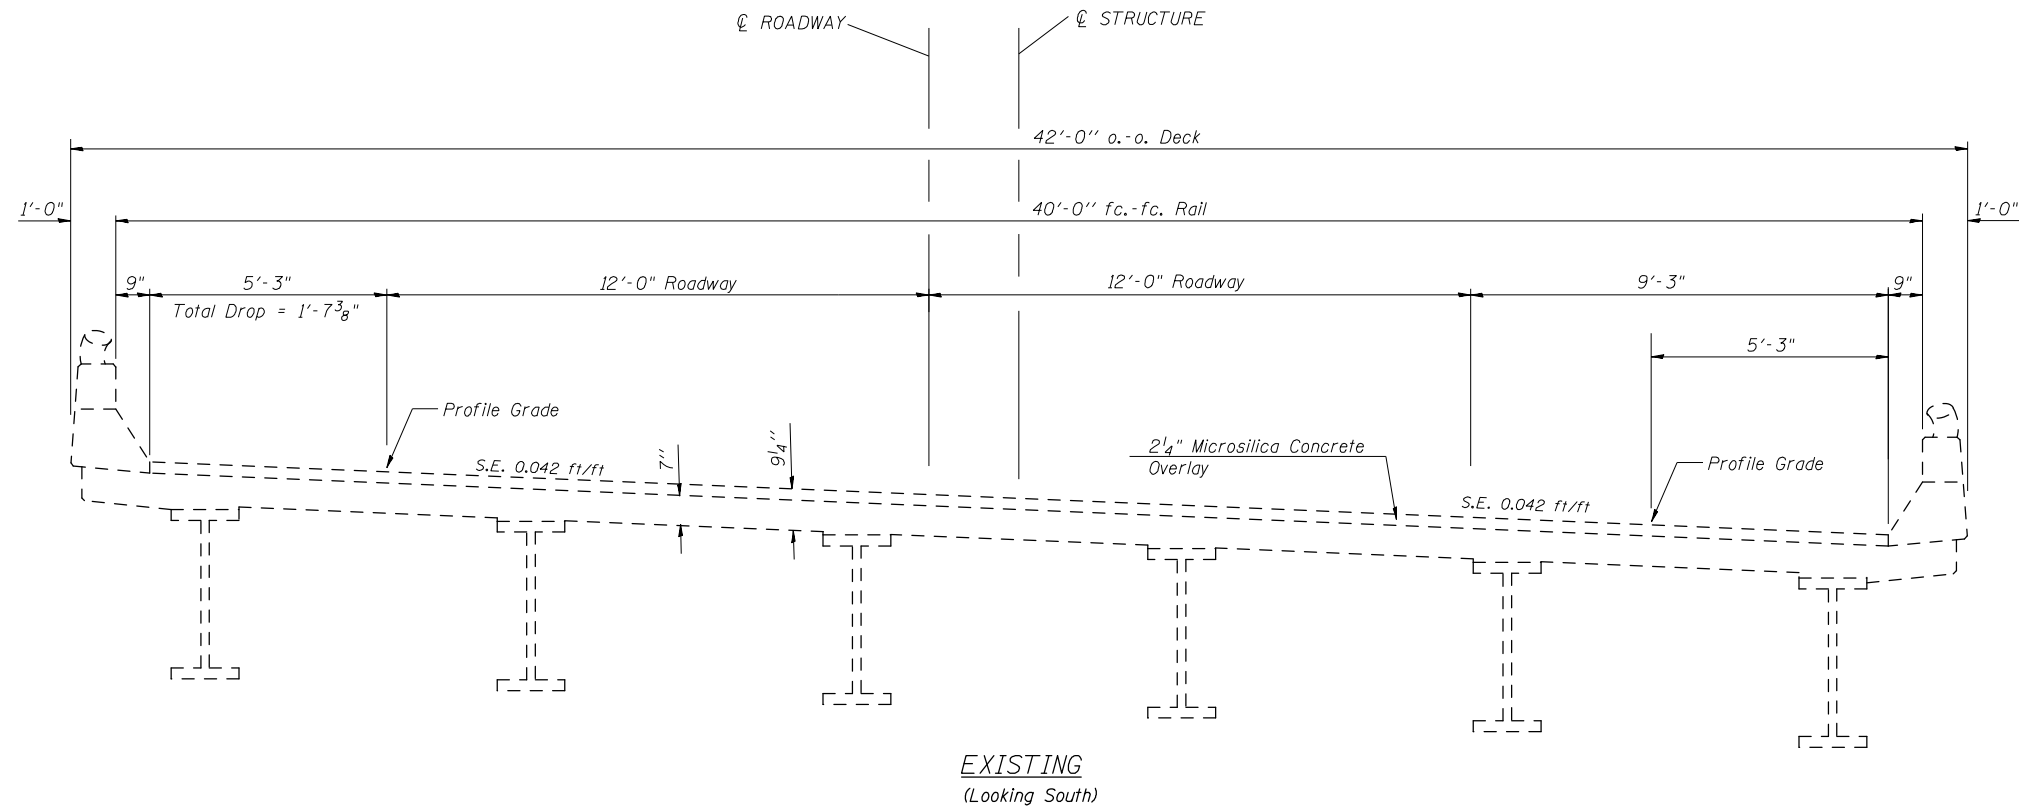

Note - All transverse dimensions are radial.

MODEL: \\MODEL\MAME
 FILE: \\MAILS_P\pub\csc\paw\hwy.com\PIV\DOT\Documents\DOT_Offices\Dir\dr: S:\Project\057057\CADD\Drawn\CAD\Sheet\057057.dwg_057-0154.dwg



USER NAME = shawleres	DESIGNED -	REVISED -
	DRAWN -	REVISED -
PLOT SCALE = 680,0000 ' / in.	CHECKED -	REVISED -
PLOT DATE = 11/10/2021	DATE -	REVISED -

**STATE OF ILLINOIS
DEPARTMENT OF TRANSPORTATION**

**DECK CROSS SECTION
S.N. 057-0154**

SCALE: SHEET 3 OF 10 SHEETS STA. TO STA.

F.A.I. RTE.	SECTION	COUNTY	TOTAL SHEETS	SHEET NO.
55	(57-10HB)BR	MCLEAN	19	7
CONTRACT NO. 70F57				
ILLINOIS FED. AID PROJECT				

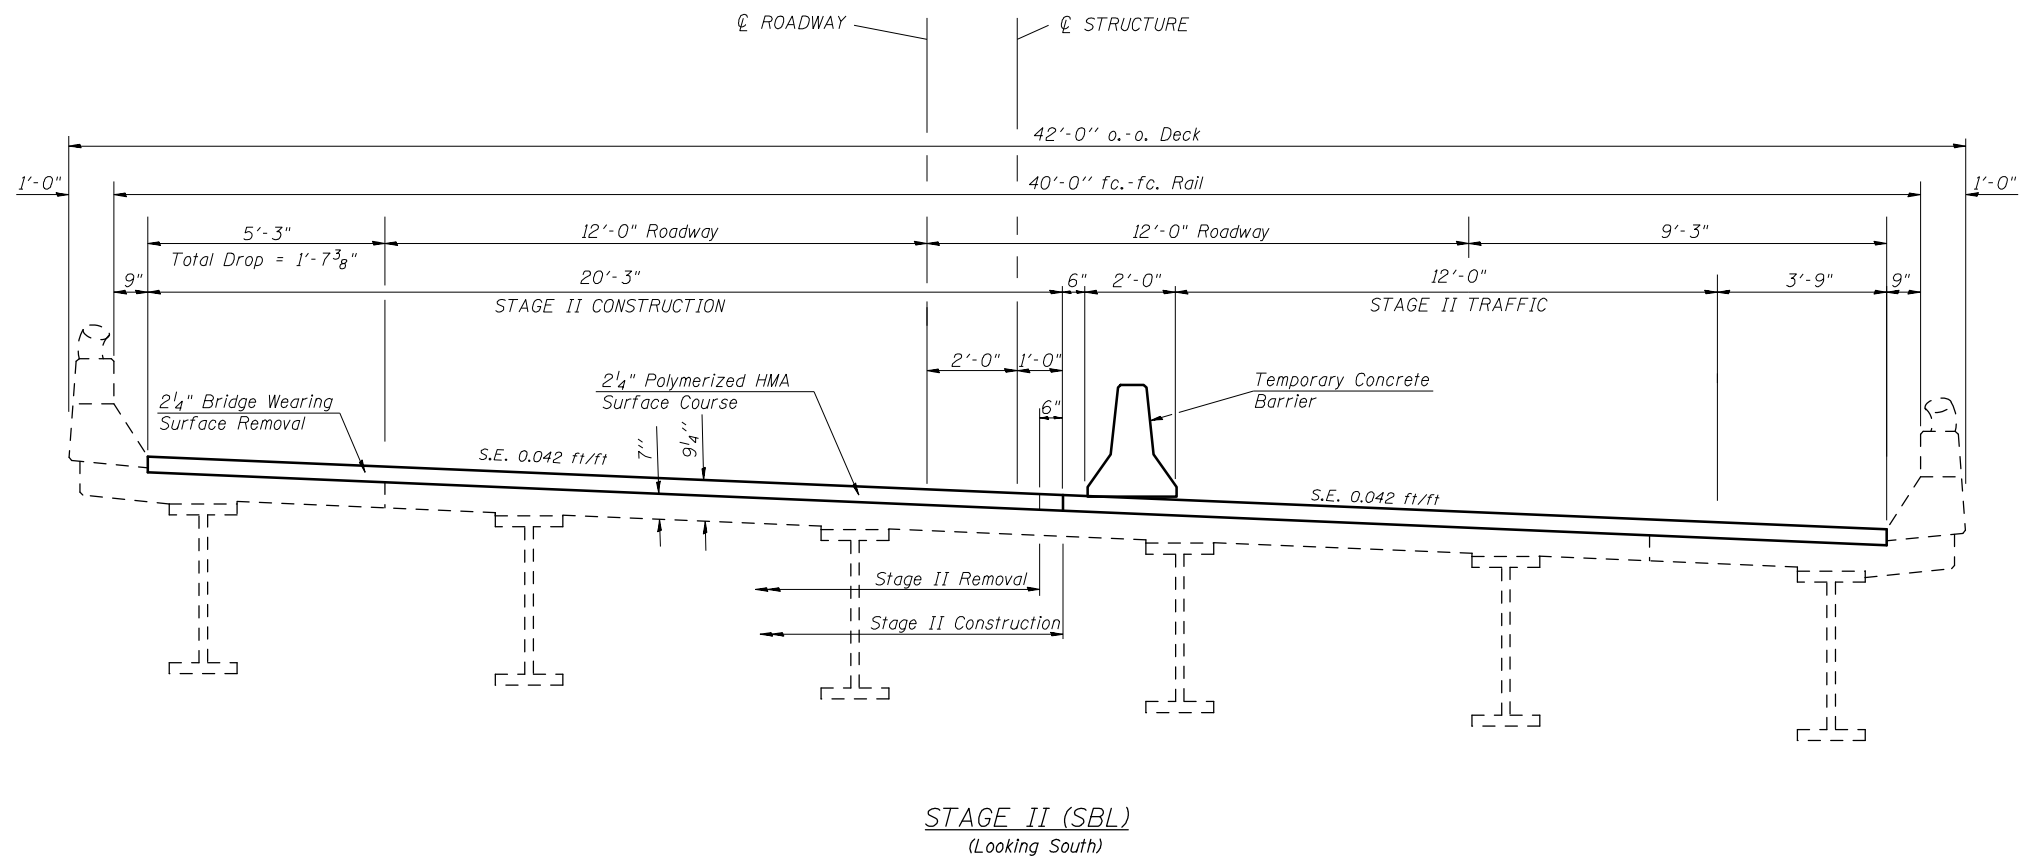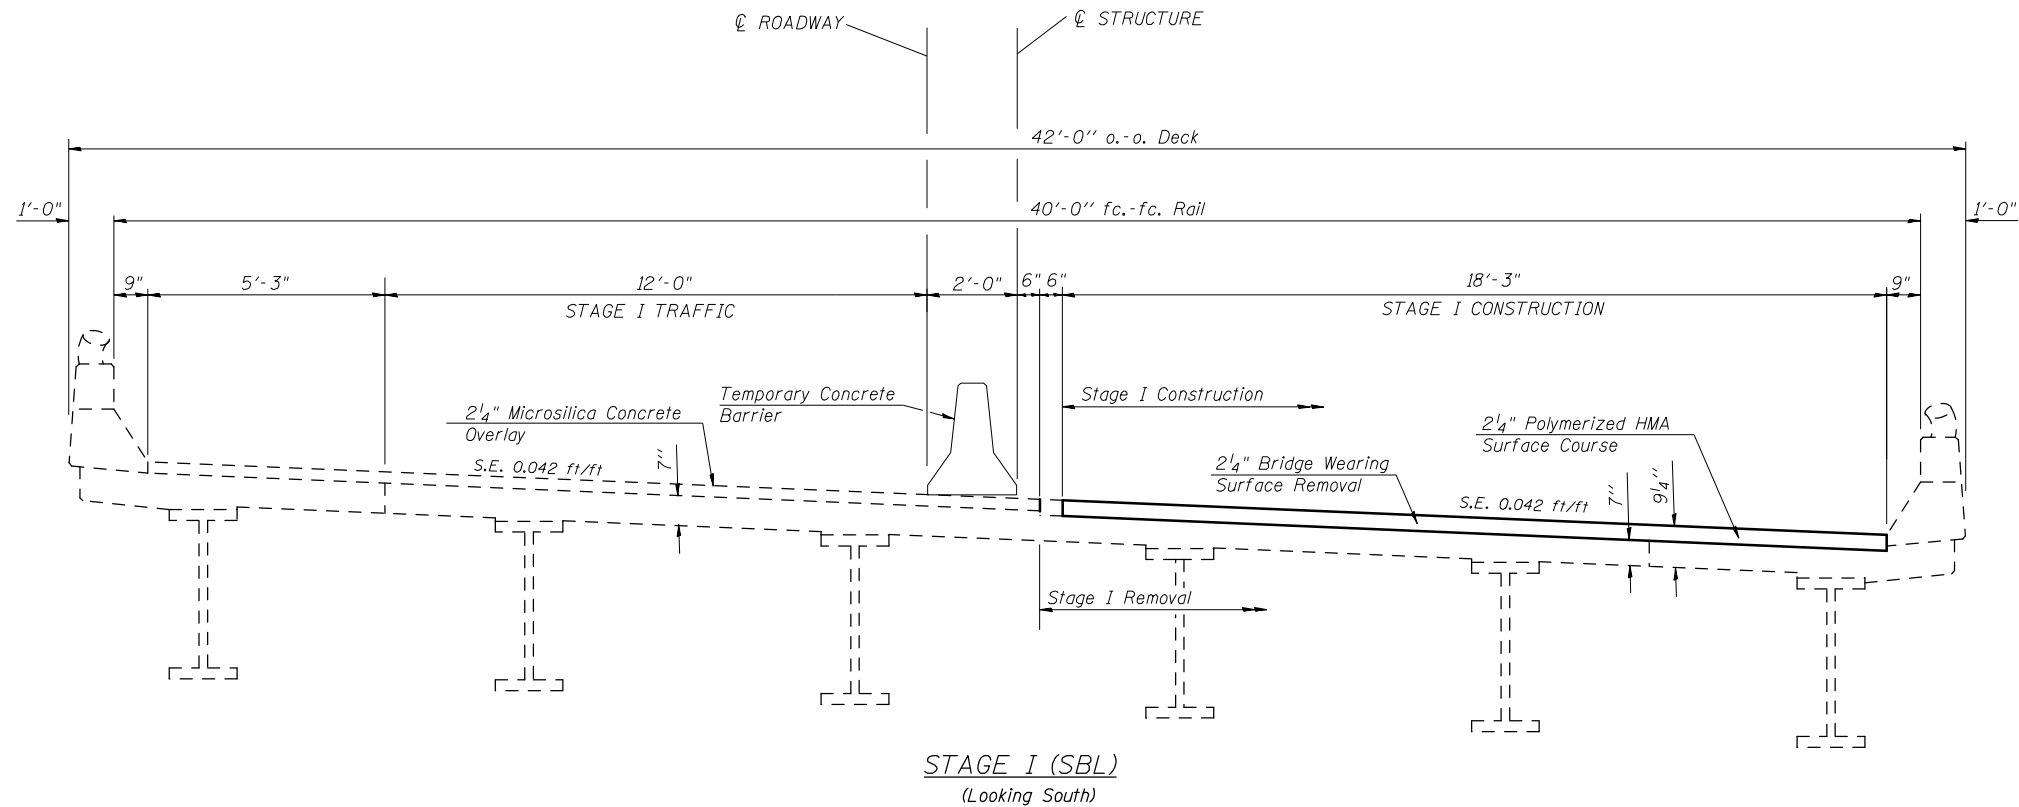

Note - All transverse dimensions are radial.


MODEL: \\MODEL\MNMF
 FILE: \\MAILS_P\pub\lucy\paw\hwy.com\PIV\DOT\Documents\DOT_Offices\Dir\dr: S:\Project\057057\CADD\Draw\CAD\Sheet\057057.dwg_057-0154.dwg

USER NAME = shawleres	DESIGNED -	REVISED -
	DRAWN -	REVISED -
PLOT SCALE = 680,0000 ' / in.	CHECKED -	REVISED -
PLOT DATE = 11/10/2021	DATE -	REVISED -


**STATE OF ILLINOIS
DEPARTMENT OF TRANSPORTATION**

DECK STAGING DETAIL S.N. 057-0154			
SCALE:	SHEET 4	OF 10 SHEETS	TO STA.


F.A.I. RTE.	SECTION	COUNTY	TOTAL SHEETS	SHEET NO.
55	(57-10HB)BR	MCLEAN	19	8
CONTRACT NO. 70F57				
ILLINOIS FED. AID PROJECT				

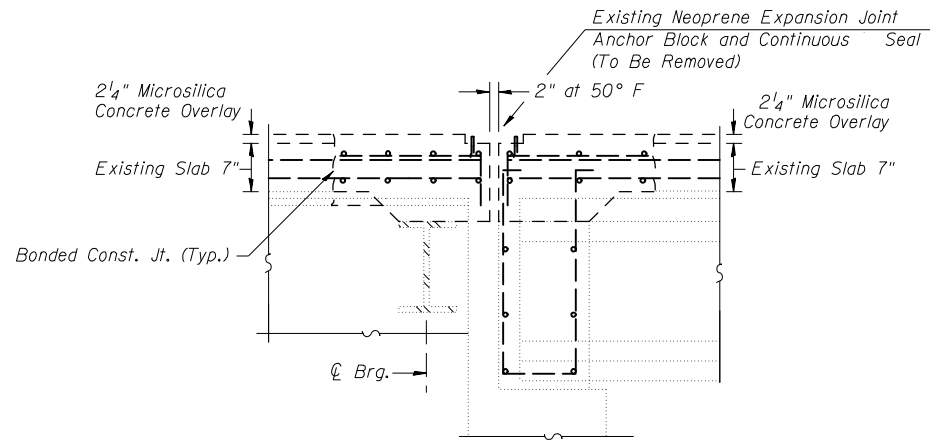


EXISTING SECTION A-A
(Dimensions are at Right Angles)

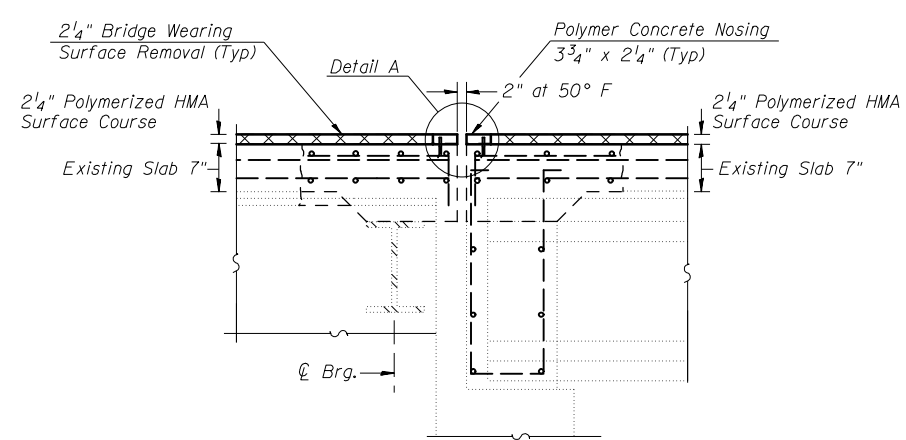


PROPOSED SECTION A-A
(Dimensions are at Right Angles)

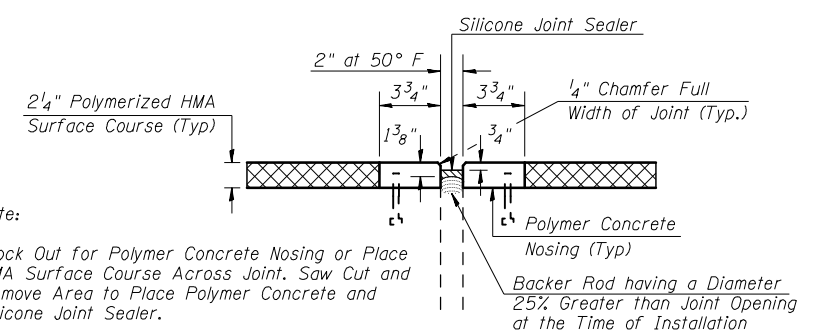

DETAIL A
(Dimensions are at Right Angles)

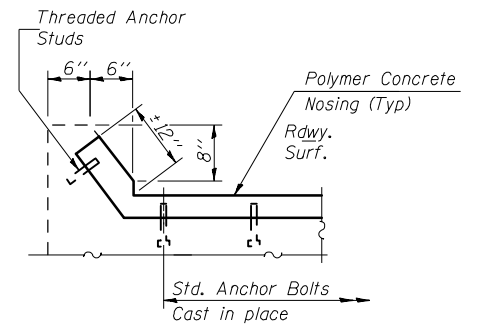

AT CURB

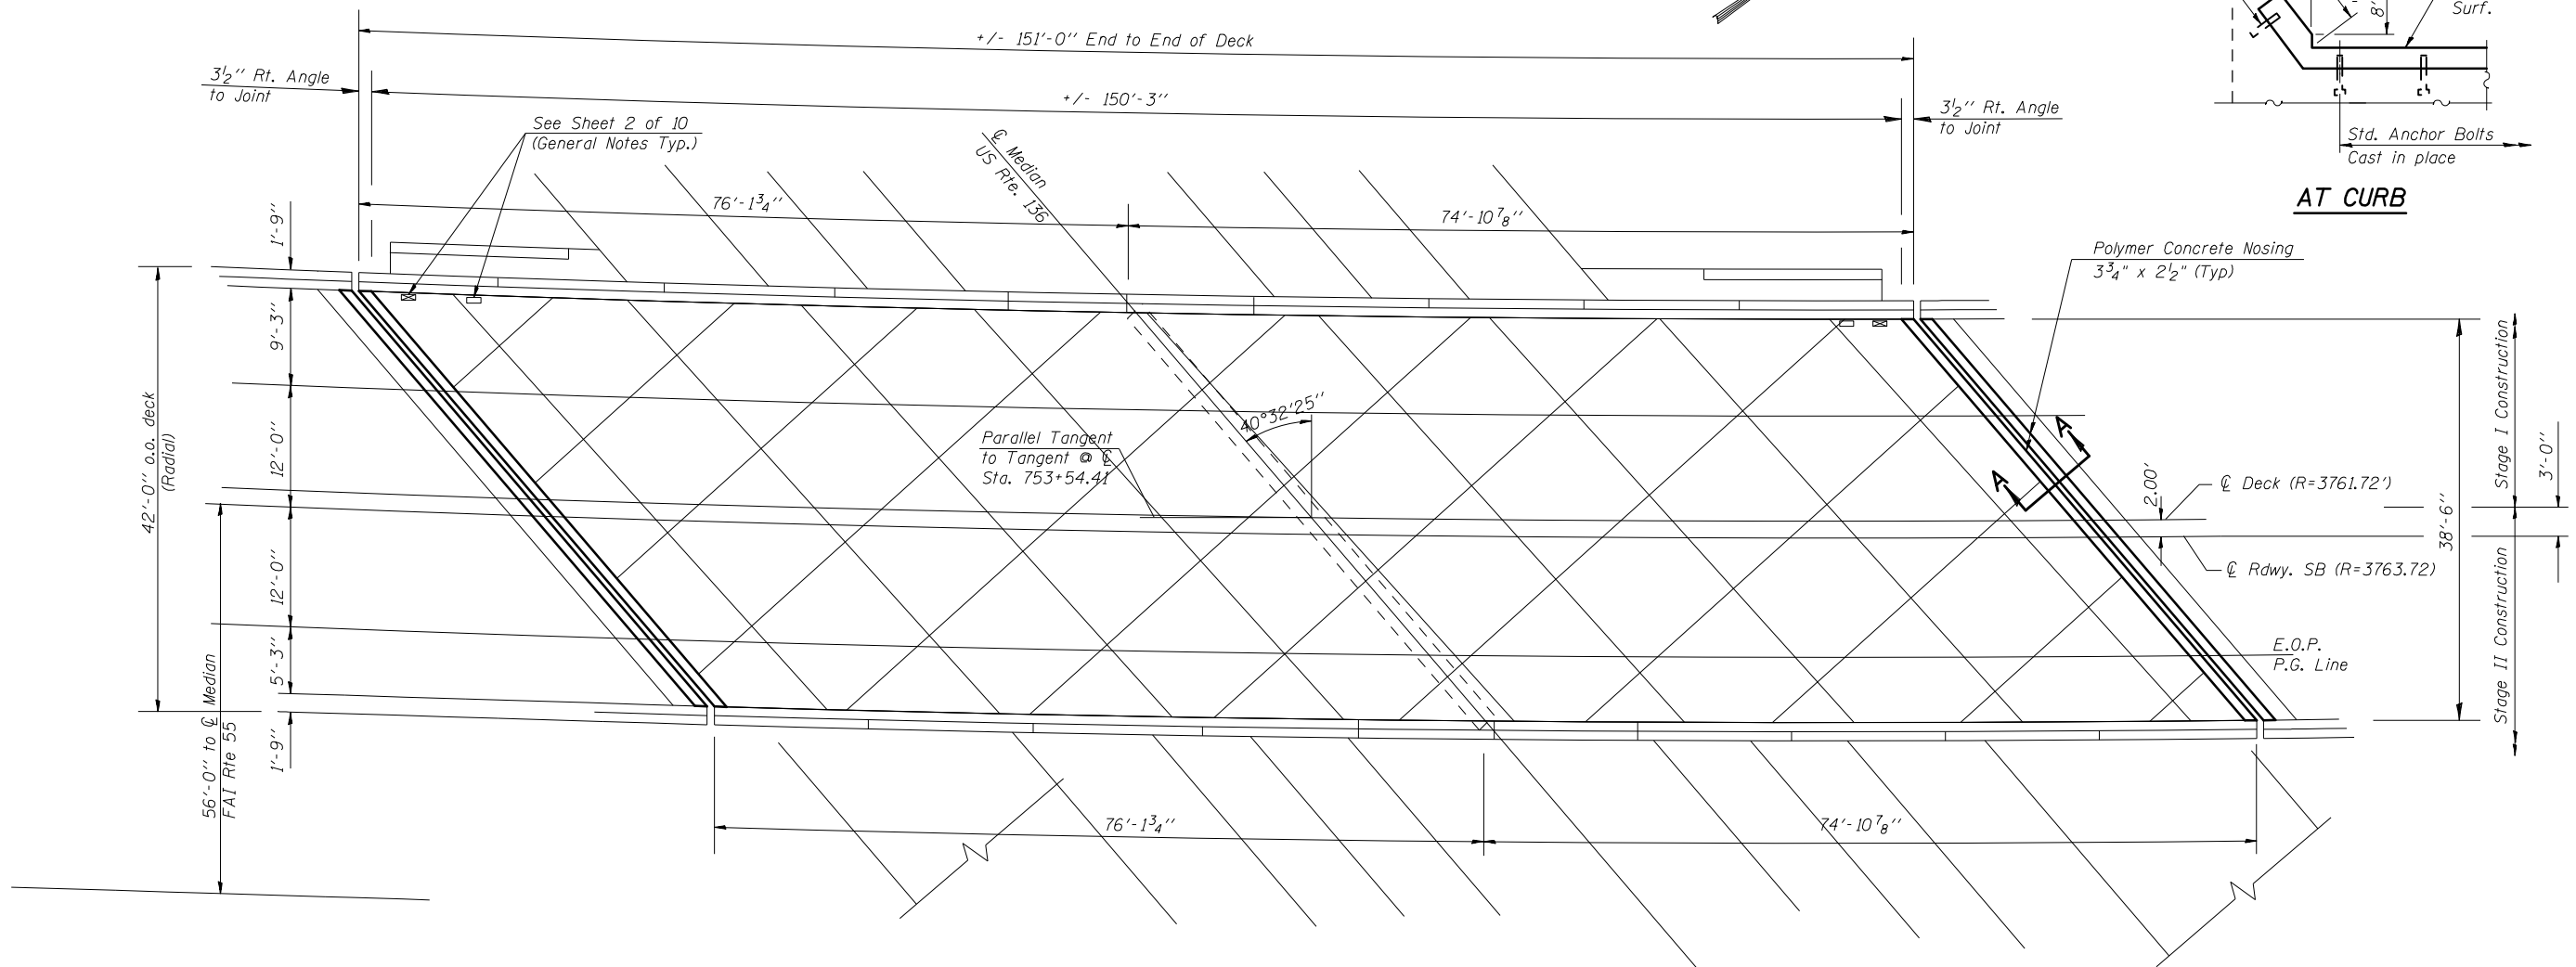

DECK TOP PLAN (MAIN SPANS)

LEGEND



Bridge Wearing Surface Removal 2 1/4"
Polymerized HMA Surface Course 2 1/4"

Notes

All transverse dimensions are radial.

Paver electronic grade control shall be operated from a preset grade control stringline. See Artical 406.06(e)

ITEM	UNIT	TOTAL
Bridge Wearing Surface Removal	Sq. Yd.	1207.8
Polymerized HMA Surface Course, II 9.5 FG, Mix D N90	Ton	152.5
Bituminous Material (Tack Coat)	Pound	545.0
Polymer Concrete	Cu. Ft.	12.5
Silicone Joint Seal 2"	Foot	106.0

MODEL: I:\MODEL\MHFS FILE: 057-0154.dgn PROJECT: I:\PROJECTS\057-0154\057-0154.dwg



USER NAME = shawleres	DESIGNED -	REVISED -
PLOT SCALE = 680,0000' / in.	DRAWN -	REVISED -
PLOT DATE = 1/23/2022	CHECKED -	REVISED -
	DATE -	REVISED -

**STATE OF ILLINOIS
DEPARTMENT OF TRANSPORTATION**

**BRIDGE WEARING SURFACE PLAN
S.N. 057-0154**

SCALE: SHEET 6 OF 10 SHEETS STA. TO STA.

F.A.I. RTE. 55	SECTION (57-10H)BR	COUNTY MCLEAN	TOTAL SHEETS 19	SHEET NO. 10
ILLINOIS FED. AID PROJECT			CONTRACT NO. 70F57	

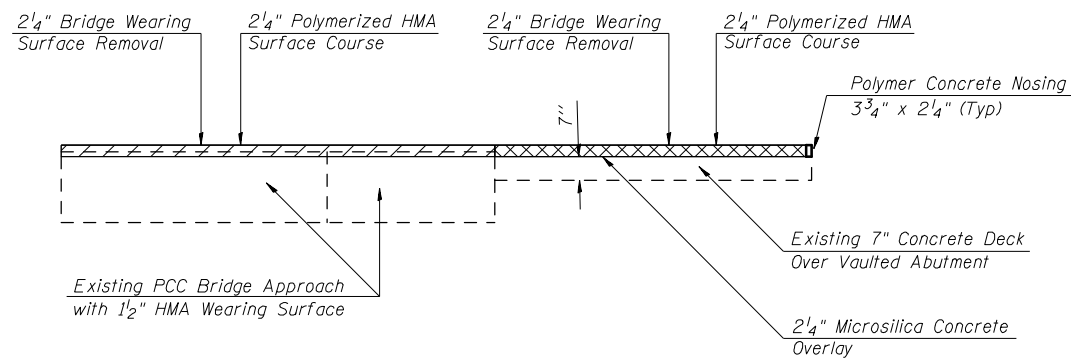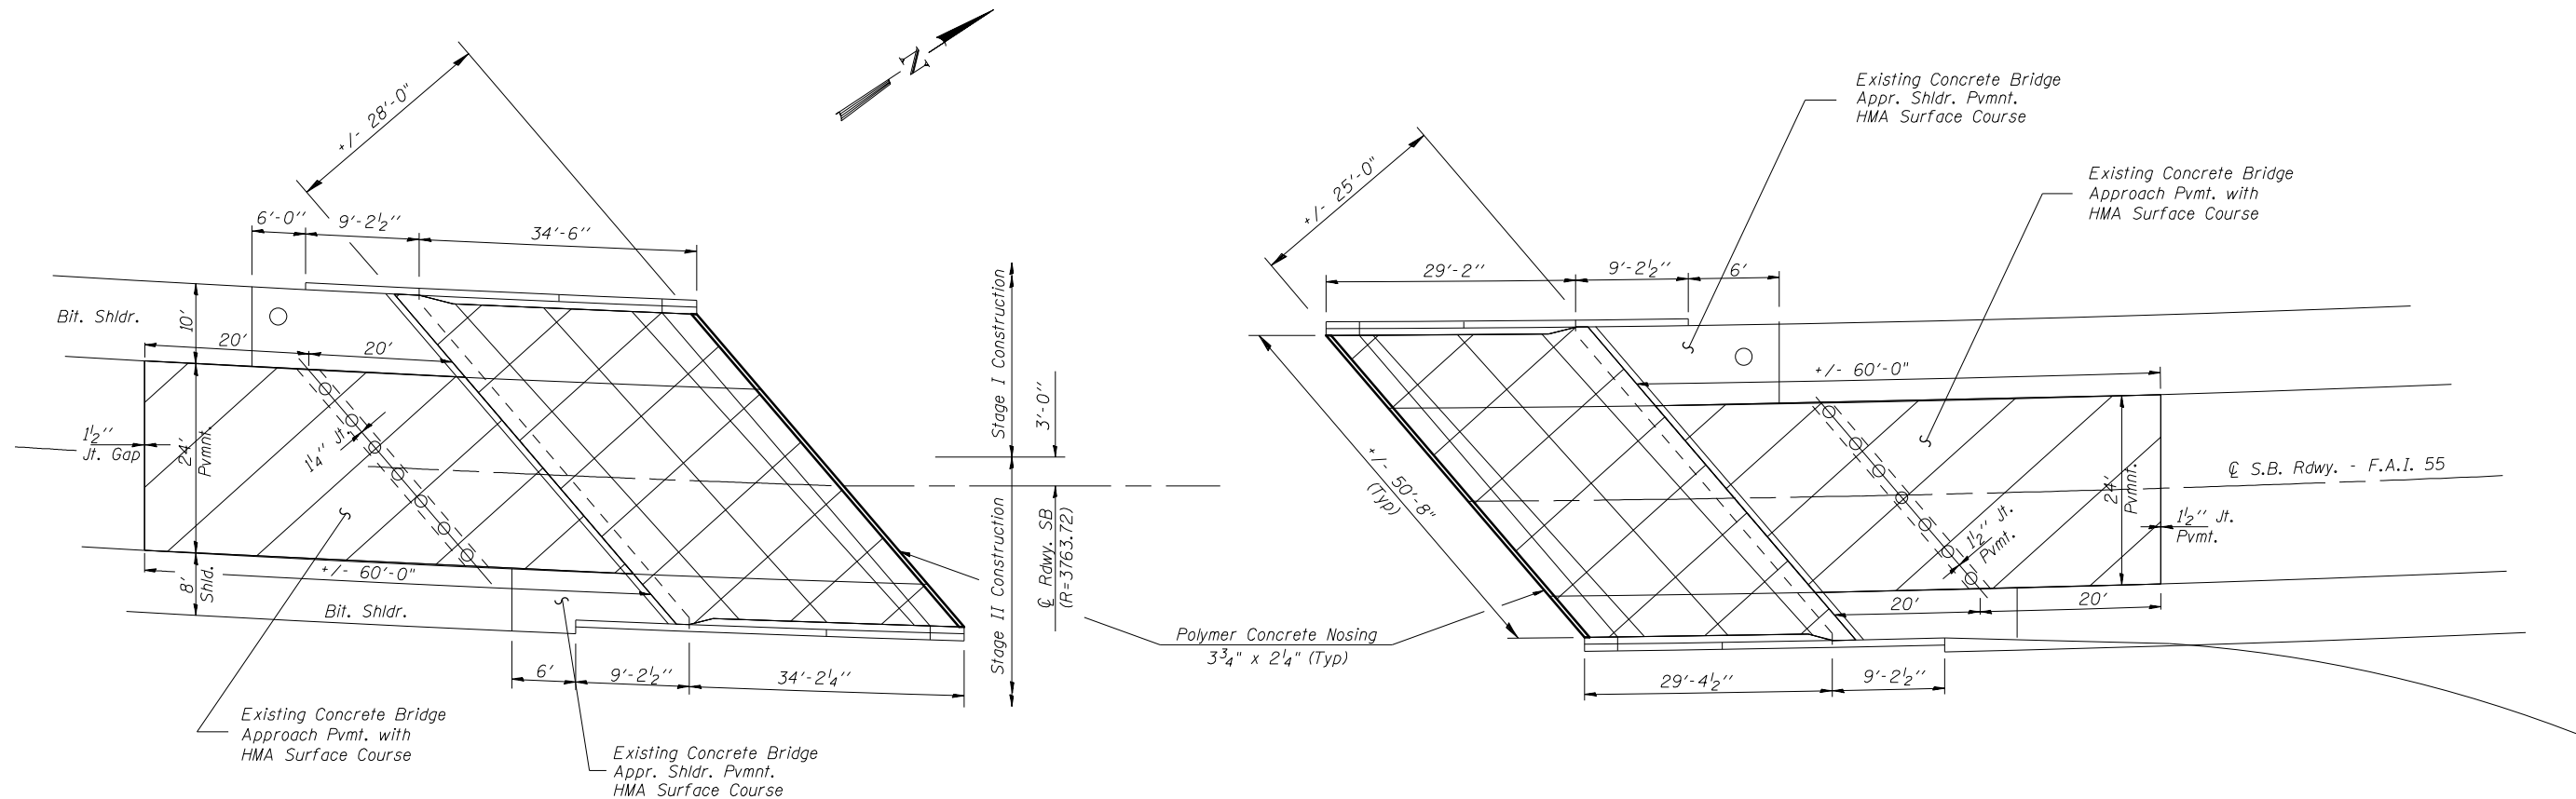

**DECK TOP PLAN
(APPROACH SPANS)**

Notes

All transverse dimensions are radial.
 Paver electronic grade control shall be operated from a preset grade control stringline, See Article 406.06(e)
 Approach Span quantities included in Table on Sheet 6 of 10.

LEGEND

- Bridge Wearing Surface Removal 2 1/4" Polymerized HMA Surface Course 2 1/4"
- Bridge Wearing Surface Removal 2 1/4" Polymerized HMA Surface Course 2 1/4"


MODEL: \\MODELS\MNMF
 FILE: \\MAILS_P\pub\lucy\paw\bea\lucy.com\PIV\DOT\Documents\DOT\Office\Dir\dr: S:\Project\057057\CAD\Drawn\CAD\Sheet\057057.dwg_057-0154.dwg

USER NAME = shawleres	DESIGNED -	REVISED -
	DRAWN -	REVISED -
PLOT SCALE = 680,0000 ' / in.	CHECKED -	REVISED -
PLOT DATE = 12/16/2021	DATE -	REVISED -

**STATE OF ILLINOIS
DEPARTMENT OF TRANSPORTATION**

APPROACH WEARING SURFACE PLAN			
S.N. 057-0154			
SCALE:	SHEET 7	OF 10 SHEETS	STA. TO STA.

F.A.I. RTE.	SECTION	COUNTY	TOTAL SHEETS	SHEET NO.
55	(57-10H)BR	MCLEAN	19	11
			CONTRACT NO. 70F57	
ILLINOIS FED. AID PROJECT				

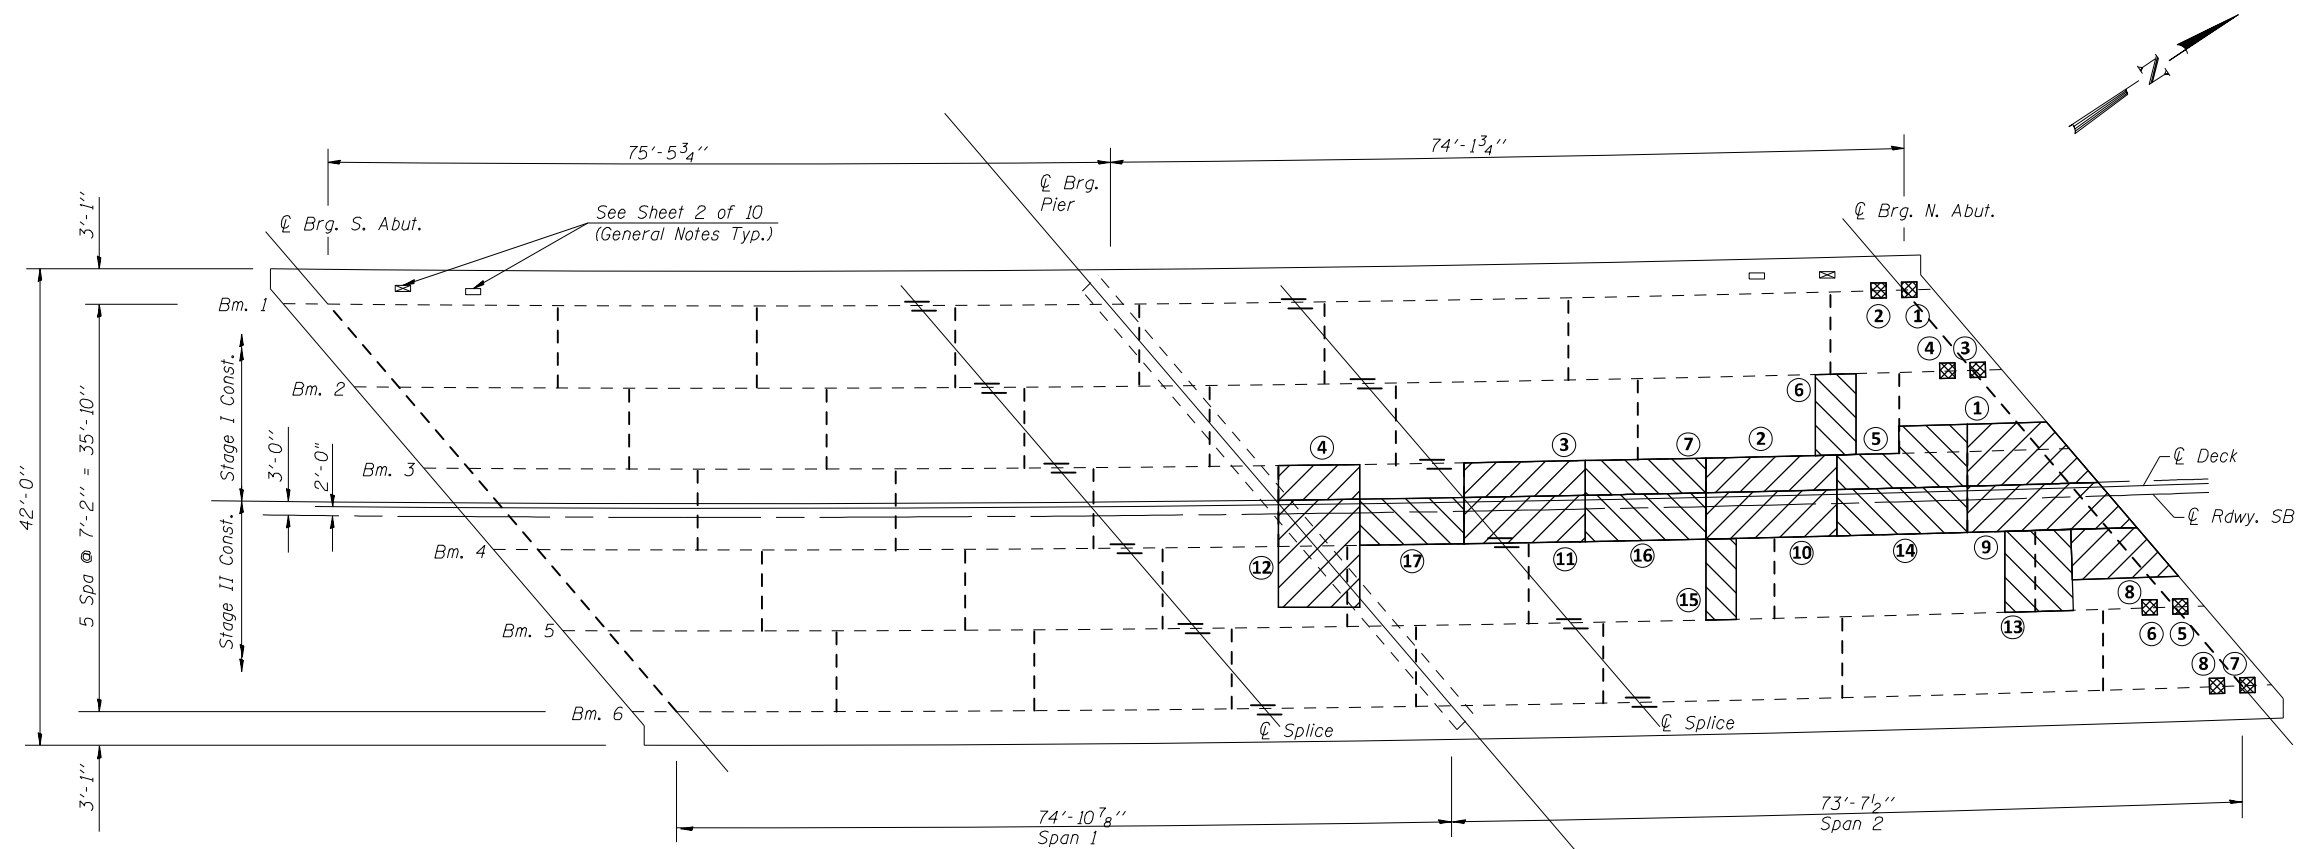




DECK PLAN

Notes

Full Depth Patching Divided into Two Pours to Maintain Slab Stability.

LEGEND

-  Deck Slab Repair (Full Depth, Type II) FIRST POUR
-  Deck Slab Repair (Full Depth, Type II) SECOND POUR
-  Deck Slab Repair (Full Depth, Type I)

Deck Slab Repair (Full Depth, Type II)

Deck Slab Repair (Full Depth, Type II)

Stud Shear Connectors (Deck Slab Repair Type I)

PATCH NO.	SIZE		DECK SLAB REPAIR (PART DEPTH)		DECK SLAB REPAIR (FD TY 1)		DECK SLAB REPAIR (FD TY 2)	
	L ft.	W ft.	SQ YD	SQ YD	SQ YD	SQ YD	SQ YD	SQ YD
1	10.0	4.583					5.1	
2	10.0	2.583					2.9	
3	9.25	2.583					2.7	
4	8.00	2.583					2.3	
5	10.0	3.583					4.0	
6	4.0	7.167					3.2	
7	10.0	2.583					2.9	
8	10.0	7.167					8.0	
9	13.0	4.583					6.6	

PATCH NO.	SIZE		DECK SLAB REPAIR (PART DEPTH)		DECK SLAB REPAIR (FD TY 1)		DECK SLAB REPAIR (FD TY 2)	
	L ft.	W ft.	SQ YD	SQ YD	SQ YD	SQ YD	SQ YD	SQ YD
10	10.0	4.583					5.1	
11	10.0	4.583					5.1	
12	8.0	10.0					8.9	
13	8.0	7.167					6.4	
14	10.0	4.583					5.1	
15	3.0	7.167					2.4	
16	10.0	4.583					5.1	
17	9.0	4.583					4.6	

PATCH NO.	SIZE		DECK SLAB REPAIR (PART DEPTH)		DECK SLAB REPAIR (FD TY 1)		DECK SLAB REPAIR (FD TY 2)	
	L ft.	W ft.	SQ YD	SQ YD	SQ YD	SQ YD	SQ YD	SQ YD
1	2.0	2.0			0.45			
2	2.0	2.0			0.45			
3	2.0	2.0			0.45			
4	2.0	2.0			0.45			
5	2.0	2.0			0.45			
6	2.0	2.0			0.45			
7	2.0	2.0			0.45			
8	2.0	2.0			0.45			

ITEM	UNIT	TOTAL
Deck Slab Repair (Full Depth Type II)	Sq. Yd.	80.4
Deck Slab Repair (Full Depth Type I)	Sq. Yd.	3.6

MODEL: \\MODELS\MAME FILE: \\MAME: \public\paw-beckley.com\PIV\DOT\Documents\DOT Office\Dir\Dir: S:\Project\057057\CADD\Drawn\CD\becks057057.dwg, 057-0154.dwg



USER NAME = shawleres	DESIGNED -	REVISED -
PLOT SCALE = 680,0000 ' / in.	DRAWN -	REVISED -
PLOT DATE = 12/16/2021	CHECKED -	REVISED -
	DATE -	REVISED -

**STATE OF ILLINOIS
DEPARTMENT OF TRANSPORTATION**

**BRIDGE DECK PATCHING PLAN
S.N. 057-0154**

SCALE: SHEET 8 OF 10 SHEETS STA. TO STA.

F.A.I. RTE.	SECTION	COUNTY	TOTAL SHEETS	SHEET NO.
55	(57-10HB)BR	MCLEAN	19	12
			CONTRACT NO. 70F57	
ILLINOIS FED. AID PROJECT				

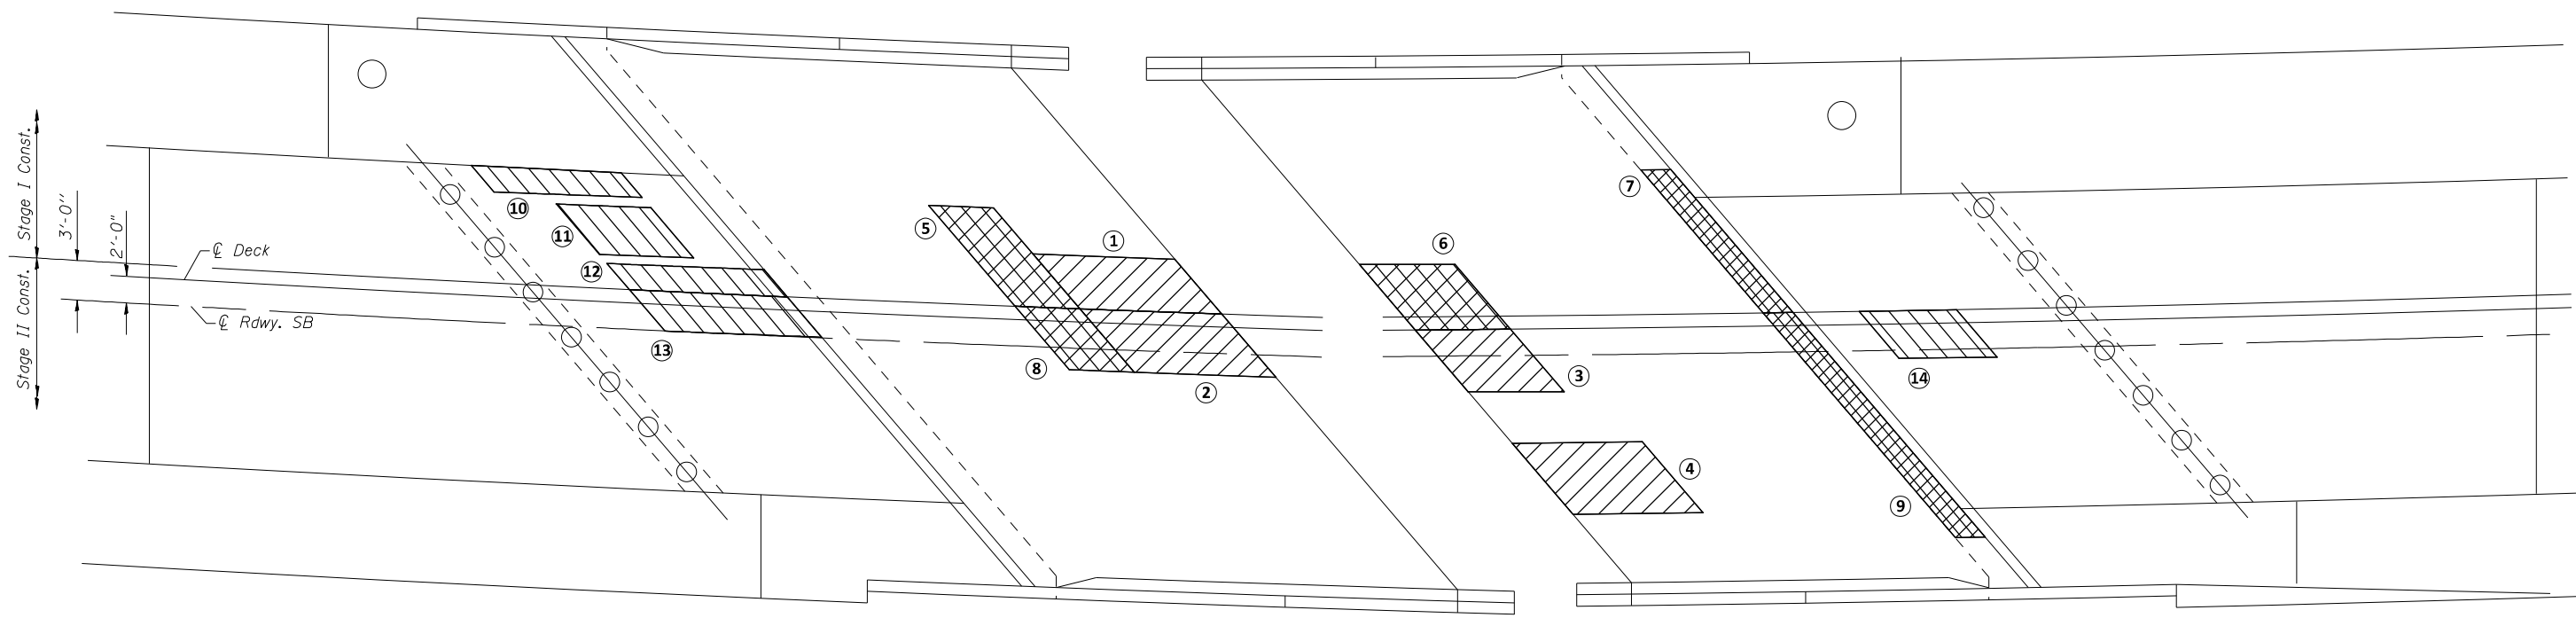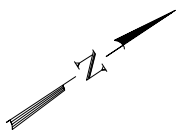

**DECK TOP PLAN
(APPROACH SPANS)**

LEGEND

- Deck Slab Repair (Full Depth, Type II)
- Deck Slab Repair (Partial)
- Approach Slab Repair (Partial Depth)

Deck Slab Repair (Full Depth, Type II)

Deck Slab Repair (Partial)

Approach Slab Repair (Partial Depth)

PATCH NO.	SIZE		DECK SLAB REPAIR (PART. DEPTH)		
	L ft.	W ft.	SQ YD	SQ YD	SQ YD
1	8.0	4.0			3.6
2	8.0	5.0			4.5
3	3.2	4.0			1.4
4	6.0	5.0			3.3

PATCH NO.	SIZE		DECK SLAB REPAIR (PART. DEPTH)		
	L ft.	W ft.	SQ YD	SQ YD	SQ YD
5	3.0	9.0	3.0		
6	3.2	4.5	1.6		
7	2.0	11.0	2.5		
8	3.0	5.0	1.7		
9	2.0	15.0	3.3		

PATCH NO.	SIZE		APPROACH SLAB REPAIR (PARTIAL DEPTH)		
	L ft.	W ft.	SQ YD	SQ YD	SQ YD
10	12.0	2.5			3.3
11	7.0	4.0			3.1
12	12.0	2.5			3.3
13	12.0	3.0			4.0
14	6.0	3.5			2.4

ITEM	UNIT	TOTAL
Approach Slab Repair (Partial Depth)	Sq. Yd.	16.1
Deck Slab Repair (Full Depth Type II)	Sq. Yd.	12.8
Deck Slab Repair (Partial)	Sq. Yd.	12.1


MODEL: \\MODEL\MAME...
 FILE: \\MAME...
 PROJECT: \\PROJECT\...
 DRAWING: \\DRAWING\...

USER NAME = shawleres	DESIGNED -	REVISED -
PLOT SCALE = 680,0000' / in.	DRAWN -	REVISED -
PLOT DATE = 11/10/2021	CHECKED -	REVISED -
	DATE -	REVISED -


**STATE OF ILLINOIS
DEPARTMENT OF TRANSPORTATION**

APPROACH PATCHING PLAN			
S.N. 057-0154			
SCALE:	SHEET 9	OF 10 SHEETS	STA. TO STA.


F.A.I. RTE.	SECTION	COUNTY	TOTAL SHEETS	SHEET NO.
55	(57-10HB)BR	MCLEAN	19	13
			CONTRACT NO. 70F57	
ILLINOIS FED. AID PROJECT				

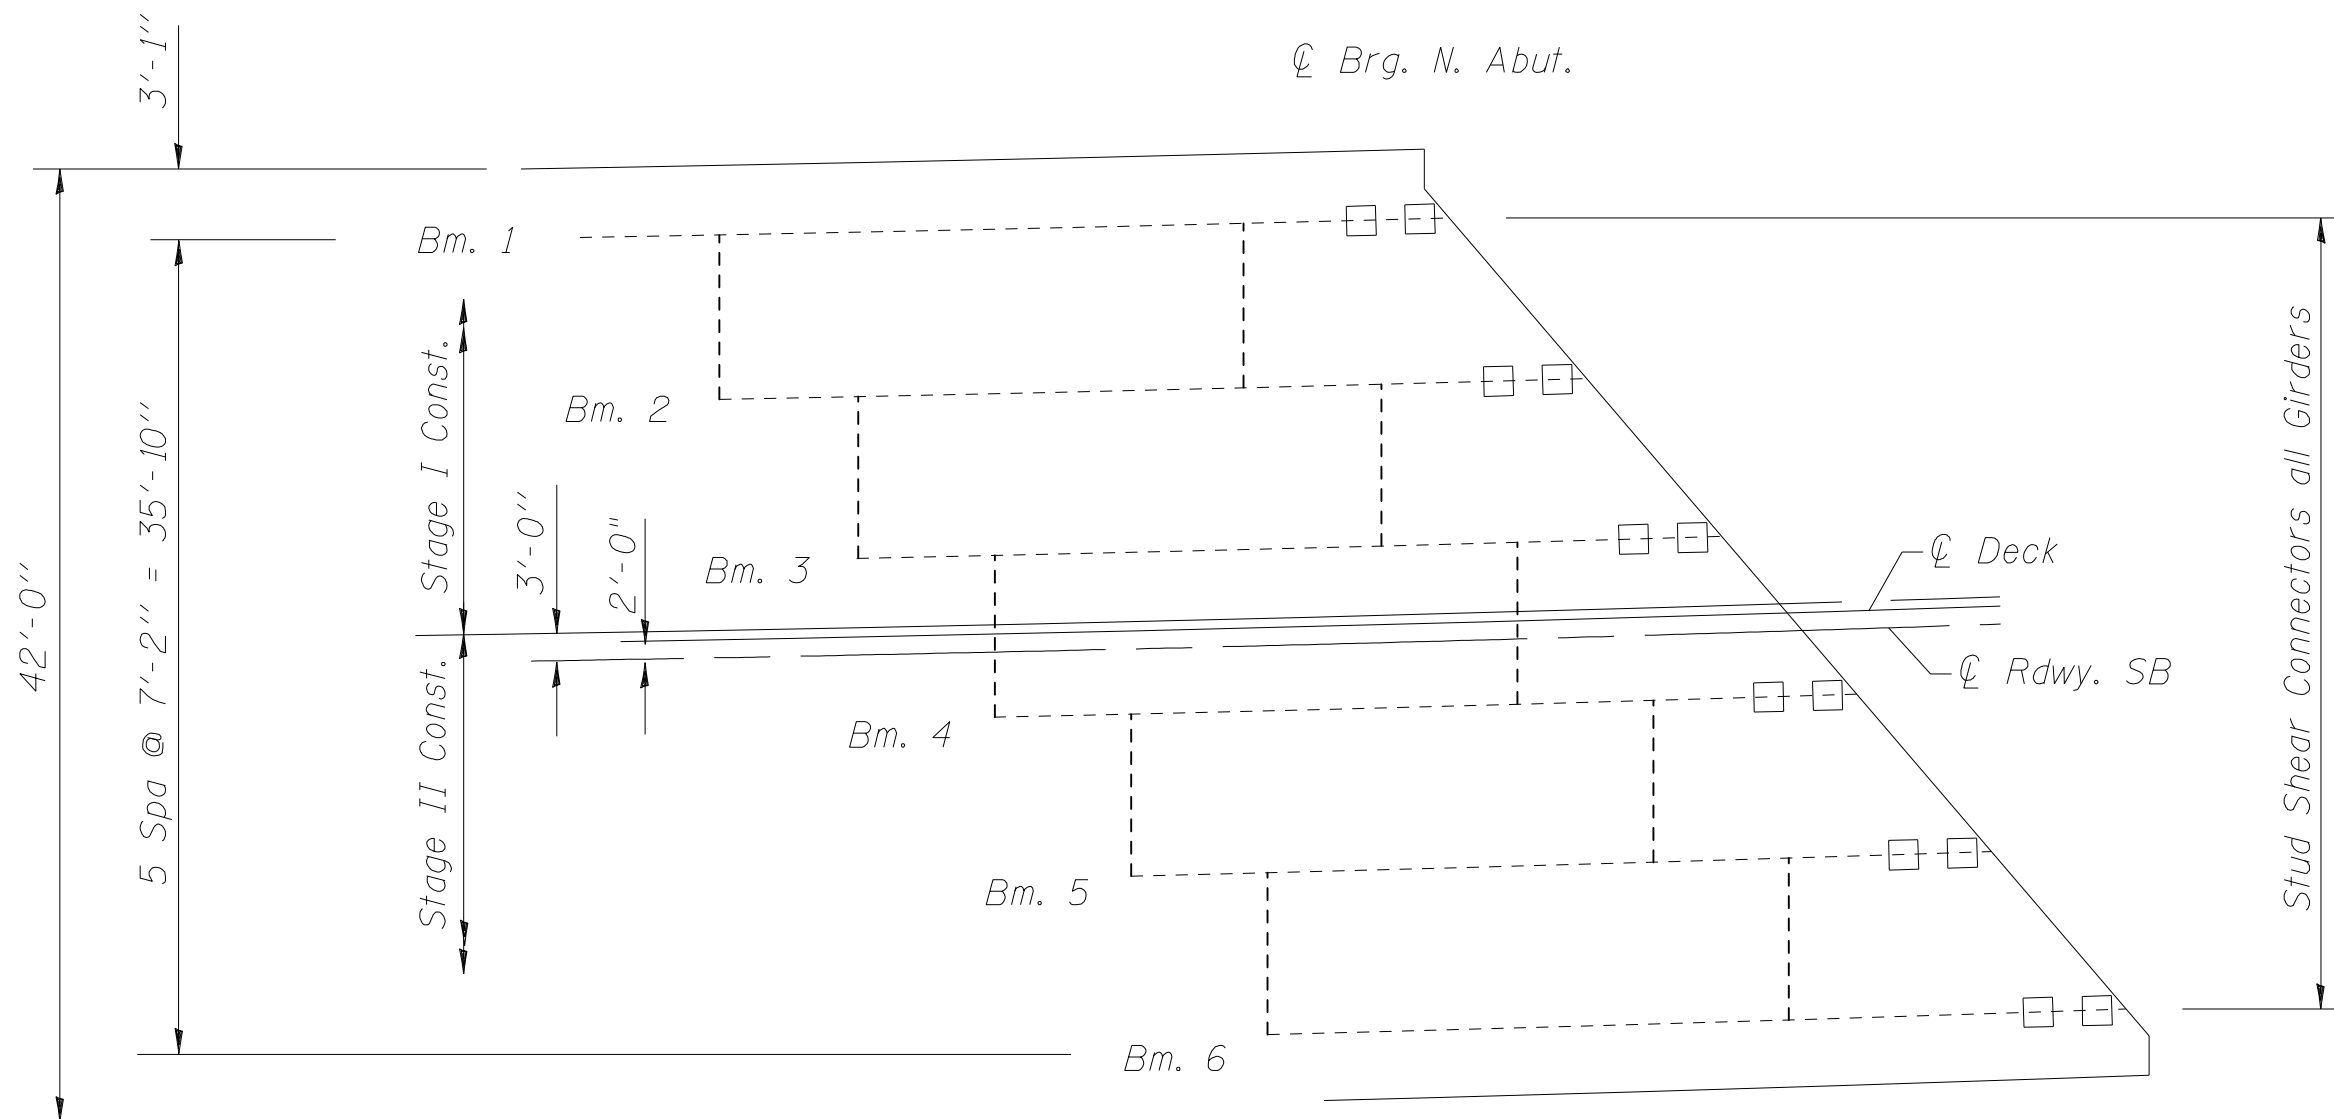

NORTH ABUTMENT PLAN

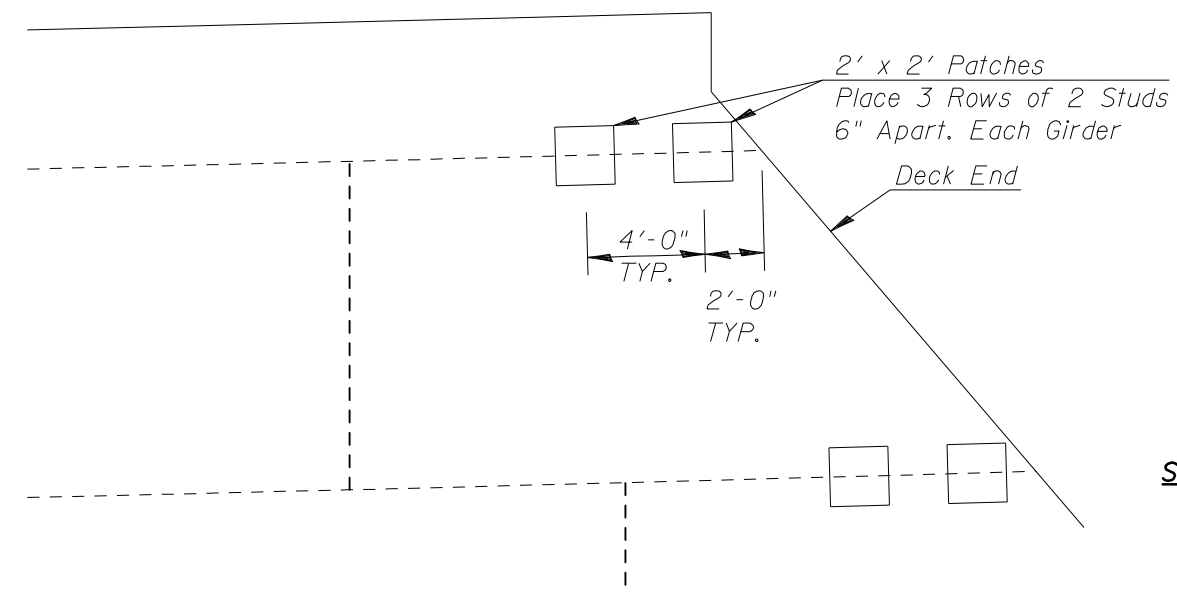


$\frac{3}{4}$ " x 5" Granular or Solid Flux Filled Headed Studs Automatically End Welded.

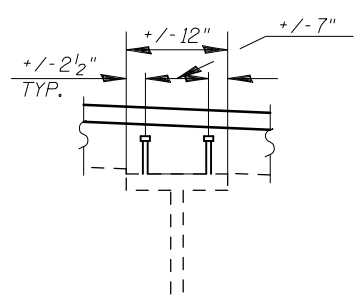

SECTION AT STUD LOCATIONS

SECTION ALONG GIRDER AT STUD LOCATIONS

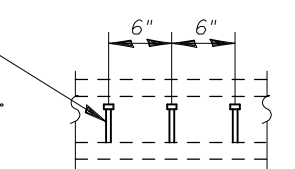

Notes
Patch quantities included in Table on Sheet 6 of 10.

ITEM	UNIT	TOTAL
Stud Shear Connectors	Each	72.0

MODEL: I:\MODEL\MAME FILE: MAME: p:\pub\cpx\beam\com\p\INDOT\Documents\DOT\Office\Dir\dir: S:\Project\057057\CAD\Drawn\CAD\sheet\057057.dwg, 057-0154.dgn

USER NAME = shawleres	DESIGNED -	REVISED -
	DRAWN -	REVISED -
PLOT SCALE = 680,0000 ' / in.	CHECKED -	REVISED -
PLOT DATE = 11/10/2021	DATE -	REVISED -



**STATE OF ILLINOIS
DEPARTMENT OF TRANSPORTATION**

**STUD SHEAR CONNECTORS DETAIL
S.N. 057-0154**

SCALE: SHEET 10 OF 10 SHEETS STA. TO STA.

F.A.I. RTE.	SECTION	COUNTY	TOTAL SHEETS	SHEET NO.
55	(57-10HB)BR	MCLEAN	19	14
			CONTRACT NO. 70F57	
		ILLINOIS	FED. AID PROJECT	

STRIPING DETAIL
STRUCTURE 057-0154 (SBL)

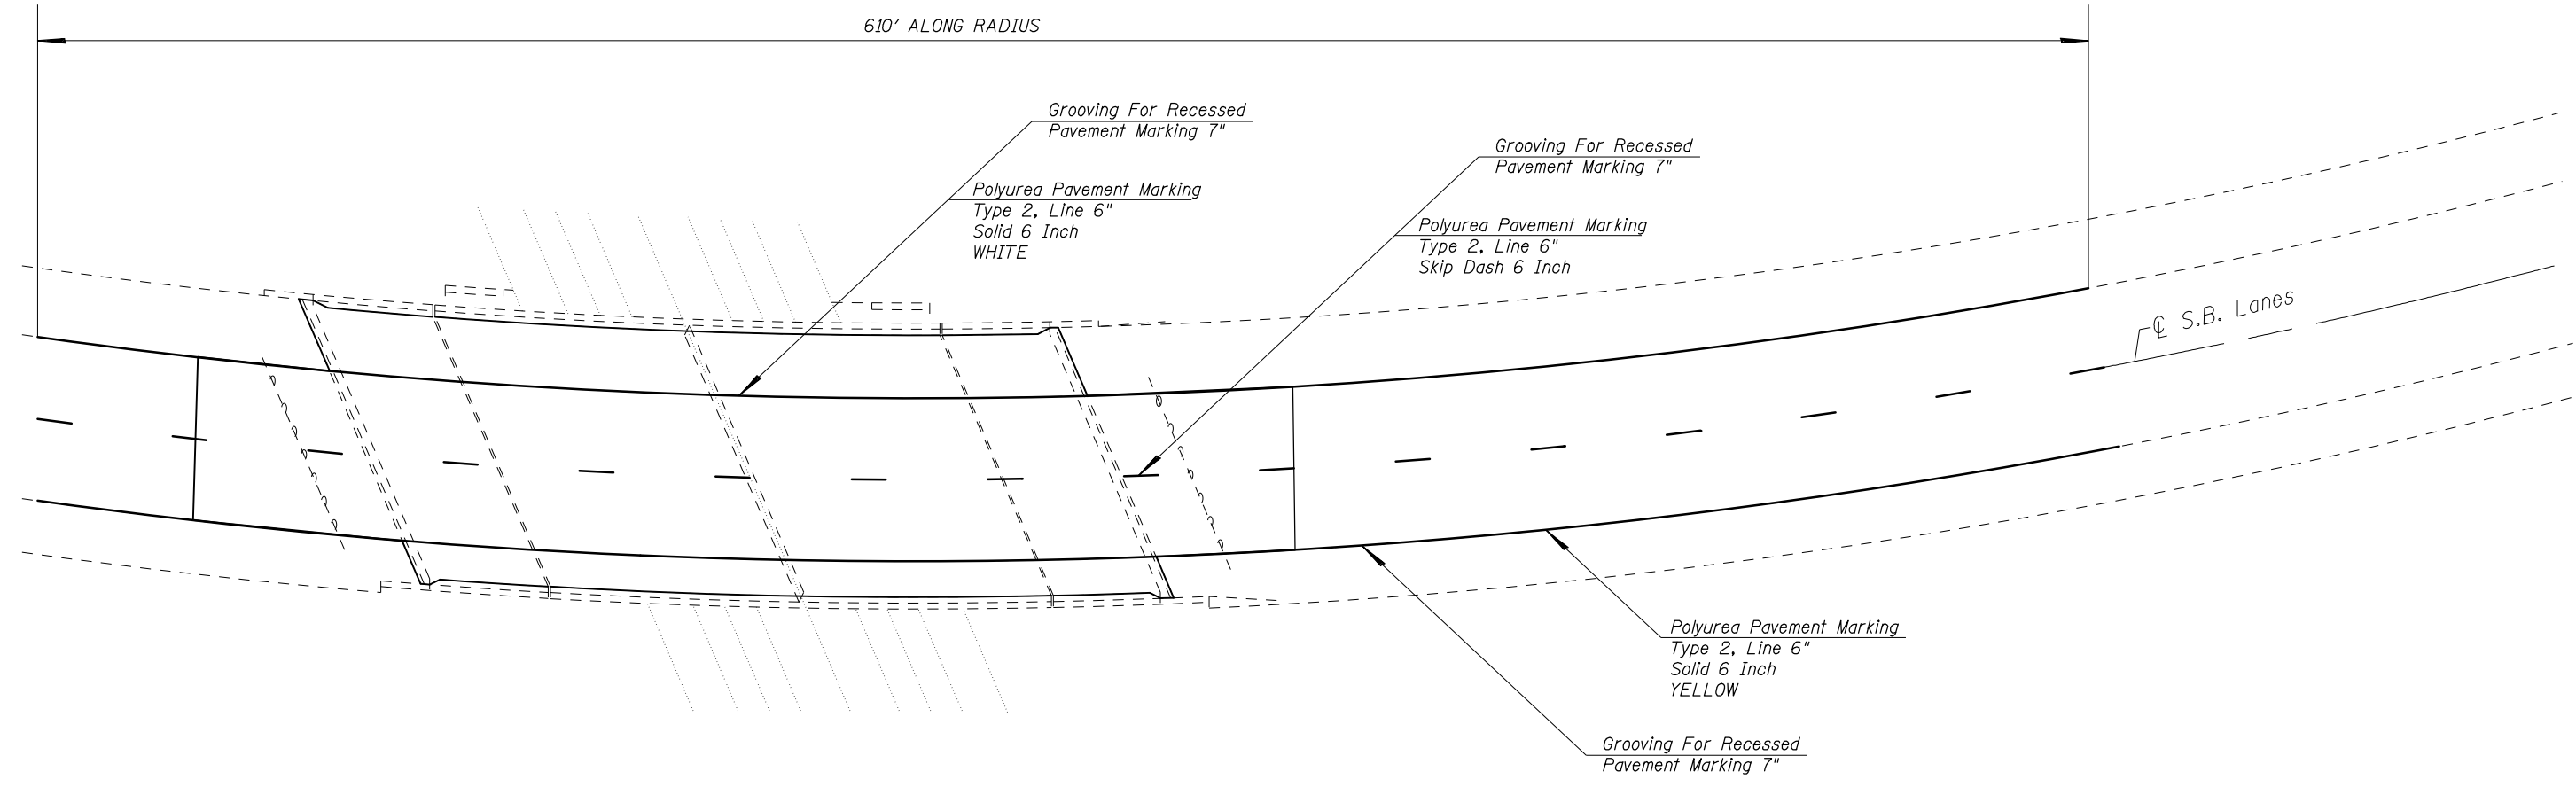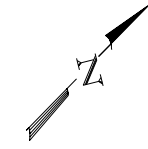

ITEM	UNIT	TOTAL
Polyurea Pavement Marking, Type 2, Line 6"	Foot	1,380.0
Grooving for Recessed Pavement Marking 7"	Foot	1,380.0

MODEL: \\MODEL\MAME
 FILE: \\MAILS_P\public\paw_bentley.com\PIV\DOT\Documents\DOT_Offices\Dir\rdt_5\Project\0570154\CADD\Drawn\CAD\Sheets\0570154_sbl_east.dgn

USER NAME = shawleres	DESIGNED -	REVISED -
	DRAWN -	REVISED -
PLOT SCALE = 1000.0000' / in.	CHECKED -	REVISED -
PLOT DATE = 11/10/2021	DATE -	REVISED -


**STATE OF ILLINOIS
DEPARTMENT OF TRANSPORTATION**

**STRIPING DETAIL
S.N. 057-0154 SB**

SCALE: SHEET 1 OF 1 SHEETS STA. TO STA.

F.A.I. RTE.	SECTION	COUNTY	TOTAL SHEETS	SHEET NO.
55	(57-10HB)BR	MCLEAN	19	15
ILLINOIS FED. AID PROJECT			CONTRACT NO. 70F57	

STAGE I (SBL)
STRUCTURE 057-0154

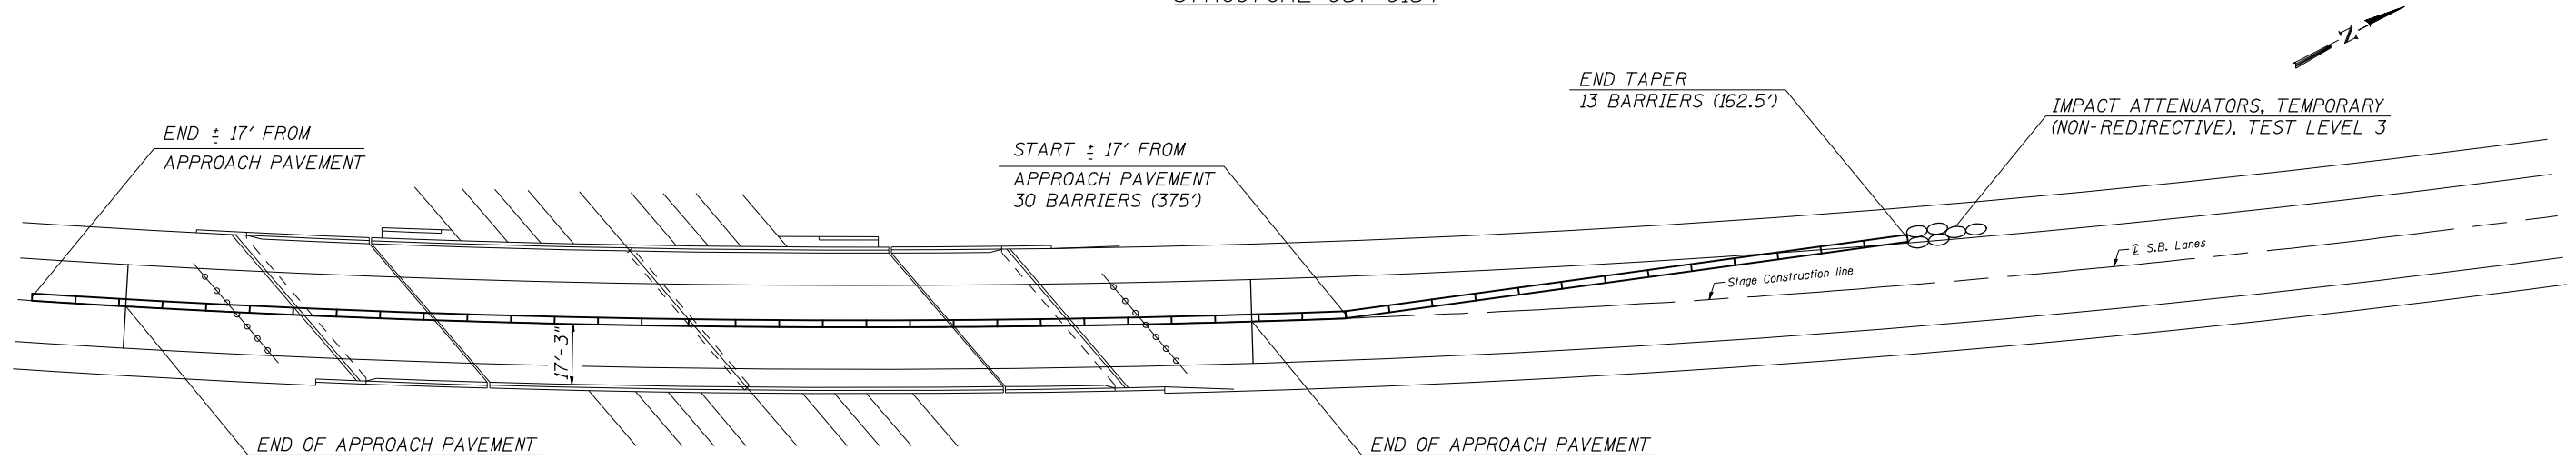

PLAN NOTES:

ALL STAGING DETAILS SHALL BE IN ACCORDANCE WITH TRAFFIC CONTROL AND PROTECTION STANDARD 701402 AND PAID FOR AT THE CONTRACT UNIT PRICE PER EACH LOCATION.

ALL WORK WITHOUT TEMPORARY CONCRETE BARRIER IN PLACE SHALL BE IN ACCORDANCE WITH TRAFFIC CONTROL AND PROTECTION STANDARDS 701400 AND 701401.


FOR ADDITIONAL DETAILS ASSOCIATED WITH TEMPORARY CONCRETE BARRIER, SEE HIGHWAY STANDARD 701402.

REFLECTOR SHALL BE ATTACHED TO GUARDRAIL AND BARRIER WALL AT 25 FOOT CENTERS. COST TO BE INCLUDED WITH TRAFFIC CONTROL AND PROTECTION STANDARD 701402.

REFLECTORIZED TEMPORARY MARKING TAPE SHALL BE PLACED THROUGHOUT THE TAPER, AND ALONGSIDE BOTH SIDES OF THE WORK AREA. EXISTING MARKINGS THAT CONFLICT WITH THE STAGED TRAFFIC MARKINGS SHALL BE REMOVED OR COVERED. COST TO REMOVE EXISTING MARKINGS AND FOR THE PLACEMENT AND REMOVAL OF TEMPORARY MARKINGS SHALL BE INCLUDED WITH TRAFFIC CONTROL AND PROTECTION STANDARD 701402.

ITEM	UNIT	TOTAL
Temporary Concrete Barrier	Foot	537.5
Impact Attenuators, Temporary (Non-Redirective), Test level 3	Each	1.0
Pinning Temporary Concrete Barrier	Each	12.0

STAGE II (SBL)
STRUCTURE 057-0154

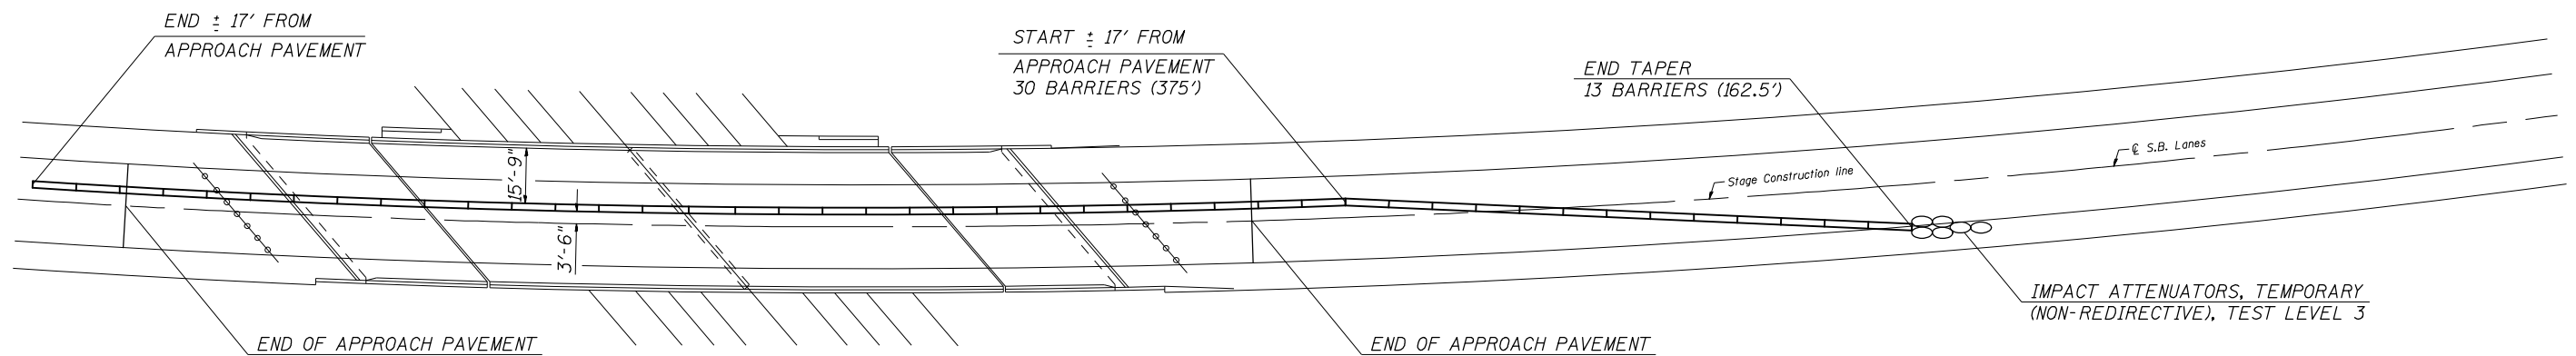

PLAN NOTES:

ALL STAGING DETAILS SHALL BE IN ACCORDANCE WITH TRAFFIC CONTROL AND PROTECTION STANDARD 701402 AND PAID FOR AT THE CONTRACT UNIT PRICE PER EACH LOCATION.

ALL WORK WITHOUT TEMPORARY CONCRETE BARRIER IN PLACE SHALL BE IN ACCORDANCE WITH TRAFFIC CONTROL AND PROTECTION STANDARDS 701400 AND 701401.

FOR ADDITIONAL DETAILS ASSOCIATED WITH TEMPORARY CONCRETE BARRIER, SEE HIGHWAY STANDARD 701402.

REFLECTOR SHALL BE ATTACHED TO GUARDRAIL AND BARRIER WALL AT 25 FOOT CENTERS. COST TO BE INCLUDED WITH TRAFFIC CONTROL AND PROTECTION STANDARD 701402.

REFLECTORIZED TEMPORARY MARKING TAPE SHALL BE PLACED THROUGHOUT THE TAPER, AND ALONGSIDE BOTH SIDES OF THE WORK AREA. EXISTING MARKINGS THAT CONFLICT WITH THE STAGED TRAFFIC MARKINGS SHALL BE REMOVED OR COVERED. COST TO REMOVE EXISTING MARKINGS AND FOR THE PLACEMENT AND REMOVAL OF TEMPORARY MARKINGS SHALL BE INCLUDED WITH TRAFFIC CONTROL AND PROTECTION STANDARD 701402.

ITEM	UNIT	TOTAL
Relocate Temporary Concrete Barrier	Foot	537.5
Impact Attenuators, Relocate (Non-Redirective), Test level 3	Each	1.0
Pinning Temporary Concrete Barrier	Each	12.0

MODEL: \\MODEL\NAME
 FILE: NAME.dwg
 PLOT DATE: 11/10/2021

USER NAME = shawleres	DESIGNED -	REVISED -
PLOT SCALE = 1000.0000' / in.	DRAWN -	REVISED -
PLOT DATE = 11/10/2021	CHECKED -	REVISED -
	DATE -	REVISED -

STATE OF ILLINOIS
DEPARTMENT OF TRANSPORTATION

TEMPORARY BARRIER WALL		F.A.I. RTE.:	SECTION	COUNTY	TOTAL SHEETS	SHEET NO.
S.N. 057-0154 SB		55	(57-10HB)BR	MCLEAN	19	16
SCALE:		SHEET 1 OF 1 SHEETS		CONTRACT NO. 70F57		
		STA. TO STA.		ILLINOIS FED. AID PROJECT		

ROUTE NO.	SECTION	COUNTY	TOTAL SHEETS	SHEET NO.
F.A.I. 55		McLEAN	163	1

ILLINOIS
*57-8, 57-9, 57-10) RS & I


98%
8-24-2002
179

057-0154 & -0155



INDEX OF SHEETS

NO.	TITLE
1.	COVER SHEET
2.	GENERAL NOTES & STANDARDS
3.-4.	SUMMARY OF QUANTITIES
5.-9.	TYPICAL SECTIONS
10.-13.	SCHEDULES
14.-44.	PLAN VIEW
45.-47.	PAVEMENT MARKING
48.-49.	RETAINING WALLS
50.-75.	S.N. 057-0154 & S.N. 057-0155
76.-84.	S.N. 057-0156
85.-109.	S.N. 057-0157 & S.N. 057-0158
110.-128.	S.N. 057-0159 & S.N. 057-0160
129.-135. B	DETAILS
136.-163.	CROSS SECTIONS

STATE OF ILLINOIS
DEPARTMENT OF TRANSPORTATION
DIVISION OF HIGHWAYS
**PLANS FOR PROPOSED
FEDERAL AID HIGHWAY**
F.A.I. 55 (I-55)
SECTION (57-8, 57-9, 57-10) RS & I
PROJECT IM-55-4 (161)141
McLEAN COUNTY
C-93-043-00

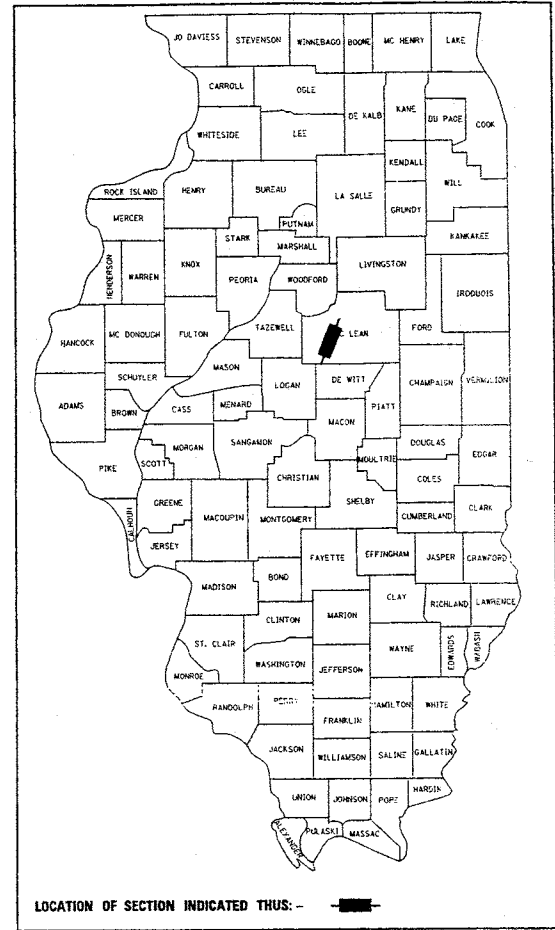


2001 ADT = 25,100
P.C. = 73.1% S.U. = 2.6% M.U. = 24.3%
DESIGN DESIGNATION - INTERSTATE

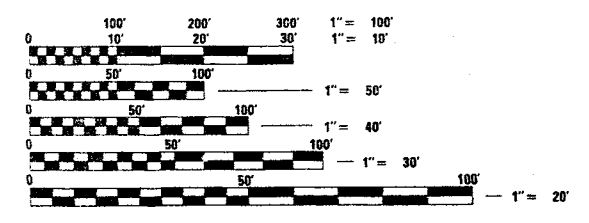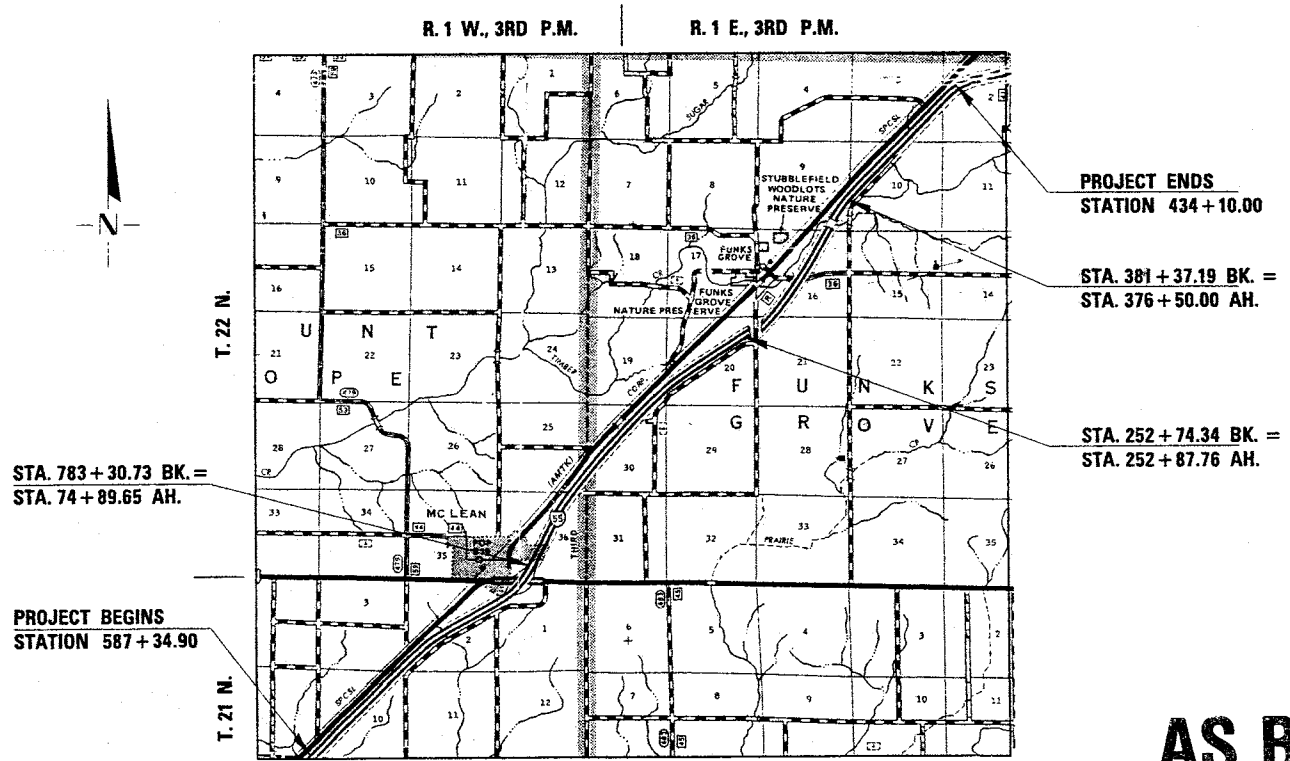

FULL SIZE PLANS HAVE BEEN PREPARED USING STANDARD ENGINEERING SCALES, REDUCED SIZED PLANS WILL NOT CONFORM TO STANDARD SCALES, IN MAKING MEASUREMENTS ON REDUCED PLANS, THE ABOVE SCALES MAY BE USED.

J.U.L.I.E.
JOINT UTILITY LOCATION INFORMATION FOR EXCAVATION
1-800-892-0123

PROJECT ENGR: RAY MULHOLLAND UNIT CHIEF: MARIE VERDINE
FUNKS GROVE TOWNSHIP, MOUNT HOPE TOWNSHIP
CONTRACT NO. 86992

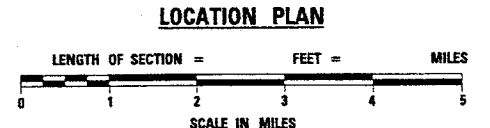

Ozyurt and Stone, Inc.
CONSULTING ENGINEERS
SPRINGFIELD, IL.

AS BUILT

Ray Mulholland 1/4/5/00
ILLINOIS PROFESSIONAL NO. 43408



STATE OF ILLINOIS
DEPARTMENT OF TRANSPORTATION
DIVISION OF HIGHWAYS
SUBMITTED JANUARY 9, 2008
James J. Jank DISTRICT ENGINEER
2008
ENGINEER OF PROJECT DEVELOPMENT AND IMPLEMENTATION
February 2, 2008
Michael Rhine ENGINEER OF DESIGN AND ENVIRONMENT
February 2, 2008
James P. Steh DIRECTOR, DIVISION OF HIGHWAYS


3-219

S.N. 057-0155 (Northbound Lanes)
 Benchmark No. 1. Top of Existing Pavement at
 Left Edge of NB Lane (P.G. Line) at Sta. 752+82.00
 at Bk. of South Appr. Bent of S.N. 057-0155. Assumed
 Elev. = 717.15 = Plan Elev.

S.N. 057-0154 (Southbound Lanes)
 Benchmark No. 2. Top of Existing Pavement at
 Left Edge of SB Lane (P.G. Line) at Sta. 754+25.06
 at Bk. of North Appr. Bent of S.N. 057-0154. Assumed
 Elev. = 717.14 = Plan Elev.

Existing Structure
 Two span continuous structure with steel beams. PPC I-beams on vaulted
 abutments and reinforced column concrete piers. S.N. 057-0154 & S.N. 057-0155.
 The rehabilitation work is done by utilizing staged construction.

FAI RTE NO.	SECTION	COUNTY	TOTAL SHEETS	SHEET NO.
FAI 55	**	McLEAN	163	50
FED. RD. DIST. NO.	ILLINOIS	FED. AID PROJECT		
** (57-8, 57-9, 57-10) RS & I Sheet No. 1 26 Sheets				

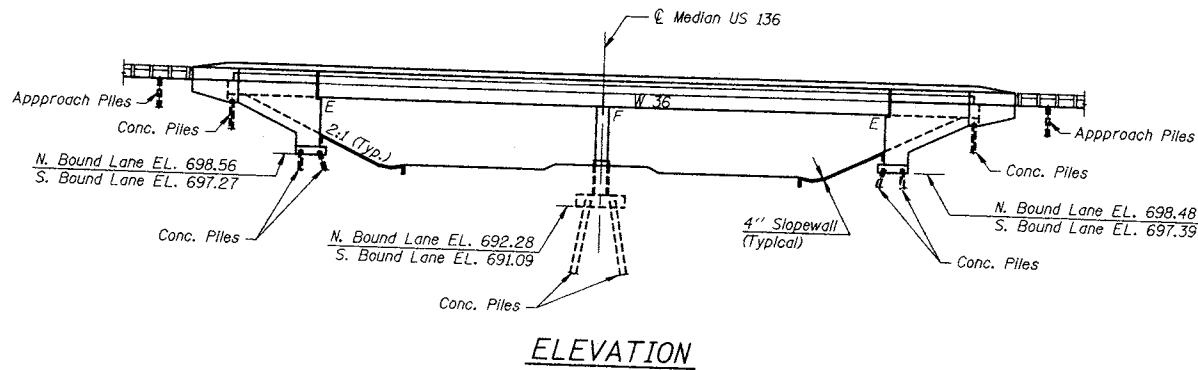

DESIGN STRESSES & LOADING (ORIGINAL CONST.)

Live Load HS20-44 & Alt. (1969 AASHTO Specification)
 Dead Load Included additional 25 psf for future wearing surface.
 $f'_c = 1,400$ psi (Substructure & (GM) Parapet)
 $f'_c = 1,200$ psi (Superstructure)
 $V_c = 75$ psi (Footings)
 $f_s = 20,000$ psi (Reinforced Bars Field)
 $f_s = 20,000$ psi (Structural Steel A-36)
 $n = 10$
 $f'_a = 5,000$ psi (Prestressed Beams)
 $f'_a = 4,000$ psi (Prestressed Beams)
 $f'_s = 248,000$ psi (Prestressed Strands)
 $f'_s = 173,600$ psi (Prestressed Strands)

NEW CONSTRUCTION

DESIGN SPECIFICATIONS


1996 AASHTO, with 1997 and 1998 interim specification.

LOADING HS 20-44 & Alt.

Allow 25#/sq.ft for future wearing surface


DESIGN STRESSES

$f'_c = 1,400$ psi (Concrete)
 $f_s = 24,000$ psi (Reinforcement bars)
 $f_s = 20,000$ psi (Structural Steel)

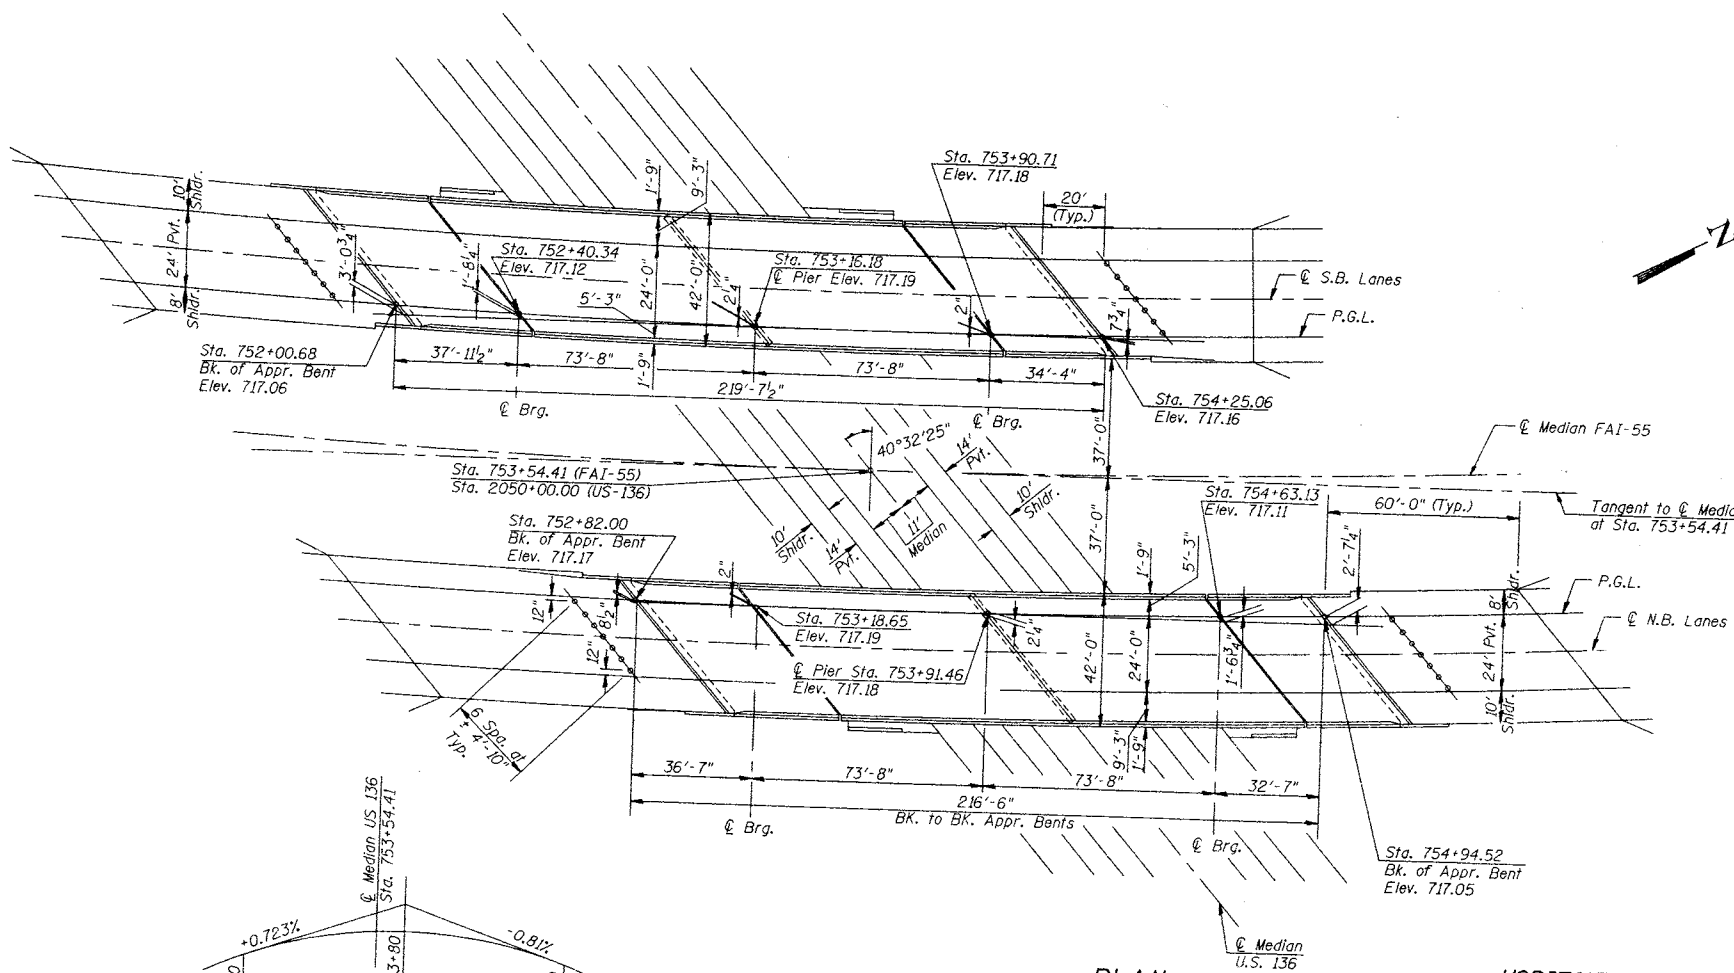

**HORIZONTAL CURVE DATA
 FAI ROUTE 55**

P.I. STA. 752+80.19
 $\Delta = 40^\circ 33' 58''$
 $D = 1^\circ 30'$
 $R = 3,819.72'$
 $T = 1,411.67'$
 $L = 2,704.41'$
 $E = 252.51'$
 $SE = 0.042$ ft/ft

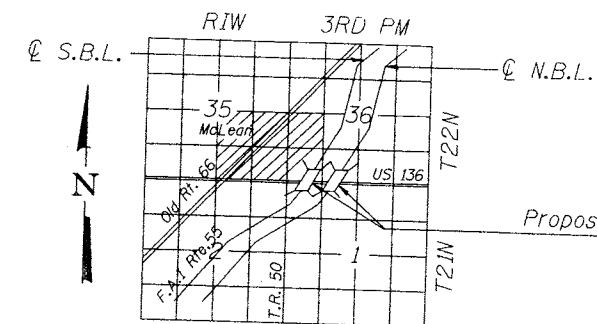

PROPOSED REHABILITATION WORK

- Remove the I-II wearing surface and waterproofing membrane system.
- Patch the deck as needed.
- Repair the delaminated, spalled and cracked areas of the parapet.
- Scarify the deck surface to a depth of 0.50 inches.
- Overlay the deck with a 2.25 inch depth microsilica overlay.
- Replace the neoprene expansion joints.
- Repair beam bottom flange impact area.
- Repair deck overhang spall and delamination areas with polymer modified portland cement mortar.
- Rehabilitate abutment expansion bearings.
- Plug deck drains within 10 feet of piers and abutment expansion joints. Extend remaining drains.
- Repair erosion and place broken concrete along the exterior of the abutment wing.
- Increase height of pier crashwalls.
- Repair substructure concrete using formed concrete repair & epoxy injection.
- Fill gaps between slopewall and abutment with controlled low strength material.

STAGES WERE SWITCHED
 REHAB WORK ON JOINTS
 WAS COMPLETED AS PER
 PLAN STAGES LINES. THE
 MICRO SILICA STAGE JOINT
 MATCHES & OF ROADWAY

PROFILE GRADE (FAI 55)
 (Top of overlay @ median edge of Pvt.)
 The profile grade is 0.02 ft above the
 existing profile grade.



Paul B. Sta.
 Illinois Structural No. 4419
 Date: 12-8-10

REVISIONS

NAME	DATE

LIN ENGINEERING, LTD.
 200 W. Chestnut
 (217) 483-8529
 Desiged By: STD
 Checked By: KRJ
 Date: 10/00
 File: COVERSHEET.DGN

ILLINOIS DEPARTMENT OF TRANSPORTATION
GENERAL PLAN & ELEVATION
F.A.I. 55 OVER U.S. ROUTE 136
SECTION (57-8, 57-9, 57-10) RS & I
McLEAN COUNTY
STATION 753+54.41
S.N. 057-0154 & 057-0155

FAI RTE NO.	SECTION	COUNTY	TOTAL SHEETS	SHEET NO.
FAI 55	**	MCLEAN	163	51
FED. RD. DIST. NO.	ILLINOIS	FED. AID PROJECT		
		** (57-8, 57-9, 57-10) RS & I	Sheet No. 2	
			26 Sheets	

TOTAL BILL OF MATERIAL

ITEM	UNIT	SUPER	SUB	TOTAL
BITUMINOUS CONCRETE REMOVAL (DECK)	SQ. YD.	1869	--	1869
CONCRETE REMOVAL	CU. YD.	31.6	--	31.6
NEOPRENE EXPANSION JOINT 2"	FOOT	212	--	212
CONCRETE SUPERSTRUCTURE	CU. YD.	36.6	--	36.6
FORMED CONCRETE REPAIR (DEPTH ≤5")	SQ. FT.	121	47	168
FURNISHING & ERECTING STRUCTURAL STEEL	POUNDS	4700	--	4700
JACK & REMOVE EXISTING BEARINGS	EACH	24	--	24
REINFORCEMENT BARS, EPOXY COATED	POUNDS	4620	350	4970
EPOXY CRACK SEALING	FOOT	45	97	142
POLYMER MODIFIED PORTLAND CEMENT MORTAR	SQ. FT.	1	--	1
BAR SPLICERS	EACH	48	--	48
CONTROLLED LOW-STRENGTH MATERIAL	CU. YD.	0.5	2	2.5
DECK SLAB REPAIR (PARTIAL)	SQ. YD.	191	--	191
BRIDGE DECK MICROSILICA CONC. OVERLAY (2 1/4")	SQ. YD.	1765	--	1765
CONCRETE BRIDGE DECK SCARIFICATION (1/2")	SQ. YD.	1765	--	1765
PLUG EXISTING DECK DRAINS	EACH	4	--	4
BRIDGE DECK GROOVING	SQ. YD.	1766	--	1766
PROTECTIVE COAT	SQ. YD.	122	--	122
BEAM STRAIGHTENING	L. SUM	1	--	1
FLOOR DRAIN EXTENSIONS	EACH	4	--	4
ELASTOMERIC EXPANSION BEARING (TYPE I)	EACH	24	--	24
DECK SLAB REPAIR (FULL DEPTH) TYPE II	SQ. YD.	5	--	5
CONCRETE STRUCTURES	CU. YD.	--	3.4	3.4
* HOLES DRILLED	EACH	18	--	18
* DRY GROUT SOLIDS	CU. FT.	75	--	75

* AT. APPROACH SHOULDERS

GENERAL NOTES

Reinforcement bars shall conform to the requirements of AASHTO M 31, M 42 or M 53 Grade 60.

Plan dimensions and details relative to existing structure have been taken from existing plans and are subject to nominal construction variations. It shall be the Contractor's responsibility to verify such dimensions and details in the field and make necessary approved adjustments prior to construction or ordering of materials. Such variations shall not be cause for additional compensation for a change in the scope of the work, however, the Contractor will be paid for the quantity actually furnished at the unit price bid for the work.

Protective coat shall not be applied over microsilica concrete overlay. All structural steel shall be shop painted with inorganic zinc rich primer per AASHTO M300, Type I.

The existing structural steel coating contains lead. The contractor should take appropriate precautions to deal with the presence of lead on this project.

Field welding of construction accessories will not be permitted to the bottom flange of beams or girders nor to the top flange for a distance equal to one-fourth the span length each way from the pier supports. Field welding in other areas will be permitted only when approved by the Engineer.

Prior to pouring the new concrete deck, all loose rust, loose mill scale, and other loose potentially detrimental foreign material shall be removed from the surfaces of the beams or girders in contact with concrete. The cost of this work will be included in the pay item covering removal of the existing concrete. All heavy rust and other tightly adhered potentially detrimental foreign matter shall also be removed from the surfaces of the beams or girders in contact with concrete. Tightly adhered paint may remain unless otherwise noted. This removal shall be accomplished by methods that will not damage the steel. The cost of this work will be paid for according to Article 109.04 of the Standard Specifications.



Limits of Bituminous Concrete Removal (Deck) and Bridge Deck Microsilica Concrete Overlay (2 1/4") are from back to back of the approach bents.

LIN ENGINEERING, LTD.
 20 E. Chestnut
 CHICAGO, ILLINOIS 60629
 TEL: (312) 463-4106
 FAX: (312) 463-4106
 Checked By: TMD | Drawn By: FAL
 Date: 12/00 | File: COVER SHEET.DWG

REVISIONS	
NAME	DATE
STD	12/11/00

ILLINOIS DEPARTMENT OF TRANSPORTATION
GENERAL NOTES & BILL OF MATERIAL
 F.A.I. 55 OVER U.S. ROUTE 136
 SECTION (57-8, 57-9, 57-10) RS & I
 MCLEAN COUNTY
 STATION 753+54.41
 S.N. 057-0154 & 057-0155

FAI RTE NO.	SECTION	COUNTY	TOTAL SHEETS	SHEET NO.
FAI 55	**	McLEAN	163	52
FED. RD. DIST. NO.	ILLINOIS	FED. AID PROJECT		
** (57-8, 57-9, 57-10) RS & I Sheet No. 3				
26 Sheets				

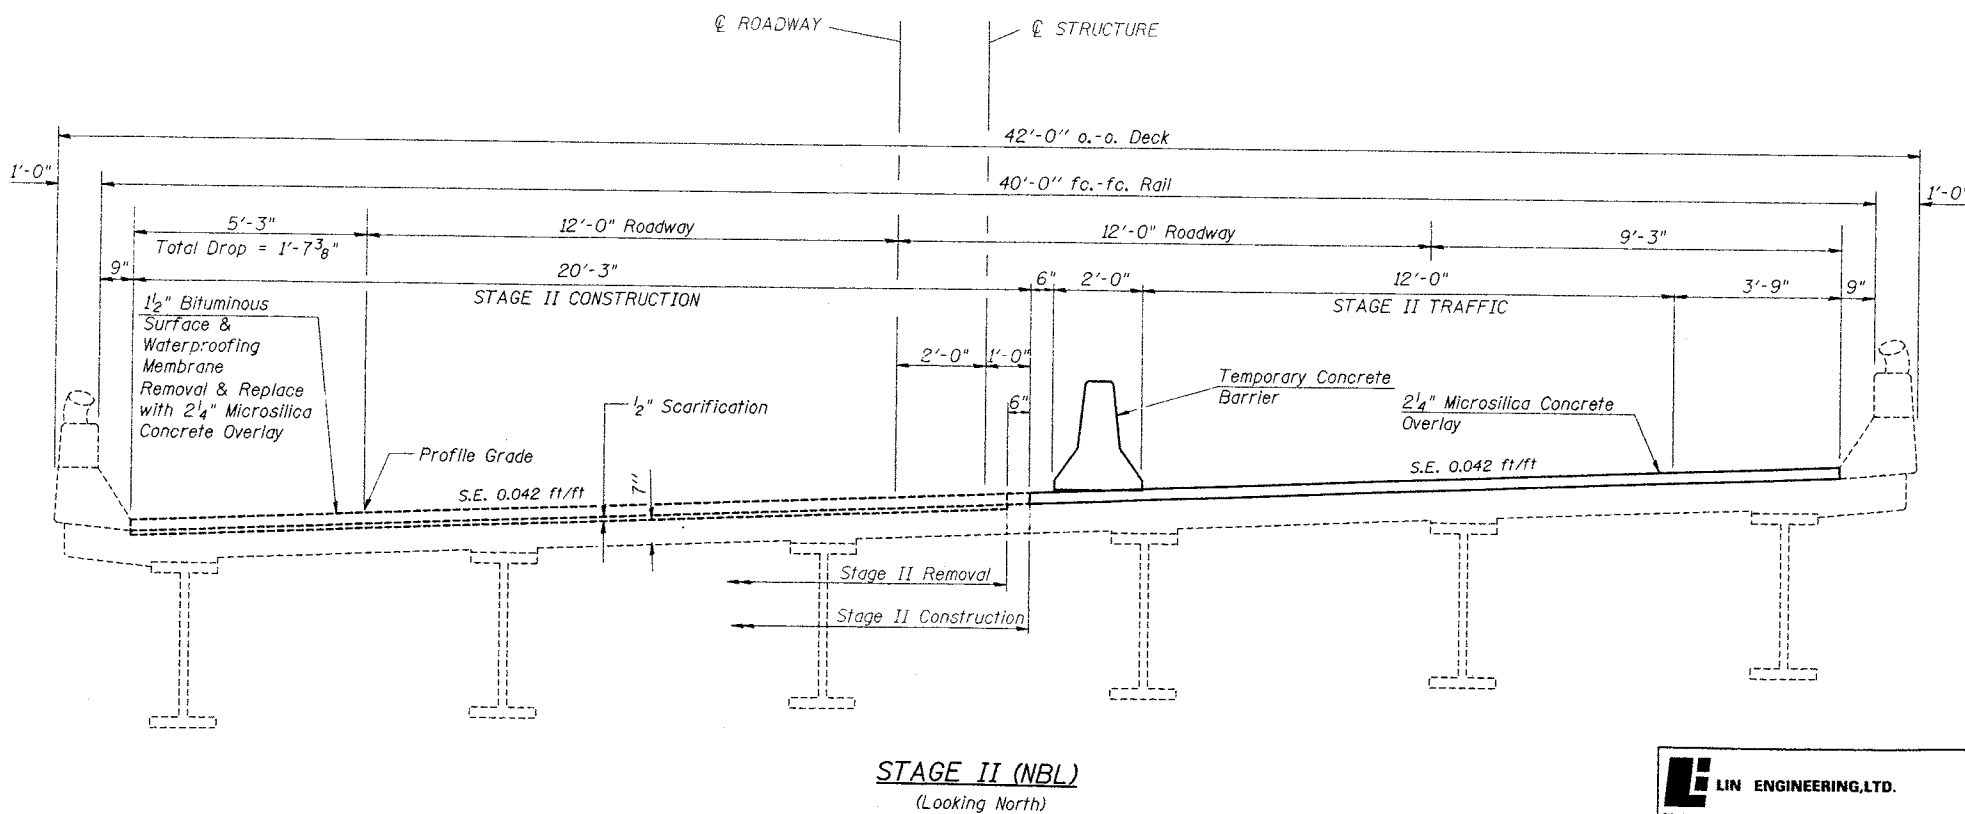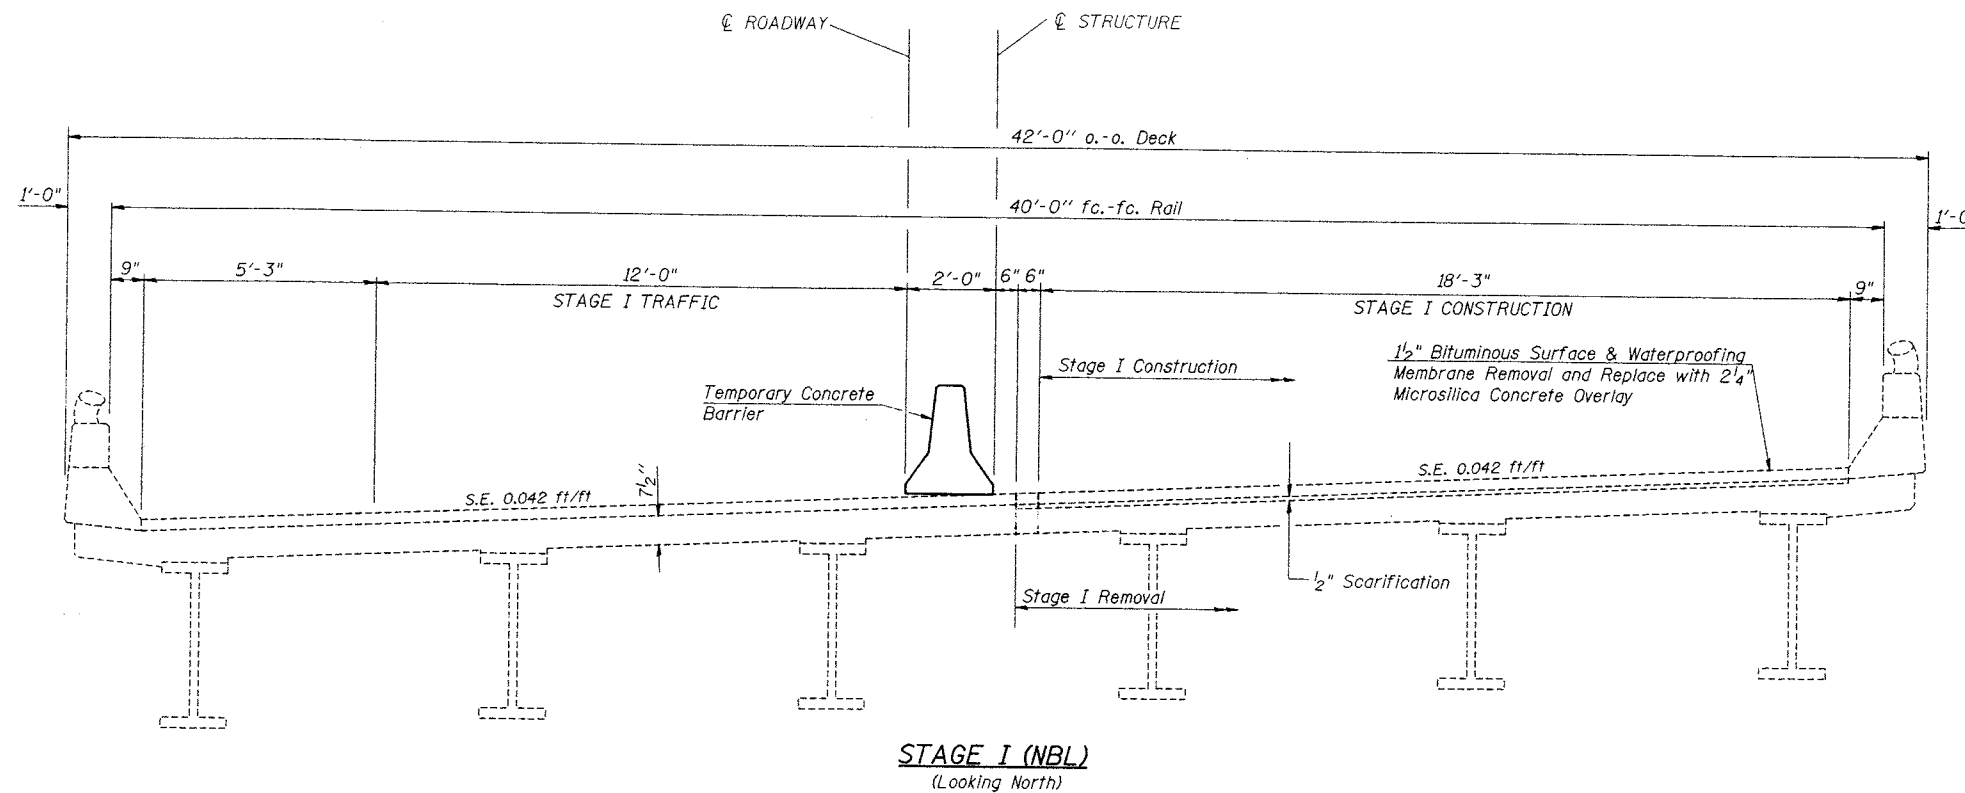

Note - All transverse dimensions are radial.



LIN ENGINEERING, LTD.
 210 W. Chestnut
 1071 481-4668
 Channah, Illinois 62629
 FAX 1271 481-4106
 Designed By: STD
 Date: 10/00
 Checked By: KRS
 Drawn By: FME
 File: STAGECON.CON

REVISIONS	
NAME	DATE

ILLINOIS DEPARTMENT OF TRANSPORTATION
STAGE CONSTRUCTION
 STRUCTURE # 057-0155
 F.A.I. 55 SEC. (57-8, 57-9, 57-10) RS & I
 McLEAN COUNTY
 STATION 753+54.41

FAI RTE NO.	SECTION	COUNTY	TOTAL SHEETS	SHEET NO.
FAI 55	**	McLEAN	163	53
FED. RD. DIST. NO.	ILLINOIS	FED. AID PROJECT		
** (57-8, 57-9, 57-10) RS & I Sheet No. 4				

26 Sheets

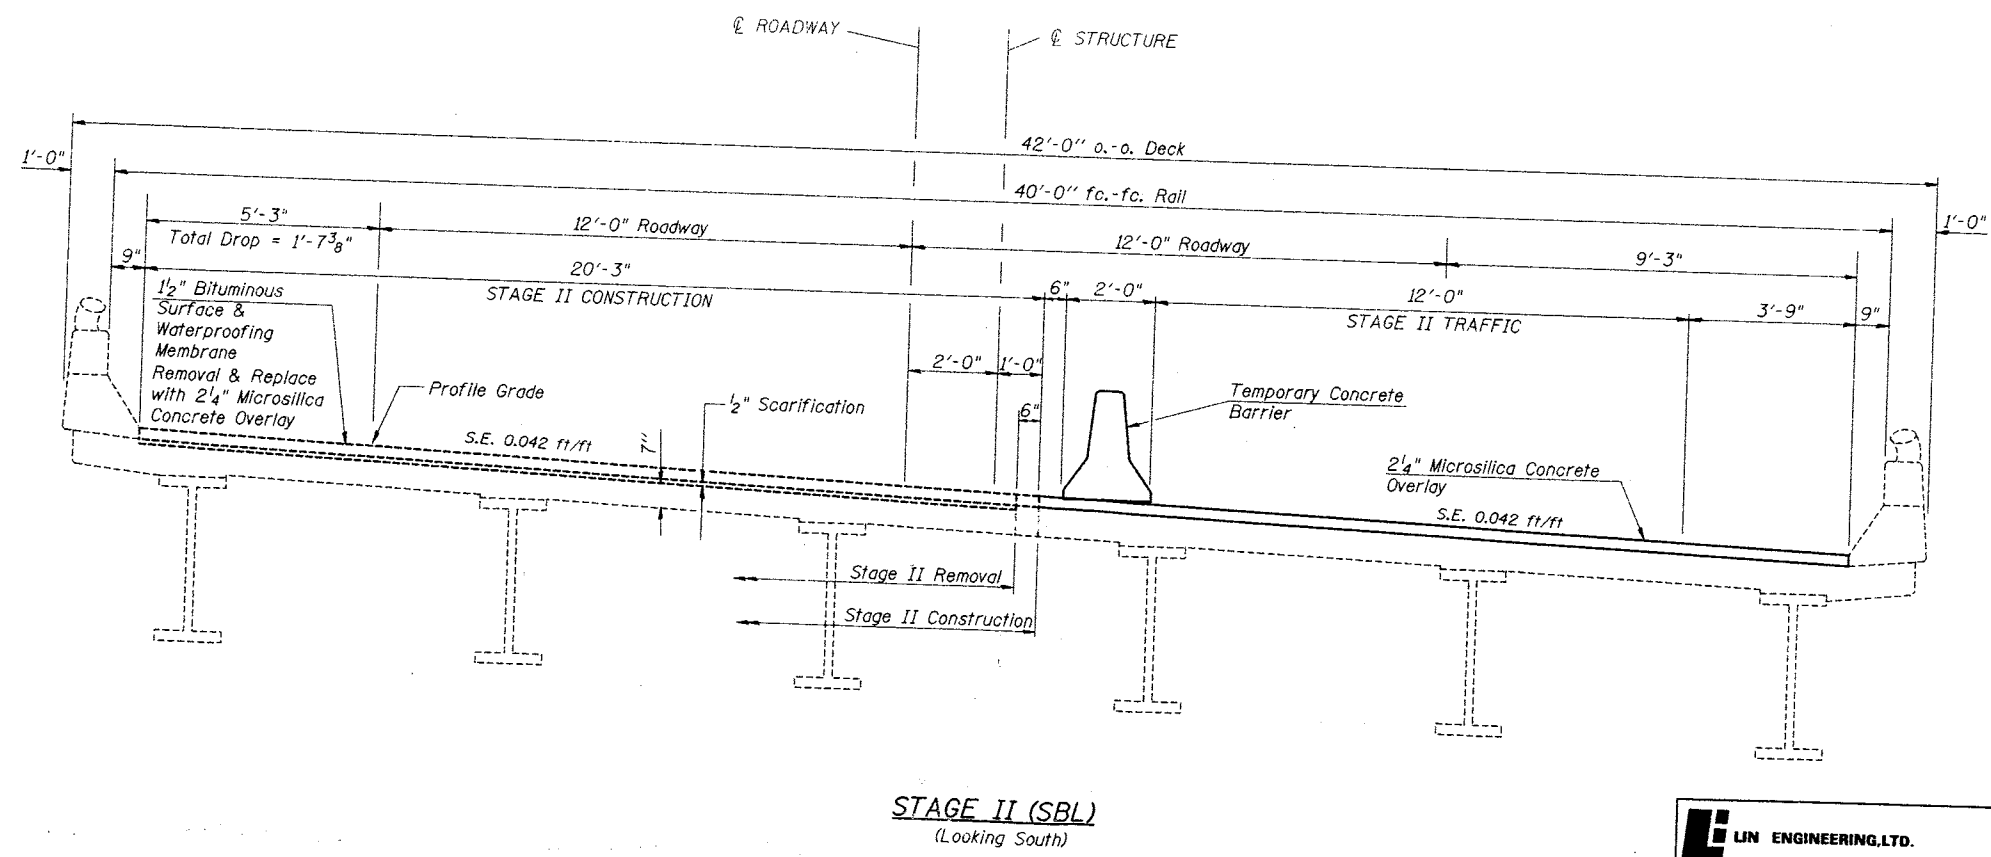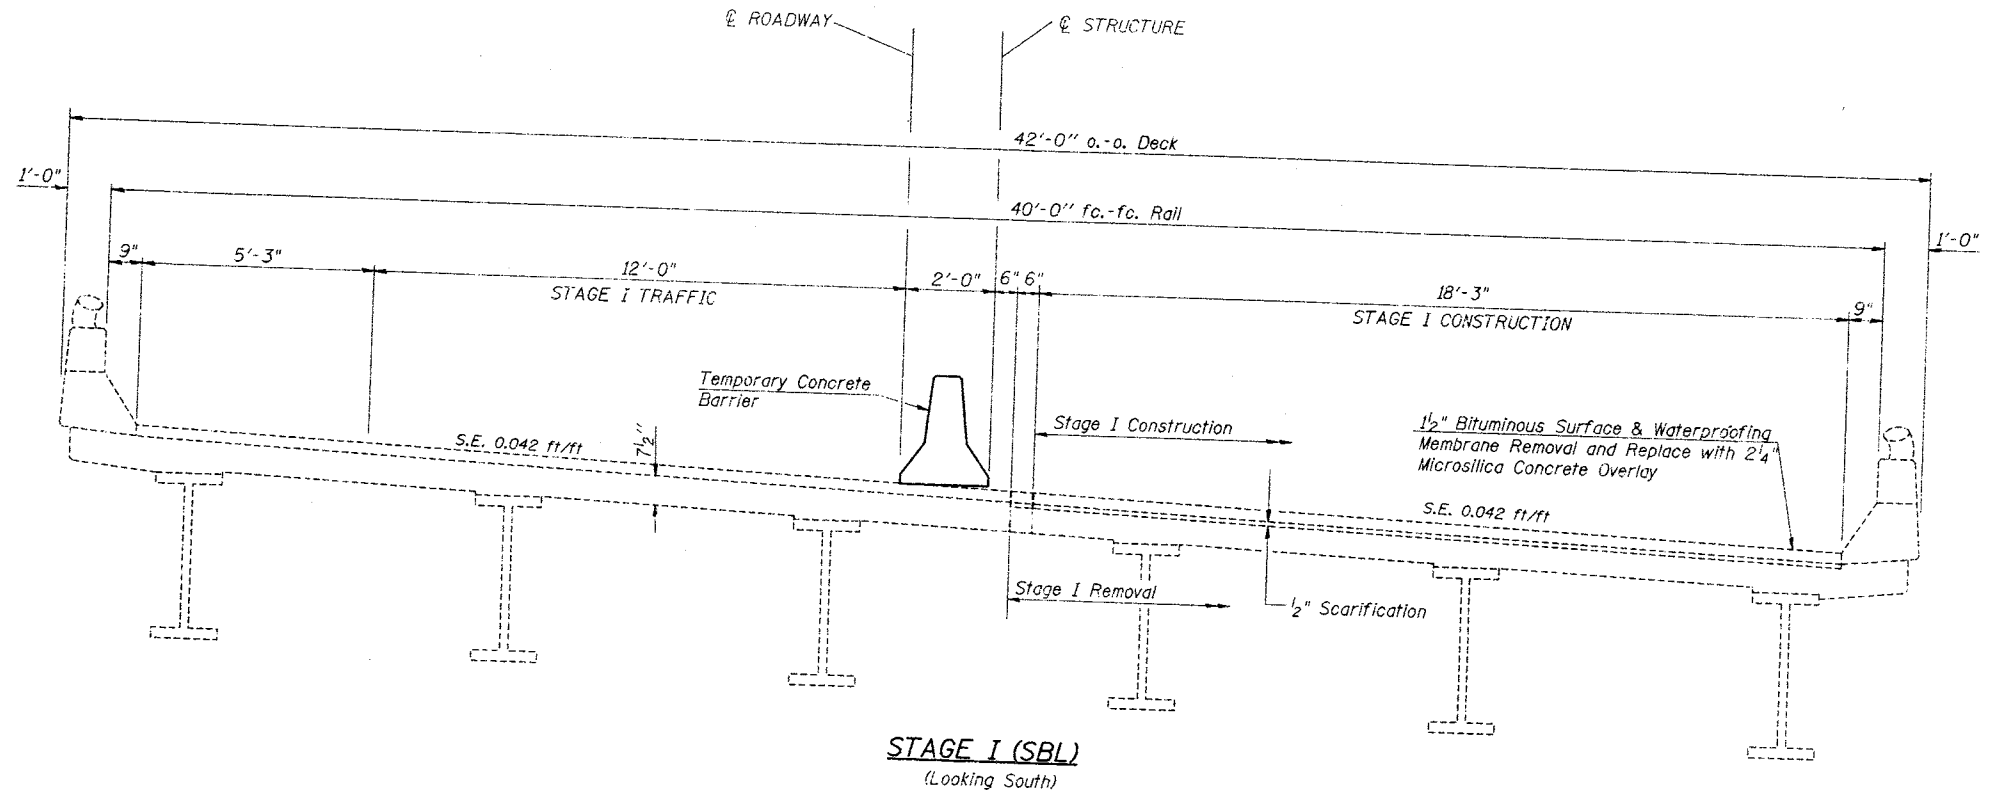

Note - All transverse dimensions are radial.



LIN ENGINEERING, LTD.
 260 N. Chestnut
 1201 453-4648
 Chatham, Illinois 61829
 Fax 1201 453-4706
 Designed By: STD | Checked By: KRG | Drawn By: JMI
 Date: 10/00 | File: STAGECON.DWG

REVISIONS	
NAME	DATE

ILLINOIS DEPARTMENT OF TRANSPORTATION
STAGE CONSTRUCTION
 STRUCTURE # 057-0154
 F.A.I. 55 SEC. (57-8, 57-9, 57-10) RS & I
 McLEAN COUNTY
 STATION 753+54.41

The Illinois Coil-Lock Anchor Bolt is a proprietary item which is the property of the Illinois Department of Transportation. Use, reproduction or disclosure without express written permission is prohibited and protected under Federal copyright laws. The production and the fabrication of this bolt for use on highway projects in the State of Illinois shall be permitted and there shall be no incurred charges or fees to the manufacturer or the fabricator for producing or fabricating this bolt.

D	E	H	K	"D"
1"	1/8"	3/16"	1 3/4"	1/4"

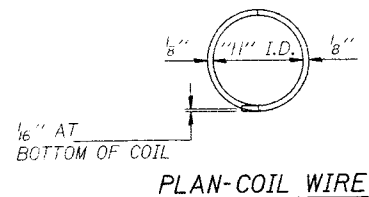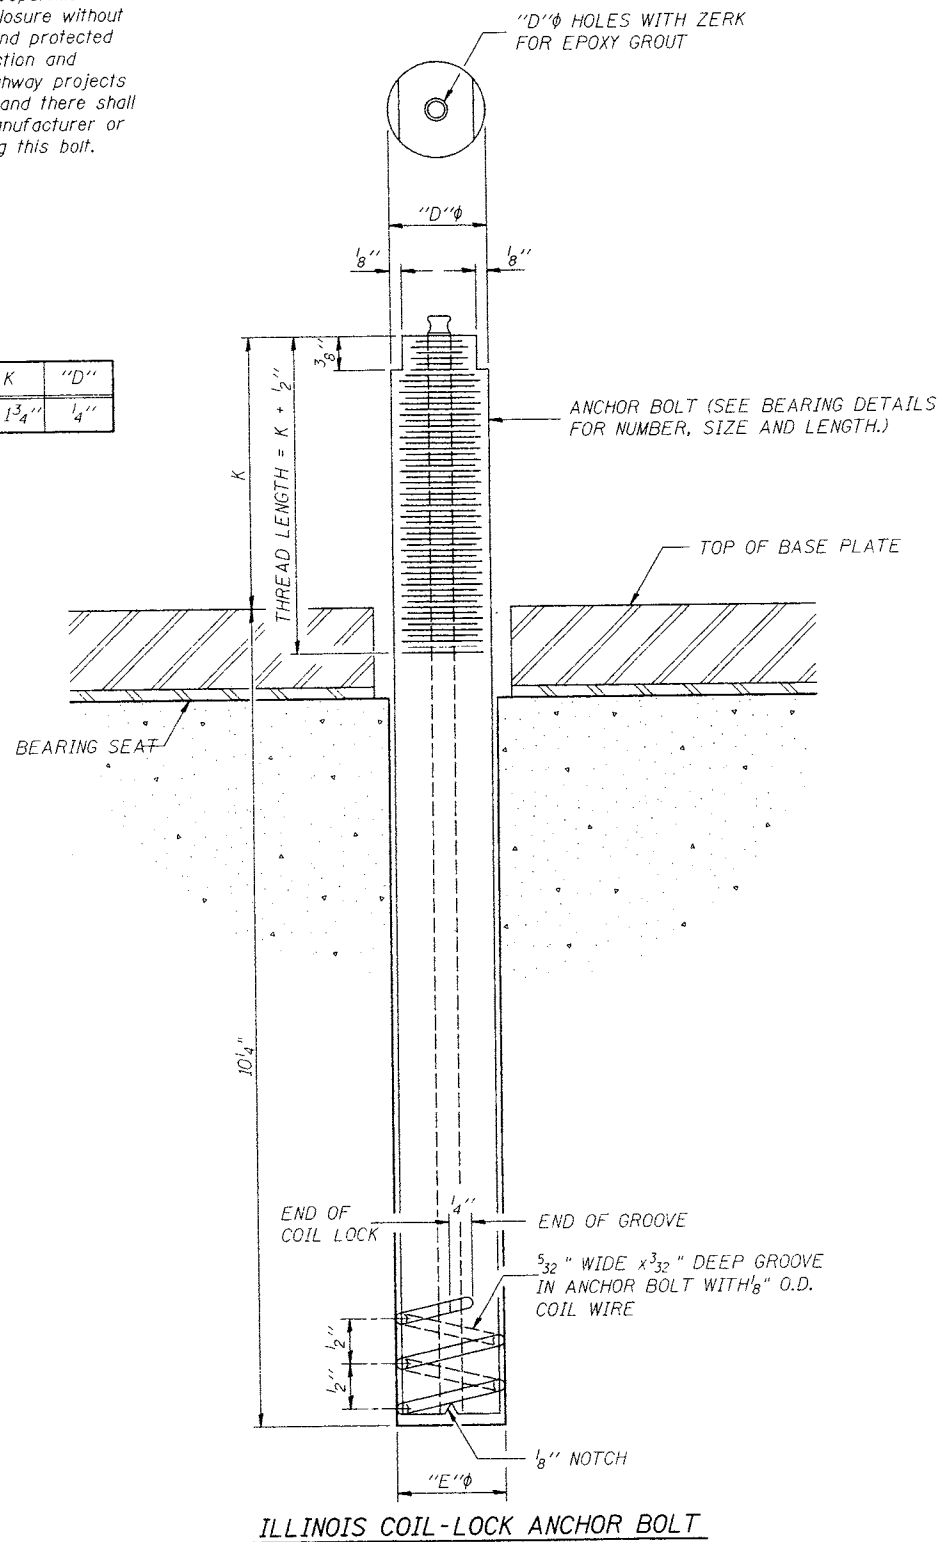

MATERIALS FOR ILLINOIS COIL-LOCK ANCHOR BOLT

The anchor bolt shall be fabricated from cold drawn or hot finished seamless carbon steel mechanical tubing conforming to ASTM A519, Grade 1026 CW and supplied with hexagonal nuts and cut washers.
 The coil wire shall be made of any suitable soft steel wire.
 The finished anchor bolt shall be cleaned of rust and other foreign materials and wrapped or packaged to prevent contamination until they are installed.
 The epoxy grout shall be a two-component, epoxy resin bonding system conforming to ASTM C881, Type I, Grade 1 and of a Class suitable for the temperature at installation.

INSTALLATION PROCEDURE for the ILLINOIS COIL-LOCK ANCHOR BOLT

1. With the coil wire in place, the bolt shall be inserted into the hole and turned clockwise to a snug fit in the hole. Nut and washer shall be placed on the bolt. The nut shall be tensioned until the steel base plates are held securely to the concrete bearing seat.
2. Epoxy grout shall be pumped through the zerk fitting with a pressure gun. Pumping shall continue until the epoxy overflows the hole around the bolt shank. After pumping is discontinued, excess epoxy shall be immediately wiped off.

ALTERNATE ANCHOR BOLTS

The Contractor may use, at his option, the capsule or the adhesive cartridge type anchor rods that have been previously tested and given a prior approval by the Department. The Contractor shall install these anchor rods in pre-drilled holes in accordance with the manufacturer's recommendations and procedures.
 The capsule or the adhesive cartridge type anchor rods shall be a two part system composed of:
 1. A threaded rod stud with nut and washer of the type specified.
 2. A sealed glass capsule or a sealed glass adhesive cartridge containing premeasured amounts of the adhesive chemical.

GENERAL NOTES

Holes in the masonry for anchor bolts shall be drilled through the base plates to the diameter and depth shown or in accordance with the manufacturer's recommendation after beams or girders have been erected and adjusted.
 Prior to setting the bolts, the holes shall be dry and all dust and loose particles shall be removed by the use of compressed air or vacuuming.
 The anchor bolts, furnished and installed and including the epoxy grout or capsules shall not be paid for separately but shall be included in the unit bid price for "Furnishing and Erecting Structural Steel".


Location	Type
Abutment	A 307

ASTM F 1554 Grade 105, ASTM A 449 and AASHTO M 314 Grade 105 anchor bolts may be substituted for the anchor bolts shown here.

LIJ ENGINEERING, LTD.
 290 N. Chestnut
 CHATTANOGUE, TENN. 37629
 (615) 483-9652 FAX (615) 483-1108
 Designed By: STD Checked By: KRG Drawn By: FML
 Date: 10/00 File: ASB-LEGG

REVISIONS	
NAME	DATE


ILLINOIS DEPARTMENT OF TRANSPORTATION
ANCHOR BOLT
 S.N. 057-0154 & S.N. 057-0155
 F.A.I. 55 SEC. (57-8, 57-9, 57-10) RS & I
 McLEAN COUNTY
 STATION 753+54.41

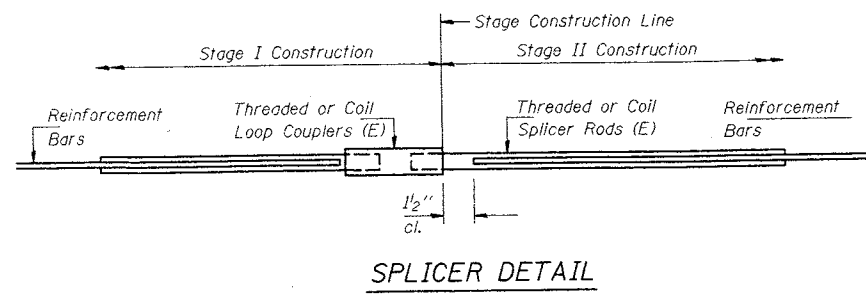

Bar Size	No. Assemblies Required	Location
#5	24	Top of Slab
#5	24	Bottom of Slab


The diameter of this part is the same as the diameter of the bar spliced.

The diameter of this part is equal or larger than the diameter of bar spliced.

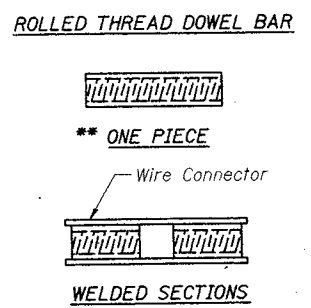


BAR SPLICER ASSEMBLY ALTERNATIVES

** Heavy Hex Nuts conforming to ASTM A 563, Grade C, D or DH may be used.

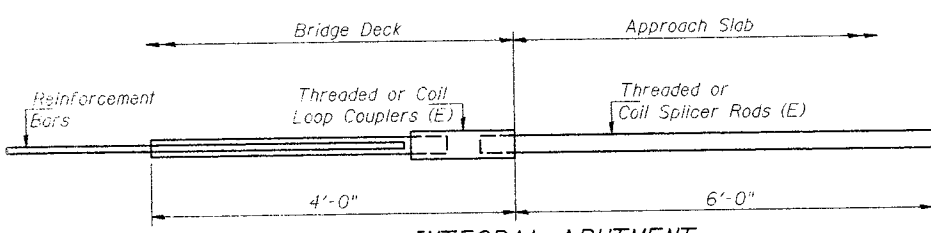

INTEGRAL ABUTMENT BAR SPLICER ASSEMBLY DETAIL FOR #5 BAR

Min. Capacity = 23 kips - tension
Min. Pull-out Strength = 9.2 kips - tension
No. Required =

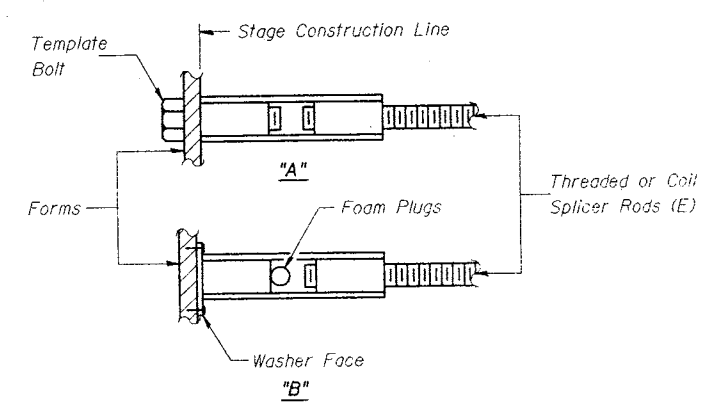

INSTALLATION AND SETTING METHODS

"A" : Set bar splicer assembly by means of a template bolt.
 "B" : Set bar splicer assembly by nailing to wood forms or cementing to steel forms.
 (E) : Indicates epoxy coating.

NOTES

Bar splicer assemblies shall be of an approved type and shall develop in tension at least 125 percent of the yield strength of the lapped reinforcement bars.
 Splicer rods shall be of minimum 60 ksi yield strength, threaded or coiled full length.
 All reinforcement bars shall be lapped and tied to the splicer rods or dowel bars.
 Bar splicer assemblies shall be epoxy coated according to the requirements for reinforcement bars.
 Other systems of similar design may be submitted to the Engineer for approval. Approval shall be based on certified test results from an approved testing laboratory that the proposed bar splicer assembly satisfies the following requirements:

- Minimum Capacity (Tension in kips) = $1.25 \times f_y \times A_t$
- Minimum *Pull-out Strength (Tension in kips) = $1.25 \times f_{s_{allow}} \times A_t$

Where f_y = Yield strength of lapped reinforcement bars in ksi.
 $f_{s_{allow}}$ = Allowable tensile stress in lapped reinforcement bars in ksi (Service Load)
 A_t = Tensile stress area of lapped reinforcement bars.
 * = 28 day concrete

Bar Size to be Spliced	Splicer Rod or Dowel Bar Length	Strength Requirements	
		Min. Capacity kips - tension	Min. Pull-Out Strength kips - tension
#5	2'-0"	23.0	9.2
#6	2'-7"	33.1	13.3
#7	3'-5"	45.1	18.0
#8	4'-6"	58.9	23.6

Bar splicer assemblies shall be according to Section 508 of the Standard Specifications, except as noted. The furnishing and installation of bar splicer assemblies will be measured and paid for at the contract unit price each for "BAR SPLICERS."

LIN ENGINEERING, LTD.

30 W. Chestnut
 1201 483-4668
 Channah, Illinois 62629
 Fax: (217) 483-4706

Designed By: STD Checked By: KRQ Drawn By: FML
 Date: 12/06 File: BSO-LDGV

REVISIONS	
NAME	DATE

ILLINOIS DEPARTMENT OF TRANSPORTATION

BAR SPLICER


S.N. 057-0154 & S.N. 057-0155

F.A.I. 55 SEC. (57-8, 57-9, 57-10) RS & I

McLEAN COUNTY

STATION 753+54.41

F.A.I. RTE. NO.	SECTION	COUNTY	TOTAL SHEETS	SHEET NO.
FAI 55	**	McLEAN	103	55
FED. RD. DIST. NO.	ILLINOIS	FED. AID PROJECT		
** (57-8, 57-9, 57-10) RS & I Sheet No. 7				
26 Sheets				

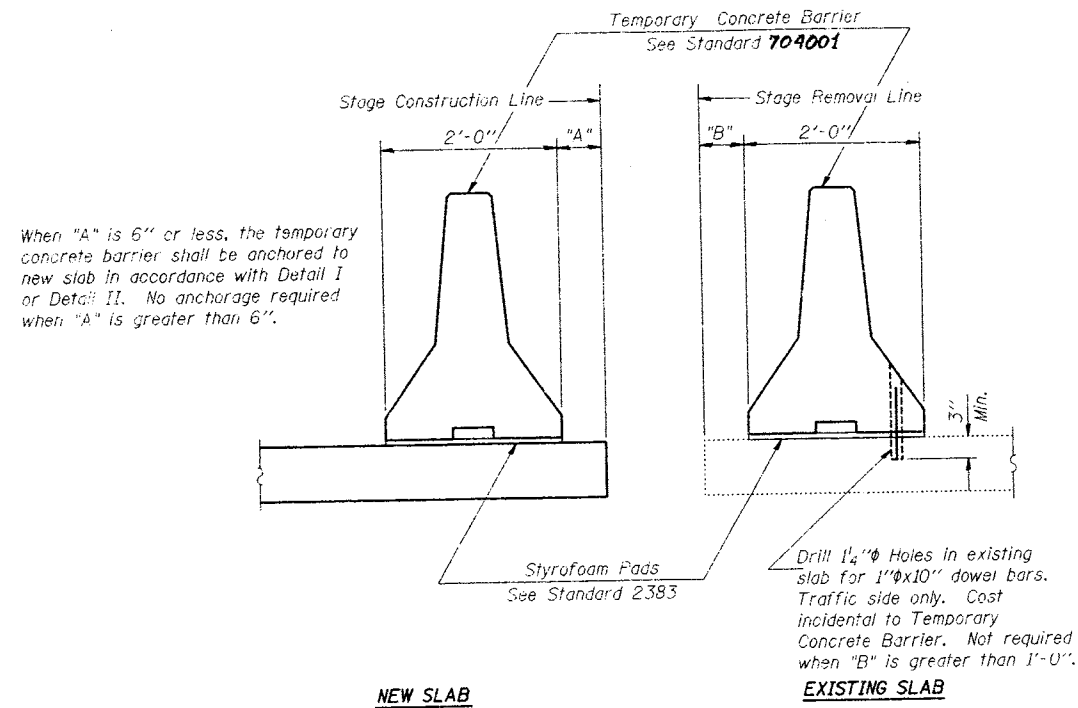


SECTIONS THRU SLAB

NOTES


- Detail I - With Bar Splicer or Couplers:
Connect one (1) 1"x7"x10" steel plate to the top layer of couplers with 2-5/8" ϕ bolts screwed to coupler at approximate ϕ of each 10'-0" barrier panel.
- Detail II - With Extended Reinforcement Bars:
Connect one (1) 1"x7"x10" steel plate to the concrete slab with 2-5/8" ϕ Expansion Anchors or cast in place inserts spaced between the top layer of reinforcement at approximate ϕ of each 10'-0" barrier panel.
- Cost of anchorage is incidental to Temporary Concrete Barrier.

Note: For Pay Item "Temporary Concrete Barrier" See Roadway Plans.

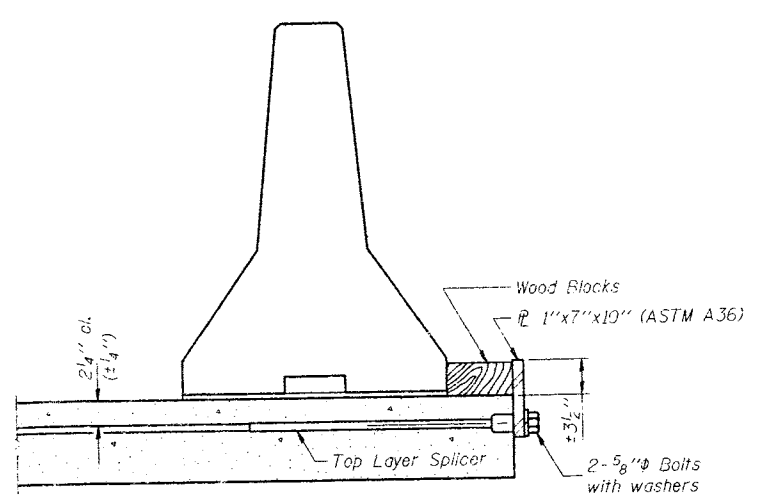


DETAIL I

The 1"x7"x10" Plate shall not be removed until Stage II Construction forms and reinforcement bars are in place.

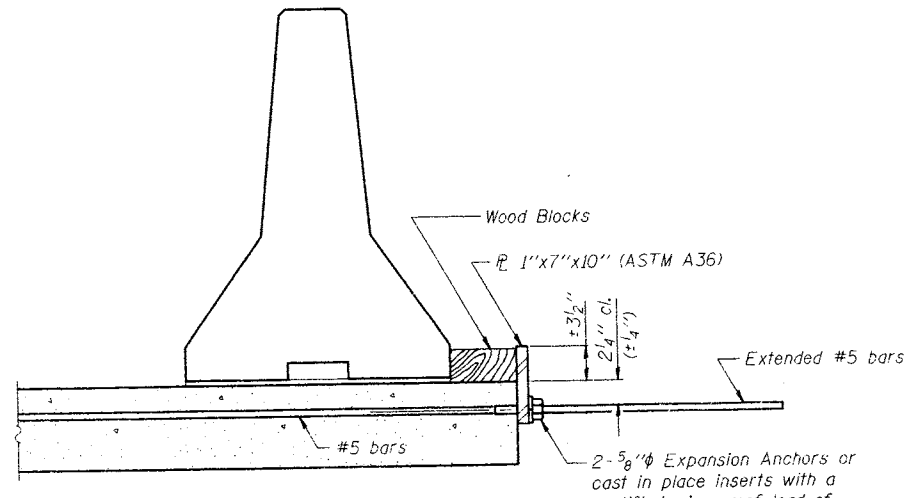

DETAIL II


The 1"x7"x10" Plate shall not be removed until Stage II Construction forms and all reinforcement bars are in place and the concrete is ready to be placed.

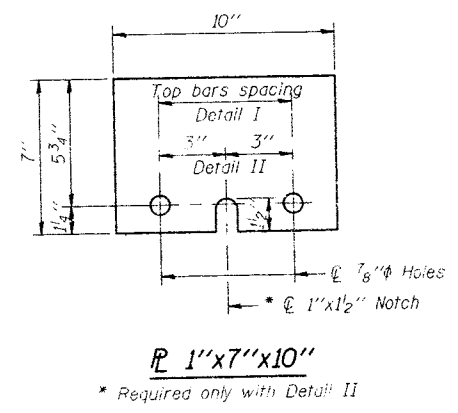

LIN ENGINEERING, LTD.
20 W. Chestnut
Chatham, Illinois 62629
(271) 483-4668
FAX (271) 483-4106
Designed By: STD Checked By: KRQ Drawn By: FMC
Date: 10/00 File: R27.DWG

REVISIONS	
NAME	DATE

ILLINOIS DEPARTMENT OF TRANSPORTATION
TEMPORARY CONCRETE BARRIER
S.N. 057-0154 & S.N. 057-0155
F.A.I. 55 SEC. (57-8, 57-9, 57-10) RS & I
McLEAN COUNTY
STATION 753+54.41

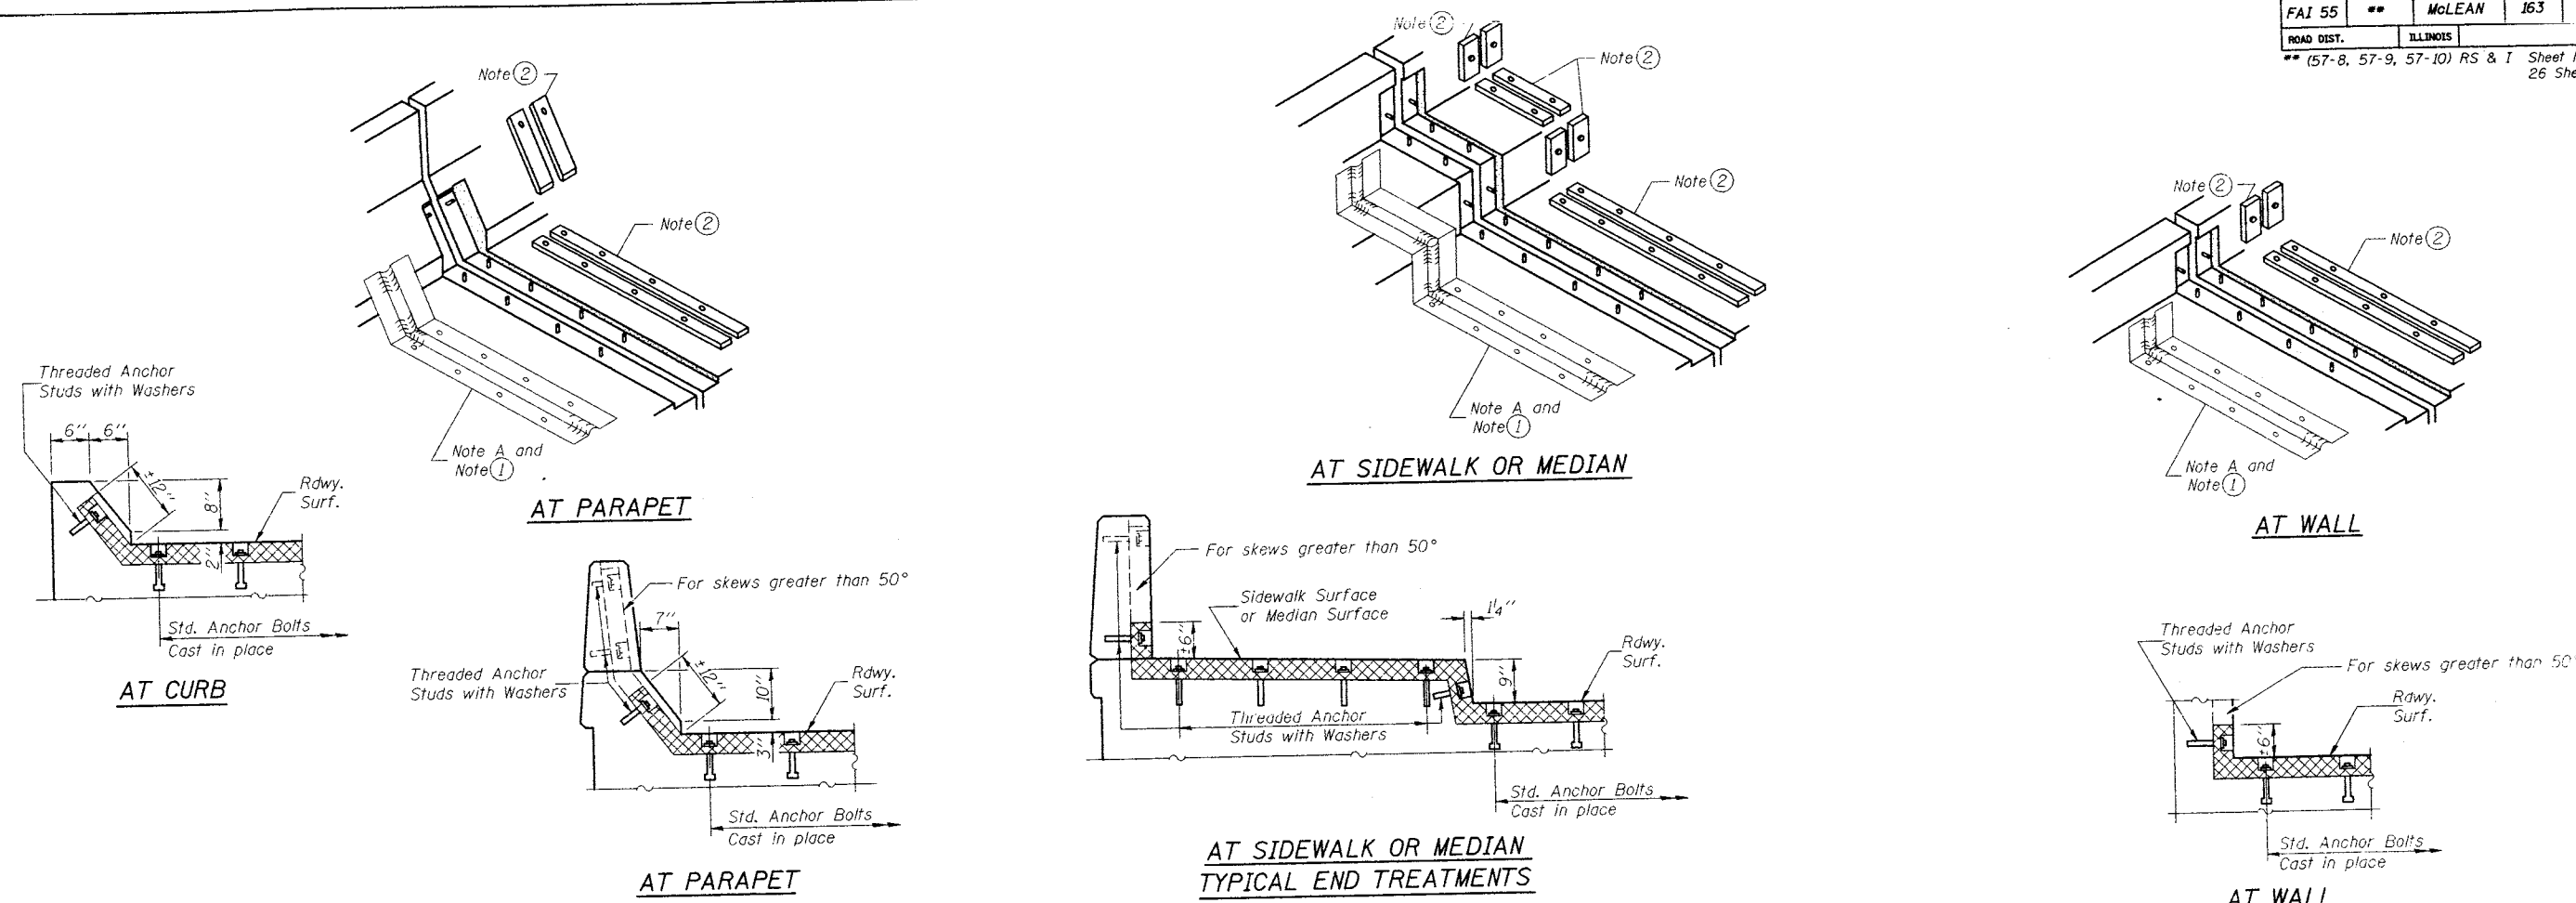


Joint Size	"C" at 50°F	"D" at 50°F
2"	2"	1 1/2" Min.
2 1/2"	2 1/2"	1 3/4" Min.
4"	3"	2 1/2" Min.

INSTALLATION NOTES

- ① Install continuous seal in roadway, parapet, curb, and sidewalk.
- ② Install anchor blocks as indicated.

NOTE A: Maximum spacing of anchor bolts shall be 12" centers.

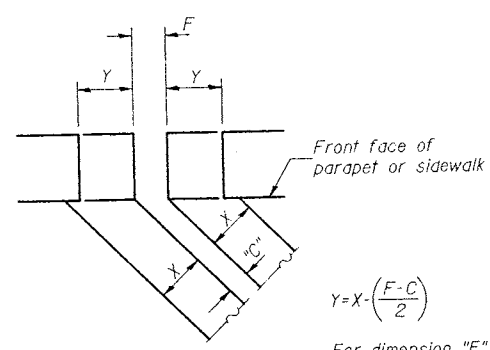


$$Y = X \cdot \left(\frac{F - C}{2} \right)$$

For dimension "F" see sheets #9 & #10 of 26.

SKEW LIMITATIONS

The details of the anchor blocks and the elastomeric membrane in the parapet, as shown, are for up to 50° skews. For skews greater than 50°, the anchor blocks and the elastomeric membrane, installed according to dimension "D", might require modifications to insure a minimum clearance of 1/2" from centerline of anchor studs to edge of parapet opening. The anchor blocks and the elastomeric membrane shall also be installed to the top of the parapet with the anchor studs spaced at ±12" cts.

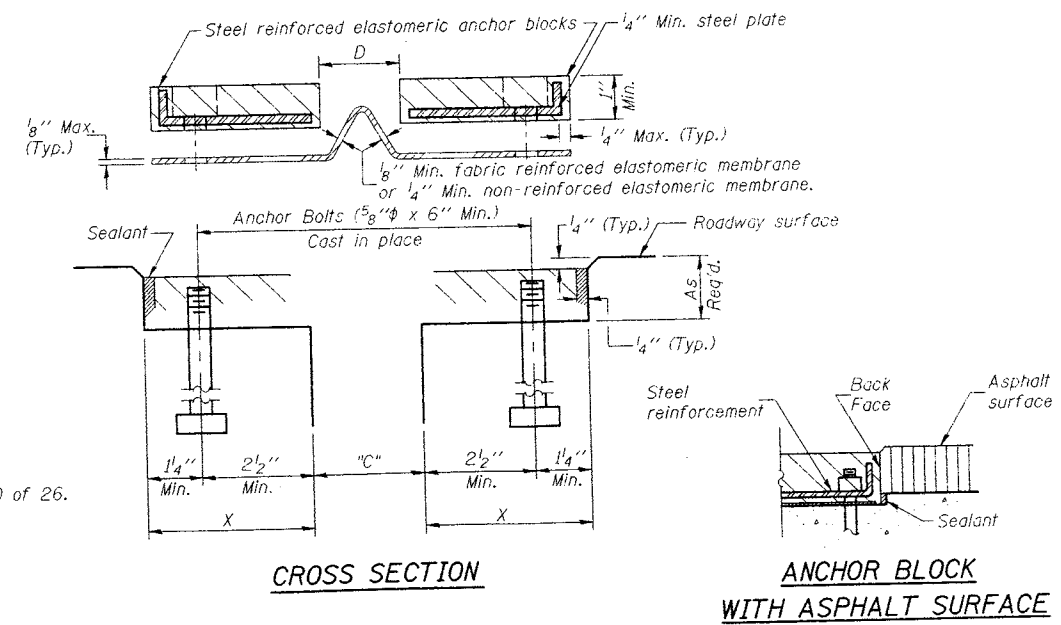

GENERAL NOTES


Continuous Seal Neoprene Expansion Joint shall consist of molded anchor blocks of elastomer and steel, field assembled over continuous lengths of elastomeric membrane.
 The elastomeric membrane shall be premolded with a single or a double upward convolution that will have a "memory" to return to its molded position upon joint closure.
 The convolution length shall be such that the extended length will not be greater than the manufactured length when the joint is fully expanded in its design range and will not protrude above the anchor blocks when the joint is fully compressed.
 Joint openings shall be adjusted according to Article 503.10(c) of the Standard Specifications when the deck is poured at an ambient temperature other than 50° F.
 The parapet and roadway membrane shall be made continuous by an approved vulcanizing process. Lapping will not be permitted.

LIN ENGINEERING, LTD.
 210 W. Chestnut
 Chatham, Illinois 62629
 (217) 483-4068
 FAX (217) 483-4706
 Designed By: STD
 Checked By: KRQ
 Drawn By: MCB
 Date: 10/00
 File: EXPJT.DWG


REVISIONS	
NAME	DATE

ILLINOIS DEPARTMENT OF TRANSPORTATION
**CONTINUOUS SEAL TYPE
 NEOPRENE EXPANSION JOINTS**
 S.N. 057-0154 & 057-0155
 F.A.I. 55 SEC. (57-8, 57-9, 57-10) RS & I
 McLEAN COUNTY
 STATION 753+54.41


ROUTE NO.	SECTION	COUNTY	TOTAL SHEETS	SHEET NO.
FAI 55	**	McLEAN	163	58
ROAD DIST.		ILLINOIS		
** (57-8, 57-9, 57-10) RS & I Sheet No. 9 26 Sheets				

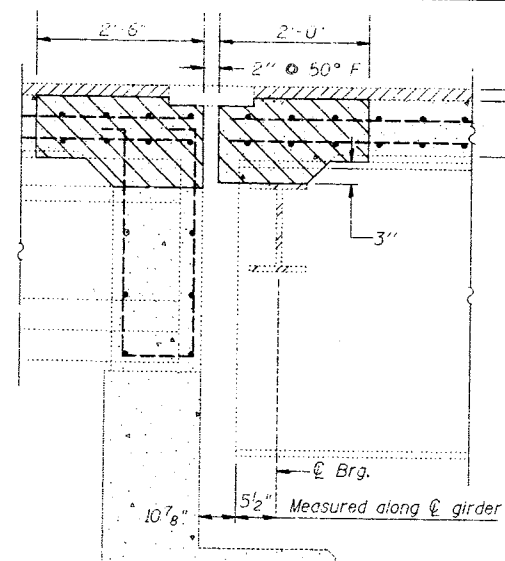


EXISTING SECTION AT ABUTMENT AT RIGHT ANGLES

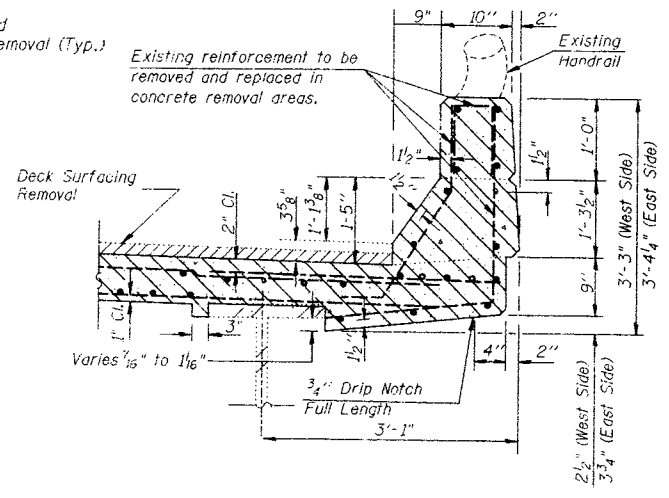

EXISTING CURB SECTION (MAIN SPAN)

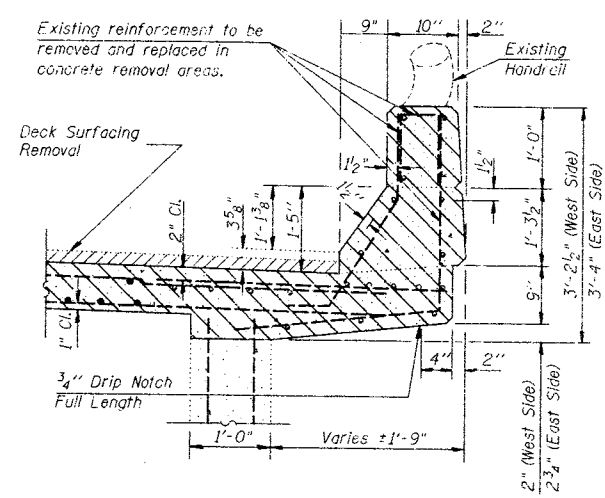


EXISTING CURB SECTION (VAULTED ABUTMENT)

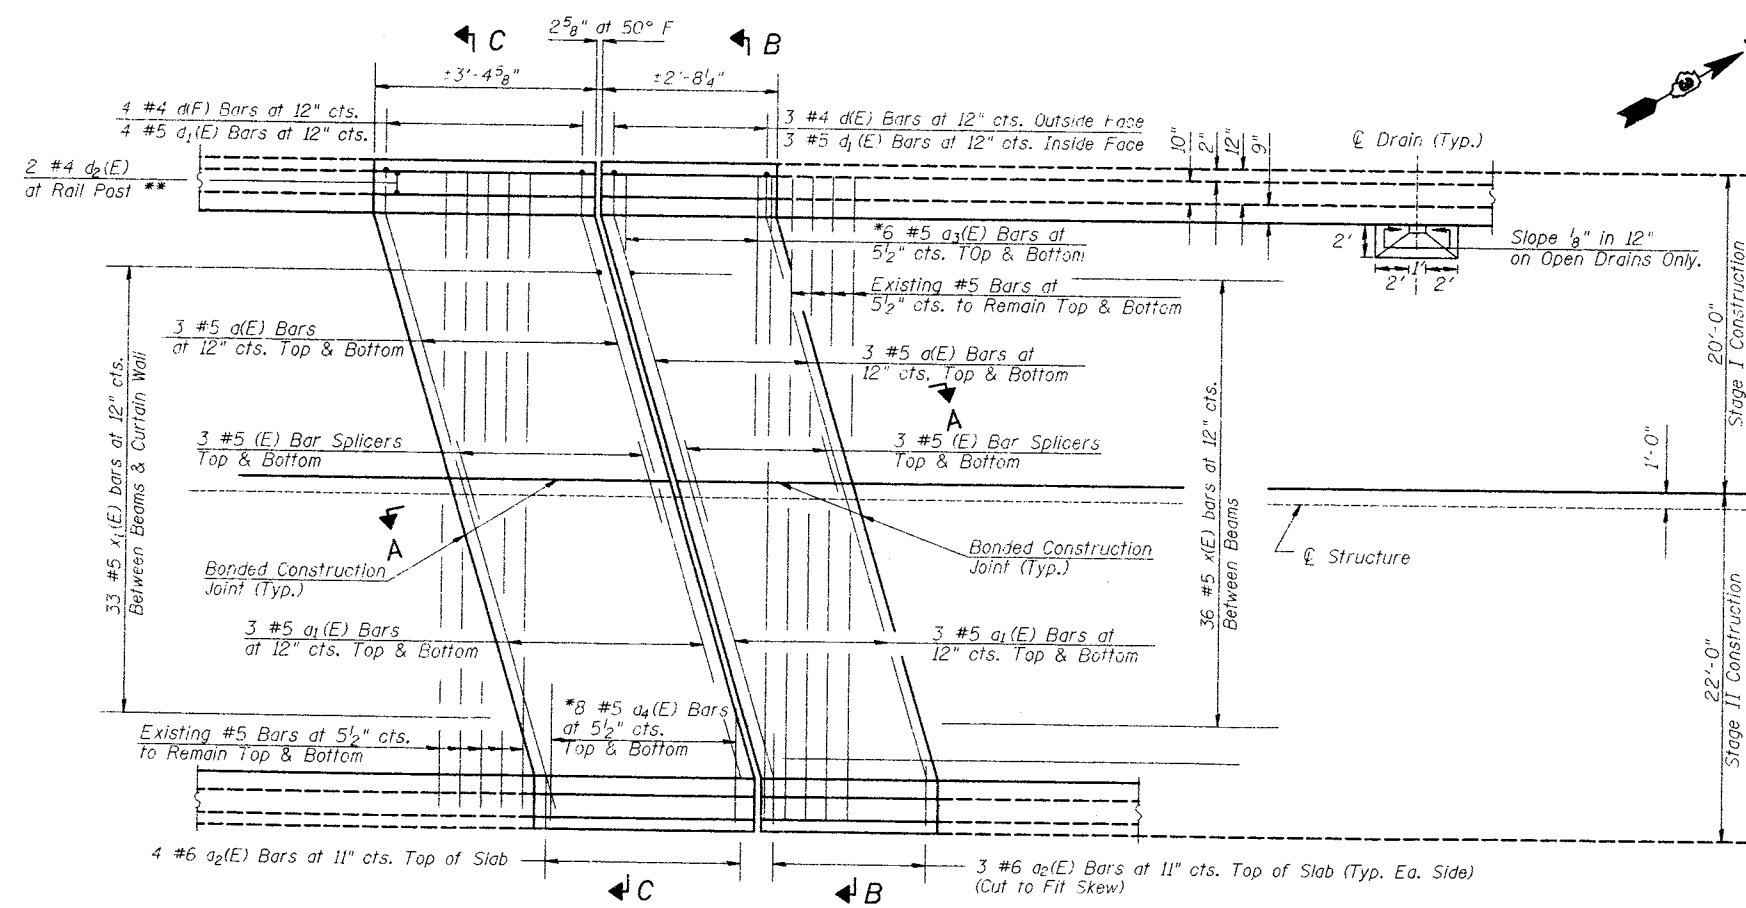


VAULTED ABUTMENT MAIN SPAN PLAN
(South End Shown - North End Similar)

Indicates Concrete Removal

* Order $a_4(E)$ & $a_3(E)$ Bars Full Length Cut to Fit Skew. Use Remainder at the Other Abutment.
 ** The Rail Post Shall be Temporarily Supported During Rehabilitation. The Post Anchorage Assembly Embedded in Concrete Shall Be Cleaned and Incorporated Into New Construction.

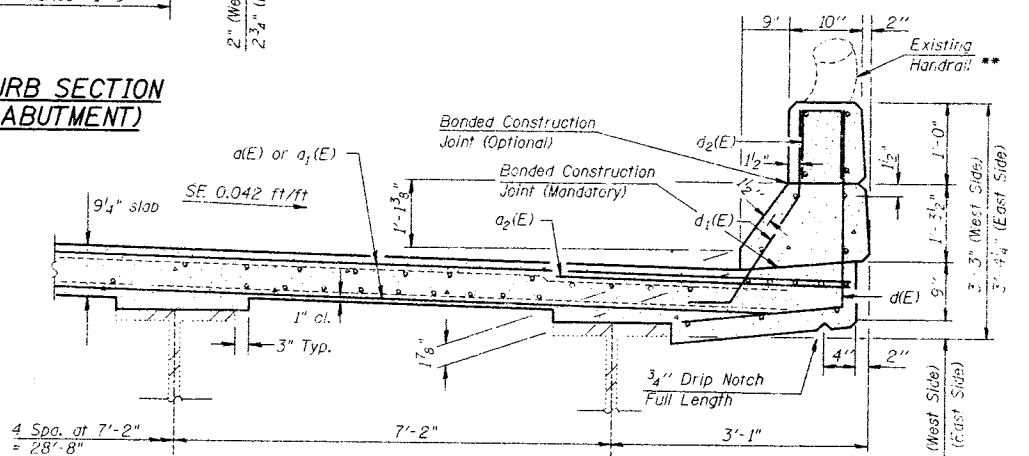

SECTION B-B
(West Side Shown)

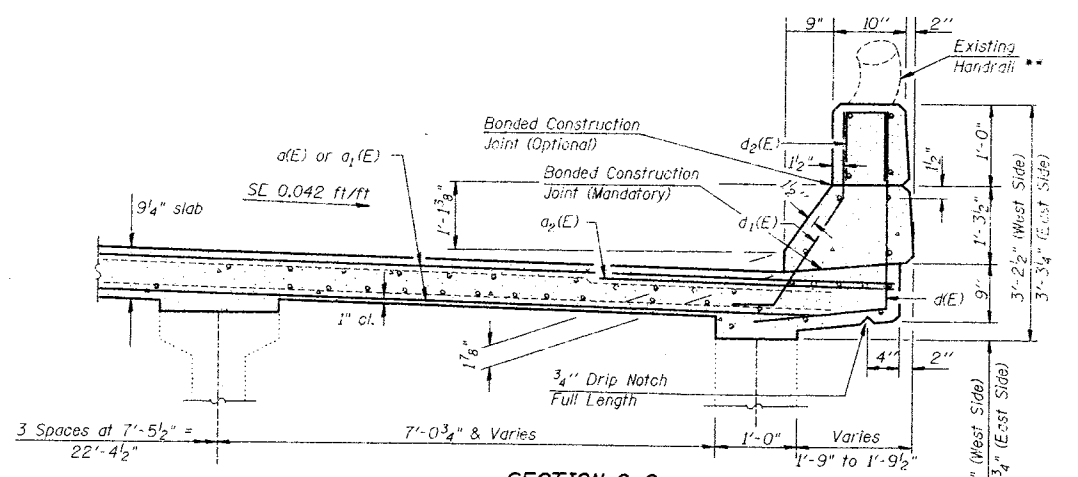

SECTION C-C


Note:
 Existing Reinforcement Bars and Dowel Rods Unless Otherwise Shown are to be Cleaned and Incorporated into New Construction.
 For Section A-A See Sheet #10 of 26.
 For Bill of Material & Bar Details See Sheet #10 of 26.
 For Concrete Removal See Sheets #10 & #11 of 26.
 All Transverse Dimensions are Radial.
 Reinforcement Bars Designated (E) Shall be Epoxy Coated.
 The Contractor Shall Use Extreme Care During Concrete Removal so as Not to Damage the P.P.C. I-Beam.

LIN ENGINEERING, LTD.
 20 W. Chestnut
 (217) 483-4888
 Chatham, Illinois 62629
 FAX (217) 483-4106
 Designed By: STD Checked By: KRG Drawn By: M.B.
 Date: 10/00 File: EXPJT.DGN

REVISIONS	
NAME	DATE

ILLINOIS DEPARTMENT OF TRANSPORTATION
EXPANSION JOINT REHABILITATION
 SOUTH BOUND LANES
 S.N. 057-0154
 F.A.I. 55 SEC. (57-8, 57-9, 57-10) RS & I
 McLEAN COUNTY
 STATION 753+54.41

ROUTE NO.	SECTION	COUNTY	TOTAL SHEETS	SHEET NO.
FAI 55	**	McLEAN	163	59
ROAD DIST.	ILLINOIS			
** (57-8, 57-9, 57-10) RS & I Sheet No. 10 26 Sheets				

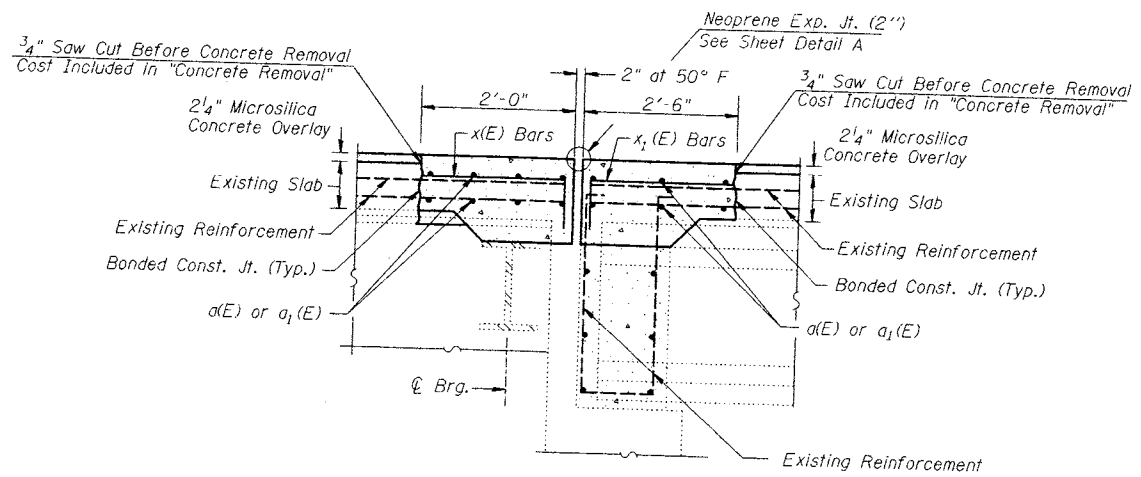


SECTION A-A
(Dimensions are at Right Angles)

**TWO SUPERSTRUCTURES
BILL OF MATERIAL**


Bar	No.	Size	Length	Shape
a(E)	48	#5	26'-0"	—
a ₁ (E)	48	#5	28'-9"	—
a ₂ (E)	56	#6	4'-0"	—
a ₃ (E)	12	#5	6'-3"	—
a ₄ (E)	16	#5	7'-9"	—
d(E)	56	#4	4'-9"	┌
d ₁ (E)	56	#5	3'-5"	┌
d ₂ (E)	16	#4	2'-1"	┌
x(E)	144	#5	2'-11"	—
x ₁ (E)	132	#5	3'-7"	—
Concrete Superstructure		Cu. Yds.	36.6	
Reinforcement Bars Epoxy Coated		Lbs.	4620	
Bar Splicers		Each	48	

Reinforcement bars designated (E) shall be epoxy coated.

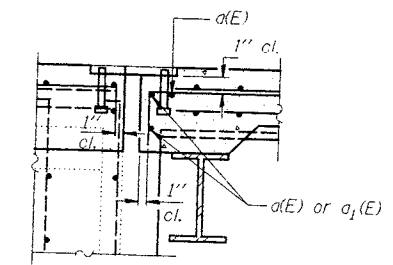

DETAIL A

Place a(E) or a₁(E) bars in back of anchor bolts as shown if required to maintain 1" cl. (+0-1/8"). Anchor bolts should be tied to a(E) or a₁(E) bars.

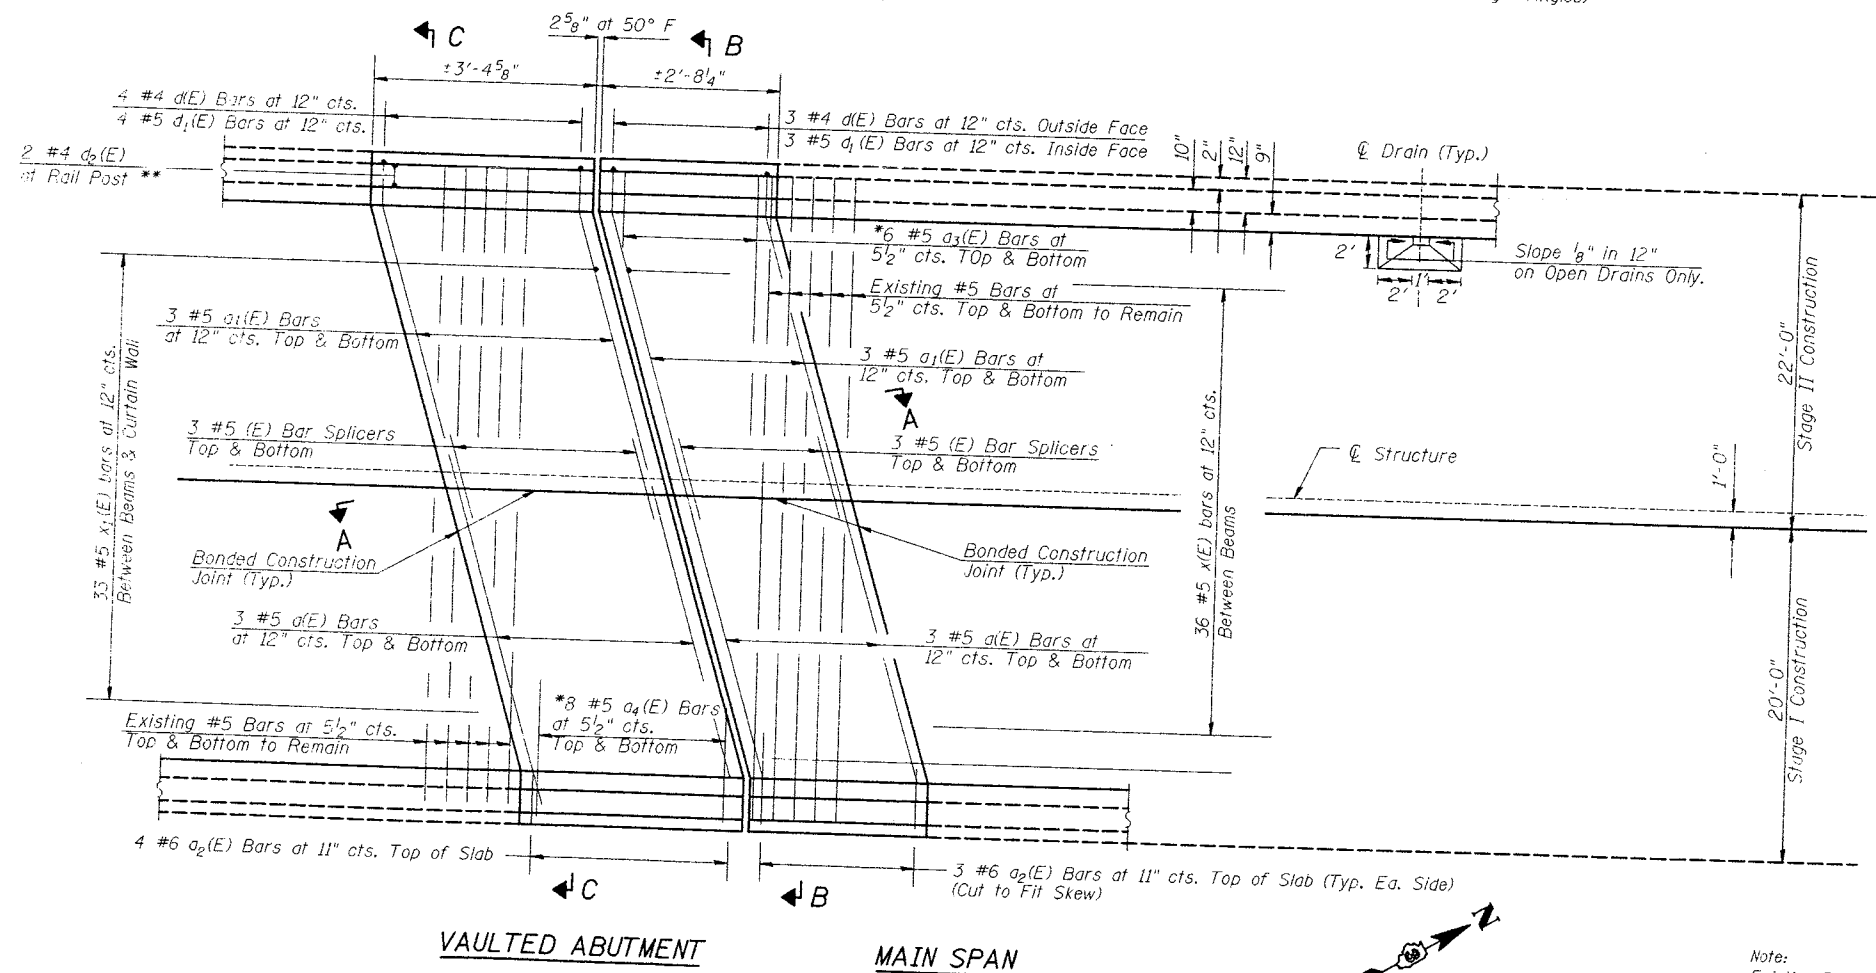


VAULTED ABUTMENT **MAIN SPAN**

PLAN

(South End Shown - North End Similar)

- * Order a₄(E) & a₃(E) Bars Full Length Cut to Fit Skew. Use Remainder at the Other Abutment.
- ** The Rail Post Shall be Temporarily Supported During Rehabilitation. The Post Anchorage Assembly Embedded in Concrete Shall Be Cleaned and Incorporated Into New Construction.

Note:
Existing Reinforcement Bars and Dowel Rods Shown are to be Cleaned and Incorporated into New Construction. For Existing Curb Sections Sec. B-B and Sec. C-C, See Sheet # 9 of 26.
For Concrete Removal see Sheets #13 & #14 of 26.
All Transverse Dimensions are Radial.

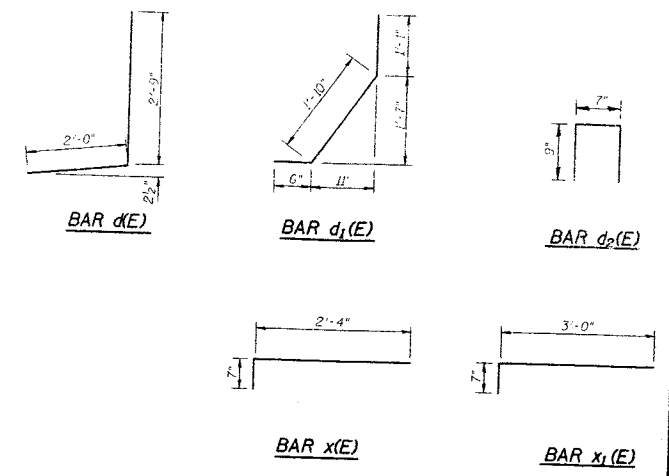

LIN ENGINEERING, LTD.
210 W. Chestnut Channahon, Illinois 62929
(271) 483-4648 FAX (271) 483-4106
Designed By: STD Checked By: KRQ Drawn By: MJB
Date: 10/00 File: EXP-JT.DGN

REVISIONS	
NAME	DATE

ILLINOIS DEPARTMENT OF TRANSPORTATION
EXPANSION JOINT REHABILITATION
NORTH BOUND LANES
S.N. 057-0155
F.A.I. 55 SEC. (57-8, 57-9, 57-10) RS & I
McLEAN COUNTY
STATION 753+54.41

Notes:

1. Existing bituminous surface and W.P. Membrane shall be removed from entire deck.

2. Entire existing deck to be scarified 1/2" depth and overlaid with 2 1/4" Microsilica Concrete.





3. Hatched areas indicate concrete removal & replacement in stages. See Sheet #9 of 26.

4. Existing reinforcement bars & dowel rods extending into removal area are to be cleaned and incorporated into new construction.

5. Deck repair areas are estimated from survey work 6-22-00. Actual locations of repairs made shall be shown by the engineer on as built plans.

Field drill 3/8" hole for 1/4" threaded rod 13" long with nuts & washers. Cost included with "Plug Existing Deck Drains".

PLUG EXISTING DECK DRAINS

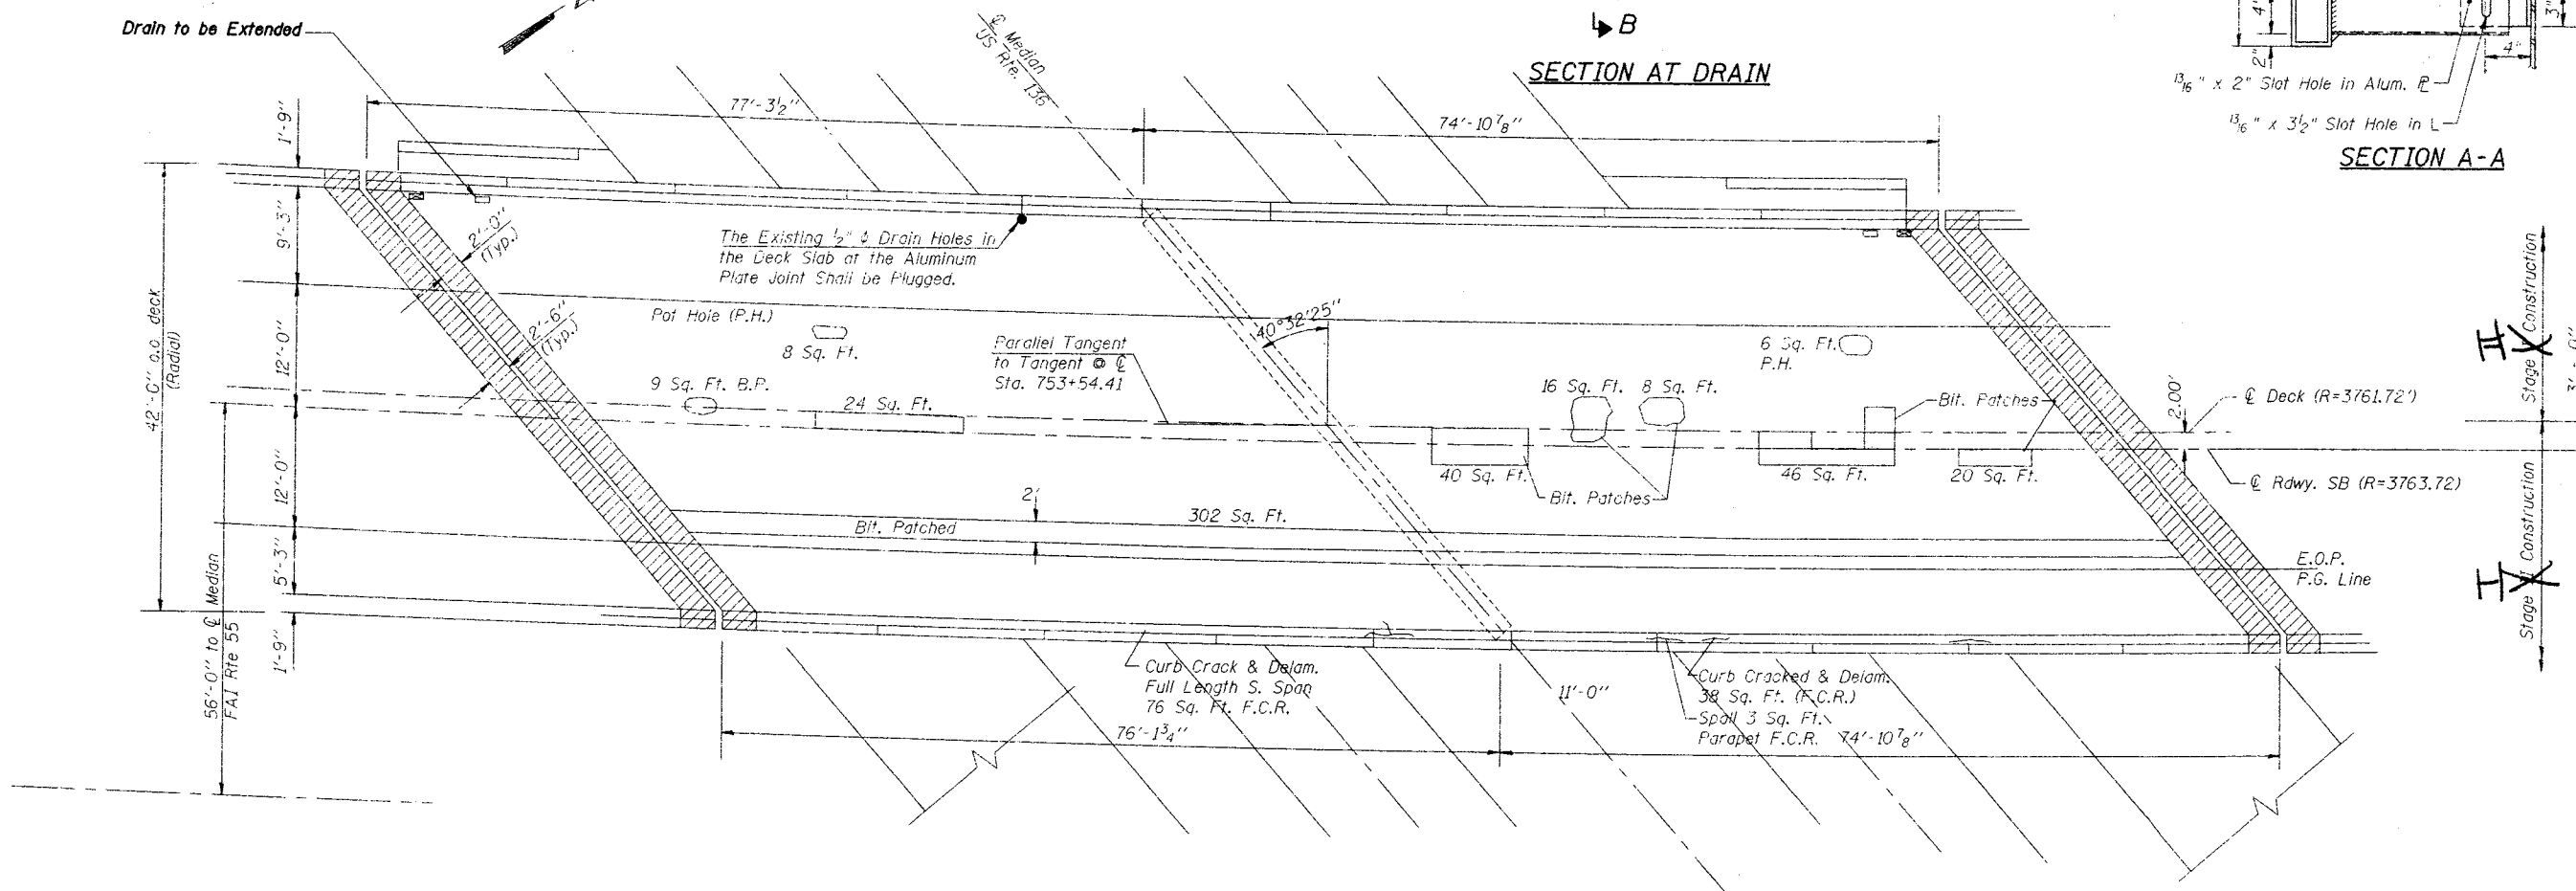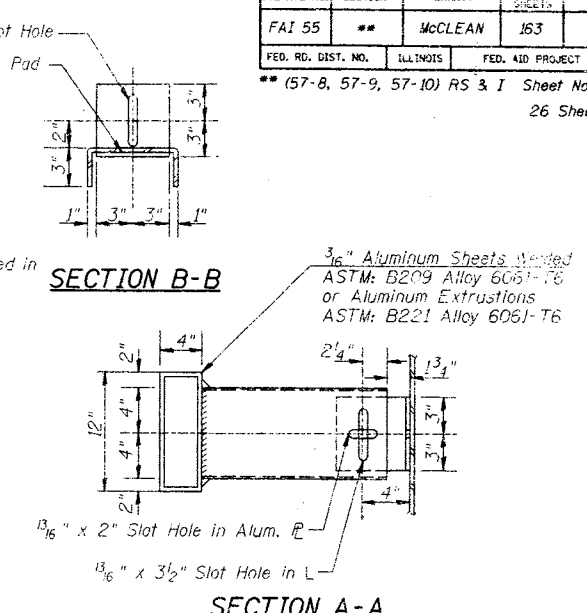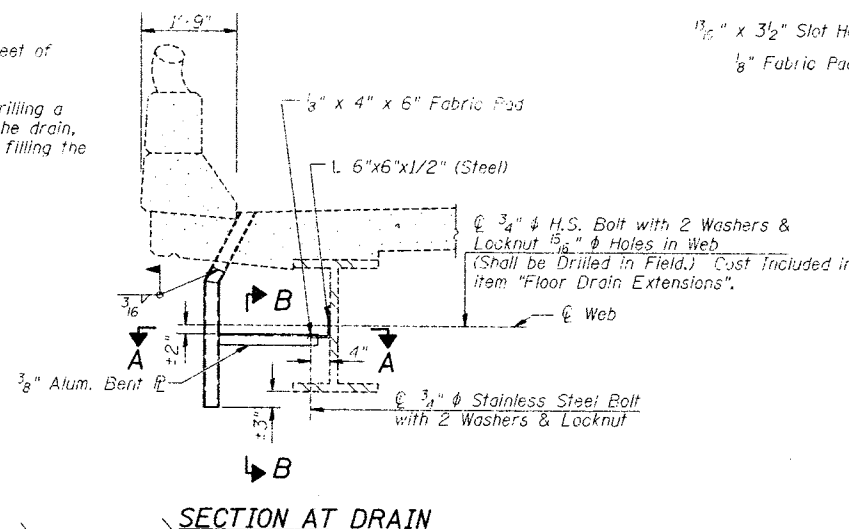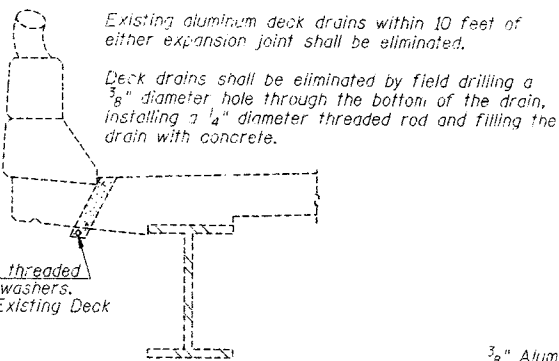

LEGEND

- Deck Slab Repair (Partial) w/ Est. Area
- Crack, width > 1/16" Epoxy Crack Sealing
- Drain to be Plugged
- F.C.R. Formed Concrete Repair (Depth = 5')
- B.P. Bituminous Patch

DECK REPAIR - QUANTITY ESTIMATE

ITEM	QUANTITY
Deck Slab Repair (Partial)	77 Sq. Yd.
Bituminous Concrete Removal (Deck)	943 Sq. Yd.
Concrete Bridge Deck Scarification 1/2"	891 Sq. Yd.
Bridge Deck Microsilica Concrete overlay 2 1/4"	891 Sq. Yd.
Bridge Deck Grooving	888 Sq. Yd.
Plug Existing Deck Drains	2 Each
Epoxy Crack Sealing	45 Foot
Formed Concrete Repair (Depth = 5')	121 Sq. Ft.
Floor Drain Extensions	2 Each
Controlled Low-Strength Material	0.5 Cu. Yd.



DECK TOP PLAN (MAIN SPANS)

Note - All transverse dimensions are radial.

LIN ENGINEERING, LTD.
 20 W. Chestnut
 (217) 483-468
 Chatham, Illinois 62629
 FAX (217) 483-4106
 Designed By: STD Checked By: KRG Drawn By: F.M.
 Date: 10/00 File: EXHIBIT54-155.DGN

REVISIONS	
NAME	DATE

ILLINOIS DEPARTMENT OF TRANSPORTATION
DECK REPAIR PLAN
SOUTH BOUND LANES
STRUCTURE# 057-0154
F.A.I. 55 SEC. (57-8, 57-9, 57-10) RS & I
McCLEAN COUNTY
STA. 753+54.41

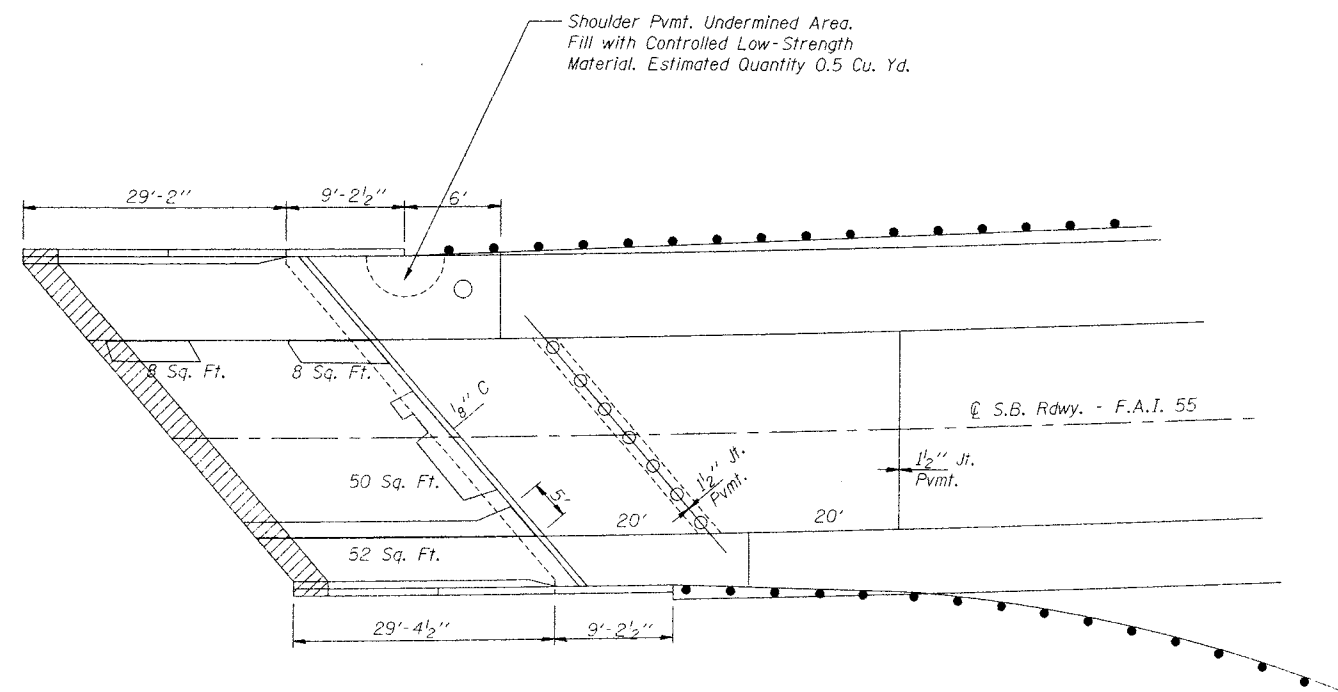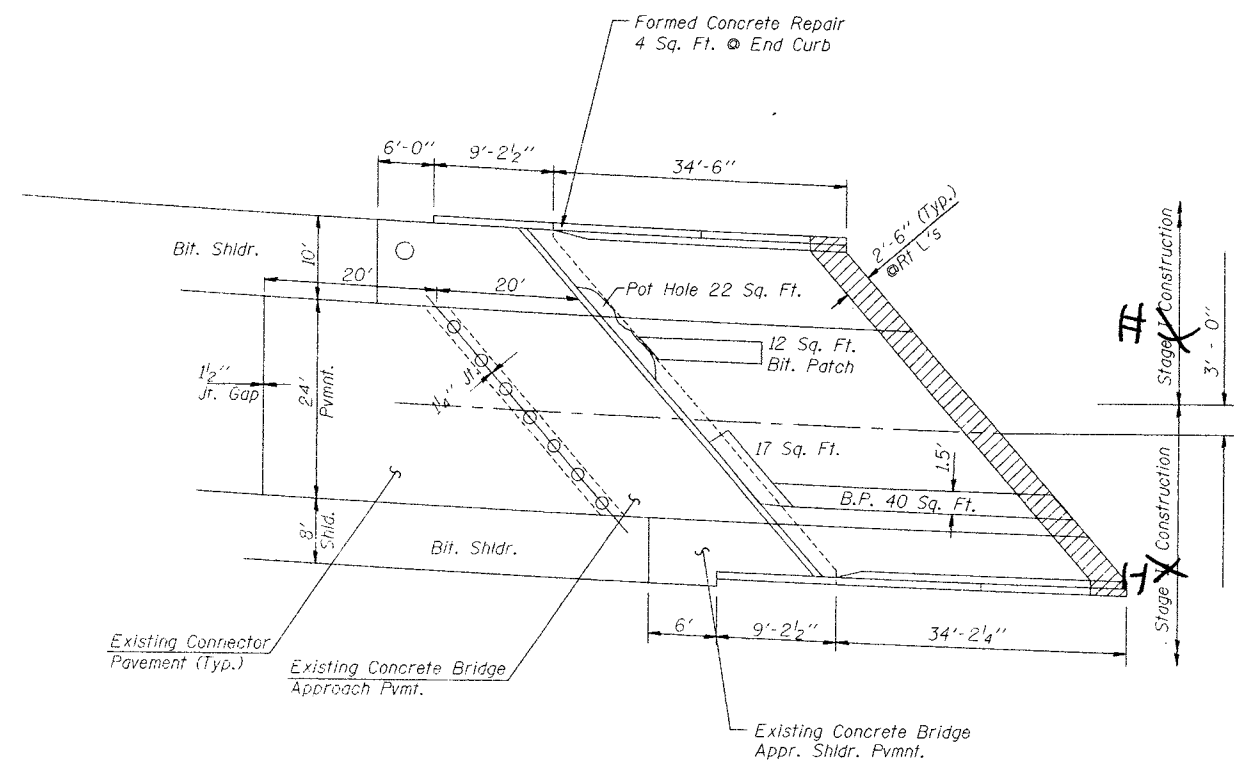

Note Approach Span quantities included in Table on Sheet 11 of 26.

**DECK TOP PLAN
(APPROACH SPANS)**

For Notes & Legend See Sheet 11 of 26.


LIN ENGINEERING, LTD.

200 W. Chestnut
1371-483-4643
Chatham, Illinois 62629
FAX: (618) 483-4106
Designed By: STD Checked By: KRG Drawn By: FWL
Date: 10/00 File: L18161154-155.DWG

REVISIONS	
NAME	DATE

ILLINOIS DEPARTMENT OF TRANSPORTATION
DECK REPAIR PLAN - APPROACH SPANS
 SOUTH BOUND LANES
 STRUCTURE # 057-0154
 F.A.I. 55 SEC. (57-8, 57-9, 57-10) RS & I
 McLEAN COUNTY
 STA. 753+54.41

- Notes:
- Existing bituminous surface and W.P. Membrane shall be removed from entire deck.
 - Entire existing deck to be scarified 2" depth and overlaid with 2 1/4" Microsilica Concrete.
 - Hatched areas indicate concrete removal & replacement in stages. See Sheet #10 of 26.
 - Existing reinforcement bars & dowel rods extending into new concrete are to be cleaned and incorporated into new construction.
 - Deck repair areas are estimated from survey work 6-22-00. Actual locations of repairs made shall be shown by the engineer on as built plans.

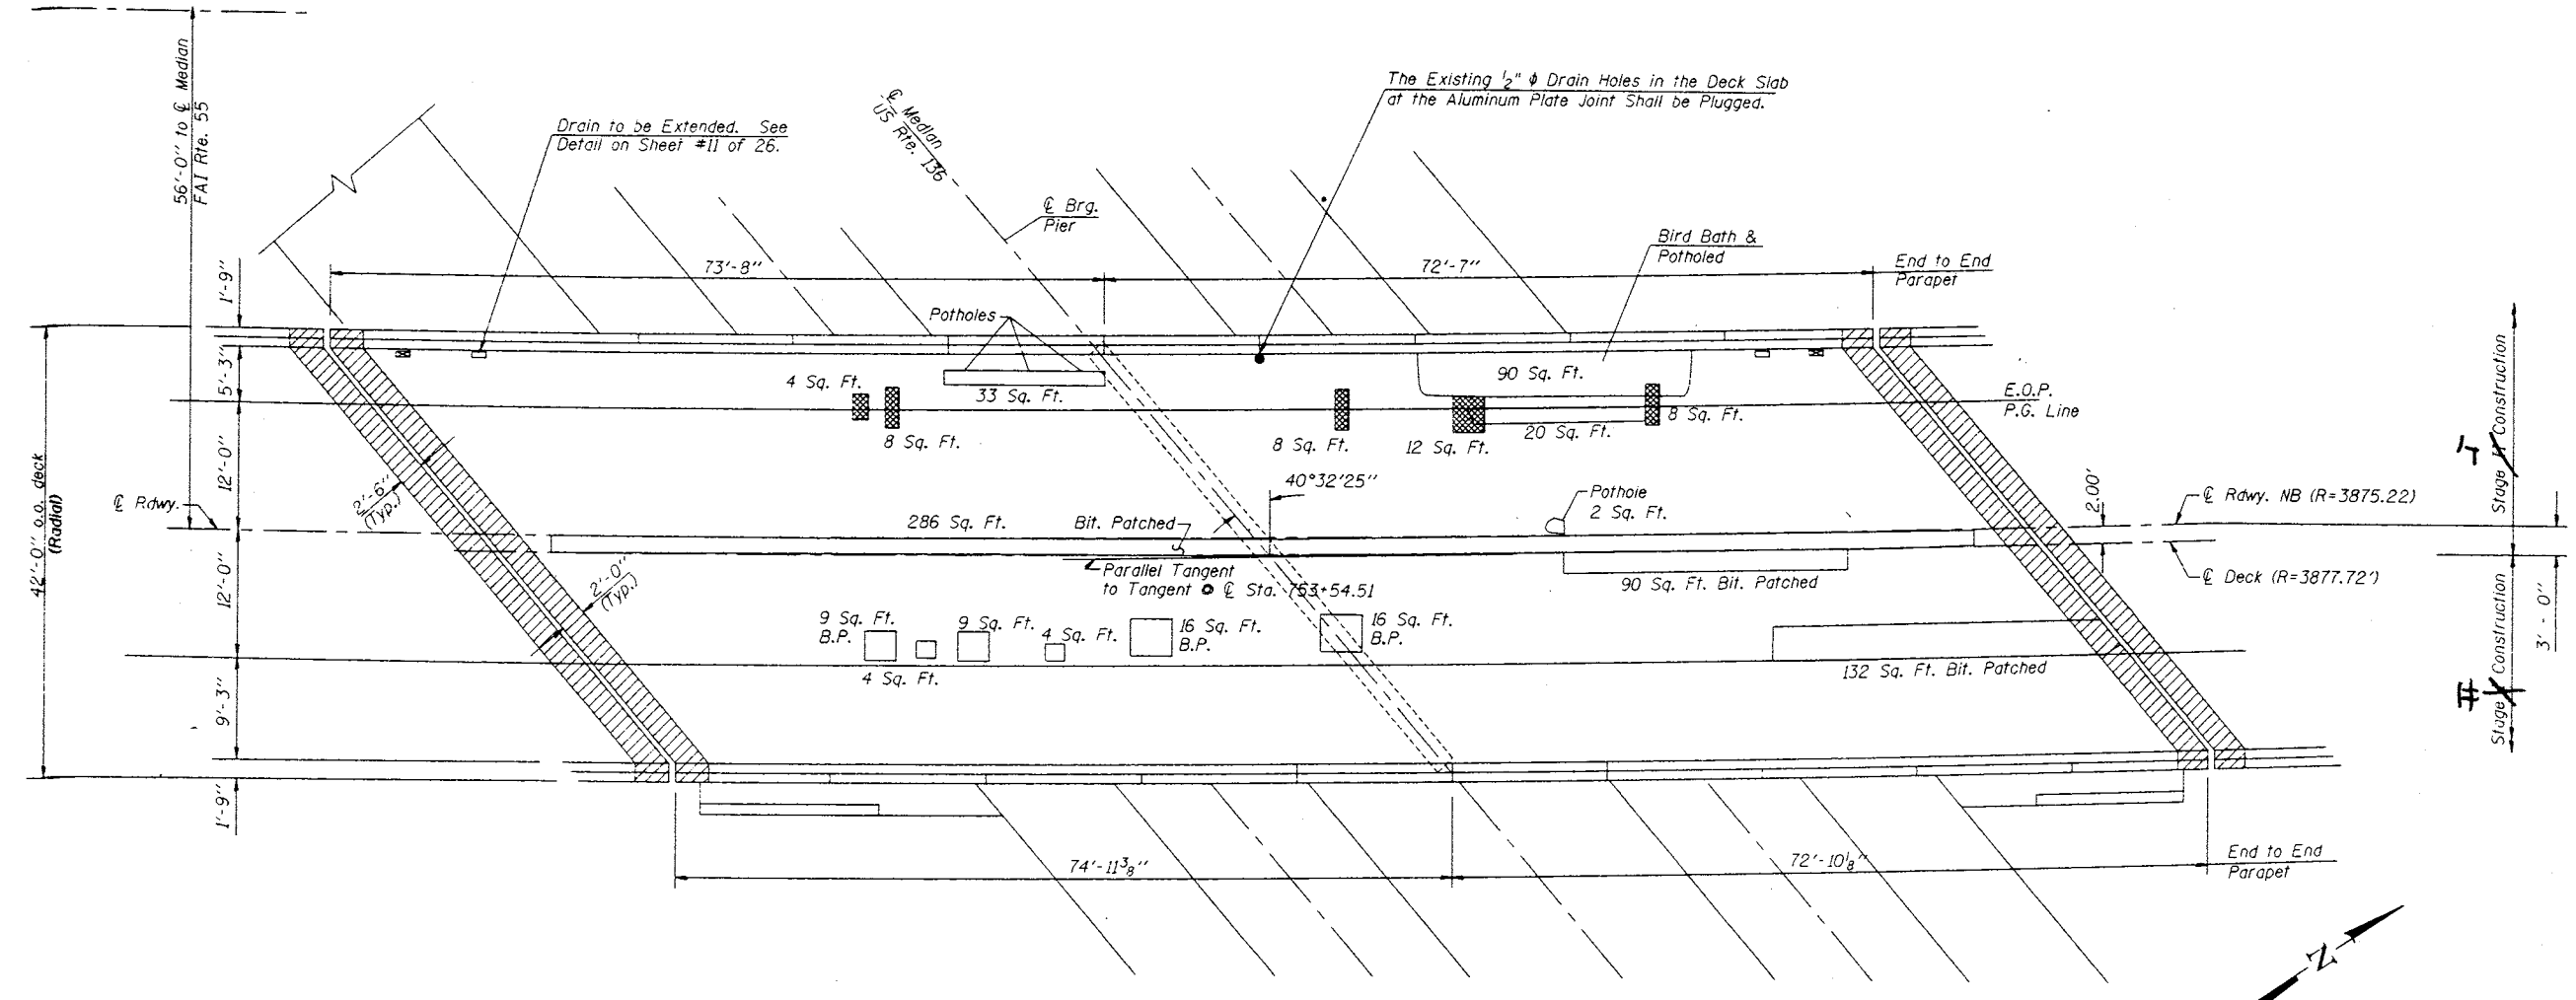

LEGEND

- Deck Slab Repair (Partial) w/ Est. Area
- Deck Slab Repair (Full Depth)
- Crack, width > 1/16" } Epoxy Crack Sealing
- Drain to be Plugged. See Detail on Sheet #11 of 26.
- B.P. Bituminous Patch

DECK REPAIR - QUANTITY ESTIMATE

ITEM	QUANTITY
Deck Slab Repair (Partial)	114 Sq. Yd.
Deck Slab Repair (Full Depth) Type II	5 Sq. Yd.
Bituminous Concrete Removal (Deck)	926 Sq. Yd.
Concrete Bridge Deck Scarification 1/2"	874 Sq. Yd.
Bridge Deck Microsilica Concrete overlay 2 1/4"	874 Sq. Yd.
Bridge Deck Grooving	878 Sq. Yd.
Plug Existing Deck Drains	2 Each
Polymer Modified Portland Cement Mortar	1 Sq. Ft.
Floor Drain Extension	2 Each

DECK TOP PLAN (MAIN SPANS)


Note:
While performing the full depth deck repair, the contractor shall provide temporary protective shield to protect the traffic below without impinging on the existing vertical clearance. The contractor's method of protection shall be submitted to the Engineer for approval. The cost shall be included in the pay item "Deck Slab Repair (Full Depth) Type II".

Note - All transverse dimensions are radial.

LIN ENGINEERING, LTD.
 20 N. CHESTNUT
 QUINN, ILLINOIS 62429
 (618) 463-8624 FAX (618) 463-8726
 Designed By: STD Checked By: KRG Drawn By: FML
 Date: 10/00 File: EXHIBIT 54-155.DWG

REVISIONS	
NAME	DATE

ILLINOIS DEPARTMENT OF TRANSPORTATION
DECK REPAIR PLAN
NORTH BOUND LANES
STRUCTURE # 057-0155
F.A.I. 55 SEC. (57-8, 57-9, 57-10) RS & I
McCLEAN COUNTY
STA. 753+54.41

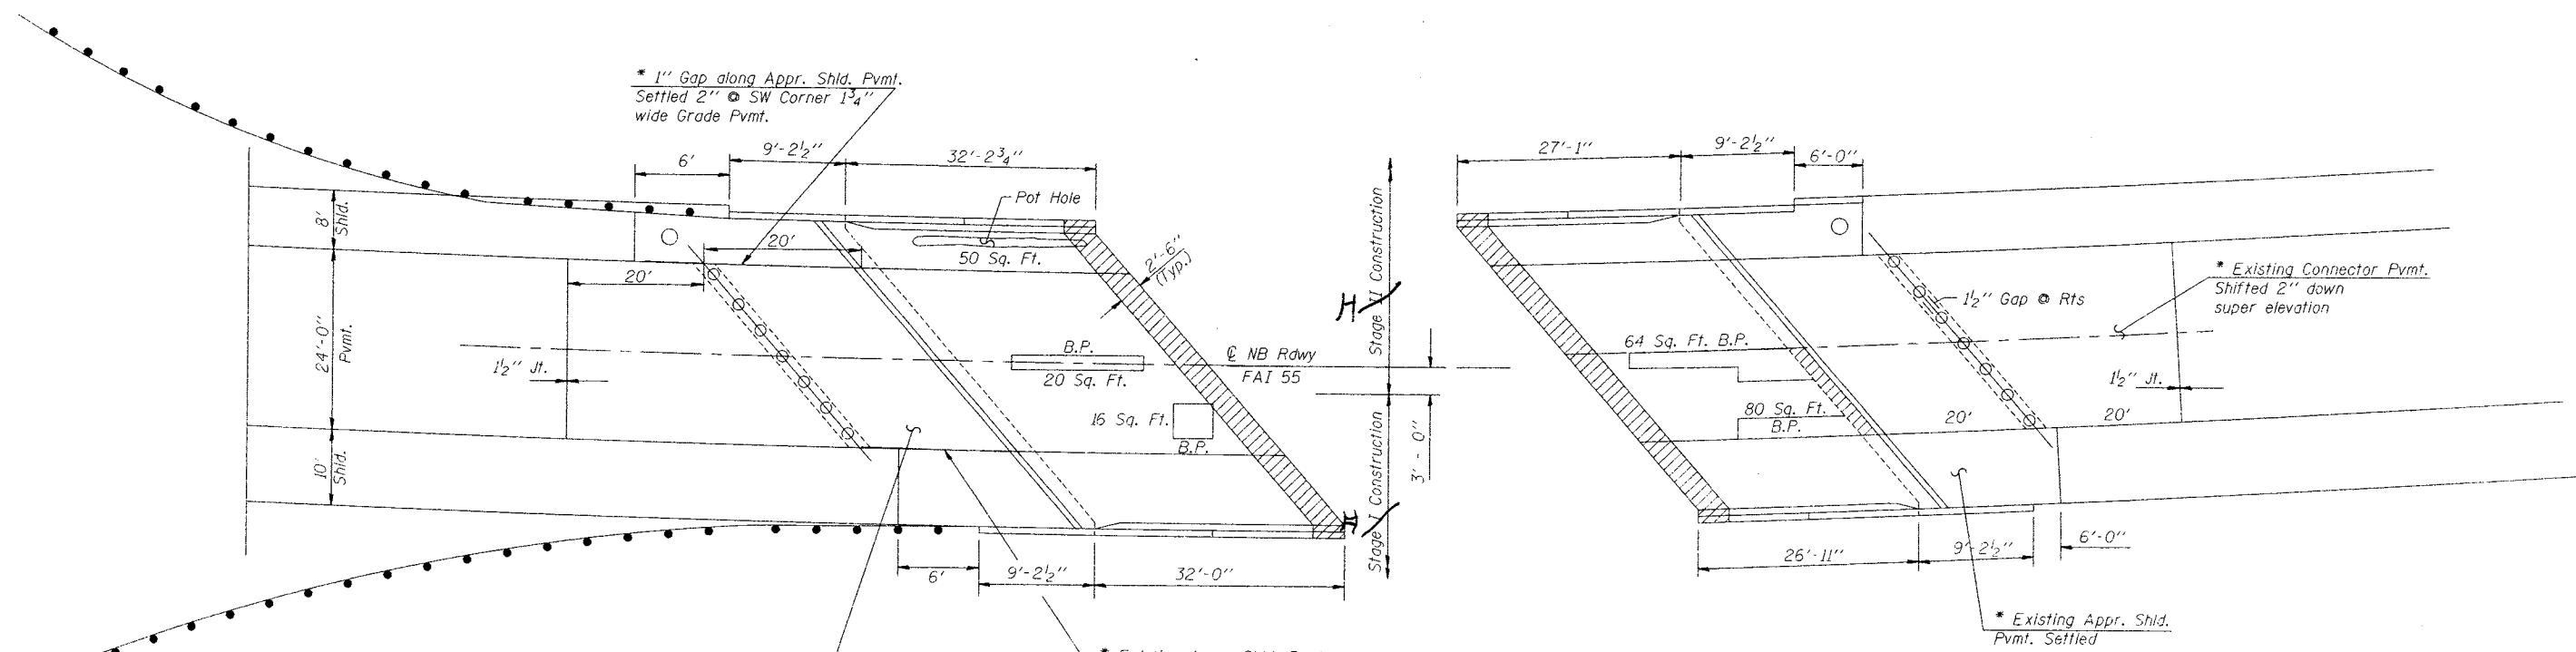

Note: Approach Span quantities included in Table on Sheet 13 of 26.

**DECK TOP PLAN
(APPROACH SPANS)**

* See Special Provisions for SUBSEALING OF CONCRETE PAVEMENT


For Notes & Legend See Sheet 13 of 26.

LIN ENGINEERING, LTD.
 200 W. Chastnut
 Chatham, Illinois 62629
 (618) 482-4668
 Fax: (618) 482-4166
 Designed By: STD Checked By: KRK Drawn By: FML
 Date: 10/00 File: EXHIBIT154-155.DGN

REVISIONS	
NAME	DATE

ILLINOIS DEPARTMENT OF TRANSPORTATION
DECK REPAIR PLAN - APPROACH SPANS
 NORTH BOUND LANES
 STRUCTURE # 057-0155
 F.A.I. 55 SEC. (57-8, 57-9, 57-10) RS & I
 McCLEAN COUNTY
 STA. 753+54.41

FAI RTE NO.	SECTION	COUNTY	TOTAL SHEETS	SHEET NO.
FAI 55	**	McCLEAN	163	64
FED. RD. DIST. NO.	ILLINOIS	FED. AID PROJECT		
** (57-8, 57-9, 57-10) RS & I Sheet No. 15				
26 Sheets				

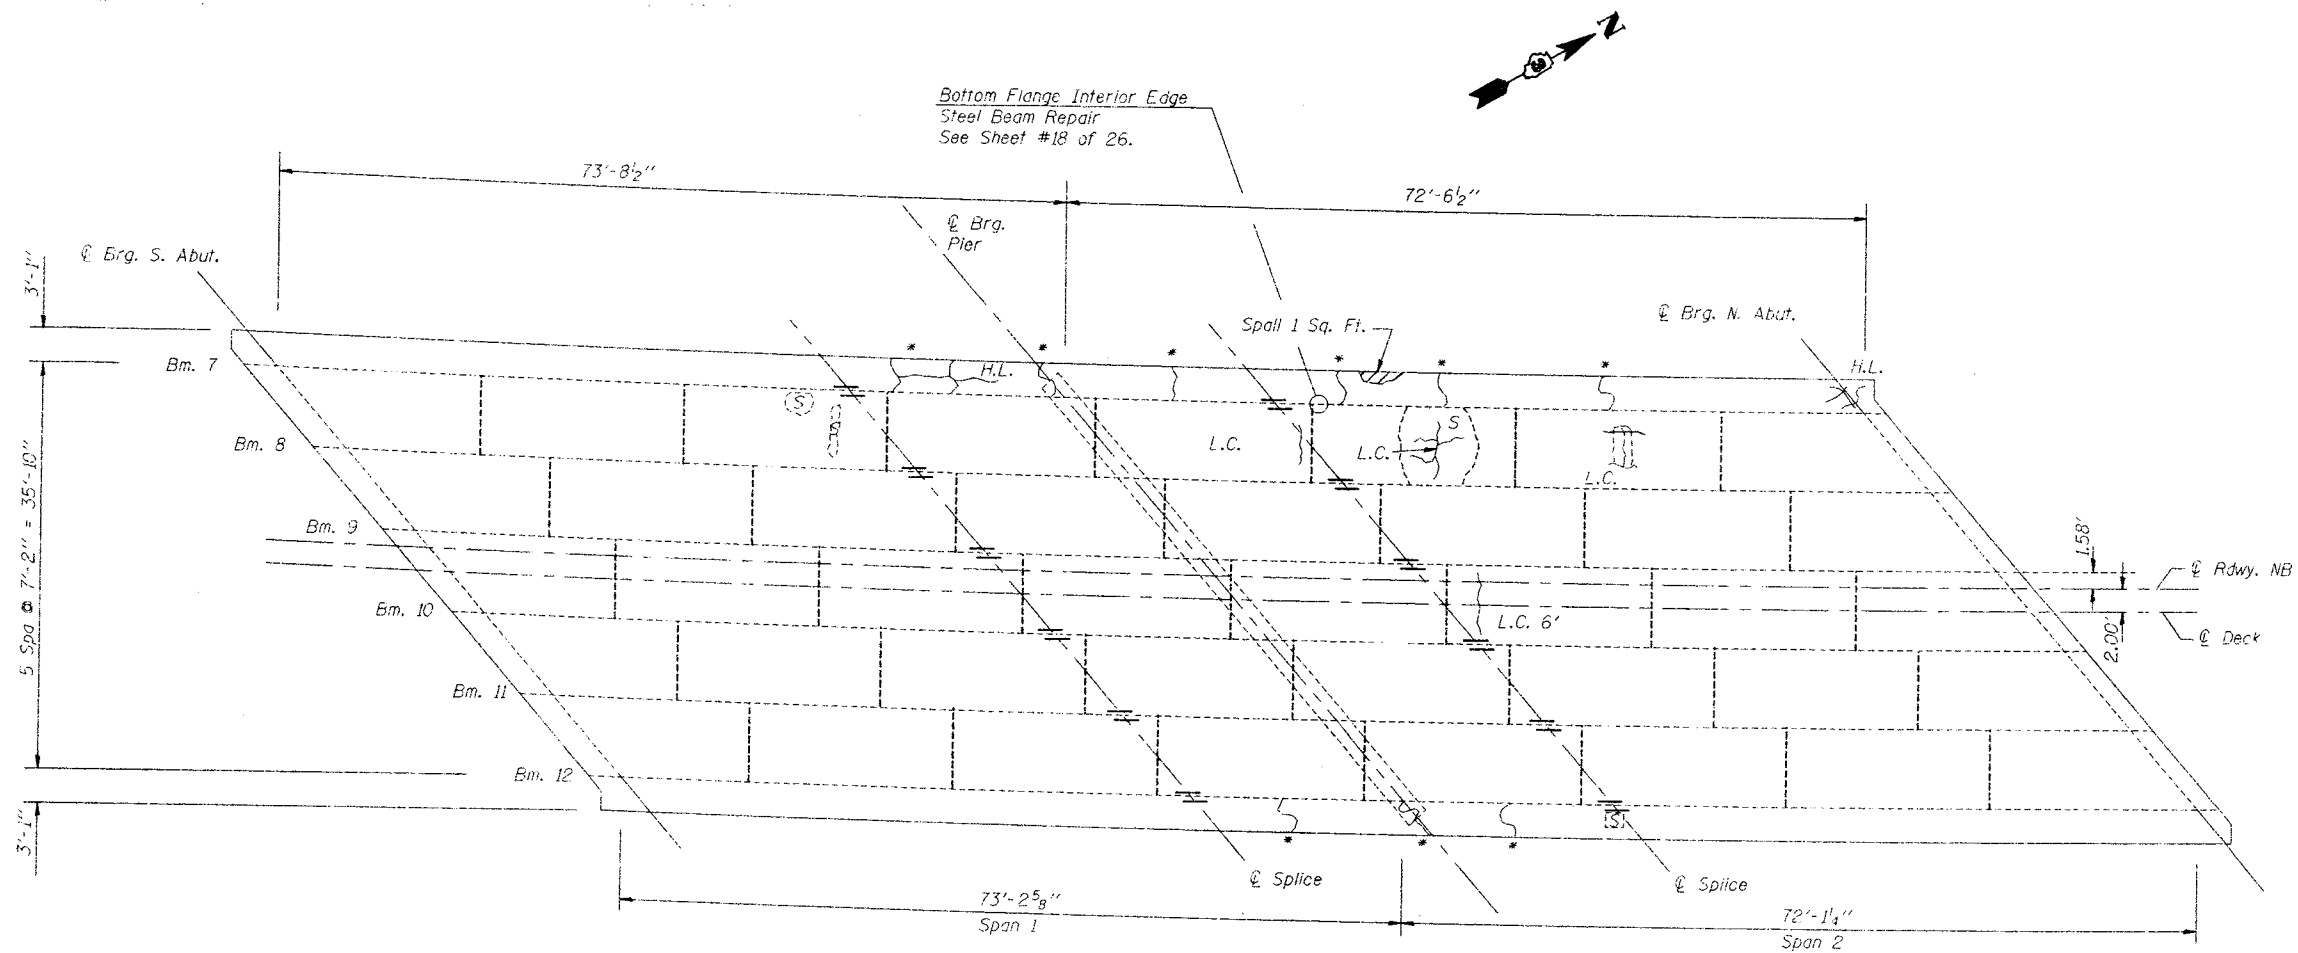

UNDERSIDE DECK PLAN - REFLECTED

Note: Quantities are included in Table on Sheet #13 of 26.

LEGEND



- Inspection Date 6-22-00
Method: Visual
- L.C. Leached Crack > 1/16" width } Epoxy Crack Sealing
 - C Crack > 1/16" width } Epoxy Crack Sealing
 - * Leached Crack at Parapet Joint
 - (S) Moisture Stain
 - (O) Spall Area } Polymer Modified Portland Cement Mortar
 - H.L. Hair Line Crack

LIN ENGINEERING, LTD.
 301 W. Chestnut Chatham, Illinois 62825
 (618) 483-4100 FAX (618) 483-4106
 Designed By: STD Checked By: KRG Drawn By: FAE
 Date: 10/00 File: EXHIBIT154-155.DGN

REVISIONS	
NAME	DATE

ILLINOIS DEPARTMENT OF TRANSPORTATION
UNDERSIDE DECK PLAN - MAIN SPANS
NORTH BOUND LANES
STRUCTURE # 057-0155
F.A.I. 55 SEC. (57-8, 57-9, 57-10) RS & I
McCLEAN COUNTY
STA. 753+54.41

FAI RTE NO.	SECTION	COUNTY	TOTAL SHEETS	SHEET NO.
FAI 55	**	McCLEAN	163	65
FED. RD. DIST. NO.	ILLINOIS	FED. AID PROJECT		
** (57-8, 57-9, 57-10) RS & I Sheet No. 16				
26 Sheets				

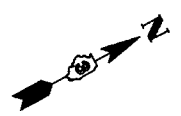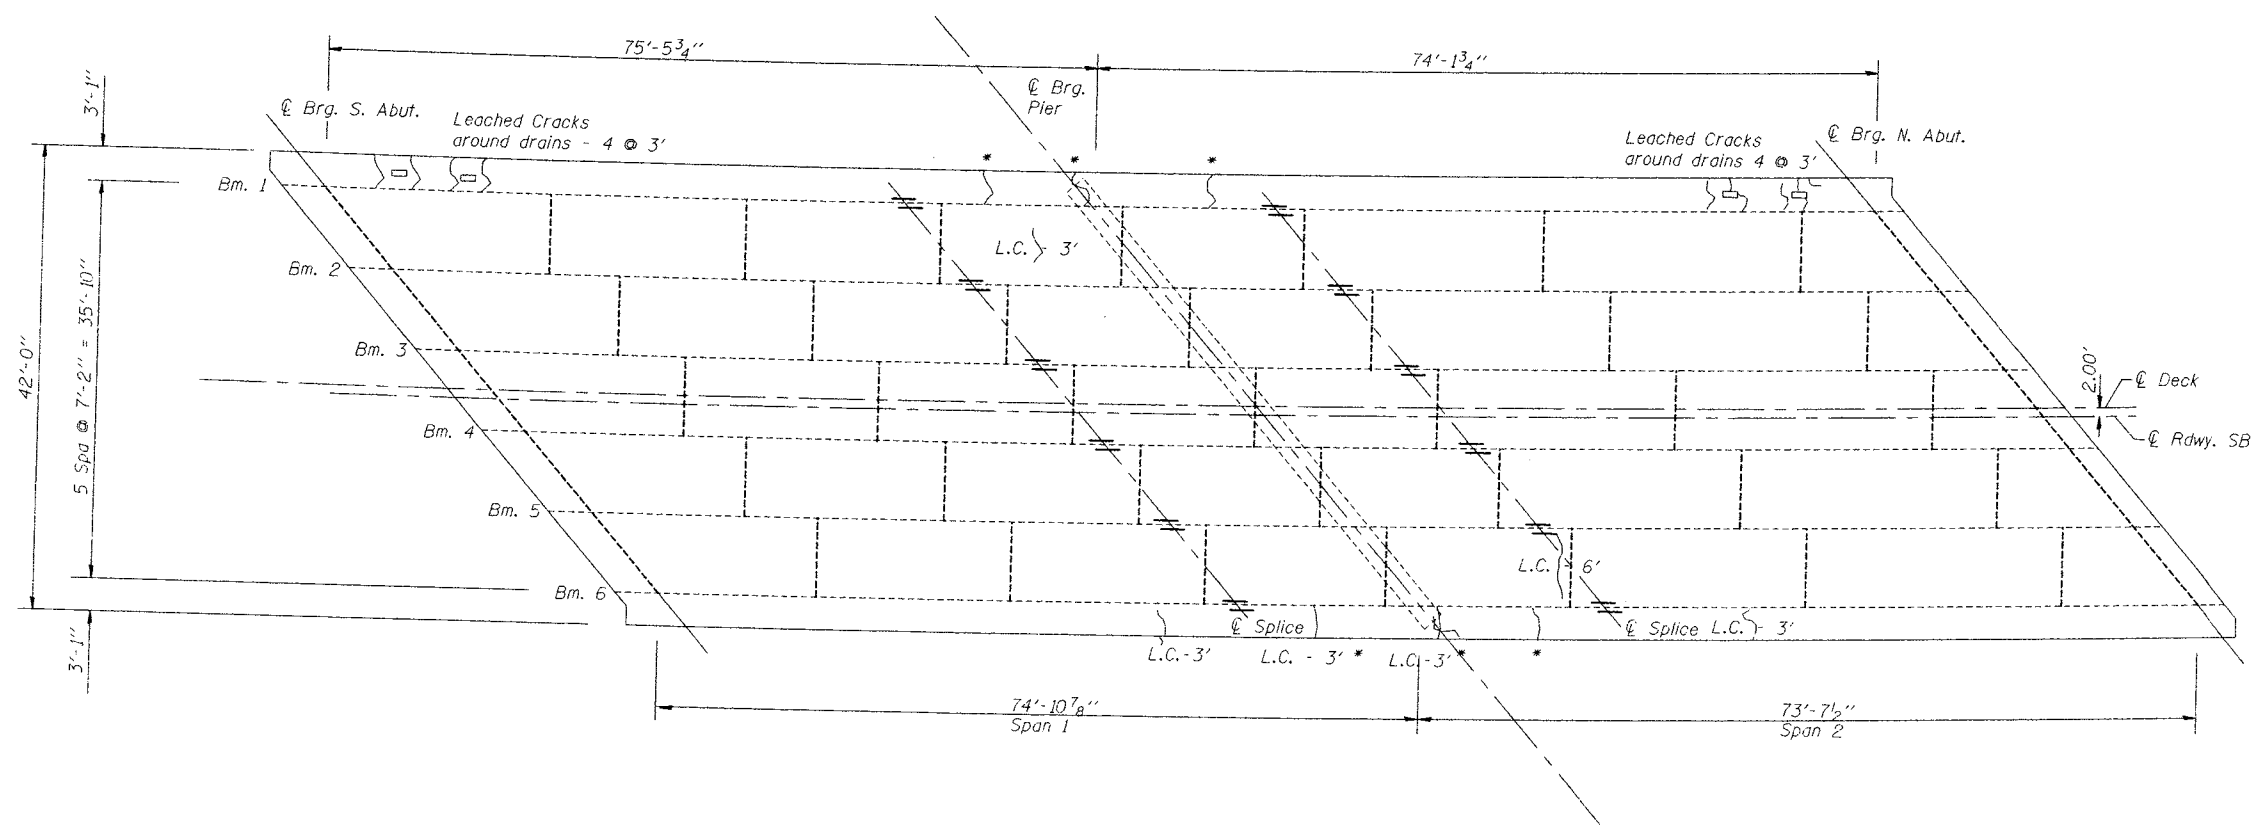

UNDERSIDE DECK PLAN - REFLECTED


- LEGEND**
- Inspection Date 6-22-00
 - Method: Visual
 - L.C. Leached Crack > 1/16" width } Epoxy Crack Sealing
 - C-3' Crack > 1/16" width }
 - * Leached Crack at Parapet Joint
 - (S) Moisture Stain
 - (⊗) Spall Area } Formed Concrete Repair (Depth = 5')
 - H.L. Hairline Crack

Note: Quantities are included in Table on Sheet #11 of 26.

LIN ENGINEERING, LTD.
 20 W. Chestnut
 (217) 483-4668
 Chatham, Illinois 62629
 FAX (217) 483-4126
 Designed By: STD Checked By: KRK Drawn By: FWL
 Date: 10/00 File: EXHIBIT/54-155.DGN


REVISIONS	
NAME	DATE

ILLINOIS DEPARTMENT OF TRANSPORTATION
UNDERSIDE DECK PLAN - MAIN SPANS
 SOUTH BOUND LANES
 STRUCTURE # 057-0154
 F.A.I. 55 SEC. (57-8, 57-9, 57-10) RS & I
 McLEAN COUNTY
 STA. 753+54.41

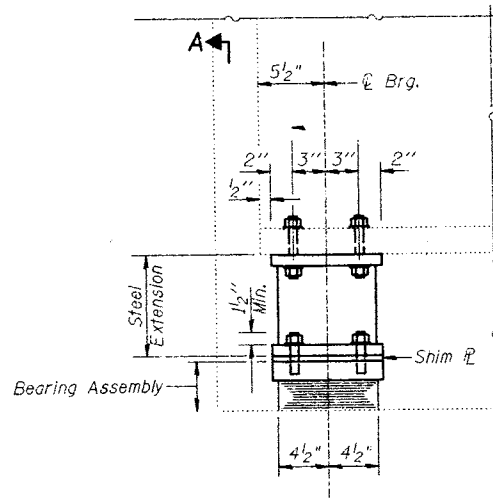


ELEVATION AT ABUT.

@ 7/8" holes in existing flange for 3/4" H.S. Bolts. These holes to be drilled in the field. Cost included with "Structural Steel."

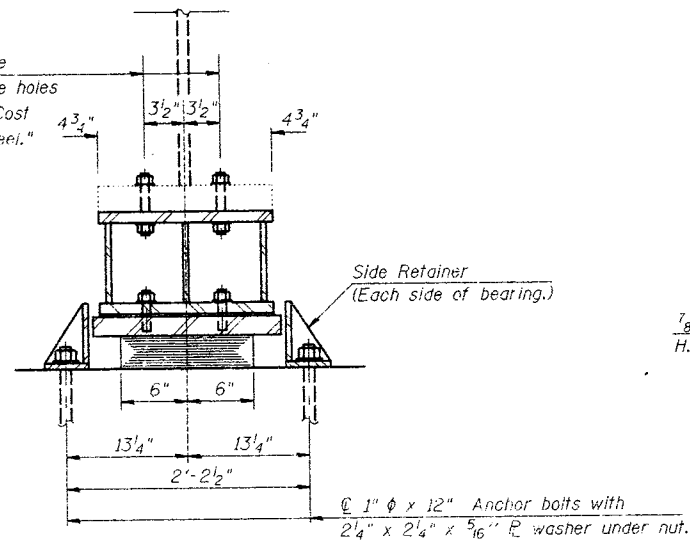


SECTION A-A

TYPE I ELASTOMERIC EXP. BRG.

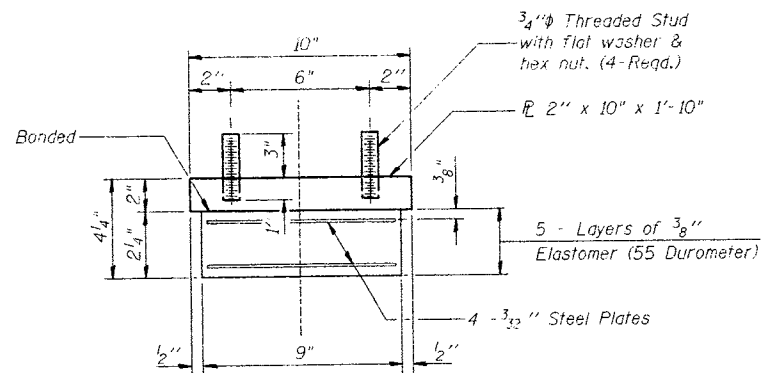

BEARING ASSEMBLY


Note: Shim plates shall not be placed under Bearing Assembly.

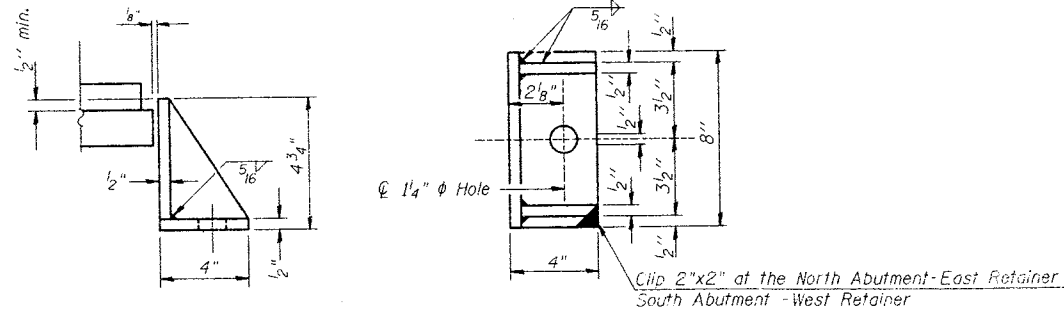


SIDE RETAINER

Equivalent rolled angle with stiffeners will be allowed in lieu of welded plates. Weight included with Structural Steel.

See Sheet #5 of 26 for Anchor Bolt Installation.

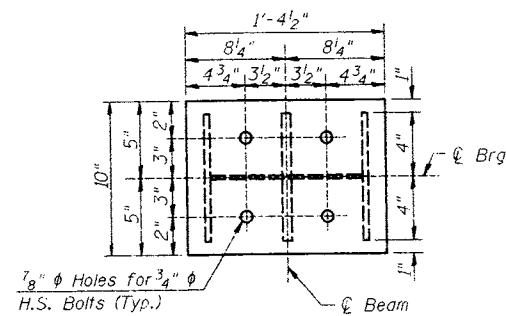


PLAN-TOP PLATE

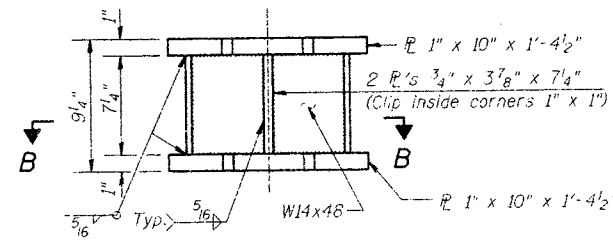


STEEL EXTENSION

Equivalent welded plates will be allowed in lieu of W14x48 section.

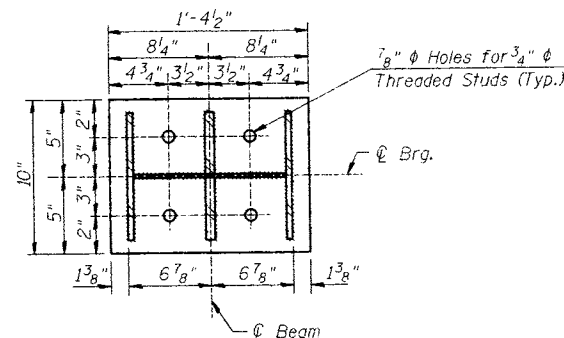

SECTION B-B

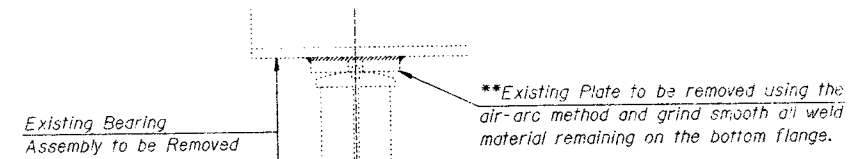

JACK AND REMOVE EXISTING BEARING AT ABUTMENTS

EXISTING REACTIONS AT ABUTMENTS

R _{DL}	38.4 k
R _{LL}	39.8 k
Impact	10.0 k
Total	88.2 k

JACK AND REMOVE EXISTING BEARING PROCEDURE AT ABUTMENTS

1. The Contractor shall submit for approval by the Engineer, plans for jacking prior to commencing any work at the bearings. Jack Capacity at each beam shall be 50 Tons.*
2. Jacking and removing existing bearings shall be done in stages.
3. Jacking shall be limited to a maximum of 1/8".
4. The new bearings and steel extensions shall be installed in place before the jacks are lowered.

*Includes effect from live load.

BILL OF MATERIAL

Item	Unit	Total
Elastomeric Bearing Assembly Type I	Each	24
Jack and Remove Existing Bearings	Each	24

Note: Prior to ordering any material, the contractor shall verify in the field all bearing height and shim thickness dimensions.

LIN ENGINEERING, LTD.


20 W. Chestnut
(217) 483-4668
Chatham, Illinois 62629
FAX (217) 483-4706
Designed By: STD Checked By: KRG Drawn By: MCB
Date: 10/00 File: BEARINGS.DWG

REVISIONS	
NAME	DATE


ILLINOIS DEPARTMENT OF TRANSPORTATION
BEARING DETAILS
NORTH BOUND AND SOUTH BOUND LANES
S.N. 057-0154 & 057-0155
F.A.I. 55 SEC. (57-8, 57-9, 57-10) RS & I
McLEAN COUNTY
STA. 753+54.41

FAI RTE NO.	SECTION	COUNTY	TOTAL SHEETS	SHEET NO.
FAI 55	**	McCLEAN	163	67
FED. RD. DIST. NO.	ILLINOIS	FED. AID PROJECT		


** (57-8, 57-9, 57-10) RS & I Sheet No. 18
26 Sheets

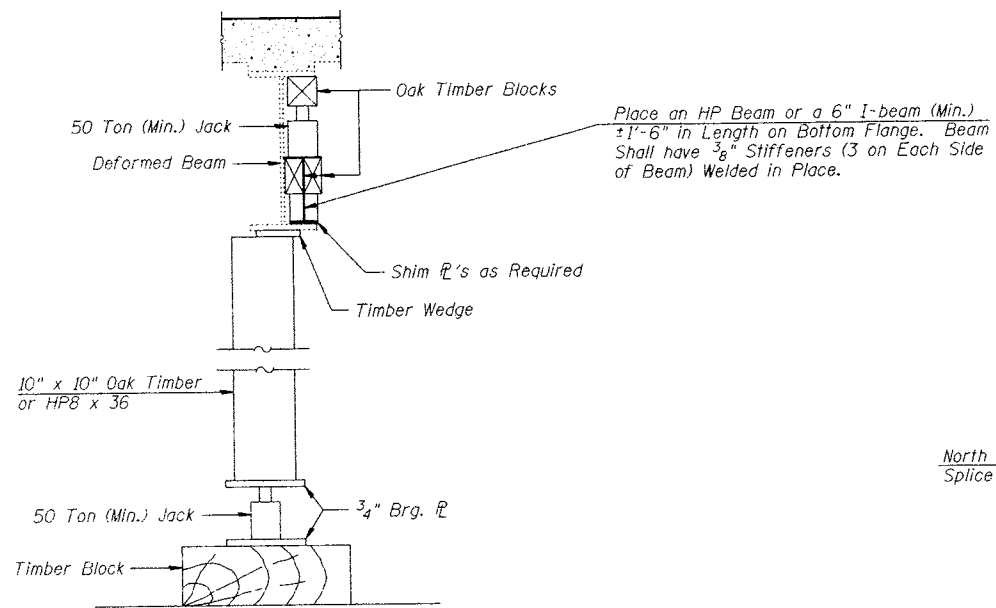

VERTICAL STRAIGHTENING DETAIL

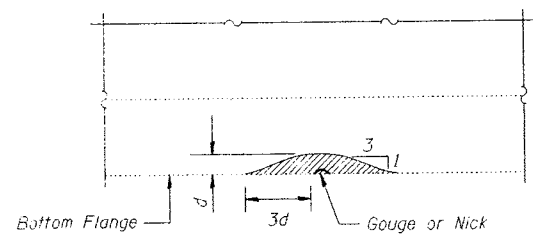


ELEVATION

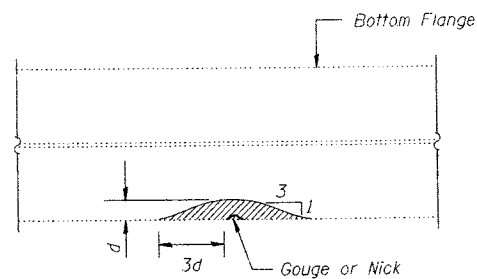

PLAN

GRINDING DETAIL

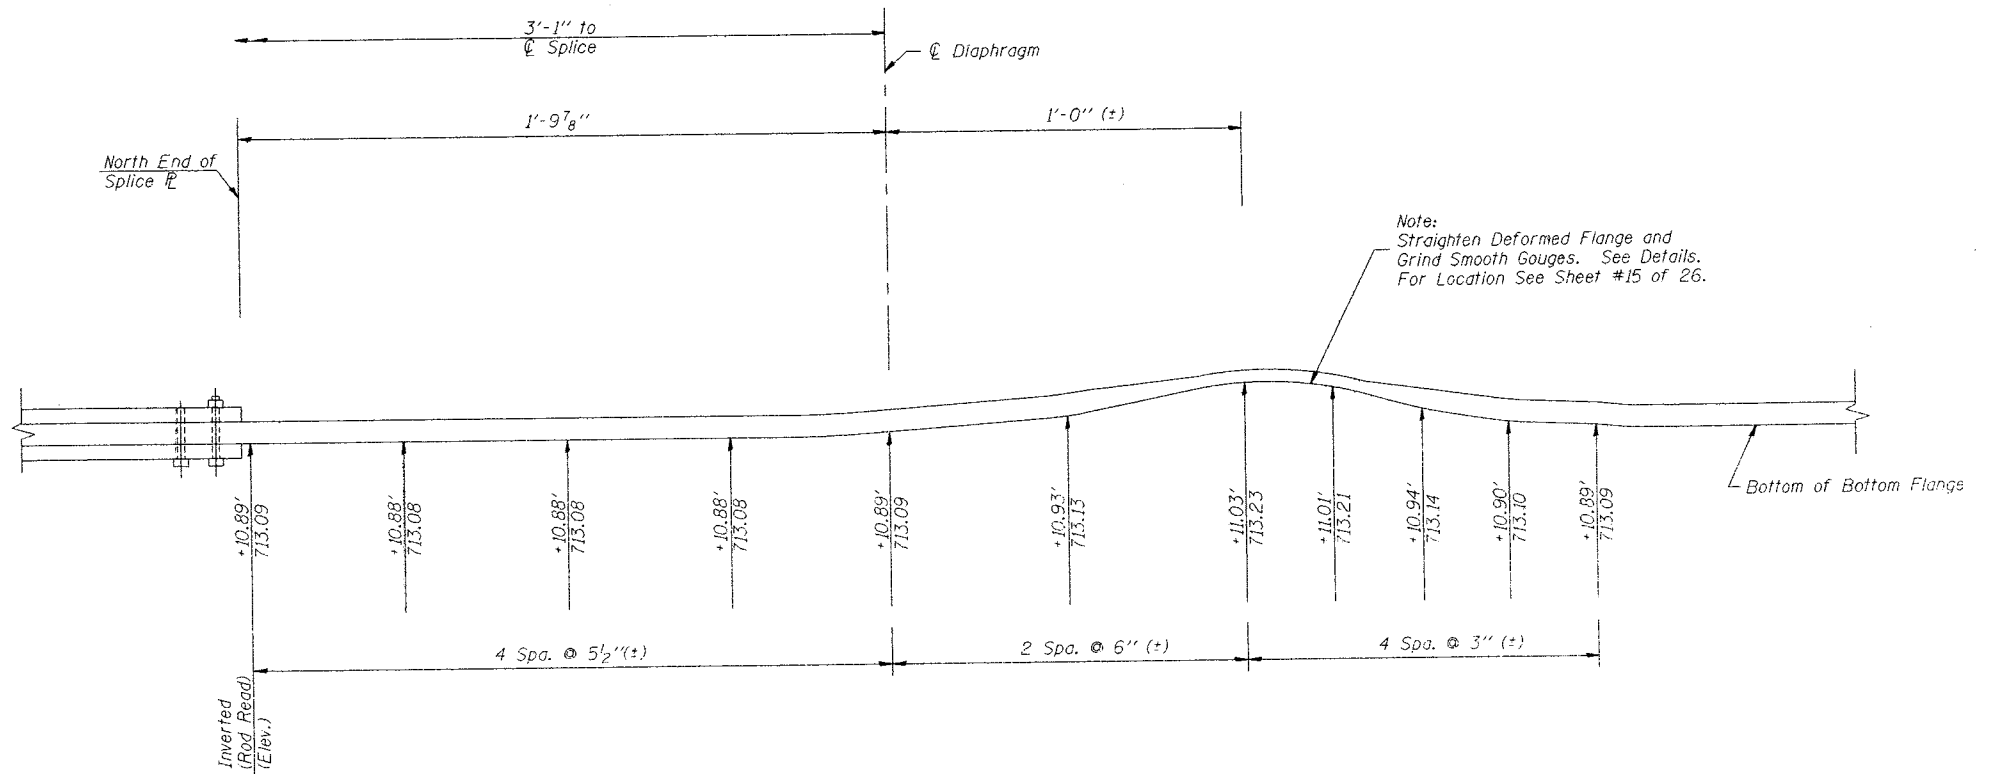

BOTTOM FLANGE INTERIOR EDGE PROFILE

B.M. LINE #7 (W36x230)


Assumed BM Top of Crashwall @ Crown
= Elev. 698.65
+3.55
H.I. = 702.20
-3.54
Top Crashwall = 698.66

LIN ENGINEERING, LTD.


210 W. Chestnut
Chattanooga, Illinois 62629
Tel: 463-4624
Fax: 463-4705
Designed By: STD Checked By: KRC Drawn By: FML
Date: 12/00 File: EXHIBIT154-155.DGN

REVISIONS	
NAME	DATE

ILLINOIS DEPARTMENT OF TRANSPORTATION
BEAM STRAIGHTENING
SOUTH BOUND LANES
STRUCTURE # 057-0155
F.A.I. 55 SEC. (57-8, 57-9, 57-10) RS & I
McCLEAN COUNTY
STA. 753+54.41

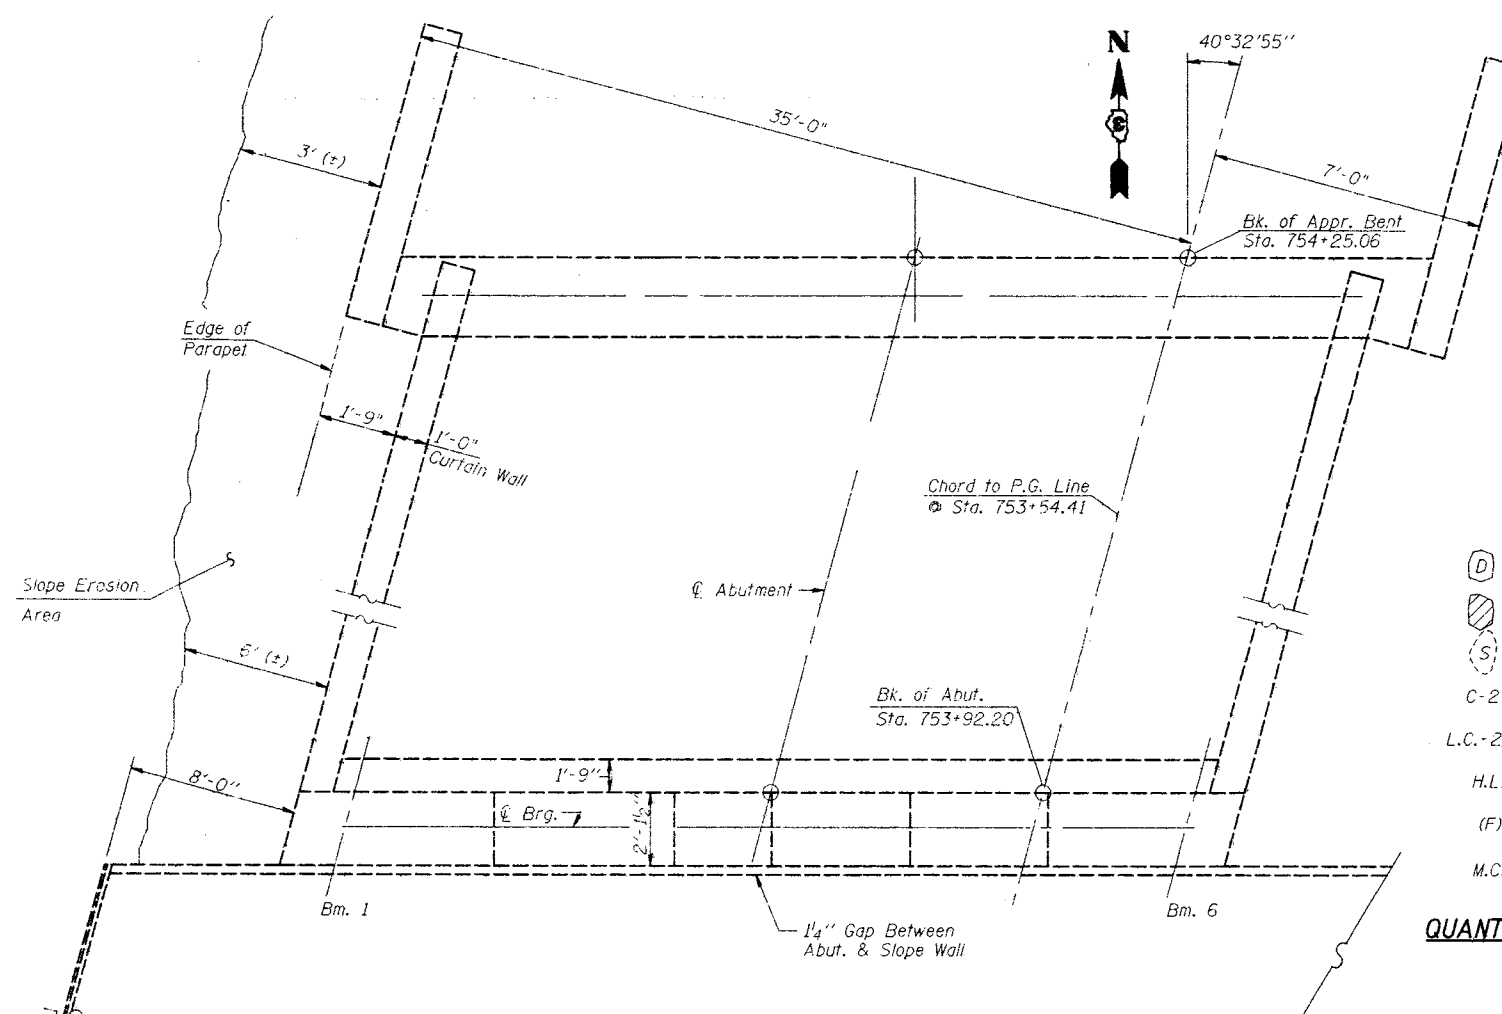


PLAN
(Looking North)

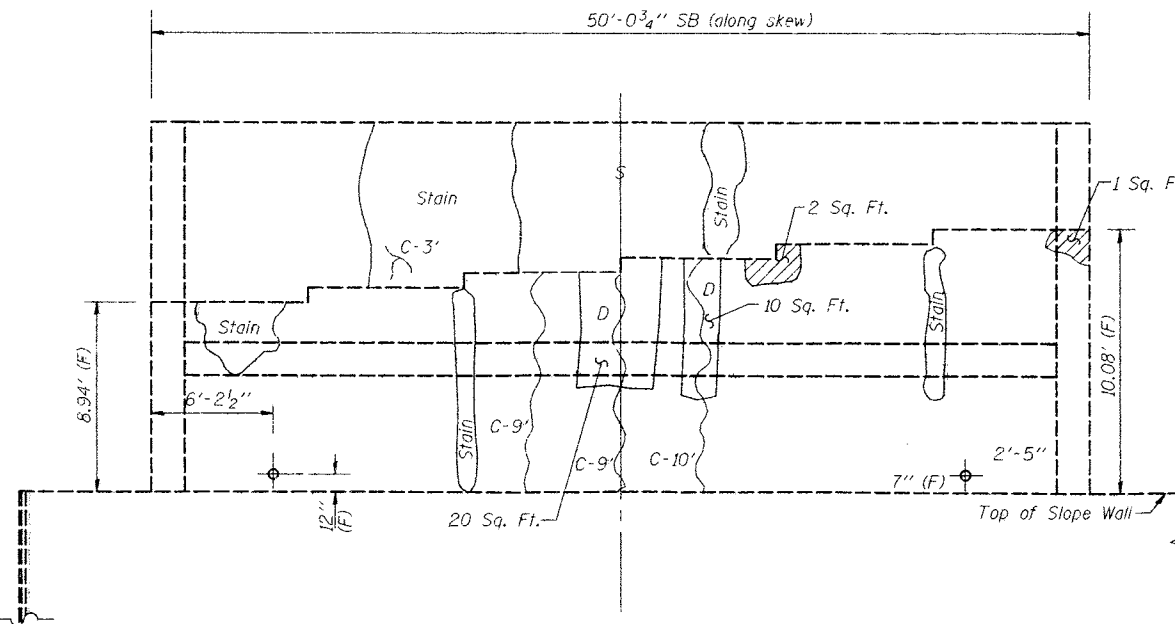


FRONT ELEVATION
(Looking North)

* Back fill embankment erosion areas along the exterior of abutment west wing walls and cover with broken concrete for protection. Cost included with Concrete Removal.

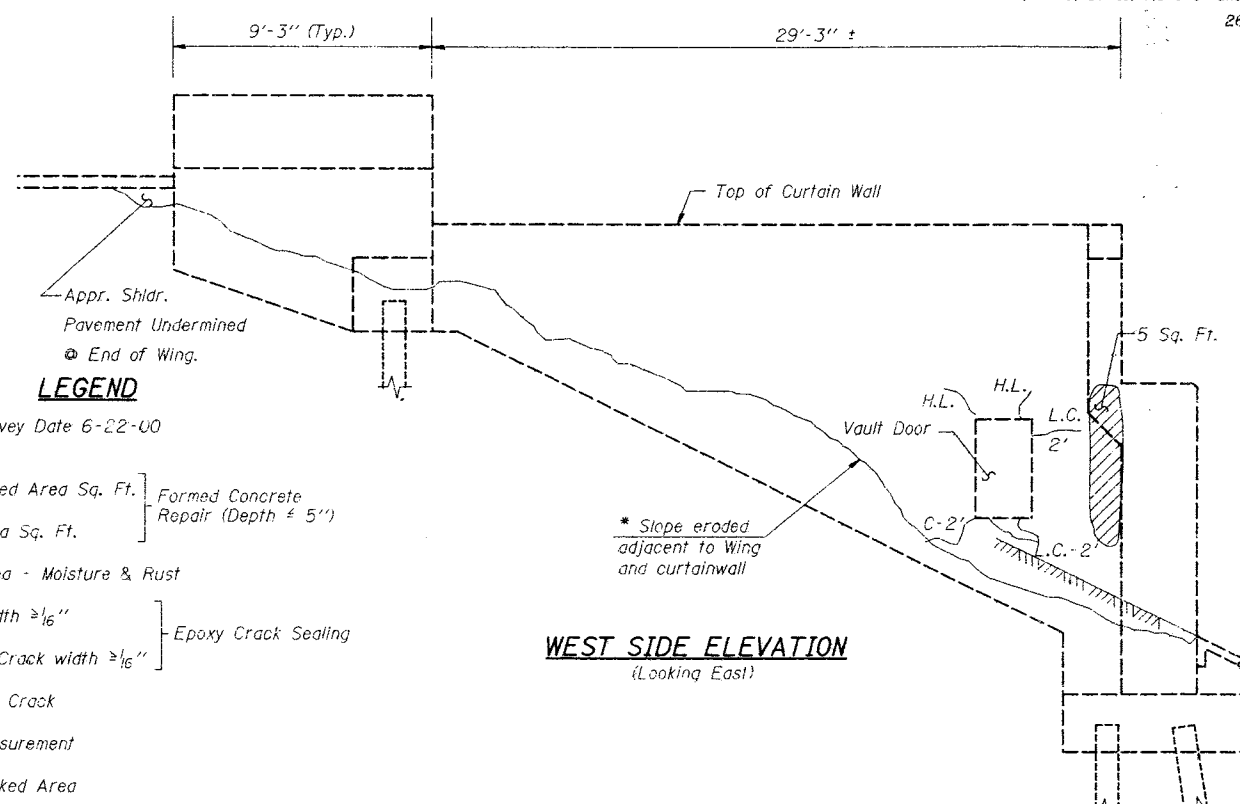

WEST SIDE ELEVATION
(Looking East)

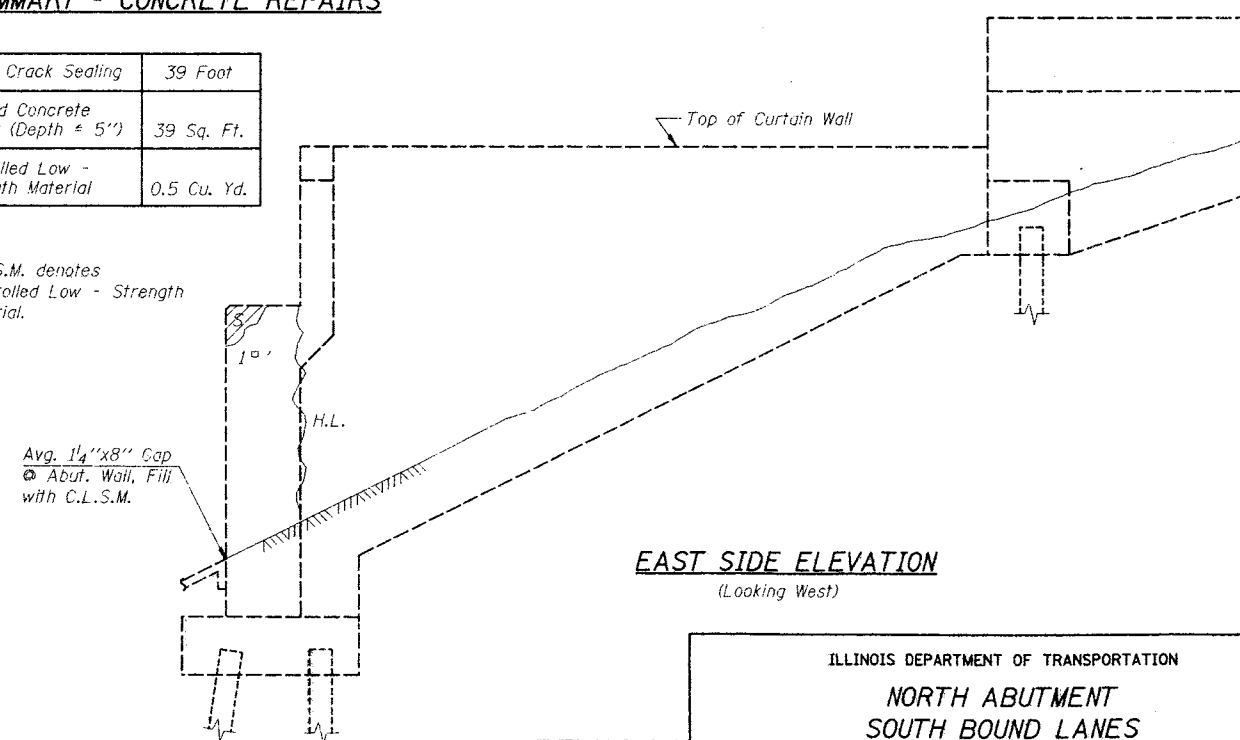

EAST SIDE ELEVATION
(Looking West)

LEGEND

- Deck Survey Date 6-22-00
- (D) Delaminated Area Sq. Ft. } Formed Concrete Repair (Depth ≠ 5")
- (S) Spall Area Sq. Ft. }
- (S) Stain Area - Moisture & Rust
- C-2' Crack width ≥ 1/16" } Epoxy Crack Sealing
- L.C.-2' Leached Crack width ≥ 1/16" }
- H.L. Hair Line Crack
- (F) Field Measurement
- M.C. Map Cracked Area

QUANTITY SUMMARY - CONCRETE REPAIRS


Epoxy Crack Sealing	39 Foot
Formed Concrete Repair (Depth ≠ 5")	39 Sq. Ft.
Controlled Low - Strength Material	0.5 Cu. Yd.

Note: C.L.S.M. denotes Controlled Low - Strength Material.


REVISIONS	
NAME	DATE

LIN ENGINEERING, LTD.
200 W. Chestnut
Chattanooga, Illinois 62629
(618) 483-4642 FAX (618) 483-4736
Designed By: STD Checked By: KRJ Drawn By: FM
Date: 12/00 File: EXHIBIT154-155.DGN

ILLINOIS DEPARTMENT OF TRANSPORTATION
NORTH ABUTMENT
SOUTH BOUND LANES
STRUCTURE # 057-0154
F.A.I. 55 SEC. (57-8, 57-9, 57-10) RS & I
McCLEAN COUNTY
STA. 753+54.41

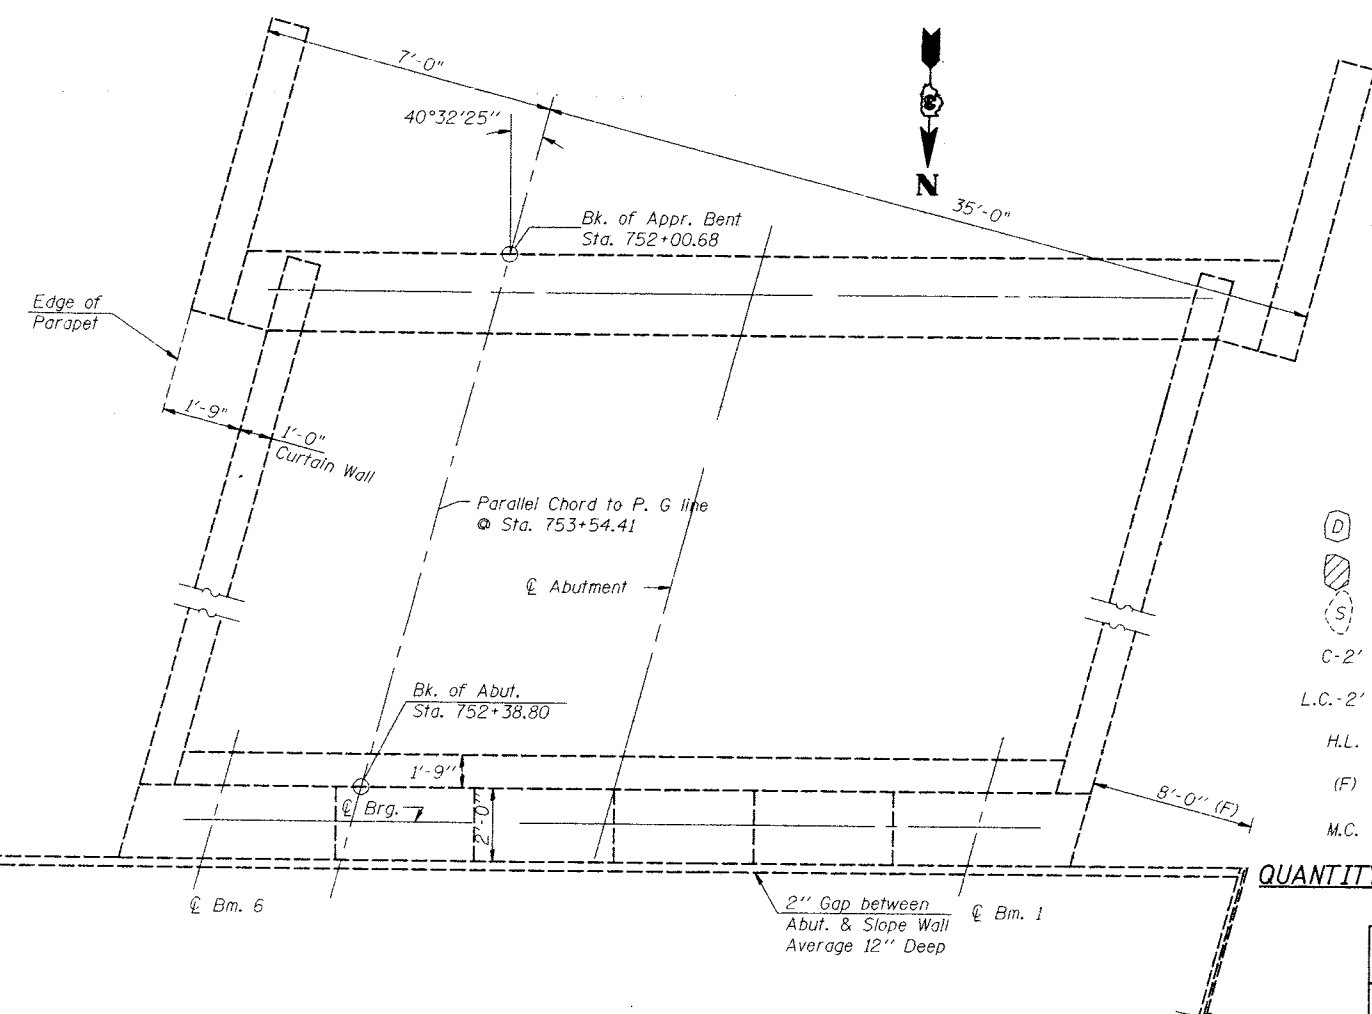

PLAN

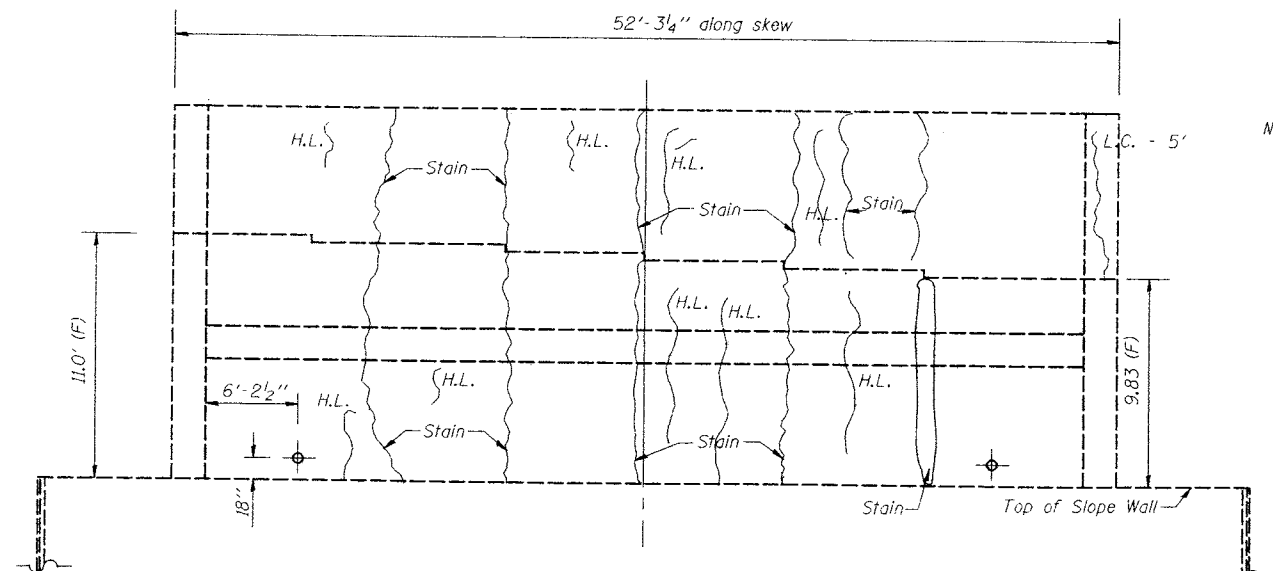

FRONT ELEVATION
(Looking South)

* Back fill embankment erosion areas along the exterior of abutment west wing walls and cover with broken concrete for protection. Cost included with Concrete Removal.


LEGEND

- Deck Survey Date 6-22-00
- (D) Delaminated Area Sq. Ft. } Formed Concrete Repair (Depth ≤ 5")
 - (S) Spall Area Sq. Ft. }
 - (S) Stain Area - Moisture & Rust
 - C-2' Crack width ≥ 1/16" } Epoxy Crack Sealing
 - L.C.-2' Leached Crack width ≥ 1/16" }
 - H.L. Hair Line Crack
 - (F) Field Measurement
 - M.C. Map Cracked Area


QUANTITY SUMMARY - CONCRETE REPAIRS

Epoxy Crack Sealing	16 Foot
Controlled Low - Strength Material	0.5 Cu. Yd.

Note: C.L.S.M. denotes Controlled Low - Strength Material.

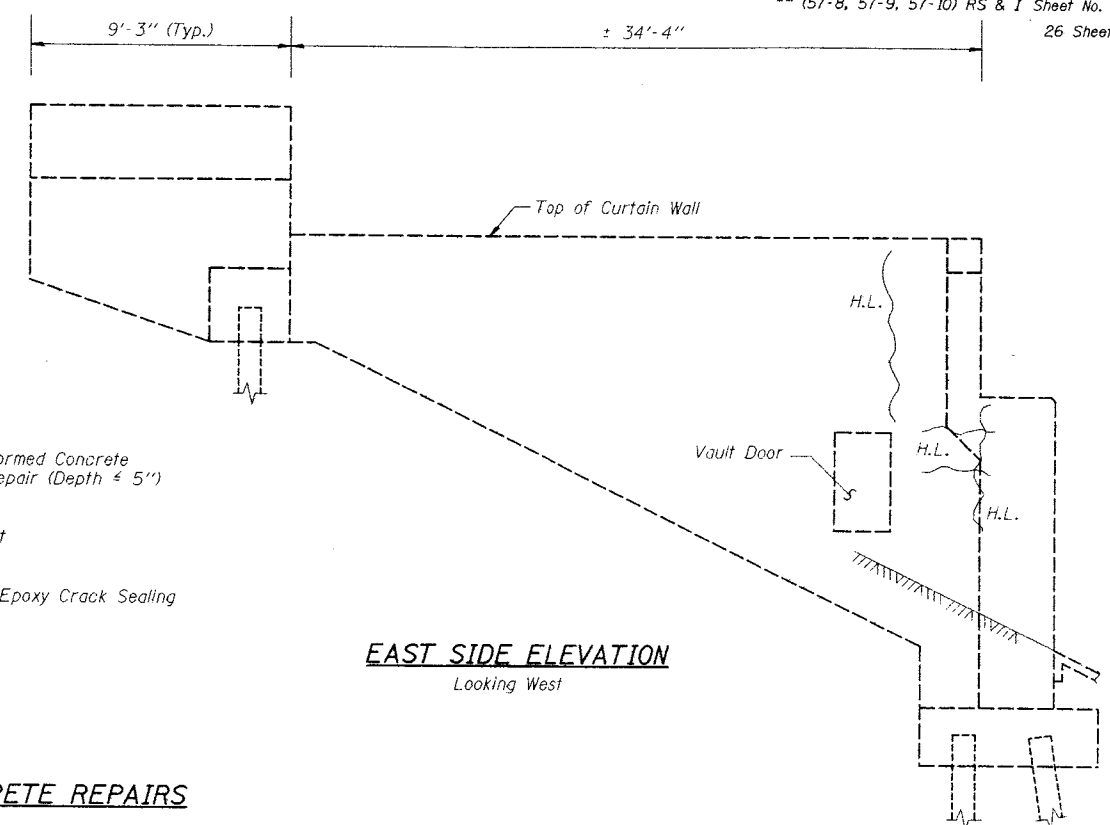

EAST SIDE ELEVATION
Looking West

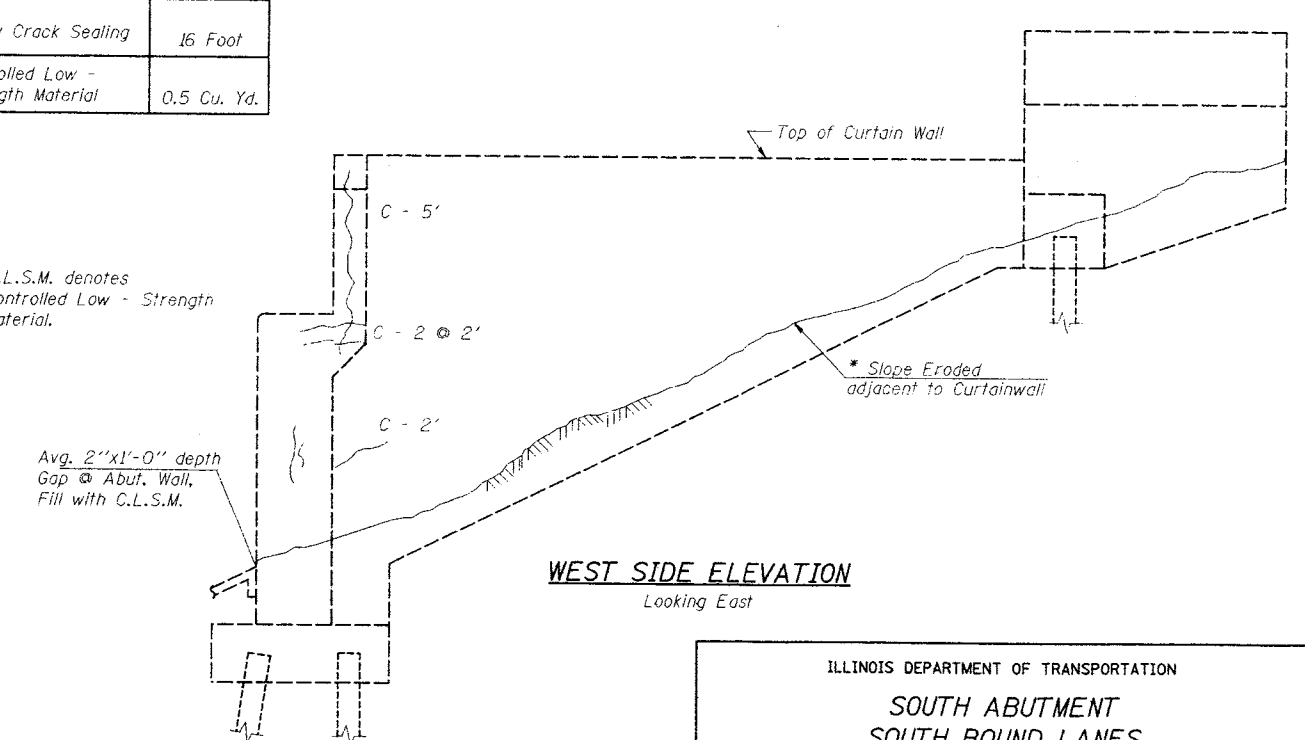


WEST SIDE ELEVATION
Looking East

LIN ENGINEERING, LTD.
20 W. Chestnut
Channahon, Illinois 62629
(815) 483-8688 FAX (815) 483-4706
Designed By: STD Checked By: KRG Drawn By: FML
Date: 10/00 File: EXHIBIT 54-155.DGN


REVISIONS	
NAME	DATE

ILLINOIS DEPARTMENT OF TRANSPORTATION
SOUTH ABUTMENT
SOUTH BOUND LANES
STRUCTURE # 057-0154
F.A.I. 55 SEC. (57-8, 57-9, 57-10) RS & I
McCLEAN COUNTY
STA. 753+54.41

FAI RTE NO.	SECTION	COUNTY	TOTAL SHEETS	SHEET NO.
FAI 55	##	McCLEAN	163	70
FED. RD. DIST. NO.	ILLINOIS	FED. AID PROJECT		
## (57-8, 57-9, 57-10) RS & I			Sheet No. 21	
			26 Sheets	

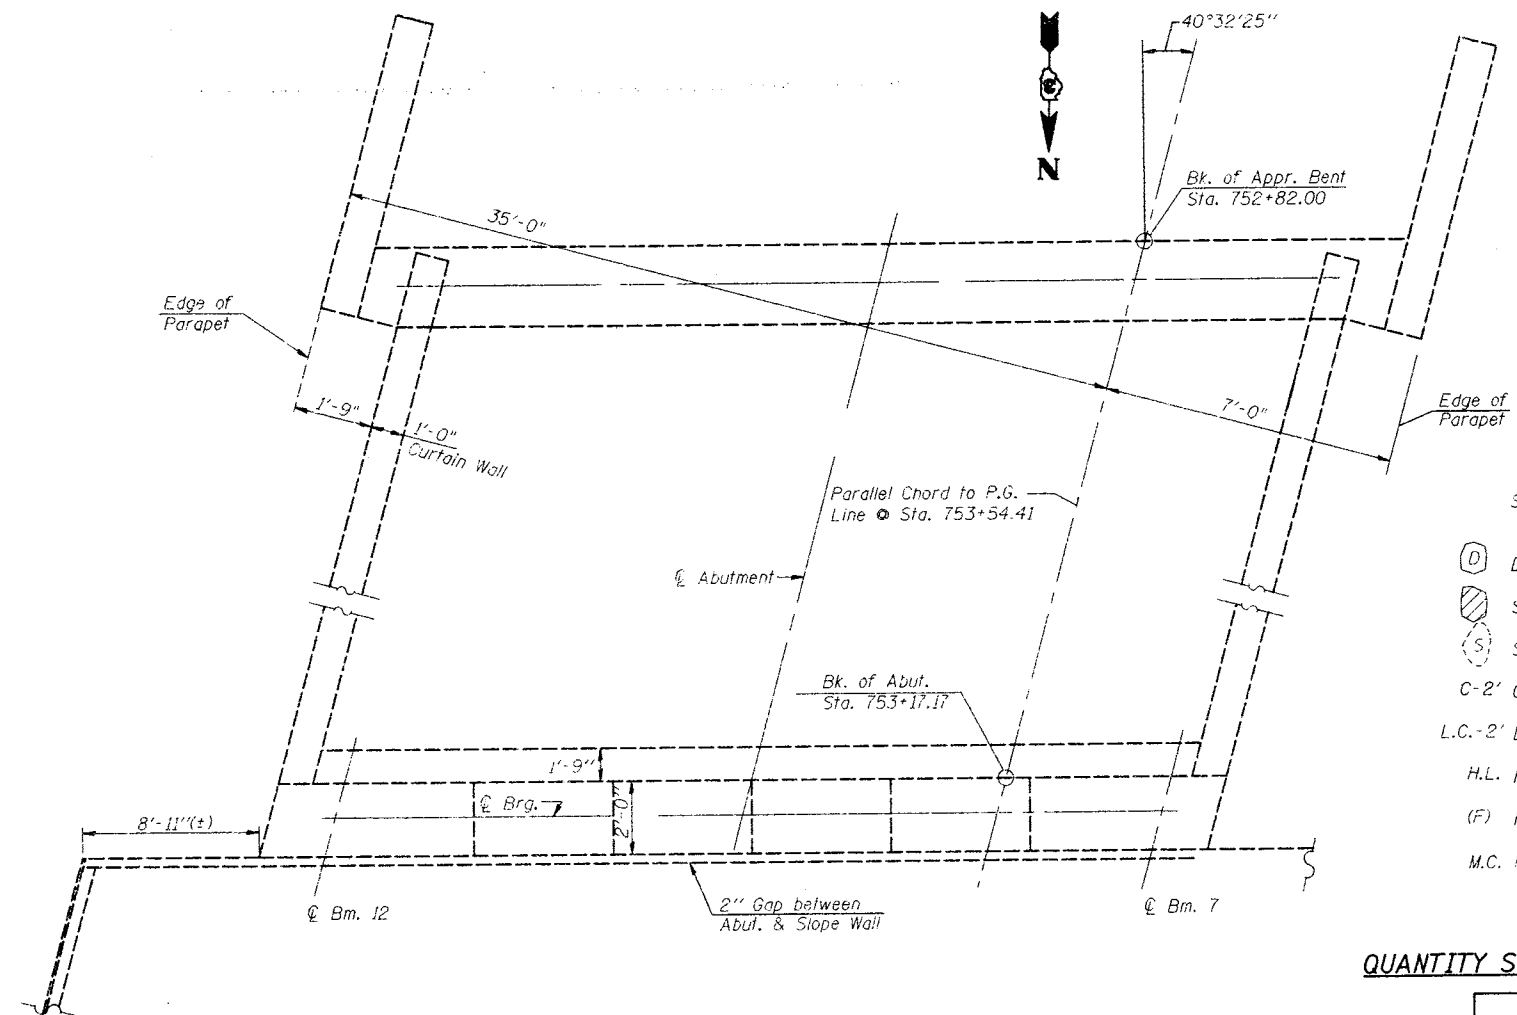

PLAN

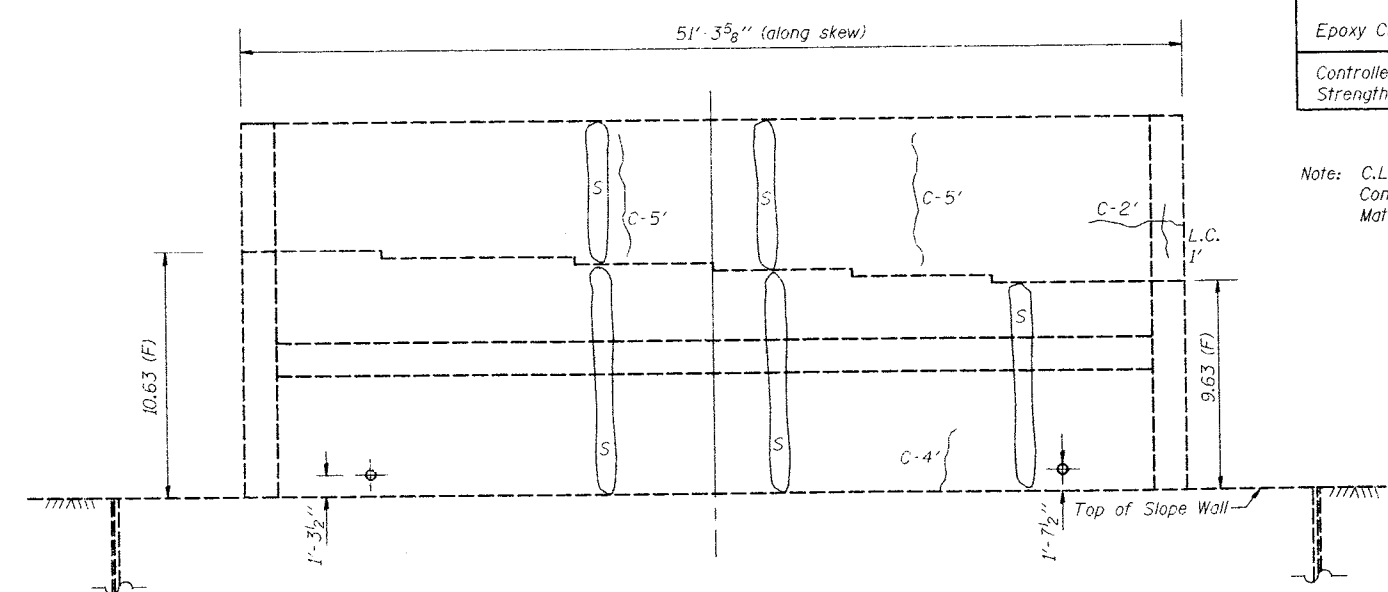

FRONT ELEVATION
(Looking South)

LEGEND


- Survey Date 6-22-00
- (D) Delaminated Area Sq. Ft. } Fermed Concrete Repair (Depth ≠ 5")
 - (S) Spall Area Sq. Ft. }
 - (S) Stain Area - Moisture & Rust
 - C-2' Crack width ≥ 1/16" } Epoxy Crack Sealing
 - L.C.-2' Leached Crack width ≥ 1/16" }
 - H.L. Hair Line Crack
 - (F) Field Measurement
 - M.C. Map Cracked Area

QUANTITY SUMMARY - CONCRETE REPAIRS


ITEM	QUANTITY
Epoxy Crack Sealing	28 Foot
Controlled Low - Strength Material	0.5 Cu. Yd.

Note: C.L.S.M. denotes Controlled Low - Strength Material.

Avg. 2"x 1'-8" Depth Gap @ Abut. Wall, Fill with C.L.S.M.

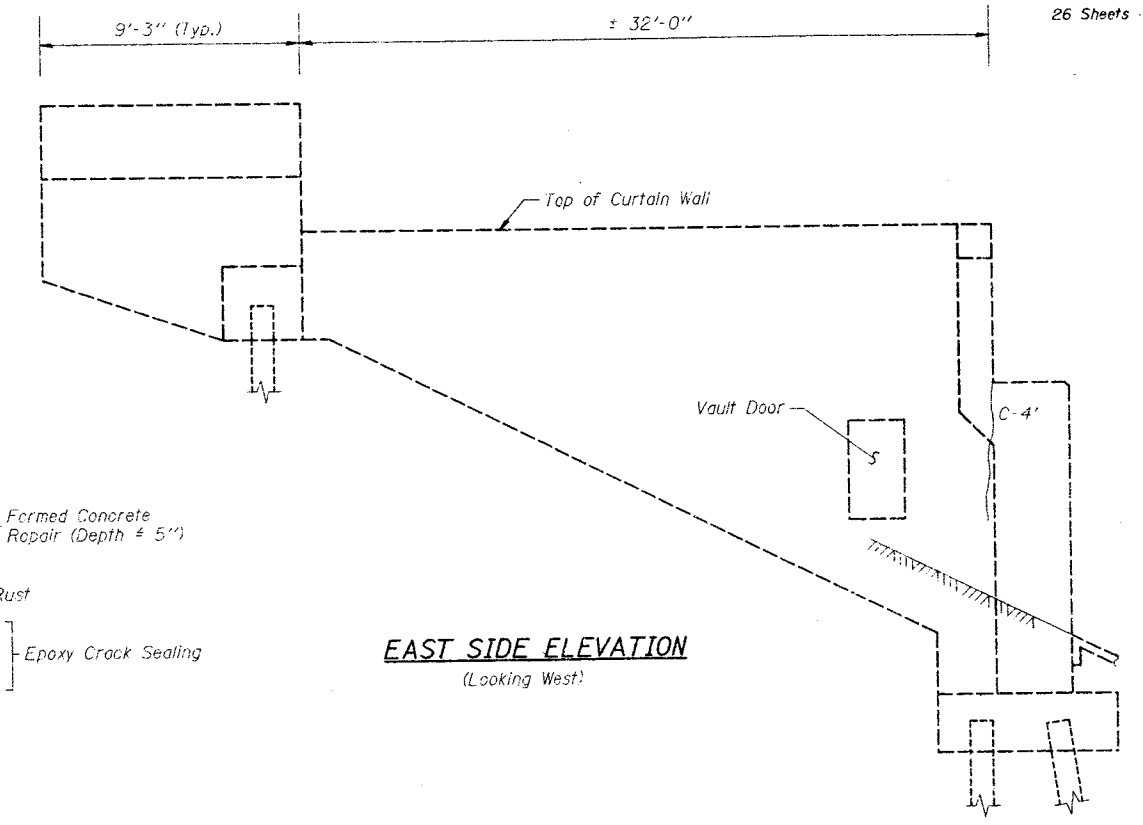

EAST SIDE ELEVATION
(Looking West)


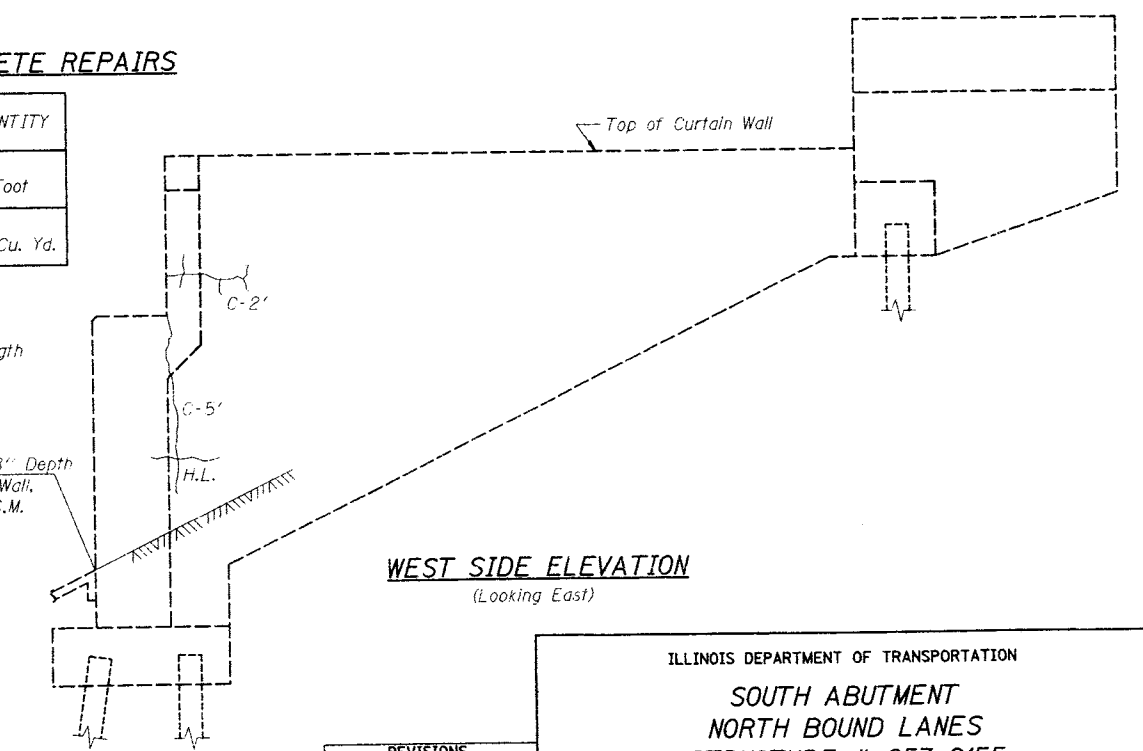


WEST SIDE ELEVATION
(Looking East)


LIN ENGINEERING, LTD.
200 W. Chestnut
Channahon, Illinois 62629
(815) 483-4068
FAX (815) 483-4106
Designed By: STD Checked By: KRG Drawn By: FML
Date: 11/00 File: EXHIBIT/54-155.DGN

REVISIONS	
NAME	DATE

ILLINOIS DEPARTMENT OF TRANSPORTATION
SOUTH ABUTMENT
NORTH BOUND LANES
STRUCTURE # 057-0155
F.A.I. 55 SEC. (57-8, 57-9, 57-10) RS & I
McCLEAN COUNTY
STA. 753+54.41

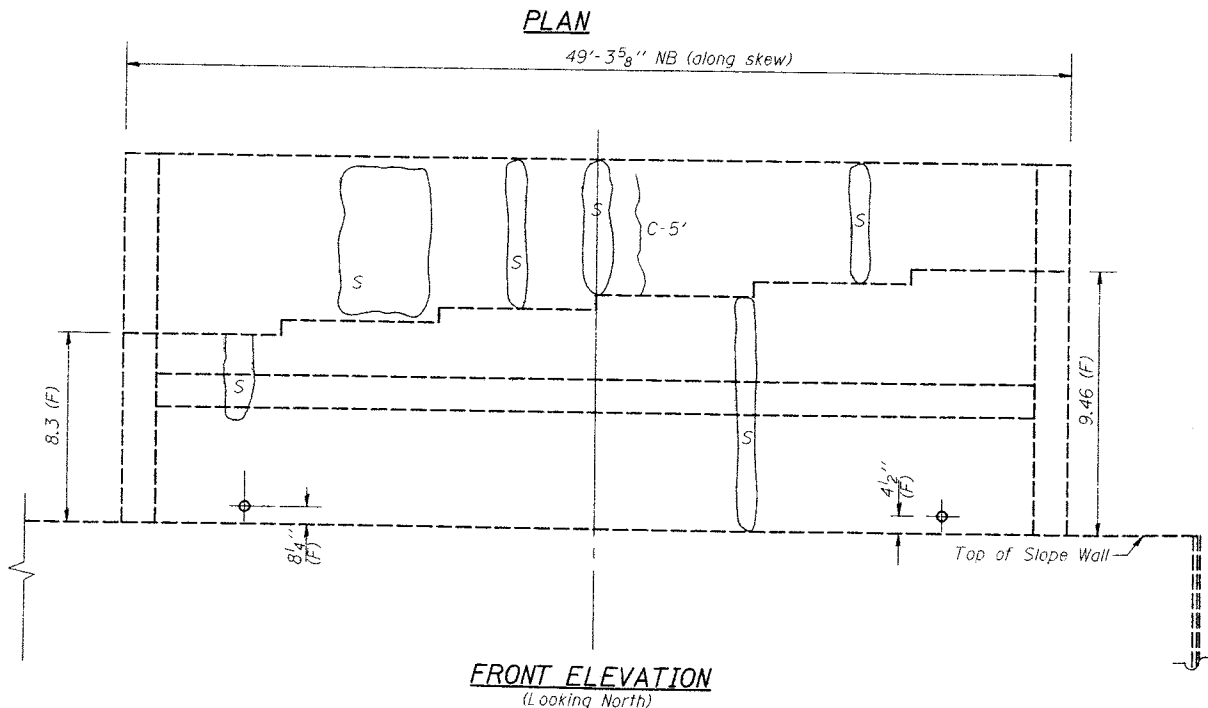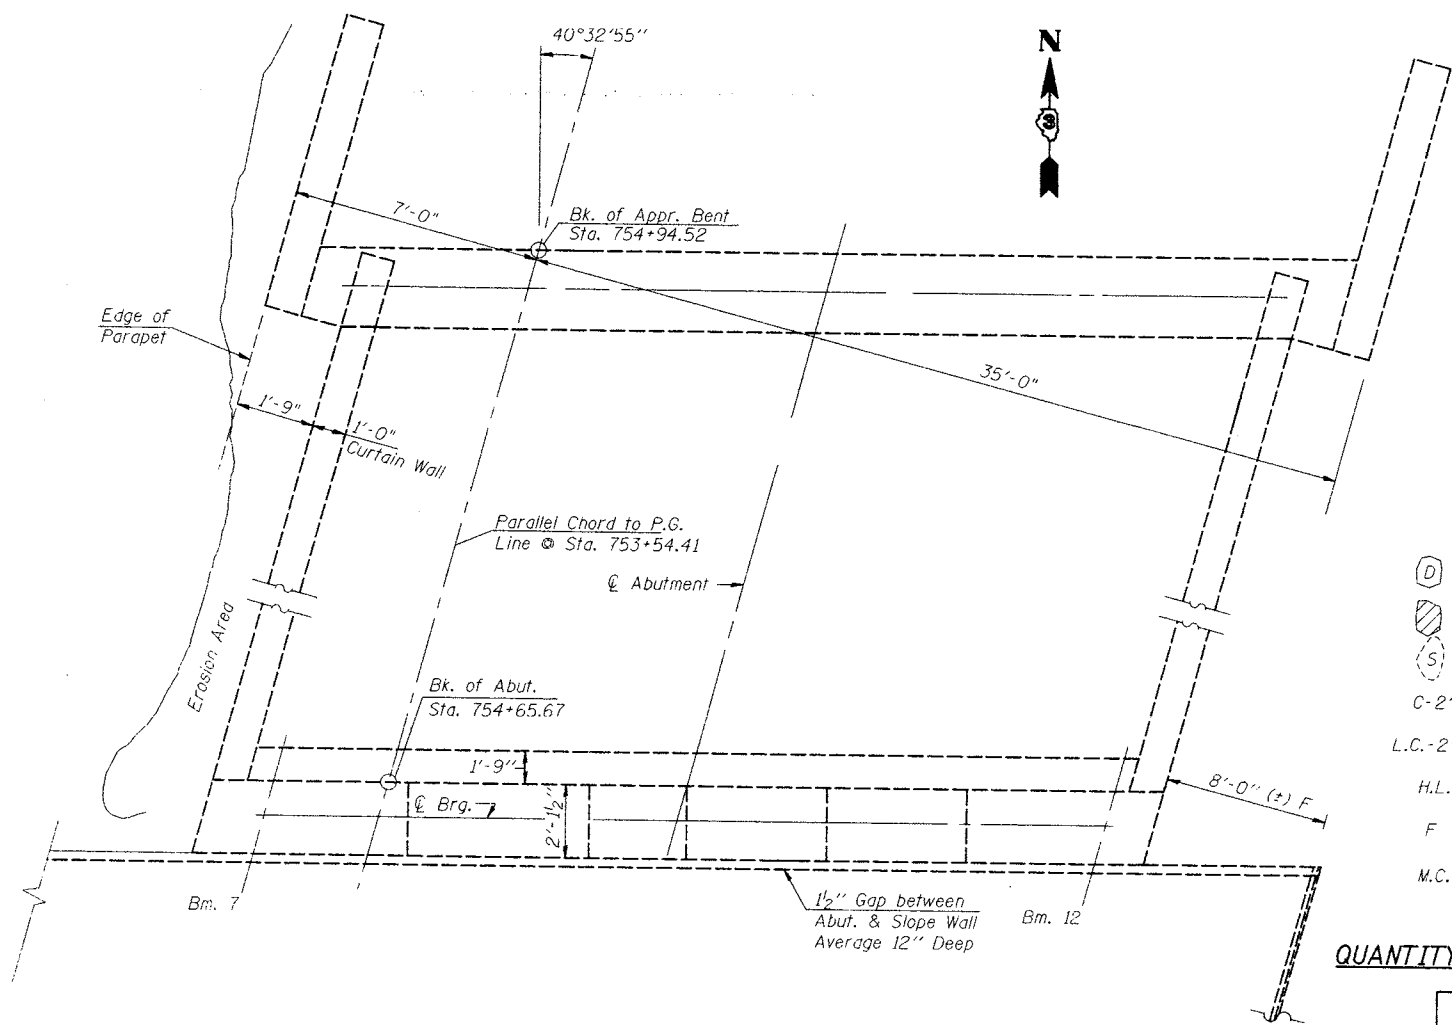

* Back fill embankment erosion areas along the exterior of abutment west wing walls and cover with broken concrete for protection. Cost included with Concrete Removal.

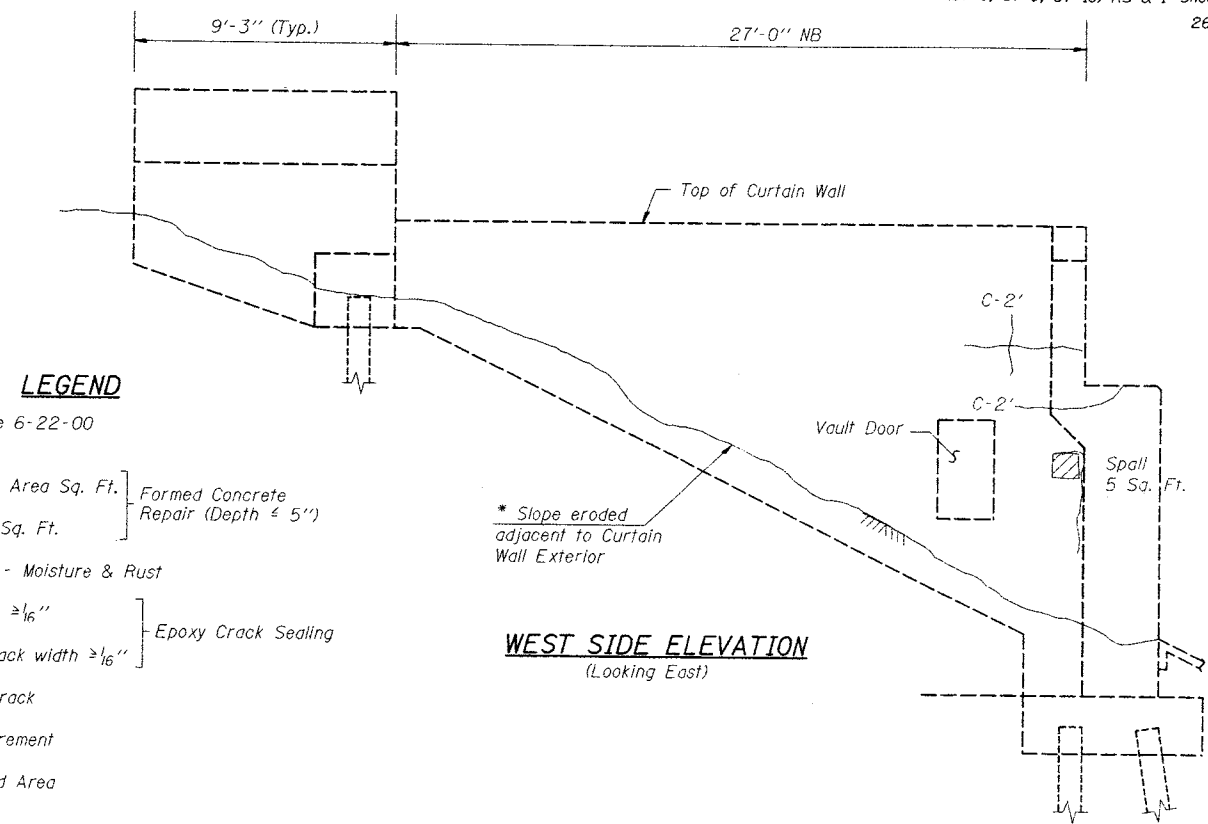

LEGEND


- Survey Date 6-22-00
- (D) Delaminated Area Sq. Ft. } Formed Concrete Repair (Depth ≤ 5")
 - (S) Spall Area Sq. Ft. }
 - (S) Stain Area - Moisture & Rust
 - C-2' Crack width ≥ 1/16" } Epoxy Crack Sealing
 - L.C.-2' Leached Crack width ≥ 1/16" }
 - H.L. Hair Line Crack
 - F Field Measurement
 - M.C. Map Cracked Area

QUANTITY SUMMARY - CONCRETE REPAIRS

ITEM	QUANTITY
Epoxy Crack Sealing	14 Foot
Formed Concrete Repair (Depth ≤ 5")	5 Sq. Ft.
Controlled Low - Strength Material	0.5 Cu. Yd.

Note: C.L.S.M. denotes Controlled Low - Strength Material.


Avg. 1 1/2" x 1'-0" Gap @ Abut. Wall. Fill with C.L.S.M.

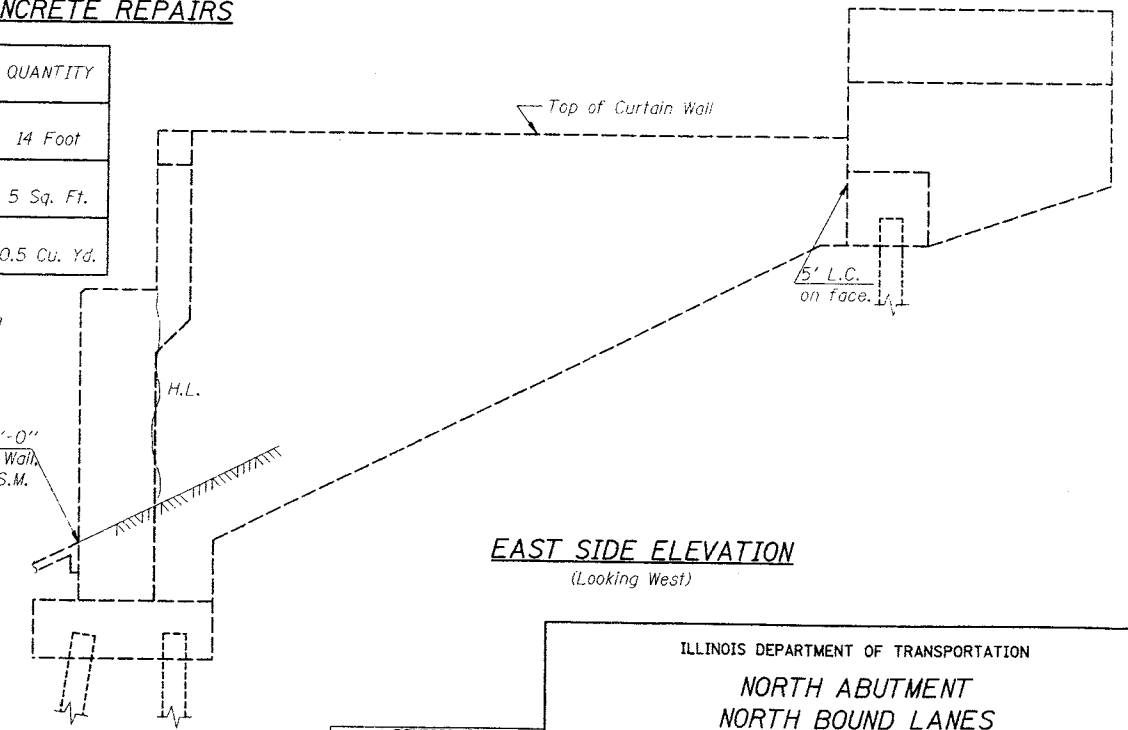


REVISIONS	
NAME	DATE

LIN ENGINEERING, LTD.
 20 W. CHESTNUT
 CHOTHAM, ILLINOIS 62629
 (217) 483-4168 FAX (217) 483-4100
 Designed By: STD Checked By: KRG Drawn By: FML
 Date: 10/00 File: EXHIBIT 154-155.DGN


ILLINOIS DEPARTMENT OF TRANSPORTATION
NORTH ABUTMENT
NORTH BOUND LANES
STRUCTURE # 057-0155
F.A.I. 55 SEC. (57-8, 57-9, 57-10) RS & I
McCLEAN COUNTY
STA. 753+54.41

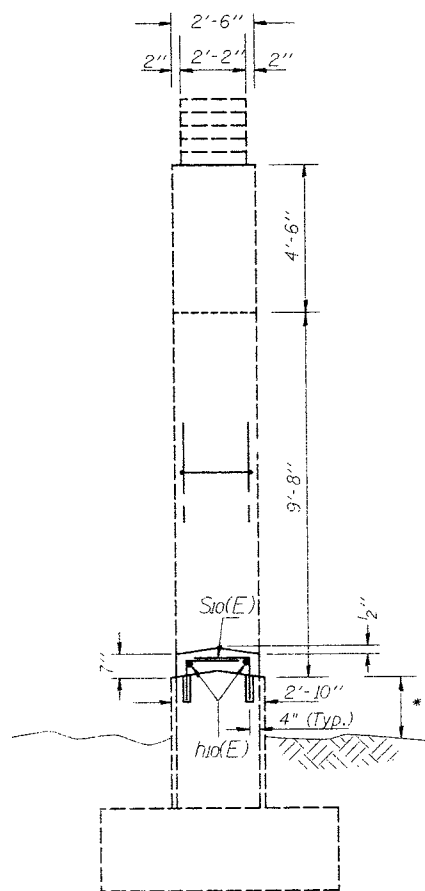

END VIEW
(West End)

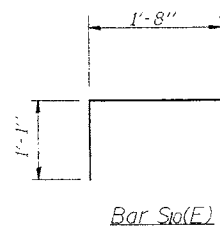

* Regrade to provide 2'-4" minimum.

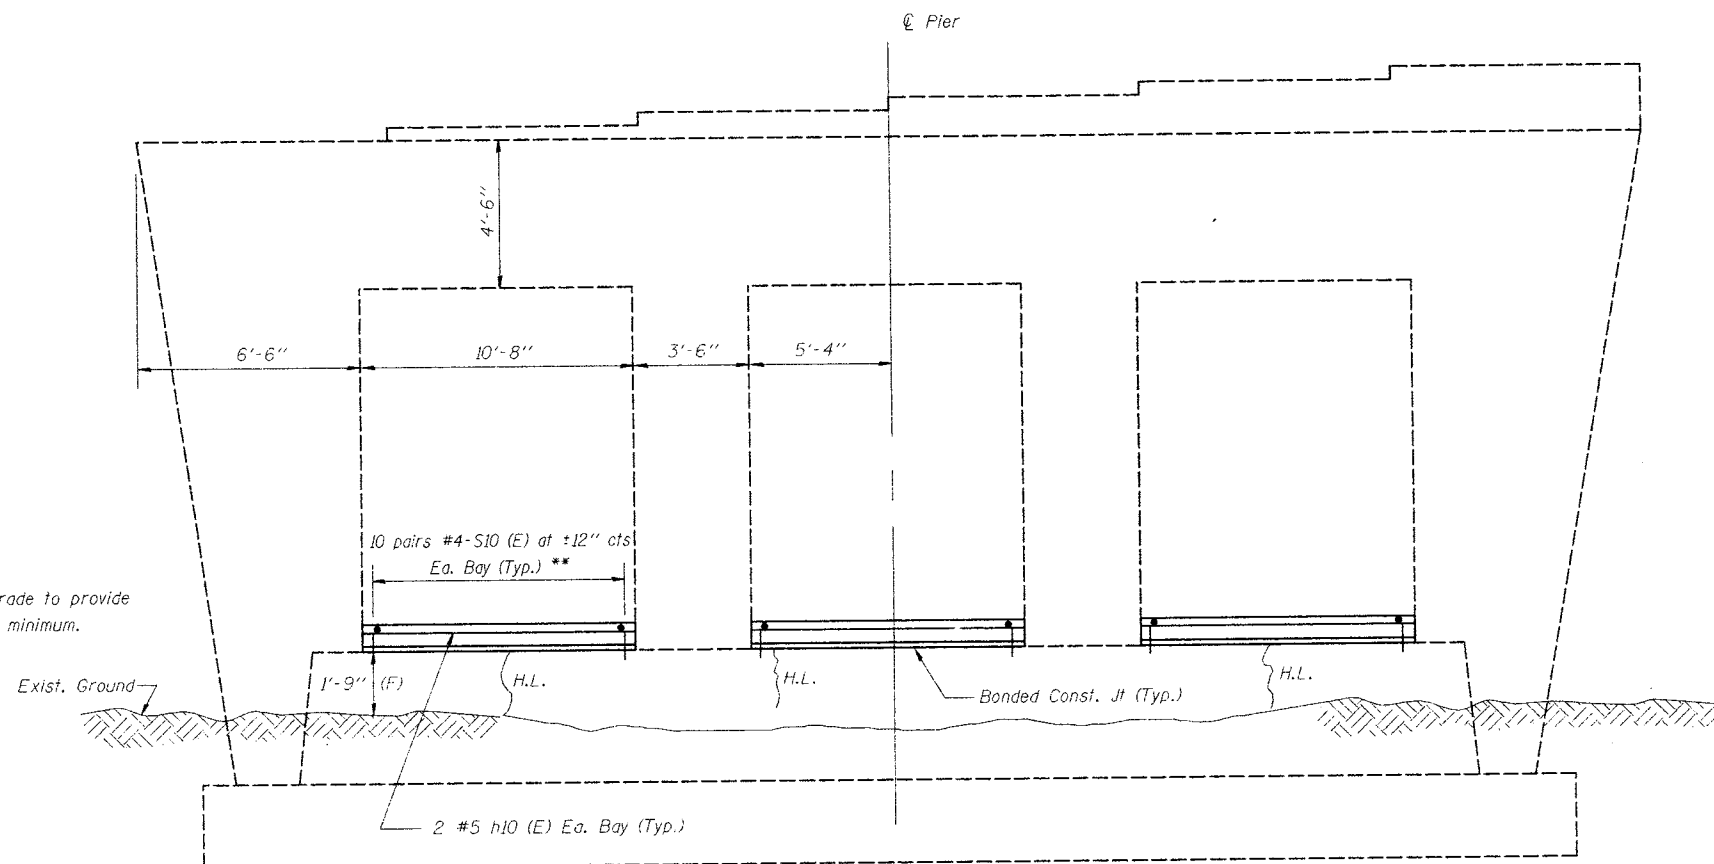

ELEVATION
(Looking North)

** Field drill 9" deep holes and epoxy grout S10 (E) bars in accordance with Article 584 of Standard Specifications.

BILL OF MATERIAL (TWO PIERS)

Bar	No.	Size	Length	Shape
h10(E)	12	#5	10'-6"	—
S10(E)	120	#4	2'-9"	⌈
Concrete Structures		Cu. Yd.		3.4
Reinforcement Bars, Epoxy Coated		Lbs.		350
*** Formed Concrete Repair (Depth 5")		Sq. Ft.		3

*** Quantity is for SN. 057-0154 (Pier South Bound)

Reinforcement bars designated (E) shall be epoxy coated.


- LEGEND**
- Survey Date 6-22-00
- Delaminated Area Sq. Ft. } Formed Concrete Repair (Depth 5")
 - Spall Area Sq. Ft. }
 - Stain Area - Moisture & Rust
 - C-2' Crack width ≥ 1/16" } Epoxy Crack Sealing
 - L.C.-2' Leached Crack width ≥ 1/16" }
 - H.L. Hair Line Crack
 - (F) Field Measurement
 - M.C. Map Cracked Area

LIN ENGINEERING, LTD.
200 W. Chestnut
Chicago, Illinois 60629
Tel: (312) 483-1100
Fax: (312) 483-1106
Designed By: STD | Checked By: KRS | Drawn By: FAL
Date: 10/00 | File: CHIRIT54-25.DWG


REVISIONS	
NAME	DATE
STD	12/11/00

ILLINOIS DEPARTMENT OF TRANSPORTATION
PIER
NORTH BOUND LANES
STRUCTURE # 057-0155
F.A.I. 55 SEC. (57-8, 57-9, 57-10) RS & I
McLEAN COUNTY
STA. 753+54.41

FAI RTE NO.	SECTION	COUNTY	TOTAL SHEETS	SHEET NO.
FAI 55	##	McCLEAN	153	73
FED. RD. DIST. NO.	ILLINOIS	FED. AID PROJECT		
** (57-8, 57-9, 57-10) RS & I Sheet No. 24 of 26 Sheets				

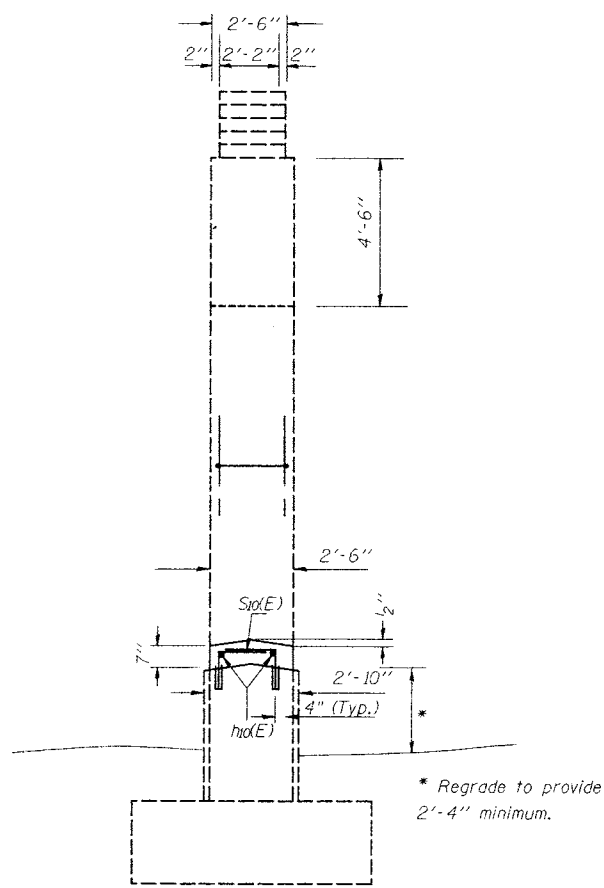

END VIEW
(East End)

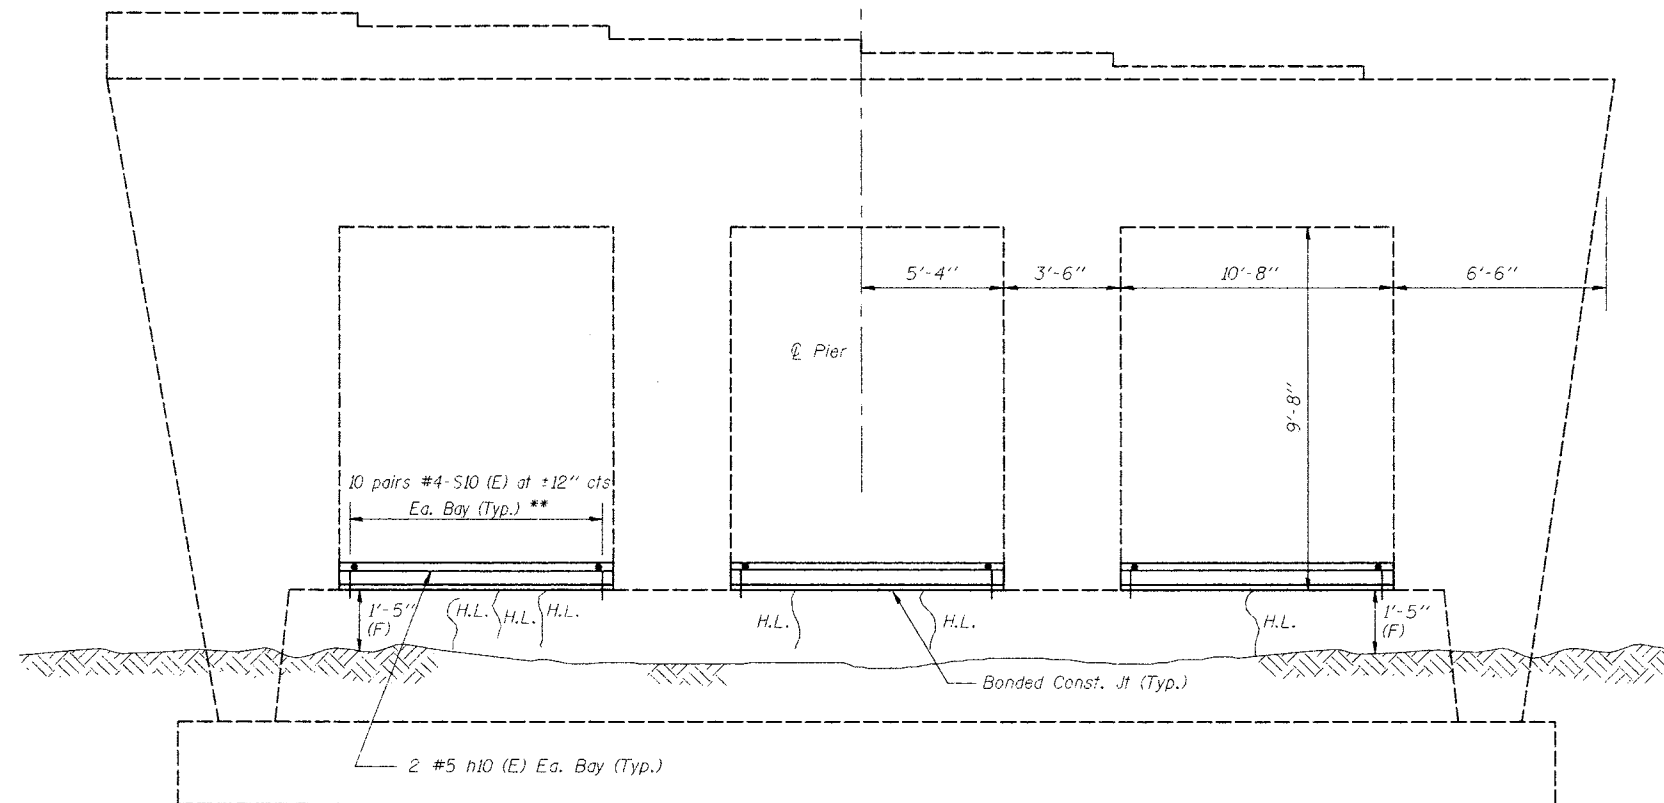

ELEVATION
(Looking South)

** Field drill 9" deep holes and epoxy grout S10 (E) bars in accordance with Article 584 of Standard Specifications.

For Notes and Bill of Material
See Sheet # 23 of 26.

LEGEND

- Deck Survey Date 6-22-00
- (D) Delaminated Area Sq. Ft. } Formed Concrete Repair (Depth ≠ 5")
- (S) Spall Area Sq. Ft. }
- (S) Stain Area - Moisture & Rust }
- C-2' Crack width ≥ 1/16" } Epoxy Crack Sealing
- L.C.-2' Leached Crack width ≥ 1/16" }
- H.L. Hair Line Crack
- (F) Field Measurement
- M.C. Map Cracked Area


310 W. Chestnut
Channahon, Illinois 62629
Tel: (815) 483-4100
Fax: (815) 483-4106
Designed By: STD Checked By: KRJ Drawn By: F.M.
Date: 10/00 File: EXHIBIT 154-155.DGN

REVISIONS	
NAME	DATE
STD	12/11/00


ILLINOIS DEPARTMENT OF TRANSPORTATION
PIER
NORTH BOUND LANES
STRUCTURE # 057-0155
F.A.I. 55 SEC. (57-8, 57-9, 57-10) RS & I
McCLEAN COUNTY
STA. 753+54.41

ROUTE NO.	SECTION	COUNTY	TOTAL SHEETS	SHEET NO.
F.A.I. 55		McLEAN	163	74
ROAD DIST.		ILLINOIS		

** (57-8, 57-9, 57-10) RS & I Sheet No. 25
25 Sheets

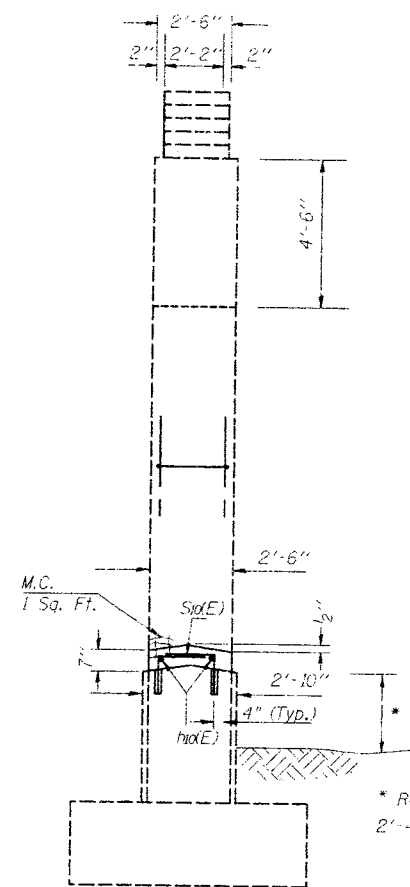

END VIEW
(West End)

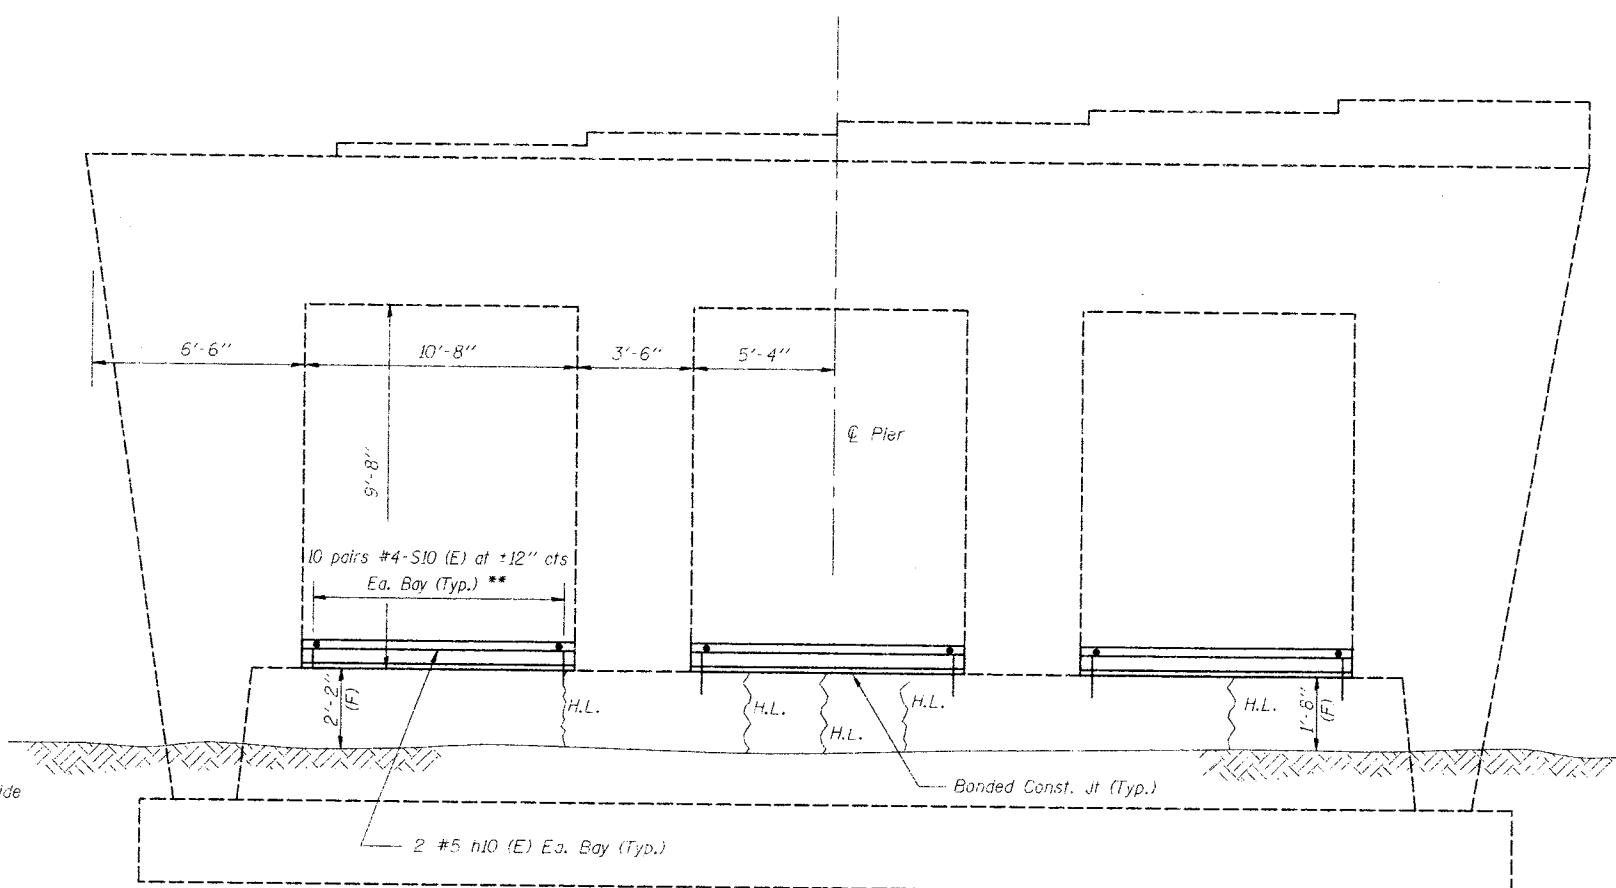

ELEVATION
(Looking North)

For Notes and Bill of Material
See Sheet # 23 of 26.

LEGEND


- Deck Survey Date 6-22-00
- (D) Delaminated Area Sq. Ft. } Formed Concrete Repair (Depth ≠ 5")
- (S) Spall Area Sq. Ft. }
- (S) Stain Area - Moisture & Rust
- C-2' Crack width ≥ 1/16" } Epoxy Crack Sealing
- L.C.-2' Leached Crack width ≥ 1/16" }
- H.L. Hair Line Crack
- (F) Field Measurement
- M.C. Map Cracked Area

REVISIONS	
NAME	DATE


ILLINOIS DEPARTMENT OF TRANSPORTATION
PIER
SOUTH BOUND LANES
STRUCTURE # 057-0154
F.A.I. 55 SEC. (57-8, 57-9, 57-10) RS & I
McLEAN COUNTY
STA. 753+54.41

ROUTE NO.	SECTION	COUNTY	TOTAL SHEETS	SHEET NO.
F.A.I. 55		McLEAN	163	75
ROAD DIST.		ILLINOIS		

** (57-8, 57-9, 57-10) RS & I Sheet No. 26
26 Sheets

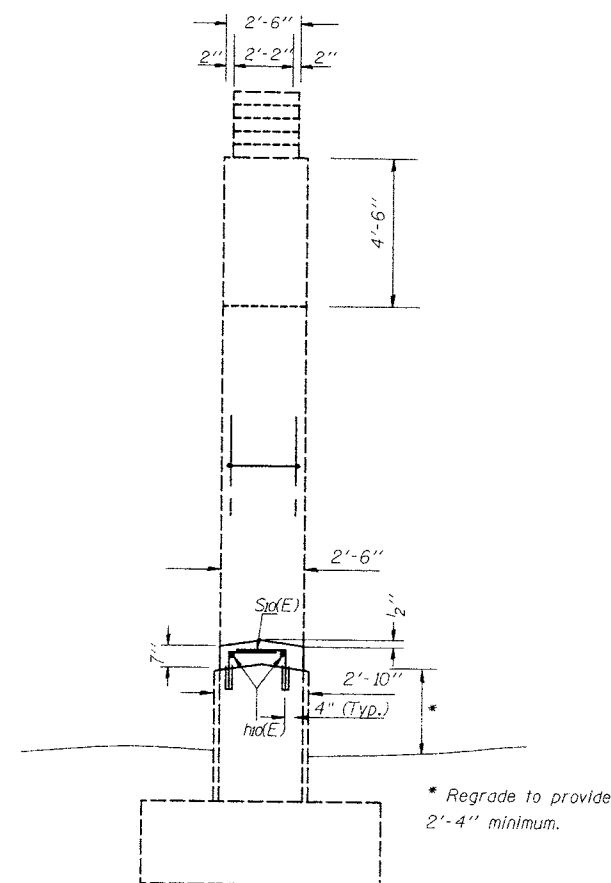

END VIEW
(East End)

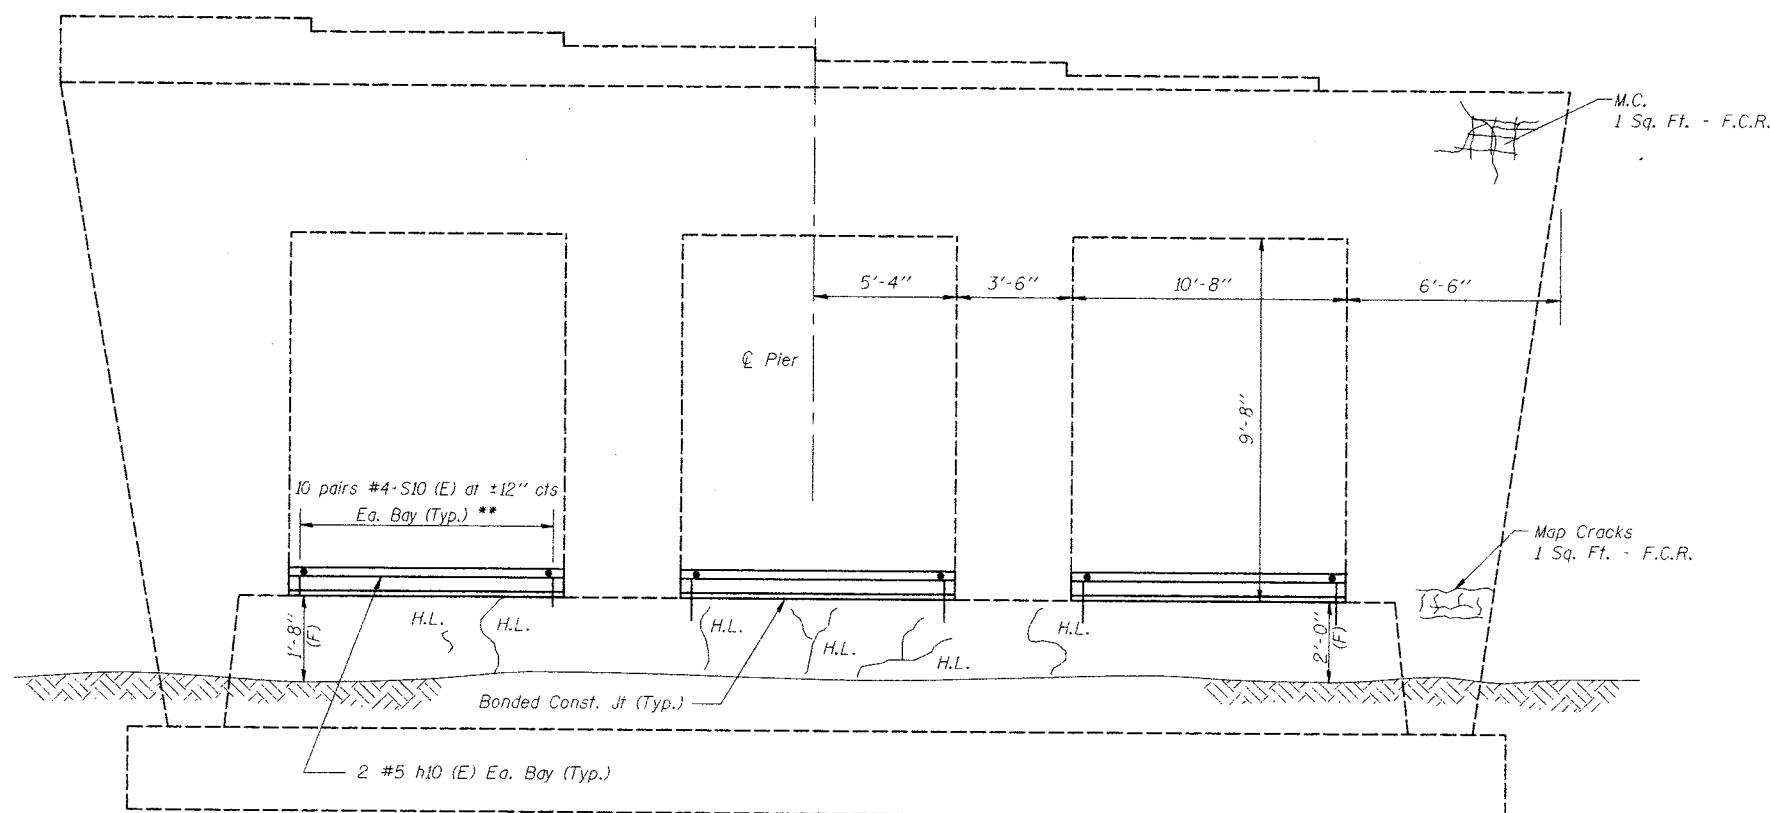

ELEVATION
(Looking South)

** Field drill 9" deep holes and epoxy grout S10 (E) bars in accordance with Article 584 of Standard Specifications.

For Notes and Bill of Material See Sheet #23 of 26.

LIN ENGINEERING, LTD.
 330 W. Chestnut Channahon, Illinois 62629
 (815) 483-4668 FAX (815) 483-4106
 Designed By: STD Checked By: KRG Drawn By: FML
 Date: 12/00 File: EXHIBIT154-155.DGN

REVISIONS	
NAME	DATE
STD	12/11/00

ILLINOIS DEPARTMENT OF TRANSPORTATION
PIER
 SOUTH BOUND LANES
 STRUCTURE # 057-0154
 F.A.I. 55 SEC. (57-8, 57-9, 57-10) RS & I
 McLEAN COUNTY
 STA. 753+54.41

Description	Sheet No.
Title Sheet	1
Typical Section	2-3
General Notes & Summary of Quantities	4-5A
Sub-Surface Drainage & Class X Concrete Summary	6-7
Plan & Profile - FAI 55	8-14
Plan & Profile - FA Route 119 (U. S. Route 136)	15-18
Plan & Profile - 3 East Frontage Road	19-20
FA Route 119 (U.S. Route 136) Pavement Data	21-23
Interchange Layout	24
Ramp Profiles	25
Details of Ramp Terminals	26, A
Details of Ramp Intersections with FA Route 119 (U.S. Route 136)	27
Interchange Grading Plans	28-31
Interchange Earthwork Index	32
Interchange State Plane Coordinate Index	32A
Sequence of Construction	33
Crossover Details	34-40
Miscellaneous Details	41-46
Headwall	47
Signaling	48-115
Bridge Plans - Sec. 57-10HB	116-141
Cross Sections - FAI-55	142-190
Cross Sections - FA Route 119 (U. S. Route 136)	191-205
Cross Sections - Interchange Ramps	206-220
Cross Sections - 3 East Frontage Road	221-224

DEPARTMENT OF TRANSPORTATION

PLANS FOR PROPOSED


FEDERAL AID INTERSTATE HIGHWAY

FAI ROUTE 55

SECTION 57-(10,10 HB) & 57-(10,9,8) SG

PROJECT I-55-4(93)139

FA ROUTE 119 SECTION 119 WRS

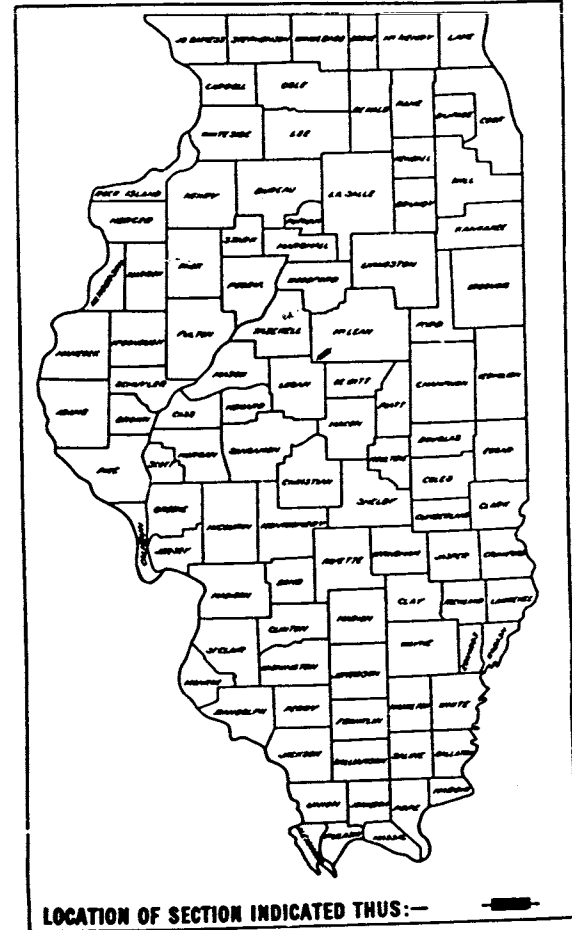


LOCATION OF SECTION INDICATED THUS: —

CONSTRUCTION DETAILS OTHER THAN THOSE SHOWN ON THE PLAN SHALL CONFORM TO THE FOLLOWING STANDARDS:

935	1997	2149-8	2225-3	2250	2314-2	2147-5
1527-5	1998	2153-9	2226-3	2251	2315-3	2319-1
1538-3	2051	2169-4	2227-1			2320-3
1683-2	2113-1	2176-1		2263-2		2330
1686-3	2115-3	2187-8	2230-7	2298-3	2323	2336
1744-2	2116-1	2212-2	2231-3	2299-4	2324-2	2337
1766-7	2117-1	2213-3	2244-3	2300	2327-1	2338
	2130-3	2214-2	2246-3	2305-2	BLR-7-2	2339
1976	2135	2217-2	2247-3	2306-3		2340
1981	2138-8	2224-9	2248-1	2307-3	2153-9	2341
2256-4	2304-2	2302-2	2303-3	2303-2	2299-1	2342

SCALES

PLAN
 PROFILE
 HORIZ.
 VERT.

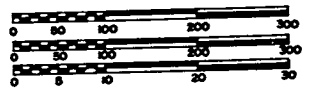


CROSS SECTIONS:
 HORIZ.
 VERT.



C-93-003-73 (FAI. 55)

Mc LEAN COUNTY

SECTION 57-10HB INCLUDES:
 N.B. STA 752+82.00 TO STA 754+94.52
 S.B. STA 752+00.68 TO STA 754+25.06
 SPECIAL BRIDGE DESIGN
 REINFORCED CONCRETE DECK
 4 MAIN SPANS AT 73'-8"
 USING W36x230 STEEL I-BEAMS &
 4 APPROACH SPANS AT 32'-7", 34'-4",
 36'-7" & 37'-11 1/2" USING PRECAST,
 PRESTRESSED CONCRETE I-BEAMS 36"
 ON VAULTED ABUTMENTS. 40° 32' 25" SKEW
 TANGENT TO CURVE AT STA 753+54.41.

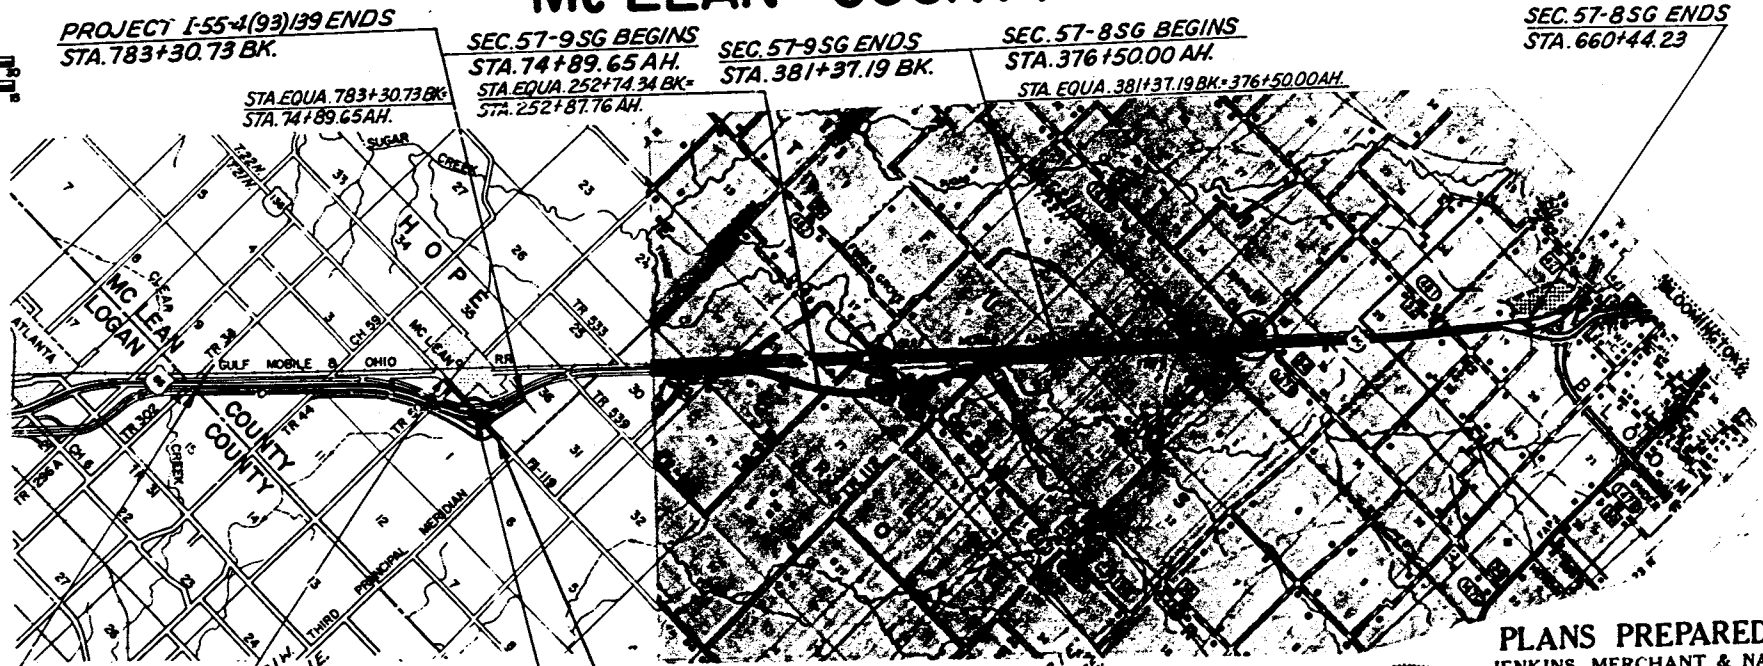

PROJECT I-55-4(93)139 ENDS
 STA. 783+30.73 BK.

SEC. 57-9SG BEGINS
 STA. 74+89.65 AH.

SEC. 57-9SG ENDS
 STA. 381+37.19 BK.

SEC. 57-8SG BEGINS
 STA. 376+50.00 AH.

SEC. 57-8SG ENDS
 STA. 660+44.23

MINIMUM HORIZONTAL RADIUS	FAI-55 3819.72 TANGENT	FA-119
MAXIMUM GRADE	0.81%	1.20%
LENGTH OF MAXIMUM GRADE	820'	150'
MINIMUM STOPPING SIGHT DISTANCE	1,050	875'

PROJECT I-55-4(93)139
 BEGINS STA. 587+25.07

SECTION 119 WRS BEGINS
 STA. 2026+75.96

SECTION 119 WRS ENDS
 STA. 2069+52.00

SECTION 57-10HB
 STA. 753+54.41 FAI. 55
 STA. 2050+00.00 FA. 119

PLANS PREPARED BY
 JENKINS, MERCHANT & NANKIVIL
 CONSULTING ENGINEERS
 SPRINGFIELD, ILLINOIS



Charles H. Merchant
 CHARLES H. MERCHANT
 STRUCTURAL ENGINEER


STATE OF ILLINOIS
 DEPARTMENT OF TRANSPORTATION

APPROVED: _____
 DATE: _____

DEPARTMENT OF TRANSPORTATION
 FEDERAL HIGHWAY ADMINISTRATION

APPROVED: _____
 DIVISION ENGINEER DATE

LEGEND
 ——— EXISTING STREETS AND ROADS
 - - - - - PROPOSED CONSTRUCTION
 * ROAD CLOSED

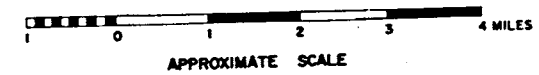

057-0154 + 0155

DESIGN DESIGNATION
 FAI. - 55 3327(93) TRUNK - 8.33 (PCC-20)
 FA RTE. 119 827(93) ROADS & STREETS - 2.30 (PCC-27)
 (US RTE. 136) CONTRACT NO. 29568

PROJECT I-55-4(93)139 NET LENGTH	19,605.66 FEET	3.7132 MILES
SECTION 57-10 & 57-10HB NET LENGTH	19,605.66 FEET	3.7132 MILES
SECTION 119 WRS NET LENGTH	4,276.04 FEET	0.810 MILES

September 30, 1978

3-89
 57-10HB

GENERAL NOTES

All reinforcement bars shall be lapped 2d diameters unless otherwise shown.
Fasteners shall be high strength bolts. Bolts 3/4" φ, open holes 1 1/4" φ unless noted.
Calculated weight of Structural Steel - 463,210 Lbs.
The Basic Lead Silico Chromate paint system shall be used for shop and field painting of structural steel.
Field welding of construction accessories will not be permitted to the bottom flange of beams or girders nor to the top flange for a distance equal to one-fourth the span length each way from the pier supports. Field welding in other areas will be permitted only when approved by the Engineer.
Anchor bolts shall be set before bolting diaphragms over supports.
The embankment configuration shown shall be the minimum embankment that must be constructed prior to the construction of the abutments.
The concrete rail section above the mandatory construction joint at the top of the slab shall be constructed of Class X Concrete, except the aggregates shall conform to the requirements of Handrail Concrete.
The contractor shall drive 3 test piles in permanent locations (See Sheets 17-22) as directed by the Engineer before ordering the remainder of the piles.
Protective Coat shall not be applied to surfaces to which Coal Tar Interlayer Protective Coat is applied.
Slope Wall shall be reinforced with welded wire fabric 6"x6" mesh, weighing 55# per 100 sq ft.
Concrete piles @ Abutments shall be driven in holes precored through the embankment in accordance with Article 513.09 (C) of the Standard Specifications.

For Footing Layout See Sheet 16 of 20

Bearing seat surfaces shall be constructed or adjusted to the designated elevations within a tolerance of 1/8" inch. Adjustment shall be made either by grinding the surface or by shimming the bearing. Two 1/2" adjusting shims, of the dimensions of the bottom bearing plate, shall be provided for each bearing in addition to all other plates or shims.

STATION 753+54.41
BUILT 197 BY
STATE OF ILLINOIS
FAI RTE 55 SEC. 57-101B
FA PROJECT I-55-4(3) 139
LOADING H520

NAME PLATE
See Std. 2113 (2 Req'd)

TOTAL BILL OF MATERIAL


Item	Unit	Super	Sub	Total
Bit Coat Surface Course, Class 1	Tons	159		159
Struct. Excavation	Cu Yd		177	177
Class X Concrete	Cu Yd	421.9	683.3	1105.2
Precast Post-Tension Beams	Lin. Ft.	505		505
Aluminum Slabbing	Lin. Ft.	9.5	75	84.5
Crossed Piles 20' to 30' feet	Lin. Ft.		9182	9182
Concrete Piles	Lin. Ft.		3	3
Test Pile Concrete	Cu Yd			3
Name Plate	EA	2		2
Slope Wall	Sq Yd			145.9
Coal Tar Interlayer Protect. Coat	Sq Yd	1665		1665
Reinforcement Bars	Lbs	150,120	69,370	219,490
Structural Steel	Lbs	45		45
Neoprene Expansion Jt. 2"	Lin. Ft.	214		214
Protective Coat	Sq Yd	335		335
Porous Granular Embankment	Cu Yd			2,311
Rem & Disp of Unsuitable Mat.	Cu Yd			1,025

DESIGN STRESSES

FIELD UNITS	PRECAST-PRESTRESSED UNITS
f _c = 12,000 psi. (Deck Slab)	f _c = 5,000 psi.
f _c = 1,400 psi. (Sub-Curb & Parapet)	f _c = 4,000 psi.
f _s = 20,000 psi. (Reinf.)	f _s = 242,000 psi.
f _s = 20,000 psi. (Struct. A-39)	f _s = 173,600 psi.
f _s = 75 psi. (Figs.)	
γ = 150	

25' included in D.L. for future wearing surface
Allowable LL Defl: 4/1000

LOADING H520 & ALTERNATE
Design Specs. 1969 A-15+D as applicable

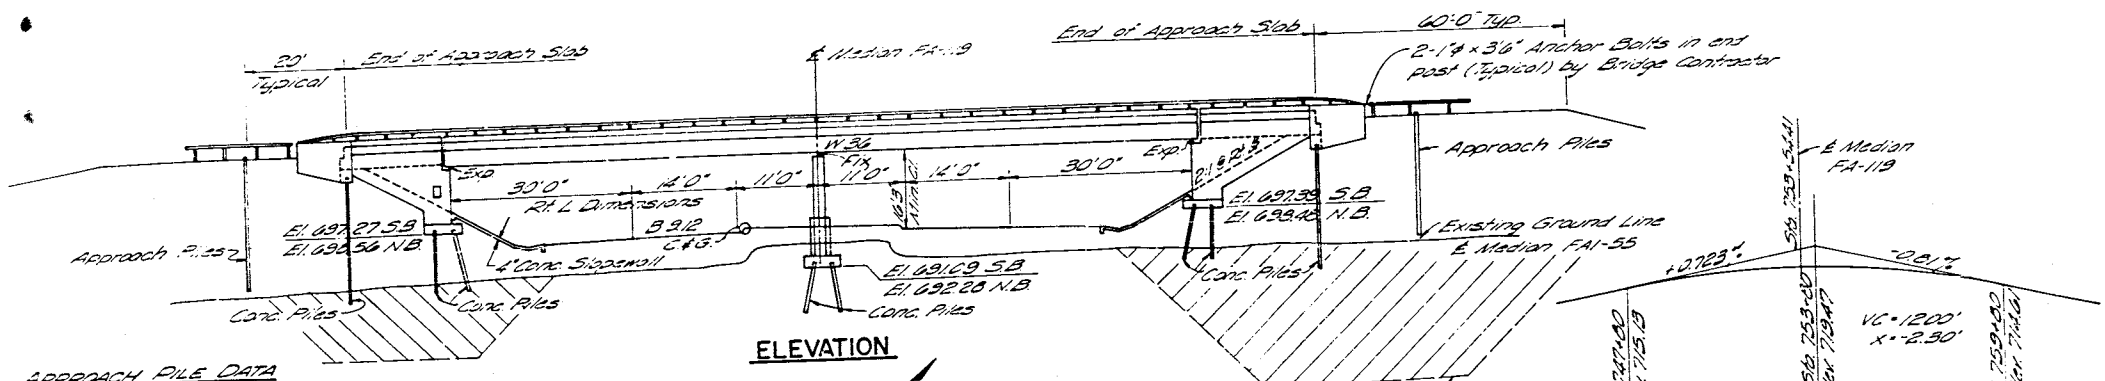


APPROACH PILE DATA
Type - Crossed
Length Req'd - 27'
No. Req'd - 28

Unsuitable material to be removed & replaced with porous granular embankment. - See Sheet 16 of 20 Sheets for limits


PROFILE FAI-55 (At Median Edge of Pav't.)

PROFILE FAI-119 (At Median Edge of Pav't.)



HORIZ. CURVE DATA
FAI ROUTE 55
P.I. Sta 752+83.19
L = 20'33"58"
Δ = 1'30"
R = 3,813.72'
T = 1,411.67'
L = 2,706.41'
E = 252.51'
SS = 0.042%

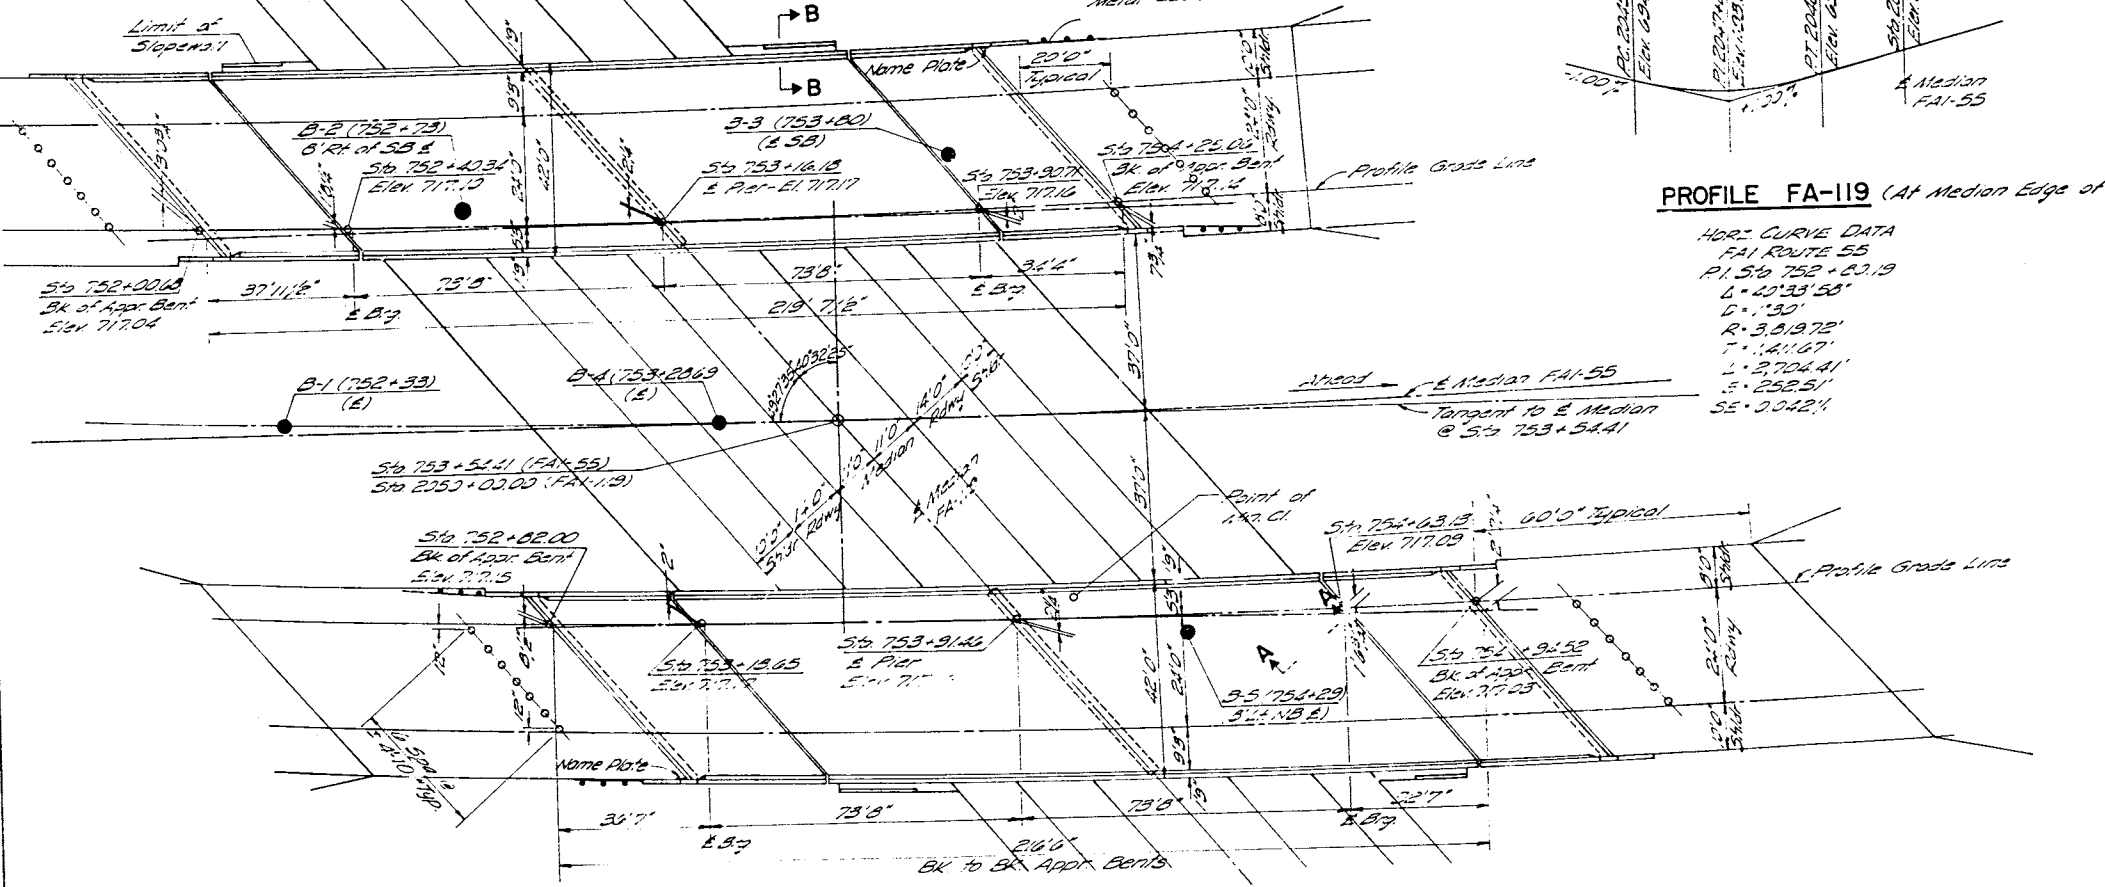

PLAN

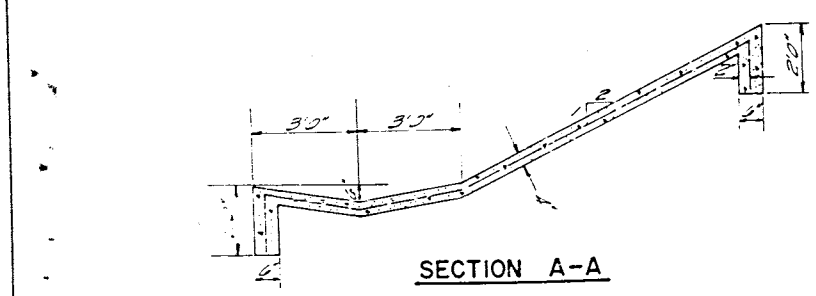

SECTION B-B

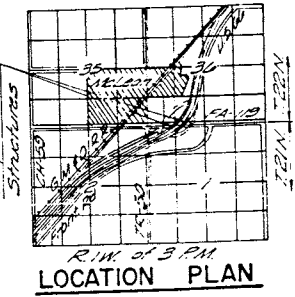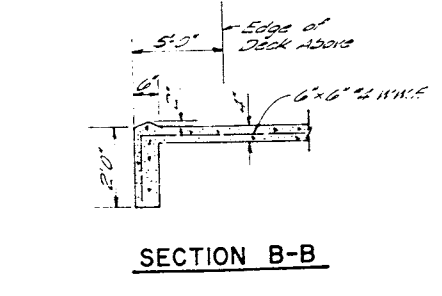


LOCATION PLAN

GENERAL PLAN & ELEVATION
FAI-55 OVER FA-119 (U.S. ROUTE 136)
PROJECT I-55-4(3) 139
FAI ROUTE 55 SEC. 57-101B
MC LEAN COUNTY
STATION 753+54.41 (FAI-55)

GENERAL NOTES


All reinforcement bars shall be lap spliced at diameters unless otherwise shown.
 Rebar shall be high strength bars. Bars No. 8, apart from No. 1 unless noted.
 Calculated weight of Structural Steel - 463,210 LBS.
 The Basic Load Stress Chromite paint system shall be used for shop and field painting of structural steel.
 Field painting of construction accessories will not be permitted in the bottom flange of beams or girders nor in the top flange for a distance equal to one-fourth the span length away from the pier supports. Field painting in other areas will be permitted only when approved by the Engineer.
 Anchor bolts shall be set before setting deck slabs over supports.
 The embankment construction shall be to the minimum requirement that must be constructed prior to the construction of the abutments.
 The concrete not shown above the mandatory construction joint at the top of the side shall be constructed of Class II Concrete, except the parapets shall conform to the requirements of Structural Concrete.
 The Contractor shall drive 3/4" dia. pins in permanent locations. (See Sheet 17-18) as directed by the Engineer before ordering the remainder of the piers.
 Protective Coat shall not be applied to surfaces to which Coal Tar Intermediate Protective Coat is applied.
 Slope 1/2:1 shall be reinforced with welded wire fabric 6" x 6" mesh, weighing 50# per 100 sq. ft.
 Concrete piles @ Abutments shall be driven in holes prepared through the embankment in accordance with Article 513.09 (C) of the Standard Specifications.
 For Roofing Layout See Sheet 16 of 20.
 Bearing seat surfaces shall be constructed or adjusted to the designated elevations within a tolerance of 1/8 inch. Adjustment shall be made either by grinding the surface or by shimming the bearing. Two 1/2" adjusting shims, of the dimensions of the bottom bearing plate, shall be provided for each bearing in addition to all other plates or shims.

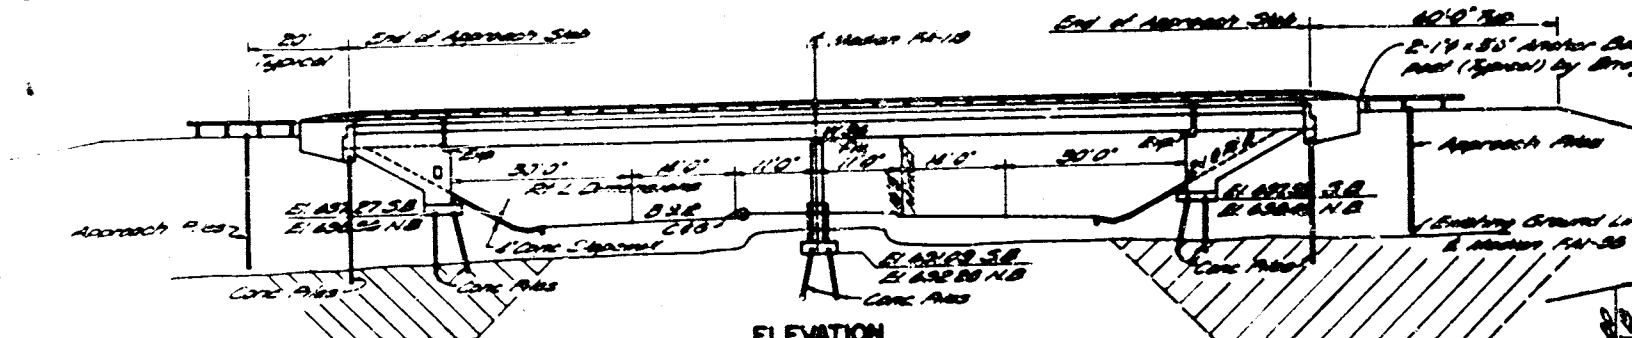


APPROACH PILE DATA
 Type - Cased
 Length Req'd - 27'
 No. Req'd - 20

ELEVATION

Unstable material to be removed & replaced with porous granular embankment. - See Sheet 15 of 20 Sheets for limits.
 Hold Steel Rod

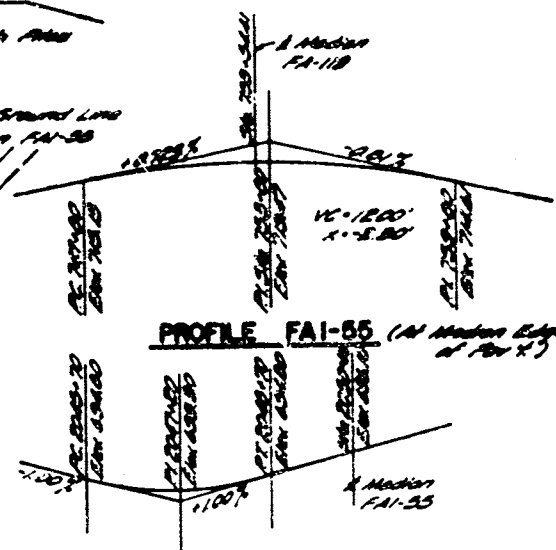

PROFILE FAI-55 (At Median Edge of Pier 2)

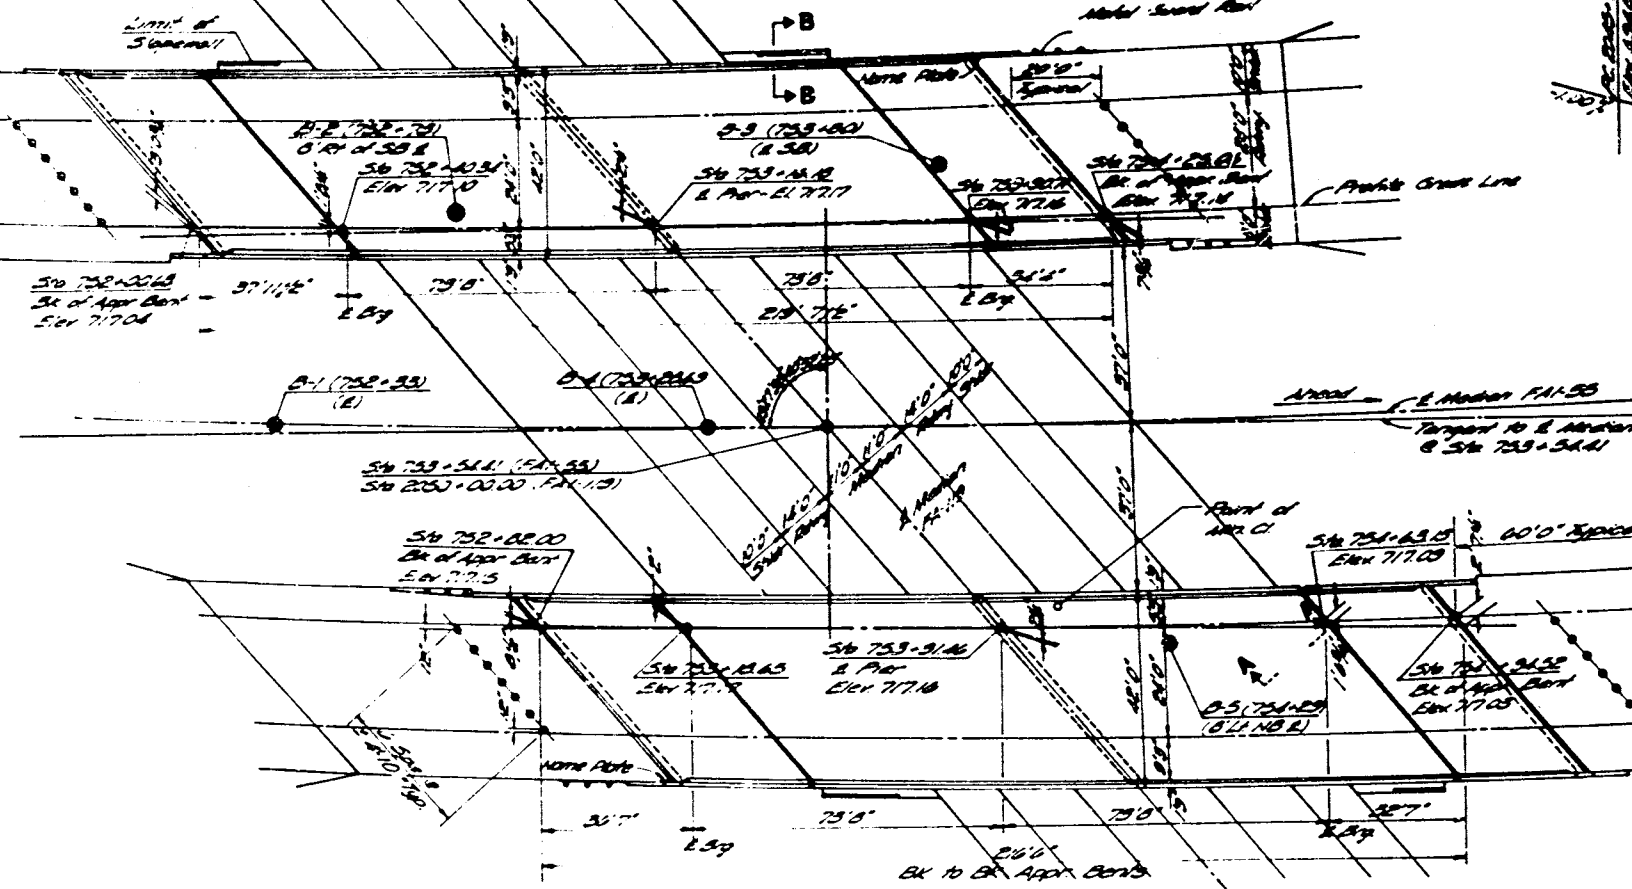

PLAN

PROFILE FA-119 (At Median Edge of Pier 1)
 HERE CURVE DATA
 FAI ROUTE 55
 P1 Sta 752+00.19
 Δ = 41°33'50"
 R = 1.30'
 T = 3.0072'
 L = 1.4167'
 E = 2.70441'
 S = 2.2824'
 SE = 0.0421'

STATION 753+54.41
 BUILT 1971 BY
 STATE OF ILLINOIS
 FAI ROUTE 55 SEC 57-10HB
 PROJECT F-55-4(93)139
 LOADING 14520

NAME PLATE
 See Sht 21/5 (2 Rpts)

TOTAL BILL OF MATERIAL

Item	Unit	Super	Sub	Total
Ext. Conc. Surface Curbs, Class I	Sq Yd	152		152
Structural Expansion	Cu Yd		177	177
Class II Concrete	Cu Yd	621.9	603.9	1225.8
Precast Prest. Conc. S. Brca. 36	Lt. Ft.	505		505
Aluminum Paving	Lt. Ft.	913		913
Concrete Piles 24" x 30" Foot	Lt. Ft.		754	754
Concrete Piles	Lt. Ft.		9182	9182
Cast Pile Concrete	Sq		3	3
Yield Plate	Sq Ft	2		2
Slope Mat. 5'	Sq Yd		1,014	1,014
Coal Tar Intermediate Protective Coat	Sq Yd	1,065		1,065
Reinforcement Bars	Lbs	150,120	71,136	221,256
Structural Steel	Lbs	45		45
Asphal. Expansion J. E.	Lt. Ft.	214		214
Protective Coat	Sq Yd	335		335
Porous Granular Embankment	Cu Yd		2,340	2,340
Rem. of Deep of Unstable Mat.	Cu Yd		10,340	10,340


AS REVISED

DESIGN STRESSES


FIELD UNITS	PRECAST-PRESTRESSED UNITS
f _c = 1,200 p.s.i. (Deck Slab)	f _c = 5,000 p.s.i.
f _c = 1,400 p.s.i. (Sub. Curbs & Parapet)	f _c = 4,000 p.s.i.
f _s = 20,000 p.s.i. (Reinf.)	f _s = 240,000 p.s.i.
f _s = 20,000 p.s.i. (Struct. A-30)	f _s = 175,620 p.s.i.
f _c = 75 p.s.i. (Figs)	
n = 10	

25% included in J.L. for 1/2" wearing surface
 Allowable LL Defl. 5/1000


LOADING 14520 / ALTERNATE
 Design Specs. 1245 ALSO as applicable

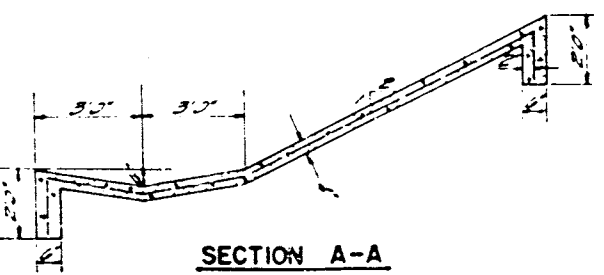

SECTION A-A

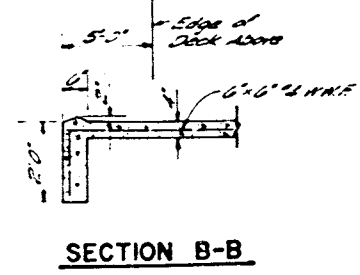



SECTION B-B

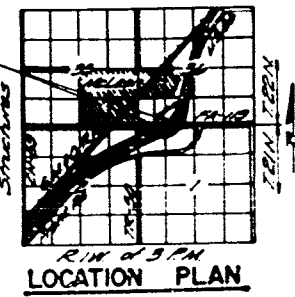

LOCATION PLAN

APPROVED

GENERAL PLAN & ELEVATION
 FAI-55 OVER FA-119 (U.S. ROUTE 136)
 PROJECT I-55-4(93)139
 FAI ROUTE 55 SEC. 57-10HB
 MC LEAN COUNTY
 STATION 753+54.41 (FAI-55)

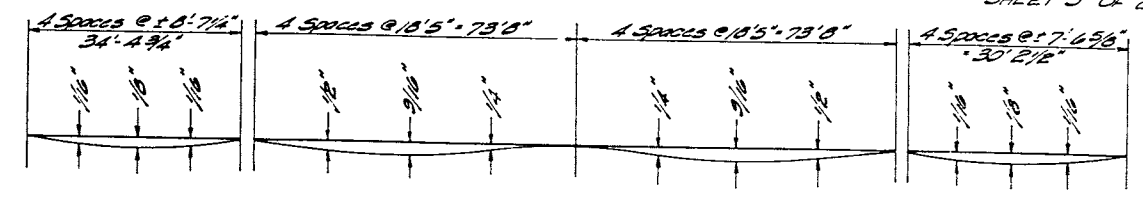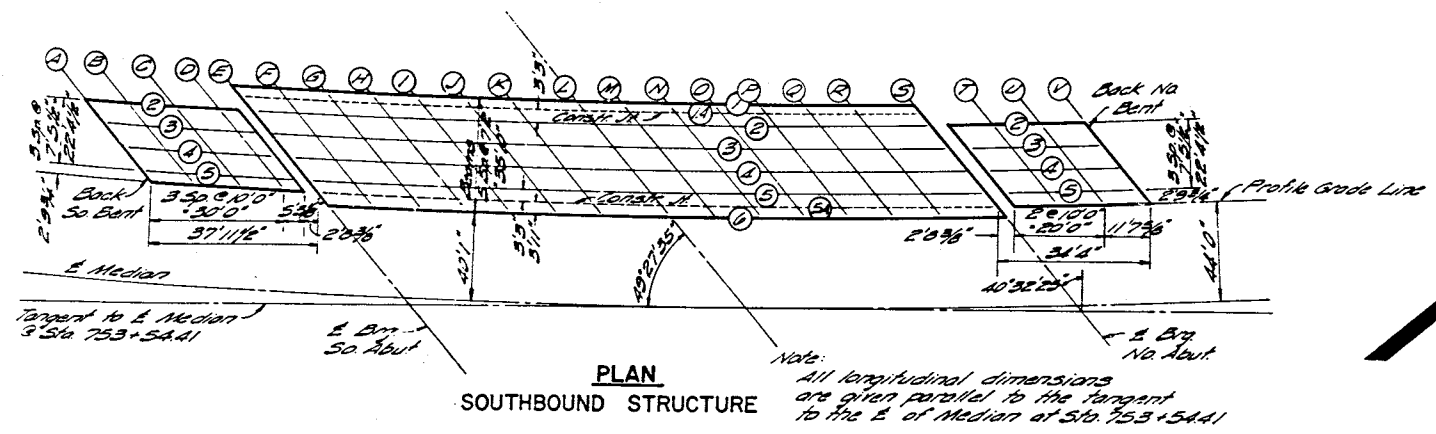

SPAN 1

Location	Beam	Station	Offset	Theoretical Grade Elevation	Theoretical Grade Elevation Adjusted for Dead Load Deflection
A BACK S. ABUT.	Wall	751+6.58	32.75	715.644	715.644
	2	751+25.77	25.011	715.937	715.937
	3	751+03.05	17.729	716.225	716.225
	4	751+30.23	10.270	716.594	716.594
	5	751+35.00	2.812	716.920	716.920
	5A	752+02.00	0	717.043	717.043
Wall	752+05.19	-4.75	717.251	717.251	
B	Wall	751+00.20	32.75	715.628	715.628
	2	751+07.35	25.187	715.900	715.900
	3	751+34.59	17.729	716.286	716.291
	4	752+01.43	10.270	716.612	716.619
	5	752+08.46	2.812	716.939	716.944
	5A	752+11.15	0	717.063	717.065
Wall	752+15.61	-4.75	717.263	717.262	
C	Wall	751+30.82	32.75	715.649	715.649
	2	751+37.93	25.187	715.900	715.900
	3	752+04.93	17.729	716.300	716.310
	4	752+11.93	10.270	716.632	716.642
	5	752+18.92	2.812	716.957	716.967
	5A	752+21.55	0	717.079	717.084
Wall	752+26.04	-4.75	717.284	717.286	
D	Wall	752+01.44	32.75	715.670	715.670
	2	752+08.50	25.187	715.939	716.004
	3	752+15.47	17.729	716.324	716.329
	4	752+22.43	10.270	716.650	716.655
	5	752+29.39	2.812	716.973	716.978
	5A	753+32.05	0	717.095	717.099
Wall	752+36.46	-4.75	717.301	717.301	

SPAN 2

Location	Beam	Station	Offset	Theoretical Grade Elevation	Theoretical Grade Elevation Adjusted for Dead Load Deflection
E BRG. S. ABUT.	1	752+10.65	31.917	715.721	715.721
	1A	752+14.34	28.000	715.691	715.691
	2	752+17.60	24.750	716.032	716.032
	3	752+18.07	17.503	716.345	716.345
	4	752+13.72	10.417	716.655	716.655
	5	752+13.74	3.250	716.967	716.967
5A	752+10.34	0	717.107	717.107	
F	1	752+14.33	-3.917	717.272	717.272
	1A	752+18.05	28.000	715.721	715.721
	2	752+22.34	24.750	716.032	716.032
	3	752+23.69	17.503	716.341	716.341
	4	752+18.12	10.417	716.670	716.670
	5	752+14.70	3.250	716.980	716.980
5A	752+15.00	0	717.120	717.120	
G	1	752+15.40	-3.917	717.289	717.289
	1A	752+19.15	31.917	715.721	715.721
	2	752+23.44	28.000	716.032	716.032
	3	752+24.03	17.503	716.341	716.341
	4	752+18.12	10.417	716.670	716.670
	5	752+14.70	3.250	716.980	716.980
5A	752+16.10	0	717.120	717.120	
H	1	752+15.40	-3.917	717.301	717.301
	1A	752+19.15	31.917	715.721	715.721
	2	752+23.44	28.000	716.032	716.032
	3	752+24.03	17.503	716.341	716.341
	4	752+18.12	10.417	716.670	716.670
	5	752+14.70	3.250	716.980	716.980
5A	752+16.10	0	717.120	717.120	
I	1	752+15.40	-3.917	717.311	717.311
	1A	752+19.15	31.917	715.721	715.721
	2	752+23.44	28.000	716.032	716.032
	3	752+24.03	17.503	716.341	716.341
	4	752+18.12	10.417	716.670	716.670
	5	752+14.70	3.250	716.980	716.980
5A	752+16.10	0	717.120	717.120	
J	1	752+15.40	-3.917	717.320	717.320
	1A	752+19.15	31.917	715.721	715.721
	2	752+23.44	28.000	716.032	716.032
	3	752+24.03	17.503	716.341	716.341
	4	752+18.12	10.417	716.670	716.670
	5	752+14.70	3.250	716.980	716.980
5A	752+16.10	0	717.120	717.120	
K	1	752+15.40	-3.917	717.329	717.329
	1A	752+19.15	31.917	715.721	715.721
	2	752+23.44	28.000	716.032	716.032
	3	752+24.03	17.503	716.341	716.341
	4	752+18.12	10.417	716.670	716.670
	5	752+14.70	3.250	716.980	716.980
5A	753+02.23	0	717.120	717.120	
6	753+05.74	-3.917	717.329	717.329	

SPAN 3







Location	Beam	Station	Offset	Theoretical Grade Elevation	Theoretical Grade Elevation Adjusted for Dead Load Deflection
L BRG. PIER	1	753+07.44	31.917	715.810	715.810
	1A	753+11.17	28.000	715.993	715.993
	2	753+14.03	24.750	716.121	716.121
	3	753+10.35	17.503	716.427	716.427
	4	753+06.92	10.417	716.730	716.730
	5	753+13.28	3.250	717.035	717.035
5A	753+14.18	0	717.176	717.176	
M	1	753+14.03	-3.917	717.339	717.339
	1A	753+17.77	31.917	715.810	715.810
	2	753+20.60	28.000	715.999	715.999
	3	753+16.77	17.503	716.432	716.439
	4	753+12.77	10.417	716.735	716.742
	5	753+13.47	3.250	717.039	717.046
5A	753+12.81	0	717.176	717.183	
N	1	753+14.03	-3.917	717.341	717.341
	1A	753+17.77	31.917	715.810	715.810
	2	753+20.60	28.000	715.995	715.995
	3	753+16.77	17.503	716.432	716.439
	4	753+12.77	10.417	716.735	716.742
	5	753+13.47	3.250	717.039	717.046
5A	753+12.81	0	717.176	717.183	
O	1	753+14.03	-3.917	717.343	717.343
	1A	753+17.77	31.917	715.810	715.810
	2	753+20.60	28.000	715.995	715.995
	3	753+16.77	17.503	716.432	716.439
	4	753+12.77	10.417	716.735	716.742
	5	753+13.47	3.250	717.039	717.046
5A	753+12.81	0	717.176	717.183	
P	1	753+14.03	-3.917	717.343	717.343
	1A	753+17.77	31.917	715.810	715.810
	2	753+20.60	28.000	715.995	715.995
	3	753+16.77	17.503	716.432	716.439
	4	753+12.77	10.417	716.735	716.742
	5	753+13.47	3.250	717.039	717.046
5A	753+12.81	0	717.176	717.183	
Q	1	753+14.03	-3.917	717.343	717.343
	1A	753+17.77	31.917	715.810	715.810
	2	753+20.60	28.000	715.995	715.995
	3	753+16.77	17.503	716.432	716.439
	4	753+12.77	10.417	716.735	716.742
	5	753+13.47	3.250	717.039	717.046
5A	753+12.81	0	717.176	717.183	
R	1	753+14.03	-3.917	717.343	717.343
	1A	753+17.77	31.917	715.810	715.810
	2	753+20.60	28.000	715.995	715.995
	3	753+16.77	17.503	716.432	716.439
	4	753+12.77	10.417	716.735	716.742
	5	753+13.47	3.250	717.039	717.046
5A	753+12.81	0	717.176	717.183	
S BRG. N. ABUT.	1	753+14.03	-3.917	717.343	717.343
	1A	753+17.77	31.917	715.810	715.810
	2	753+20.60	28.000	715.995	715.995
	3	753+16.77	17.503	716.432	716.439
	4	753+12.77	10.417	716.735	716.742
	5	753+13.47	3.250	717.039	717.046
5A	753+12.81	0	717.176	717.183	
6	753+13.50	-3.917	717.329	717.329	

SPAN 4

Location	Beam	Station	Offset	Theoretical Grade Elevation	Theoretical Grade Elevation Adjusted for Dead Load Deflection
T	Wall	753+25.51	32.75	715.797	715.797
	2	753+31.90	25.187	716.112	716.117
	3	753+08.91	17.729	716.422	716.427
	4	753+34.67	10.270	716.732	716.737
	5	754+01.02	2.812	717.041	717.046
	5A	754+03.42	0	717.159	717.160
Wall	754+07.47	-4.75	717.354	717.354	
U	Wall	753+05.04	32.75	715.793	715.793
	2	753+12.20	25.187	716.100	716.100
	3	753+09.59	17.729	716.415	716.417
	4	754+04.72	10.270	716.725	716.727
	5	754+11.04	2.812	717.033	717.035
	5A	754+13.43	0	717.149	717.157
Wall	754+16.53	-4.75	717.346	717.346	
V BACK N. ABUT.	Wall	753+07.43	32.75	715.784	715.784
	2	754+03.81	25.187	716.099	716.099
	3	754+10.10	17.729	716.407	716.407
	4	754+16.40	10.270	716.715	716.715
	5	754+22.69	2.812	717.022	717.022
	5A	754+25.04	0	717.138	717.138
Wall	754+27.07	-4.75	717.334	717.336	

Note: See Sheet 2 for Fillet Details and Determination of Elevations indicated are to top of deck surfacing

GRADE ELEVATIONS
 SOUTHBOUND STRUCTURE
 FAI ROUTE 55 SEC. 57-IOHB
 MC LEAN COUNTY
 STATION 753+54.41

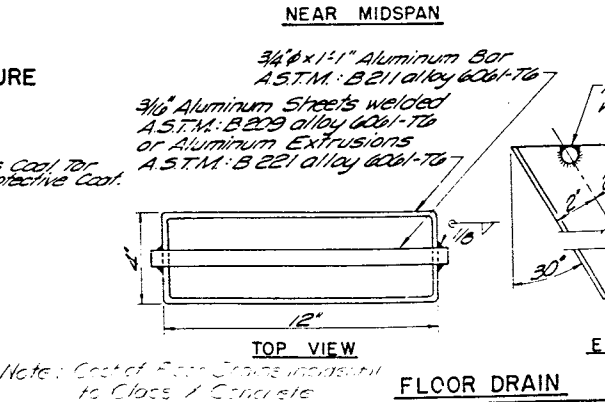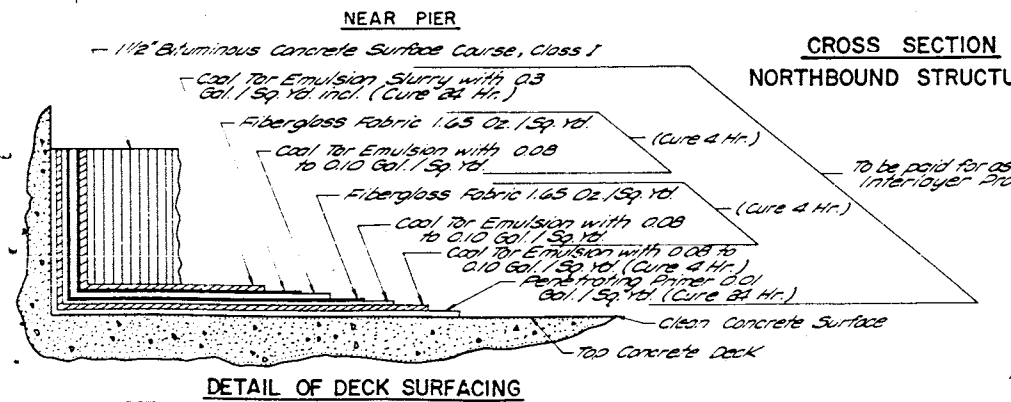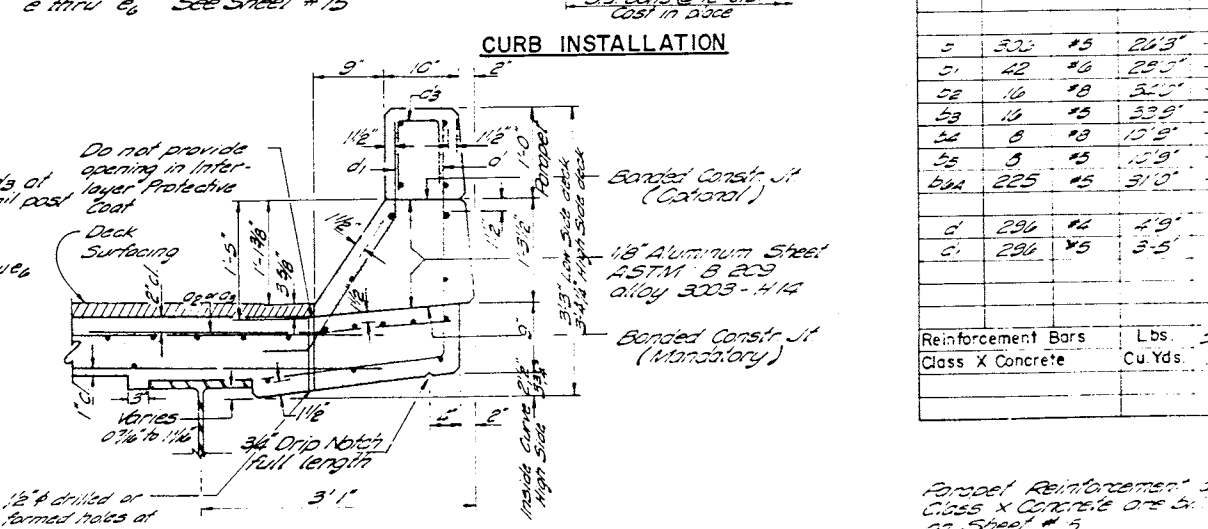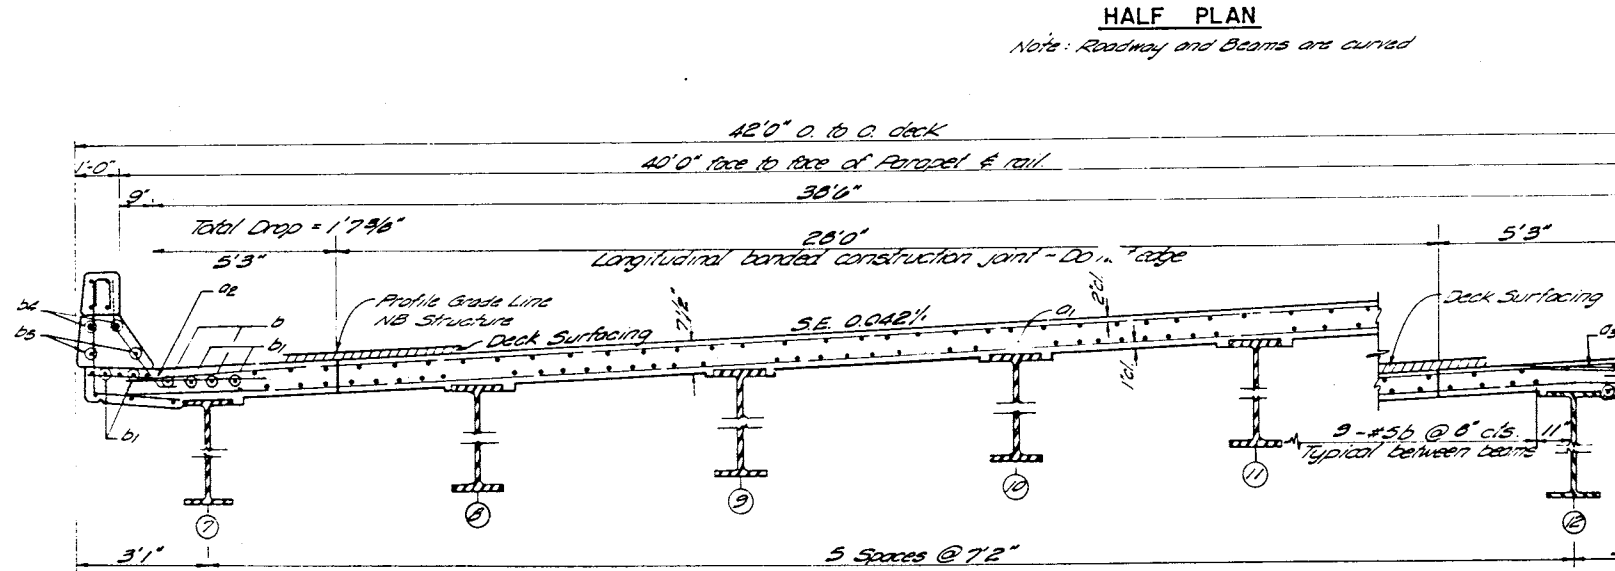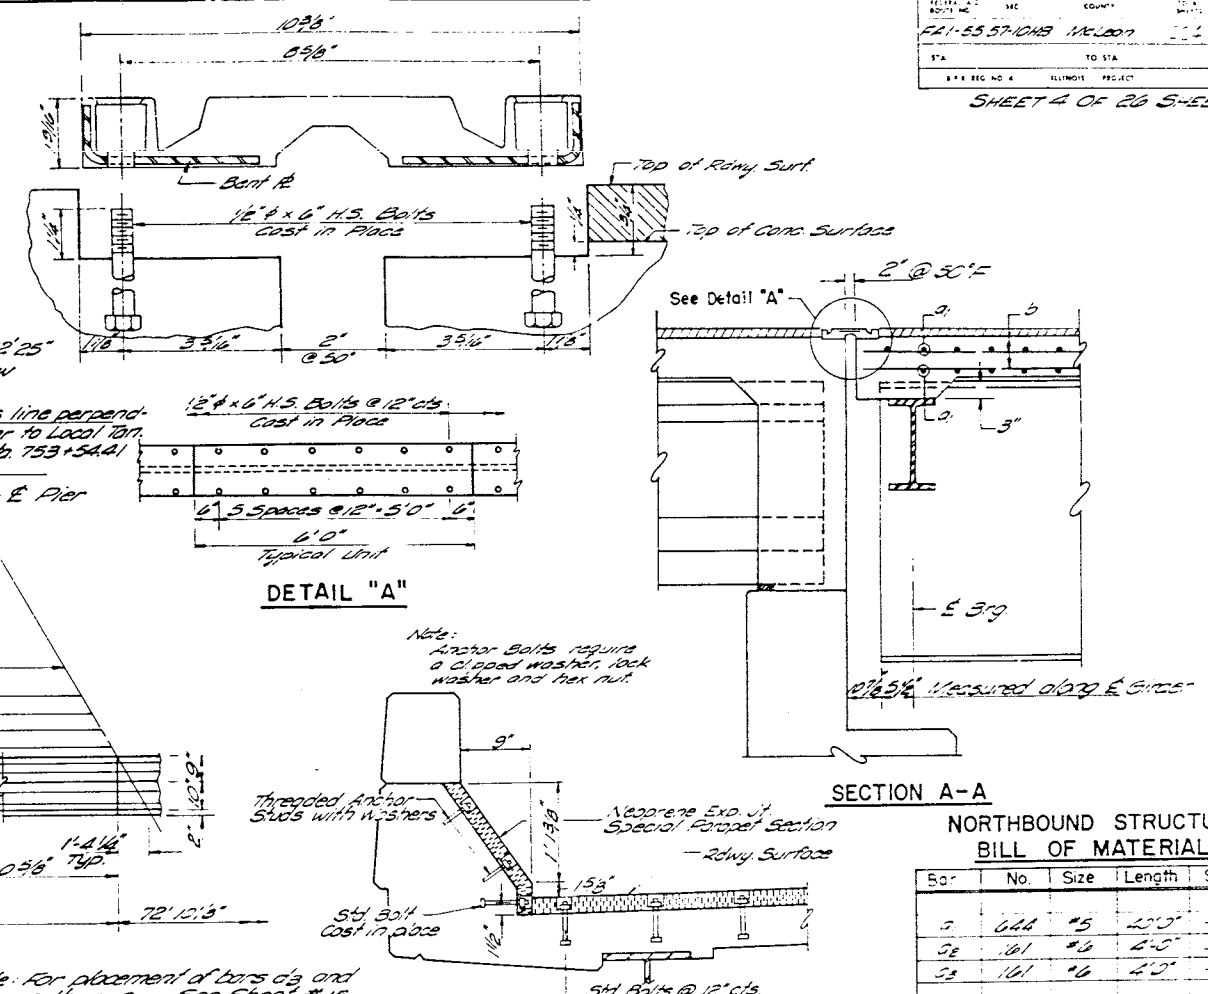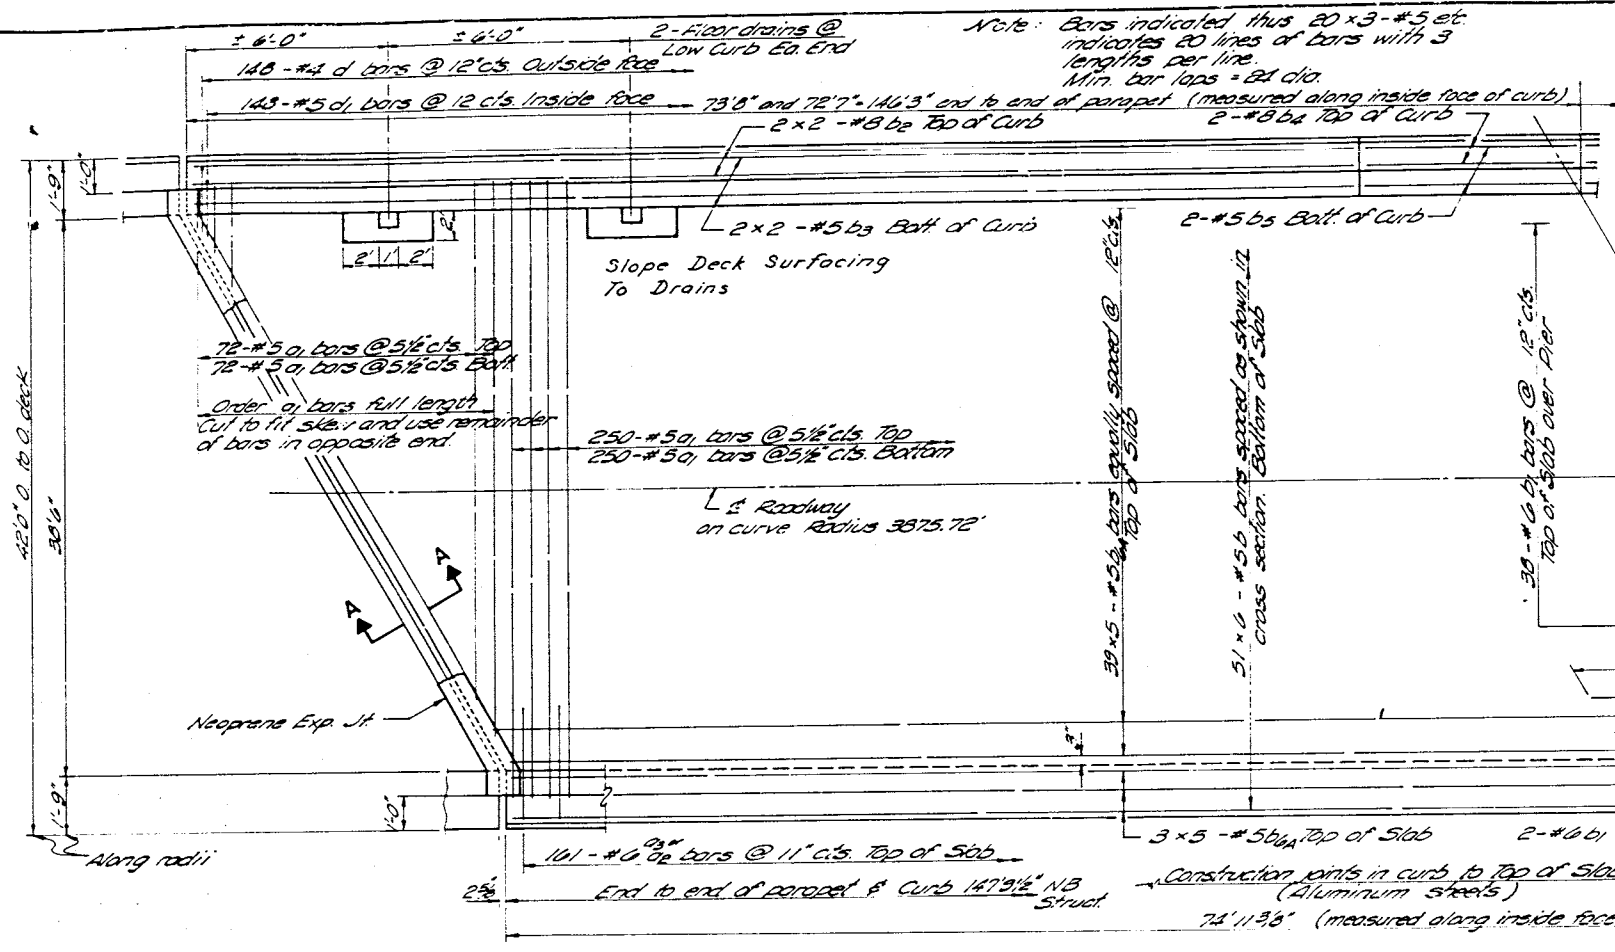



NORTHBOUND STRUCTURE BILL OF MATERIAL

Bar	No.	Size	Length	Shape
1	644	#5	25'0"	
2	181	#6	2'0"	
3	161	#6	4'0"	
4	300	#5	20'3"	
5	42	#6	22'0"	
6	16	#8	3'0"	
7	16	#8	33'9"	
8	8	#8	15'8"	
9	8	#5	15'9"	
10	225	#5	3'10"	
11	296	#2	2'9"	
12	296	#5	3'5"	

Reinforcement Bars Lbs. 50,550
 Class X Concrete Cu Yds. 709




SUPERSTRUCTURE NORTHBOUND STRUCTURE
 FAI ROUTE 55 SEC. 57-10HB
 MC LEAN COUNTY
 STATION 753+54.41

Parapet Reinforcement 515
 Class X Concrete area 51.82
 at Sheet #.5

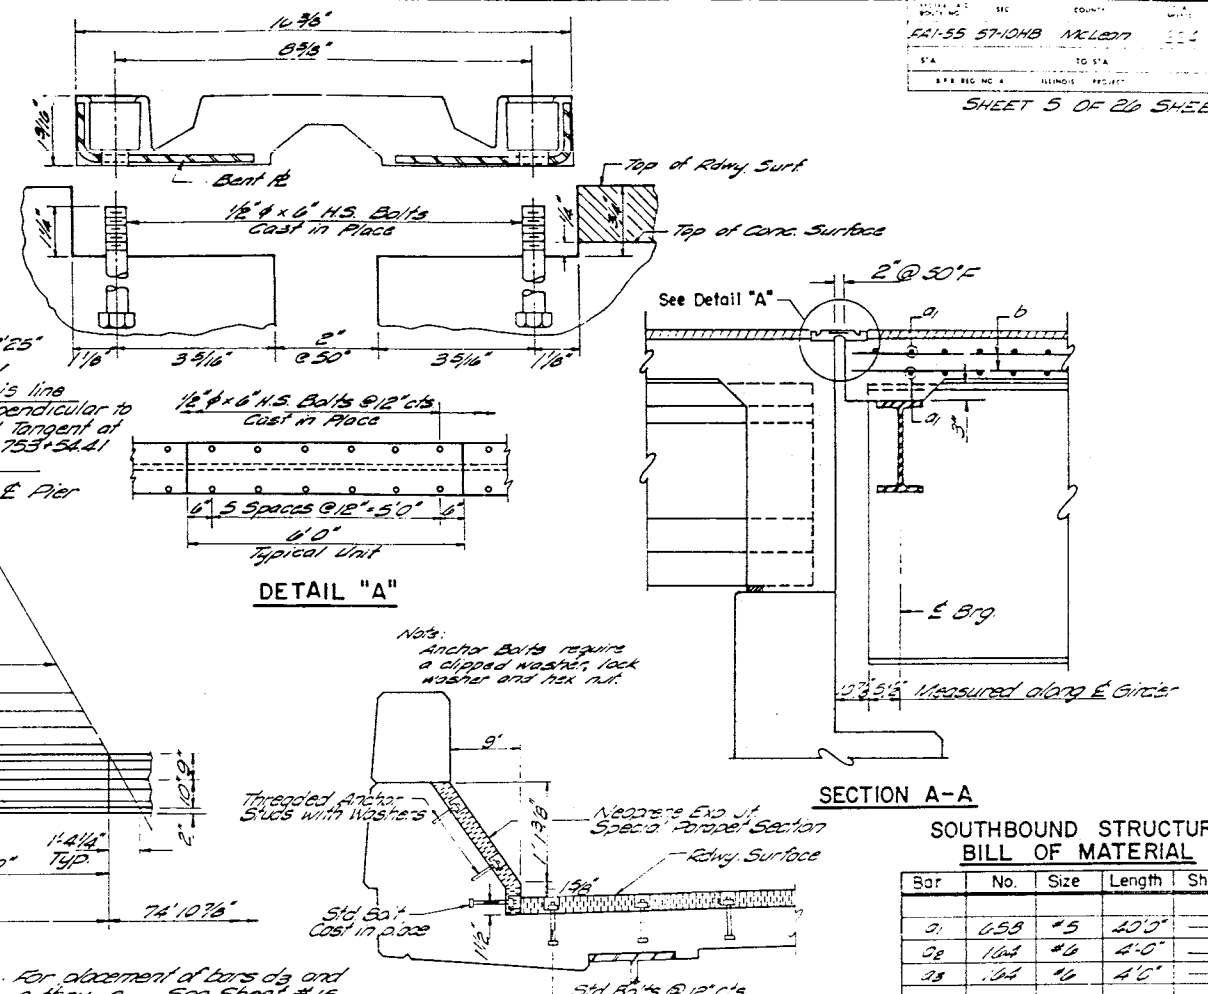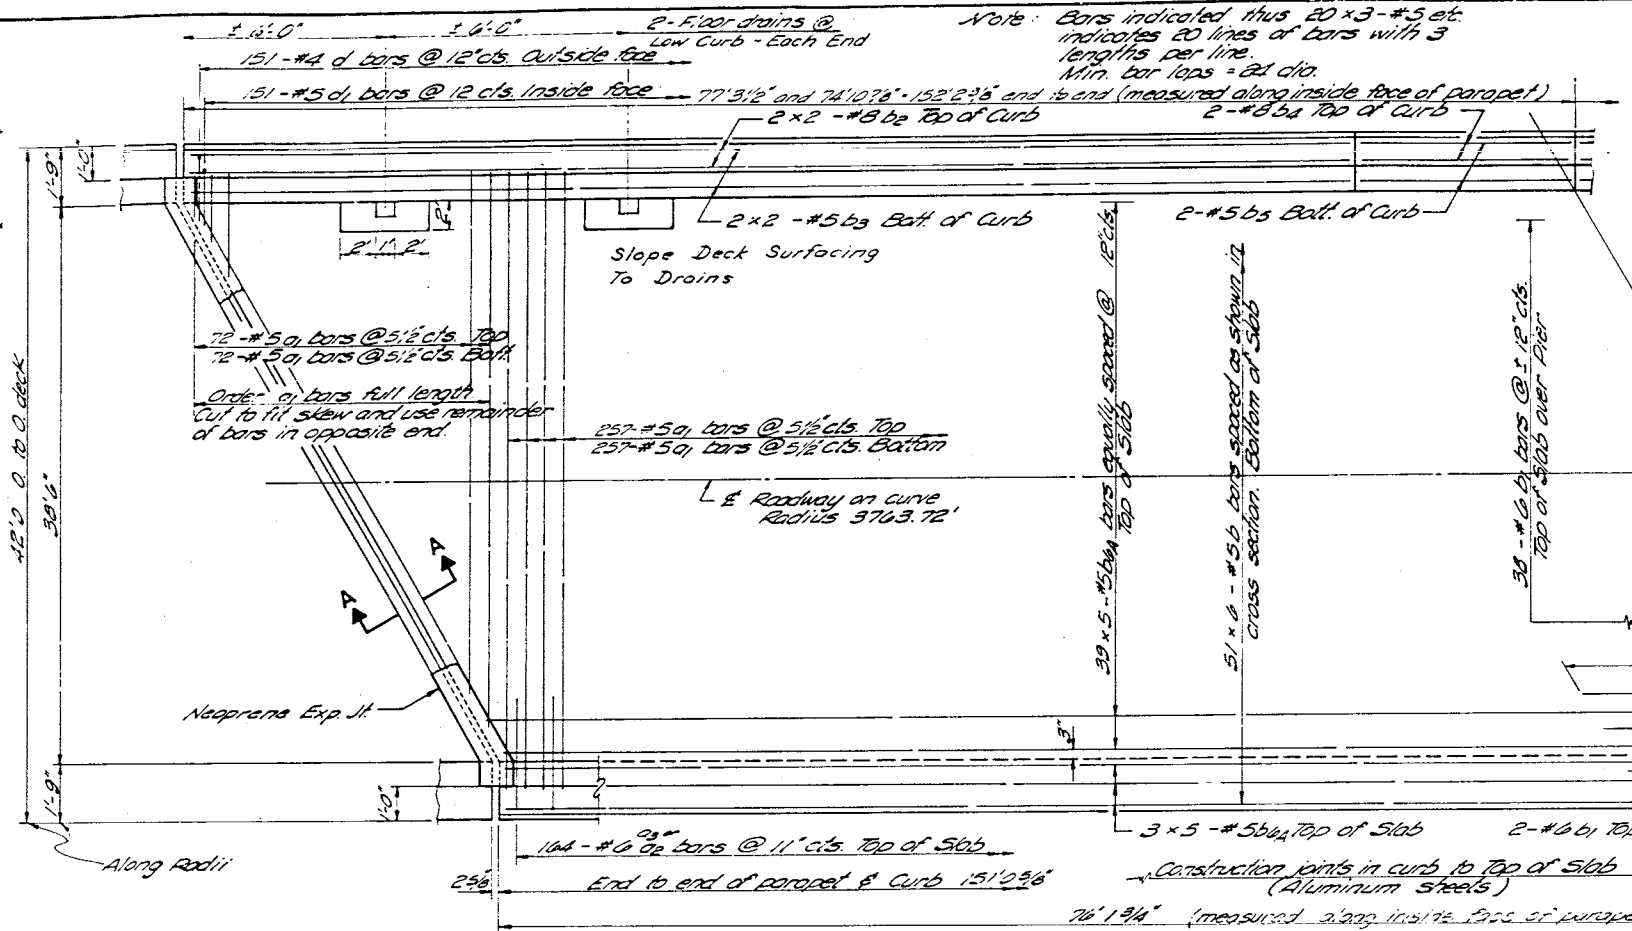

SOUTHBOUND STRUCTURE BILL OF MATERIAL

Bar	No.	Size	Length	Shape
a1	658	#5	40'0"	
a2	164	#6	4'0"	
a3	154	#6	4'0"	
b	300	#5	24'3"	
b1	42	#6	25'0"	
b2	16	#8	34'0"	
b3	10	#8	33'9"	
b4	8	#8	10'9"	
b5	8	#8	10'9"	
b6a	225	#5	31'0"	
d	302	#4	4'9"	
d1	302	#5	3'5"	
Reinforcement Bars		Lbs.	5,210	
Class X Concrete		Cu. Yds.	182.3	

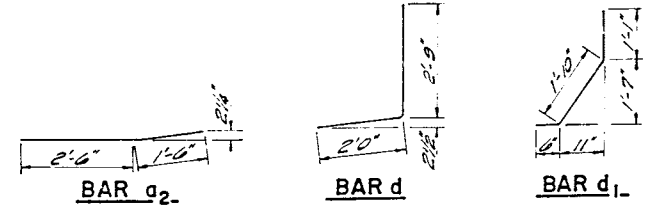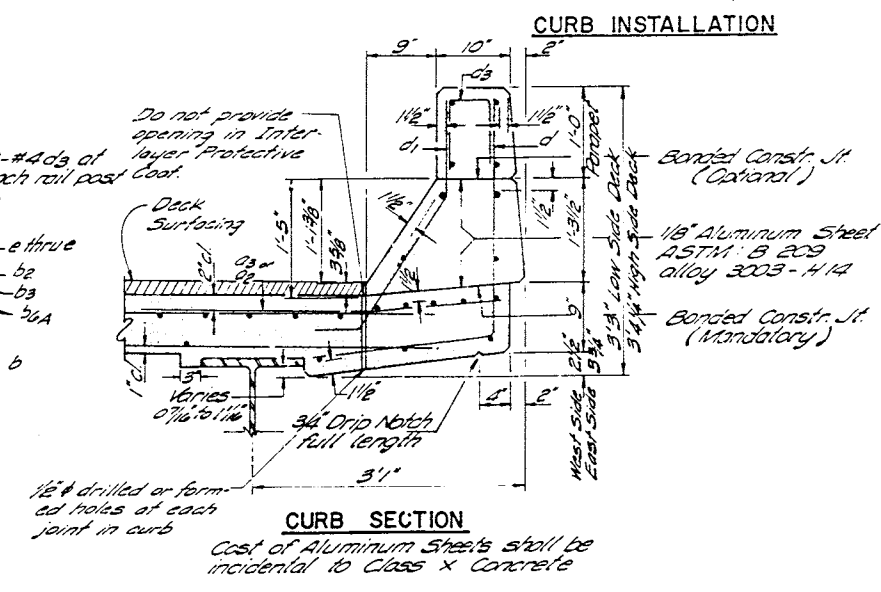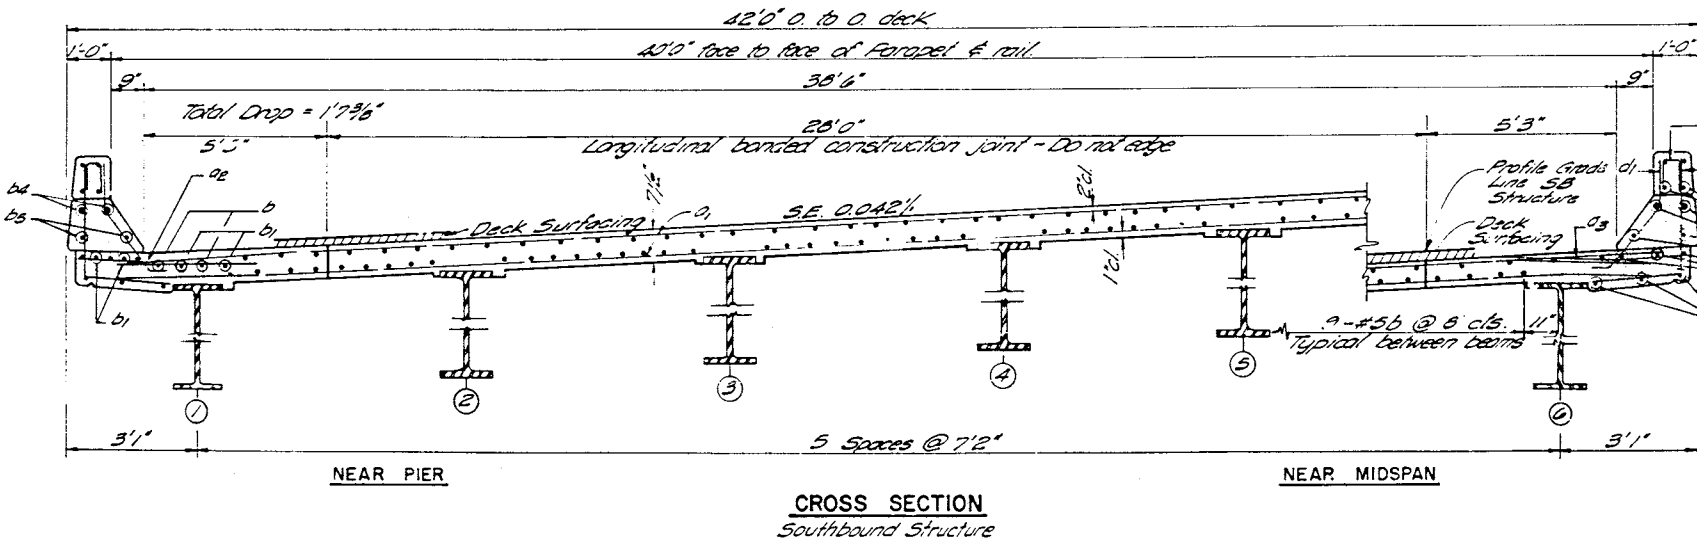


Parapet Reinforcement and Class X Concrete are detailed on Sheet #15


SUPERSTRUCTURE
SOUTHBOUND STRUCTURE
 FAI ROUTE 55 SEC. 57-10HB
 MC LEAN COUNTY
 STATION 753+54.1

Note:
 See Sheet 4 of 26 for detail of Deck Surfacing.
 See Sheet 4 of 26 for detail of Floor Drain.


Note: For details of rebar exp. Jt. see Detail "A" sheet # 5

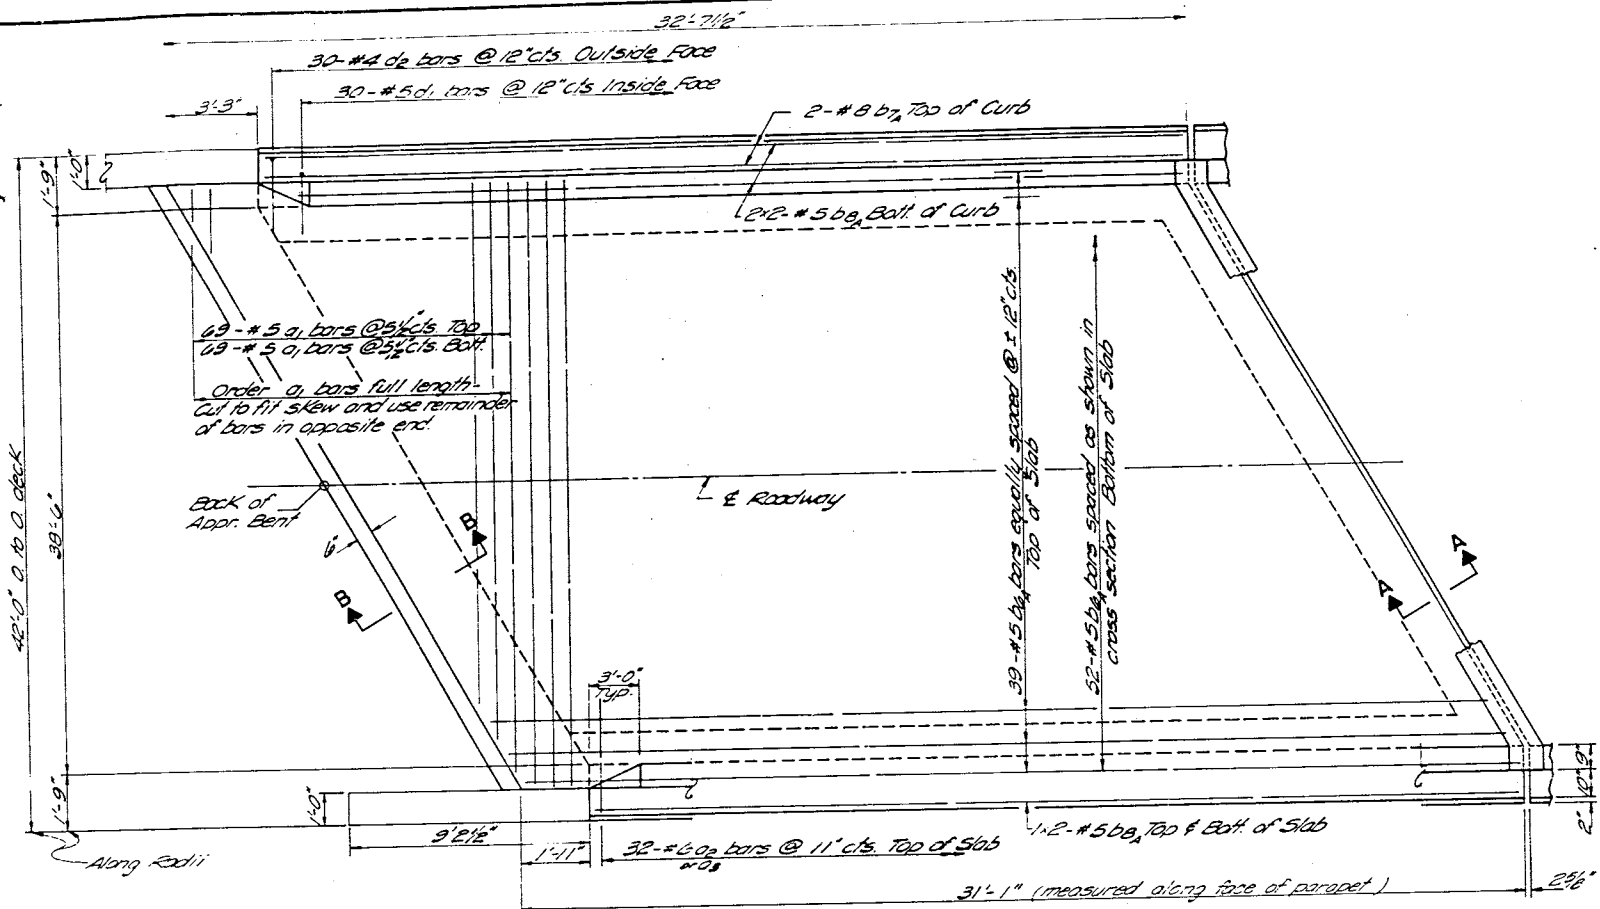

PLAN
NORTH SPAN - SOUTHBOUND

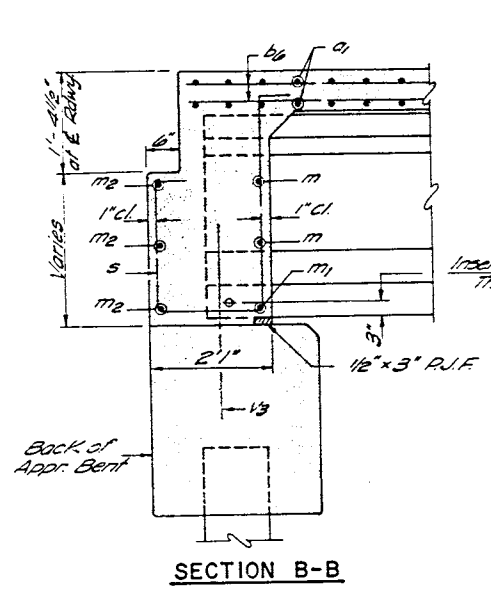

SECTION B-B

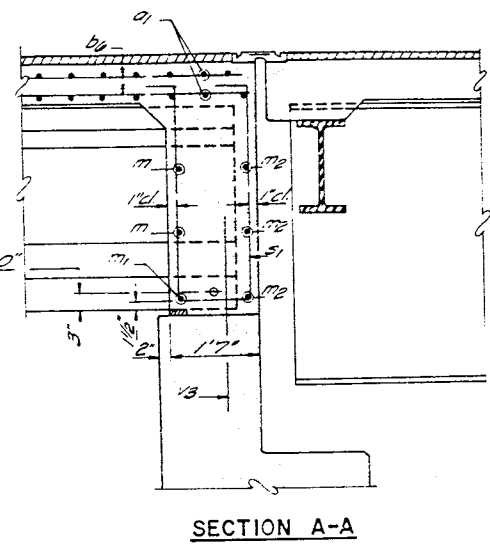


SECTION A-A


ONE APPR. SPAN
BILL OF MATERIAL

Bar	No.	Size	Length	Shape
a1	138	#5	40'-0"	
a2	32	#6	4'-0"	
a3	32	#6	4'-0"	
b1a	91	#5	31'-6"	
b2a	2	#8	28'-9"	
b3a	16	#5	15'-3"	
d1	20	#5	3'-5"	
d2	60	#4	4'-9"	
m	20	#4	8'-6"	
m1	10	#5	7'-6"	
m2	12	#5	24'-3"	
m3	10	#4	6'-9"	
m4	10	#4	5'-9"	
s	25	#4	7'-9"	
s1	25	#4	8'-9"	
s2	25	#4	6'-10"	
Reinforcement Bars			Lbs.	11,180
Class X Concrete			Cu. Yds.	55.9


* Parapet Reinforcement and Class X Concrete are billed on sheet # 5
For placement and details of bars thru m3 and s thru s2 see Sheet # 2

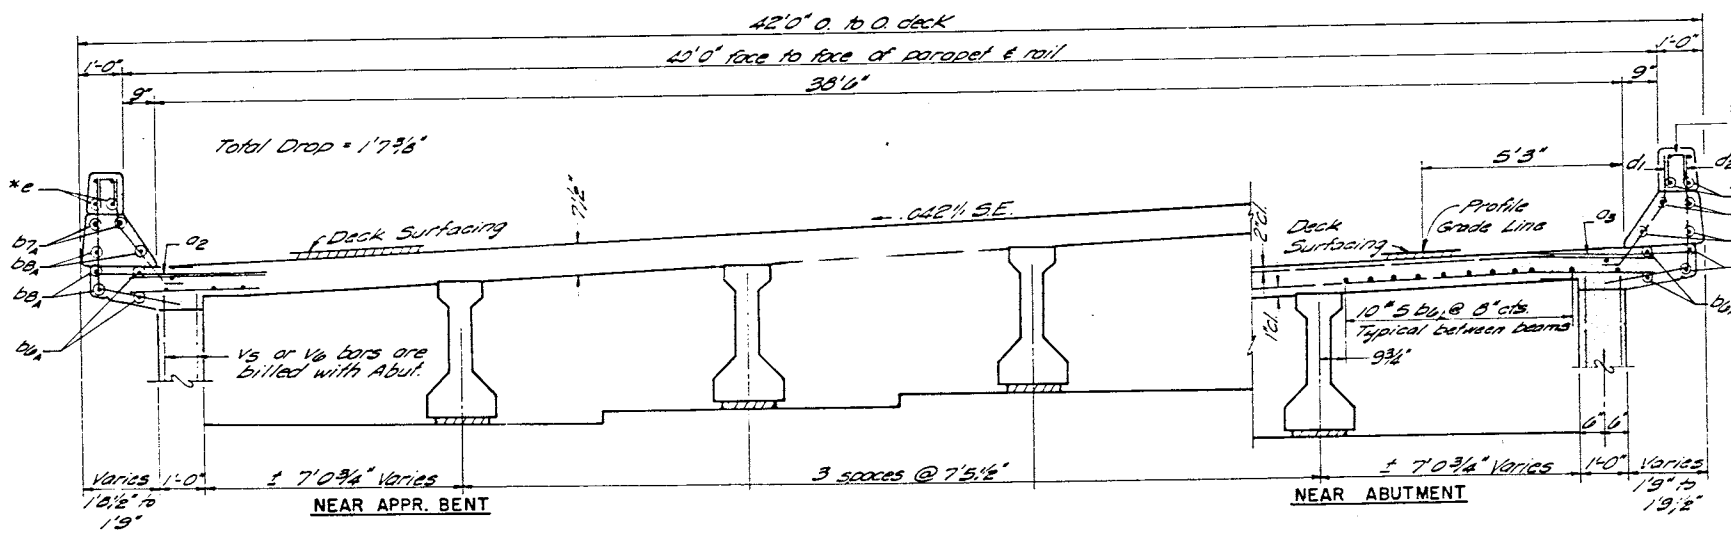

CROSS SECTION

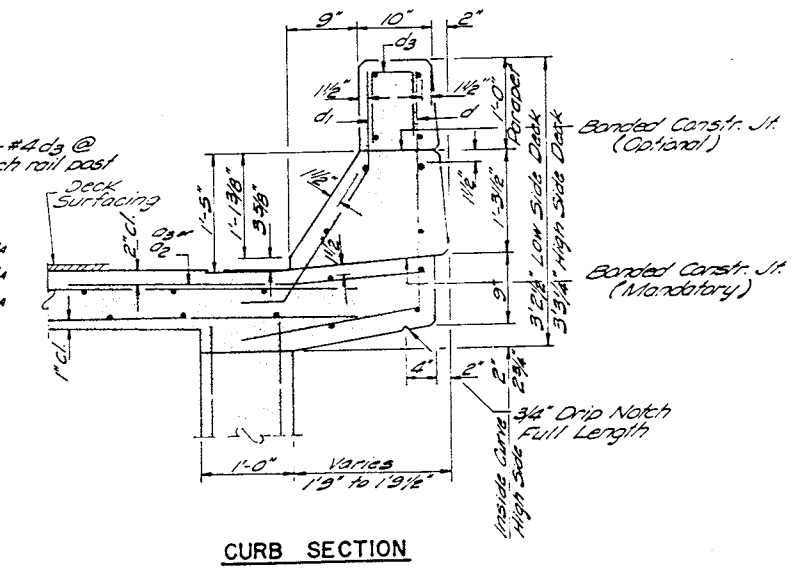


CURB SECTION

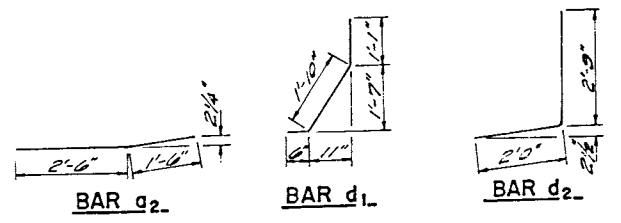


SUPERSTRUCTURE
 NORTH SPAN - SOUTHBOUND
 FAI ROUTE 55 SEC. 57-10H-B
 MC LEAN COUNTY
 STATION 753+54.41

Note: See Sheet 4 For Detail Of Deck Surfacing


Note: For details of Neoprene exp. Jt. see Detail "A" sheet # 5

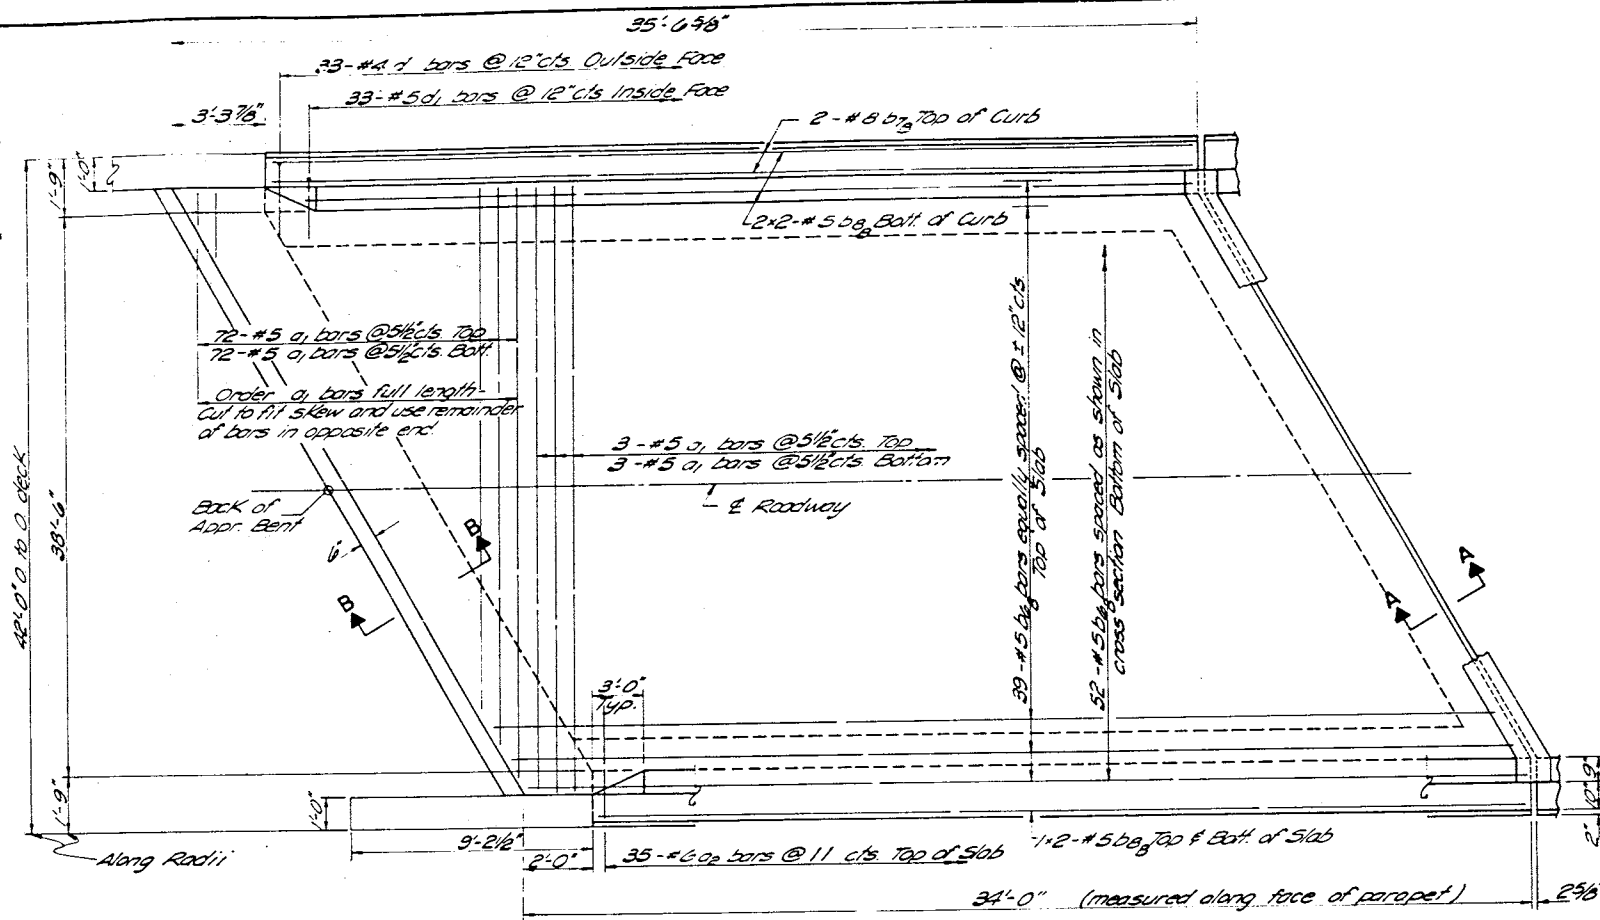

PLAN
 SOUTH SPAN - NORTHBOUND

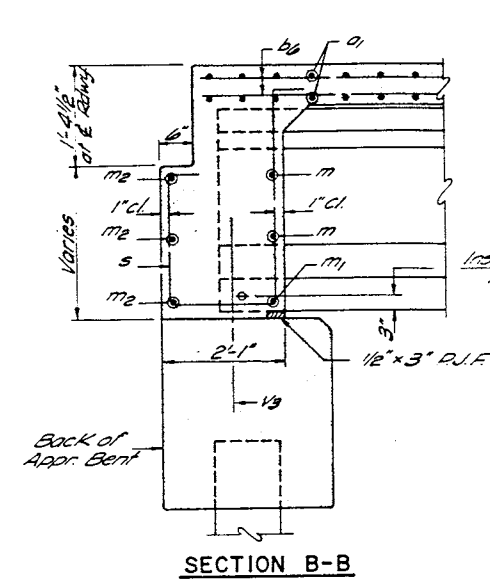


SECTION B-B

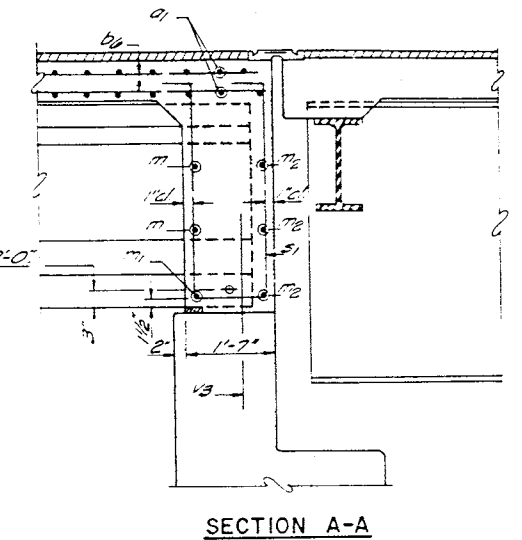


SECTION A-A

ONE APPR. SPAN
 BILL OF MATERIAL


Bar	No.	Size	Length	Shape
s1	150	#5	40'-0"	
s2	35	#5	4'-5"	
s3	35	#5	4'-0"	
s3a	91	#5	34'-0"	
o7a	4	#8	32'-0"	
o8a	19	#5	16'-5"	
d1	60	#5	3'-5"	
d2	60	#4	4'-9"	
m	20	#4	8'-6"	
m1	10	#5	7'-6"	
m2	12	#5	24'-6"	
m3	10	#4	6'-9"	
m4	10	#4	5'-9"	
s	35	#4	7'-9"	
s1	35	#4	8'-9"	
s2	25	#4	4'-10"	
Reinforcement Bars		Lbs.	2050	
Class X Concrete		Cu. Yds.	55.7	

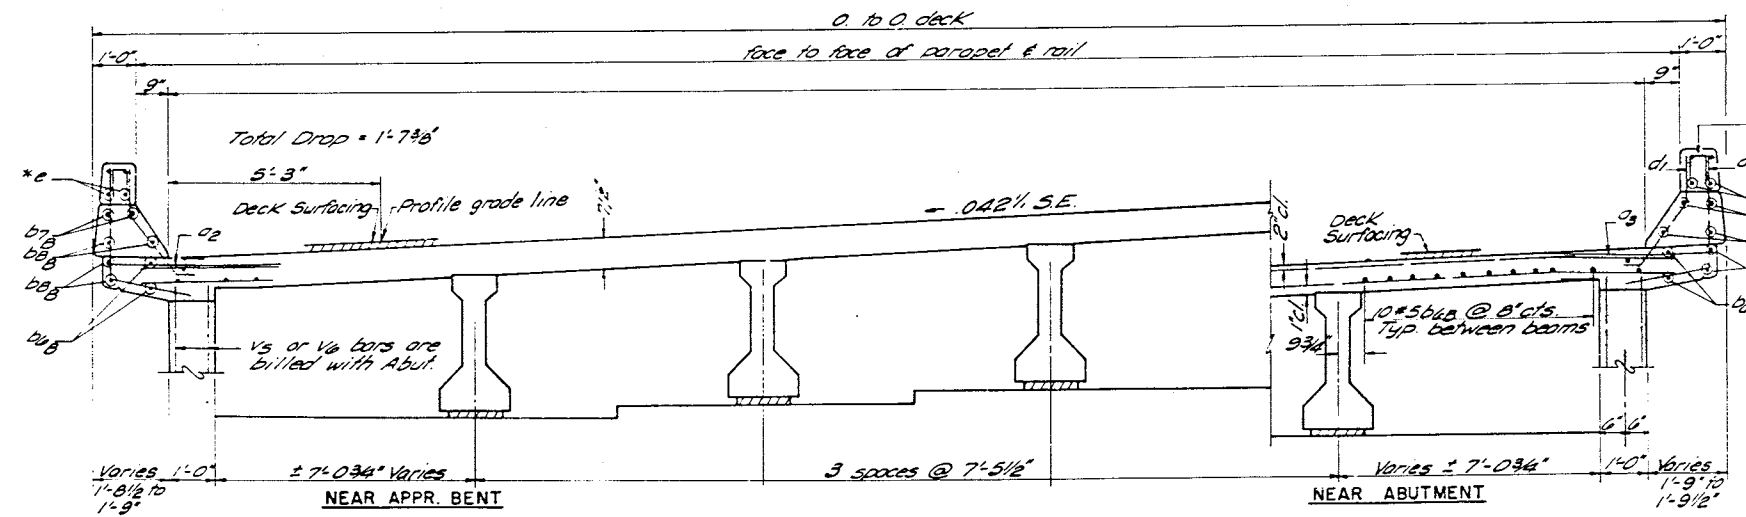

CROSS SECTION

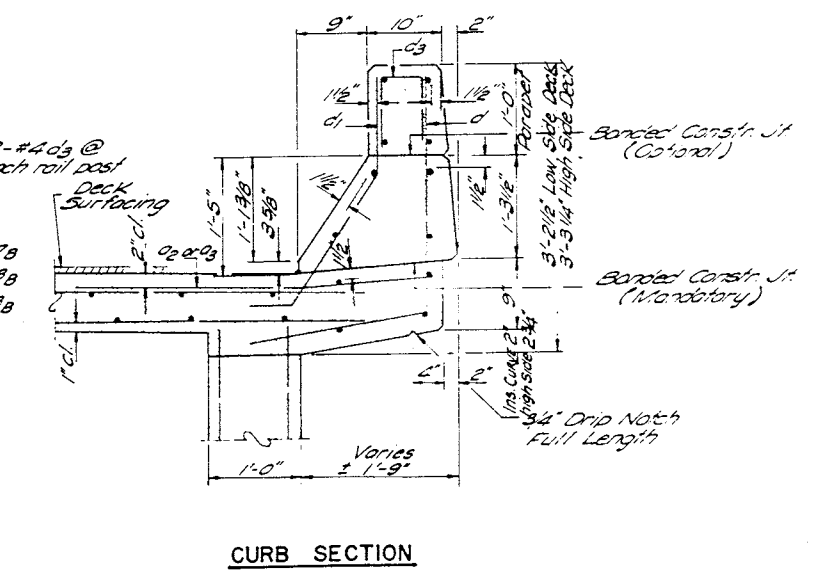


CURB SECTION

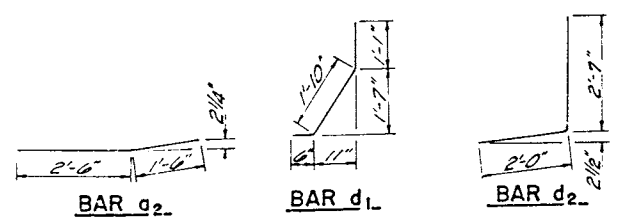


SUPERSTRUCTURE
 SOUTH SPAN - NORTHBOUND
 FAI ROUTE 55 SEC. 57-104B
 MC LEAN COUNTY
 STATION 753+54.41

Note: See Sheet 4 For Detail Of Deck Surfacing


Note: For details of neoprene exp. jt. see Detail 'A' sheet # 5

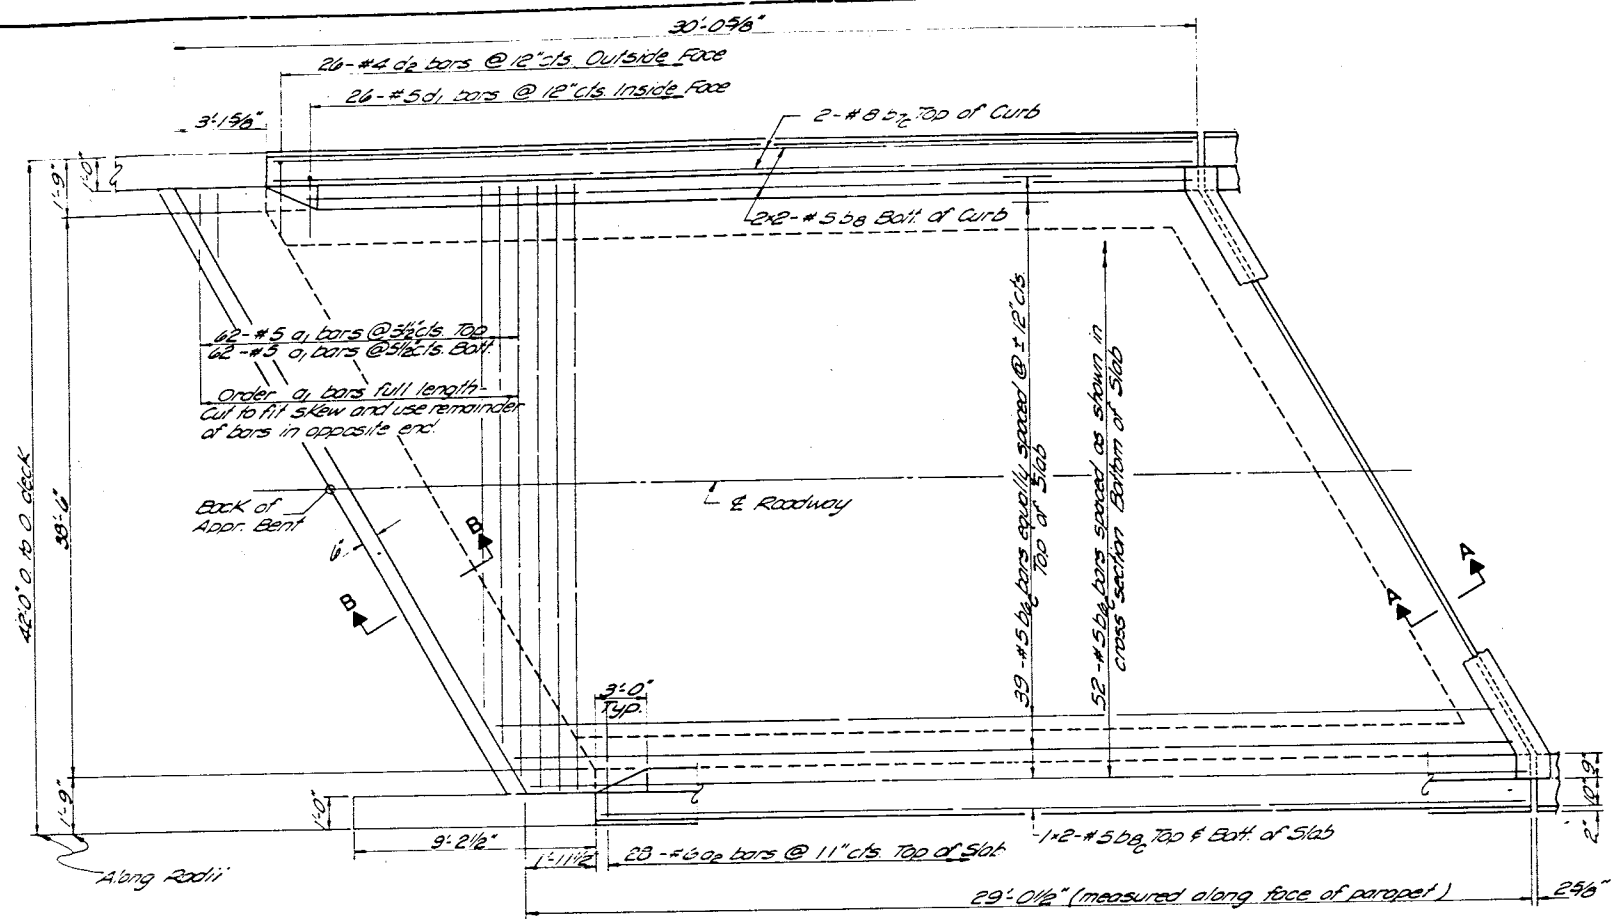

PLAN
North Span Northbound

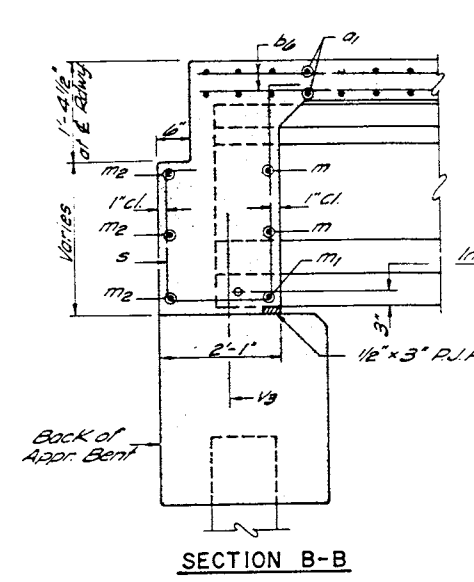

SECTION B-B

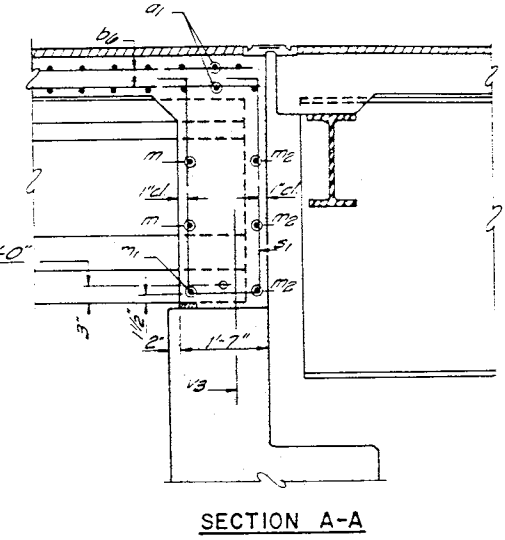


SECTION A-A


ONE APPR. SPAN
BILL OF MATERIAL

Bar	No.	Size	Length	Shape
a1	24	#5	40'-0"	
a2	28	#6	4'-3"	
a3	28	#6	4'-0"	
a4	91	#5	28'-3"	
a5	4	#8	25'-6"	
a6	16	#5	12'-3"	
d1	52	#5	3'-5"	
d2	52	#4	4'-9"	
m	20	#4	8'-6"	
m1	10	#5	7'-6"	
m2	12	#5	25'-5"	
m3	10	#4	6'-9"	
m4	10	#4	5'-9"	
s	35	#4	7'-9"	
s1	35	#4	8'-9"	
s2	25	#4	6'-0"	
Reinforcement Bars			Lbs.	10,140
Class X Concrete			Cu. Yds.	53.5


* Parapet Reinforcement and Class X Concrete are billed on sheet # 5
 For placement and details of bars thru m5 and s thru s2 see sheet # 2

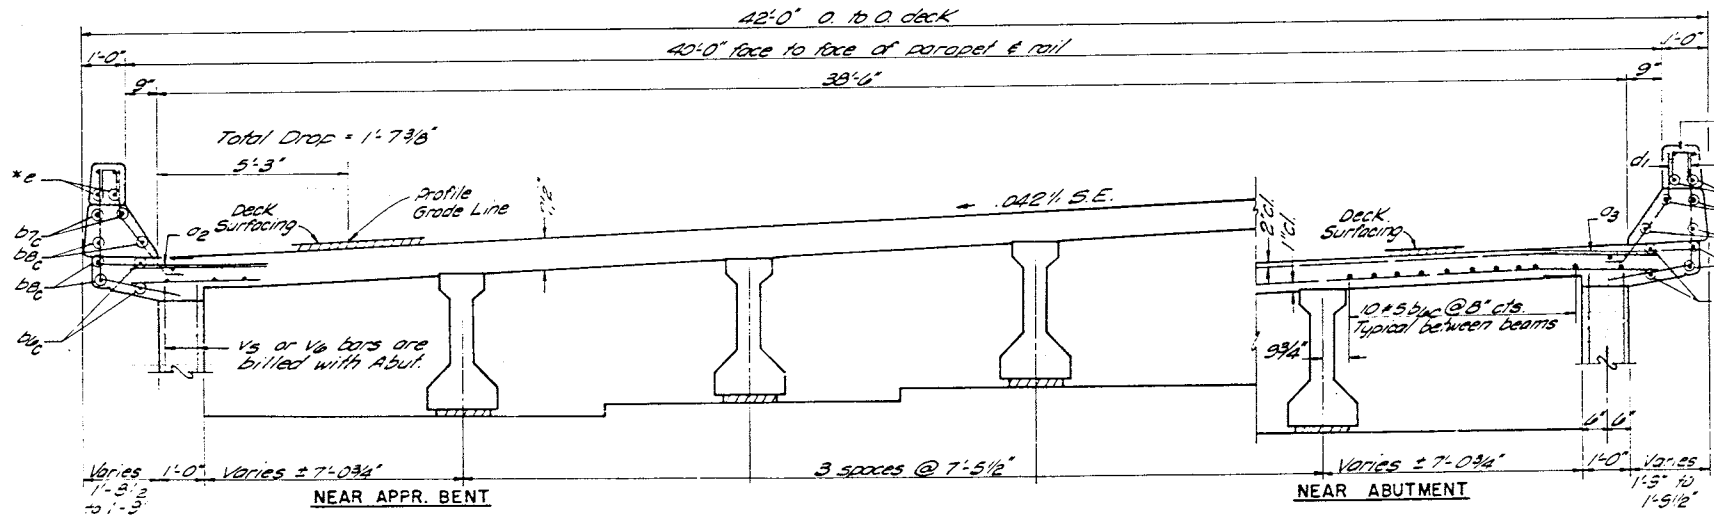

CROSS SECTION

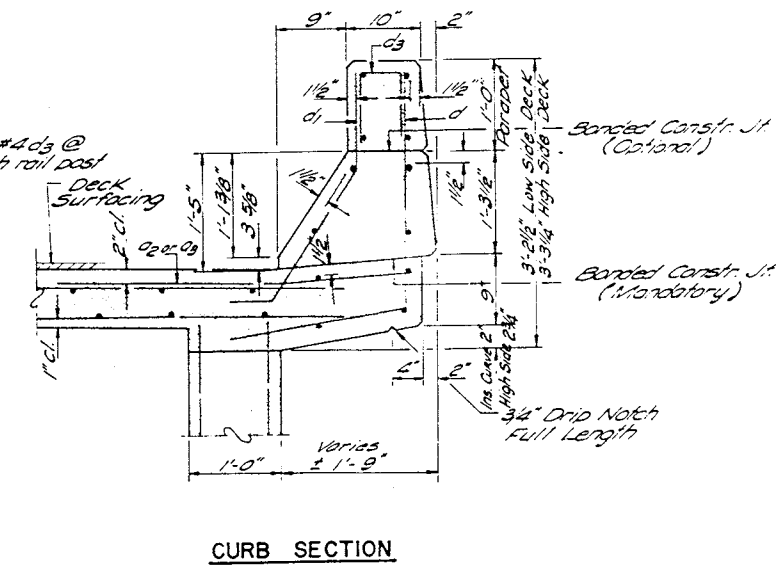

CURB SECTION

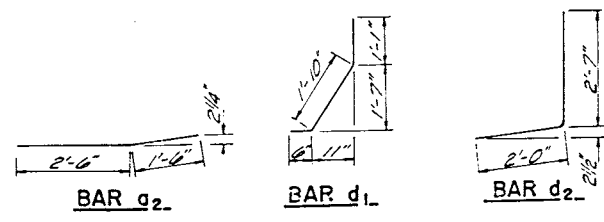


BAR a2

BAR d1


BAR d2

Note: See Sheet 4 For Detail Of Deck Surfacing


SUPERSTRUCTURE
 NORTH SPAN - NORTHBOUND
 FAI ROUTE 55 SEC. 57-104B
 MC LEAN COUNTY
 STATION 753+54.41

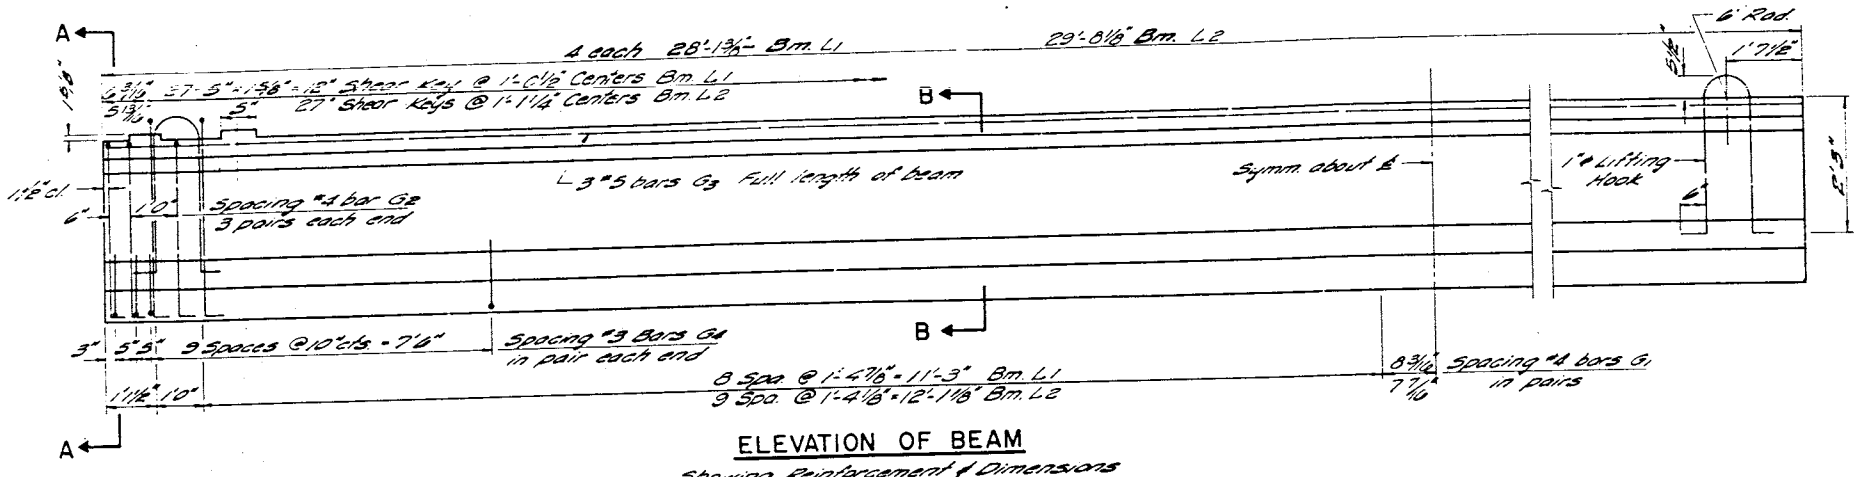


ELEVATION OF BEAM
 Showing Reinforcement & Dimensions

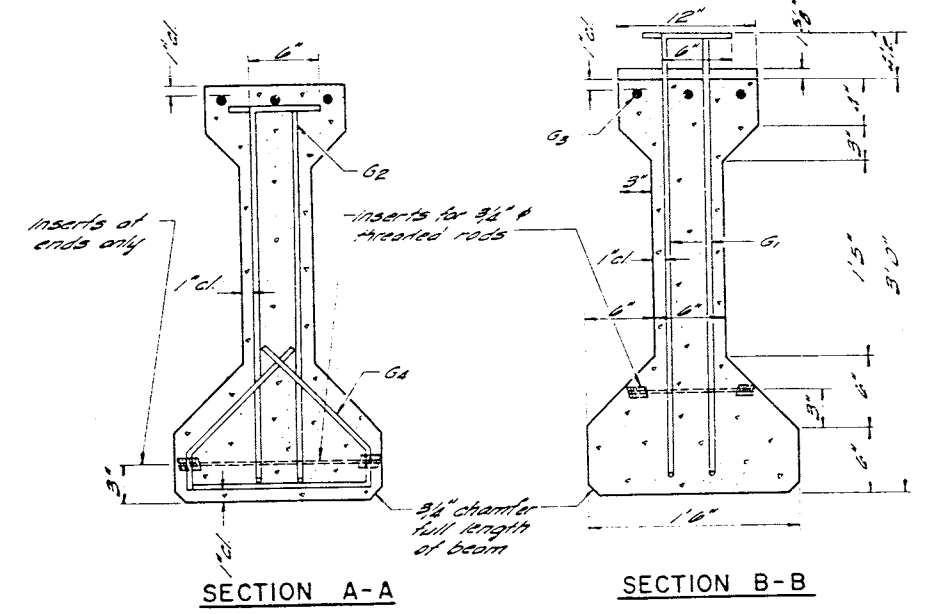


SECTION A-A **SECTION B-B**

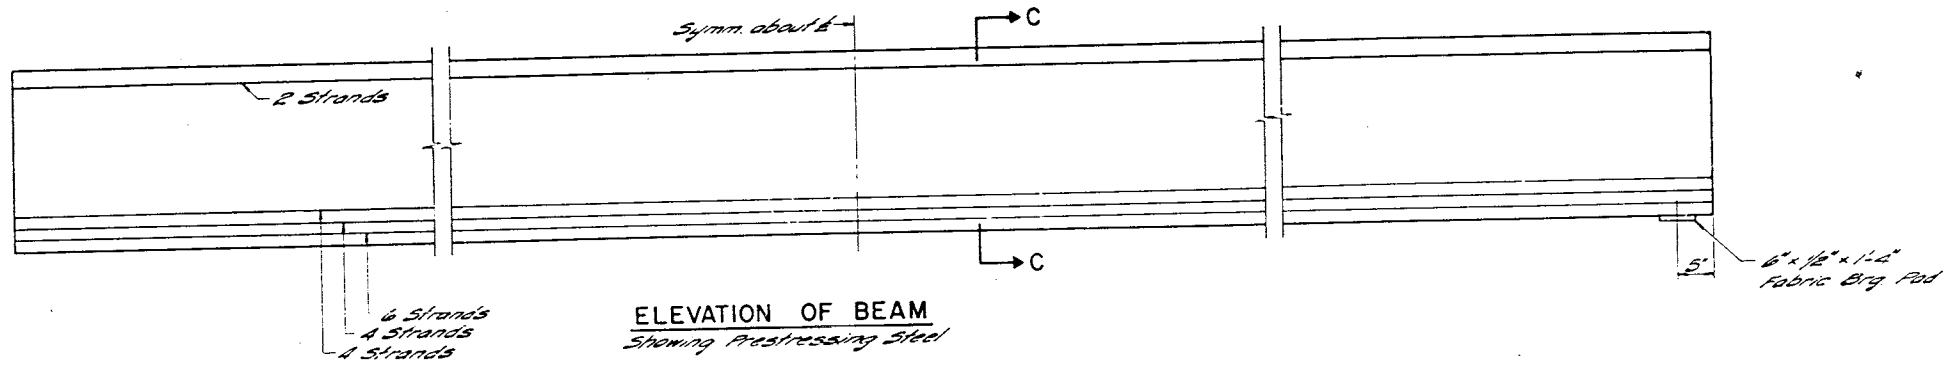

ELEVATION OF BEAM
 Showing Prestressing Steel

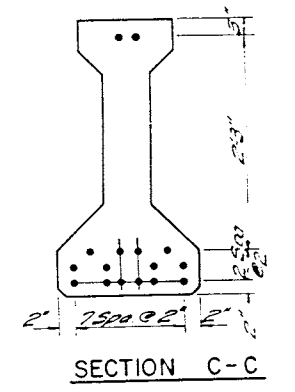


SECTION C-C

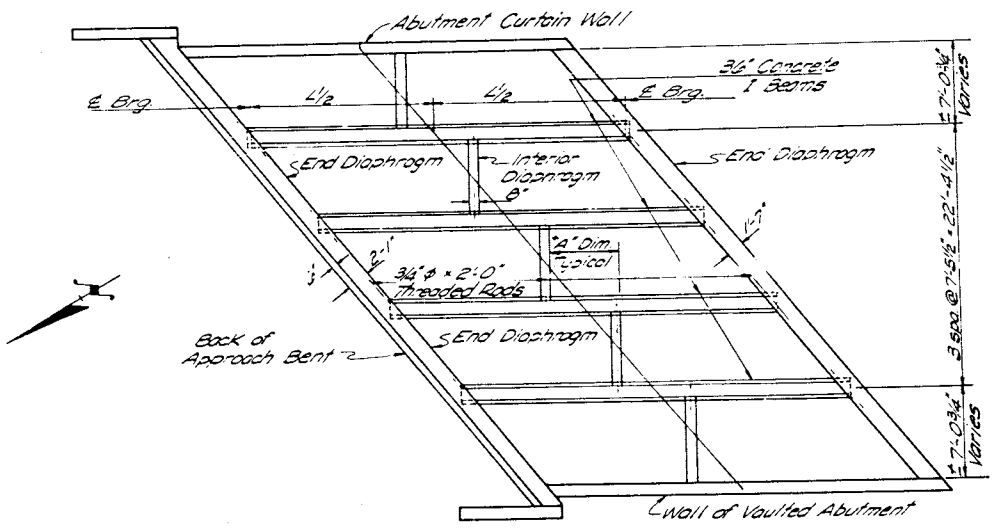

FRAMING PLAN

Beam L1: L=27'-3 3/8\" A=5'-11 3/8\" North Span Northbound Roadway
 Beam L2: L=28'-10 1/8\" A=6'-2 3/8\" North Span Southbound Roadway
 Four of each beam required

Note: Beams are to be set parallel to the chord of the line designated as profile which are cast into the Precast concrete I-Beams which are included in the contract unit price per linear foot of "Furnishing And Erecting Precast Prestressed concrete I-Beams, 36 in."

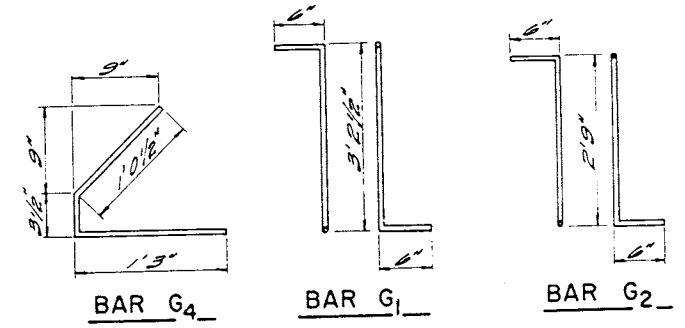

BAR G4 **BAR G1** **BAR G2**

NOTES

All inserts and threaded rods for inserts, reinforcing and Prestressing Steel, and other items which are cast into the Precast concrete I-Beams shall be included in the contract unit price per linear foot of "Furnishing And Erecting Precast Prestressed concrete I-Beams, 36 in."

See Standard Specifications for additional information regarding materials, Prestressing equipment, construction and handling methods and other requirements for Precast Prestressed concrete I-Beams. Prestressing Steel shall have a nominal diameter of 7/16."

Inserts for 3/4\" threaded rods are to be two strut, coil type for interior I-Beams and single coil, flared loop type for exterior I-Beams. Steel for lifting hooks shall be A.S.T.M. A-306, Grade 70-80. An alternate strand pattern using Extra High Strength Prestressing strand (270 ksi) is permitted. See Special Provisions.






*** BAR LIST**

Beam	Bar No	Size	Length	Shape
Beam L1	G1	#4	42 1/2"	7L
	G2	#4	39"	7L
	G3	#5	27 1/2"	—
	G4	#3	27"	L
Beam L2	G1	#4	42 1/2"	7L
	G2	#4	39"	7L
	G3	#5	27 1/2"	—
	G4	#3	27"	L


BILL OF MATERIAL * For Each Beam

Item	Unit	Total
Furnishing & Erecting Precast Prestressed Concrete I-Beams, 36"	Lin. Ft.	231

**NORTH APPR. SPANS
 PRESTRESSED I-BM. DETAILS**
 F.A.I. ROUTE 55 SEC. 57-10HB
 MC LEAN COUNTY
 STATION 753+54.41

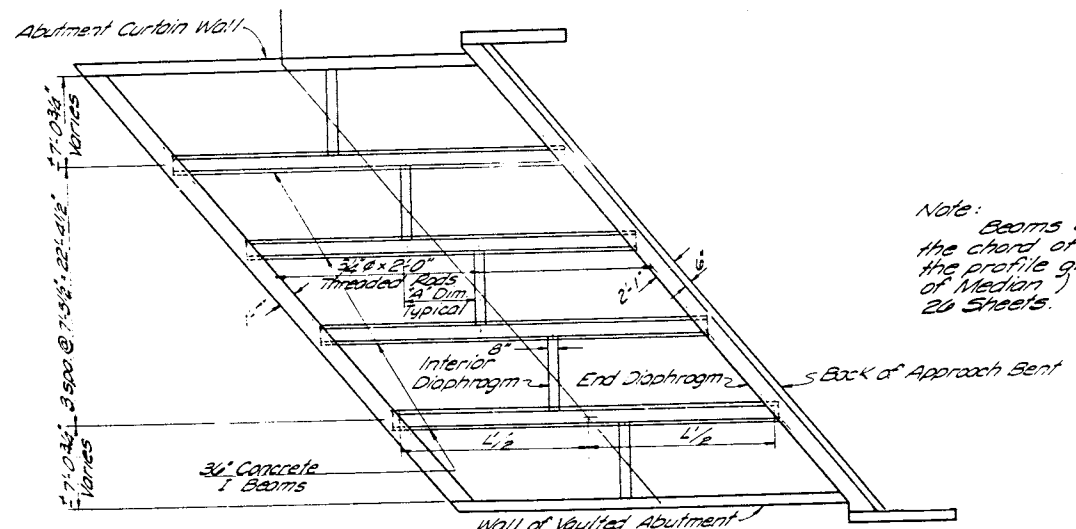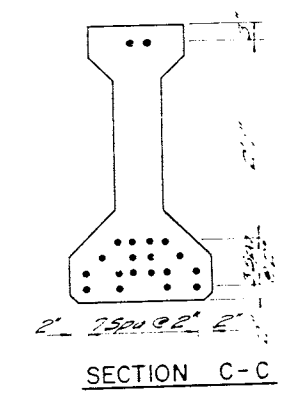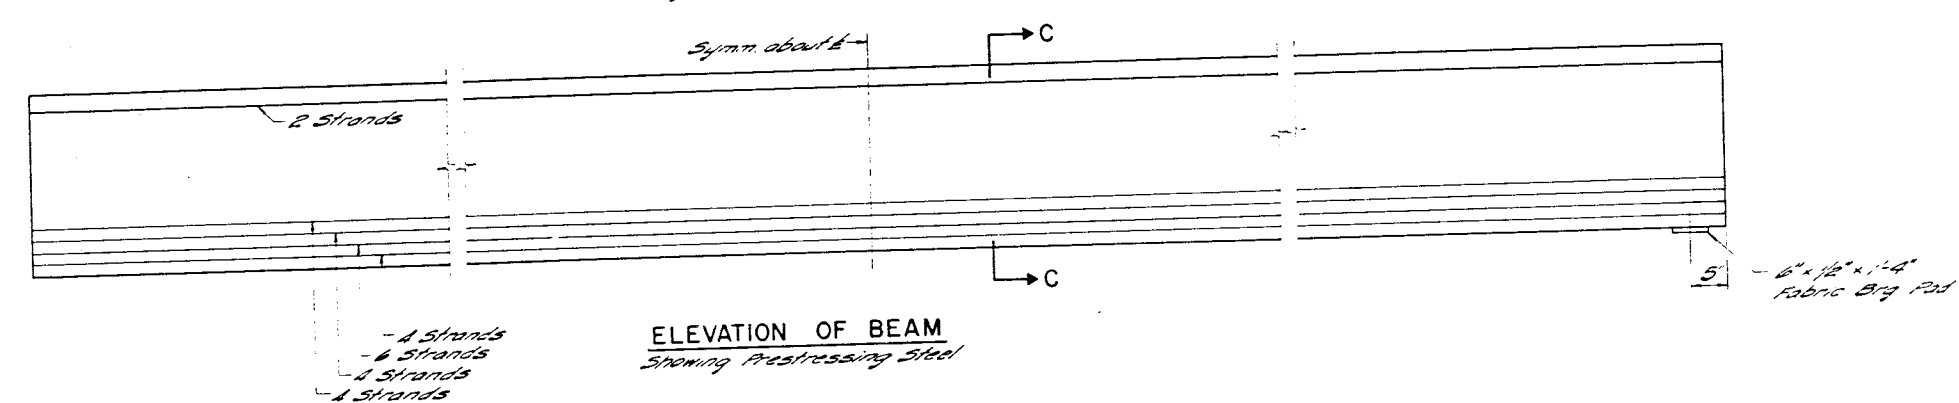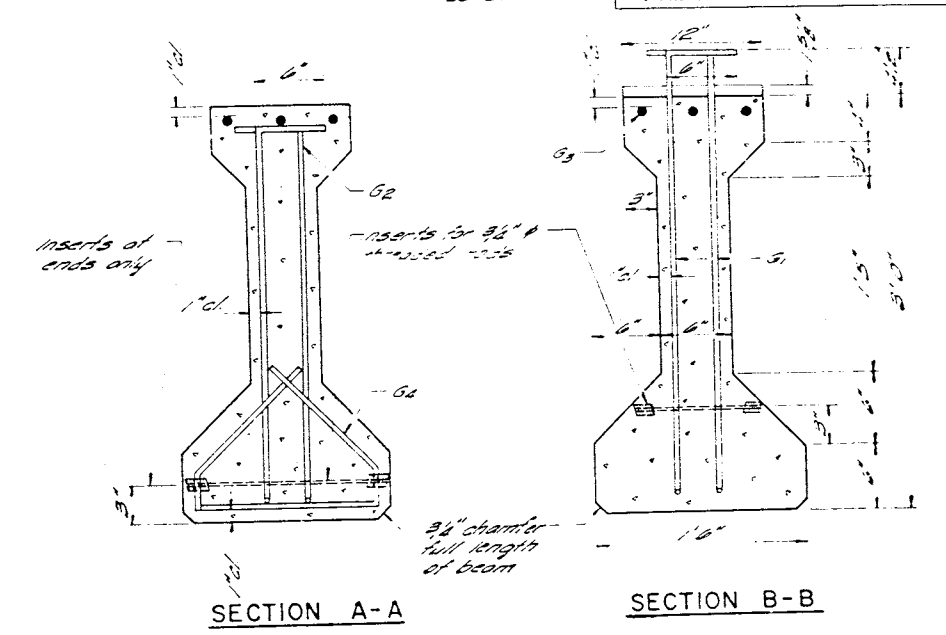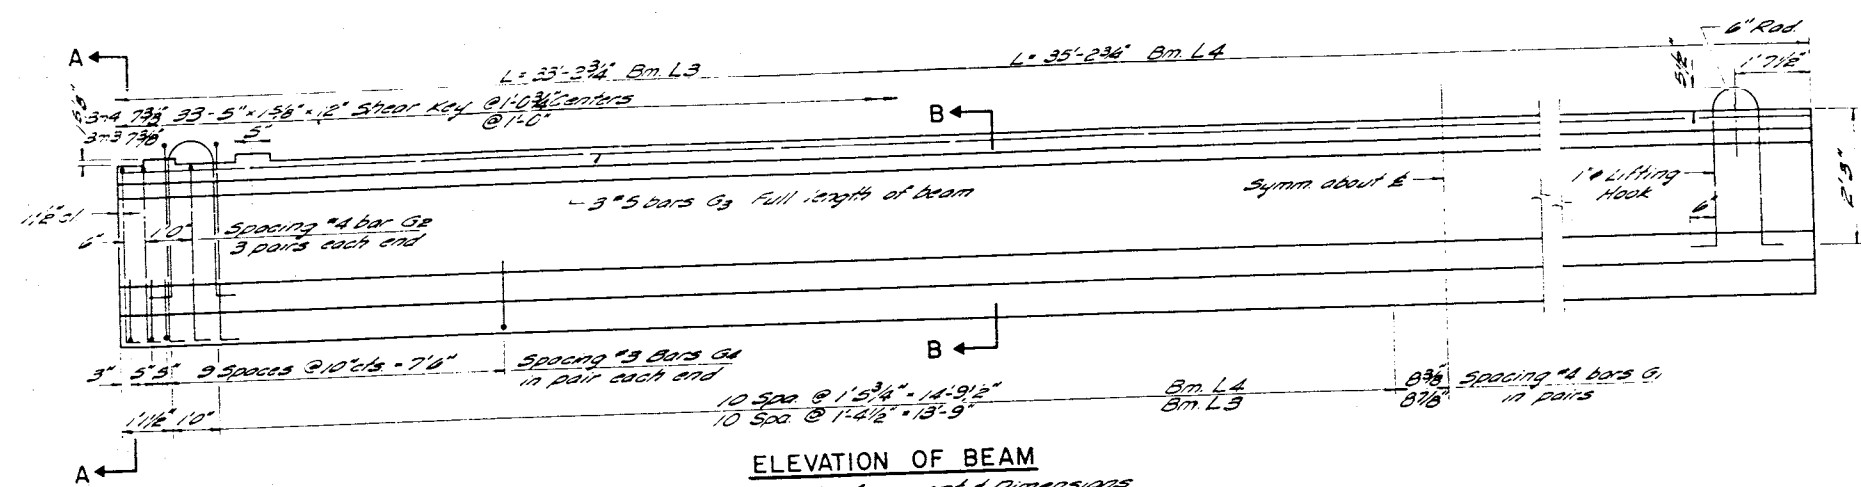

Beam L3: L = 32'-4 3/4" A = 6'-6 3/4" South Span Northbound Roadway
 Beam L4: L = 34'-4 3/4" A = 6'-10 1/8" South Span Southbound Roadway
 Four of each beam required

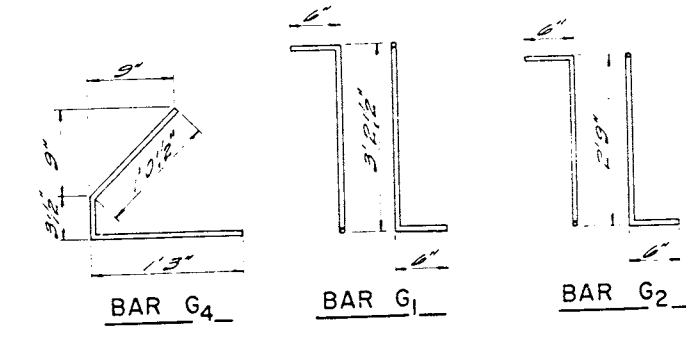

*** BAR LIST**

Beam	ID	Size	Length	Shape
Beam L4	G1	#8	42'6"	TL
	G2	#8	39'	TL
	G3	#5	35'0"	—
	G4	#3	2'7"	L
Beam L3	G1	#8	42'6"	TL
	G2	#8	39'	TL
	G3	#5	32'0"	—
	G4	#3	2'7"	L

BILL OF MATERIAL * For Each Beam

Item	Unit	Total
Furnishing & Erecting Precast Prestressed Concrete I-Beams, 36"	Lin. Ft.	274



NOTES

All inserts and threaded rods for inserts, reinforcing and prestressing steel, and other items which are cast into the precast concrete I-beams shall be included in the contract unit price per linear foot of "Furnishing and Erecting Precast Prestressed Concrete I-Beams, 36 in."
 See Standard Specifications for additional information regarding materials, prestressing equipment, construction and handling methods and other requirements for Precast Prestressed Concrete I-Beams.
 Prestressing steel shall have a nominal diameter of 7/8".
 Inserts for #4 threaded rods are to be two strut, coil type for interior I-beams and single coil, flared loop type for exterior I-beams.
 Steel for lifting hooks shall A.S.T.M., A306, Grade 70-80.
 An alternate strand pattern using Extra High Strength Prestressing strand (270 ksi) is permitted. See Special Provisions.


**SOUTH APPR. SPANS
 PRESTRESSED I-BM. DETAILS**
 F.A.I. ROUTE 55 SEC. 57-10HB
 MC LEAN COUNTY
 STATION 753+54.41

BEAM #	LOCATION	LENGTH	A	B	C
L1	North Bound N. Abutment	28'-1 3/8"	1'-5 3/4"	1'-3 3/4"	1'-2 1/8"
L2	South Bound N. Abutment	29'-0 1/8"	2'-1 5/8"	1'-2 1/4"	1'-5 3/4"
L3	North Bound S. Abutment	33'-2 3/4"	1'-10 7/8"	1'-5"	1'-2 7/8"
L4	South Bound S. Abutment	35'-2 3/4"	1'-11 1/2"	1'-5 3/4"	1'-3 3/8"


Note: Beams are set parallel to the chord of the line designated as profile grade line (44'-0" from the E Median.)

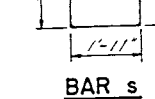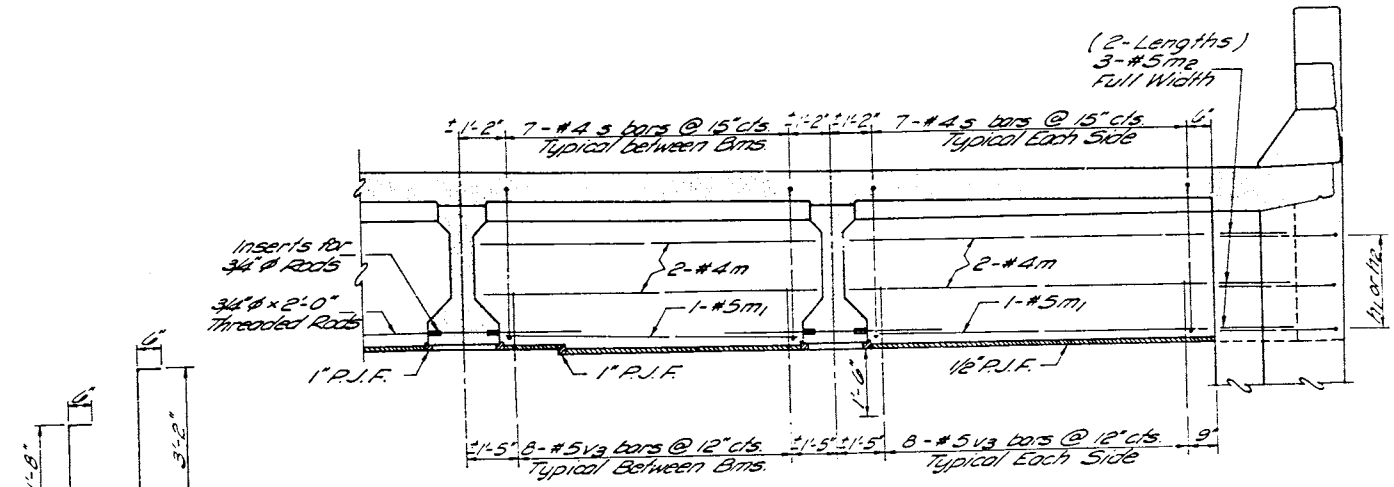


BAR s

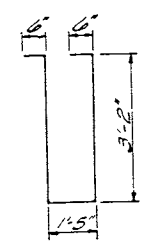


BAR s1

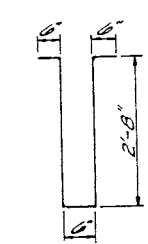


BAR s2

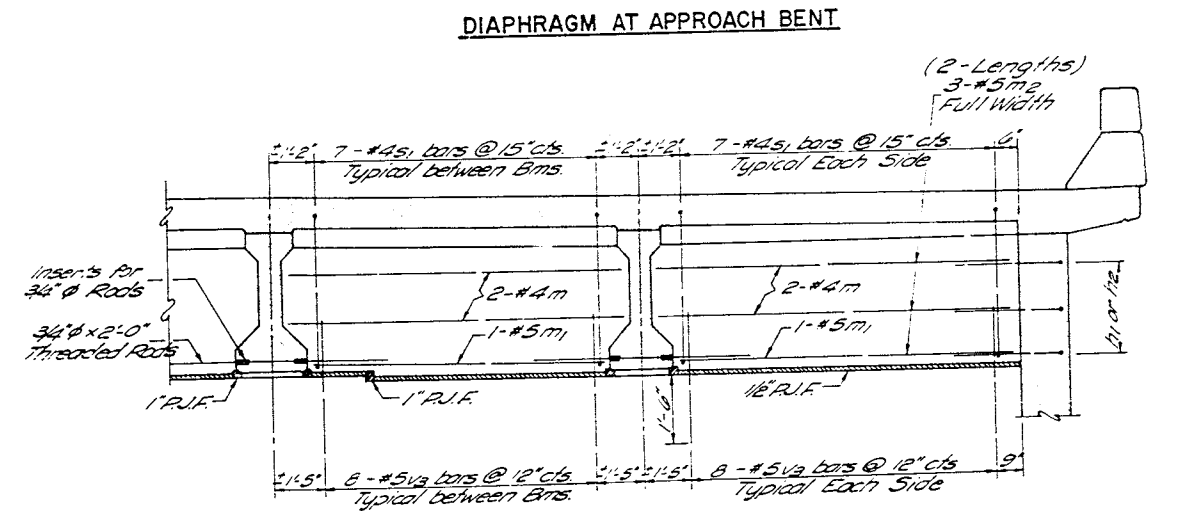

DIAPHRAGM AT ABUTMENT

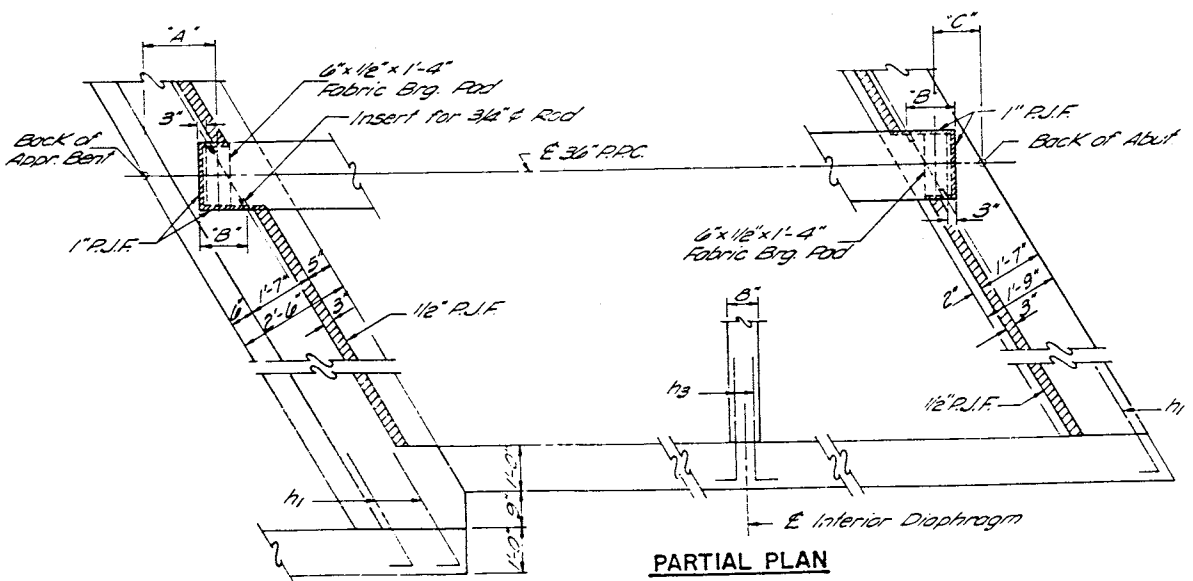


PARTIAL PLAN

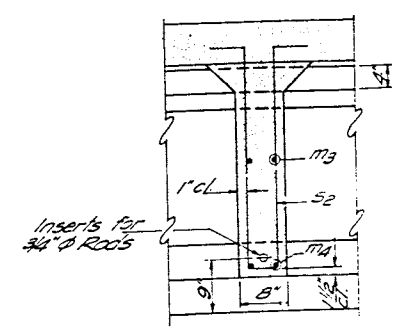


SECTION THRU INTERIOR DIAPHRAGM

Notes:
 Bars s thru s2 and m thru m3 are billed with Approach Slab Bill of Material on Sheets # 6 thru 9
 Bars m1, m2, m3 & v3 are billed with Abutment Bill of Material on Sheet # 19 thru 22
 See Sheets # 6 thru 9 for sections thru abutment and approach bent diaphragms.

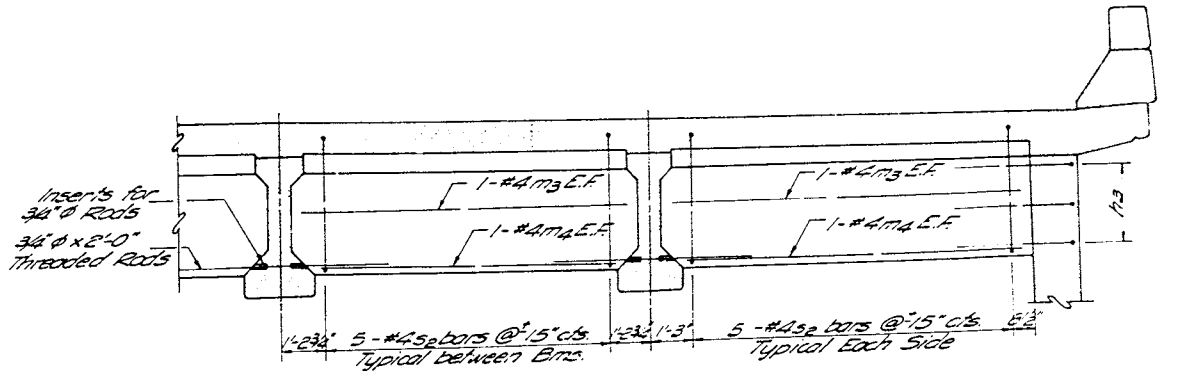


INTERIOR DIAPHRAGM


PRESTRESSED I-BEAM
 DIAPHRAGM & BEARING DETAILS
 FAI ROUTE 55 SEC. 57-10HB
 MC LEAN COUNTY
 STATION 753+54.41

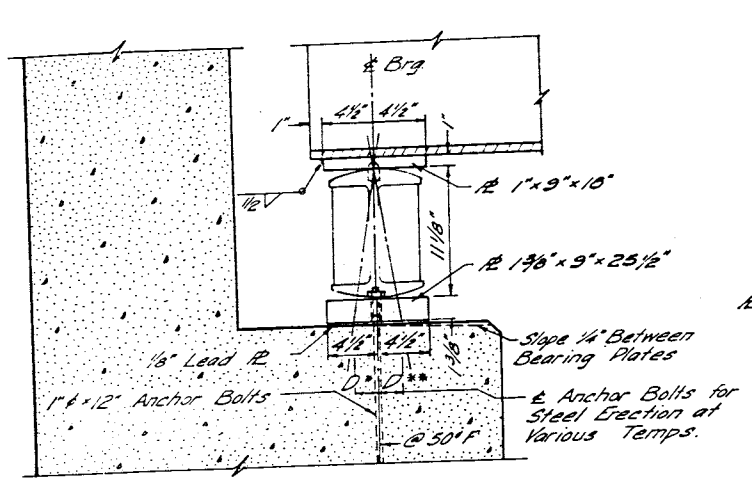


ELEVATION

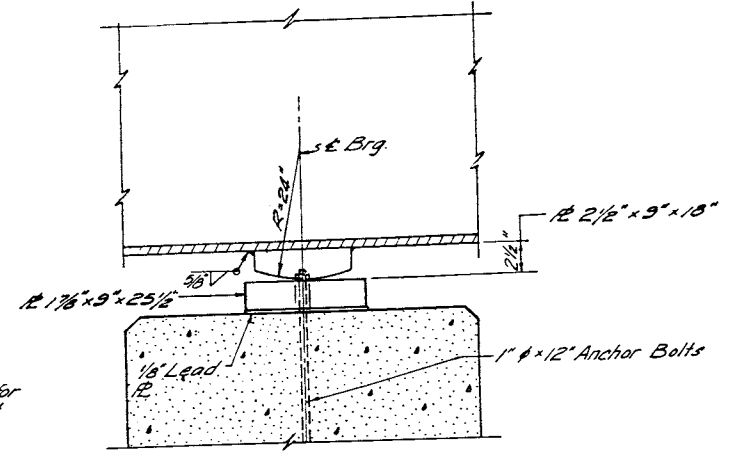

ELEVATION

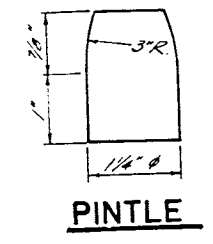


PINTLE

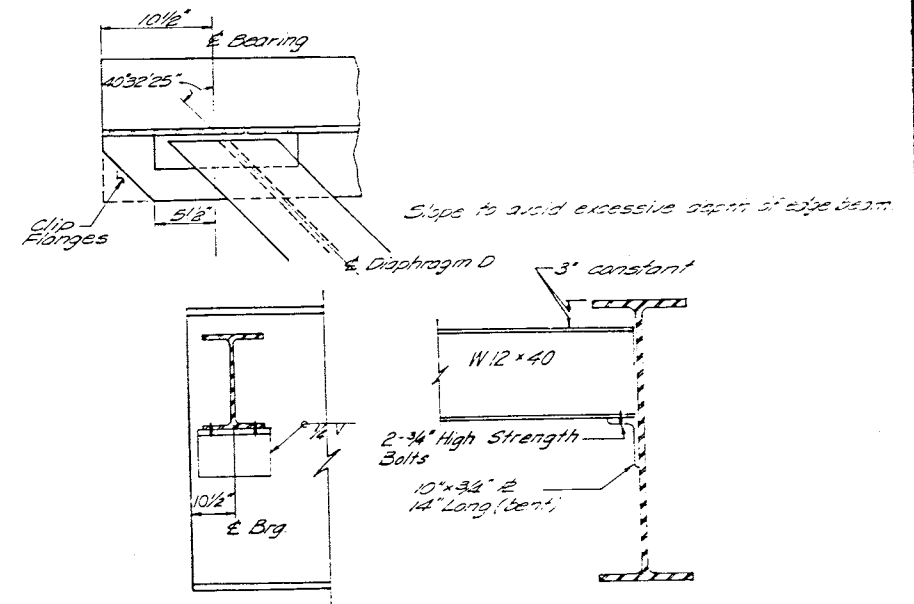


DIAPHRAGM D


20 Required
 Lengths vary See Sheet 14

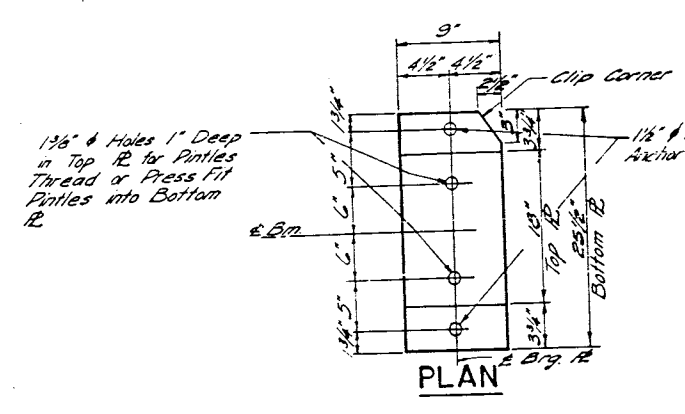


PLAN

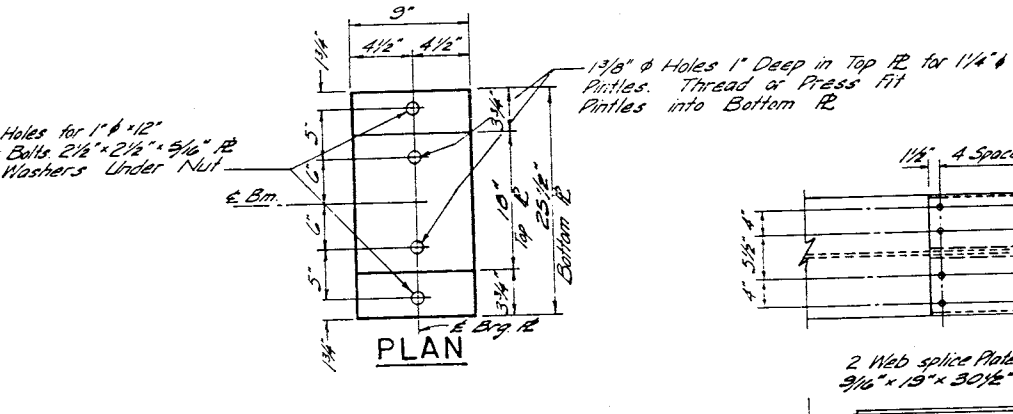

PLAN

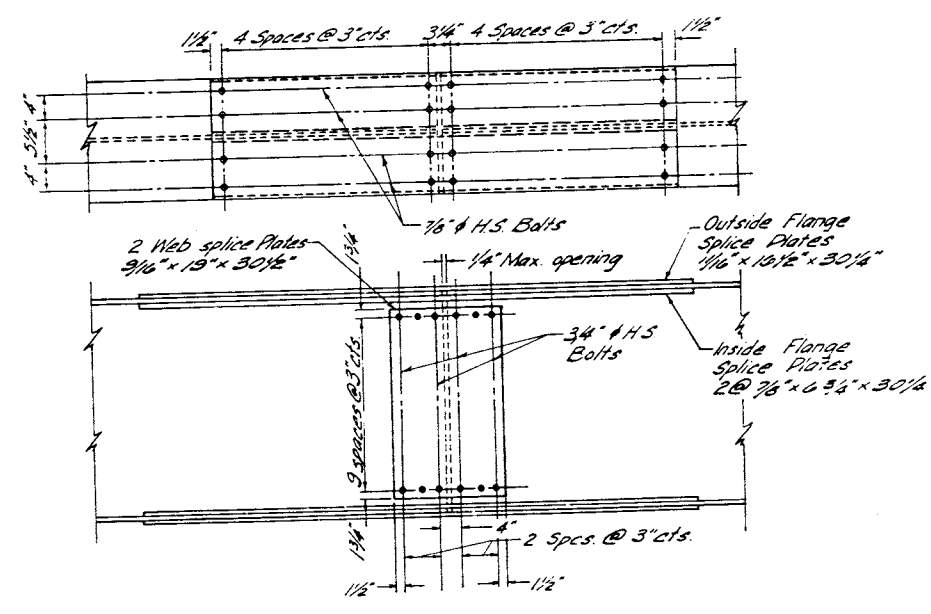


SPLICE DETAIL

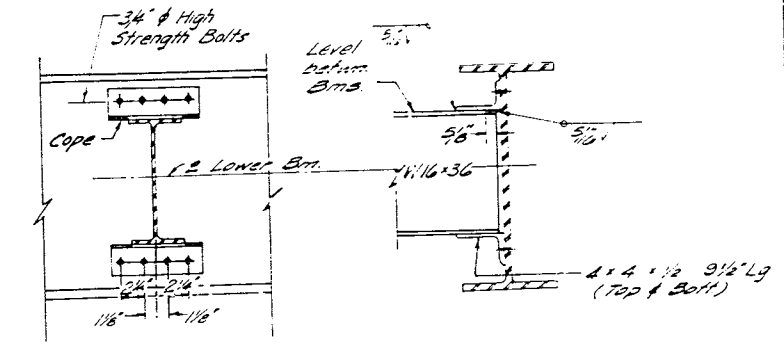

DIAPHRAGM D1

70 Required

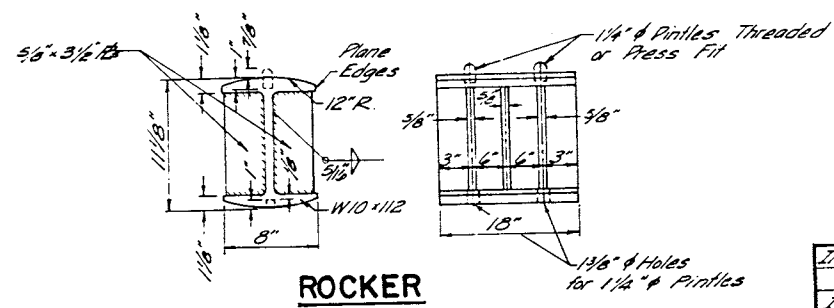

ROCKER

INT BEAM MOMENT TABLE

	Abut	Pier
I_s (in ⁴)	14398.4	14398.4
S_x (in ³)	835.5	835.5
DL (K/ft)	1.39	1.39
MDL (1-K)	532.1	343.0
MCL (1-K)	548.4	308.7
MMP (1-K)	130.2	77.8
M Total (1-K)	1216.7	1329.5
$\frac{1}{8}$ Total (K)	17.5	18.6


INT BEAM REACTION TABLE

	Abut	Pier
ROL (K)	35.4	128.0
RLL (K)	39.8	45.7
IMP (K)	10.0	11.5
R Total (K)	85.2	185.2

NOTES FOR SETTING OF ANCHOR BOLTS AT EXPANSION BEARINGS:

- D^* (Side of brg away from fixed brg)
 $D^* = .16"$ per each 100' of Expansion for every 15° fall below the normal temp. of 50°F
 D^{**} (Side of brg toward fixed brg)
 $D^{**} = .16"$ per each 100' of Expansion for every 15° rise above the normal temp. of 50°F
- After beams have been erected and dimensions D^* & D^{**} determined, holes shall be drilled and anchor bolts shall be grouted in place. All fixed anchor bolts may be built into the masonry.


STEEL BEAM DETAILS
 FAI ROUTE 55 SEC. 57-10HB
 MCLEAN COUNTY
 STA. 753+54.41

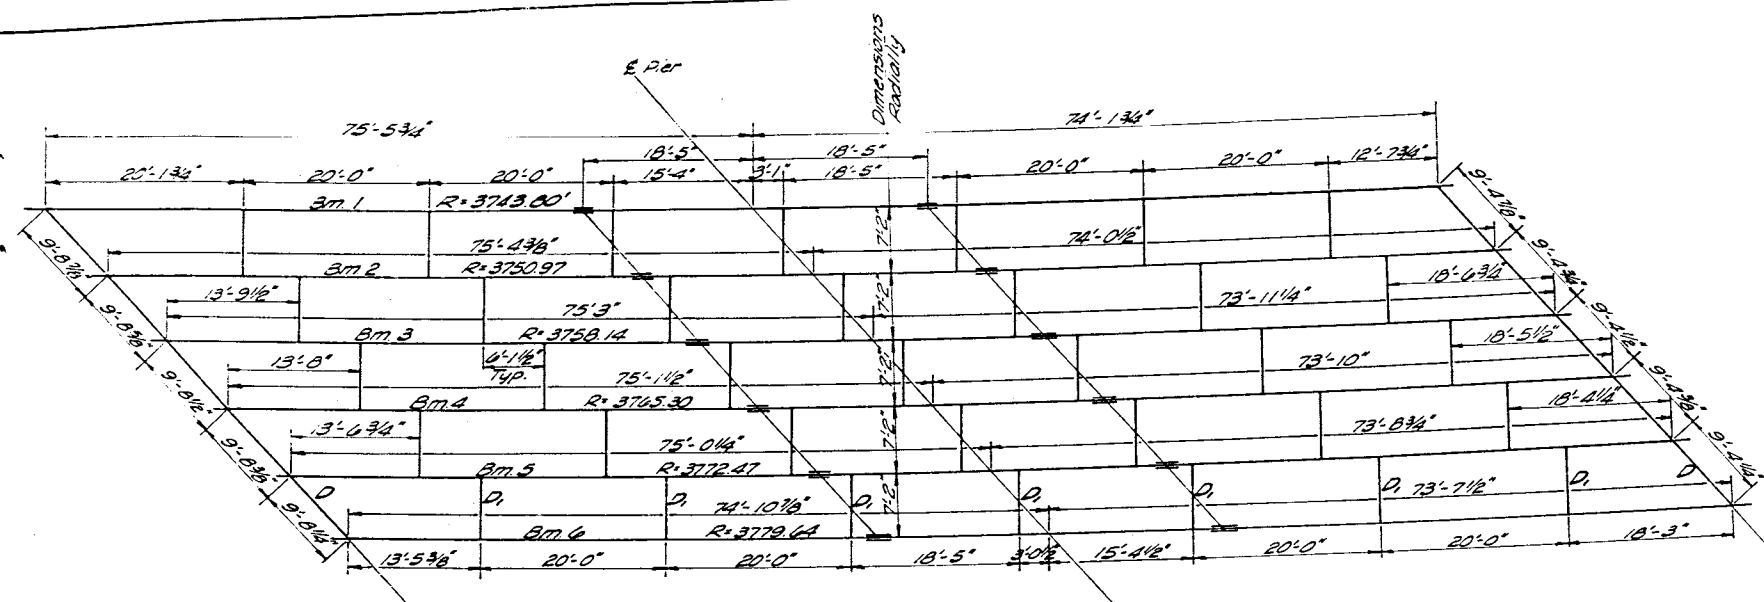

TOP OF BEAM ELEVATIONS


	BEAM NO.	SOUTH ABUT.	SPLICE #1	PIER	SPLICE #2	NORTH ABUT.
SOUTHBOUND	1	714.895	714.945	714.955	714.965	715.015
	2	715.215	715.255	715.265	715.275	715.315
	3	715.525	715.555	715.565	715.575	715.615
	4	715.835	715.855	715.865	715.875	715.915
	5	716.145	716.165	716.175	716.185	716.215
	6	716.455	716.465	716.475	716.485	716.505
NORTHBOUND	7	716.185	716.155	716.145	716.135	716.105
	8	716.485	716.450	716.435	716.420	716.405
	9	716.795	716.745	716.735	716.725	716.695
	10	717.095	717.040	717.025	717.010	716.965
	11	717.395	717.340	717.325	717.310	717.275
	12	717.695	717.645	717.625	717.605	717.515

Note: All Diaphragms except end diaphragms are to be radial. Space interior bays diaphragms as Exterior Bays diaphragms unless otherwise indicated.

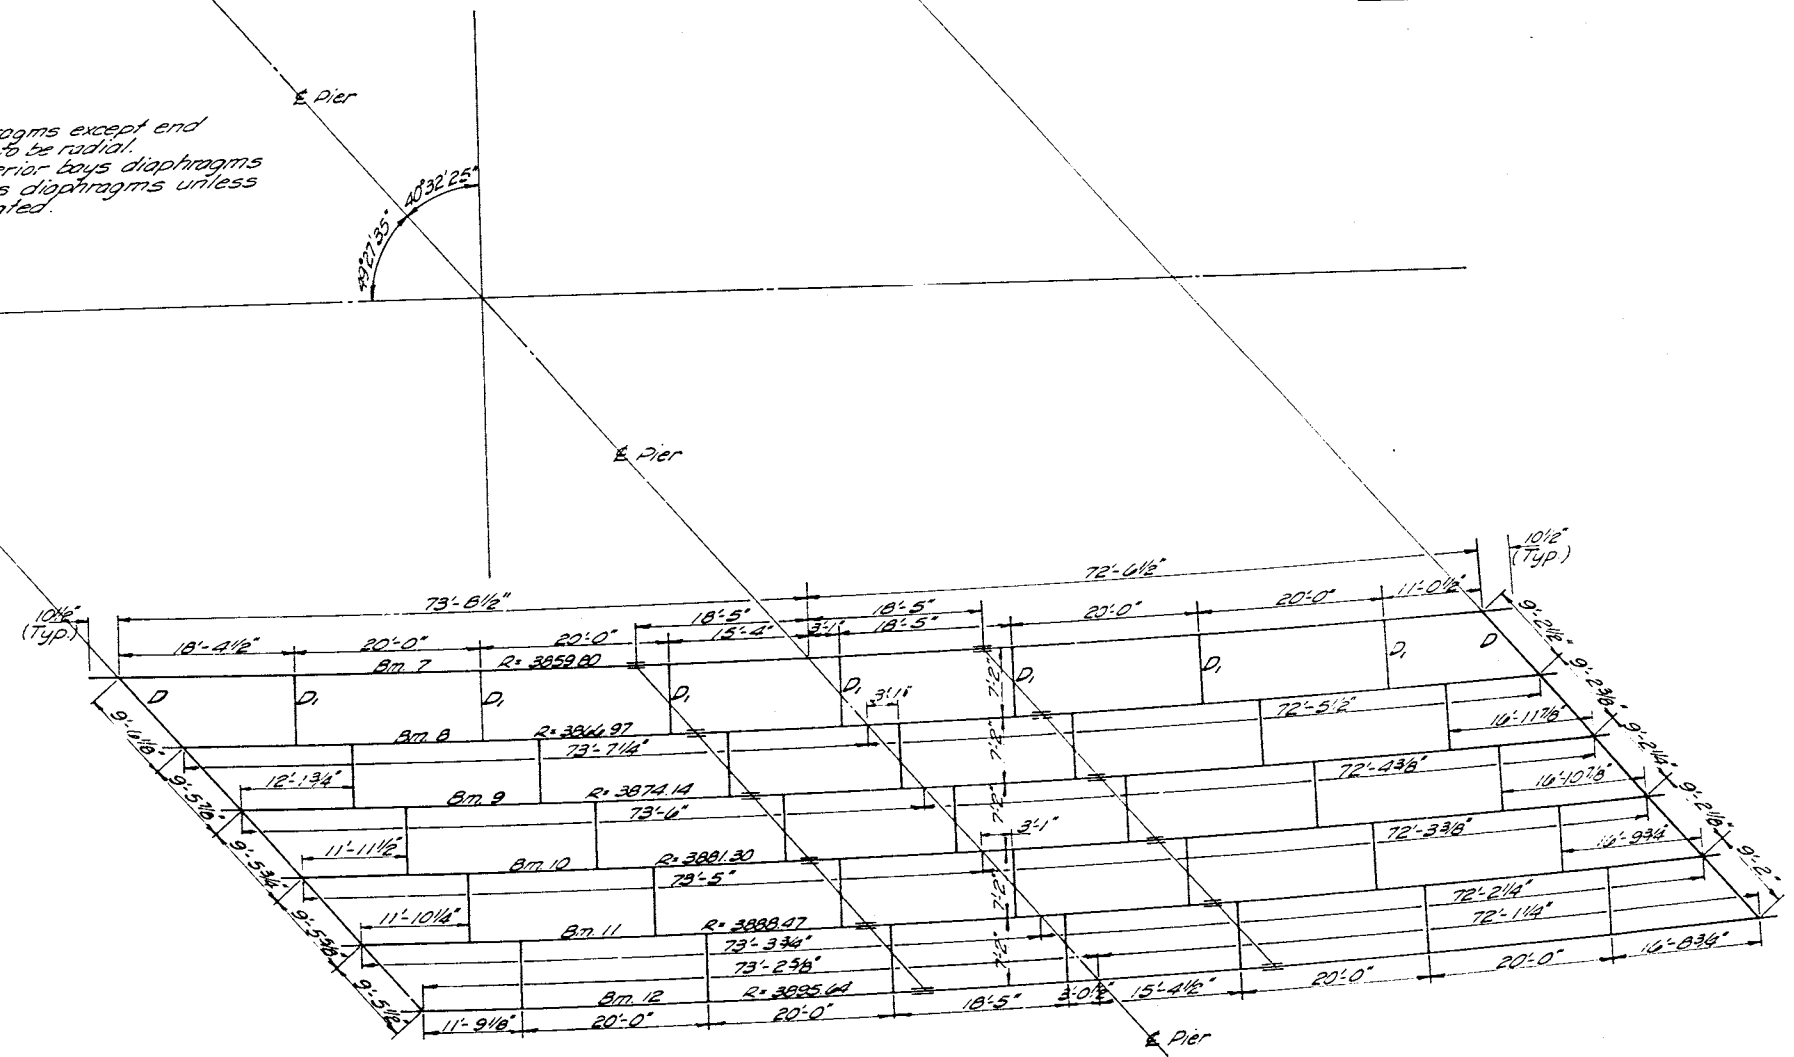


STRUCTURAL STEEL LAYOUT
 ALL BEAMS W36 x 230


BEAM LAYOUT
 FAI ROUTE 55 SEC. 57-10H3
 MC LEAN COUNTY
 STATION 753+54.41

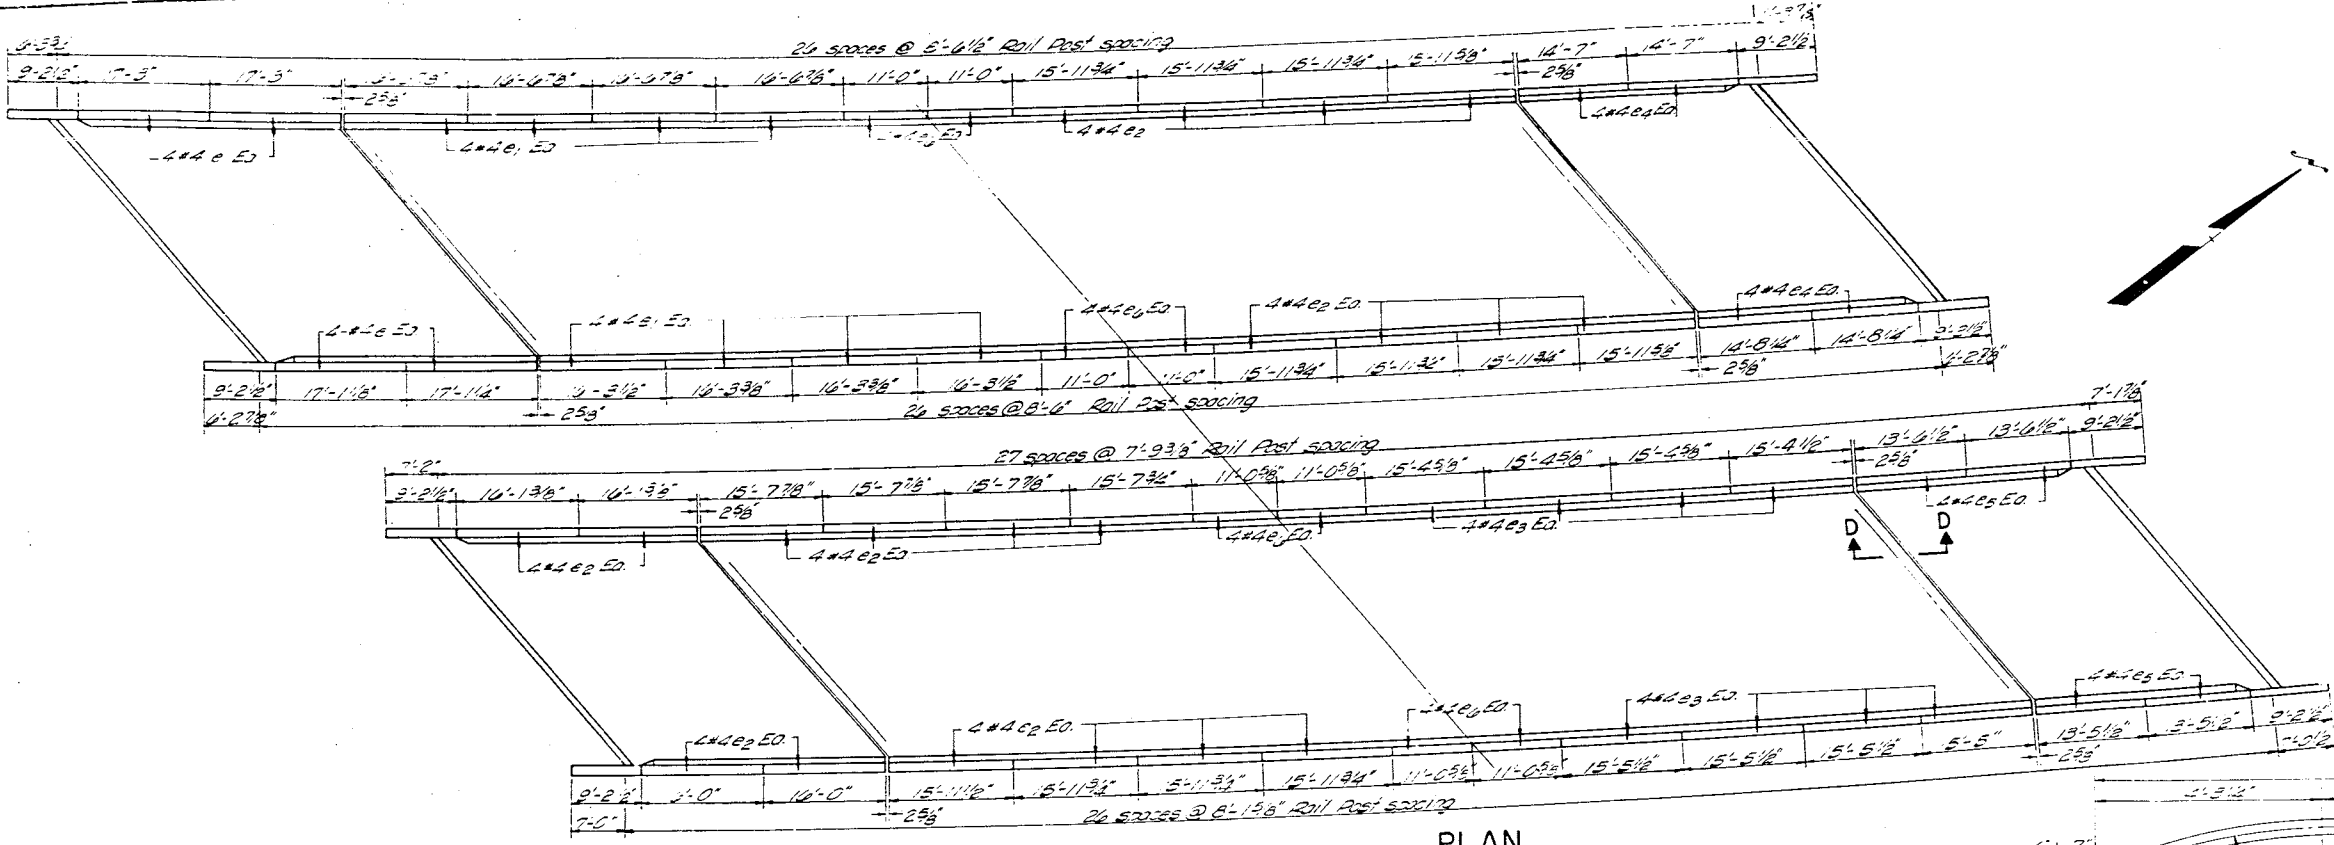


PLAN

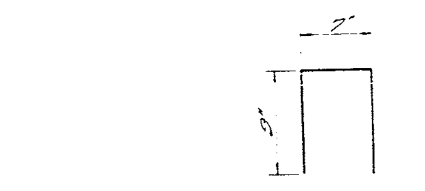

BAR d2

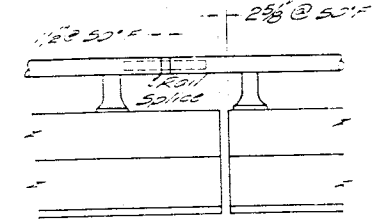


VIEW D-D

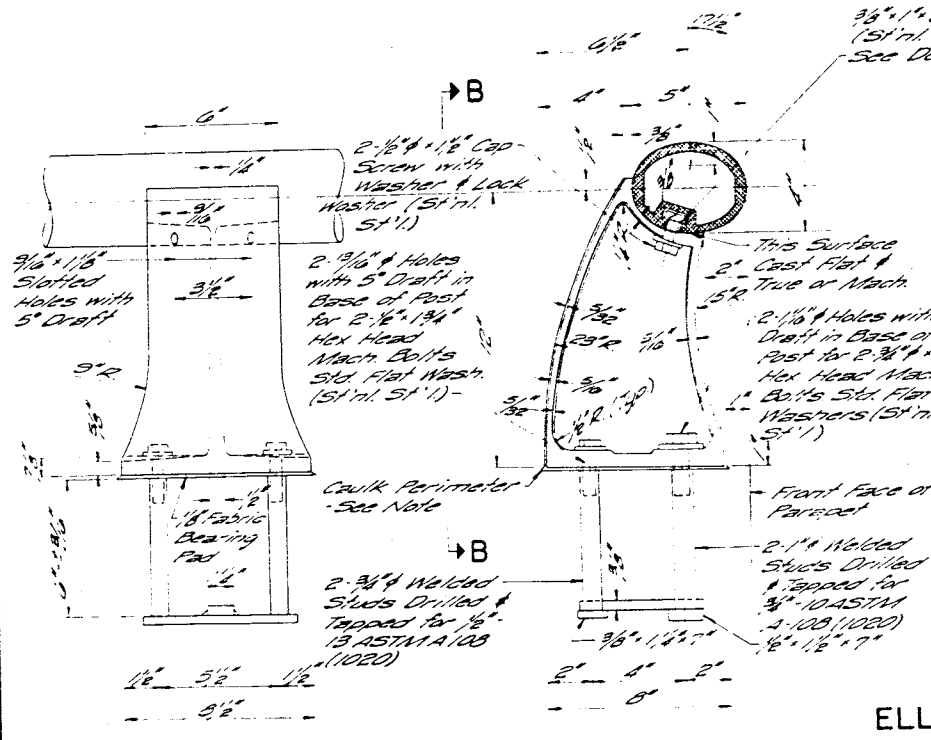


VIEW B-B

RAIL POST

SECTION A-A

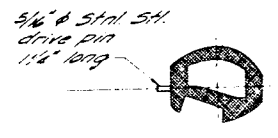


RAIL SPLICE

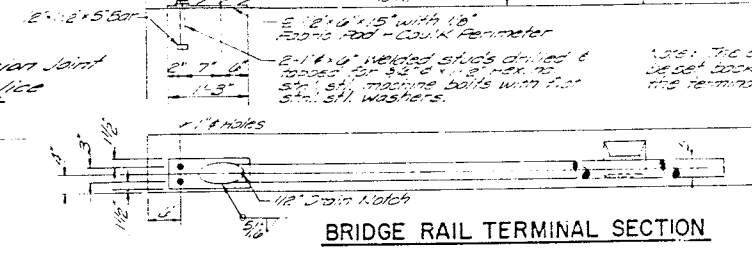


BRIDGE RAIL TERMINAL SECTION


SECTION THRU ELLIPTICAL RAIL SECTION

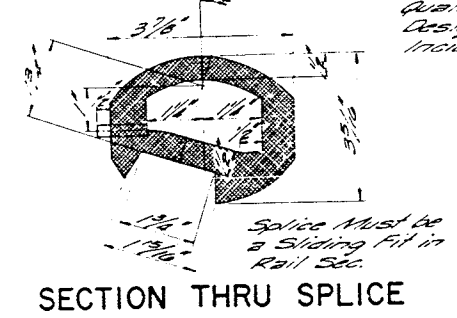

SECTION THRU SPLICE

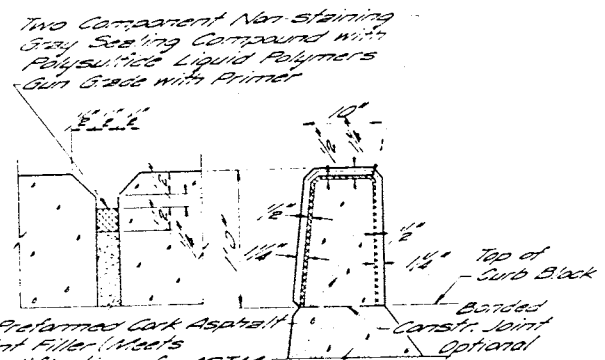

PARAPET JOINT

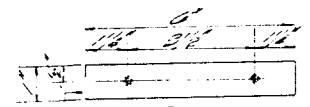

CLAMP BAR




BILL OF MATERIAL

BAR NO.	SIZE	LENGTH	SHAPE
1	1 1/2"	10'-3"	
2	3/4"	10'-3"	
3	3/4"	10'-3"	
Concrete C.Y. 25.5
 Reinforcement Bars Lbs. 25.5
 Aluminum Railing L.F. 5.5

PARAPET & ALUMINUM RAILING
 FAI ROUTE 55 SECTION 57-10HB
 MC LEAN COUNTY
 STATION 753+54.41

13'-0":
 All posts shall be normal to parapet.
 All Aluminum Alloy Extruded Rail shall conform to ASTM Specification B221 alloy 6061-T6 or 6061-T5 and shall be supplied in lengths of 30 feet, except at the ends of bridge or at end joints in bridge deck where the rail shall be attached to a minimum of 2 posts. If the rail is on a horizontal curve of 2500 foot radius or less, the maximum spans may be reduced but shall be attached to a minimum of 2 posts. All joints in rail shall be soldered per detail.
 Provide 1-1/8" and 2-1/8" aluminum shims 13'-25.5' of the posts.
 Rail element shall be parallel to grade-top soot shall be ground and low soot shims.
 Seal perimeter of base of post to parapet with two component non-staining gray sealing compound with polysulfide liquid polymers, gun grade with primer. Fabric Bearing Pad shall have same dimensions as base of post.
 Aluminum alloy shall have minimum yielding strength 35 ksi, minimum tensile strength 38 ksi, and elongation of 10% in 2 inches.

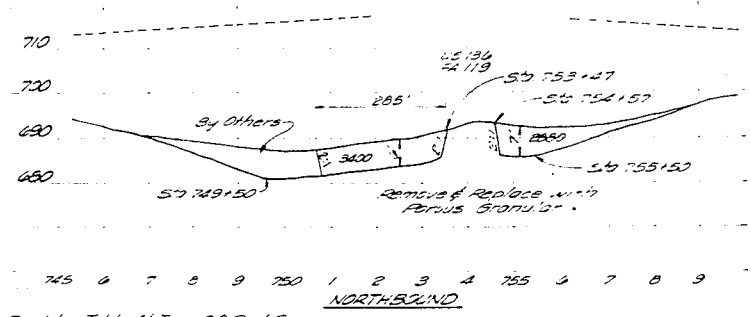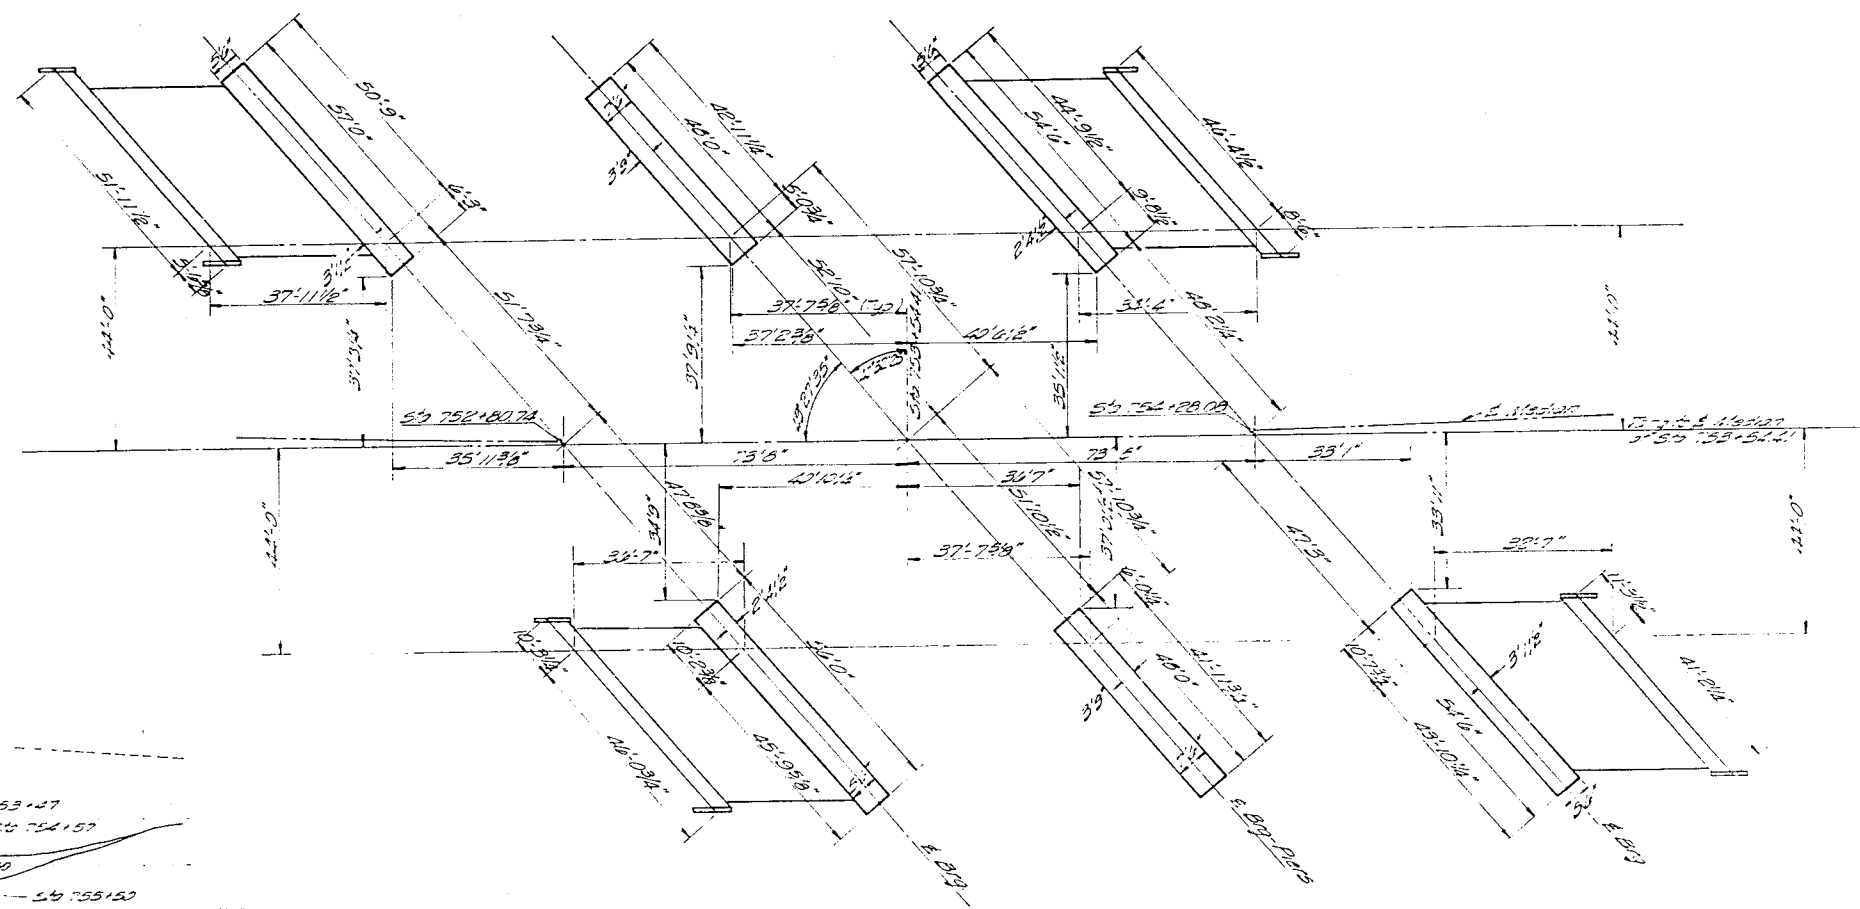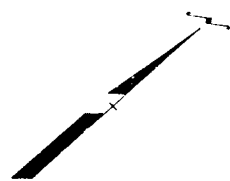


* Water Table At Time Of Soil Survey
 * Place Pervious Granular Material To 2' Above The Water Table At Time Of Construction

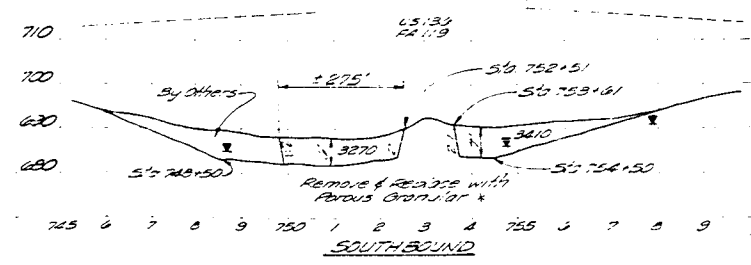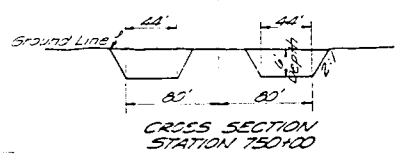

FOOTING LAYOUT
 FAI ROUTE 55 SEC. 57-10HB
 MC LEAN COUNTY
 STATION 753+54.41


NOTES

Space reinforcement in cap to miss anchor bolts.
All edges shall have standard chamfers except as noted.
Pour steps monolithically with cap.

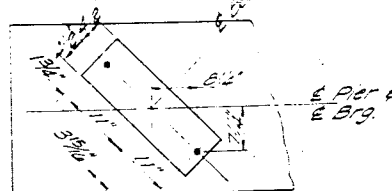

BEARING PLATE LAYOUT


Dimensions typical for setting all anchor bolts for Southbound Pier

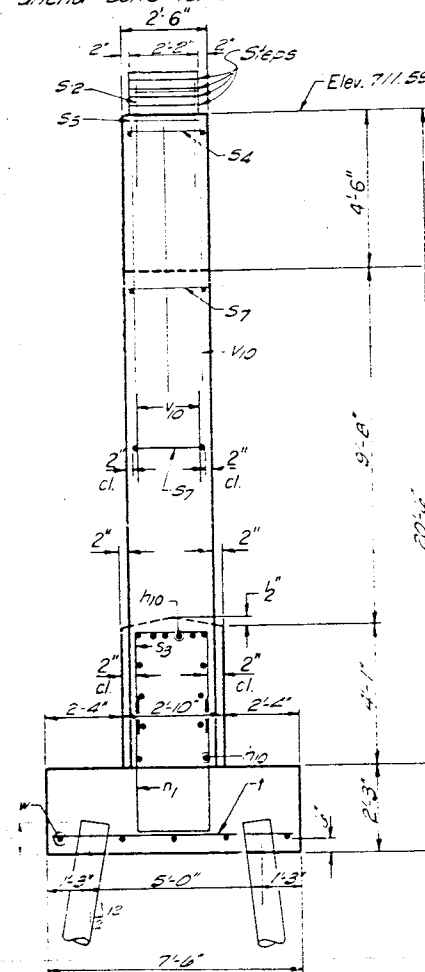


END VIEW

PILE DATA

Type - Concrete
Capacity 29 Tons
Est. Length 48'-0"
No. Required 22 (Including 1 test pile)

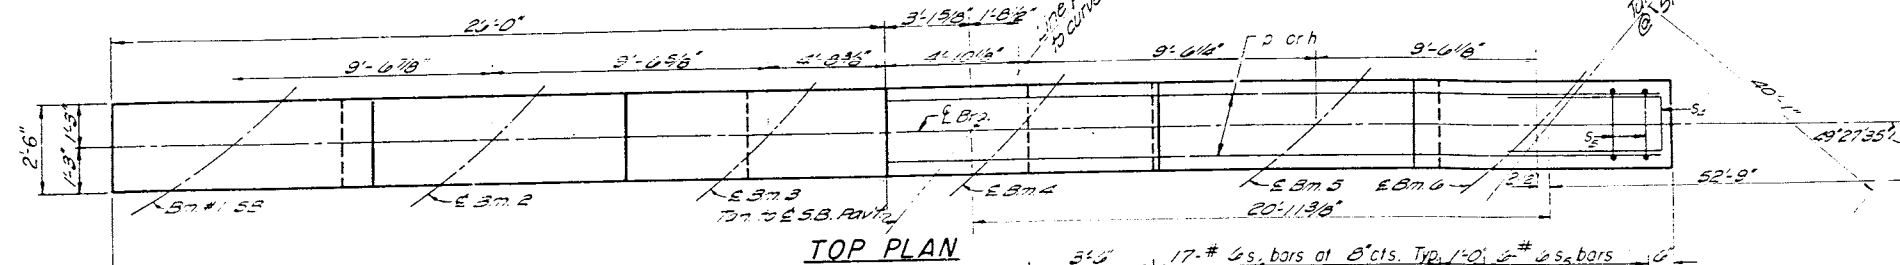


TOP PLAN

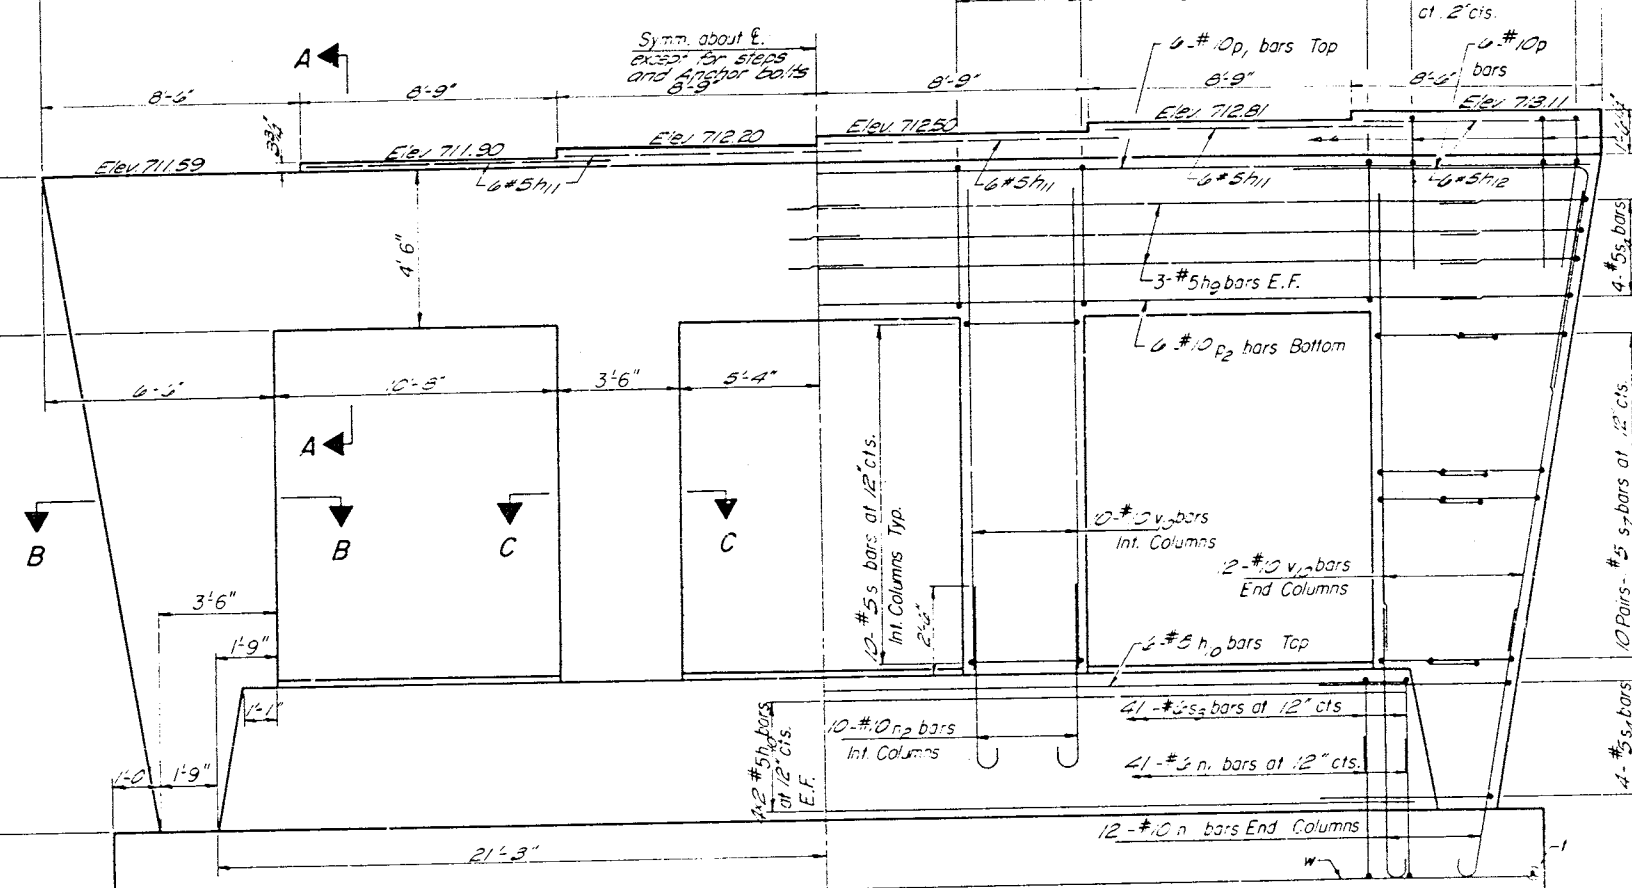

DIMENSIONS

ELEVATION


REINFORCEMENT

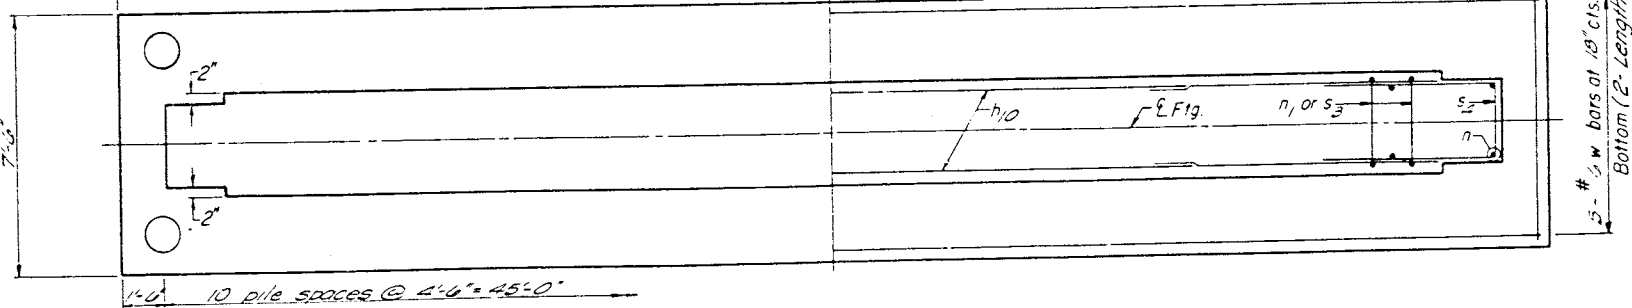


PILE LAYOUT & DIMENSIONS

FOOTING PLAN


REINFORCEMENT

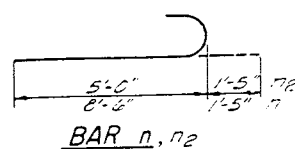


BAR n, n2

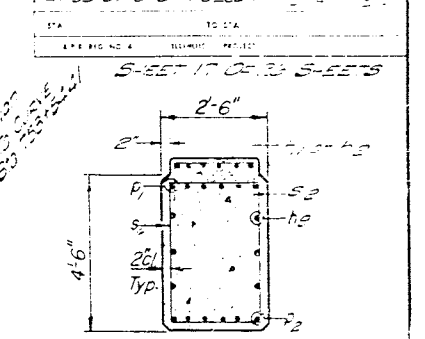

SECTION A-A

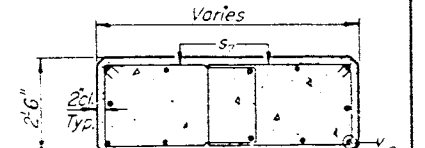

SECTION B-B

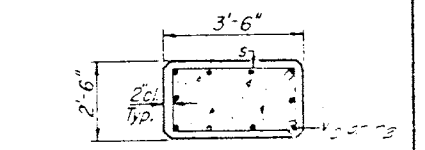

SECTION C-C

BILL OF MATERIAL

Bar	No.	Size	Length	Splice
s2	17	#5	3'-0"	
s1	20	#5	3'-0"	
s4	2	#5	3'-0"	
s3	2	#5	3'-0"	
n1	2	#5	3'-0"	
n2	2	#5	3'-0"	
n	21	#5	3'-0"	
p	12	#5	3'-0"	7
p1	5	#5	3'-0"	
p2	5	#5	3'-0"	
s	20	#5	3'-0"	
s2	2	#5	3'-0"	
s1	2	#5	3'-0"	
s4	2	#5	3'-0"	
s3	2	#5	3'-0"	
n1	2	#5	3'-0"	
n2	2	#5	3'-0"	
v.s	22	#5	3'-0"	
w	10	#5	3'-0"	

Class X Concrete Cyls. 5,500
Reinforcement Bars Lbs. 5,500
Concrete Piles 12,250
25' Piles-Concrete 5,500

PIER








SOUTHBOUND STRUCTURE
FAI ROUTE 55 SEC. 57-10HB
MC LEAN COUNTY
STATION 753+54.41

A & B DIMENSIONS

Bar	A	B
n1	2'-6"	3'-9"
s2	2'-6"	3'-9"
s4	2'-0 1/2"	5'-1/2"
s3	2'-0"	4'-0"
s1	1'-0"	1'-0"




ADDED BILL OF MATERIAL

Bar No.	Size	Length	Shape
h3	#5	11'-0"	
V1A	#5	5'-6"	
V2A	#5	13'-0"	
Added Reinf. Bars Lbs. 455			

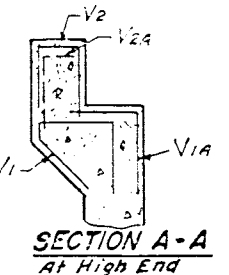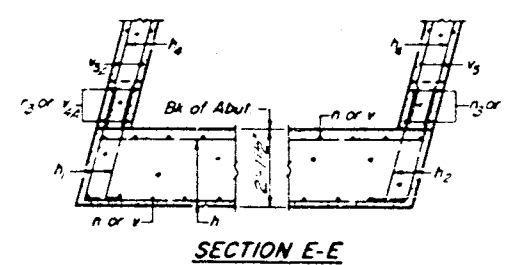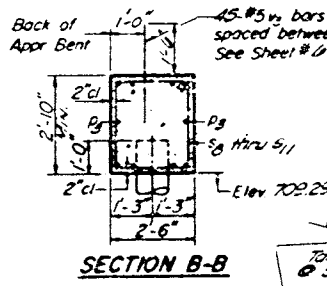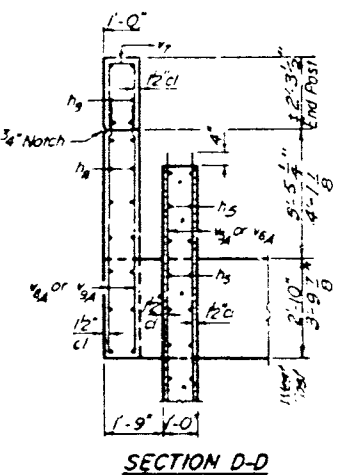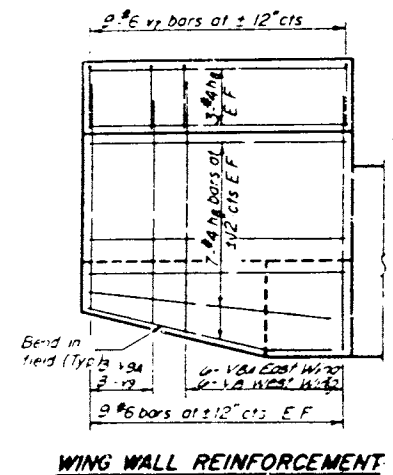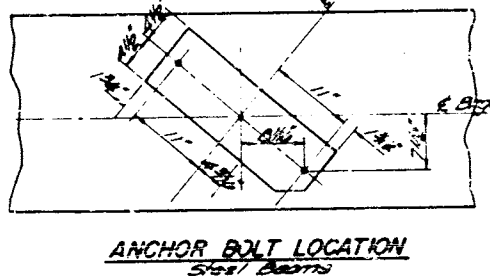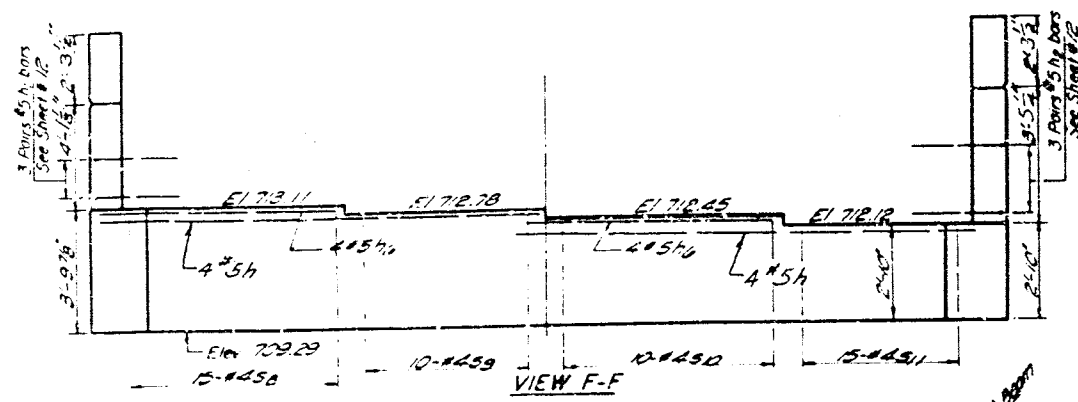

PILE DATA

Type - Concrete
Capacity 29 Tons
Est Length 63 Bent
Number 9 Bent
Est Length 28 Abut
Number 28 Abut
Include 19 24" pile

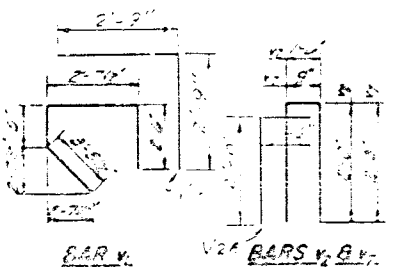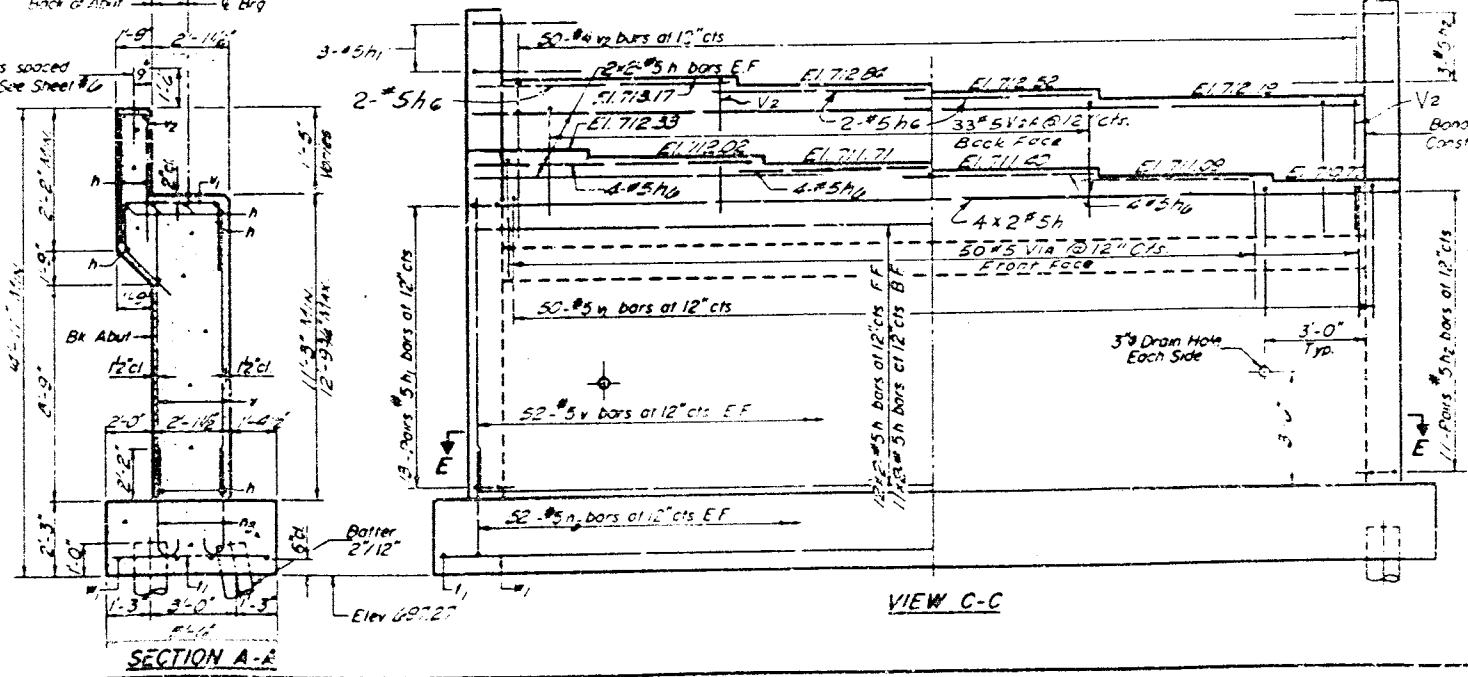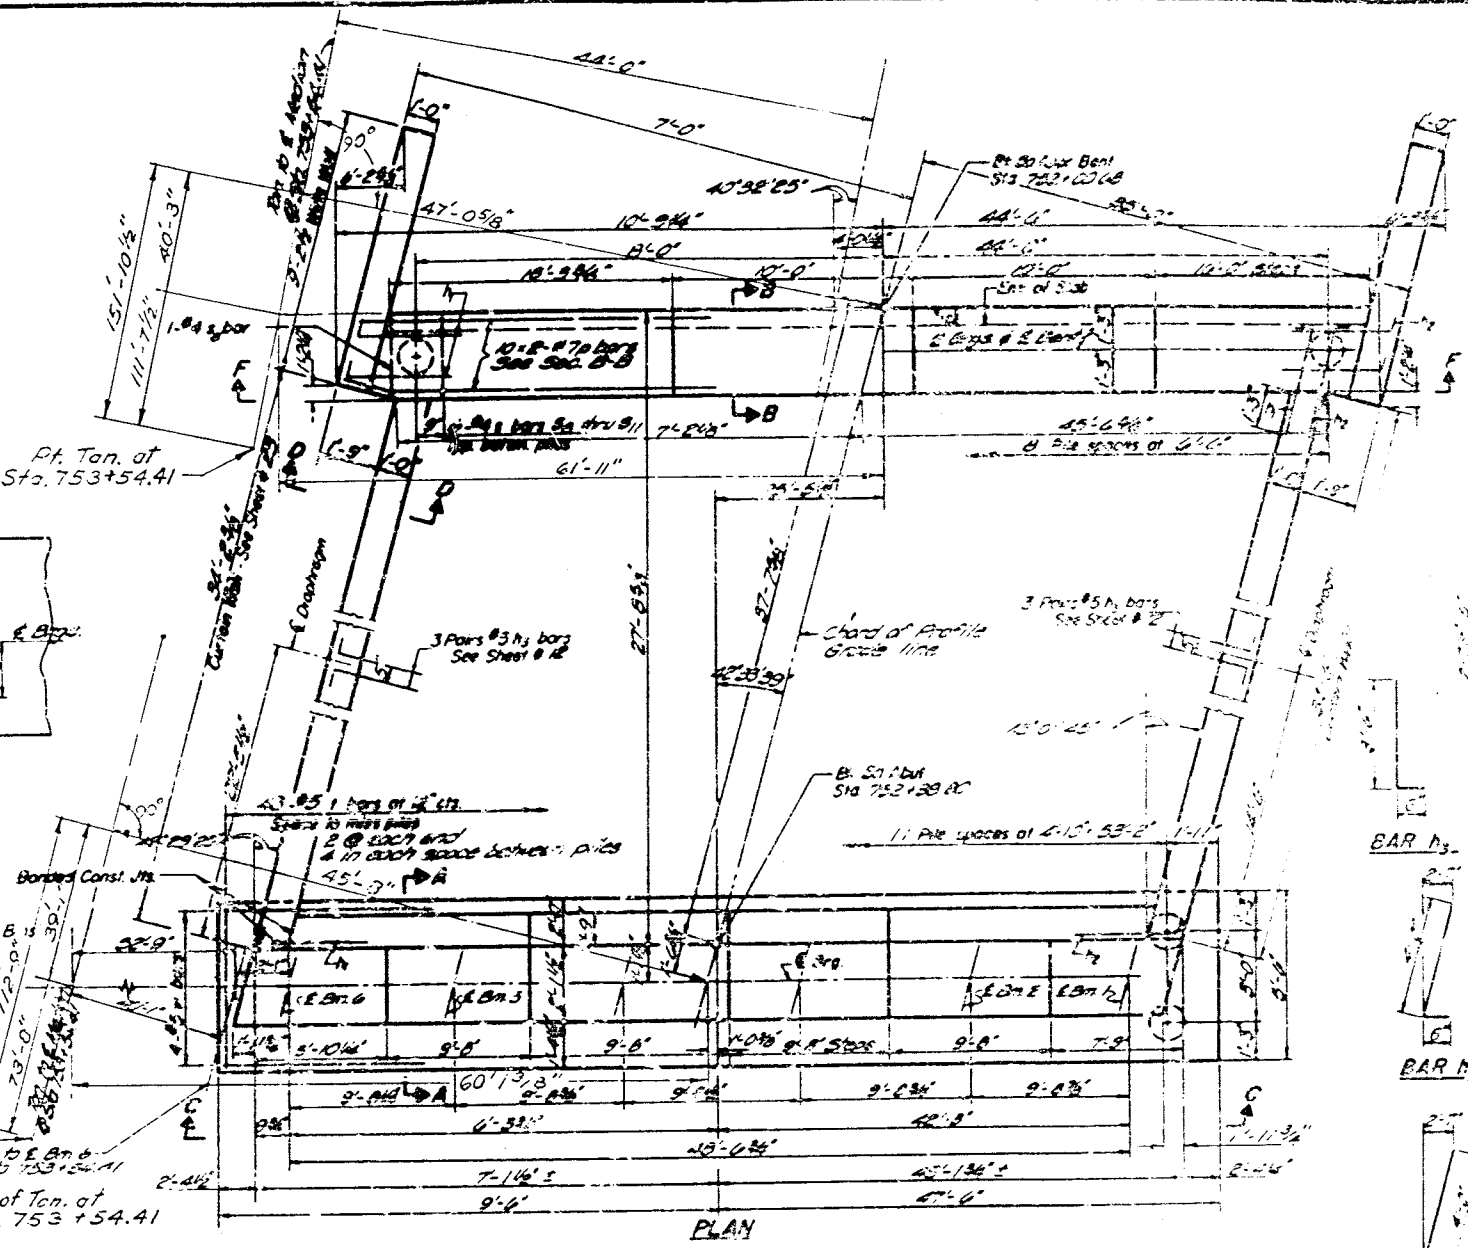






BILL OF MATERIAL

Bar No.	Size	Length	Shape
A1	#5	6'-5"	
A2	#5	4'-6"	
A3	#5	3'-0"	
A4	#5	29'-5"	
A5	#5	35'-0"	
A6	#5	11'-0"	
A7	#5	30'-0"	
A8	#5	9'-0"	
V1A	#5	22'-6"	
V2A	#5	4'-6"	
V3A	#5	7'-8"	
A9	#5	23'-5"	
A10	#5	11'-5"	
A11	#5	10'-9"	
S1	#5	5'-5"	
S2	#5	15'-0"	
S3	#5	15'-0"	
S4	#5	15'-0"	
S100	#5	15'-0"	





Note: h Bars are not to be Placed on Slope

AS REVISED

ABUTMENT & APPROACH BENT
SOUTHBOUND ROADWAY - SOUTH
FAI ROUTE 55 SEC. 57-10HS
MC LEAN COUNTY
STATION 753+54.41

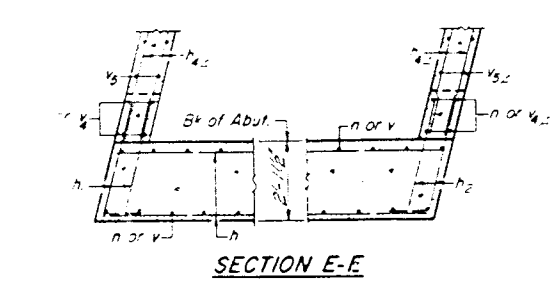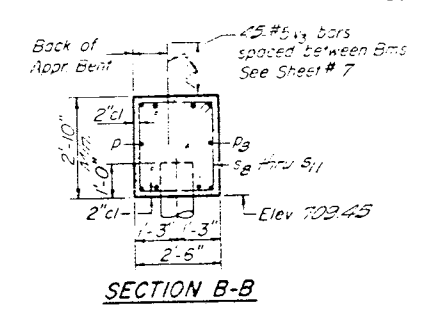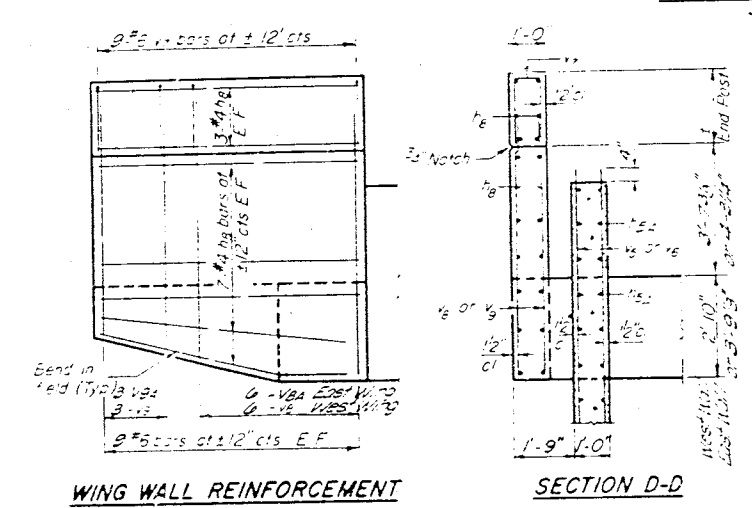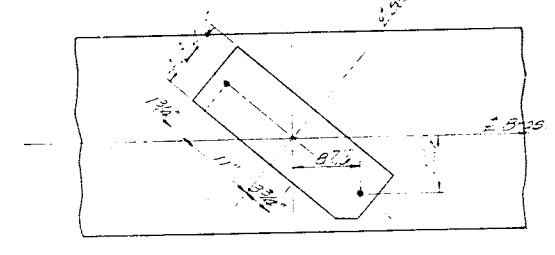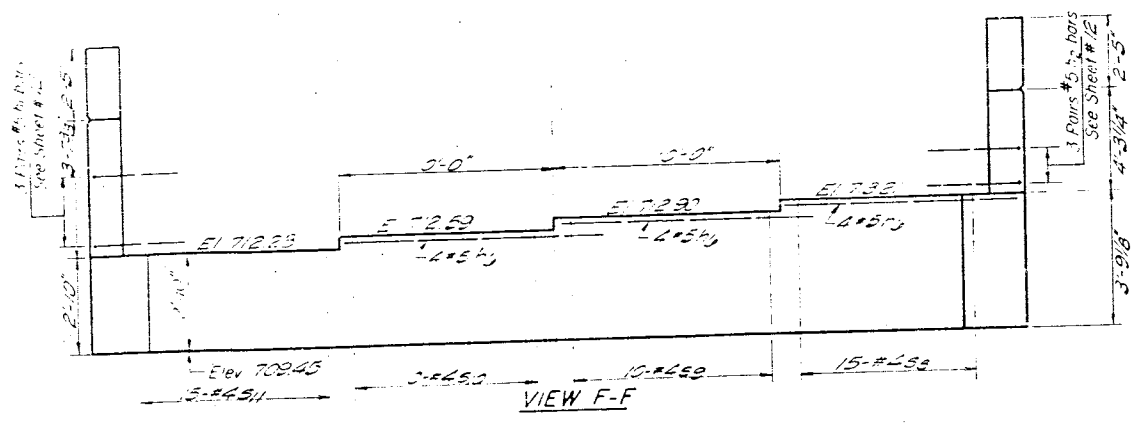






PIPE DATA
 Type - Concrete
 Capacity - 29 Bms
 Est. Length of Bent
 Number of Bent
 Est. Length of Abut.
 Number of Abut.

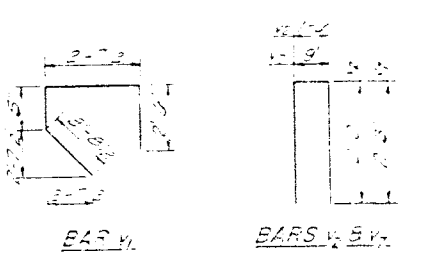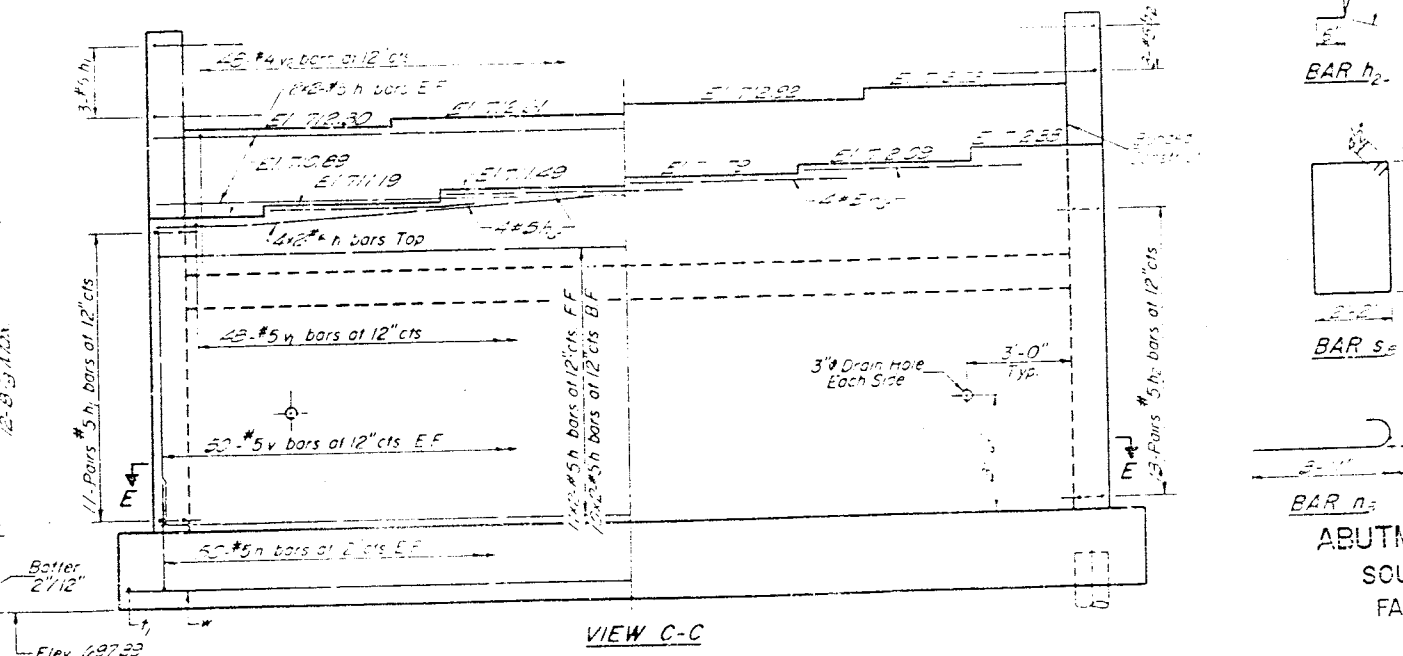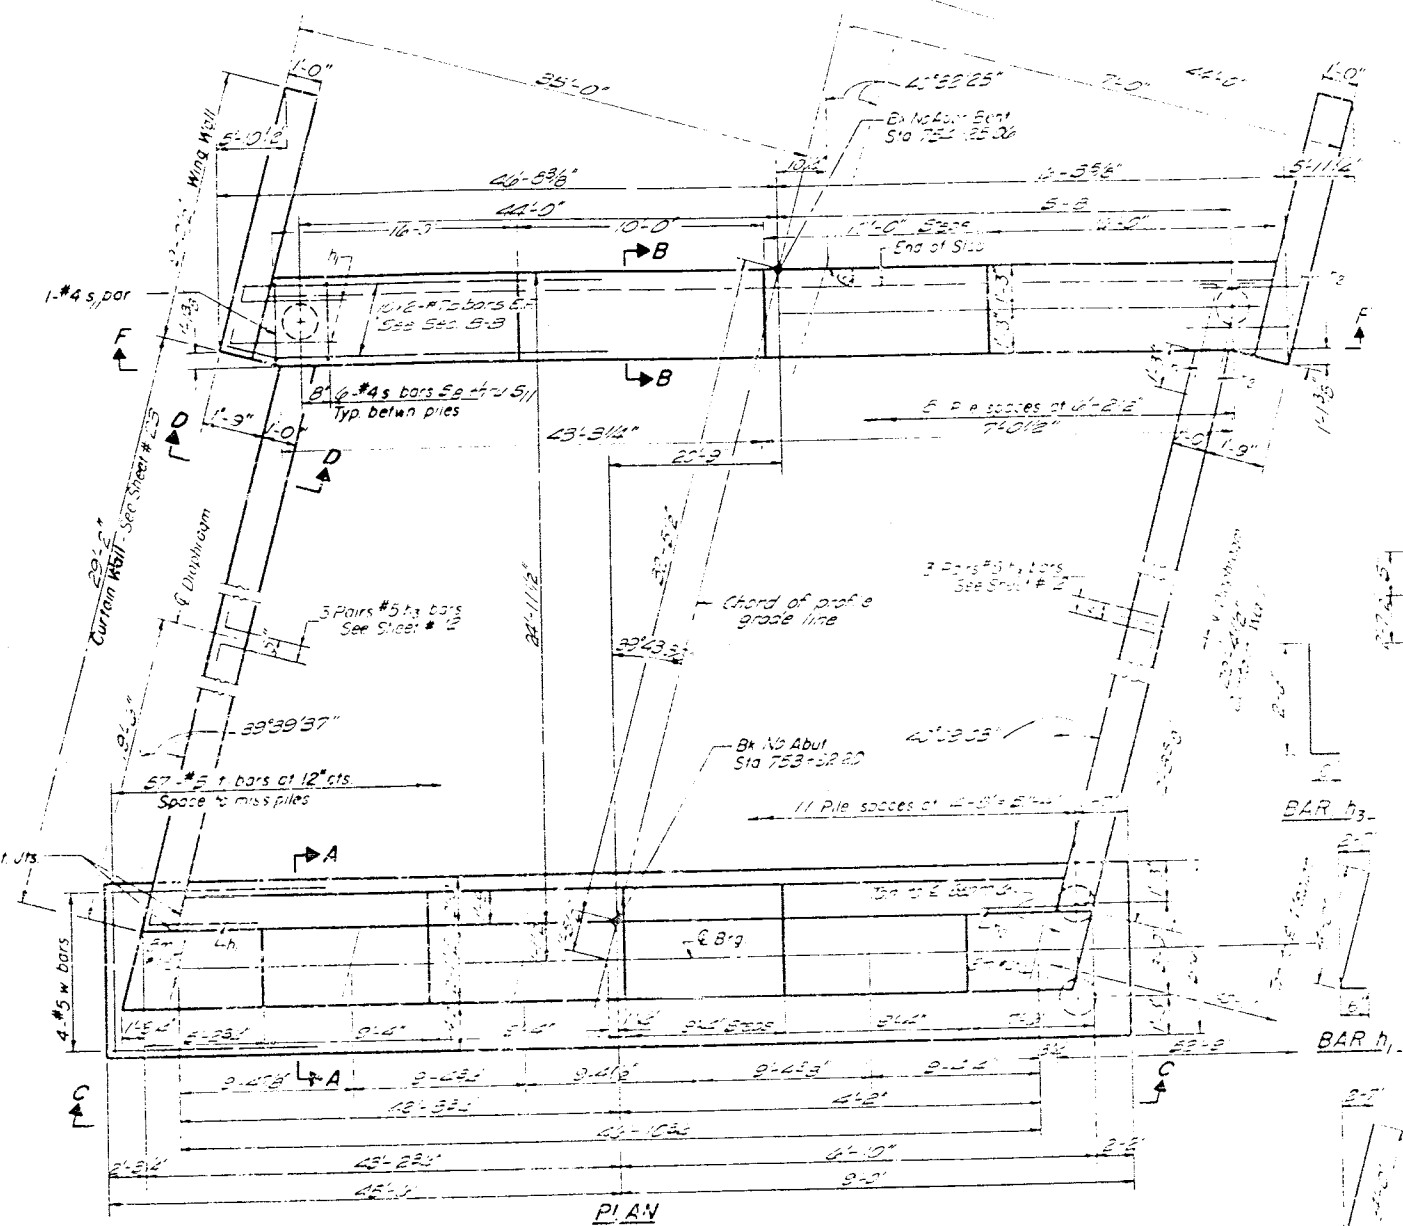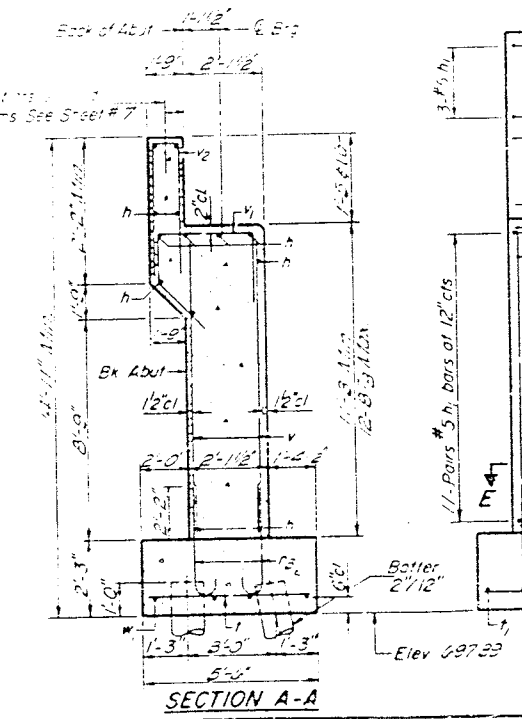





BILL OF MATERIAL

NO.	SIZE	LENGTH	SHAPE
1	#5	20.0	BAR
2	#5	15.0	BAR
3	#5	15.0	BAR
ABUTMENT & APPROACH BENT
 SOUTHBOUND ROADWAY - NORTH
 FAI ROUTE 55 SEC. 57-10-E
 MC LEAN COUNTY
 STATION 753+54.41

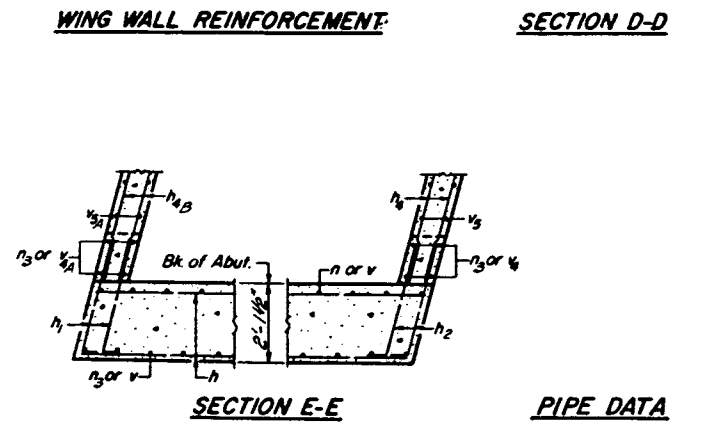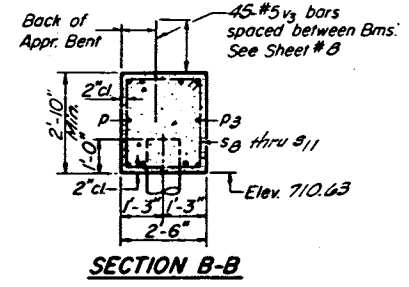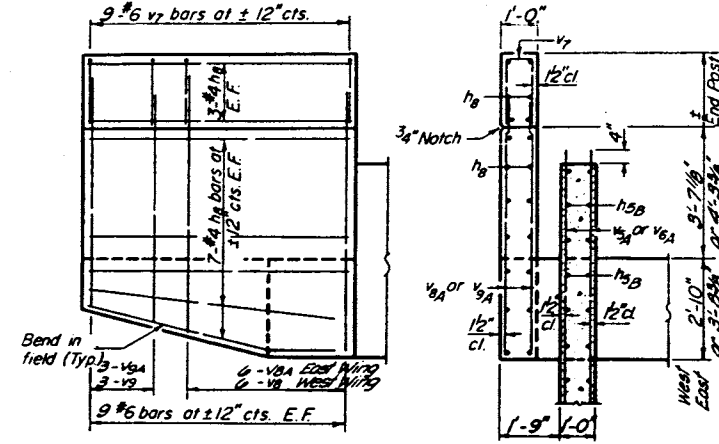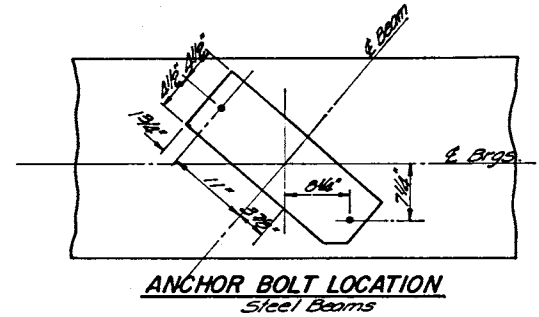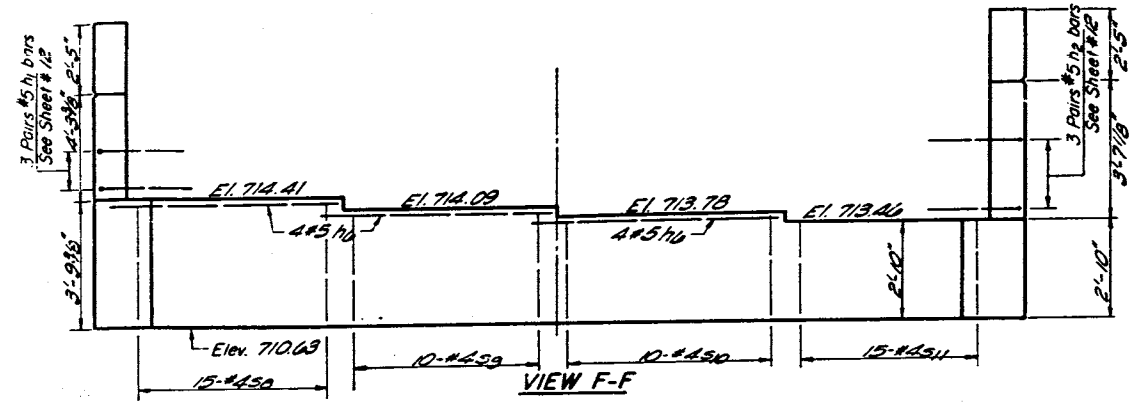

PIPE DATA
 Type - Concrete
 Capacity 29 Tons
 Est. Length 67 Bent
 Number 9 Bent
 Est. Length 52 Abut.
 Number 8 Abut.

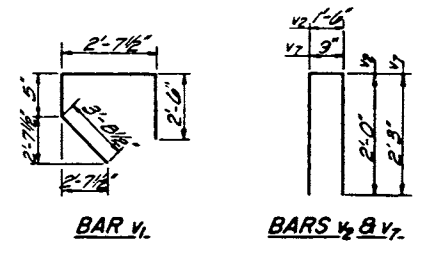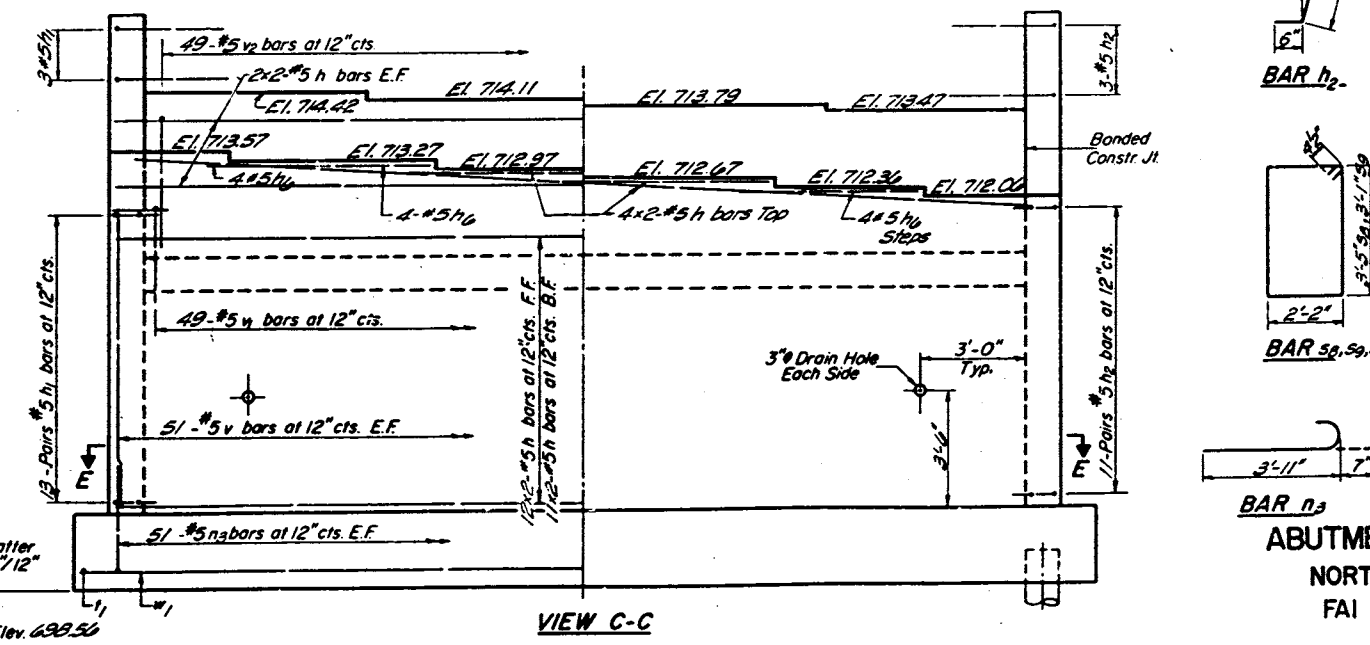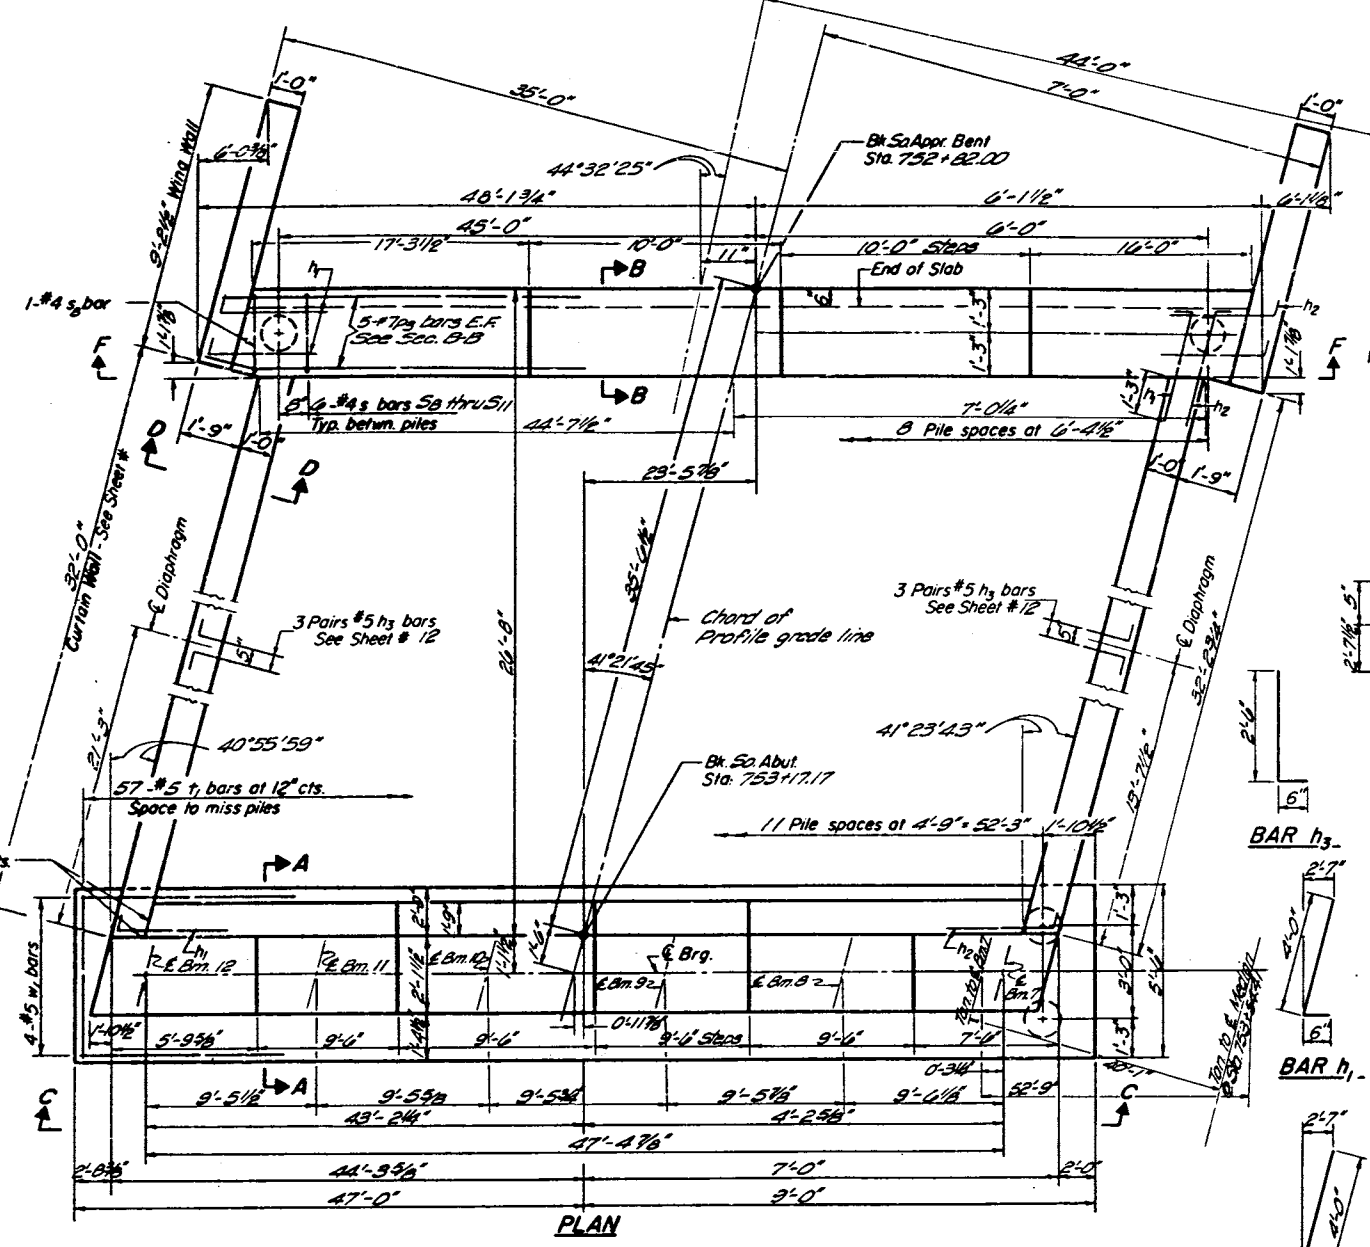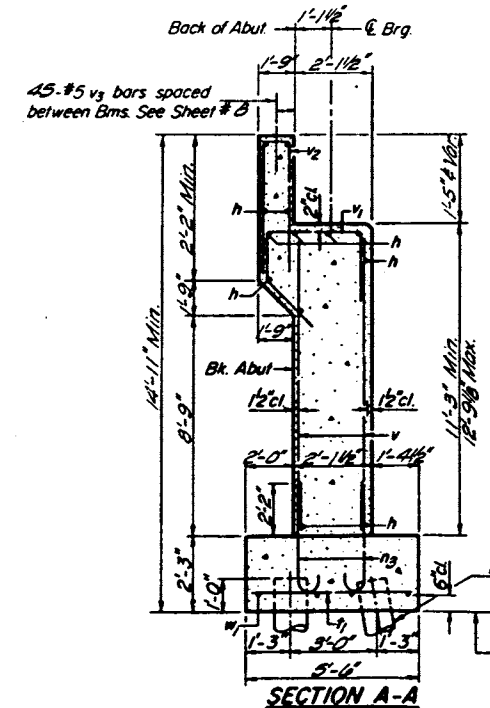

BILL OF MATERIAL











Bar	No.	Size	Length	Shape
h	62	#5	20'-6"	
h1	41	#5	4'-6"	L
h2	37	#5	4'-6"	L
h3	12	#5	3'-0"	L
h4	10	#5	27'-2"	
h5	28	#5	32'-0"	
h6	28	#5	11'-0"	
h7	4	#6	26'-0"	
h8	40	#4	9'-0"	
V3A	24	#5	22'-0"	
h9	102	#5	4'-6"	
V6A	10	#5	7'-2"	
D8	20	#7	28'-3"	
S8	15	#4	11'-11"	
S9	10	#4	11'-3"	
S10	10	#4	10'-9"	
V1	57	#5	5'-3"	
S11	15	#4	10'-1"	
V	102	#5	11'-0"	
V2	49	#5	9'-3"	
V3	29	#5	6'-0"	
V4	20	#5	3'-0"	
V5	6	#5	15'-6"	
V6	24	#5	19'-6"	
V7	10	#5	5'-7"	
V8	18	#6	5'-3"	
V9	12	#6	7'-0"	
V10	6	#6	7'-0"	
V11A	12	#6	9'-3"	
V12	8	#5	29'-0"	
V13A	6	#6	9'-3"	
V14A	6	#5	17'-0"	
Reinforcement Bars		Lbs.	11,010	
Class X Concrete		Cu. Yds.	128.6	
Concrete Piles		Lin. Ft.	4,951	

ABUTMENT & APPROACH BENT
 NORTHBOUND ROADWAY - SOUTH
 FAI ROUTE 55 SEC. 57-10HB
 MC LEAN COUNTY
 STATION 753+54.41

ADDED BILL OF MATERIAL

Bar No.	Size	Length	Shape
Via 49	#5	5'-6"	┐
V13	#5	4'-6"	┐
V16	#5	11'-0"	—
V24	#5	3'-6"	┐

Added Reinf. Bars Lbs. 485
 50 lbs. for Bars Not Needed

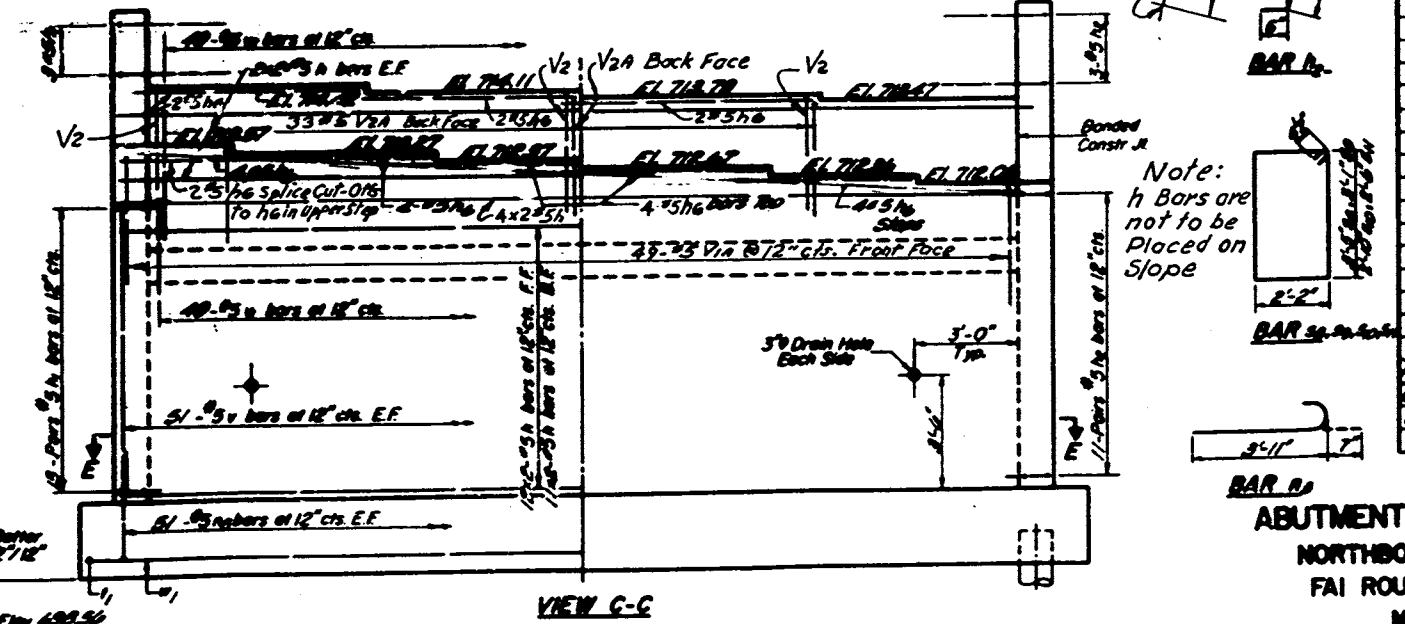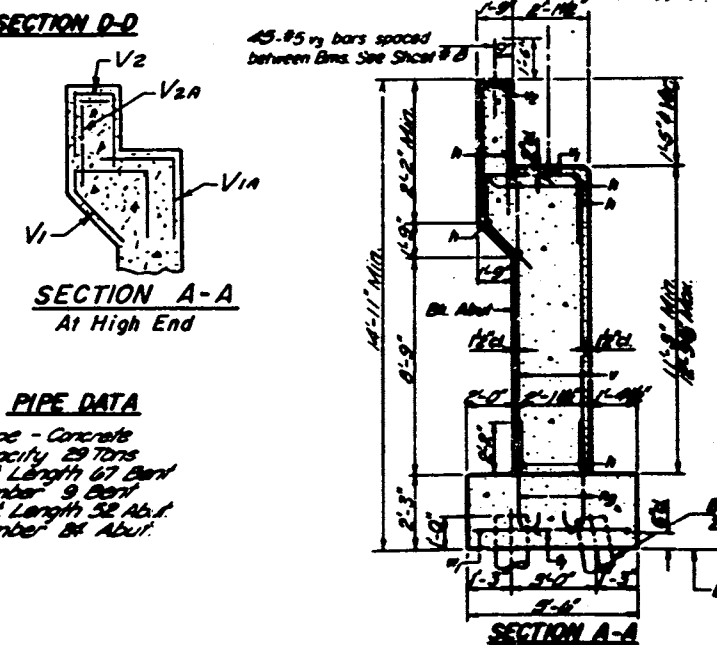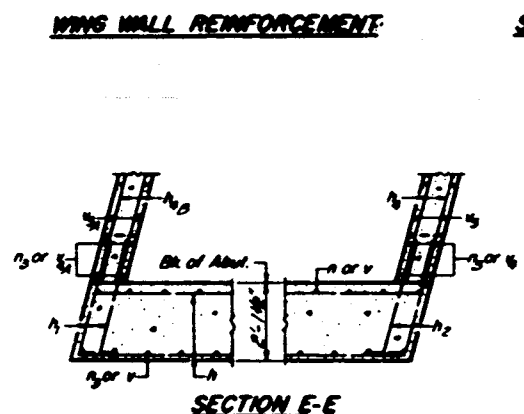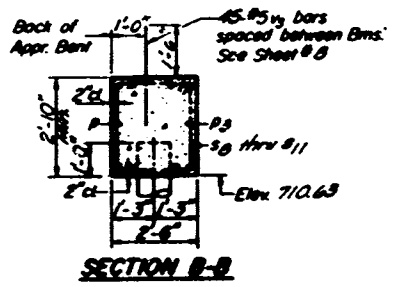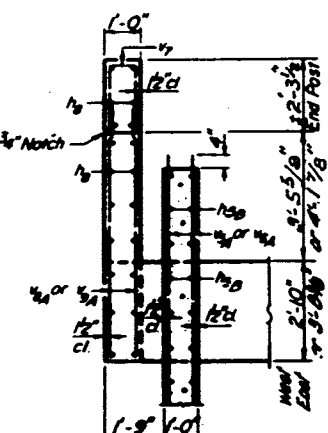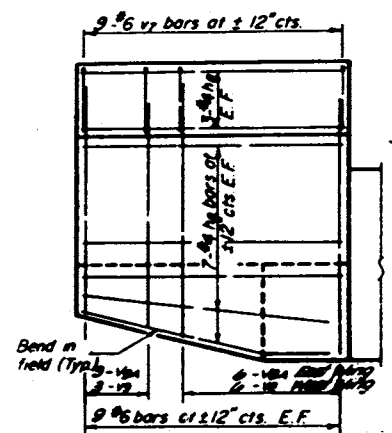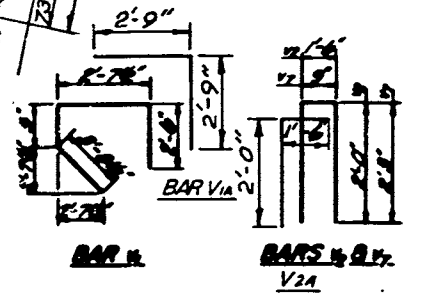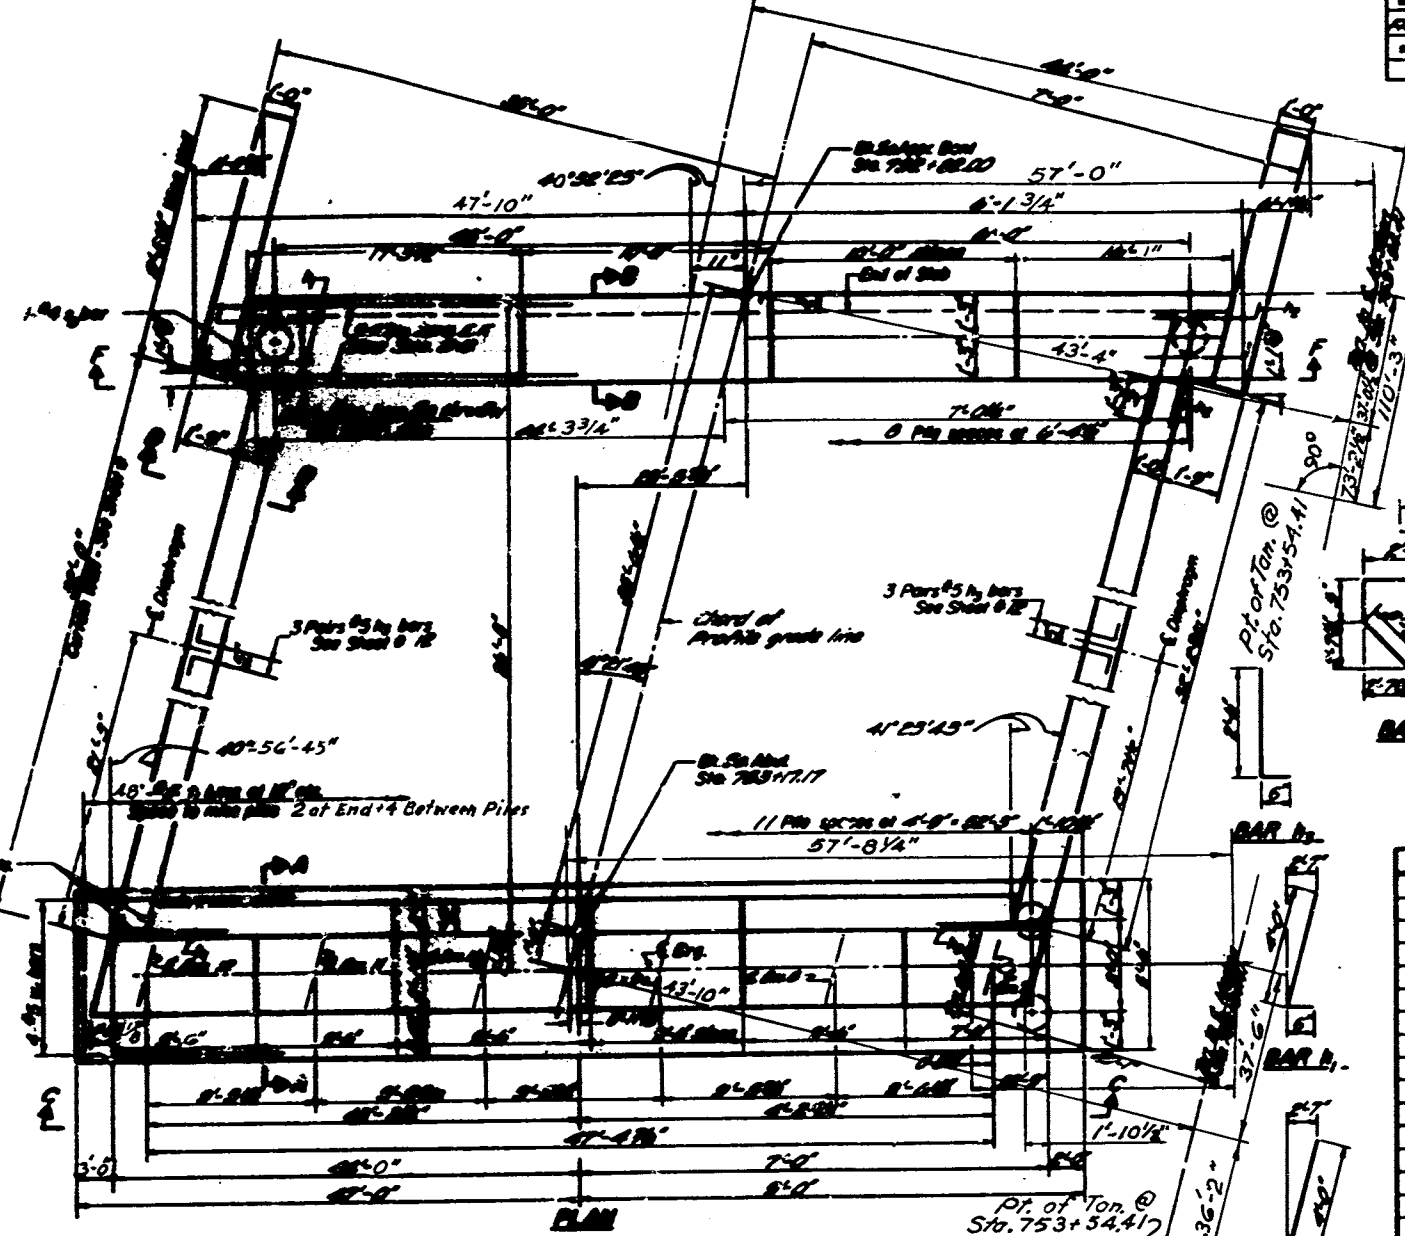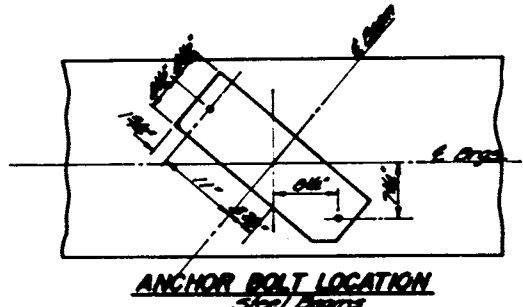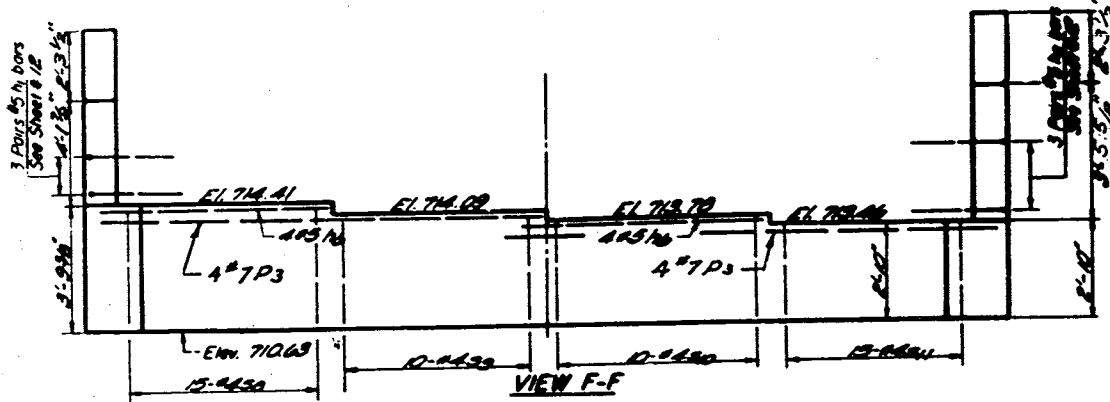

BILL OF MATERIAL






Bar No.	Size	Length	Shape
1	#4	25'	—
2	#4	25'	—
3	#4	25'	—
Note:
h Bars are not to be placed on Slope





AS REVISED

PIPE DATA
 Type - Concrete
 Capacity - 29 Tons
 Est. Length 67' Bent
 Number 9 Bent
 Est. Length 52' Abut.
 Number 84 Abut.

ABUTMENT & APPROACH BENT
 NORTHBOUND ROADWAY - SOUTH
 FAI ROUTE 55 SEC. 57-10NB
 MC LEAN COUNTY
 STATION 753+54.41

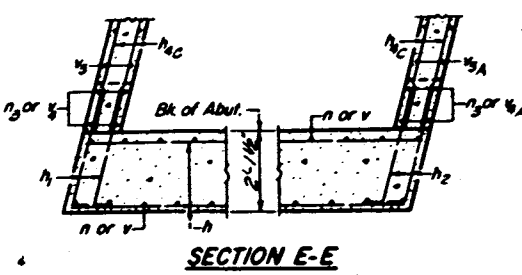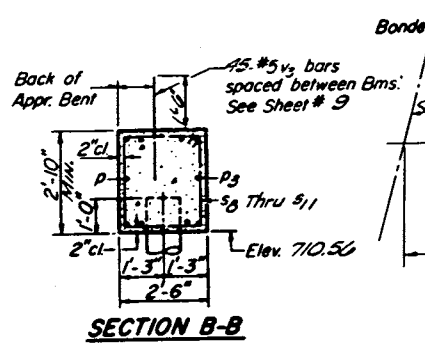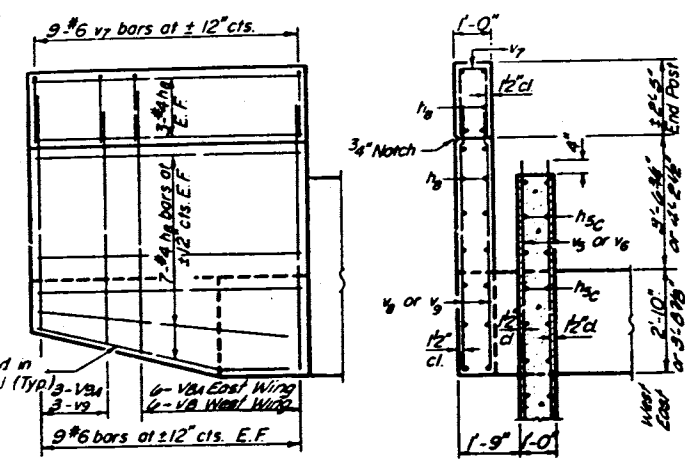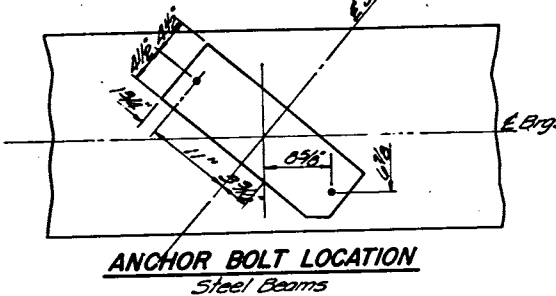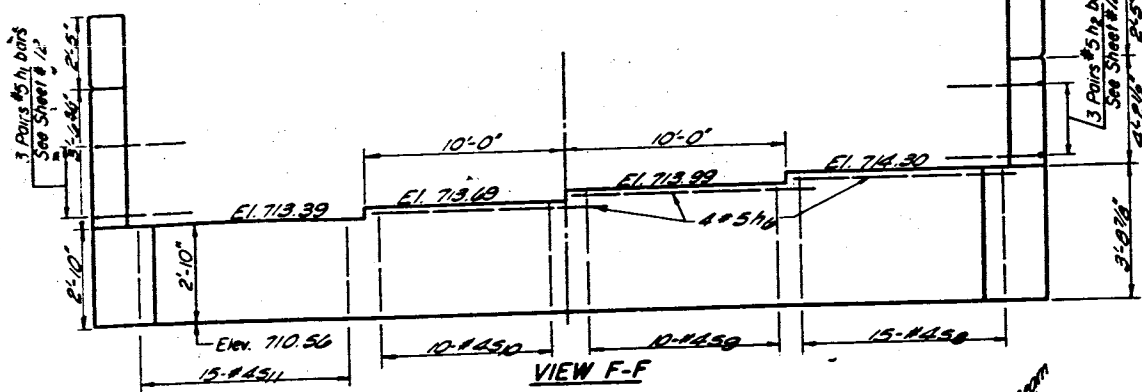

PILE DATA
 Type - Concrete
 Capacity - 29 Tons
 Est. Length 64 Bent
 Number 9 Bent
 Est. Length 52 Abut.
 Number 24 Abut.
 including 1 Test Pile

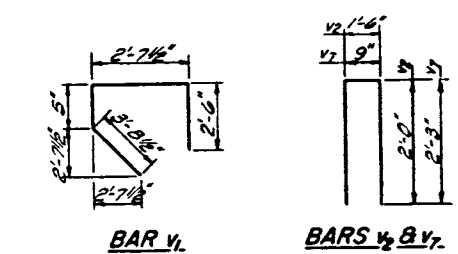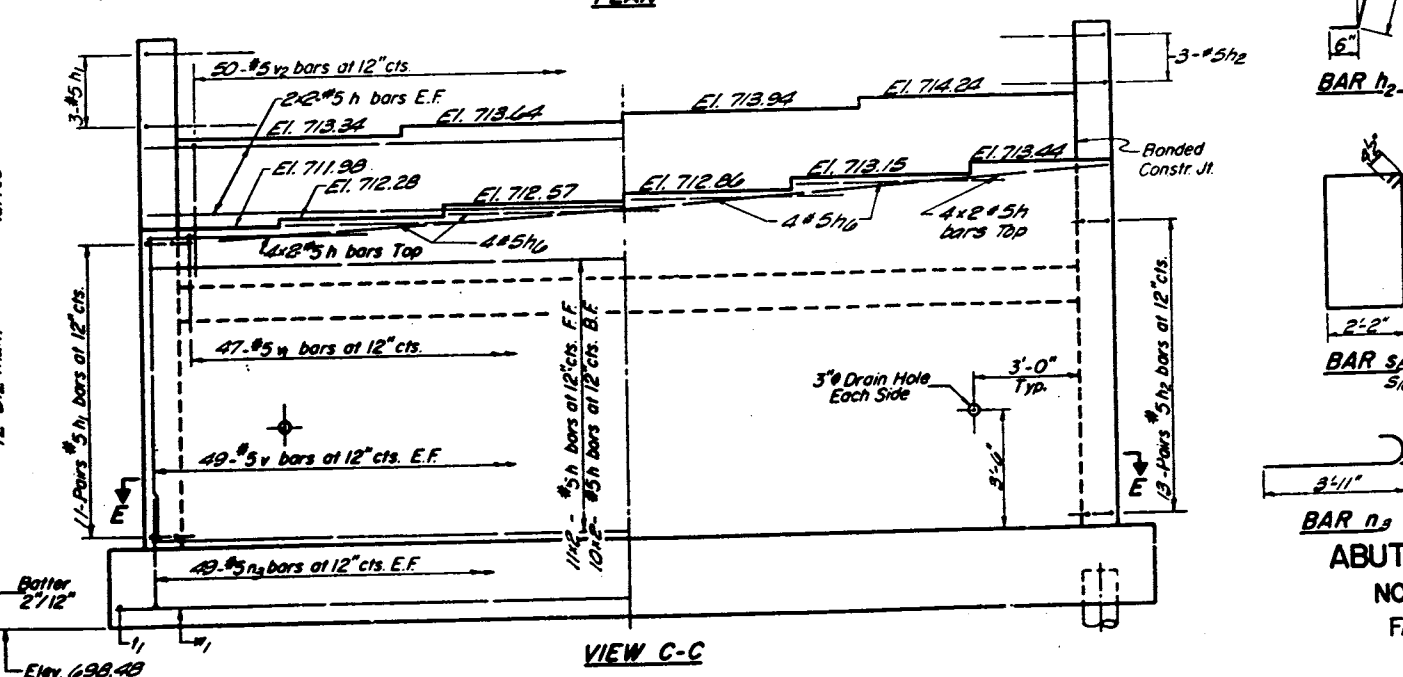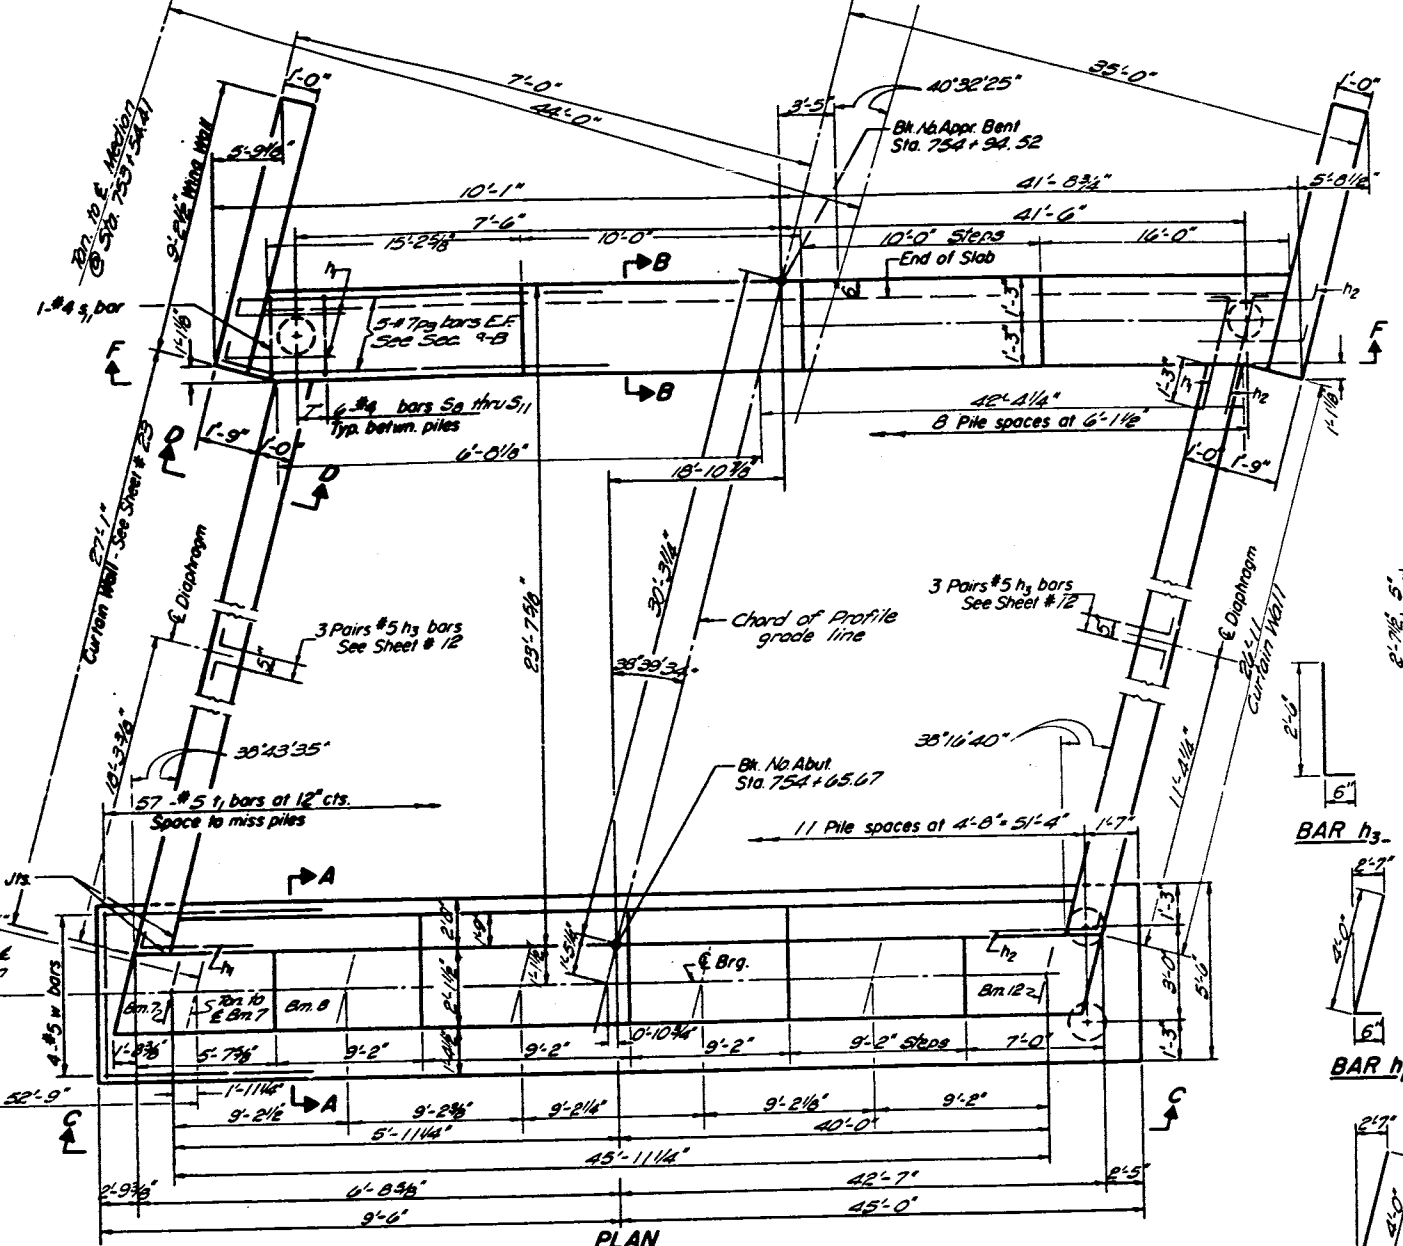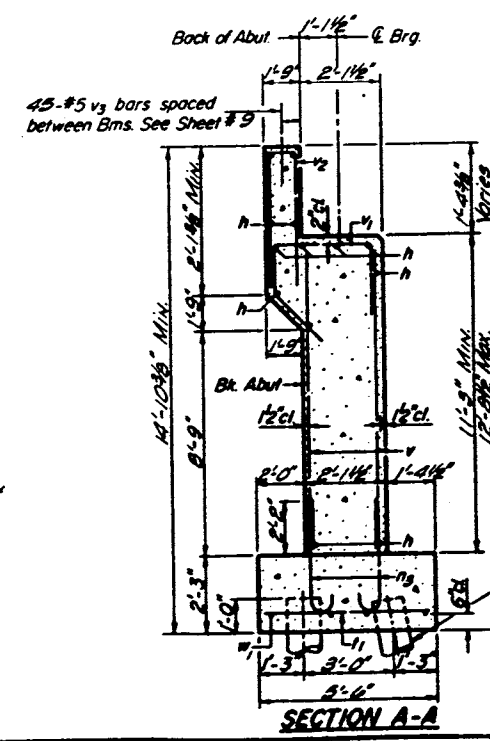

BILL OF MATERIAL


Bar No.	Size	Length	Shape
h	#5	26'-6"	—
h1	#5	4'-0"	L
h2	#5	4'-0"	L
h3	#5	3'-0"	L
h4c	#5	22'-3"	—
h5c	#5	27'-0"	—
h6	#5	11'-0"	—
h7c	#6	24'-3"	—
h8	#4	9'-0"	—
v8a	#5	22'-6"	—
n3	#5	4'-6"	—
v6a	#5	7'-2"	—
p2	#7	28'-3"	—
s9	#4	11'-3"	—
s10	#4	10'-9"	—
s11	#4	5'-3"	—
v	#5	11'-0"	—
v1	#5	9'-3"	—
v2	#5	6'-0"	—
v3	#5	3'-0"	—
v4	#5	15'-0"	—
v5	#5	19'-0"	—
v6	#5	5'-7"	—
v7	#6	5'-3"	—
v8	#6	7'-0"	—
v9	#6	9'-3"	—
v10	#5	24'-0"	—
v11	#6	8'-9"	—
v12	#6	7'-0"	—
v13	#5	17'-0"	—
v14	#5	17'-0"	—
Reinforcement Bars	Lbs.	12,370	
Class x Concrete	Cu. Yds.	120.7	
Concrete Piles	Lin. Ft.	1772	
Test Piles - Concrete	Each	1	

ABUTMENT & APPROACH BENT
 NORTHBOUND ROADWAY - NORTH
 FAI ROUTE 55 SEC. 57-10HB
 MC LEAN COUNTY
 STATION 753+54.41

ADDED BILL OF MATERIAL

Bar No.	Size	Length	Shape
VIA	#5	5'-6"	7
V2A	#5	3'-6"	7
V3	#5	4'-6"	1
h6	#5	11'-0"	1

Added Reinf. Bars Lbs. 480
 50 Lbs. #1 Bars not needed

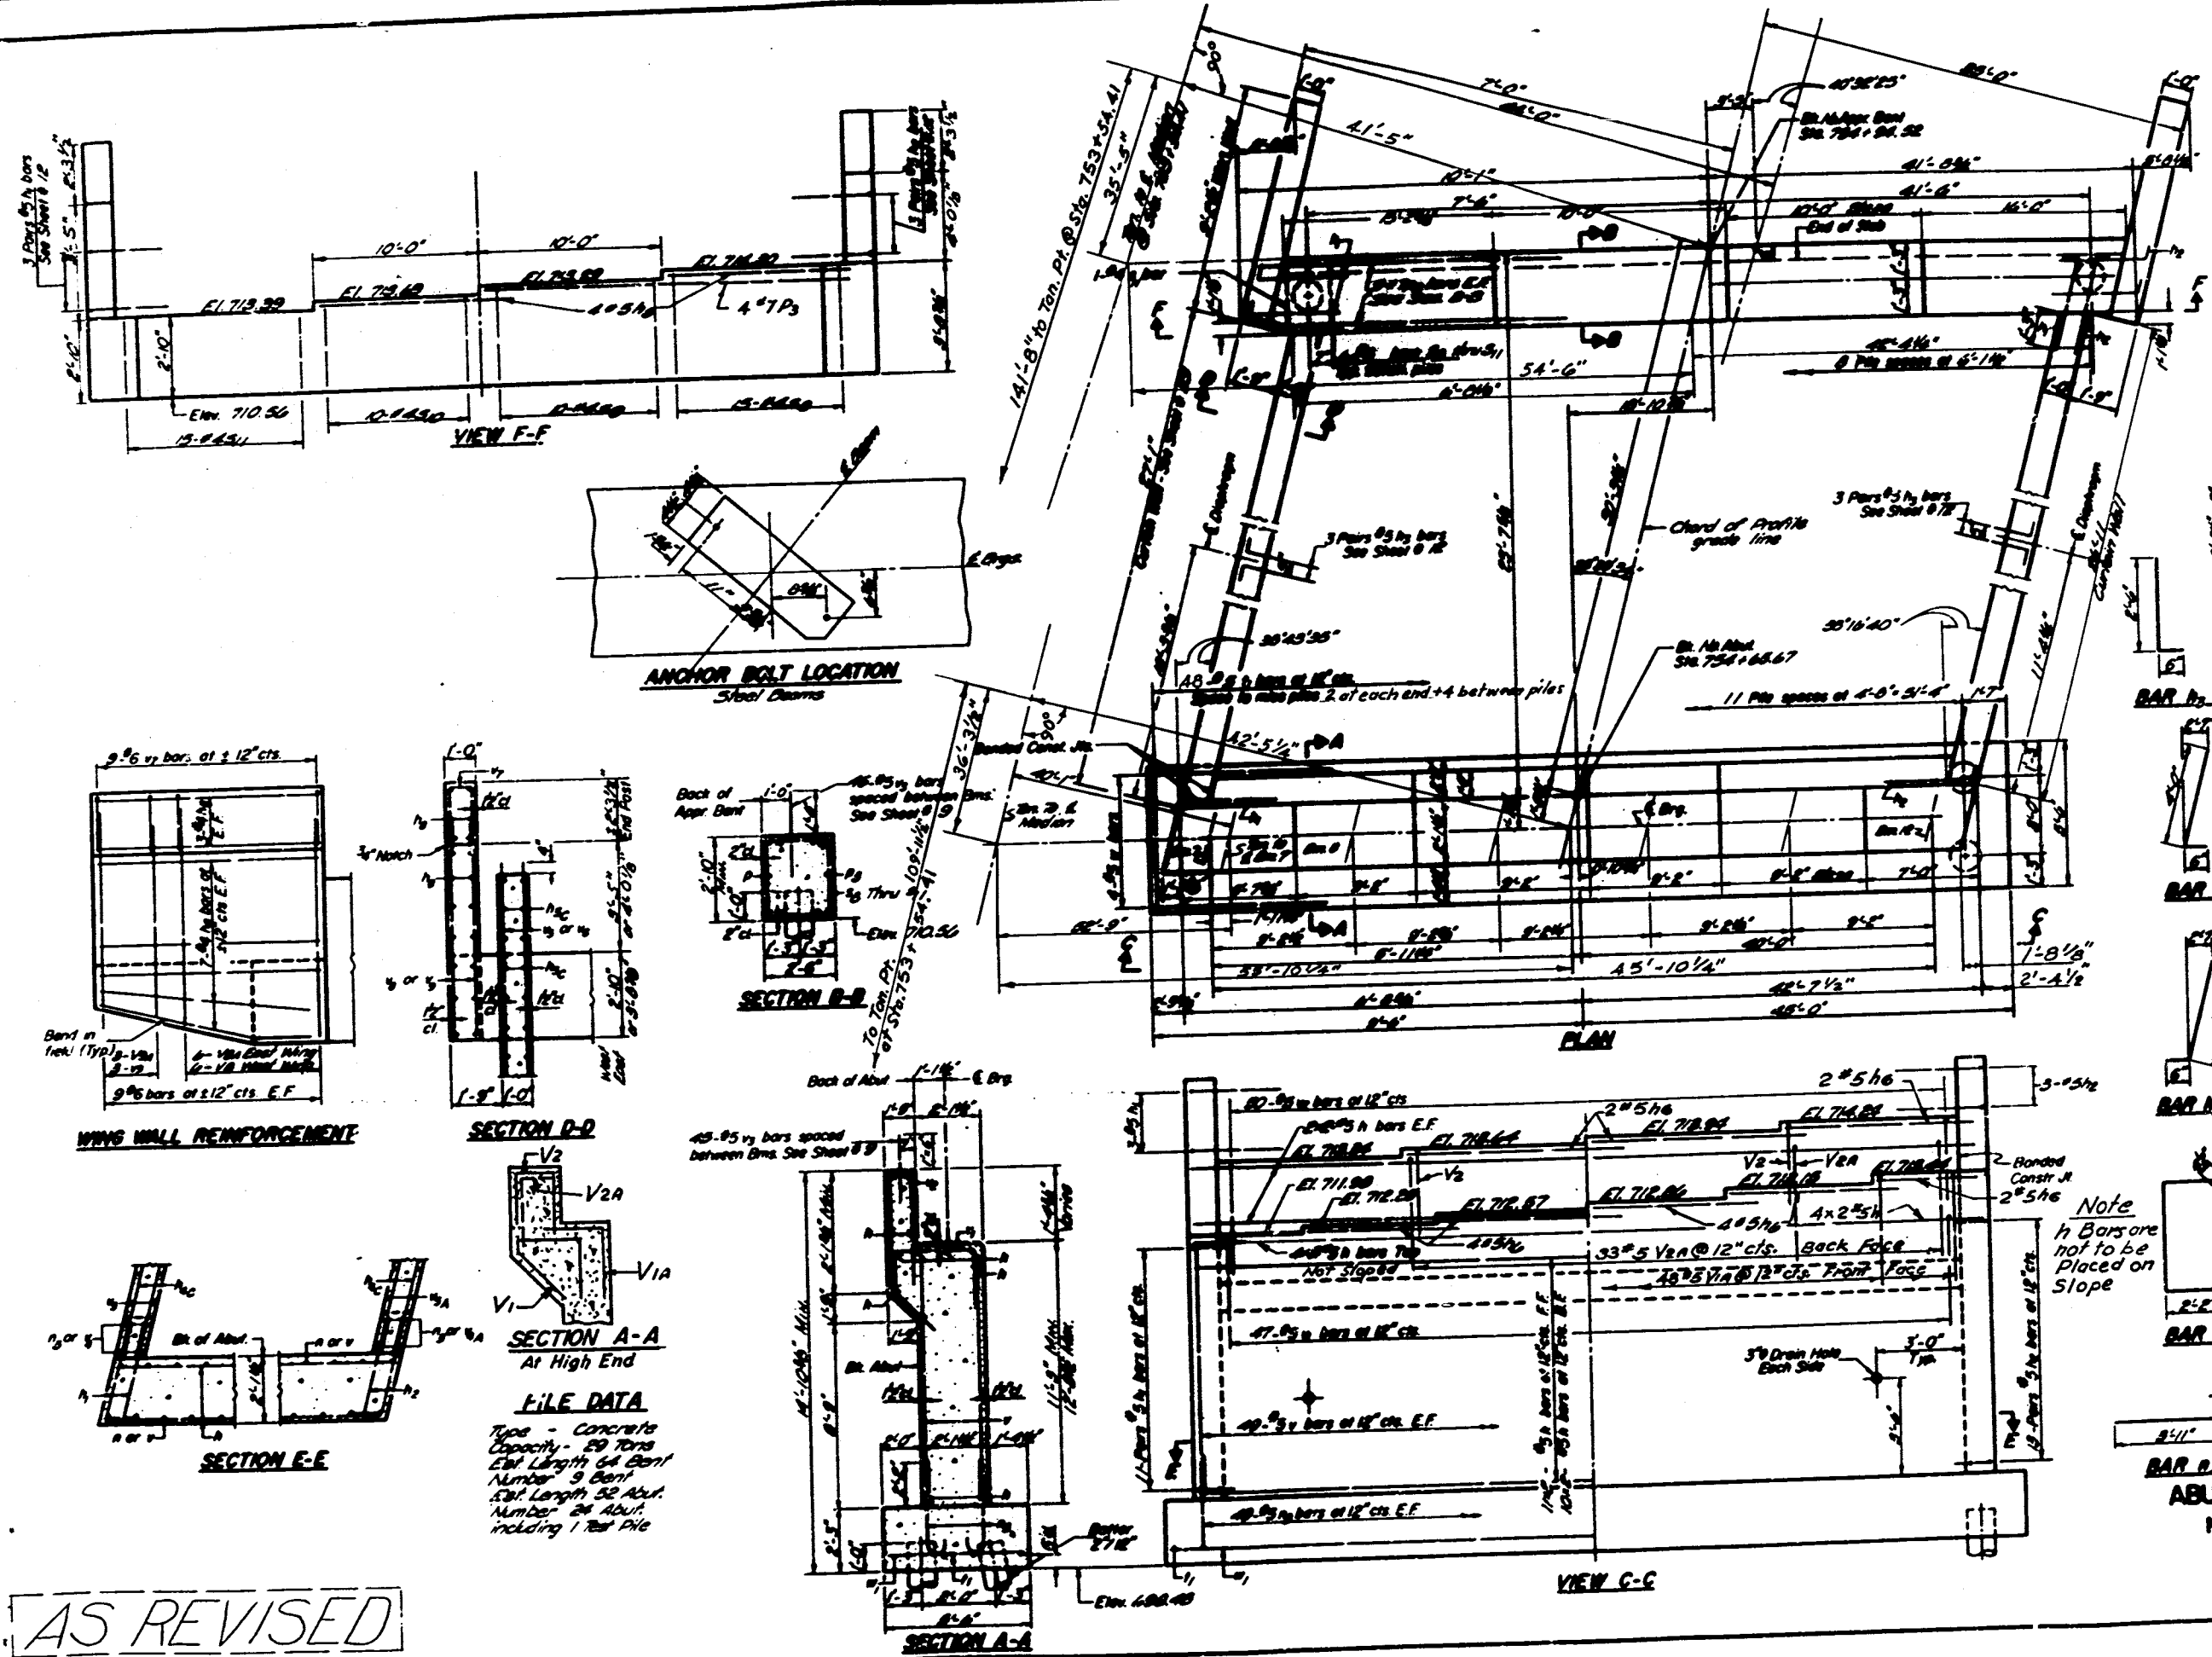

BILL OF MATERIAL

Bar No.	Size	Length	Shape
1	#5	8'-0"	1
2	#5	8'-0"	1
3	#5	4'-6"	1
4	#5	4'-6"	1
5	#5	2'-0"	1
6	#5	2'-0"	1
Reinforcement Bars Lbs. 13,570
 Class X Concrete Cu. Yds. 162.7
 Concrete Piles Lin. Ft. 1772
 Test Piles-Concrete Each 1

FILE DATA


Type - Concrete
 Capacity - 80 Tons
 Ebf Length 64 Bent
 Number 9 Bent
 Ebf Length 52 Abut.
 Number 24 Abut.
 including 1 Test Pile

AS REVISED


As Revised 4-29-75

ABUTMENT & APPROACH BENT
 NORTHBOUND ROADWAY - NORTH
 FAI ROUTE 55 SEC. 57-104B
 MC LEAN COUNTY
 STATION 753+54.41


2" dia. Conduit (Sch. 40 Pipe) Extend to clear end of wing wall and terminate at a point outside of the shoulder. Thread and cap each end. Place conduit at the two outside corners of each dual bridge and all four corners of a single bridge (4 total.) Cast incidental.

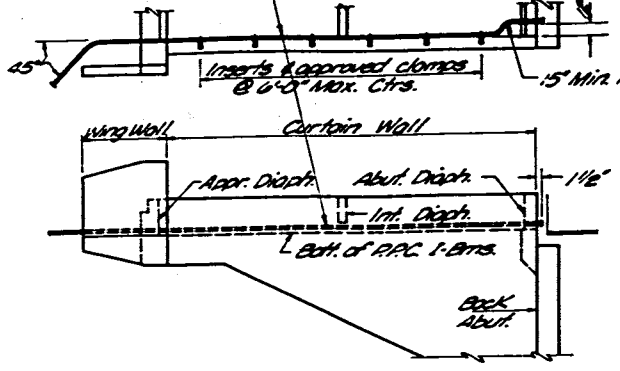


ELECTRICAL CONDUIT LOCATION

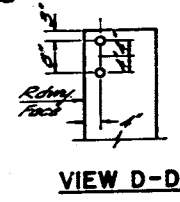

VIEW D-D

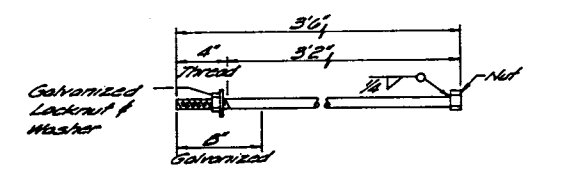


1" ANCHOR BOLT
(Cast incidental to Bridge Construction)

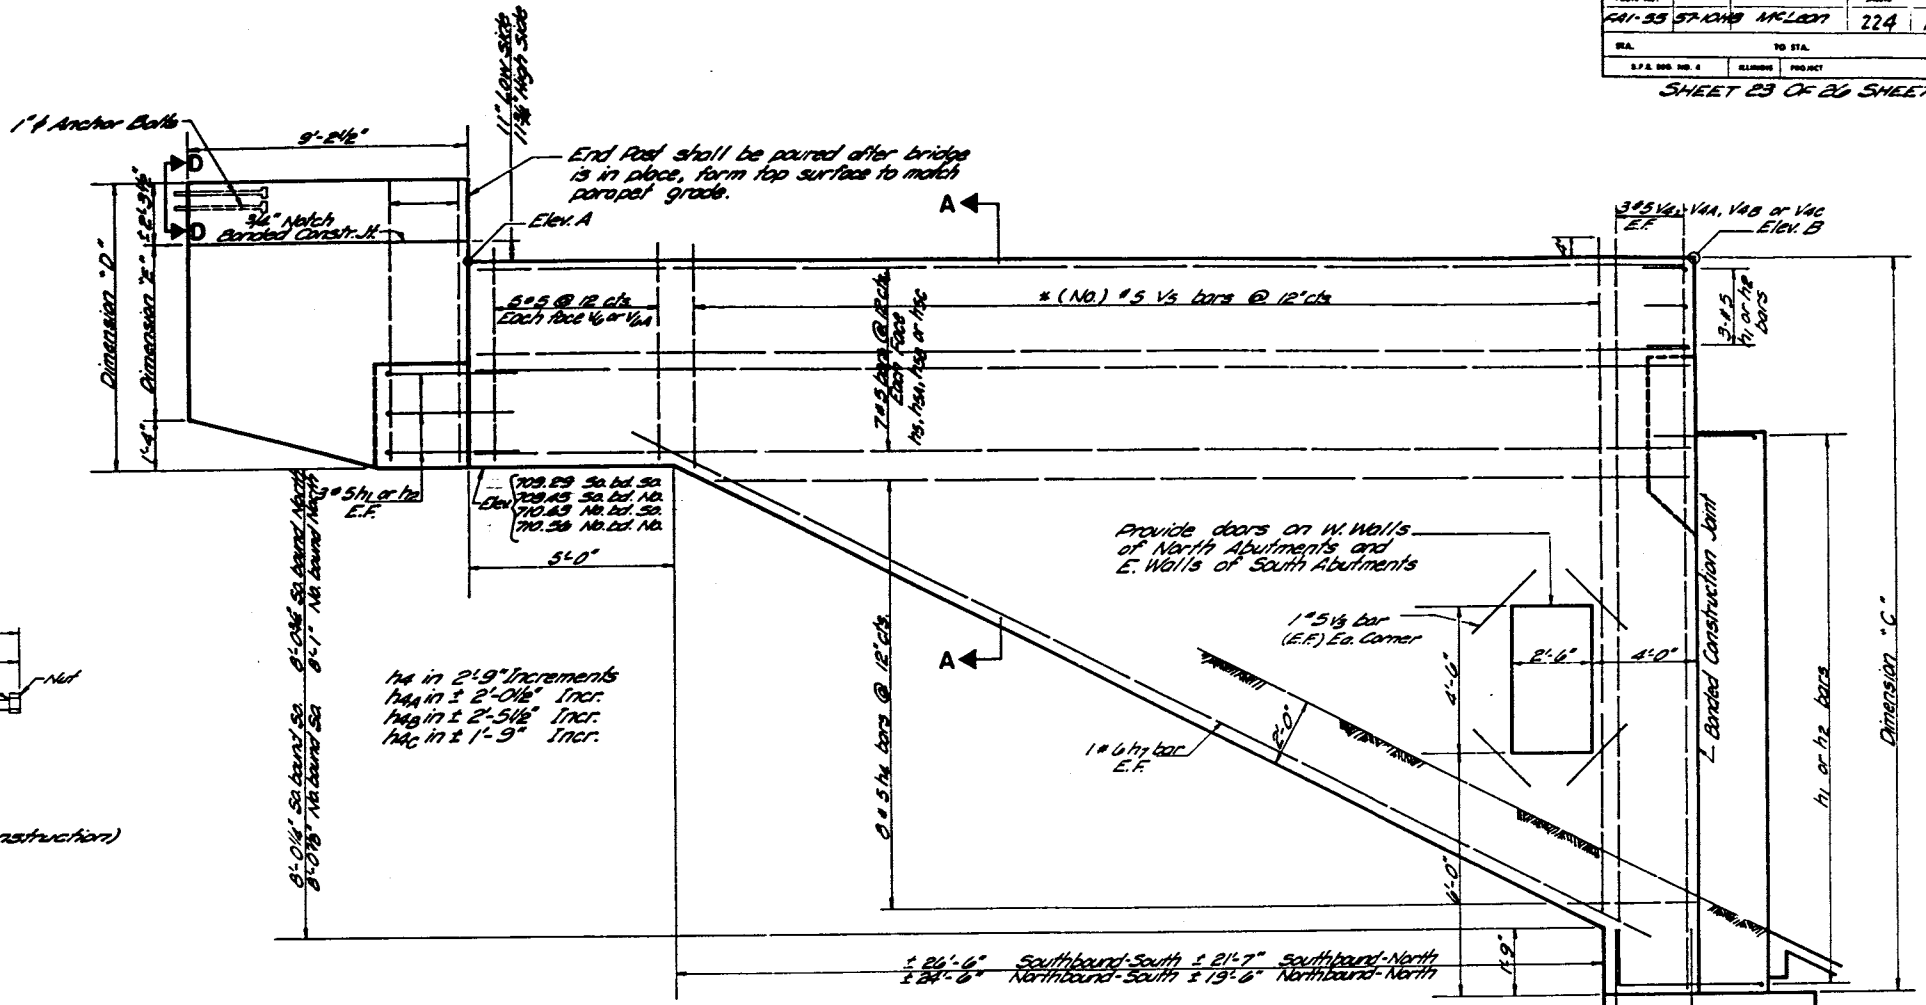


1/4" in 2'-9" Increments
1/4" in 2'-0 1/2" Incr.
1/4" in 2'-5 1/2" Incr.
1/4" in 2'-9" Incr.

* Number of vs bars for Southbound South ± (3 3/8" Increments)
24 vs bars for Northbound South ± (4" Increments)
22 vs bars for Southbound North ± (4 1/4" Increments)
19 vs bars for Northbound North ± (5" Increments)

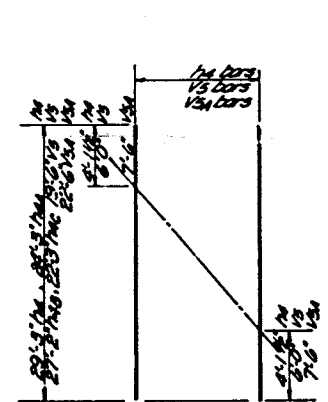


FIELD CUTTING DIAGRAM

* Order 1/4" & 1/2" bars full length cut to fit as shown and use remainder of bars in other face

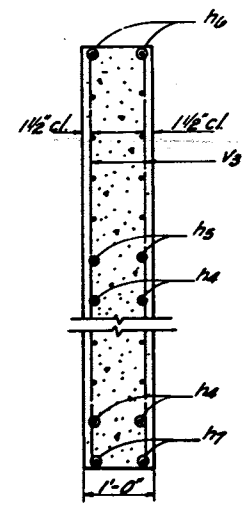


SECTION A-A

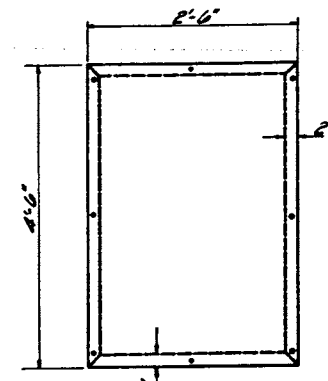

DOOR ELEVATION

Cost of doors and frames are incidental!


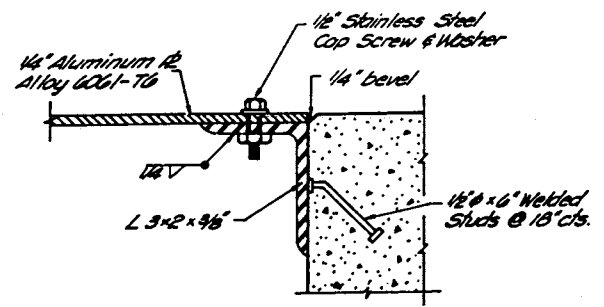


SECTION THRU DOOR FRAME



	LOCATION	DIM. "C"	DIM. "D"	DIM. "E"
Southbound Approach	W. Wall S. Abut.	15'-2 1/4"	8'-0 3/8"	4'-11 1/2"
	E. Wall S. Abut.	16'-9 1/8"	10'-2 1/4"	6'-7"
	W. Wall N. Abut.	15'-2 3/8"	8'-7"	4'-11 1/2"
	E. Wall N. Abut.	16'-0 3/8"	10'-1 5/8"	6'-6 1/2"
Northbound Approach	W. Wall S. Abut.	15'-2 3/8"	8'-7"	4'-11 1/2"
	E. Wall S. Abut.	16'-0 3/8"	10'-2"	6'-6 1/2"
	W. Wall N. Abut.	15'-2 3/8"	8'-6 1/2"	4'-11"
	E. Wall N. Abut.	16'-0"	10'-0 1/4"	6'-5"

	LOCATION	ELEV. A	ELEV. B
Southbound Approach	W. Wall S. Abut.	714.640	714.712
	E. Wall S. Abut.	716.230	716.200
	W. Wall N. Abut.	714.820	714.843
	E. Wall N. Abut.	716.315	716.337
Northbound Approach	W. Wall S. Abut.	715.990	716.011
	E. Wall S. Abut.	717.524	717.532
	W. Wall N. Abut.	715.880	715.932
	E. Wall N. Abut.	717.339	717.392

CURTAIN WALL
FAI ROUTE 55 SEC. 57-10HB
MCLEAN COUNTY
STATION 753+54.41

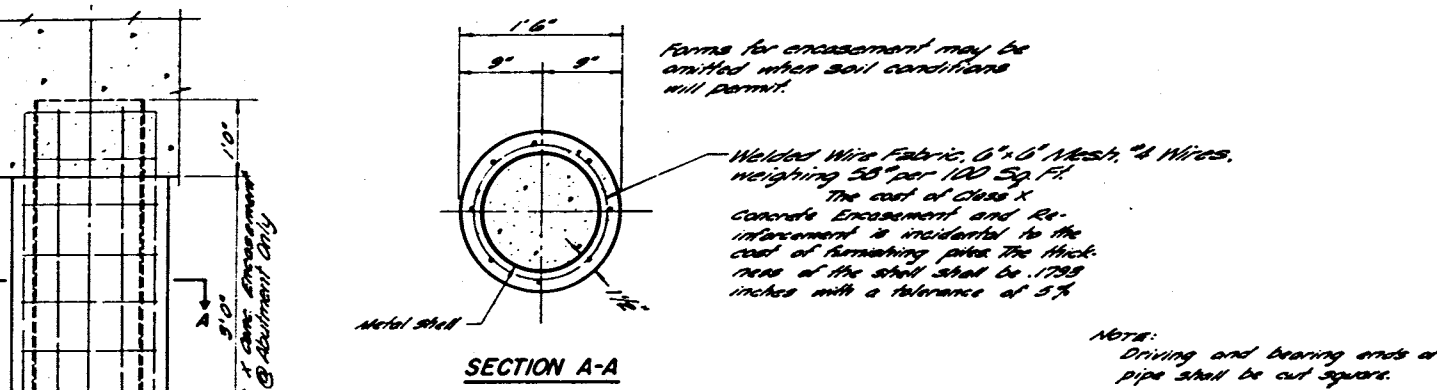
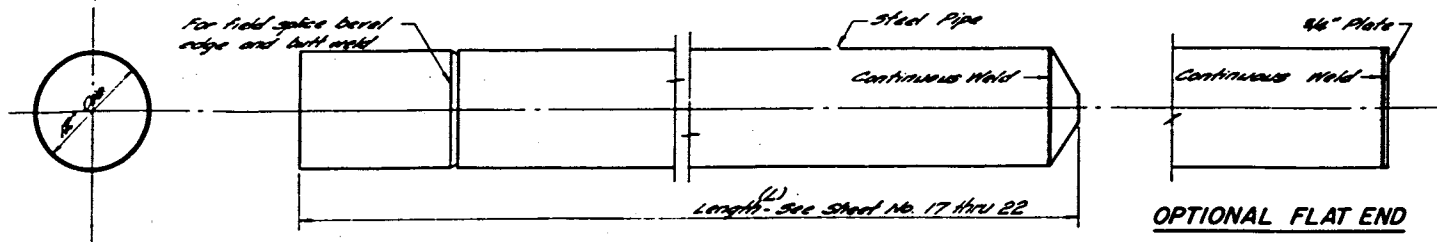


DETAIL OF CYLINDRICAL STEEL SHELL FOR CAST IN PLACE CONCRETE PILES

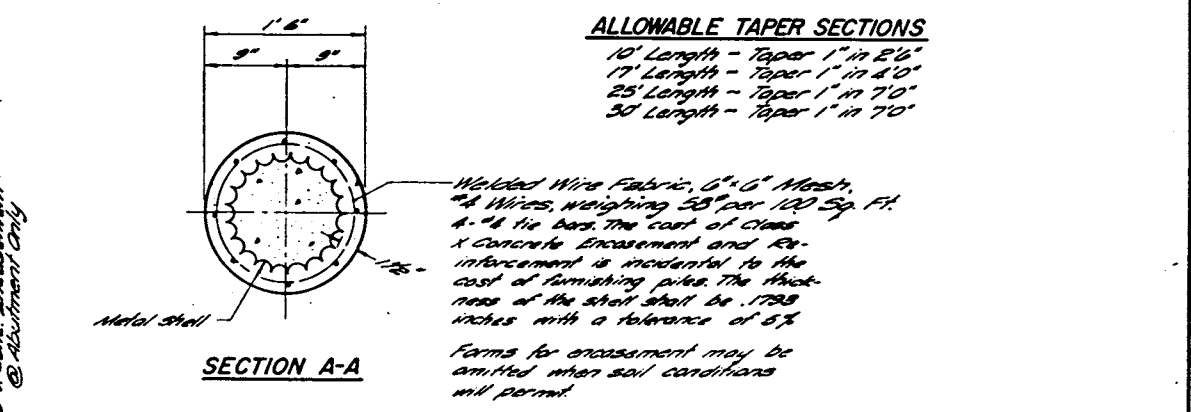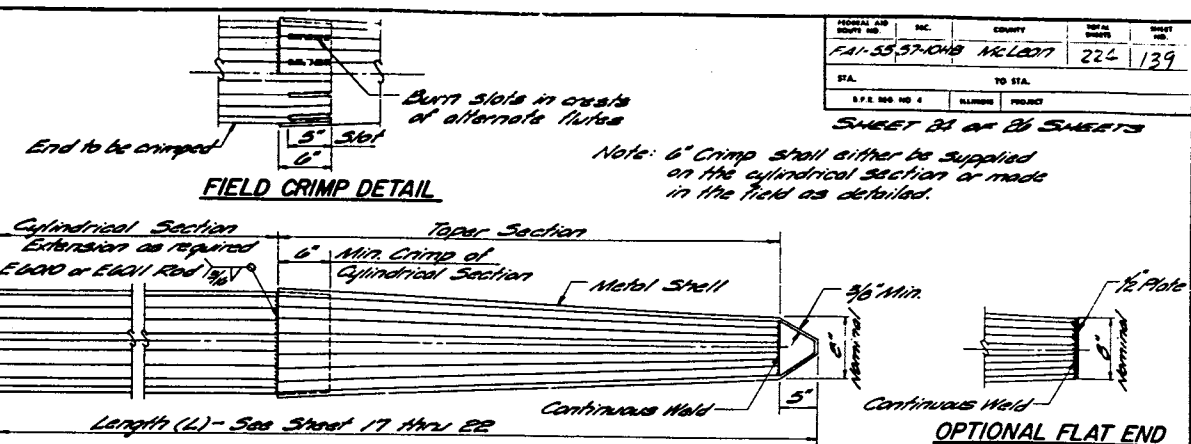

- ALLOWABLE TAPER SECTIONS**
- 10' Length - Taper 1" in 2'6"
 - 17' Length - Taper 1" in 4'0"
 - 25' Length - Taper 1" in 7'0"
 - 30' Length - Taper 1" in 7'0"



DETAIL OF TAPERED METAL SHELL FOR CAST IN PLACE CONCRETE PILES

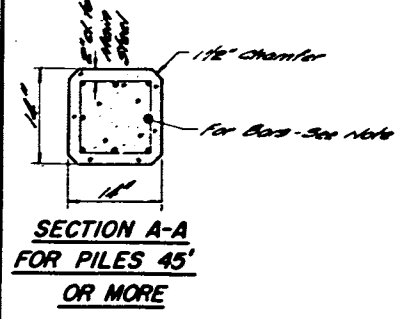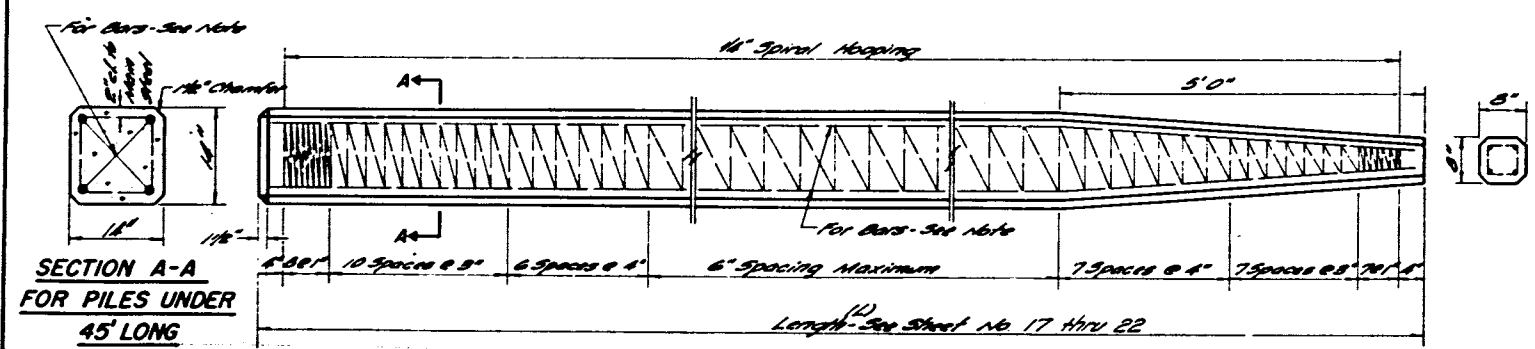

NOTE: For 18" Piles 45' long or more use 8-#8 bars, 4 for the full length and 4 to the point of bend. For 18" Piles under 45' long use 6-#9 bars the full length.

HANDLING: For Pile lengths up to 45', use two slings placed at a distance of 0.21 L from each end. For Piles longer than 45', use three slings placed at a distance of 0.12 L from each end and at midpoint of pile.

DETAIL OF PRECAST CONCRETE PILES

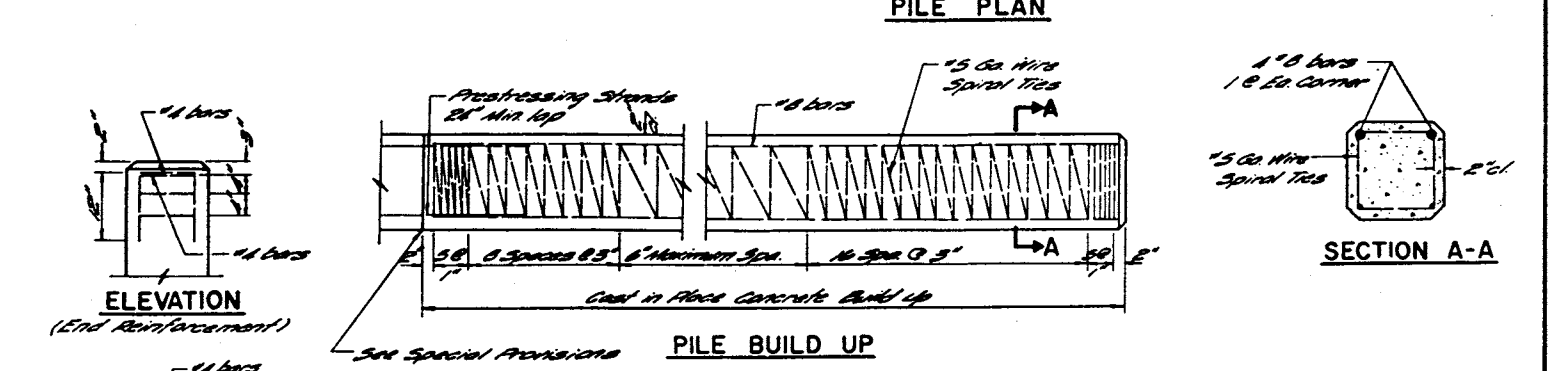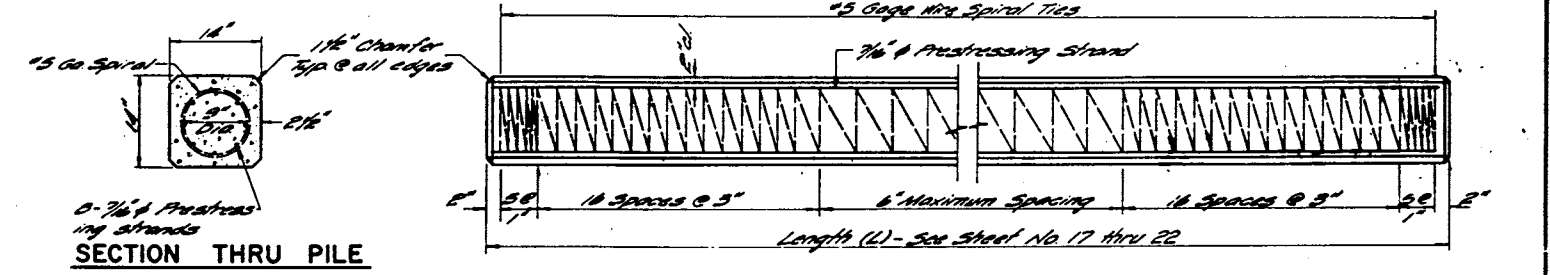


DESIGN STRESSES

- f_c' = 5000 psi
- f_c' = 4000 psi
- f_s' = 200,000 psi (24,000 ksi)
- f_s' = 180,000 psi (22,000 ksi)


NOTE: Prestressing steel shall be non-galvanized unless high strength stress-relieved 7 wire strand. The nominal shall be 7/16" and the minimum nominal cross-sectional area shall be 0.155 square inch.

HANDLING: For pile lengths up to 45', use two slings placed at a distance of 0.21 L from each end. For piles longer than 45', use three slings placed at a distance of 0.12 L from each end and at midpoint of pile.


DETAIL OF PRECAST PRESTRESSED CONCRETE PILES

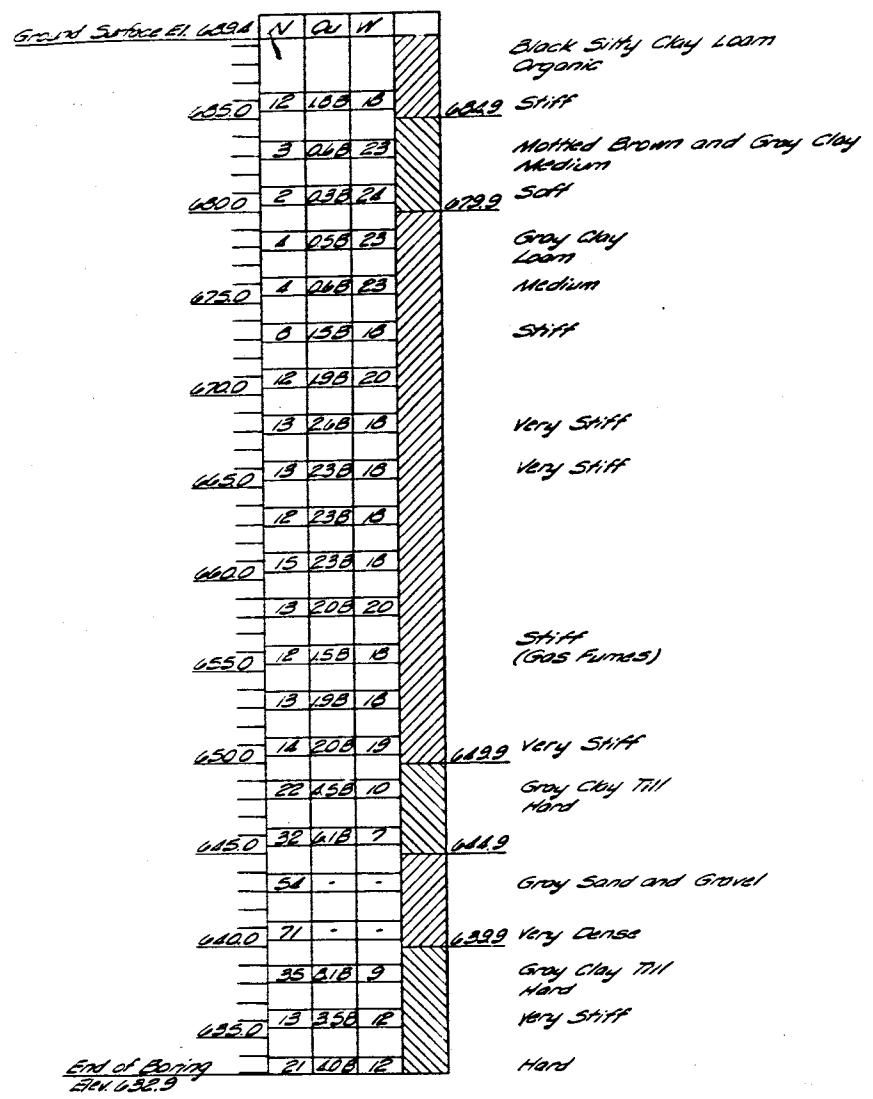

B-1
STA. 752 + 33
CL

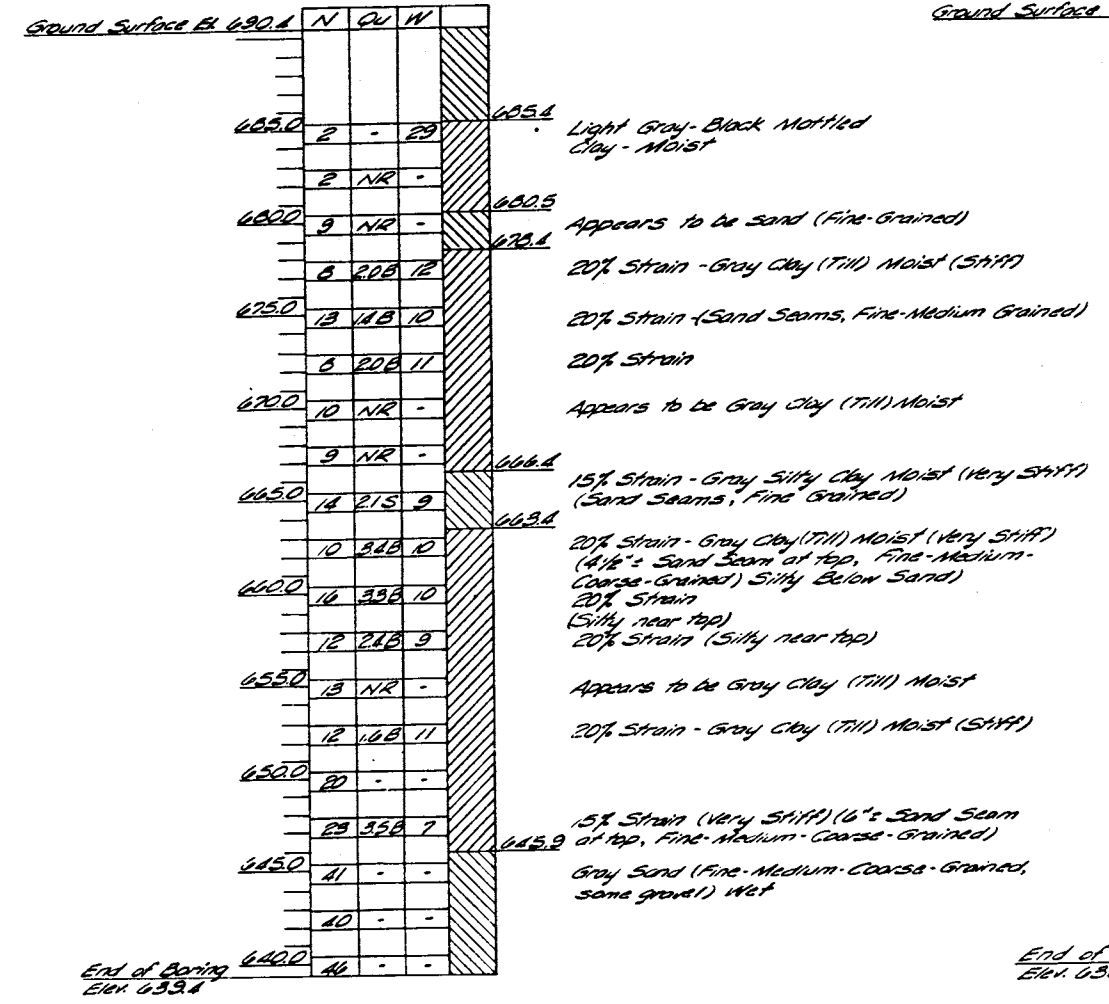


B-2
STA. 752 + 73
8' RT. CL SB M.

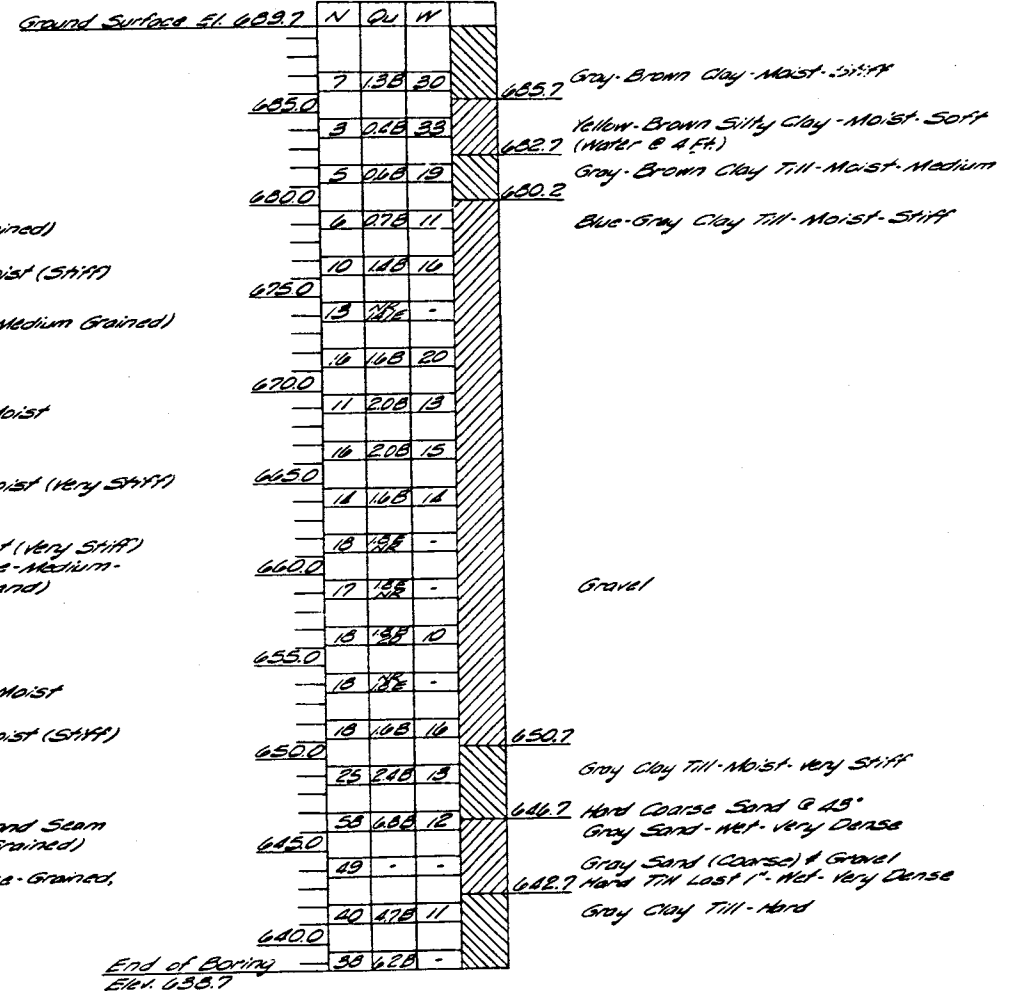


B-3
STA. 753 + 80
CL SB M.

N - Standard Penetration Test - Blows per Ft. to drive 2" O.D. Split Spoon Sampler 12" with 140# hammer falling 30".
 CU - Unconfined Compressive Strength - Tons per Sq. Ft.
 W - Water Content - percentage of Oven Dry Weight - %
 Type Failure:
 B - Bulge Failure
 S - Shear Failure
 E - Estimated Value

BORING DATA
 FAI ROUTE 55 SEC. 57-10HB
 McLEAN COUNTY
 STATION 753 + 54.41

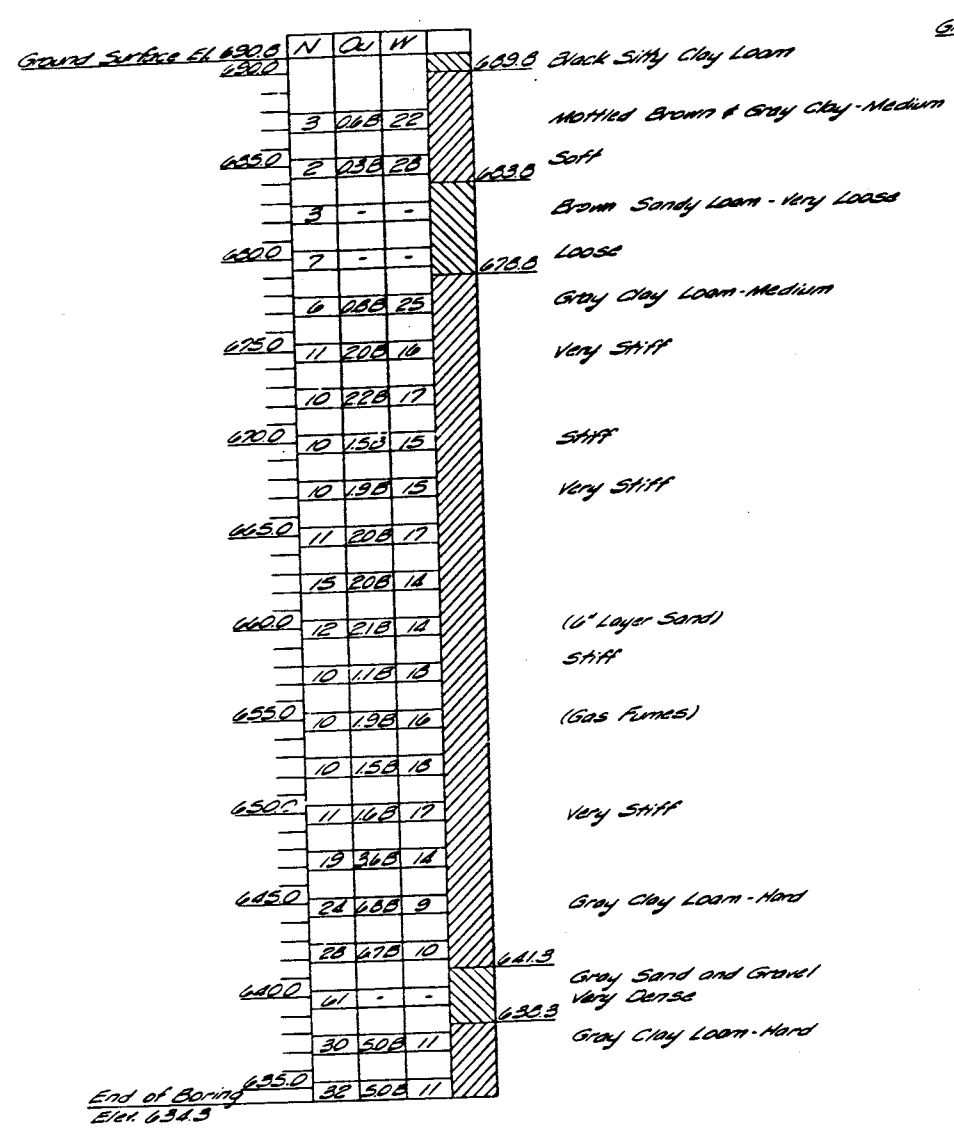

B-4
 STA. 753 + 28.69
 CL

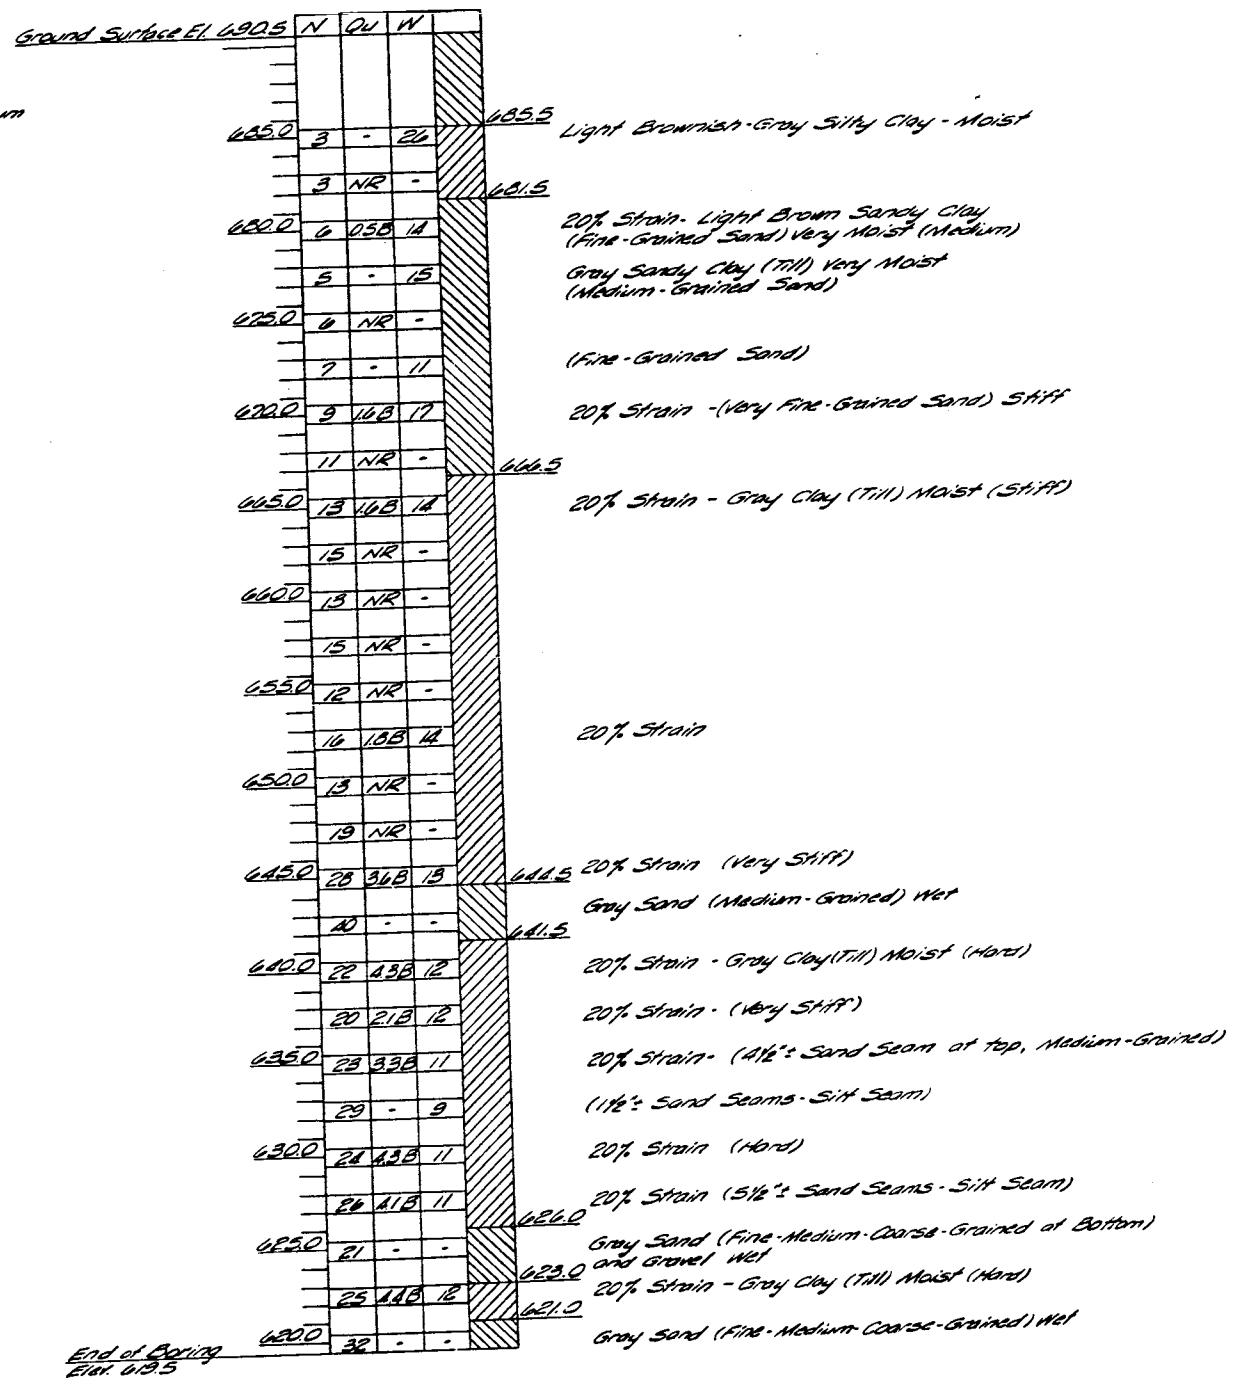


B-5
 STA. 754 + 29
 8' LT. CL NB M.

N - Standard Penetration Test - Blows per ft. to drive 2" O.D. Split Spoon Sampler 12" with 140# hammer falling 30".
 Qu - Unconfined Compressive Strength - Tons per Sq. Ft.
 W - Water Content - percentage of Oven Dry Weight - %
 Type Failure:
 B - Bulge Failure
 S - Shear Failure
 E - Estimated Value


BORING DATA
 FAI ROUTE 55 SEC. 57-10HB
 McLEAN COUNTY
 STATION 753 + 54.41

STANDARD DESIGN BRIDGE APPROACH SHOULDER PAVEMENT

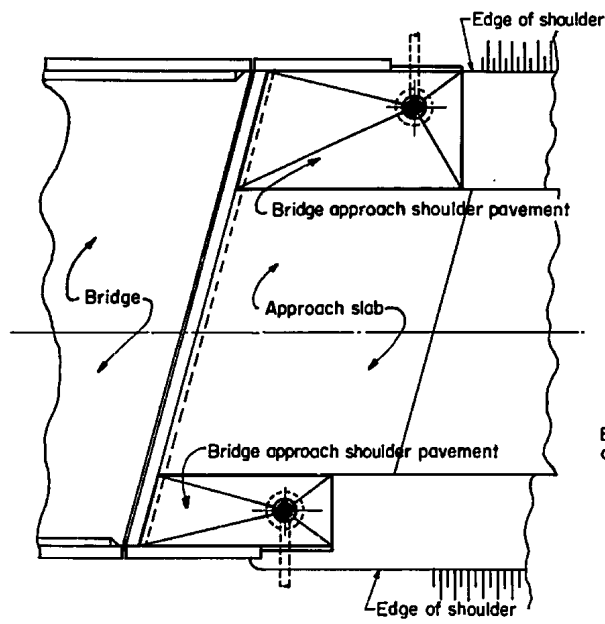


GENERAL PLAN


NOTE:
Use two inlets when the total drainage length is greater than 150 ft. and the structure has no deck drains.

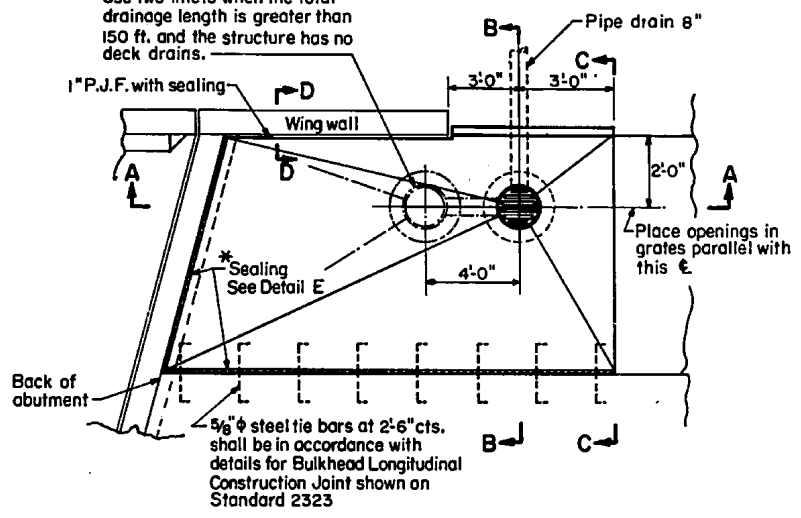


TYPICAL DETAIL PLAN

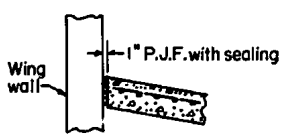


SECTION D-D

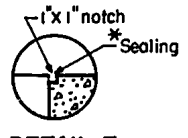


DETAIL E

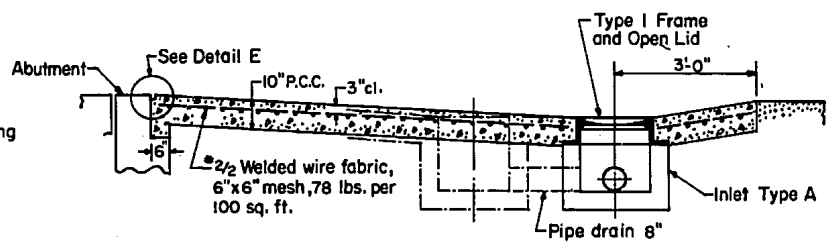

SECTION A-A

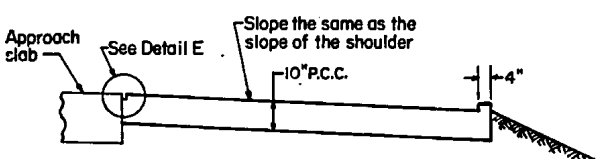

SECTION C-C

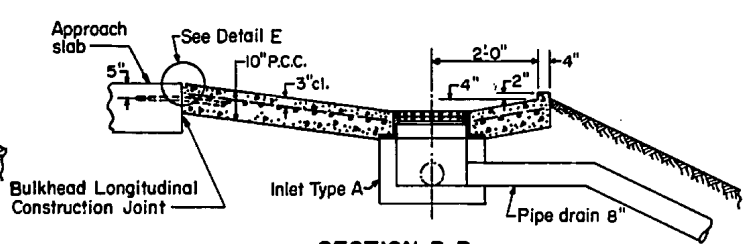


SECTION B-B


The material for Pipe Drains 8" shall be either corrugated steel or aluminum alloy pipe.
Inlets and pipe drains will be paid for in accordance with the Standard Specifications.
Bridge approach shoulder pavement will be measured in square yards and paid for as P.C. CONCRETE BRIDGE APPROACH SHOULDER PAVEMENT which shall include the cost of tie bars, reinforcement, joint fillers, and sealing.

GENERAL NOTES
* Where indicated, joints shall be sealed with two component, non-staining, gray, sealing compound with polysulfide liquid polymers, gun grade with primers.
See bridge approach slab plans for location of bridge approach shoulder pavement.
For placement of drainage elements on existing construction with existing rigid approach pavement, substitute expansion anchor bolts for tie bars. For non-rigid approaches, shoulder pavement will be as shown except omit tie bars and inside edge sealing.
For bridges with end posts partially or completely on superstructure, locate the center line of 8" drain pipe a minimum of 6 ft. behind the back of abutment measured as an extension of the outside superstructure edge. If end posts are completely on superstructure, use the outer 2' x 4" lip for full length of shoulder pavement.

STATE OF ILLINOIS		ISSUED 12-1-69
DEPARTMENT OF TRANSPORTATION		REVISIONS
PASSED	Aug. 1 1972	W.F. 12-1-69
<i>J. Shuler</i> Engineer of Road Plans and Contracts		W.F. 3-18-70
APPROVED	Aug. 1 1972	W.F. 8-1-72
<i>W. E. Bannerman</i> Engineer of Design		

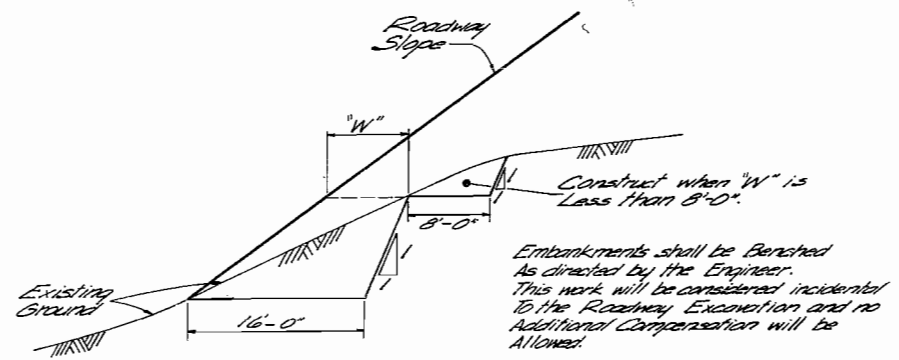


EMBankment Benching Detail

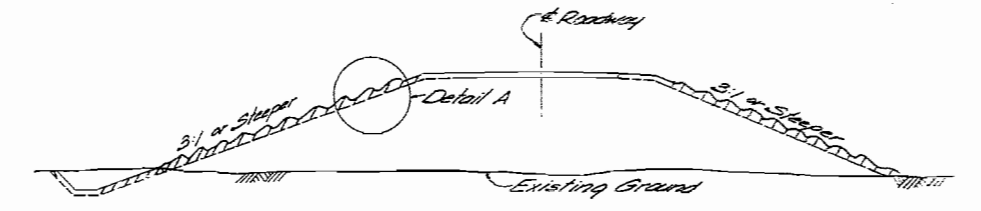

Class III Seeding
 Note: Class I seeding to be used Where the slope is flatter than 3:1.


Areas to be seeded for Class III Mixture shall be placed with 6" deep trenches approximately 3' on center parallel to the contour lines of the fill.

SEEDING DETAIL

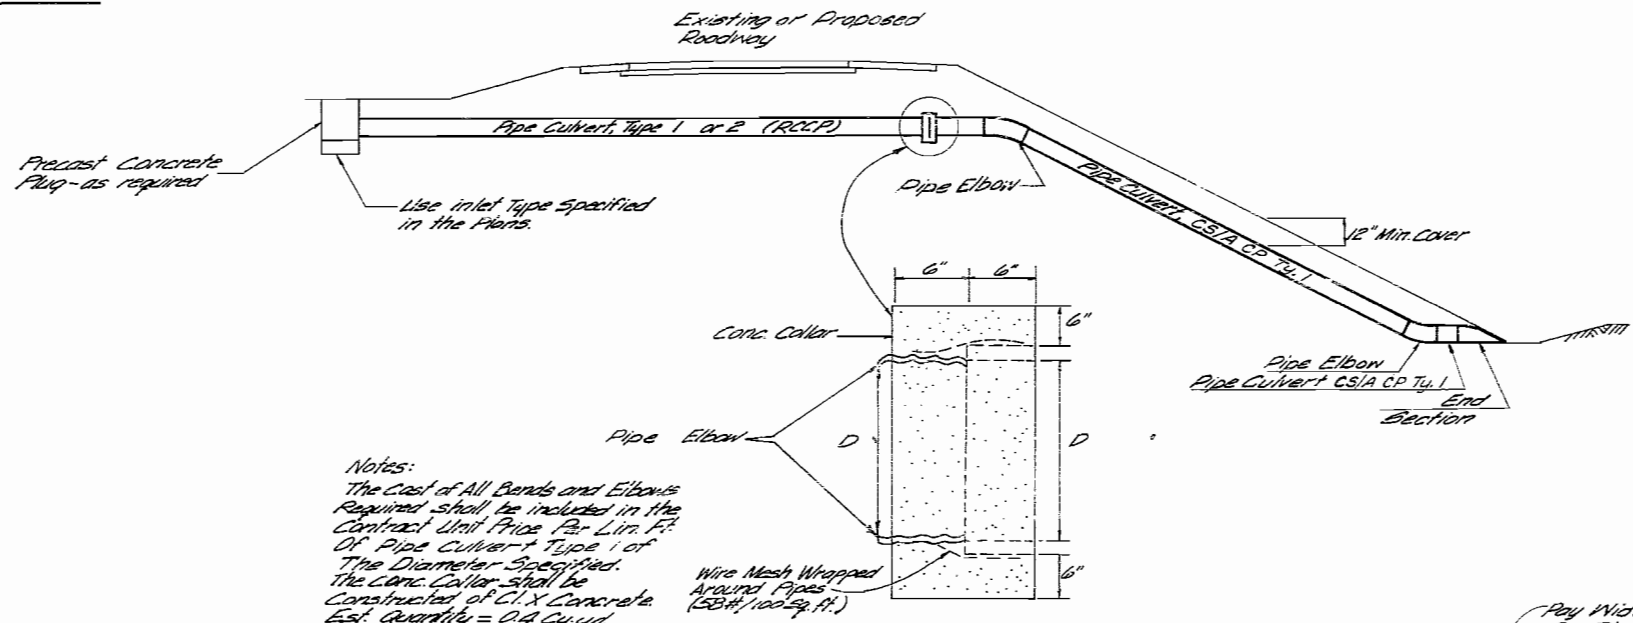


Notes:
 The Cost of All Bends and Elbows Required shall be included in the Contract Unit Price Per Lin. Ft. of Pipe Culvert Type 1 of the Diameter Specified.
 The Conc. Collar shall be Constructed of C.I. X Concrete. Est. Quantity = 0.14 Cu. Yds.
 The Cost of the Wire Mesh shall be Considered as Incidental to C.I. X Conc. and no additional compensation will be allowed.
 Pay Item: Cu. Yd. of C.I. X Concrete For Headwalls

DETAIL OF MEDIAN SLOPE DRAIN

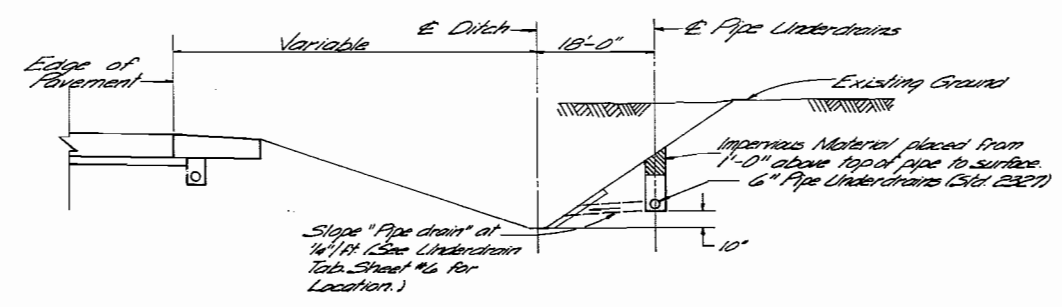


SUB-SURFACE DRAINAGE FOR SEEPAGE CONTROL
 SEE SHEET 7 FOR TABULATION

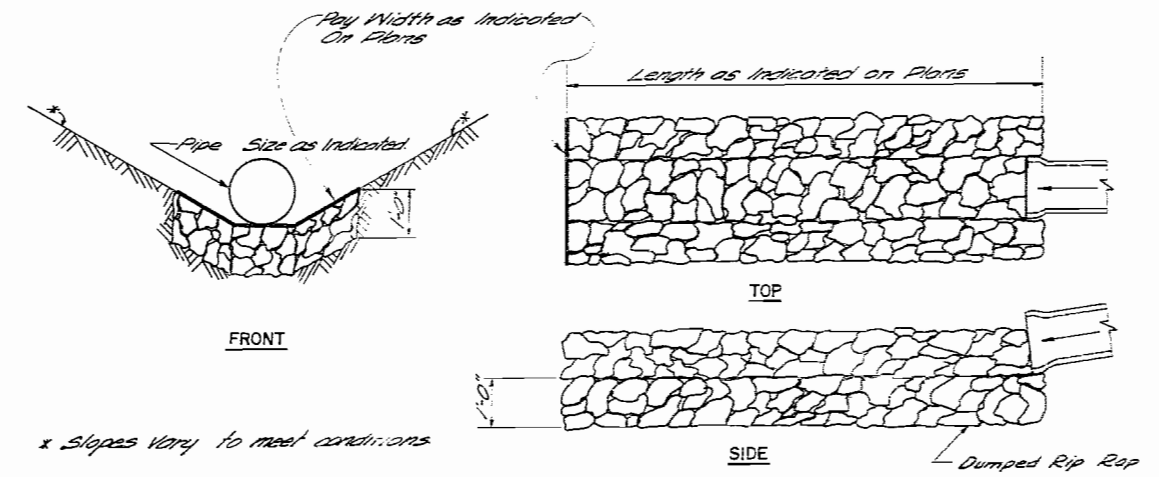

EROSION CONTROL OF CULVERT OUTLETS WITH DUMPED RIP RAP

MISCELLANEOUS DETAILS
 FAI-55 SECTION 57-10
 McLEAN COUNTY

150
 741-5557-10 MFL 224 175
 747 + 00 750 + 00

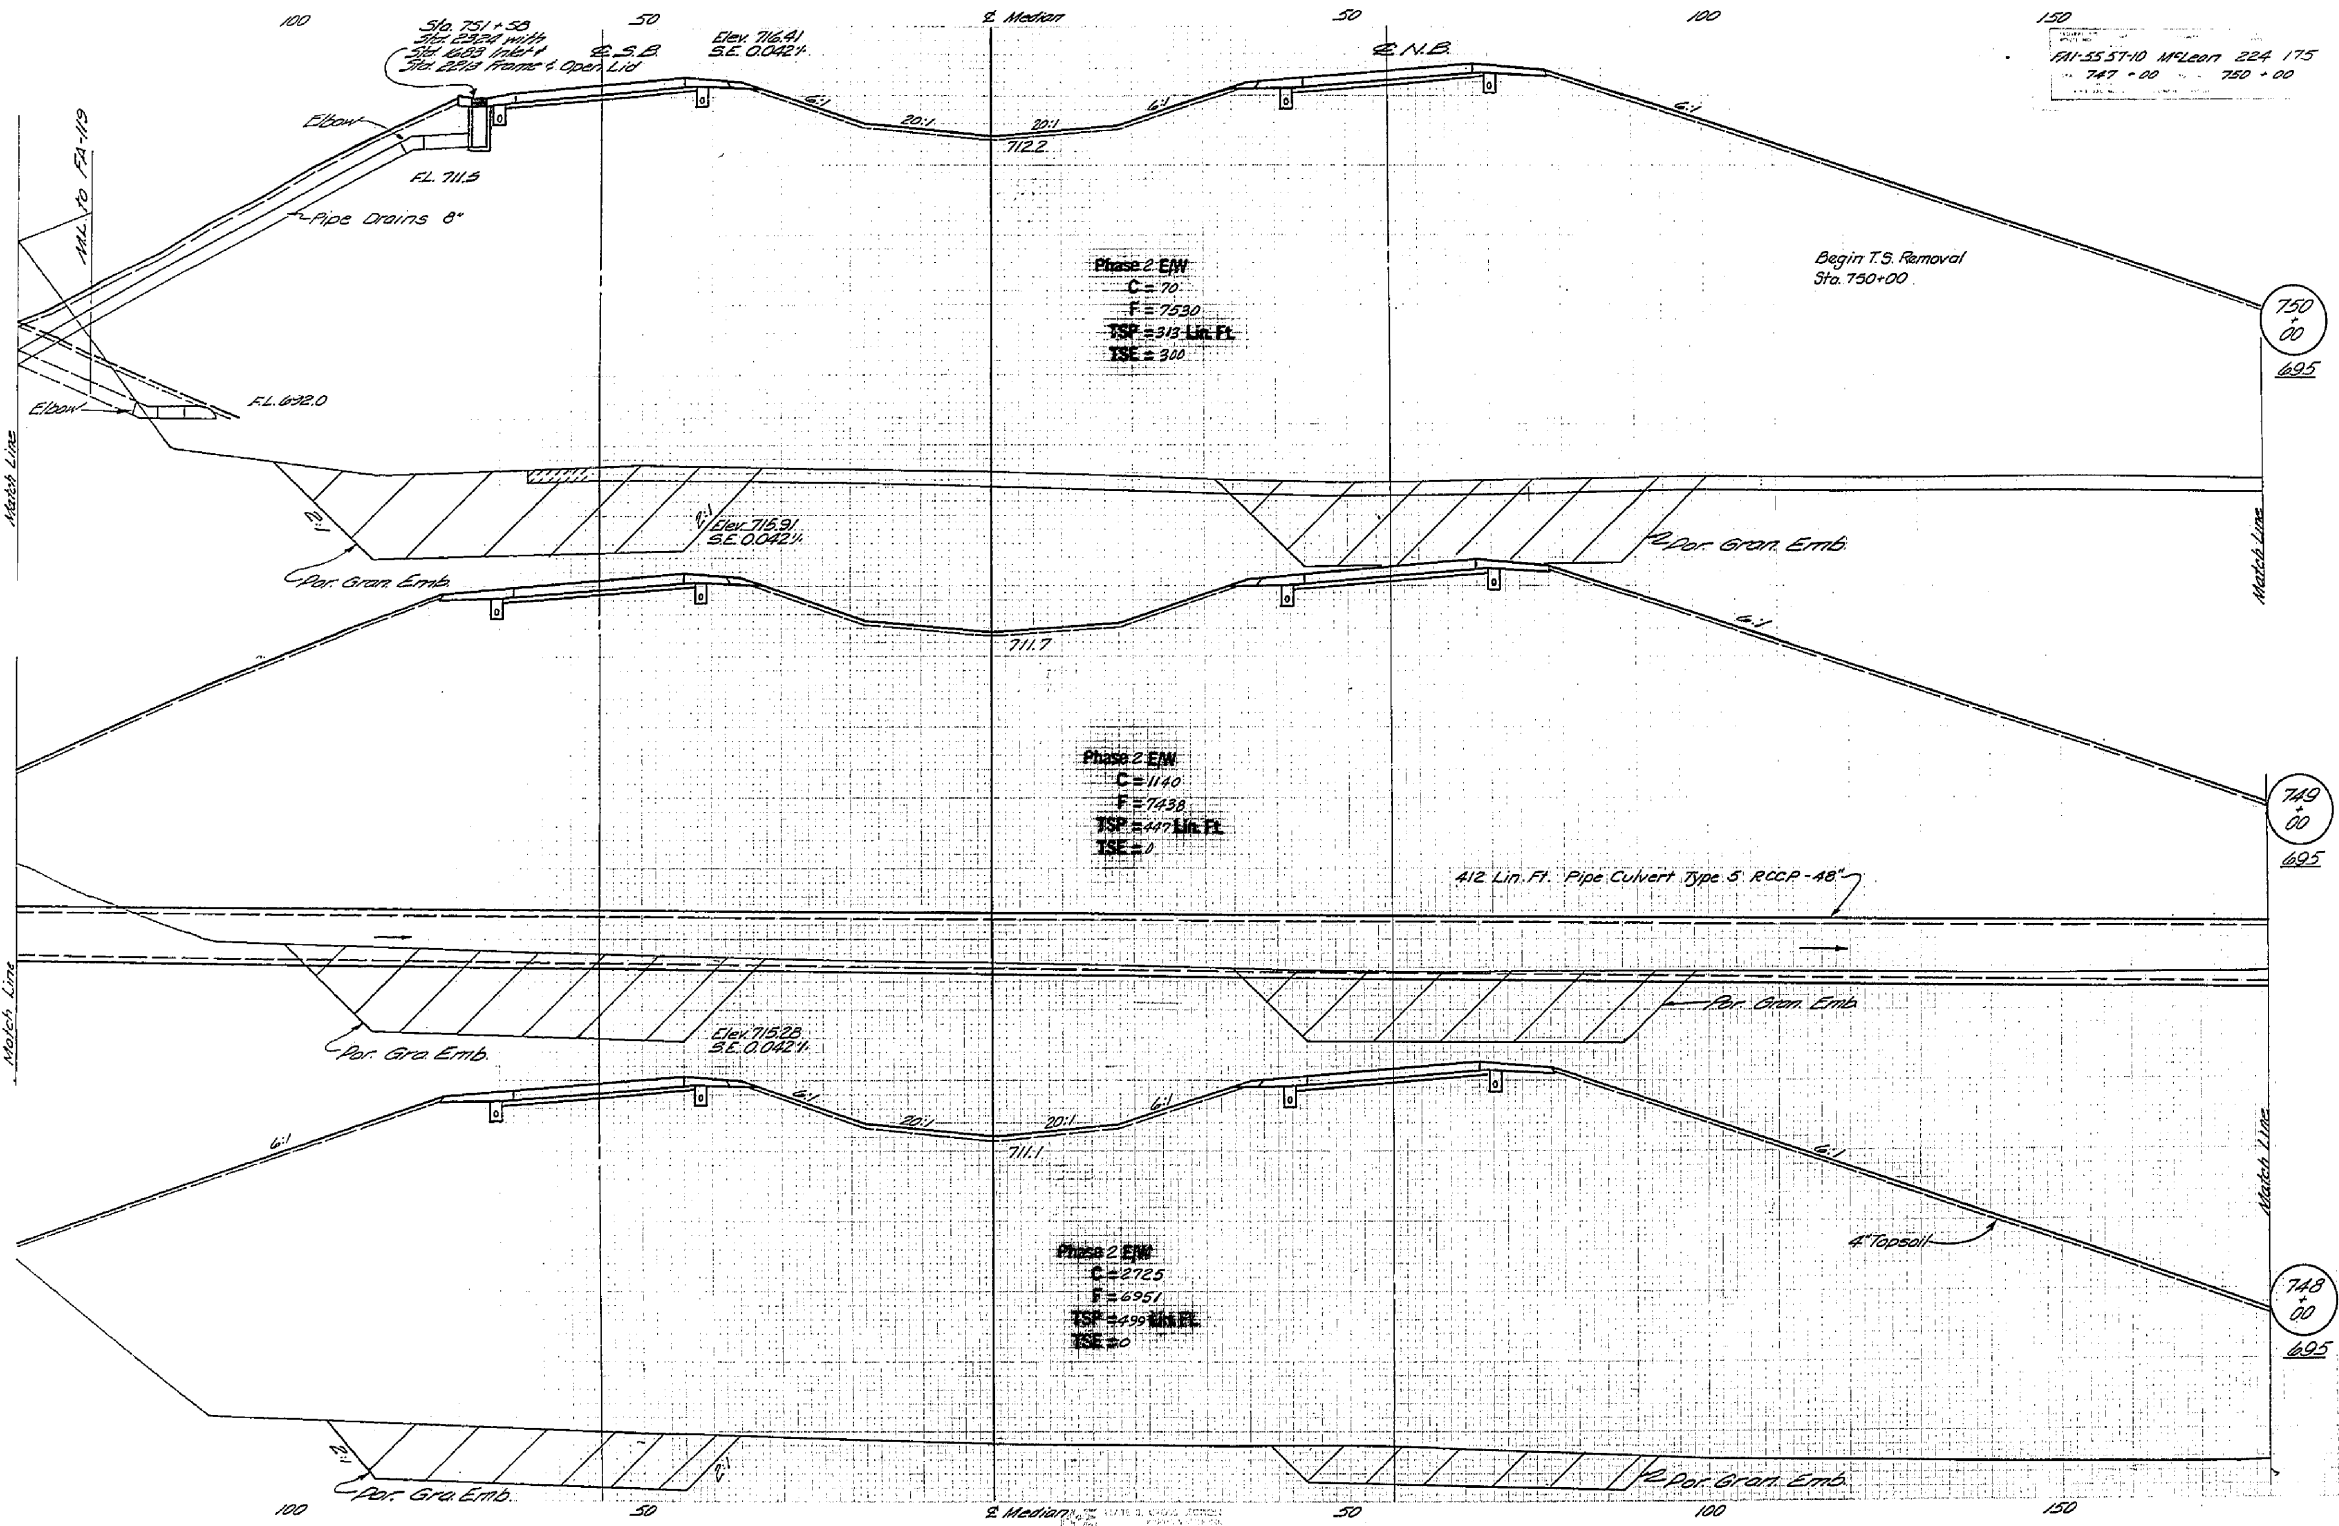

Sta. 751+50
 2' x 2' Frame & Open Lid
 Elev. 716.41
 S.E. 0.042%

Phase 2 EW
 C = 70
 F = 7530
 TSP = 313 Lin. Ft.
 TSE = 300

Begin T.S. Removal
 Sta. 750+00

Phase 2 EW
 C = 1140
 F = 7438
 TSP = 447 Lin. Ft.
 TSE = 1

412 Lin. Ft. Pipe Culvert Type 5 RCP - 48"


Phase 2 EW
 C = 2725
 F = 6951
 TSP = 499 Lin. Ft.
 TSE = 20

750
 + 00
 695

749
 + 00
 695

748
 + 00
 695

FH 155-57-10 McLean 224 176
 STA 746+00 750+00

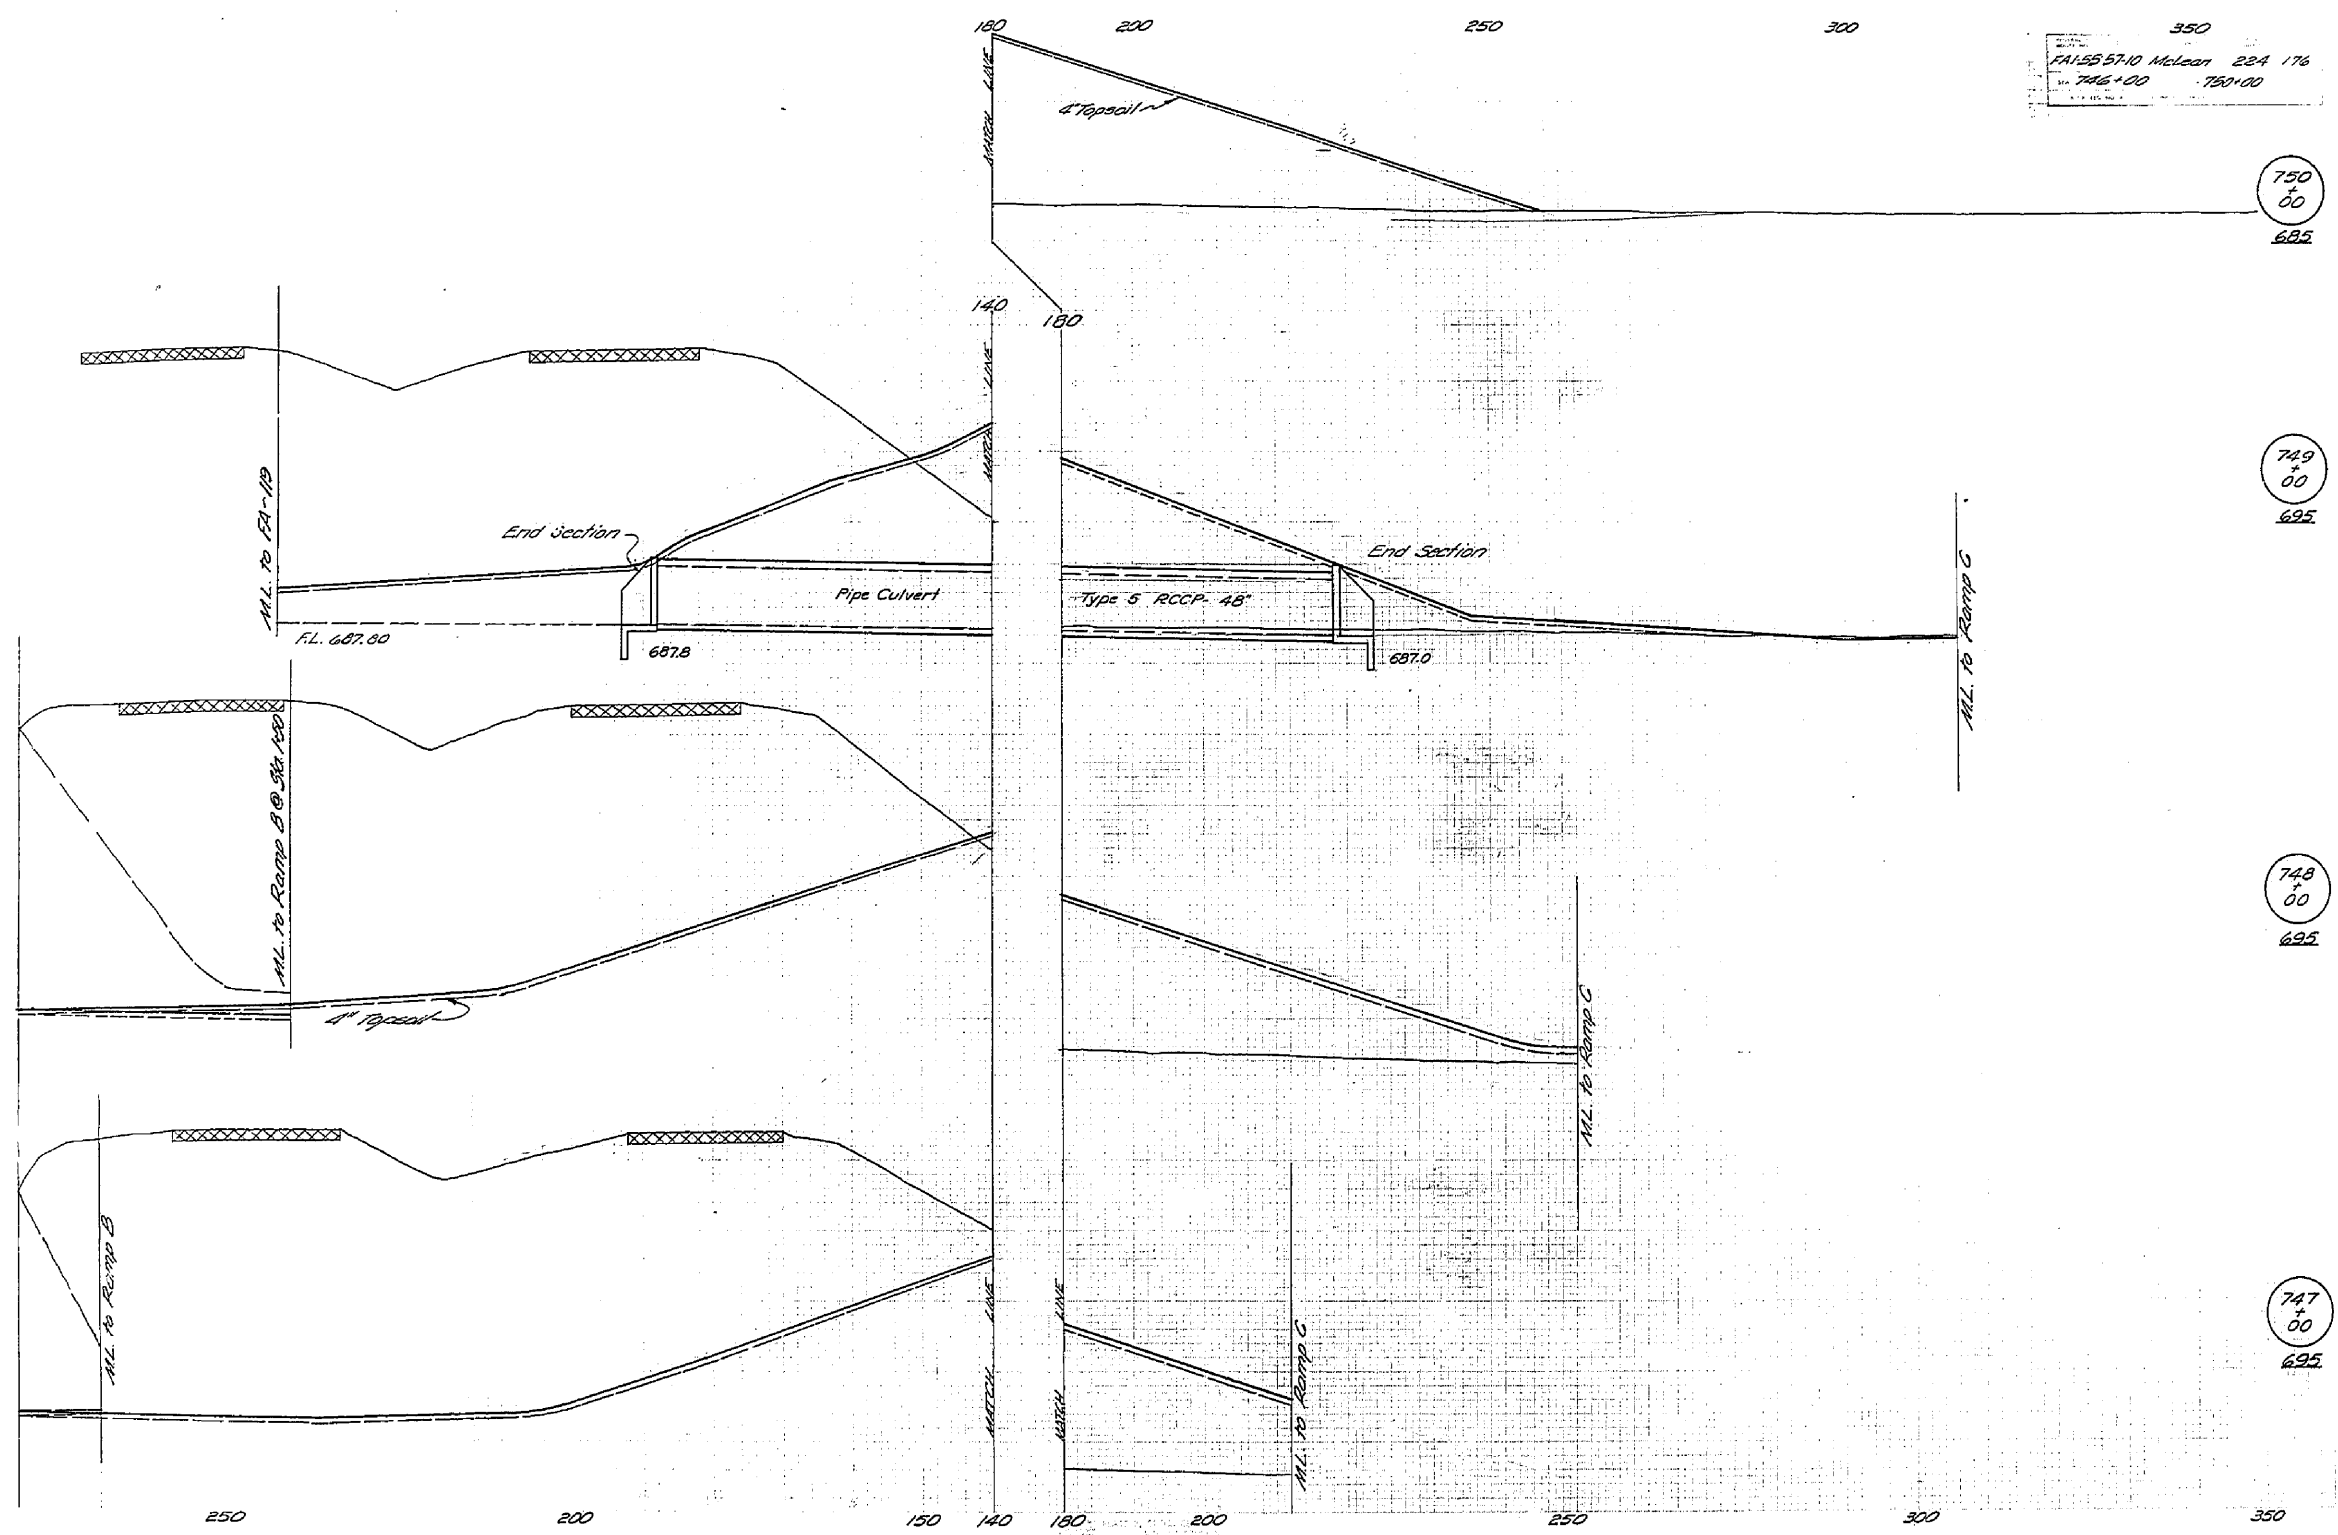

750
 +
 00
 695


749
 +
 00
 695

748
 +
 00
 695

747
 +
 00
 695

FH-55-57-10 M'Leann 224 177
 Sta. 750+00 753+00

End Unavailable Material Removal
 Sta. 753+00

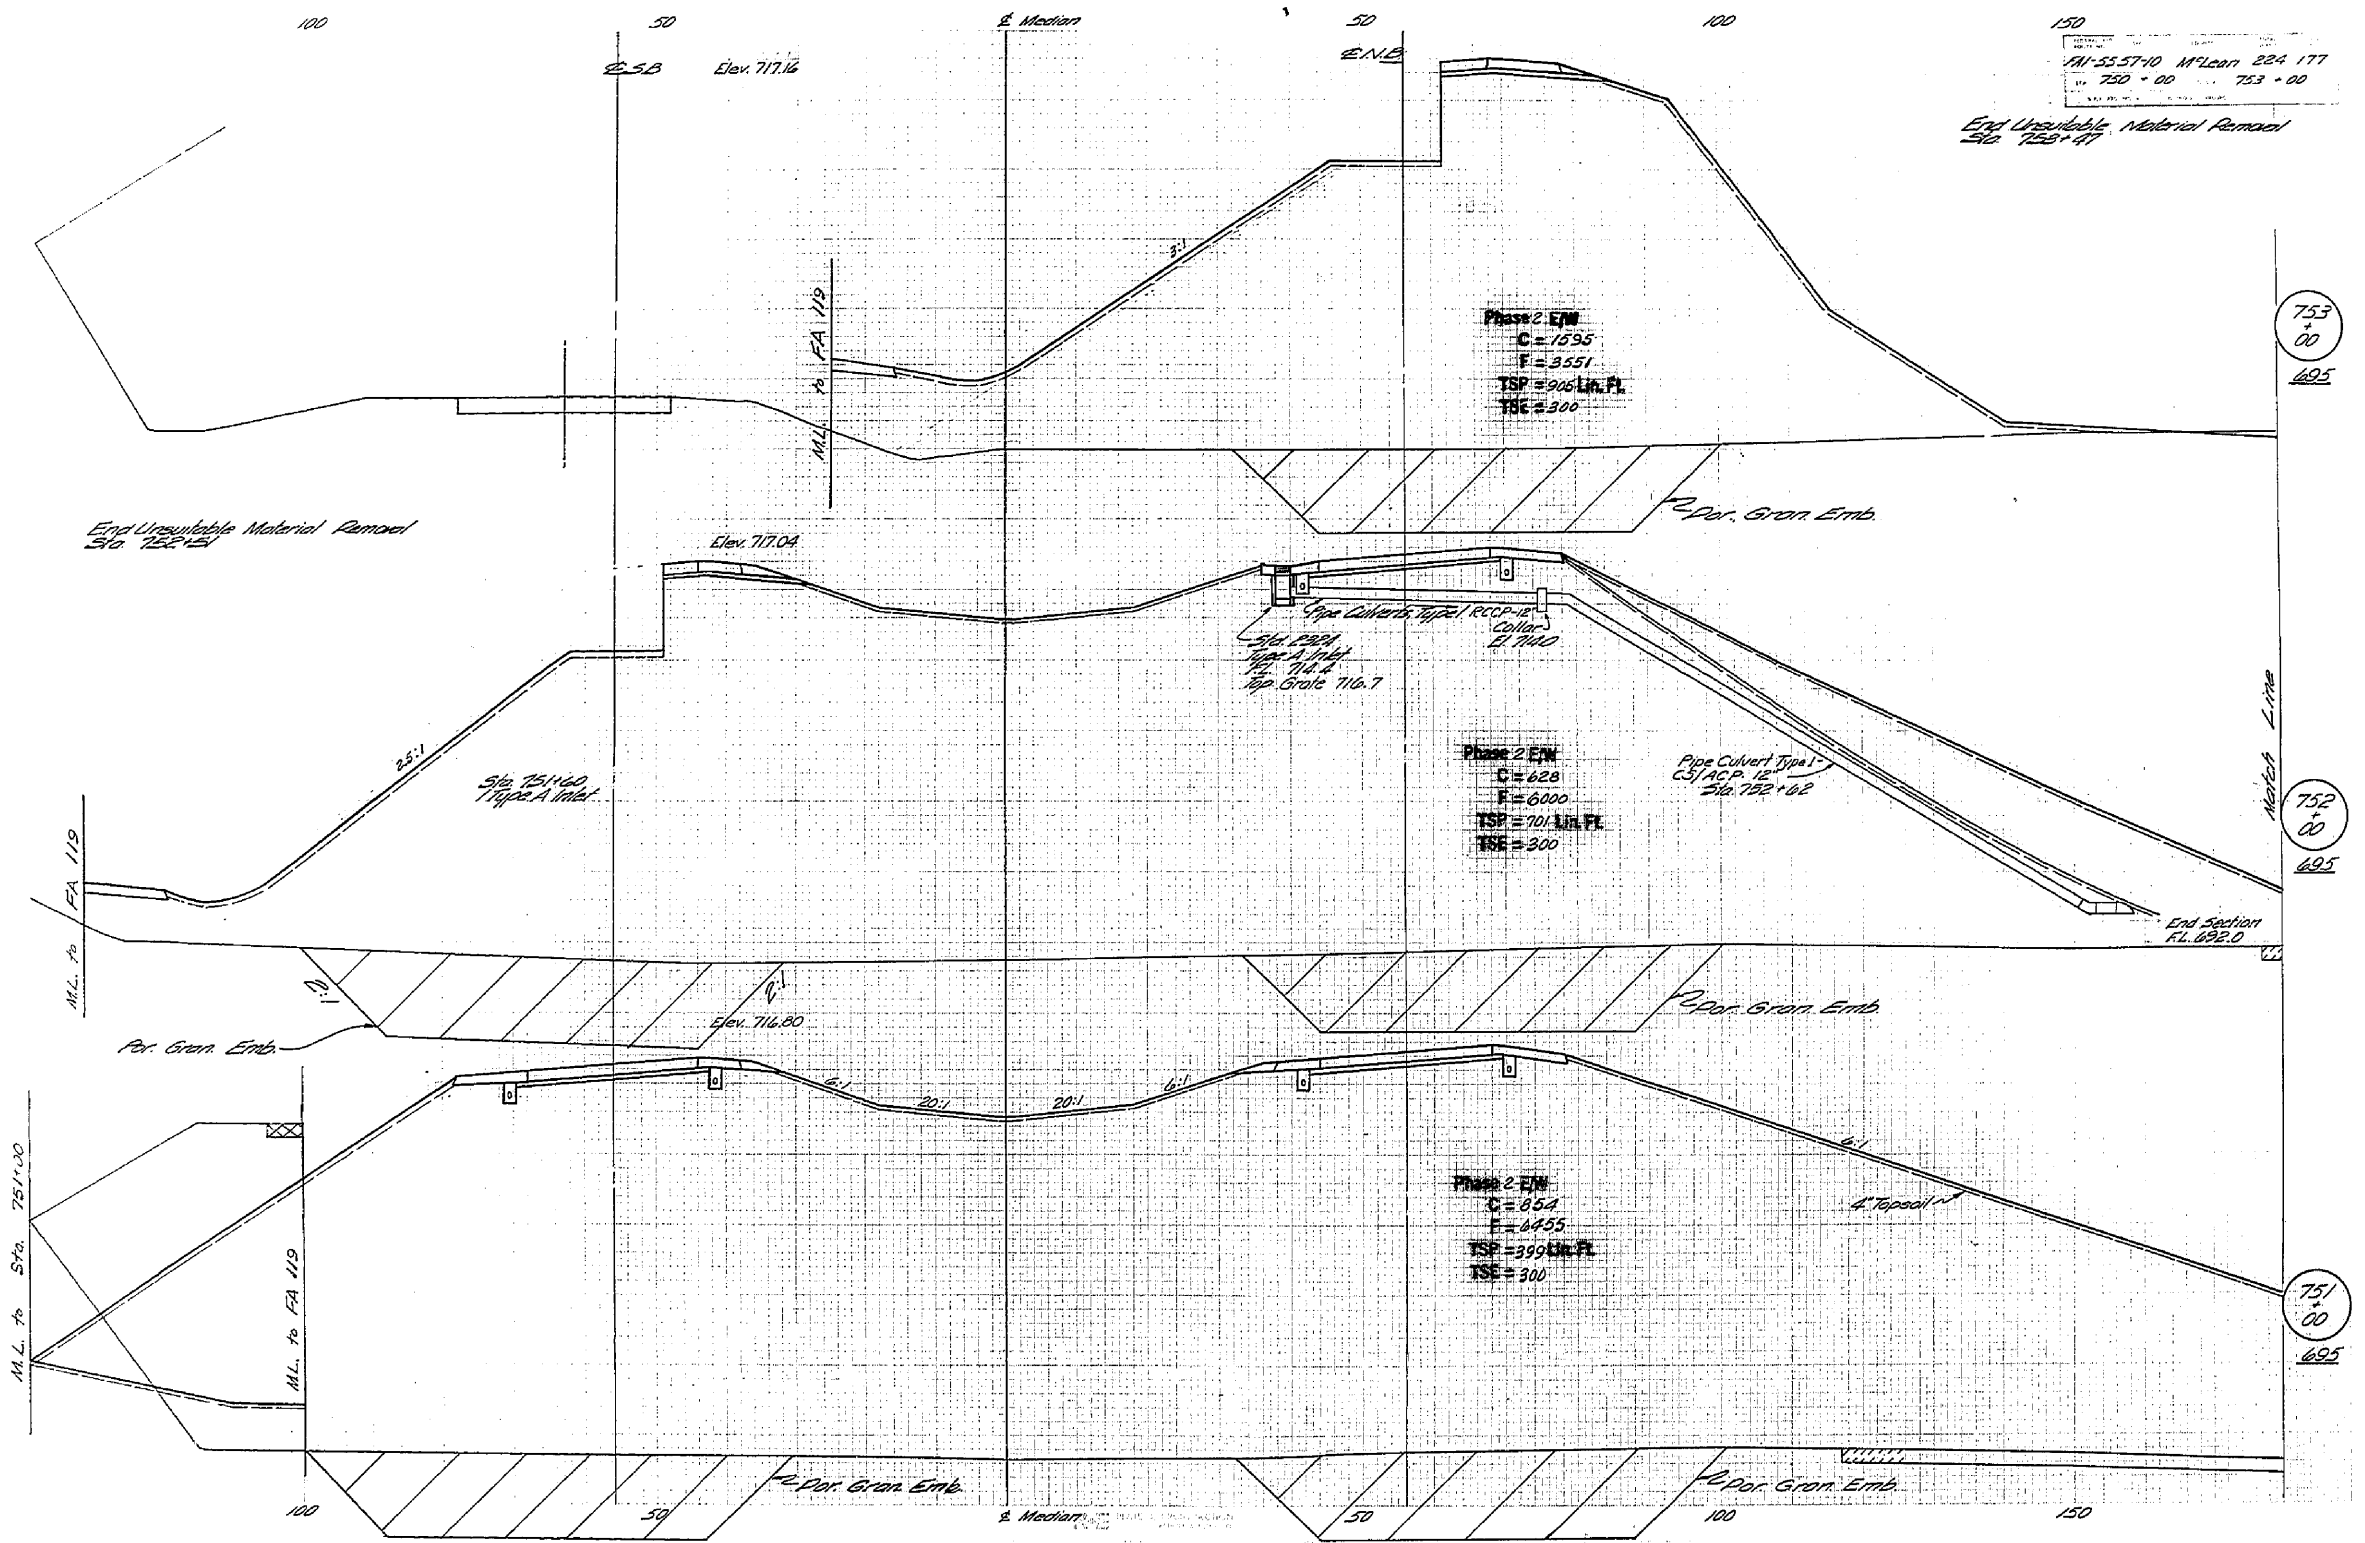

753+00
 695

752+00
 695

751+00
 695

200 150 100 50 0 50 100 130

FAI-55 57-10 McLean 224 175
12+00 14+43.44

INTERCHANGE INFIELD
EAST BASELINE

Sta. 14+43.44
416.63' Rt. =
755
00
695



Sta. 13+32.50
415.42' Rt. =
754
00
695

Sta. 12+21.72
415.42' Rt. =
753
00
700

Sta. 11+10.54
416.63' Rt. =
752
00
695

Sta. 10+00
418.26' Rt. =
751
00
680

Note:
Earthwork included
in Mainline (FAI-55)
Computations.

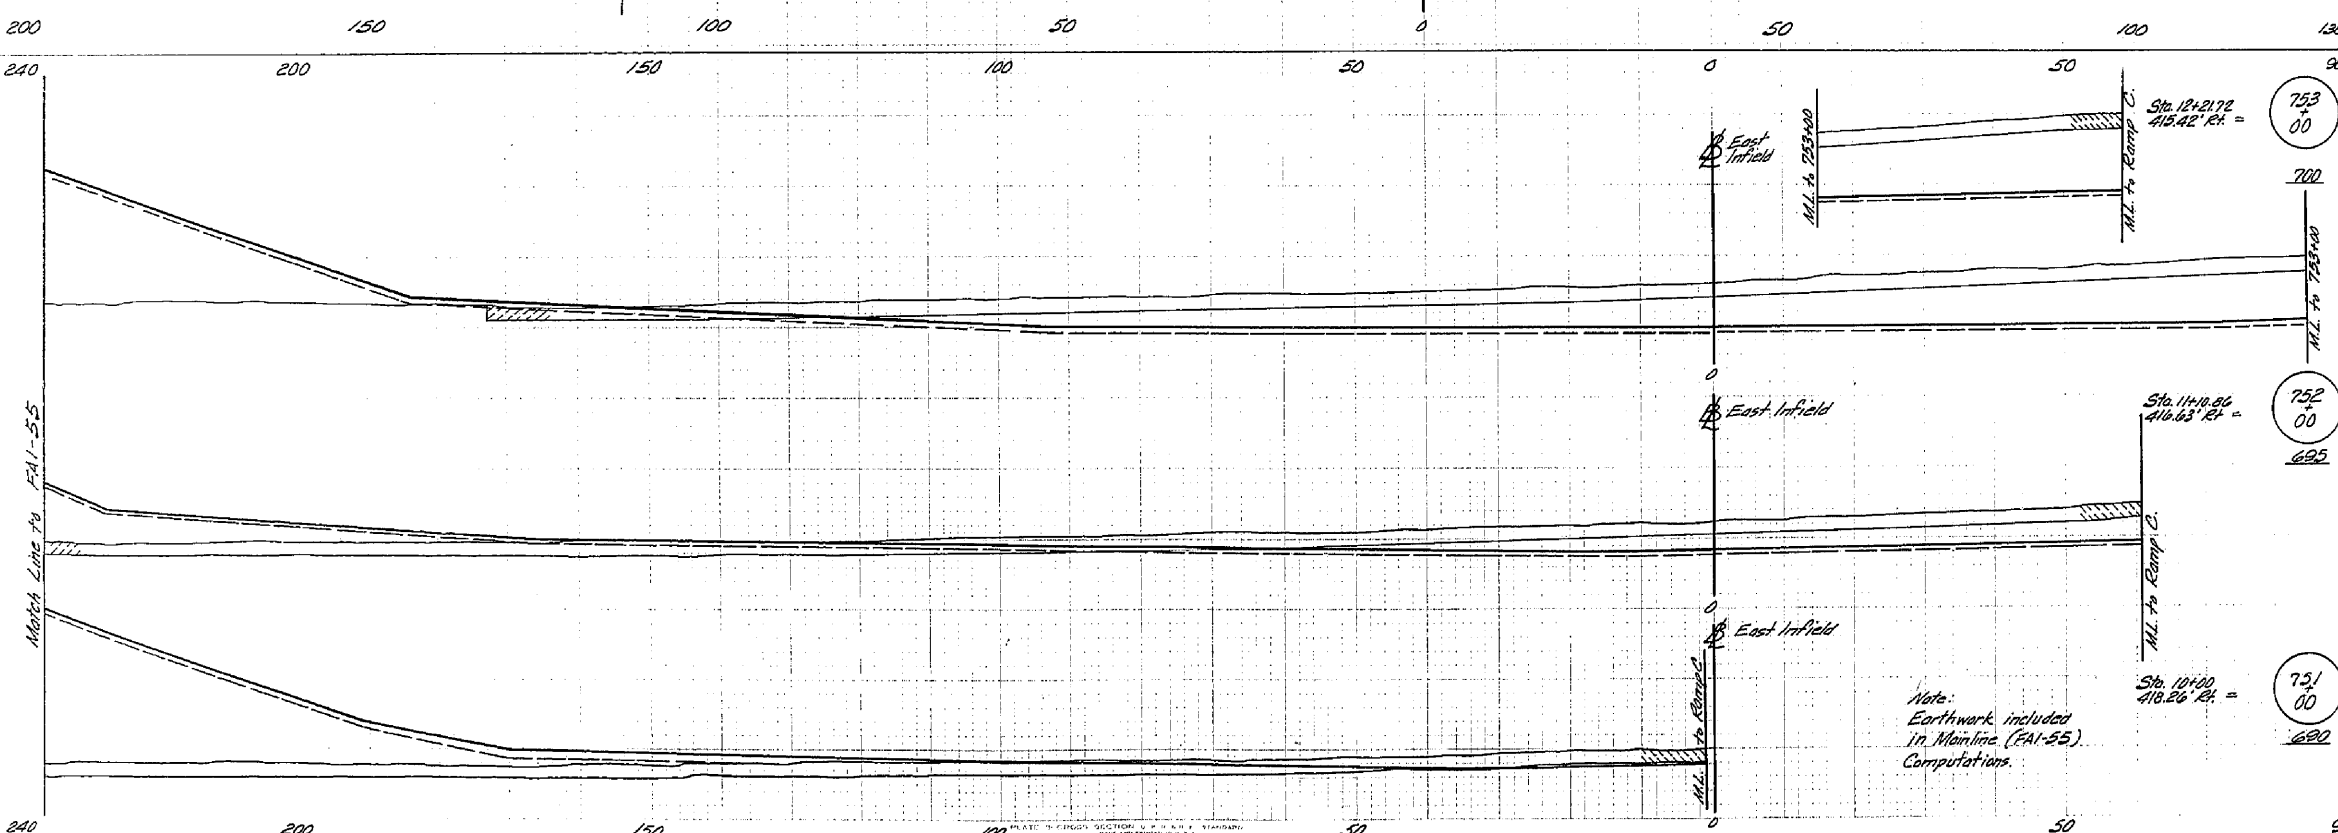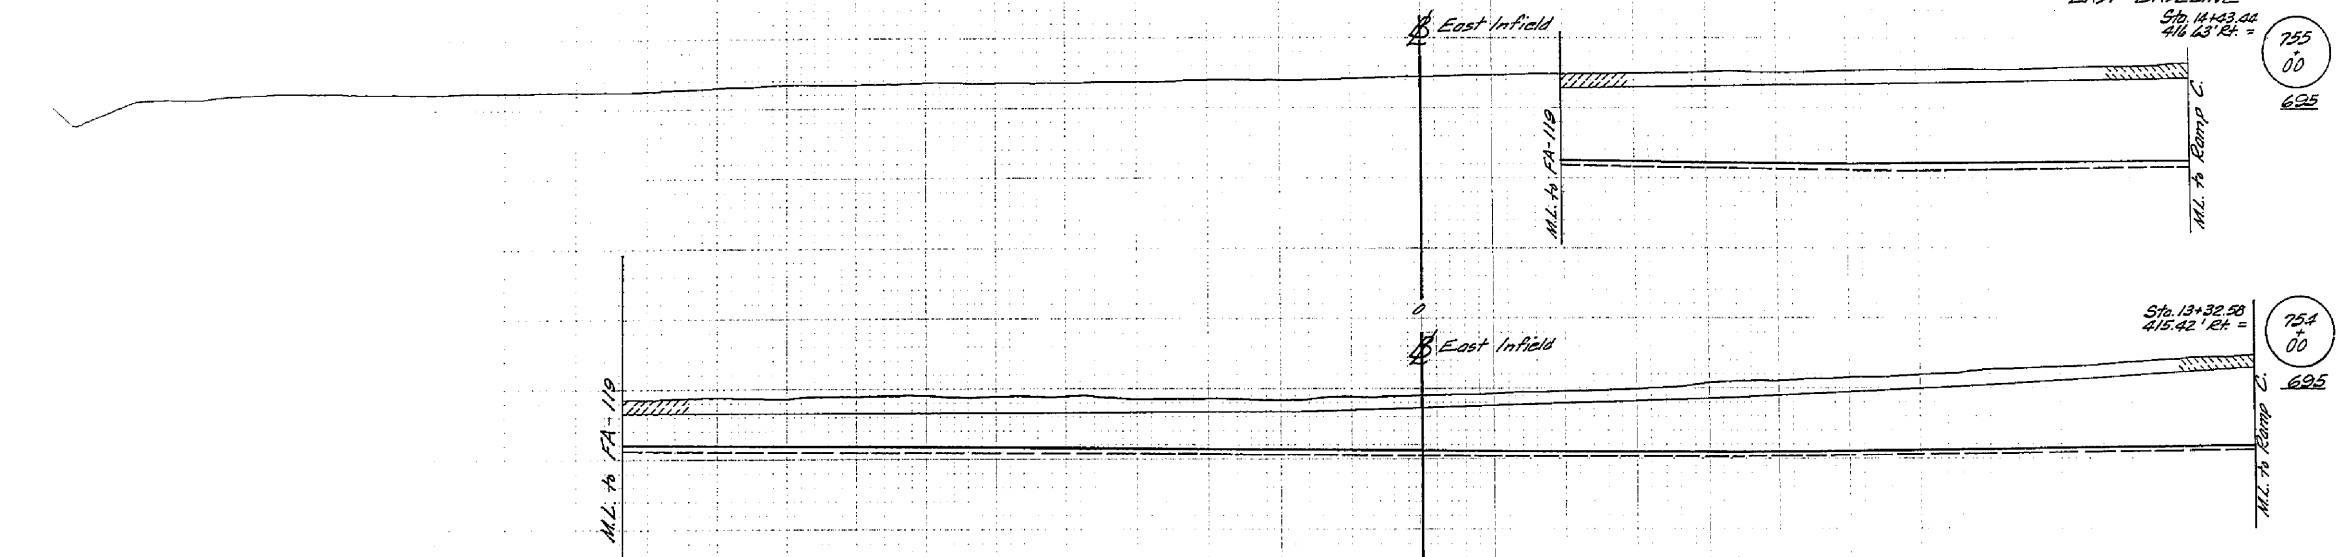

INTERCHANGE INFIELD
WEST BASELINE

FAI-55 ST-10 McLean 224 179
Sta. 0+00 3+50.76
S.A. 216.10 216.10



Sta. 3+50.76
471.03' Lt. =
755
00

Sta. 2+63.07 =
470.27' Lt. =
754
00

Sta. 1+75.38 =
470.27' Lt. =
753
00


Sta. 0+81.69 =
471.03' Lt. =
752
00

Sta. 0+00 - Sta. 751+00
472.06' Lt.


Note:
Earthwork included
in Mainline (FAI-55)
Computations.

FA-55 57-10 McLean 224 179A
41-30-85

INTERCHANGE INFIELD
WEST BASELINE

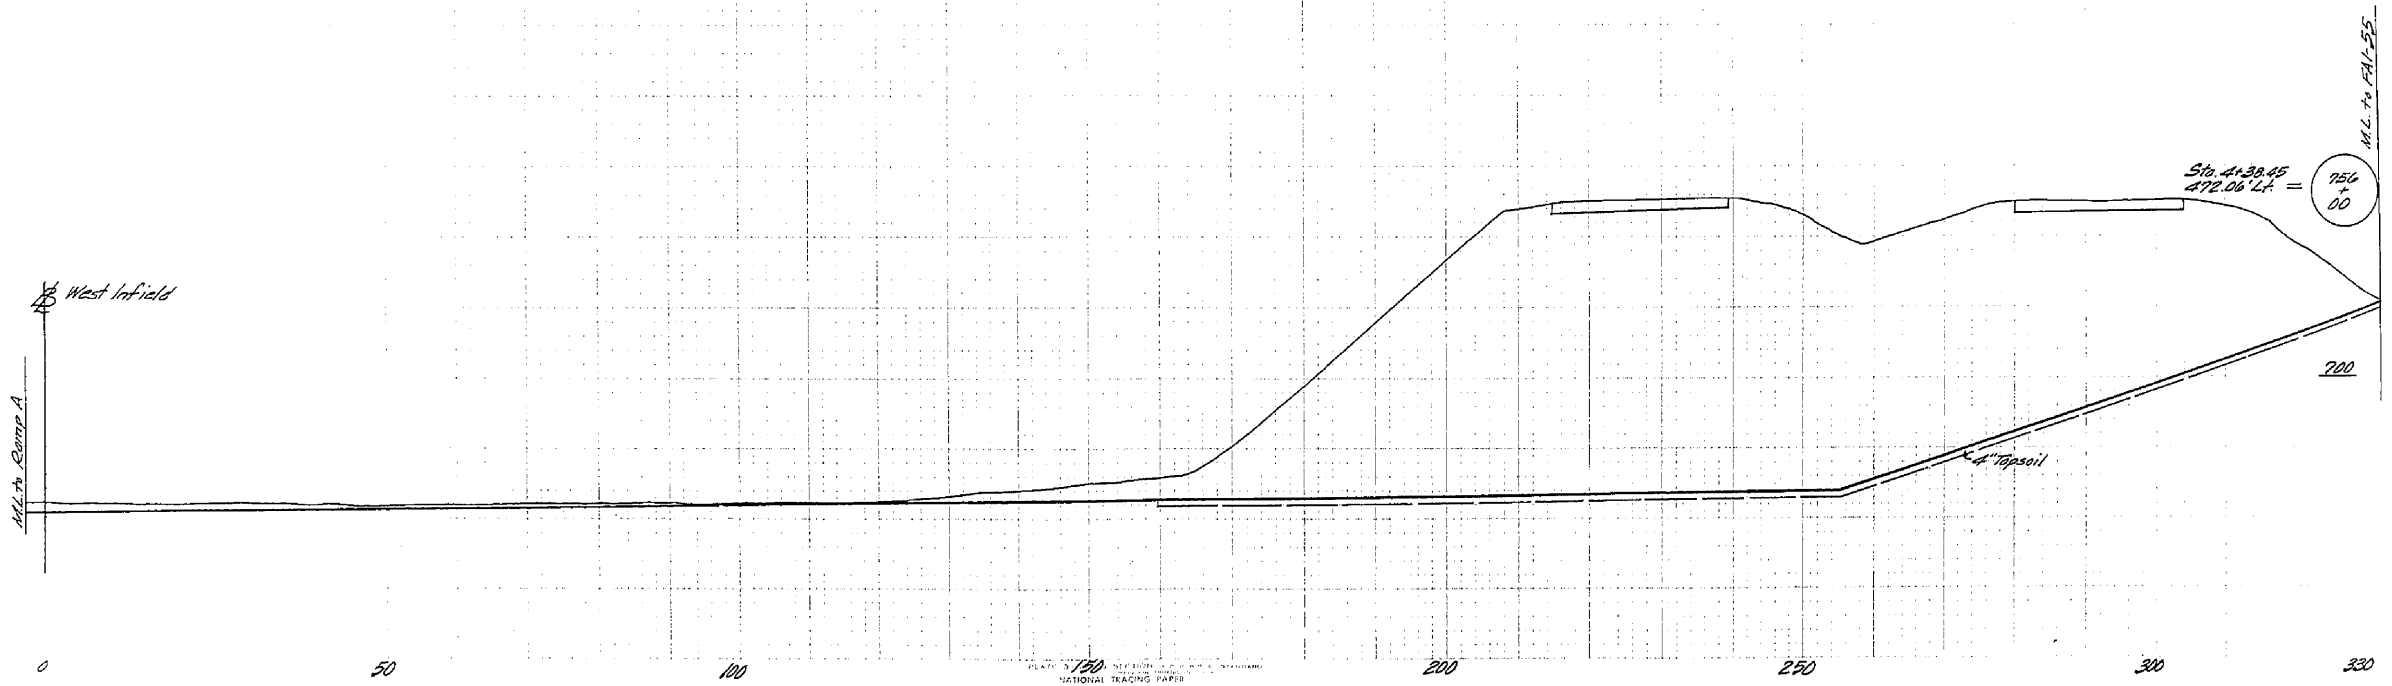

150
 PLAN NO. 11
 DATE 11/22/07
 PROJECT NO. 11-55-57-10 M¹ LEAD 224 180
 STA. 753+00 TO 756+00
 SHEET NO. 11

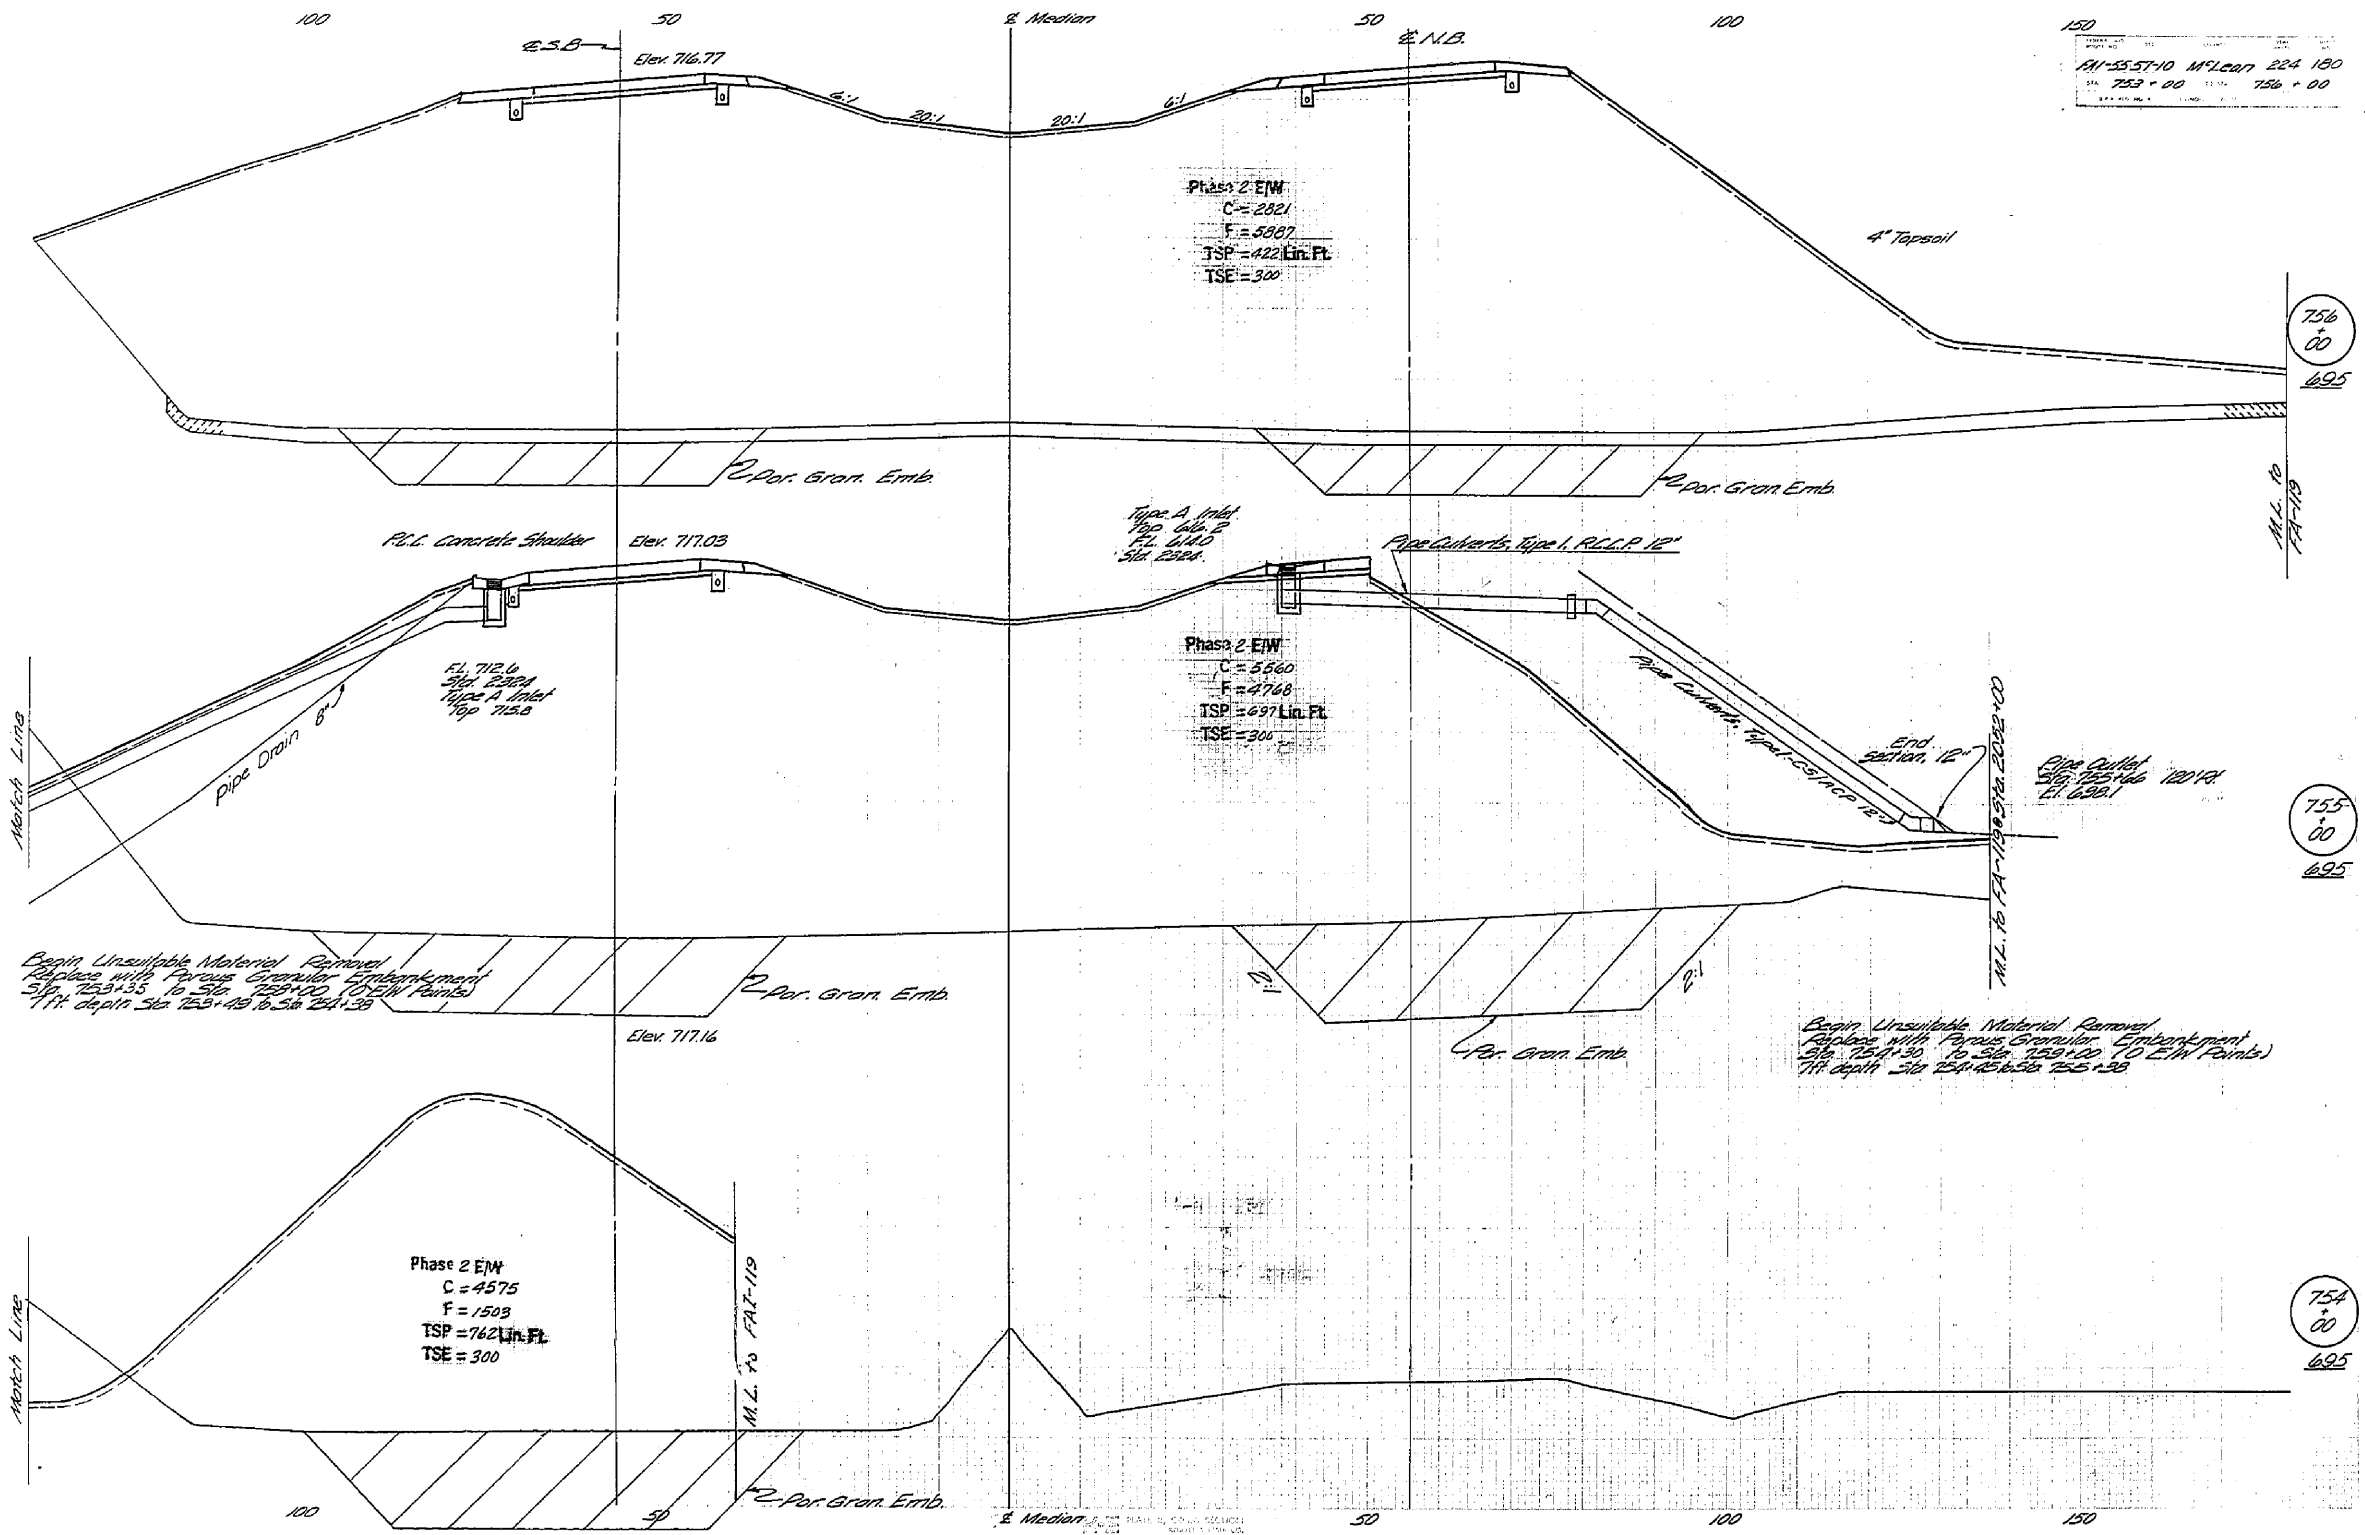

756
+
00
695

755
+
00
695

754
+
00
695