

80% FEDERAL  
20% STATE

80% FEDERAL  
20% STATE

SUMMARY OF QUANTITIES			TOTAL QUANTITIES	CONSTRUCTION TYPE CODE	
CODE NO	ITEM	UNIT		0005 SHELBY	0005 CUMBERLAND
20200600	EXCAVATING AND GRADING EXISTING SHOULDER	UNIT	50	28	22
20201200	REMOVAL AND DISPOSAL OF UNSUITABLE MATERIAL	CU YD	22	22	
20700220	POROUS GRANULAR EMBANKMENT	CU YD	82	82	
28100107	STONE RIPRAP, CLASS A4	SO YD	29	29	
28200200	FILTER FABRIC	SO YD	29	29	
40600290	BITUMINOUS MATERIALS (TACK COAT)	POUND	84851	50172	34679
40600645	LEVELING BINDER (MACHINE METHOD), N90	TON	4518	2662	1856
40600982	HOT-MIX ASPHALT SURFACE REMOVAL - BUTT JOINT	SO YD	1114	642	472
40600990	TEMPORARY RAMP	SO YD	67	12	55
40603320	HOT-MIX ASPHALT SURFACE COURSE, MIX "C", N90	TON	11314	6699	4615
40800050	INCIDENTAL HOT-MIX ASPHALT SURFACING	TON	289	171	118
42400300	PORTLAND CEMENT CONCRETE SIDEWALK 6 INCH	SO FT	3834	2273	1501
42400800	DETECTABLE WARNINGS	SO FT	379	254	125
<del>44000100</del>	<del>PAVEMENT REMOVAL</del>	<del>SO YD</del>	<del>15</del>		<del>15</del>

SUMMARY OF QUANTITIES			TOTAL QUANTITIES	CONSTRUCTION TYPE CODE	
CODE NO	ITEM	UNIT		0005 SHELBY	0005 CUMBERLAND
44000152	HOT-MIX ASPHALT SURFACE REMOVAL, 3/4"	SO YD	24455	15393	9062
44000155	HOT-MIX ASPHALT SURFACE REMOVAL, 1 1/2"	SO YD	94140	58641	35499
44000158	HOT-MIX ASPHALT SURFACE REMOVAL, 2 1/4"	SO YD	16756	6227	10529
44000200	DRIVEWAY PAVEMENT REMOVAL	SO YD	13		13
44000500	COMBINATION CURB AND GUTTER REMOVAL	FOOT	183		183
44000600	SIDEWALK REMOVAL	SO FT	2750	1132	1618
44201798	CLASS D PATCHES, TYPE I, 13 INCH	SO YD	16		16
44201803	CLASS D PATCHES, TYPE II, 13 INCH	SO YD	1051	461	590
44201807	CLASS D PATCHES, TYPE III, 13 INCH	SO YD	116	76	40
44201809	CLASS D PATCHES, TYPE IV, 13 INCH	SO YD	739	71	668
44201833	CLASS D PATCHES, TYPE IV, 15 INCH	SO YD	62	62	
48102100	AGGREGATE WEDGE SHOULDER, TYPE B	TON	722	432	290
48203023	HOT-MIX ASPHALT SHOULDERS, 6 1/2"	SO YD	1670	939	731
54001001	BOX CULVERT END SECTIONS, CULVERT NO. 1	EACH	2	2	

14

14

REV. 2-14-2017

80% FEDERAL  
20% STATE

80% FEDERAL  
20% STATE

SUMMARY OF QUANTITIES			CONSTRUCTION TYPE CODE		
CODE NO	ITEM	UNIT	TOTAL QUANTITIES	0005 SHELBY	0005 CUMBERLAND
54010403	PRECAST CONCRETE BOX CULVERTS 4' X 3'	FOOT	44	44	
60603800	COMBINATION CONCRETE CURB AND GUTTER, TYPE B-6.12	FOOT	142		142
60605000	COMBINATION CONCRETE CURB AND GUTTER, TYPE B-6.24	FOOT	53		53
64200108	SHOULDER RUMBLE STRIPS, 8 INCH	FOOT	71971	45510	26461
67000500	ENGINEER'S FIELD OFFICE, TYPE B	CAL MO	4	2	2
67100100	MOBILIZATION	LSUM	1	0.5	0.5
70100450	TRAFFIC CONTROL AND PROTECTION, STANDARD 701201	LSUM	1	0.5	0.5
70100460	TRAFFIC CONTROL AND PROTECTION, STANDARD 701306	LSUM	1	0.5	0.5
70100500	TRAFFIC CONTROL AND PROTECTION, STANDARD 701326	LSUM	1	0.5	0.5
70102640	TRAFFIC CONTROL AND PROTECTION, STANDARD 701801	LSUM	1	0.5	0.5
70103815	TRAFFIC CONTROL SURVEILLANCE	CAL DA	14	7	7

SUMMARY OF QUANTITIES			CONSTRUCTION TYPE CODE		
CODE NO	ITEM	UNIT	TOTAL QUANTITIES	0005 SHELBY	0005 CUMBERLAND
70300100	SHORT TERM PAVEMENT MARKING	FOOT	12921	7714	5207
70300150	SHORT TERM PAVEMENT MARKING REMOVAL	SO FT	1436	857	579
78000100	THERMOPLASTIC PAVEMENT MARKING - LETTERS AND SYMBOLS	SO FT	122		122
78000200	THERMOPLASTIC PAVEMENT MARKING - LINE 4"	FOOT	12705	5166	7539
78000400	THERMOPLASTIC PAVEMENT MARKING - LINE 6"	FOOT	316	48	268
78000600	THERMOPLASTIC PAVEMENT MARKING - LINE 12"	FOOT	48	48	
78000650	THERMOPLASTIC PAVEMENT MARKING - LINE 24"	FOOT	122		122
78001110	PAINT PAVEMENT MARKING - LINE 4"	FOOT	87220	54926	32294
78100100	RAISED REFLECTIVE PAVEMENT MARKER	EACH	538	321	217
X1200050	BOX CULVERT REMOVAL	FOOT	46	46	
X4060995	TEMPORARY RAMP, SPECIAL	SO YD	752	449	303
X7015005	CHANGEABLE MESSAGE SIGN	CAL DA	28	14	14
X7830060	GROOVING FOR RECESSED PAVEMENT MARKING, LETTERS AND SYMBOLS	SO FT	122		122

\* SPECIALTY ITEM

REV. 2-14-2017


ADA RAMP SCHEDULE			SIDEWALK REMOVAL	COMBINATION CURB AND CUTTER REMOVAL	PAVEMENT REMOVAL	DRIVEWAY PAVEMENT REMOVAL	COMBINATION CURB AND CUTTER, TYPE B-6.12	COMBINATION CURB AND CUTTER, TYPE B-6.24	DETECTABLE WARNINGS	PORTLAND CEMENT CONCRETE SIDEWALK 6"
LOCATION			SO FT	FT	SO YD	SO YD	FT	SO FT	SO FT	SO FT
TOWN	STREET	QUADRANT								
SIGEL	CENTRAL	NE	47	-	-	-	-	-	17	119
		SE	175	-	-	-	-	-	20	226
		NW	147	-	-	-	-	-	20	205
		SW	56	-	-	-	-	-	20	276
SIGEL	WASHINGTON	NE	133	-	-	-	-	-	21	190
		SE	25	-	-	-	-	-	20	166
		NW	65	-	-	-	-	-	20	172
		SW	163	-	-	-	-	-	20	216
SIGEL	LOUIS	NE	76	-	-	-	-	-	20	109
		SE	69	-	-	-	-	-	20	124
		NW	67	-	-	-	-	-	16	160
		SW	30	-	-	-	-	-	20	174
SIGEL	HOFFMAN	NE	79	-	-	-	-	20	136	
SHELBY CO TOTALS:			1132	0	0	0	0	254	2273	
NEOGA	SIXTH	NE	332	62	-	-	74	-	9	348
		SE	311	41	-	-	41	-	16	311
		NW	98	37	-	13	-	37	10	102
		SW	89	16	-	-	-	16	20	96
NEOGA	SEVENTH	NE	222	-	-	-	-	-	20	100
		SE	202	27	-	-	27	-	20	202
		NW	175	-	-	-	-	-	15	212
		SW	189	-	-	-	-	-	15	190
CUMBERLAND CO TOTALS:			1618	183	13	142	53	125	1561	
JOB TOTALS:			2750	183	13	142	53	379	3834	

REV. 2-14-2017

FILE NAME: p:\1108481\BID\PEG, Illinois.gov\WIDOT\Documents\DDT_Offices\District 7\Projects\746	USER NAME: steffannk	DESIGNED: -	REVISED: -	<b>STATE OF ILLINOIS DEPARTMENT OF TRANSPORTATION</b>	<b>SCHEDULE OF QUANTITIES</b>				F.A.S. RTE. 1652	SECTION (13,14,14-12IRS-4)	COUNTY *	TOTAL SHEETS 33	SHEET NO. 10			
Default	Default	DRAWN: (a) (c) sheets\0774693-sht-schedule	REVISED: -						SCALE:	SHEET	OF	SHEETS	STA.	TO	STA.	CONTRACT NO. 74693
		CHECKED: -	REVISED: -						ILLINOIS FED. AID PROJECT							
		DATE: -	REVISED: -						* CUMBERLAND, SHELBY							



U.S. 45

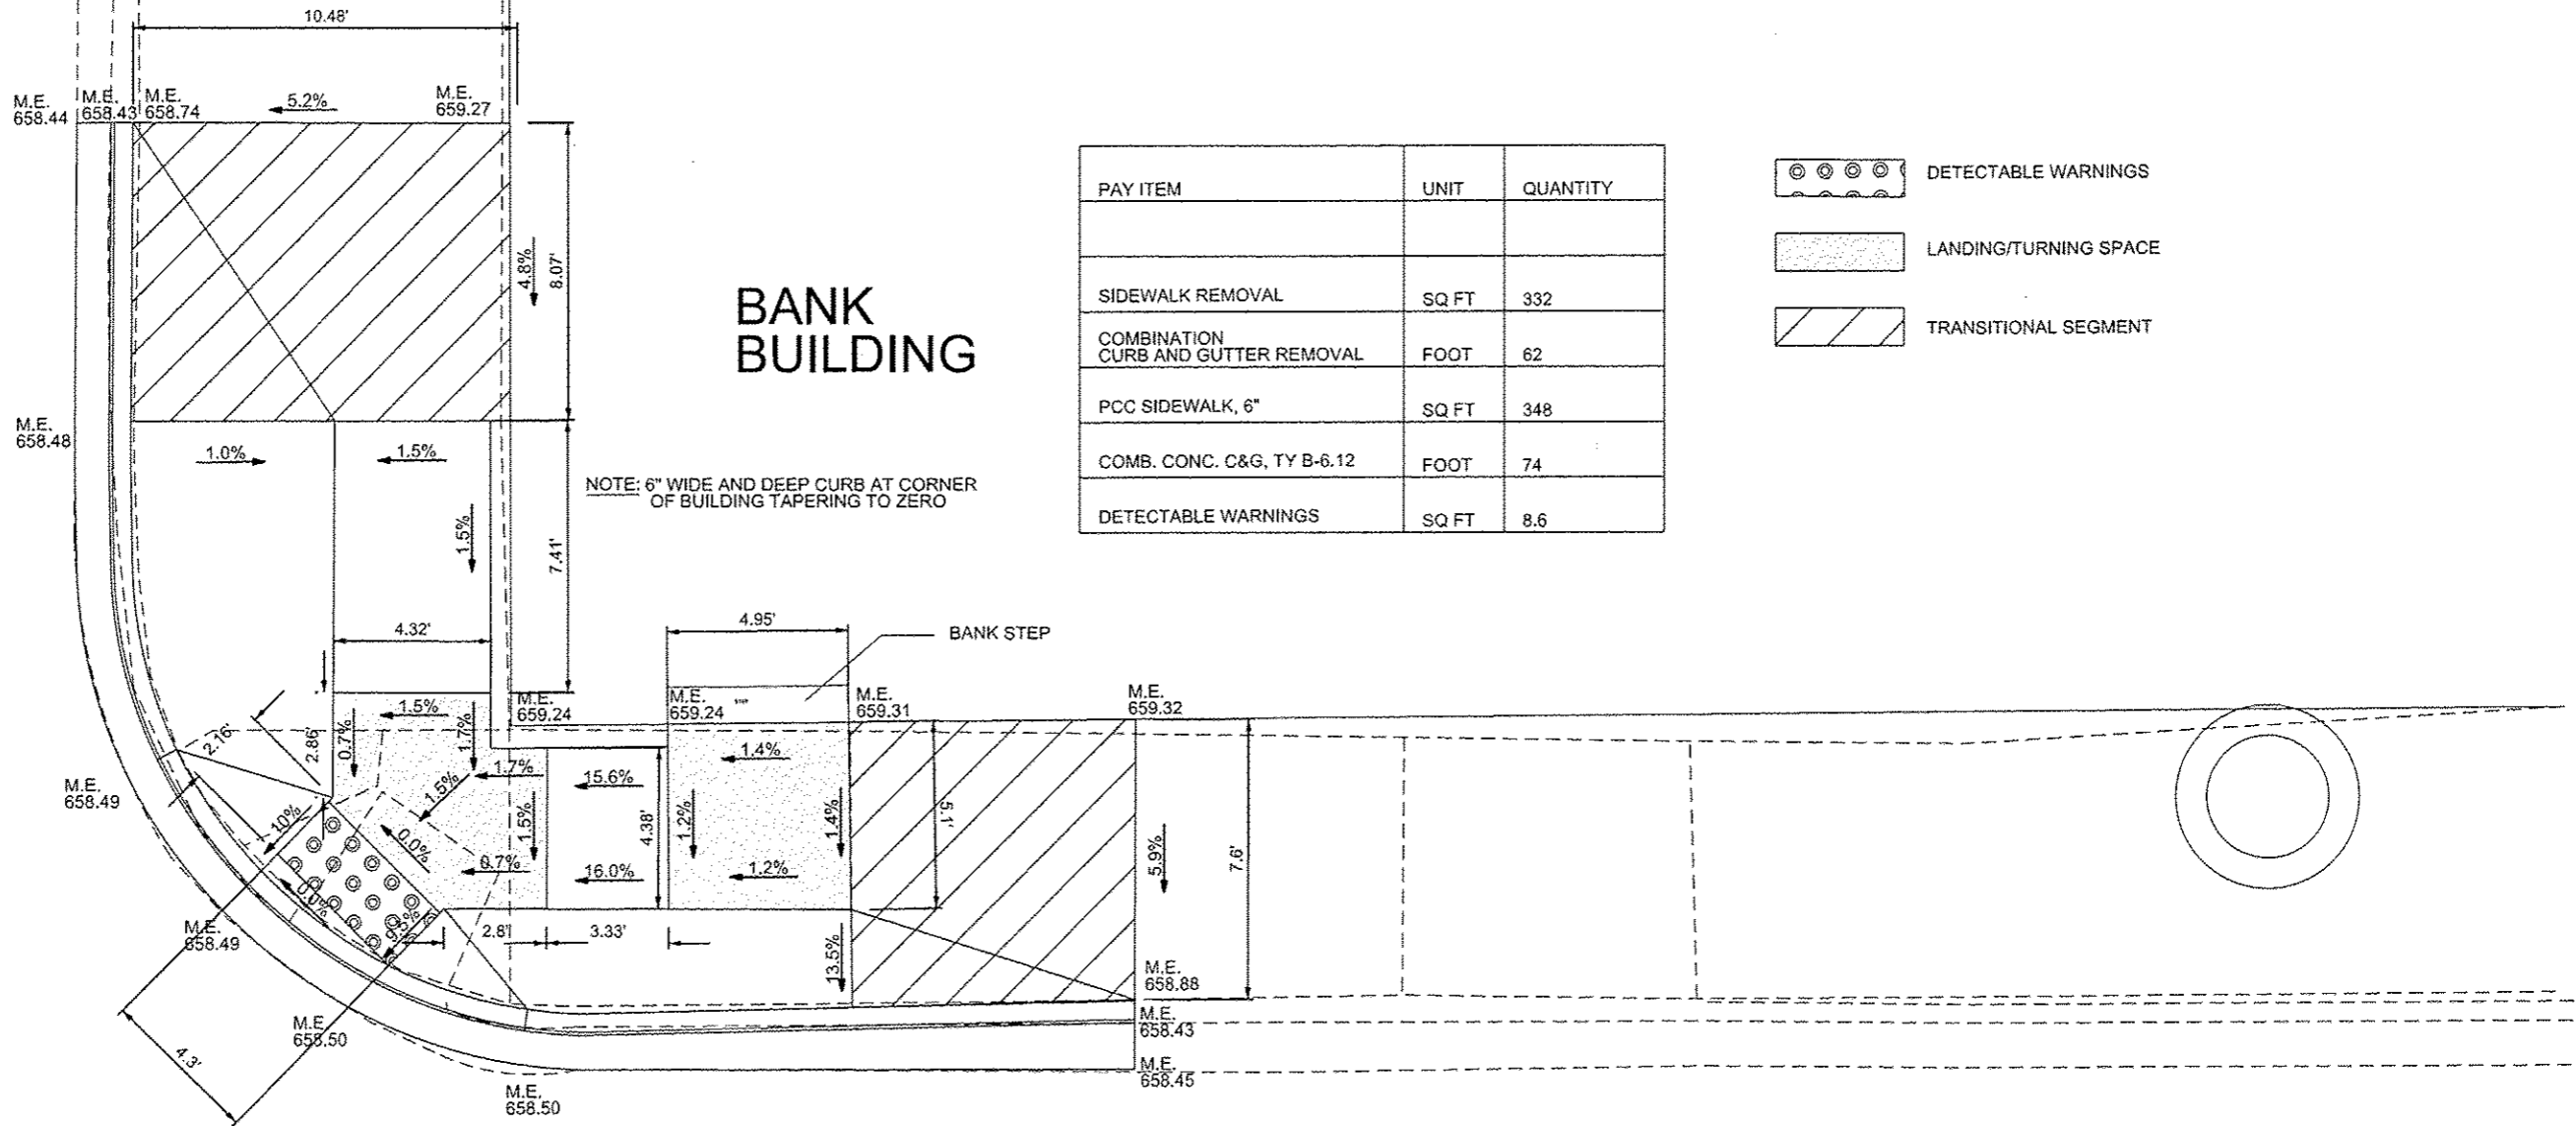

PAY ITEM	UNIT	QUANTITY
SIDEWALK REMOVAL	SQ FT	332
COMBINATION CURB AND GUTTER REMOVAL	FOOT	62
PCC SIDEWALK, 6"	SQ FT	348
COMB. CONC. C&G, TY B-6.12	FOOT	74
DETECTABLE WARNINGS	SQ FT	8.6

- DETECTABLE WARNINGS
- LANDING/TURNING SPACE
- TRANSITIONAL SEGMENT

NOTE: 6" WIDE AND DEEP CURB AT CORNER OF BUILDING TAPERING TO ZERO

6th St.

⚠ SHEET REPLACED 2-14-2017

FILE NAME =	USER NAME = biermanbj	DESIGNED -	REVISED -	<b>STATE OF ILLINOIS DEPARTMENT OF TRANSPORTATION</b>	<b>NEOGA ADA RAMPS: 6TH ST.</b>	F.A.S. RTE.	SECTION	COUNTY	TOTAL SHEETS	SHEET NO.	
pw\11084E810NTEG\Illinois.gov\PI001\Documents\DOT Offices\District 7\Projects\746\Drawings\CAD\Sheets\174613-shr-neoga	DRAMA\CA\Sheets\174613-shr-neoga	CHECKED -	REVISED -			1652	(13,14,14-12)RS-4	*	33	20	
Default	PLOT SCALE = 5.0000 / / in.	DATE -	REVISED -			CONTRACT NO. 74693		ILLINOIS FED. AID PROJECT			
	PLOT DATE = 2/6/2017					SCALE:	SHEET OF SHEETS	STA.	TO STA.	CLUMBERLAND, SHELBY	