03-08-2019 LETTING ITEM 168 INDEX OF SHEETS 01 02 GENERAL NOTES 03 GENERAL NOTES BRIDGE 04-05 SUMMARY OF QUANTITIES 06-10 SCHEDULE OF QUANTITIES 11 OVERALL PROJECT CONTROL 12-14 TYPICAL SECTIONS 15-33 PLAN AND PROFILES 34-35 BRIDGE 103 36 STORMWATER POLLUTION PLAN DETAILS 37-39 ADA DETAILS 40-42 MISCELLANEOUS DETAILS 43-44 EARTHWORK SCHEDULES

PLANS FOR PROPOSED (ITEP) PROJECT

FREEPORT - PECATONICA PRAIRIE PATH SECTION 15-00163-00-BT PROJECT No. YJTA(949) STEPHENSON COUNTY JOB NO. C-92-032-18

CONTRACT NO. 85674

DISTRICT STANDARDS

CROSS SECTIONS

45-101

102-106

CONCRETE COLLARS FOR PIPE OR BOX CULVERT EXTENSIONS

41.1 TYPICAL PAVEMENT MARKINGS

92.1 DETAILS OF PLANTING AND BRACING TREES

IDOT DISTRICT 2 STANDARDS

OF STATE HIGHWAY STANDARDS

202001-01 EARTH MEDIAN DITCH CHECK 280001-07 TEMPORARY EROSION CONTROL SYSTEMS 424001-11 PERPENDICULAR CURB RAMPS FOR SIDEWALKS 424006-04 DIAGONAL CURB RAMPS FOR SIDEWALKS 424011-04 CORNER PARALLEL CURB RAMPS FOR SIDEWALKS 424021-05 DEPRESSED CORNER FOR SIDEWALKS 515001-03 NAME PLATE FOR BRIDGES 542301-03 PRECAST REINFORCED CONCRETE FLARED END SECTIONS METAL FLARED END SECTION FOR PIPE CULVERTS 542401-03 602306-03 INLET - TYPE B 606001-07 CONCRETE CURB TYPE B AND COMBINATION CONCRETE CURB AND GUTTER 664001-02 CHAIN LINK FENCE 701001-02 TRAFFIC CONTROL OFF-RD OPERATIONS, 2L, 2W, MORE THAN 15' AWAY TRAFFIC CONTROL OFF-RD OPERATIONS, 2L, 2W, 15' TO 24" FROM PAVEMENT EDGE 701006-05 TRAFFIC CONTROL LANE CLOSURE, 2L, 2W, DAY ONLY 701301-04 TRAFFIC CONTROL LANE CLOSURE, 2L, 2W, SHORT TIME OPERATIONS 701501-06 TRAFFIC CONTROL URBAN LANE CLOSURE, 2L, 2W, UNDIVIDED SIDEWALK, CORNER OR CROSSWALK CLOSURE 701801-06 701901-08

TRAFFIC CONTROL DEVICES 720001-01 SIGN PANEL MOUNTING DETAILS 720006-04 SIGN PANEL ERECTION DETAILS 720011-01 METAL POSTS FOR SIGNS, MARKERS, & DELINEATORS 728001-01 TELESCOPING STEEL SIGN SUPPORT

APPLICATIONS OF TYPES A & B METAL POSTS (FOR SIGNS & MARKERS) 780001-05 TYPICAL PAVEMENT MARKINGS

UTILITY CONTACTS

GAS: NICOR MR. BRUCE KOPPANG DOT LIAISON 1844 FERRY ROAD NAPERVILLE, ILLINOIS 60563 (630) 388-3046

ELECTRIC: ADAM SADKOWSKI 123 ENERGY AVENUE ROCKFORD, ILLINOIS 61109 (630) 985-4043

TELEPHONE: FRONTIER COMMUNICATIONS DON BELMORE 2239 NEWBURG ROAD BELVIDERE, ILLINOIS 61008 (815) 544-6171


CABLE TELEVISION: COMCAST 4450 KISHWAUKEE STREET ROCKFORD, ILLINOIS 61109 (224) 229-4612

WATER AND SEWER COMMISSION 337 S. HANCOCK AVENUE FREEPORT, ILLINOIS 61032 (815) 232-6017

ROADWAY - TRANSPORTATION: CITY OF FREEPORT DENNIS CARR DIRECTOR OF PUBLIC WORKS 314 W. STEPHENSON STREET FREEPORT, ILLINOIS 61032 (815) 297-1166



811 or 1-800-892-0123 TOLL FREE

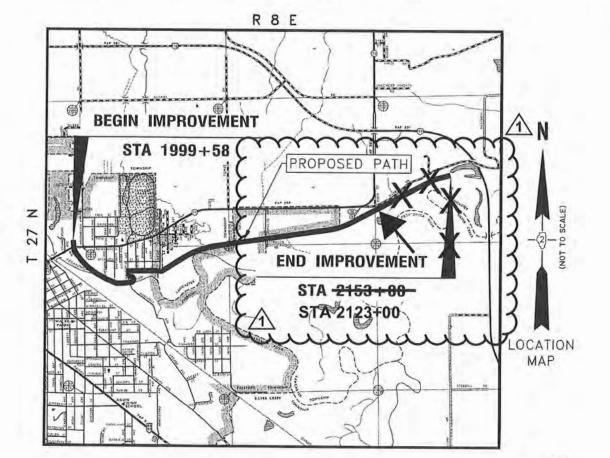


PROJECT LENGTH STRUCTURE #104 STA. 2087+89 TO STA. 2088+05


STATION EQUATIONS: STA. 2018+91.87 = 2+79.19 & SHERIDAN RD


STRUCTURE LOCATIONS: STRUCTURE 103 = 2059+12.04 TO 2060+35.12

1 ADDENDUM 1 - 2/22/2019

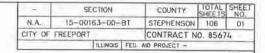

DISTRICT 2

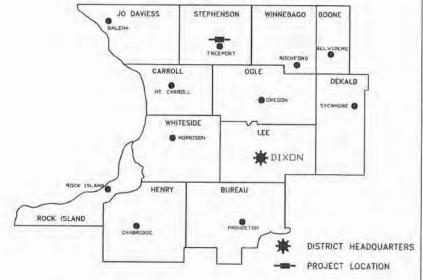

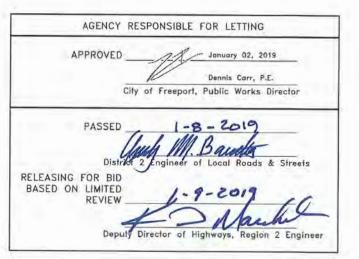

PRINTED BY THE AUTHORITY OF THE STATE OF ILLINOIS



SHEETS All Except 03,34,35

DATE SIGNED 1/2/19 EXPIRES 11/30/19

03, 34, SHEETS DATE SIGNED 1/2/19 EXPIRES 11/30/20

McCLURE PROJECT NO: 04-28-14-054
FILE NAME AND PATH: \\abstructure \\alpha\text{NM\O} \\approx \\alpha\text{NM\O} \\\alpha\text{NM\O} \\\alpha\text

SUMMARY OF QUANTITIES

CONSTRUCTION CODE 0028

SP	SI	ITEM#	PAY ITEM NAME	UNIT	TOTAL
*		20100110	TREE REMOVAL (6 TO 15 UNITS DIAMETER)	UNIT	536.0
*		20100210	TREE REMOVAL (OVER 15 UNITS DIAMETER)	UNIT	437.0
\dashv	~ *				~~~
	<i>ች</i> જ	20101400	NITROGEN FERTILIZER NUTRIENT	POUND	210.4
	**	20101500	PHOSPHORUS FERTILIZER NUTRIENT	POUND	210 4
	**	20101600	POTASSIUM FERTILIZER NUTRIENT	POUND	210.4
*		20200100	EARTH EXCAVATION	CU YD {	4,944.2
		20400800	FURNISHED EXCAVATION	CU YD	1,971.6
		20700220	POROUS GRANULAR EMBANKMENT	CUYD	15.0
		20800150	TRENCH BACKFILL	CUYD	7.6
		21101615	TOPSOIL FURNISH AND PLACE, 4 th	\$Q.YD	1,259.0
	**	25000210	SEEDING, CLASS 2A	ACRE	1.0
7	**	25000300	SEEDING, CLASS 3	ACRE	1.5
1	**	25100125	MULCH, METHOD 3	ACRE	1.6
X	**	25100630	EROSION CONTROL BLANKET	SQYD	3,676.0
		28000250	TEMPORARY EROSION CONTROL SEEDING	POUND	467.2
-		28000305	TEMPORARY DITCH CHECKS	FOOT	200.0
		28000400	PERIMETER EROSION BARRIER	FOOT	2,000.0
+		28000500	INLET AND PIPE PROTECTION	EACH {	24
+		28100109	STONE RIP RAP, CLASS A5	SQ YD	653.0
-		28100709	STONE DUMPED RIP RAP, CLASS AS	SQ YD	785.0
		28200200	FILTER FABRIC	SQ YD	1,438.0
		35101400	AGGREGATE BASE COURSE, TYPE B	TON {	5,268.7
+		40200000	AGGREGATE SURFACE COURSE, TYPE B	TON }	458.3

SP	SI	ITEM#	PAY ITEM NAME	UNIT	TOTAL
*		40600275	BITUMINOUS MATERIALS (PRIME COAT)	POUND	7,333.2
		40800050	INCIDENTAL HOT-MIX ASPHALT SURFACING	TON	365.0
		42400200	PORTLAND CEMENT CONCRETE SIDEWALK 5 INCH	\$Q FT	2,033-2
		42400800	DETECTABLE WARNINGS	SQ FT	100.0
		44000100	PAVEMENT REMOVAL	SQ YD	404.0
		44000500	COMBINATION CURB AND GUTTER REMOVAL	FOOT	62.0
		44000600	SIDEWALK REMOVAL	SQ FT	408.0
*		44200065	PAVEMENT PATCHING, TYPE II, 6 I NCH	SQ YD	10.0
*		44200069	PAVEMENT PATCHING, TYPE III, 6 INCH	SQ YD	9.0
		48101498	AGGREGATE SHOULDERS, TYPE B 4"	SQ YD	3,648.9
*		50100100	REMOVAL OF EXISTING STRUCTURES	EACH	~
		50105220	PIPE CULVERT REMOVAL	FOOT	64.0
		50300225	CONCRETE STRUCTURES	CU YD	17.0
		50800105	REINFORCEMENT BARS	POUND	2,370.0
		51201800	FURNISHING STEEL PILES HP14X73	FOOT	150.0
		51202305	DRIVING PILES	FOOT	150.0
		51203800	TEST PILES STEEL HP 14X73	EACH	1
*		51500100	NAME PLATES	EACH	1
		52100520	ANCHOR BOLTS, 1"	EACH	8
_	_	54213657	PRECAST REINFORCED CONCRETE FLARED END SECTIONS 1.2"	EACH	2
		54213669	PRECAST REINFORCED CONCRETE FLARED END SECTIONS 24"	EACH	2
		54213681	PRECAST REINFORCED CONCRETE FLARED END SECTIONS 36"	EACH	1
-	\neg	542A1069	PIPE CULVERTS, CLASS A, TYPE 2 24"	FOOT	100.0

		EG	
120 S	IST STREET	PH: 815,956,6400	
ROCK	ORD, IL 61350	www.imegcorp.com	
	FORM	MERLY	
€ 170	memen inc.	- McClure	

USER NAME:	DESIGNED:	REVISED: ADDENDUM 1 - 2/22/2019
	CHECKED:	REVISED:
PLOT SCALE:	DRAWN: ATH	REVISED:
PLOT DATE: 2/22/2019	CHECKED: WLK	REVISED:

SUMMARY OF QUANTITIES

CONSTRUCTION CODE 0028

			15-00163-00-BT - FREEPORT PEC PATH		
SP	SI	ITEM#	PAY ITEM NAME	UNIT	TOTAL
		542A1093	PIPE CULVERTS, CLASS A, TYPE 2 48"	FOOT	5.0
		550A0340	STORM SEWERS, CLASS A, TYPE 2 12"	FOOT	86.0
٠		60609800	COMBINATION CONCRETE CURB AND GUTTER, TYPE M-6 18	FOOT	42.0
•		60610400	COMBINATION CONCRETE CURB AND GUTTER, TYPE M-6.24	FOOT	42.0
_	**	66900200	NON-SPECIAL WASTE DISPOSAL	CU YD	1,671.0
	**	66900530	SOIL DISPOSAL ANALYSIS	EACH	10
	**	6690100	REGULATED SUBSTANCES PRE-CONSTRUCTION PLAN	LSUM	1
,	**	66901002	ON-SITE MONITORING OF REGULATED SUBSTANCES	CAL DAY	9
}	**	66901003	REGULATED SUBSTANCES FINAL CONSTRUCTION REPORT	LSUM	1
		67100100	MOBILIZATION	LSUM	1
	**	72000100	SIGN PANEL - TYPE 1	sq FT (127.3
+	**	72800100	TELESCOPING STEEL SIGN SUPPORT	FOOT	30.0
	**	73000100	WOOD SIGN SUPPORT	FOOT	405.0
+	**	73100100	BASE FOR TELESCOPING STEEL SIGN SUPPORT	EACH	<u>~~</u>
	**	78000400	THERMOPLASTIC PAVEMENT MARKING - LINE 6"	FOOT	80.0
+	**	78000650	THERMOPLASTIC PAVEMENT MARKING - LINE 24"	FOOT	100.0
-	**	78001.11.0	PAINT PAVEMENT MARKING - LINE 4"	FOOT	1,145.0
-	**	78001130	PAINT PAVEMENT MARKING - LINE 6"	FOOT	40.0
+	**	78001180	PAINT PAVEMENT MARKING - LINE 24"	FOOT	50.0
+	+•	78200011	BARRIER WALL REFLECTOR, TYPE C	EACH	12
e ;	**	89502385	REMOVE EXISTING CONCRETE FOUNDATION	EACH	1
	7.	A2000116	TREE, ACER X FREEMANII AUTUMN BLAZE (AUTUMN BLAZE FREEMAN MAPLE), 2" CALIPER, BALLED AND BURLAPPED	EACH	34

co	۲.	ITENA "	DAVITO LIVE		
SP	SI	ITEM#	PAY ITEM NAME	UNIT	TOTAL
	**	A2008116	TREE, TILIA CORDATA GREENSPIRE (GREENSPIRE LITTLE LEAF LINDEN), 2" CALIPER, BALLED AND BURLAPPED	EACH	34
*		x0100003	CLEARING AND GRUBBING	SQ YD	4,414.7
*		X0301797	GATE REMOVAL	EACH	2
+		X0322508	PEDESTRIAN TRUSS SUPERSTRUCTURE	SQ FT	1,482.0
+	本次	X0325714	FLASHING BEACON, POST MOUNTED SOLAR POWERED INSTALLATION	EACH	2
*	**	X0327008	REMOVE AND RELOCATE SIGN (SPECIAL)	EACH	1
#		X0327036	BIKE PATH REMOVAL	SQ YD	54.0
*		X0327423	CONNECTION TO EXISTING CULVERT	EACH	1
	7.	X0327979	PAVEMENT MARKING REMOVAL - GRINDING	SQFT	7.0
*		X2020105	GRADING AND SHAPING BIKEWAY	UNIT	10.3
*		X6024504	INLETS, TYPE 8, WITH FRAME AND GRATE, SPECIAL	EACH	3
*		X7010216	TRAFFIC CONTROL AND PROTECTION, (SPECIAL)	LSUM	1
*	,	XX006345	TURBIDITY BARRIER	FOOT	438.0
*	**	XX006653	FENCE (SPECIAL)	FOOT	359.0
*			STEEL SHEET PLUNG W/ DICYCLE RAILING	- 1001 -	8.0
*	$\overline{}$	XX006821	CONCRETE YRUCK WASHOUT	LSUM	~~
*		20004002	BOLLARDS	EACH	6
*		Z0013798	CONSTRUCTION LAYOUT	LSUM	1
*		Z0022800	FENCE REMOVAL	FOOT	28.0
*		20055905	TEMPORARY CONSTRUCTION FENCE	FOOT	216.0
*		20048900	RAILROAD TRACK REMOVAL	FOOT	76.0
*		20064600	SELECTIVE CLEARING	ACRE	0.1
*	**	20078000	WOOD RAIL	FOOT	32.0

	MEG
120 S 1ST STREET	PH. 815,956,6400
ROCKFORD, IL 61:	350 www.imegcorp.com
-	FORMERLY

AIMEG	USER NAME:	DESIGNED:	REVISED: 1 ADDENDUM 1 - 2/22/2019
120 S 1ST STREET PH. 815,956,6400		CHECKED:	REVISED:
ROCKFORD, IL 61350 www.imegcorp.com FORMERLY	PLOT SCALE:	DRAWN: ATH	REVISED:
McClure McClure	PLOT DATE: 2/22/2019	CHECKED: WLK	REVISED:
FILE NAME AND PATH: \\AD.KJWW.COM\KJWW\K	(JWW\OFFICES\MCCLURE\ROCKFORD\PROJECTS\H—DRIVE TI	RANS\14-054-PECPATH-FREEPORT\DESIGN\DRA	WINGS\14-054 QUANTITIES.DWG

PAY CODE	ITEM		QUANTITY
20100110	TREE REMO	VAL (6 TO 15 UNITS DIAMETER) OFFSET/COMMENTS	UNIT
	2004+69.8	13.2' RT	12.0
	2006+65.9	8.8' LT	14.0
	2016+64.8	8.3' LT	10.0
	2016+77.1	8.0' LT	10.0
	2017+12.7	3.8' LT	10.0
	2017+25.1 2017+35.2	1.5' LT 1.1' LT / 2@10"	8.0 20.0
	2017+35.2 2017+45.7	3.8' RT / 3@12"	20.0 36.0
	2017+43.7	27.7' RT	15.0
	2024+02.8	22.5' RT	15.0
	2024+04.1	18.9' RT	10.0
	2024+71.0	12.1' LT	8.0
	2024+94.3	14.0' RT	10.0
	2025+08.8	15.6' RT	10.0
	2025+10.6	11.9' RT	7.0 15.0
	2025+15.6 2025+16.9	21.7' RT 15.2' RT	15.0 15.0
	2025+16.9	20.0' RT	6.0
	2040+90.3	15.2' RT	6.0
	2058+46.2	10.3' LT / 2@6", 9", 12"	33.0
	2058+55.3	8.1' RT	6.0
	2058+57.3	12.5' RT / 7",9",10"	26.0
	2058+58.0	12.5' LT / 2@6", 2@7", 2@ 8", 2@9"	60.0
	2058+99.0	23.3' LT / 7",8",9"	24.0
	2059+02.6	7.9' LT / 6", 15"	21.0
	2058+94.9	24.1' RT	15.0
	2059+02.3 2059+09.7	26.9' RT / 8",9",15" 29.7' RT / 6",12"	32.0 18.0
	2059+09.7	29.7 KT / 6 , 12 26.8' RT / 8",15"	23.0
	2060+30.3	12.4' LT	6.0
	2060+43.2	41.6' RT	15.0
	2060+61.4	13.3' LT	8.0
	2060+92.4	15.4' LT	12.0
	TOTAL		536.0
AY CODE	ITEM		QUANTITY
		VAL (OVER 15 UNITS DIAMETER) OFFSET/COMMENTS	QUANTITY UNIT
	TREE REMO	,	
	TREE REMO	OFFSET/COMMENTS	UNIT
	TREE REMO'STATION	OFFSET/COMMENTS 11.8' RT	UNIT 16.0
	TREE REMO' STATION 2004+83.6 2006+71.7 2013+56.5 2017+58.8	OFFSET/COMMENTS 11.8' RT 10.9' LT 13.4' LT FELLED TREE (3@16") 6.3' LT	UNIT 16.0 18.0 48.0 16.0
	TREE REMO'STATION 2004+83.6 2006+71.7 2013+56.5 2017+58.8 2019+27.0	OFFSET/COMMENTS 11.8' RT 10.9' LT 13.4' LT FELLED TREE (3@16") 6.3' LT 20.0' LT FELLED TREE	UNIT 16.0 18.0 48.0 16.0 48.0
	TREE REMO'STATION 2004+83.6 2006+71.7 2013+56.5 2017+58.8 2019+27.0 2024+67.1	OFFSET/COMMENTS 11.8' RT 10.9' LT 13.4' LT FELLED TREE (3@16") 6.3' LT 20.0' LT FELLED TREE 9.9' LT	UNIT 16.0 18.0 48.0 16.0 48.0 39.0
	TREE REMO'STATION 2004+83.6 2006+71.7 2013+56.5 2017+58.8 2019+27.0 2024+67.1 2024+77.2	OFFSET/COMMENTS 11.8' RT 10.9' LT 13.4' LT FELLED TREE (3@16") 6.3' LT 20.0' LT FELLED TREE 9.9' LT 1.0' RT	UNIT 16.0 18.0 48.0 16.0 48.0 39.0 52.0
	TREE REMOT STATION 2004+83.6 2006+71.7 2013+56.5 2017+58.8 2019+27.0 2024+67.1 2024+77.2 2024+77.6	OFFSET/COMMENTS 11.8' RT 10.9' LT 13.4' LT FELLED TREE (3@16") 6.3' LT 20.0' LT FELLED TREE 9.9' LT 1.0' RT 12.1' LT	UNIT 16.0 18.0 48.0 16.0 48.0 39.0 52.0 24.0
	TREE REMO'STATION 2004+83.6 2006+71.7 2013+56.5 2017+58.8 2019+27.0 2024+67.1 2024+77.2 2024+77.6 2024+85.7	OFFSET/COMMENTS 11.8' RT 10.9' LT 13.4' LT FELLED TREE (3@16") 6.3' LT 20.0' LT FELLED TREE 9.9' LT 1.0' RT 12.1' LT 18.9' RT	UNIT 16.0 18.0 48.0 16.0 48.0 39.0 52.0 24.0 24.0
	TREE REMO'STATION 2004+83.6 2006+71.7 2013+56.5 2017+58.8 2019+27.0 2024+67.1 2024+77.2 2024+77.6 2024+85.7 2024+90.3	OFFSET/COMMENTS 11.8' RT 10.9' LT 13.4' LT FELLED TREE (3@16") 6.3' LT 20.0' LT FELLED TREE 9.9' LT 1.0' RT 12.1' LT 18.9' RT 17.4' RT	UNIT 16.0 18.0 48.0 16.0 48.0 39.0 52.0 24.0 24.0 20.0
	TREE REMOT STATION 2004+83.6 2006+71.7 2013+56.5 2017+58.8 2019+27.0 2024+67.1 2024+77.2 2024+77.6 2024+85.7 2024+90.3 2025+13.2	OFFSET/COMMENTS 11.8' RT 10.9' LT 13.4' LT FELLED TREE (3@16") 6.3' LT 20.0' LT FELLED TREE 9.9' LT 1.0' RT 12.1' LT 18.9' RT 17.4' RT 19.6' RT	UNIT 16.0 18.0 48.0 16.0 48.0 39.0 52.0 24.0 24.0 20.0 20.0
	TREE REMO'STATION 2004+83.6 2006+71.7 2013+56.5 2017+58.8 2019+27.0 2024+67.1 2024+77.2 2024+77.6 2024+85.7 2024+90.3	OFFSET/COMMENTS 11.8' RT 10.9' LT 13.4' LT FELLED TREE (3@16") 6.3' LT 20.0' LT FELLED TREE 9.9' LT 1.0' RT 12.1' LT 18.9' RT 17.4' RT	UNIT 16.0 18.0 48.0 16.0 48.0 39.0 52.0 24.0 24.0 20.0
	TREE REMO'STATION 2004+83.6 2006+71.7 2013+56.5 2017+58.8 2019+27.0 2024+67.1 2024+77.2 2024+77.6 2024+85.7 2024+90.3 2025+13.2 2025+14.8	OFFSET/COMMENTS 11.8' RT 10.9' LT 13.4' LT FELLED TREE (3@16") 6.3' LT 20.0' LT FELLED TREE 9.9' LT 1.0' RT 12.1' LT 18.9' RT 17.4' RT 19.6' RT 11.8' RT	UNIT 16.0 18.0 48.0 16.0 48.0 39.0 52.0 24.0 24.0 20.0 20.0 24.0
	TREE REMOT STATION 2004+83.6 2006+71.7 2013+56.5 2017+58.8 2019+27.0 2024+67.1 2024+77.2 2024+77.6 2024+85.7 2024+90.3 2025+13.2 2025+14.8 2058+63.7	OFFSET/COMMENTS 11.8' RT 10.9' LT 13.4' LT FELLED TREE (3@16") 6.3' LT 20.0' LT FELLED TREE 9.9' LT 1.0' RT 12.1' LT 18.9' RT 17.4' RT 19.6' RT 11.8' RT 13.7' LT	UNIT 16.0 18.0 48.0 16.0 48.0 39.0 52.0 24.0 24.0 20.0 20.0 24.0 22.0
	TREE REMOT STATION 2004+83.6 2006+71.7 2013+56.5 2017+58.8 2019+27.0 2024+67.1 2024+77.6 2024+77.6 2024+85.7 2024+90.3 2025+13.2 2025+14.8 2058+63.7 2059+13.8	OFFSET/COMMENTS 11.8' RT 10.9' LT 13.4' LT FELLED TREE (3@16") 6.3' LT 20.0' LT FELLED TREE 9.9' LT 1.0' RT 12.1' LT 18.9' RT 17.4' RT 19.6' RT 11.8' RT 13.7' LT 13.7' LT	UNIT 16.0 18.0 48.0 16.0 48.0 39.0 52.0 24.0 24.0 20.0 20.0 24.0 22.0 17.0
	TREE REMO'STATION 2004+83.6 2006+71.7 2013+56.5 2017+58.8 2019+27.0 2024+67.1 2024+77.6 2024+77.6 2024+85.7 2024+90.3 2025+13.2 2025+14.8 2058+63.7 2059+13.8 2060+43.9 2060+73.0	OFFSET/COMMENTS 11.8' RT 10.9' LT 13.4' LT FELLED TREE (3@16") 6.3' LT 20.0' LT FELLED TREE 9.9' LT 1.0' RT 12.1' LT 18.9' RT 17.4' RT 19.6' RT 11.8' RT 13.7' LT 13.7' LT	UNIT 16.0 18.0 48.0 16.0 48.0 39.0 52.0 24.0 24.0 20.0 20.0 24.0 22.0 17.0 30.0 19.0
	TREE REMO'S STATION 2004+83.6 2006+71.7 2013+56.5 2017+58.8 2019+27.0 2024+67.1 2024+77.2 2024+77.6 2024+85.7 2024+90.3 2025+13.2 2025+14.8 2058+63.7 2059+13.8 2060+43.9	OFFSET/COMMENTS 11.8' RT 10.9' LT 13.4' LT FELLED TREE (3@16") 6.3' LT 20.0' LT FELLED TREE 9.9' LT 1.0' RT 12.1' LT 18.9' RT 17.4' RT 19.6' RT 11.8' RT 13.7' LT 13.7' LT	UNIT 16.0 18.0 48.0 16.0 48.0 39.0 52.0 24.0 24.0 20.0 20.0 24.0 22.0 17.0 30.0
20100210	TREE REMO'STATION 2004+83.6 2006+71.7 2013+56.5 2017+58.8 2019+27.0 2024+67.1 2024+77.6 2024+77.6 2024+85.7 2024+90.3 2025+13.2 2025+14.8 2058+63.7 2059+13.8 2060+43.9 2060+73.0	OFFSET/COMMENTS 11.8' RT 10.9' LT 13.4' LT FELLED TREE (3@16") 6.3' LT 20.0' LT FELLED TREE 9.9' LT 1.0' RT 12.1' LT 18.9' RT 17.4' RT 19.6' RT 11.8' RT 13.7' LT 13.7' LT	UNIT 16.0 18.0 48.0 16.0 48.0 39.0 52.0 24.0 24.0 20.0 20.0 24.0 22.0 17.0 30.0 19.0
20100210 PAY CODE	TREE REMO'S STATION 2004+83.6 2006+71.7 2013+56.5 2017+58.8 2019+27.0 2024+67.1 2024+77.2 2024+77.6 2024+85.7 2024+90.3 2025+13.2 2025+14.8 2058+63.7 2059+13.8 2060+43.9 2060+73.0 TOTAL	OFFSET/COMMENTS 11.8' RT 10.9' LT 13.4' LT FELLED TREE (3@16") 6.3' LT 20.0' LT FELLED TREE 9.9' LT 1.0' RT 12.1' LT 18.9' RT 17.4' RT 19.6' RT 11.8' RT 13.7' LT 13.7' LT	UNIT 16.0 18.0 48.0 16.0 48.0 39.0 52.0 24.0 24.0 20.0 20.0 22.0 17.0 30.0 19.0
20100210 PAY CODE	TREE REMO'S STATION 2004+83.6 2006+71.7 2013+56.5 2017+58.8 2019+27.0 2024+67.1 2024+77.6 2024+77.6 2024+85.7 2024+90.3 2025+13.2 2025+14.8 2058+63.7 2059+13.8 2060+43.9 2060+73.0 TOTAL ITEM NITROGEN F STATION	OFFSET/COMMENTS 11.8' RT 10.9' LT 13.4' LT FELLED TREE (3@16") 6.3' LT 20.0' LT FELLED TREE 9.9' LT 1.0' RT 12.1' LT 18.9' RT 17.4' RT 19.6' RT 11.8' RT 13.7' LT 13.0' LT 19.0' LT	UNIT 16.0 18.0 48.0 16.0 48.0 39.0 52.0 24.0 24.0 20.0 20.0 24.0 22.0 17.0 30.0 19.0 QUANTITY POUNDS
PAY CODE 20100210	TREE REMO'S STATION 2004+83.6 2006+71.7 2013+56.5 2017+58.8 2019+27.0 2024+67.1 2024+77.2 2024+77.6 2024+85.7 2024+90.3 2025+13.2 2025+14.8 2058+63.7 2059+13.8 2060+43.9 2060+73.0 TOTAL ITEM NITROGEN F STATION 1999+58.0 2002+46.0	OFFSET/COMMENTS 11.8' RT 10.9' LT 13.4' LT FELLED TREE (3@16") 6.3' LT 20.0' LT FELLED TREE 9.9' LT 1.0' RT 12.1' LT 18.9' RT 17.4' RT 19.6' RT 11.8' RT 13.7' LT 13.7' LT 13.0' LT 19.0' LT FERTILIZER NUTRIENT OFFSET 2000+03.0 LT/RT 2028+59.0	UNIT 16.0 18.0 48.0 16.0 48.0 39.0 52.0 24.0 24.0 20.0 20.0 24.0 22.0 17.0 30.0 19.0 437.0 QUANTITY POUNDS 0.7 67.8
20100210 PAY CODE	TREE REMO'S STATION 2004+83.6 2006+71.7 2013+56.5 2017+58.8 2019+27.0 2024+67.1 2024+77.6 2024+77.6 2024+85.7 2024+90.3 2025+13.2 2025+14.8 2058+63.7 2059+13.8 2060+43.9 2060+73.0 TOTAL ITEM NITROGEN F STATION 1999+58.0	OFFSET/COMMENTS 11.8' RT 10.9' LT 13.4' LT FELLED TREE (3@16") 6.3' LT 20.0' LT FELLED TREE 9.9' LT 1.0' RT 12.1' LT 18.9' RT 17.4' RT 19.6' RT 11.8' RT 13.7' LT 13.7' LT 13.0' LT 19.0' LT FERTILIZER NUTRIENT OFFSET 2000+03.0 LT/RT	UNIT 16.0 18.0 48.0 16.0 48.0 39.0 52.0 24.0 24.0 20.0 20.0 24.0 22.0 17.0 30.0 19.0 437.0 QUANTITY POUNDS 0.7
20100210 PAY CODE	TREE REMO'S STATION 2004+83.6 2006+71.7 2013+56.5 2017+58.8 2019+27.0 2024+67.1 2024+77.2 2024+77.6 2024+85.7 2024+90.3 2025+13.2 2025+14.8 2058+63.7 2059+13.8 2060+43.9 2060+73.0 TOTAL ITEM NITROGEN F STATION 1999+58.0 2002+46.0 2039+08.0 SHERIDAN F	OFFSET/COMMENTS 11.8' RT 10.9' LT 13.4' LT FELLED TREE (3@16") 6.3' LT 20.0' LT FELLED TREE 9.9' LT 1.0' RT 12.1' LT 18.9' RT 17.4' RT 19.6' RT 11.8' RT 13.7' LT 13.7' LT 13.0' LT 19.0' LT	UNIT 16.0 18.0 48.0 16.0 48.0 39.0 52.0 24.0 24.0 20.0 20.0 22.0 17.0 30.0 19.0 QUANTITY POUNDS 0.7 67.8 135.3
20100210 PAY CODE	TREE REMO'S STATION 2004+83.6 2006+71.7 2013+56.5 2017+58.8 2019+27.0 2024+67.1 2024+77.6 2024+85.7 2024+90.3 2025+13.2 2025+14.8 2058+63.7 2059+13.8 2060+73.0 TOTAL ITEM NITROGEN F STATION 1999+58.0 2002+46.0 2039+08.0	OFFSET/COMMENTS 11.8' RT 10.9' LT 13.4' LT FELLED TREE (3@16") 6.3' LT 20.0' LT FELLED TREE 9.9' LT 1.0' RT 12.1' LT 18.9' RT 17.4' RT 19.6' RT 11.8' RT 13.7' LT 13.0' LT 19.0' LT 19.0' LT 2000+03.0 LT/RT 2028+59.0 2123+00.0	UNIT 16.0 18.0 48.0 16.0 48.0 39.0 52.0 24.0 24.0 20.0 20.0 24.0 22.0 17.0 30.0 19.0 437.0 QUANTITY POUNDS 0.7 67.8

PAY CODE	ITEM			QUANTITY
20101500	PHOSPHOR STATION	OUS FERTILIZER	NUTRIENT OFFSET	POUNDS
	1999+58.0	2000+03.0	LT/RT	0.7
~~~	2002+46.0 2039+08.0	2028+59.0 2123+00.0	~~~~~~~	67.8
	SHERIDAN A	AVE 2+79.0		6.6
	TOTAL			210.4
PAY CODE	ITEM			QUANTITY
20101600	POTASSIUM	FERTILIZER NUT		
	STATION		OFFSET	POUNDS
~~~	1999+58.0 2002+46.0	2000+03.0 2028+59.0	LT/RT	0.7
	2039+08.0	2123+00.0		135.3
	SHERIDAN A 0+00.0	AVE 2+79.0		6.6
	TOTAL			210.4
PAY CODE	ITEM			QUANTITY
20700220	POROUS GR. STATION	ANULAR EMBANI	KMENT OFFSET	CU YD
	2059+08.5 2060+32.0		WEST ABUTMENT EAST ABUTMENT	7.5 7.5
	TOTAL			15.0
PAY CODE	ITEM			QUANTITY
20800150	TRENCH BAC	CKFILL	OFFSET	CU YD
	2018+45.3			3.1
	2023+84.1 2024+82.3			2.4 2.1
	TOTAL			7.6
PAY CODE	ITEM			QUANTITY
21101615	TOPSOIL FUR	RNISH AND PLAC	E, 4" OFFSET	SQ YD
	1999+58.0 1999+58.0	2000+03.5 2000+03.5	LT RT	10.5 9.7
	2002+49.9	SHERIDAN	LT	420.3
	SHERIDAN 2002+41.0	2023+73.0 2023+73.0	LT RT	163.6 475.6
	2024+60.0 2024+60.0	2028+65.0 2028+69.0	LT RT	87.4 91.9
	TOTAL			1,259.0
	I O I/AL			1,203.0

PAY CODE	ITEM			QUANTITY
25000210	SEEDING, CLASS STATION	2A	OFFSET	ACRE
		2000+03.0 2028+59.0	LT/RT LT/RT	0.1 0.8
	SHERIDAN AVE 0+00.0 2	2+79.0	LT/RT	0.1
	TOTAL			1.0
PAY CODE	ITEM			QUANTITY
25000300	SEEDING, CLASS STATION	3	OFFSET	ACRE
~~~	2039+08.0	2123+00.0	LT/RT	1.5
	TOTAL			1.5
PAY CODE	ITEM			QUANTITY
25100125	MULCH, METHOD STATION	3	OFFSET	ACRE
~~~~	2039+08.0 2	2123+00.0	LT/RT	1.5
	SHERIDAN AVE 0+00.0 2	2+79.0	LT/RT	0.1
	TOTAL			1.6
PAY CODE	ITEM			QUANTITY
25100630	EROSION CONTRO	OL BLANKET	OFFSET	SQ YD
		2000+03.0 2028+59.0	LT/RT	32.8 3,643.2
	TOTAL			3,676.0
PAY CODE	ITEM			QUANTITY
28000250	TEMPORARY ERO	SION CONTRO		POUNDS
	STATION		OFFSET	
	STATION 1999+58.0 2	2000+03.0	LT/RT	1.4 150 G
~~~	STATION  1999+58.0 2 2002+46.0 2	2000+03.0 2028+59.0 2123+00.0		1.4 150.6 300.6
	STATION  1999+58.0 2 2002+46.0 2 2039+08.0 2 SHERIDAN AVE	2028+59 0	LT/RT	150.6


EARTHWORK SCHEDULE LOCATED ON SHEETS 43 & 44



USER NAME:	DESIGNED:	REVISED: ADDENDUM 1 - 2/22/2019
	CHECKED:	REVISED:
PLOT SCALE:	DRAWN: ATH	REVISED:
PLOT DATE: 2/22/2019	CHECKED: WLK	REVISED:

STATE	0F	ILLINOIS
CITY O	FF	REEPORT

SCHEDULE OF QUANTITIES FREEPORT PEC PATH		SECTION	COUNTY	TOTAL SHEETS	SHEE NO
		15-00163-00-BT	STEPHENSON	106	06
THELFORT TECTATII	CITY OF	FREEPORT	CONTRACT N	O. 8567	74
SHEET NO. OF SHEETS		ILLINOIS FED. A	ID PROJECT —		

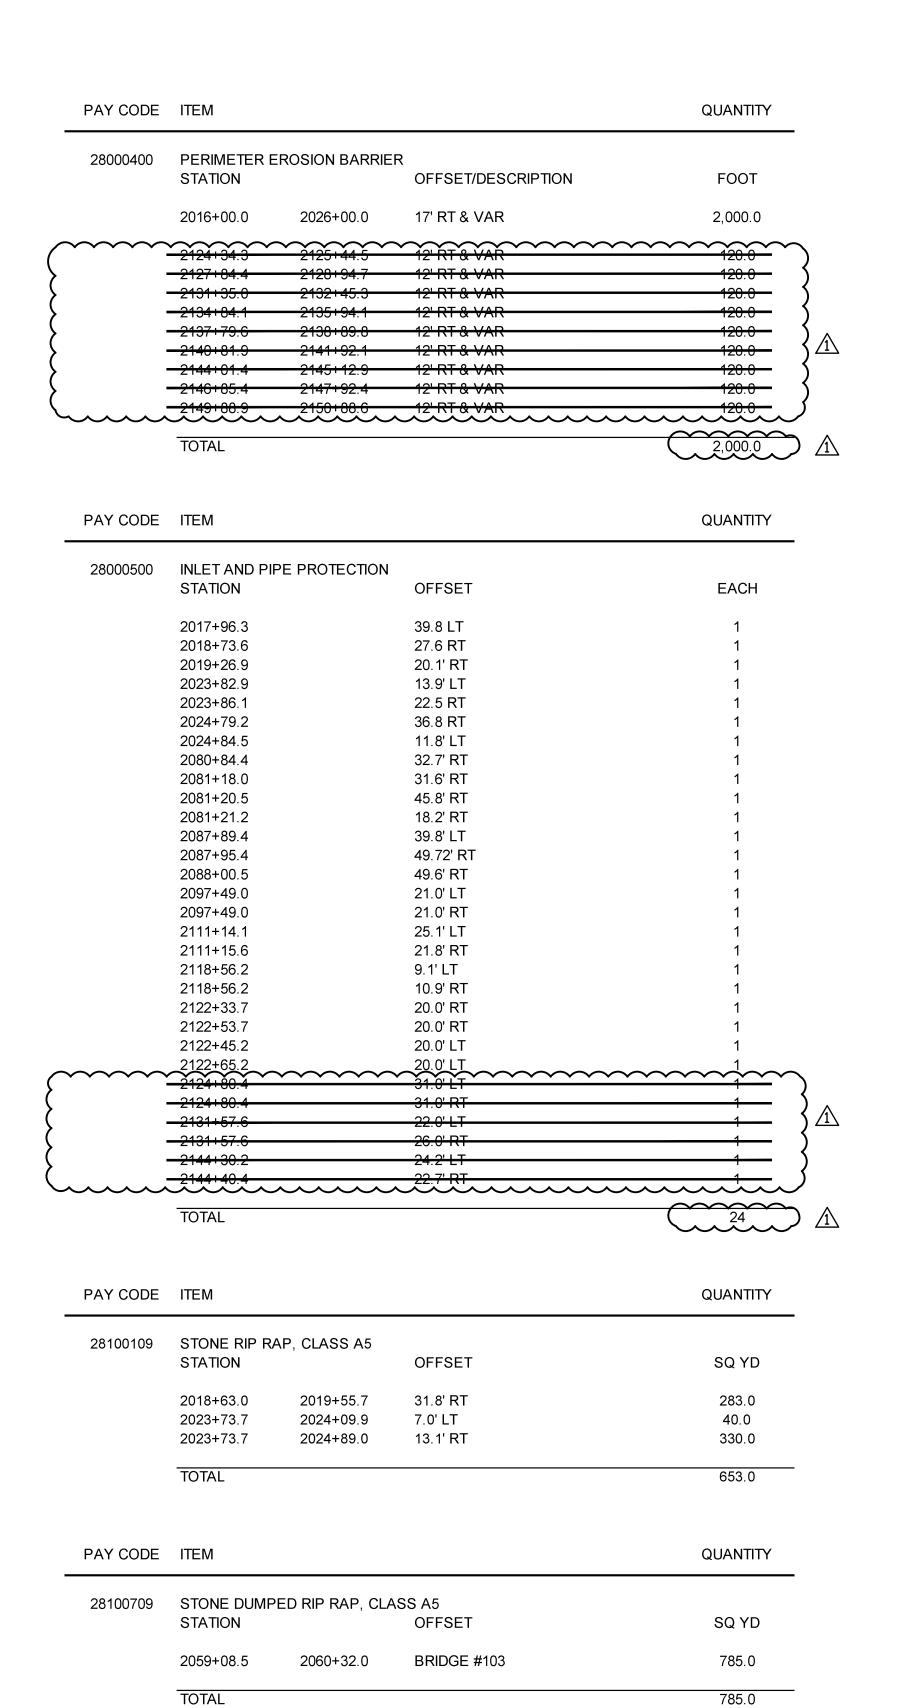

PAY CODE	ITEM			QUANTITY
28200200	FILTER FABRIC			
	STATION		OFFSET	SQ YD
	2018+63.0	2019+55.7	31.8' RT	283.0
	2023+73.7	2024+09.9	7.0' LT	40.0
	2023+73.7	2024+89.0	13.1' RT	330.0
	2059+08.5	2060+32.0	BRIDGE #103	785.0
	TOTAL			1,438.0
				,
PAY CODE	ITEM			QUANTITY
35101400	AGGREGATE BA	SE COURSE. 1	YPE B	
00101400	STATION	.oc	OFFSET	TONS
	1999+58.00	2000+03.48	PATH	23.8
	2000+03.48	2000+03.40	PAD	8.7
	2000+56.54	2000+67.27	PAD	10.7
	2002+45.48	2018+71.00	PATH	849.6
	SHERIDAN ACCE	ESS	PATH	132.6
	SHERIDAN ACCE	ESS RAMP	PAD	7.0
	SHERIDAN INTER	RSECTION	PATH	35.8
	2019+12.67	2023+73.73	PATH	241.0
	2023+73.73	2024+60.61	HANCOCK BRIDGE	30.3
	2024+60.61	2028+59.48	PATH	208.5
	2028+59.48	2028+69.09	PAD	2.5
	2039+08.31	2059+08.50	PATH	995.7
	2060+32.00	2080+73.15	PATH	1,016.0
	2080+73.15	2080+88.53	PAD	3.8
	STRUCTO RD INT	ERSECTION	PATH	31.0
	2081+08.60	2081+23.99	PAD	3.8
	2081+23.99	2081+73.99	PATH	24.9
~~~	2081+73.99 2087+89.98	2087+89.98 2123+00.00	PATH PATH	245.3 1,397.8
	TOTAL			5,268.7
PAY CODE	ITEM			QUANTITY
40200800	AGGREGATE SU	RFACE COURS	SE, TYPE B	
	STATION		OFFSET/COMMENT	TONS
	2039+08.0	2059+08.5	*10' PATH	124.0
	2060+32.0 2081+09.0	2080+89.0 2087+90.0	*10' PATH *8' PATH	126.8 33.5
~~~~	2088+04.0	2123+00.0	*8' PATH	174.0
				00000
	TOTAL			458.3
PAY CODE	TOTAL			QUANTITY
	ITEM	TEDIALO (SST.	UE COATS	
PAY CODE 40600275		TERIALS (PRIM	IE COAT) OFFSET	
	ITEM  BITUMINOUS MA STATION  1999+58.0	2000+03.0	· · · · · · · · · · · · · · · · · · ·	QUANTITY  POUNDS  113.7
	ITEM BITUMINOUS MA STATION	,	· · · · · · · · · · · · · · · · · · ·	QUANTITY
	BITUMINOUS MA STATION 1999+58.0 2002+46.0	2000+03.0 2023+74.0	· · · · · · · · · · · · · · · · · · ·	QUANTITY  POUNDS  113.7 5,322.7
	ITEM  BITUMINOUS MA STATION  1999+58.0 2002+46.0 2024+61.0	2000+03.0 2023+74.0	· · · · · · · · · · · · · · · · · · ·	QUANTITY  POUNDS  113.7 5,322.7 1,032.9

PAY CODE	ITEM			QUANTIT
40800050	INCIDENTAL H	OT-MIX ASPHAL	T SURFACING OFFSET	TONS
	1999+58.0	2000+03.0		6.0
	2002+46.0	2023+74.0		265.0
	2024+61.0	2028+59.0		51.0
	STRUCTO RD			8.0
	0+00.0	2+72.2	SHERDIAN AVE	35.0
	TOTAL			365.0
PAY CODE	ITEM			QUANTIT
42400200	PORTLAND CF	MENT CONCRE	TE SIDEWALK - 5 INCH	
12 100200	STATION		OFFSET	SQ FT
	2000+03.5	2000+11.5	STEPHENSON ST NORTH	174.0
	2000+56.6	2000+64.7	STEPHENSON ST SOUTH	234.0
	2023+73.7	2024+60.6	HANCOCK BRIDGE	1,216.5
	2028+59.5	2028+69.1	ALBUM ST	100.9
	2080+73.1 2081+08.6	2028+88.5 2081+24.0	STRUCTO RD WEST STRUCTO RD EAST	153.9 153.9
	∠∪01+∪0.0	∠UO I+∠4.U	SINUCIO ND EAST	193.9
	TOTAL			2,033.2
PAY CODE	ITEM			QUANTIT
42400800	DETECTABLE	WARNINGS		
	STATION		OFFSET	SQ FT
	0000 00 4	2222 11 1		00.0
	2000+09.4	2000+11.4	LT/RT	20.0
	2000+56.4	2000+58.4	LT/RT	20.0
	2028+64.6 2080+86.2	2028+66.6 2080+88.2	LT/RT STRUCTO RD	20.0 20.0
	2081+09.0	2081+11.0	STRUCTO RD	20.0
	TOTAL			
	IOIAL			100.0
PAY CODE	ITEM			QUANTIT
44000100	PAVEMENT RE	 =ΜΟ\/ΔΙ		
44000100	STATION		OFFSET	SQ YD
	2027+44.3	2028+52.0	20.0' RT (CONCRETE)	189.0
	2028+54.6	2028+90.0	9.6' LT - 7.6' RT (HMA)	25.0
	2039+08.3	2040+12.5	0' LT - 25.2' LT (HMA)	190.0
	TOTAL			404.0
PAY CODE	ITEM			QUANTIT
44000500	COMBINATION STATION	CURB AND GU	TTER REMOVAL OFFSET	FOOT
	2000+13.9		LT/RT	22.0
	2000+13.9		LT/RT	20.0
	2028+54.5	2028+74.0	11.5' LT	20.0
	TOTAL			62.0



USER NAME:	DESIGNED:	REVISED: ADDENDUM 1 - 2/22/2019
	CHECKED:	REVISED:
PLOT SCALE:	DRAWN: ATH	REVISED:
PLOT DATE: 2/22/2019	CHECKED: WLK	REVISED:

_	PAY CODE	ITEM				QUANTITY	
	44000600	SIDEWALK REMO	OVAL	OFFSET		SQ FT	
		2000+03.5 2000+56.6	2000+11.4 2000+64.7	LT/RT LT/RT		174.0 234.0	
		TOTAL				408.0	
_	PAY CODE	ITEM				QUANTITY	
	44200065	PAVEMENT PATO STATION	CHING, TYPE	II, 6" OFFSET		SQ YD	
		2000+13.9 2000+54.1		LT/RT LT/RT		5.0 5.0	
		TOTAL				10.0	
_	PAY CODE	ITEM				QUANTITY	
	44200069	PAVEMENT PATO STATION	CHING, TYPE	III, 6" OFFSET		SQ YD	
		SE QUAD OF HA	NCOCK AND A	ALBUM		9.0	
		TOTAL				9.0	
	PAY CODE	ITEM				QUANTITY	
_	48101498	AGGREGATE SHO	OULDERS, TY	PE B 4" OFFSET		SQ YD	
		2039+08.0	2059+08.5	LT		441.0	
			2059+08.5	RT		442.4	
			2080+89.0 2080+89.0	LT RT		454.5 454.0	
			2087+90.0	LT		151.5	
	~~~	$\sim\sim\sim\sim$	2087+90.0	RT	<b>~~~~</b>	151.7	
			2123+00.0 2123+00.0	RT		776.9 776.9	} <u>^</u>
		TOTAL				3,648.9	<u> </u>
	PAY CODE	ITEM				QUANTITY	
	50100100	REMOVAL OF EXISTATION	STING STRUC	TURES COMMENTS		EACH	
		2058+76.0		EX BRIDGE #102		1	
		TOTAL				1	
	PAY CODE	ITEM				QUANTITY	
	50105220	PIPE CULVERT STATION	REMOVAL OFFSET	STATION	OFFSET	FOOT	
		2017+97.1	40.5' LT	2018+47.7	1.0' RT	64.0	
		TOTAL				64.0	
	PAY CODE	ITEM				QUANTITY	
	50300225	CONCRETE STRU	JCTURES				
		STATION		OFFOFT		CU YD	
		STATION		OFFSET		COTD	
		2059+08.5	2060+32.0	BRIDGE #103		17.0	

PAY CODE	ITEM			QUAN
50800105	REINFORCEMEI STATION	NT BARS	OFFSET	POUI
	2059+08.5	2060+32.0	BRIDGE #103	2,370
	TOTAL			2,370
PAY CODE	ITEM			QUAN
51201800	FURNISHING ST STATION	EEL PILES HP	14X73 OFFSET	FOC
	2059+08.5	2060+32.0	BRIDGE #103	150.
	TOTAL			150.
PAY CODE	ITEM			QUAN
51202305	DRIVING PILES STATION		OFFSET	FOC
	2059+08.5	2060+32.0	BRIDGE #103	150
	TOTAL			150
PAY CODE	ITEM			QUAN
51203800	TEST PILE STEE	EL HP 14X73	OFFSET	EAC
	2059+08.5		BRIDGE #103, WEST ABUTMENT	1
	TOTAL			1
PAY CODE	ITEM			QUAN
51500100	NAME PLATES STATION		OFFSET	EAC
	2059+15.0		6' RT (BRIDGE #103)	1
	TOTAL			1
PAY CODE	ITEM			QUAN
52100520	ANCHOR BOLTS	5, 1"	OFFSET	EAC
	2059+08.5	2060+32.0	BRIDGE #103	8
	TOTAL			8

PAY CODE	ITEM				QUANTITY
54213657	PRECAST REIN STATION	NFORCED CONCR	RETE FLARED END OFFSET	SECTIONS 12"	EACH
	2023+86.1 2024+79.2		22.5 RT 36.8 RT		1 1
	TOTAL				2
PAY CODE	ITEM				QUANTITY
54213669	PRECAST REIN	IFORCED CONCR	RETE FLARED END	SECTIONS 24"	
	STATION		OFFSET		EACH
	2017+96.3 2018+73.6		39.8 LT 27.6 RT		1 1
	TOTAL				2
PAY CODE	ITEM				QUANTITY
54213681	PRECAST REIN	NFORCED CONCR	ETE FLARED END	SECTIONS 36"	EACH
	2019+26.9		20.1' RT		1
	TOTAL				1
PAY CODE	ITEM				QUANTITY
542A1069		RTS, CLASS A, T			
	STATION 2017+96.3	OFFSET 39.8 LT	STATION 2018+73.6	OFFSET 27.6 RT	FOOT 100.0
	TOTAL	J9.0 L1	2010-73.0	27.0 101	100.0
					.00.0
PAY CODE	ITEM				QUANTITY
5 4 2A1093	PIPE CULVER STATION	RTS, CLASS A, TY OFFSET	PE 2 48" STATION	OFFSET	FOOT
	2111+14.1	25.1 LT	2111+14.2	20.1 LT	5.0
	TOTAL				5.0
PAY CODE	ITEM				QUANTITY
550A0340	STORM SEWI	ERS, CLASS A, T OFFSET	YPE 2 12" STATION	OFFSET	FOOT
	2023+84.0 2023+83.1 2024+84.0	17.1 LT 11.9 LT 9.9 LT	2023+83.6 2023+86.1 2024+79.2	15.8 LT 22.5 RT 36.8 RT	5.0 34.0 47.0
	TOTAL				86.0



USER NAME:	DESIGNED:	REVISED: ADDENDUM 1 - 2/22/2019
	CHECKED:	REVISED:
PLOT SCALE:	DRAWN: ATH	REVISED:
PLOT DATE: 2/22/2019	CHECKED: WLK	REVISED:

YAY CODE	ITEM			QUANTITY
60609800	COMBINATION (STATION	CONCRETE CUI	RB AND GUTTER, TYPE M-6.18 OFFSET	FOOT
	2028+54.5 SE QUAD OF H.			20.0 22.0
	TOTAL			42.0
PAY CODE	ITEM			QUANTITY
60610400	COMBINATION (CONCRETE CUI	RB AND GUTTER, TYPE M-6.24 OFFSET	FOOT
	2000+11.4 2000+56.6		E STEPHENSON ST E STEPHENSON ST	22.0 20.0
	TOTAL			42.0
PAY CODE	ITEM			QUANTITY
72000100	SIGN PANEL - STATION	TYPE 1 OFFSET	SIGN TYPE	SQ FT
	2000+02.4 2000+02.6	265.3' LT 15.3' LT	W11-15 W11-15	6.25 6.25
	2000+02.6	15.3' LT	W16-7P	2.00
	2000+58.7	267.2' RT	W11-15	6.25
	2000+59.1 2000+59.1	17.2' RT 17.2' RT	W11-15 W16-7P	6.25 2.00
	2000+70.8	17.2 IXT 10.9' LT	R1-1	2.25
	2002+50.5	RT	R5-3	4.00
	2002+81.8	LT	R1-2	2.25
	2024+53.7 2026+01.3	RT LT	W1-2L W1-2R	2.25 2.25
	2028+59.9	RT	R1-1	2.25
	2028+59.9	RT	D11-1	3.00
	2028+59.9 2029+50.0	RT LT	M6-1 D11-1	0.75 3.00
	2029+50.0	LT	M6-1	3.00 0.75
	2032+00.0	RT	D11-1	3.00
	2032+00.0	RT	M6-3	0.75
	2032+00.0	LT	D11-1	3.00
	2032+00.0 2034+20.0	LT RT	M6-3 D11-1	0.75 3.00
	2034+20.0	RT	M6-3	0.75
	2034+20.0	LT	D11-1	3.00
	2034+20.0	LT	M6-3	0.75
	2037+75.0 2037+75.0	RT RT	W14-2 D11-1	4.00 3.00
	2037+75.0	RT	M6-3	0.75
	2039+08.3	LT	D11-1	3.00
	2039+08.3	LT	M6-2	0.75
	2039+08.3	RT DT	D11-1	3.00
	2039+08.3 2039+08.3	RT RT	M6-2 R5-3	0.75 4.00
	2080+75.0	LT	R5-3	4.00
	2080+81.0	RT	R1-1	2.25
	2081+19.8	LT	R1-1	2.25
	2081+22.6 2081+22.6	RT RT	R5-3 W5-4A	4.00 2.25
	2107+50.5	LT	W11-15	2.25
	2107+50.5	LT	W11-15P	1.50
	2107+70.5	RT	W11-15	2.25
	2107+70.5 2112+36.9	RT LT	W11-15P W11-15	1.50 2.25
	2112+36.9 2112+36.9	LT	W11-15 W11-15P	2.25 1.50
	2112+65.3	RT	W11-15	2.25
	2112+65.3	RT	W11-15P	1.50
	2122+38.3	LT	W11-15	2.25
	2122+38.3 2122+57.8	LT RT	W11-15P W11-15	1.50 2.25
	2122+57.8	RT	W11-15P W11-15P	1.50
~~~	<del>2139+84.9</del>	$\widetilde{\mathcal{L}}$	W11-15	<u> </u>
	<del>2139+84.9</del>	<del>\\\\\\\\\\\\\\\\\\\\\\\\\\\\\\\\\\\\\</del>	W11-15P	<del>1.50-</del> /
	SHERIDAN ALI	GNMENT		
	0+20.7	RT	R5-3	4.00

	ITEM		QUANTITY
72800100	TELESCOPING STEEL		
	STATION	OFFSET	FOOT
	2000+58.7	267.2' RT	15.0
	2000+59.1	17.2' RT	15.0
	TOTAL		30.0
	70 11 12		00.0
PAY CODE	ITEM		QUANTITY
73000100	WOOD SIGN SUPPOR	т	
73000100	STATION STATION	OFFSET	FOOT
	0000.00.4	005 011 T	45.0
	2000+02.4 2000+02.6	265.3' LT 15.3' LT	15.0 15.0
	2000+02.8	10.9' LT	15.0
	2000+70.8	RT	15.0
	2002+81.8	LT	15.0
	2002+61.6	RT	15.0
	2024+53.7	LT	15.0
	2028+59.9	RT	15.0
	2029+50.0	LT	15.0
	2032+00.0	LT	15.0
	2032+00.0	RT	15.0
	2034+20.0	LT	15.0
	2034+20.0	RT	15.0
	2037+75.0	RT	15.0
	2039+08.3	LT	15.0
	2039+08.3	RT	15.0
	2080+75.0	LT	15.0
	2080+81.0	RT	15.0
	2081+19.8	LT	15.0
	2081+22.6	RT	15.0
	2107+50.5	LT	15.0
	2107+70.5	RT	15.0
	2112+36.9	LT	15.0
	2112+65.3	RT	15.0
	2122+38.3	LT	15.0
~~~	2122+57.8	RT RT	15.0
	2139:04.9		
	SHERIDAN ALIGNMEN 0+20.7	T RT	
			15.0
		KI	15.0
	TOTAL	KI	15.0
PAY CODE	TOTAL	KI	405.0
PAY CODE		KI	
PAY CODE 73100100	TOTAL ITEM BASE FOR TELESCOP	PING STEEL SIGN SUPPORT	QUANTITY
	TOTAL ITEM BASE FOR TELESCOPE STATION	PING STEEL SIGN SUPPORT OFFSET	QUANTITY EACH
	TOTAL ITEM BASE FOR TELESCOP	PING STEEL SIGN SUPPORT	QUANTITY
	TOTAL ITEM BASE FOR TELESCOP STATION 2000+58.7 2000+59.1	PING STEEL SIGN SUPPORT OFFSET 267.2' RT	QUANTITY EACH 1 1
	TOTAL ITEM BASE FOR TELESCOP STATION 2000+58.7	PING STEEL SIGN SUPPORT OFFSET 267.2' RT	QUANTITY EACH 1
73100100	TOTAL ITEM BASE FOR TELESCOP STATION 2000+58.7 2000+59.1	PING STEEL SIGN SUPPORT OFFSET 267.2' RT	QUANTITY EACH 1 1
73100100 PAY CODE	TOTAL ITEM BASE FOR TELESCOP STATION 2000+58.7 2000+59.1 TOTAL ITEM	PING STEEL SIGN SUPPORT OFFSET 267.2' RT 17.2' RT	QUANTITY EACH 1 1 2
PAY CODE 73100100 PAY CODE 78000400	TOTAL ITEM BASE FOR TELESCOP STATION 2000+58.7 2000+59.1 TOTAL ITEM	PING STEEL SIGN SUPPORT OFFSET 267.2' RT	QUANTITY EACH 1 1 2
73100100 PAY CODE	TOTAL ITEM BASE FOR TELESCOP STATION 2000+58.7 2000+59.1 TOTAL ITEM THERMOPLASTIC PANSTATION	PING STEEL SIGN SUPPORT OFFSET 267.2' RT 17.2' RT	QUANTITY EACH 1 1 2 QUANTITY

PAY CODE	ITEM			QUANTITY
7800650	THERMOPLASTI STATION	C PAVEMENT I	MARKING - LINE 24" OFFSET/COMMENTS	FOOT
	2000+13.9	2000+54.1	CROSSWALK	100.0
	TOTAL			100.0
PAY CODE	ITEM			QUANTIT
78001110	PAINT PAVEMEI STATION	NT MARKING -	LINE 4" OFFSET/COMMENTS	FOOT
	1999+58.0 2000+65.0 2000+65.0	2000+03.5 2002+46.0 2028+59.5	CENTERLINE 3' DASH/9' SKIP LT & RT / EDGE LINE CENTERLINE 3' DASH/9' SKIP	12.0 362.0 699.0
	SHERDIAN AVE 0+00.0	2+79.0	CENTERLINE 3' DASH/9' SKIP	72.0
	TOTAL			1,145.0
PAY CODE	ITEM			QUANTITY
78001130	PAINT PAVEMEI STATION	NT MARKING -	LINE 6" OFFSET/COMMENTS	FOOT
	2080+88.9	2081+08.9	CROSSWALK	40.0
	TOTAL			40.0
PAY CODE	ITEM			QUANTIT
78001180	PAINT PAVEMEI STATION	NT MARKING -	LINE 24" OFFSET/COMMENTS	FOOT
	2080+88.9	2081+08.9	CROSSWALK	50.0
	TOTAL			50.0
PAY CODE	ITEM			QUANTIT
78200011	BARRIER WALL STATION	REFLECTOR, 1	TYPE C OFFSET/COMMENTS	EACH
	2059+08.5	2060+32.0	BRIDGE #103	12
	TOTAL			12
PAY CODE	ITEM			QUANTIT
89502385	REMOVE EXISTI STATION	NG CONCRETE	FOUNDATION OFFSET	EACH
	2019+68.2		0.5' RT	1



USER NAME:	DESIGNED:	REVISED: ADDENDUM 1 - 2/22/2019
	CHECKED:	REVISED:
PLOT SCALE:	DRAWN: ATH	REVISED:
PLOT DATE: 2/22/2019	CHECKED: WLK	REVISED:

STATE OF ILLINOIS	
CITY OF FREEPORT	

SCHEDULE OF QUANTITIES (4) FREEPORT PEC PATH		- SECTION				SHEE NO.	
		15-00163-00-BT		STEPHENSON	106	09	
		FREEPORT			CONTRACT N	0. 856	74
SHEET NO. OF SHEETS			ILLINOIS	FED. A	AID PROJECT —		

	ITEM		QUANTITY
A 0000 1 1 5		MN BLAZE (AUTUMN BLAZE FREE!	ЛAN
A2000116	MAPLE), 2" CALIPER, BALLED AI STATION	ND BURLAPPED OFFSET	EACH
	VARIOUS LOCATIONS TO BE DE	TERMINED IN THE FIELD	34
	TOTAL		34
PAY CODE	ITEM		QUANTITY
A2008116	TREE, TILIA CORDATA GREENSF LINDEN), 2" CALIPER, BALLED AI STATION		EACH
	VARIOUS LOCATIONS TO BE DE	TERMINED IN THE FIELD	34
	TOTAL		34
PAY CODE	ITEM		QUANTITY
X0100003	CLEARING AND GRUBBING STATION	OFFSET	SQ YD
	2040+32.0 2065+91.0	7' LT & RT	3,980.7
	SHERIDAN AVE 0+00.0 2+79.0	7' LT & RT	434.0
	TOTAL		4,414.7
PAY CODE	ITEM		QUANTITY
			QOANTITI
X0301797	GATE REMOVAL		
X0301191	STATION	OFFSET	EACH
×		OFFSET	EACH 1 1
X0001797	STATION 2019+37.1	OFFSET	EACH 1 1 2 2
X0001797	STATION 2019+37.1 2035+63.0 2131+80.0	OFFSET	EACH 1 1 2 2
	STATION 2019+37.1 2035+63.0 2131+80.0	OFFSET	EACH 1 1 2 2 QUANTITY
PAY CODE	STATION 2019+37.1 2035+63.0 2131+80.9 TOTAL		1 1 2 2
PAY CODE	STATION 2019+37.1 2035+63.0 2131+80.9 TOTAL ITEM PEDESTRIAN TRUSS SUPER STE	RUCTURE	1 1 2 2 QUANTITY
PAY CODE	STATION 2019+37.1 2035+63.0 2131+80.0 TOTAL ITEM PEDESTRIAN TRUSS SUPER STESTATION	RUCTURE OFFSET	QUANTITY SQ FT
PAY CODE	\$TATION 2019+37.1 2035+63.0 2131+80.0 TOTAL ITEM PEDESTRIAN TRUSS SUPER STE STATION 2059+08.5 2060+32.0	RUCTURE OFFSET	QUANTITY SQ FT 1,482.0
PAY CODE X0322508	\$TATION 2019+37.1 2035+63.0 2131+80.0 TOTAL ITEM PEDESTRIAN TRUSS SUPER STE STATION 2059+08.5 2060+32.0 TOTAL	RUCTURE OFFSET BRIDGE #103	QUANTITY SQ FT 1,482.0 1,482.0
PAY CODE X0322508	STATION 2019+37.1 2035+63.0 2191+80.0 TOTAL ITEM PEDESTRIAN TRUSS SUPER STE STATION 2059+08.5 2060+32.0 TOTAL ITEM	RUCTURE OFFSET BRIDGE #103	QUANTITY SQ FT 1,482.0 1,482.0
PAY CODE X0322508	STATION 2019+37.1 2035+63.0 2191+80.0 TOTAL ITEM PEDESTRIAN TRUSS SUPER STE STATION 2059+08.5 2060+32.0 TOTAL ITEM FLASHING BEACON, POST MOUI INSTALLATION	RUCTURE OFFSET BRIDGE #103 NTED, SOLAR POWERED	1 1 2 2 QUANTITY SQ FT 1,482.0 1,482.0 QUANTITY
PAY CODE X0322508	STATION 2019+37.1 2035+63.0 2131+80.0 TOTAL TOTAL ITEM PEDESTRIAN TRUSS SUPER STESTATION 2059+08.5 2060+32.0 TOTAL ITEM FLASHING BEACON, POST MOUI INSTALLATION STATION 2000+02.40	RUCTURE OFFSET BRIDGE #103 NTED, SOLAR POWERED OFFSET 73.8' LT	QUANTITY SQ FT 1,482.0 1,482.0 QUANTITY EACH 1
PAY CODE X0322508 PAY CODE X0325714	STATION 2019+37.1 2035+63.0 2131+89.9 TOTAL ITEM PEDESTRIAN TRUSS SUPER STESTATION 2059+08.5 2060+32.0 TOTAL ITEM FLASHING BEACON, POST MOUINSTALLATION STATION 2000+02.40 2000+58.70	RUCTURE OFFSET BRIDGE #103 NTED, SOLAR POWERED OFFSET 73.8' LT	QUANTITY SQ FT 1,482.0 1,482.0 QUANTITY EACH 1 1
PAY CODE X0322508	STATION 2019+37.1 2035+63.0 2131+86.8 TOTAL ITEM PEDESTRIAN TRUSS SUPER STESTATION 2059+08.5 2060+32.0 TOTAL ITEM FLASHING BEACON, POST MOUI INSTALLATION STATION 2000+02.40 2000+58.70 TOTAL	RUCTURE OFFSET BRIDGE #103 NTED, SOLAR POWERED OFFSET 73.8' LT 97.2' RT	QUANTITY SQ FT 1,482.0 1,482.0 QUANTITY EACH 1 1 2
PAY CODE X0322508 PAY CODE X0325714	STATION 2019+37.1 2035+63.0 2131+80.0 TOTAL TOTAL ITEM PEDESTRIAN TRUSS SUPER STESTATION 2059+08.5 2060+32.0 TOTAL ITEM FLASHING BEACON, POST MOUI INSTALLATION STATION 2000+02.40 2000+58.70 TOTAL ITEM REMOVE AND RELOCATE SIGN (1)	RUCTURE OFFSET BRIDGE #103 NTED, SOLAR POWERED OFFSET 73.8' LT 97.2' RT	QUANTITY SQ FT 1,482.0 1,482.0 QUANTITY EACH 1 1 2 QUANTITY

PAY CODE	ITEM			QUANTIT
X0327423		I TO EXISTING CL		
	STATION		OFFSET	EACH
	2111+14.1		25.1' LT	1
	TOTAL			1
PAY CODE	ITEM			QUANTIT
X0327979	PAVEMENT N	ARKING REMOV	/AL - GRINDING	
	STATION		OFFSET	SQ FT
	2000+27.2 2000+29.6		LT/RT LT/RT	3.5 3.5
	TOTAL			7.0
DAY 0005				01144177
PAY CODE	ITEM			QUANTIT
X2020105	GRADING AN STATION	D SHAPING BIKE	WAY OFFSET	UNIT
	2081+24.0	2091+51.0	LT/RT	10.3
	TOTAL			10.3
	IOIAL			10.3
PAY CODE	ITEM			QUANTIT
X6024504		E B, WITH FRAME	E AND GRATE, SPECIAL	EACH
	STATION		OFFSET	
	2019+26.6 2023+82.9		10.0' LT 13.9' LT	1 1
	2024+84.5		11.8' LT	1
	TOTAL			3
DAY 22=	IT			
PAY CODE	ITEM			QUANTIT
XX006345	TURBIDITY BA	ARRIER	OFFSET	FOOT
	2058+48.2 2060+36.2	2058+83.6 2060+64.3	54.4' RT to 57.2' LT 52.2' RT to 53.0' LT	256.0 182.0
	TOTAL			438.0
PAY CODE	ITEM			OLIANTIT
TAT CODE	II⊏IVI			QUANTIT
XX006653	FENCE (SPEC	CIAL)	OFFSET	FOOT
	2019+37.0	2022+96.0	19.0' LT	359.0
	TOTAL			359.0
PAY CODE	ITEM			QUANTIT
		T DIL INIO VALLETON	(CLE DAILING	
XX008638	STEEL SHEE STATION	T PILING W/ BICY	CLE RAILING OFFSET	FOOT
-	2124+34.3	2125+44.5		110.0 110.0
	2127+84.4 2131+35.0	2128+94.7 2132+45.3		110.0 110.0
	2134+84.1	2135+94.1		110.0
-	2137+79.6	2138+89.8		110.0
•	2140+81.9	2141+92.1		110.0
•	2144+01.4	2145+12.9		110.0
	2146+85.4	2147+92.4		110.0
•	2149+88.9	2150+88.6		100.0

ITEM			QUANTITY
BOLLARDS STATION		OFFSET	EACH
2035+63.0		9.3' RT	1
2035+63.0 2035+63.0		0' RT 7.5' LT	1 1
	NUE	5' RT	1
0+35.0		0' RT	1
		5' L I	1
TOTAL			6
ITEM			QUANTITY
FENCE REMOVA	AL	OFFSET	FOOT
2019+37.1		20' LT - 8' RT	28.0
2131-100.			
TOTAL			28.0
ITEM			QUANTITY
TEMPORARY CO	ONSTRUCTION F	ENCE OFFSET	FOOT
2024+63.7	2027+40.4	24.2' LT to 16.4' LT	216.0
TOTAL			216.0
ITEM			QUANTITY
RAILROAD TRAC	CK REMOVAL	OFFSET	FOOT
2080+68.0 2107+59.0	2081+06.0 2107+69.3	LT/RT LT/RT	38.0 38.0
TOTAL			76.0
ITEM			QUANTITY
SELECTIVE CLE	ARING		
STATION		OFFSET	ACRE
2012+12.0	2016+25.0	0' RT to 8' RT	0.1
TOTAL			0.1
ITEM			QUANTITY
WOOD RAIL STATION		OFFSET/COMMENTS	FOOT
2058+99.2	2059+09.6	NW CORNER BRIDGE #103	8.0
2058+99.2	2059+09.6 2060+41.3	SW CORNER BRIDGE #103 NE CORNER BRIDGE #103	8.0 8.0
ろしたいするい ひ		INC COMINCIA DUIDGE #103	0.0
2060+30.9 2060+30.9	2060+41.3	SE CORNER BRIDGE #103	8.0
	BOLLARDS STATION 2035+63.0 2035+63.0 2035+63.0 SHERDIAN AVE 0+35.0 0+35.0 TOTAL ITEM FENCE REMOVE STATION 2019+37.1 2131+80.9 TOTAL ITEM TEMPORARY COSTATION 2024+63.7 TOTAL ITEM RAILROAD TRACE STATION 2080+68.0 2107+59.0 TOTAL ITEM SELECTIVE CLE STATION 2012+12.0 TOTAL ITEM WOOD RAIL STATION 2058+99.2	BOLLARDS STATION 2035+63.0 2035+63.0 2035+63.0 SHERDIAN AVENUE 0+35.0 0+35.0 0+35.0 TOTAL ITEM FENCE REMOVAL STATION 2019+37.1 2131+89.8 TOTAL ITEM TEMPORARY CONSTRUCTION F STATION 2024+63.7 2027+40.4 TOTAL ITEM RAILROAD TRACK REMOVAL STATION 2080+68.0 2107+69.3 TOTAL ITEM SELECTIVE CLEARING STATION 2012+12.0 2016+25.0 TOTAL ITEM WOOD RAIL STATION 2058+99.2 2059+09.6	BOLLARDS STATION OFFSET 2035+63.0 9.3' RT 2035+63.0 7.5' LT SHERDIAN AVENUE 0+35.0 0' RT 0+35.0 1' RT 0+35.0 1' RT 0+35.0 1' RT 0+35.0 1' RT 0+35.0 0' RT 0+35.




USER NAME:	DESIGNED:	REVISED: 1 - 2/22/201
	CHECKED:	REVISED:
PLOT SCALE:	DRAWN: ATH	REVISED:
PLOT DATE: 2/22/2019	CHECKED: WLK	REVISED:

OVERALL PROJECT CONTROL



BENCHMARKS

BENCHMARKS					
NO.	DESCRIPTION	ELEVATION			
BM 781	BM 781 USGS Disk in west end of top step at the south entrance to post office building in Freepot at NEX N. Chicago Ave and E. Exchange St.				
BM 1	RR Spike in Power Pole ±75 Northwest of Stephenson St. Bridge over Pecatonica River	766.22			
BM 2	South Bonnet Bolt on Fire Hydrant at the Northeast corner of Commercial and Stephenson St. (US Hwy. 75)	761.55			
BM 3	Southeast Bonnet Bolt on top flange of Fire Hydrant at Northwest corner of Sherman St. and Stephenson St.(US Hwy. 75)	760.38			
BM 4	RR Spike in Power Pole at Northeast corner of Mary Ave. and Album Street. 2037+73± 20'± LT.	756.27			
BM 300	RR Spike in Tree near Bridge 103 south side of old Railroad bed. 2058+57± 22'± RT.	753.19			
BM 301	Cut "x" in North Bolt on 6 foot diameter Metal Comed Electrical Pole 2066+66± 19'± RT.	757.61			
BM 302	Chiseled square on Sanitary Manhole Rim at Northwest corner of Structo Rd. and railroad bed. 2080+60± 43°± LT.	756.21			
BM 303	RR Spike in Power Pole #2360 Sta. 2104+19± 13'± Rt.	768.55			
BM 304	RR Spike in Power Pole #2350 Sta. 2138+35± 5'± Lt.	758.47			

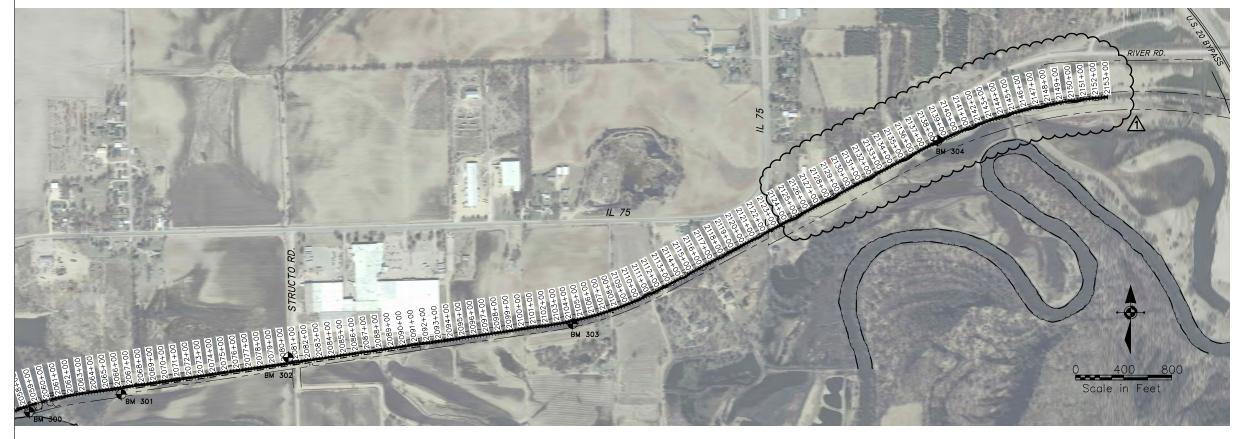


NOTES

- 1. COORDINATES ARE BASED ON STATE PLANE COORDINATES.
- 2. BENCHMARK ELEVATIONS ARE BASED ON NAVD 88 TAKEN FROM NGS CONTROL (PID NH 0646; DES 781 USGS)
- 3. EXISTING PROPERTY CORNERS TO BE PROTECTED (SEE GENERAL NOTES)
- THE CONTRACTOR SHALL VERIFY ALL SURVEY CONTROL BEFORE USING AND REPORT ANY DISCREPENCIES TO THE ENGINEER.

◆IM	EG
120 S 1ST STREET	PH: 815.956.6400
ROCKFORD, IL 61350	www.imegcorp.com
FORM	IERLY
The same of the	McClure

USER NAME:	DESIGNED:	REVISED: 1 ADDENDUM 1 - 2/22/2019
	CHECKED:	REVISED:
PLOT SCALE:	DRAWN: ATH	REVISED:
PLOT DATE: 2/22/2019	CHECKED: WLK	REVISED:

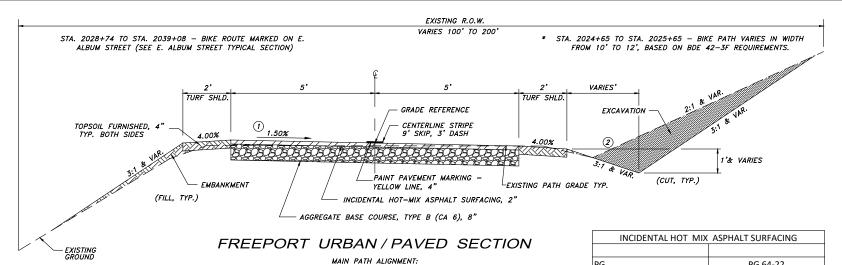

STA. 1999+58 TO STA. 2000+03 - NORTH OF STEPHENSON ST


STA. 2000+65 TO STA. 2002+46 - PATH MARKED ACROSS EXISTING CONCRETE PARKING LOT

STA. 2024+61 TO STA. 2028+59 - HANCOCK BRIDGE TO ALBUM ST

SHERIDAN AVE. ALIGNMENT: STA. 0+00 TO STA. 2+79

STA. 2002+46 TO STA. 2023+74 - SOUTH OF STEPHENSON ST. TO HANCOCK BRIDGE


PG 64-22 4.0 % @ N50 DESIGN AIR VOIDS MIXTURE COMPOSITION IL 9.5 FG (GRADATION MIXTURE) FRICTION AGGREGATE 20 YEAR ESAL NA 112 lbs/sy/inch MIX UNIT WEIGHT

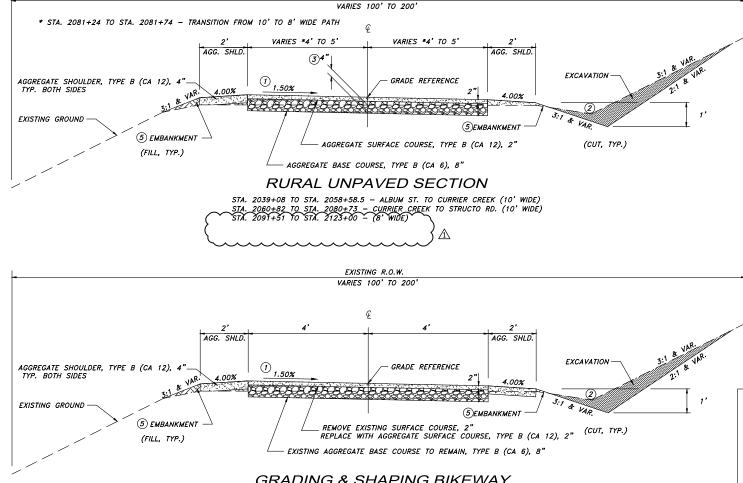

GRADING & SHAPING BIKEWAY


(SEE SPECIAL PROVISIONS)

STA. 2081+24 TO STA. 2091+51 - 2" SURFACE & SHOULDER ONLY EAST OF STRUCTO RD (8' WIDE)

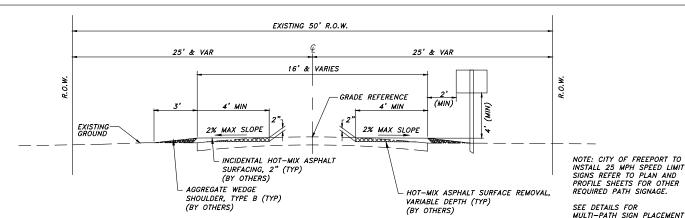

E. ALBUM STREET SECTION - (STA 2028+74 TO 2039+08)

(SHARED USE FACILITY< 2,000 ADT)

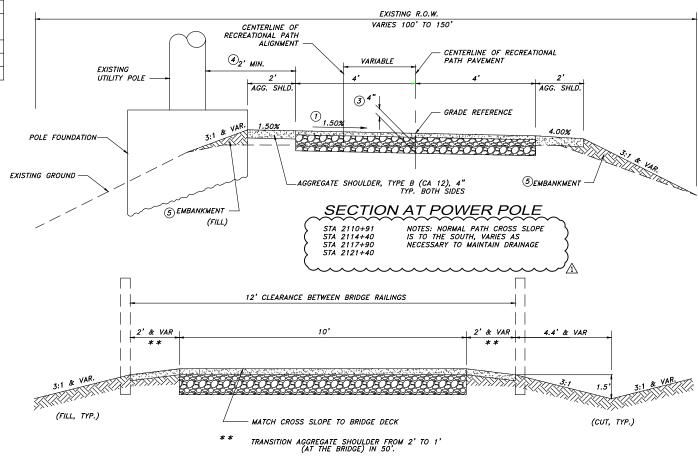

APPROACH SECTION AT BRIDGE #103

SEE FREEPORT URBAN/PAVED SECTIONS FOR ADDITIONAL DETAILS AND NOTES STA. 2058+58.5 TO STA. 2060+82 (EXCLUDING BRIDGE STRUCTURE)


NOTES:


- 1 TYPICAL PATH CROSS SLOPE IS TOWARD PECATONICA RIVER OR SOUTHERLY & AWAY FROM POWER POLES. REVERSE SLOPE AS SHOWN IN THE CROSS SECTIONS. TRANSITION LENGTH SHALL BE 50' MINIMUM DISTANCE WHEN REVERSING SLOPE.
- (2) VARIES AS NECESSARY TO MAINTAIN DRAINAGE. CONSULT CROSS SECTIONS FOR SPECIAL DITCH CUTS.
- (3) NOMINAL 4" SURFACE ORGANIC MATERIAL IS TO BE REMOVED AND USED TO BUILD SHOULDERS. THIS REMOVAL IS TO BE PAID FOR AS PART OF SHAPING AND GRADING ROADWAY.
- (4) CLEARANCE AT POLES IS 2' TO EITHER THE FOUNDATION RING OR THE FACE OF POLE IF NO FOUNDATION RING IS PRESENT.
- (\$) EMBANKMENT AS SHOWN WILL NOT BE PAID FOR SEPARATELY, BUT IS THE RESULT OF GRADING AND SHAPING ROADWAY. IF FILL MATERIAL MUST BE BROUGHT FROM A REMOTE LOCATION, IT WILL BE PAID AS EARTH EXCAVATION (FOR EMBANKMENT EXCAVATED WITHIN THE PATH RIGHT-OF-WAY) OR FURNISHED EXCAVATION. (IF PROVIDED FROM A REMOTE SOURCE).


	USER NAME:	DESIGNED:	REVISED: 1 - 2/22/201
		CHECKED:	REVISED:
	PLOT SCALE:	DRAWN: ATH	REVISED:
	PLOT DATE: 2/22/2019	CHECKED: WLK	REVISED:


STATE OF ILLINOIS **CITY OF FREEPORT**


SECTION COUNTY **TYPICAL SECTIONS - PROPOSED 1** STEPHENSON 106 13 N.A. 15-00163-00-BT FREEPORT PEC PATH CITY OF FREEPORT CONTRACT NO. 85674 SHEET NO. OF SHEETS

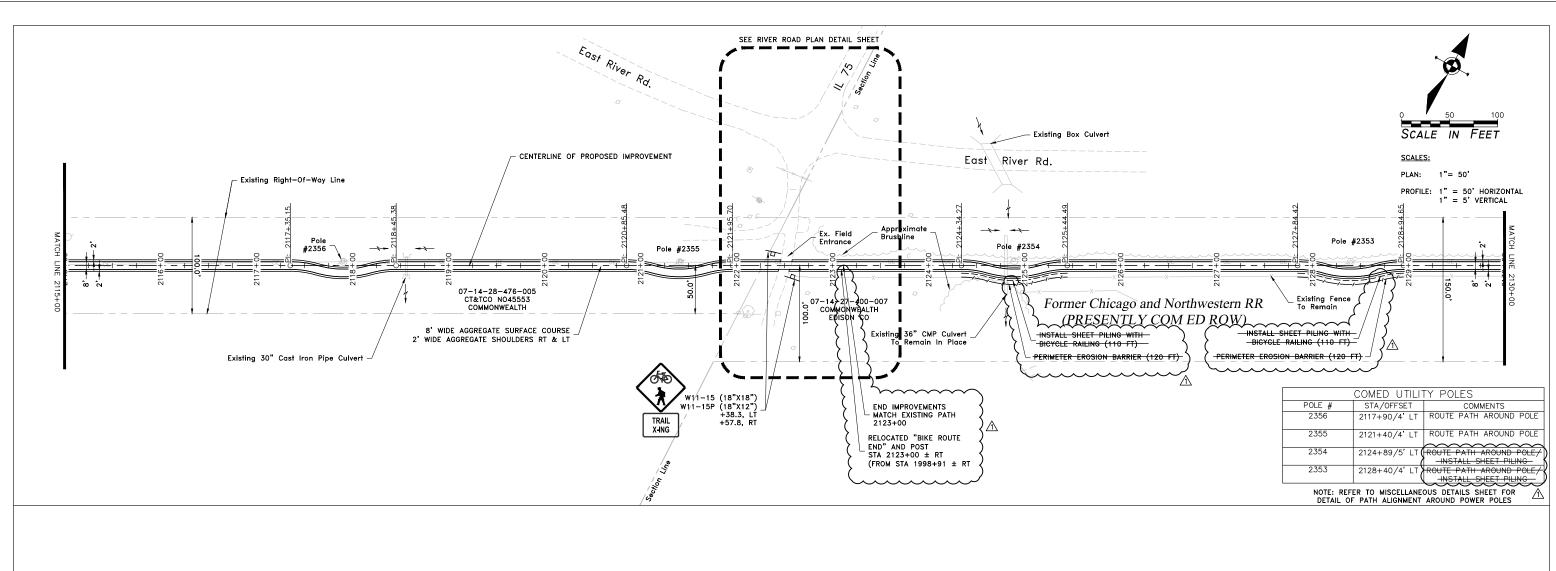


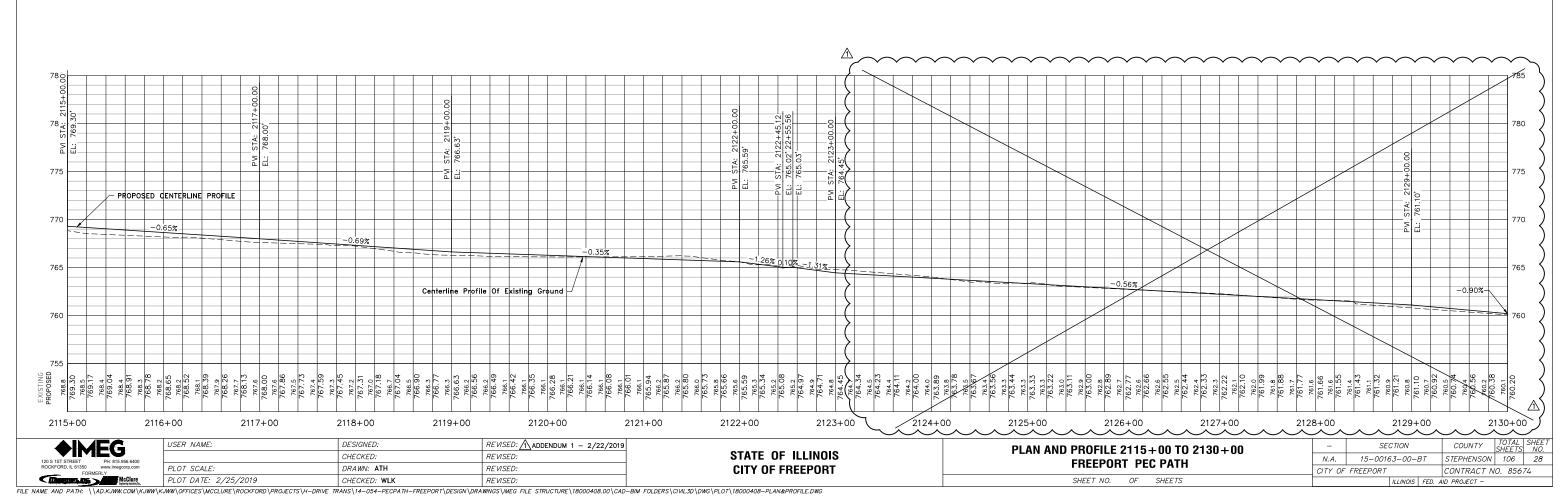


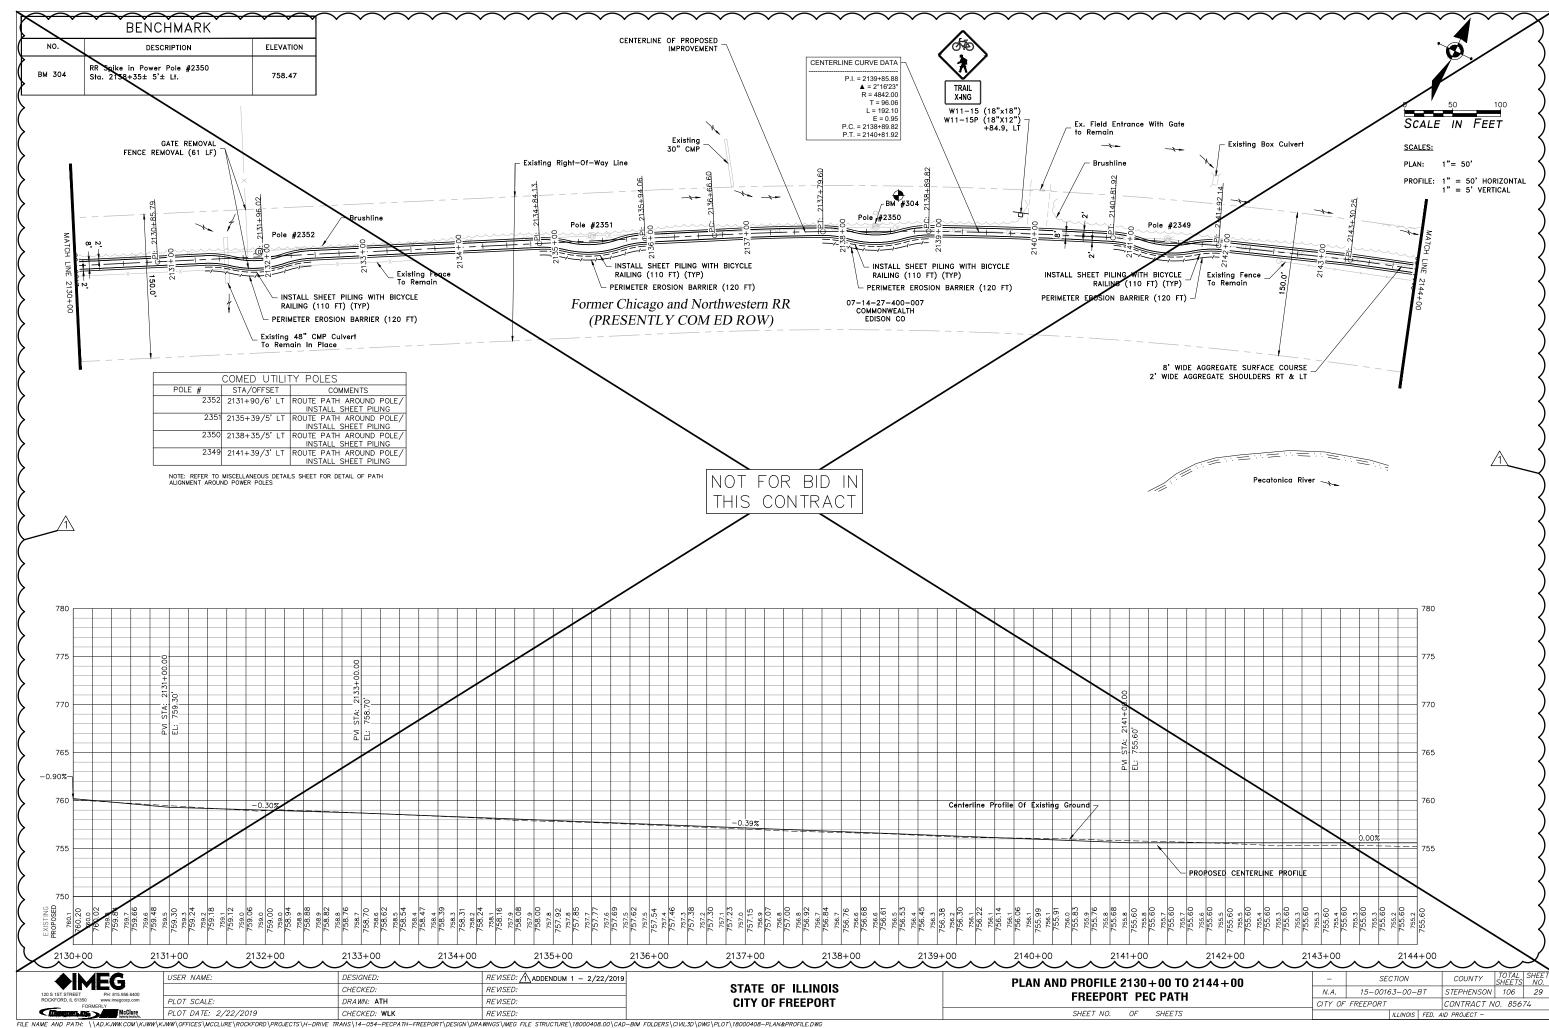


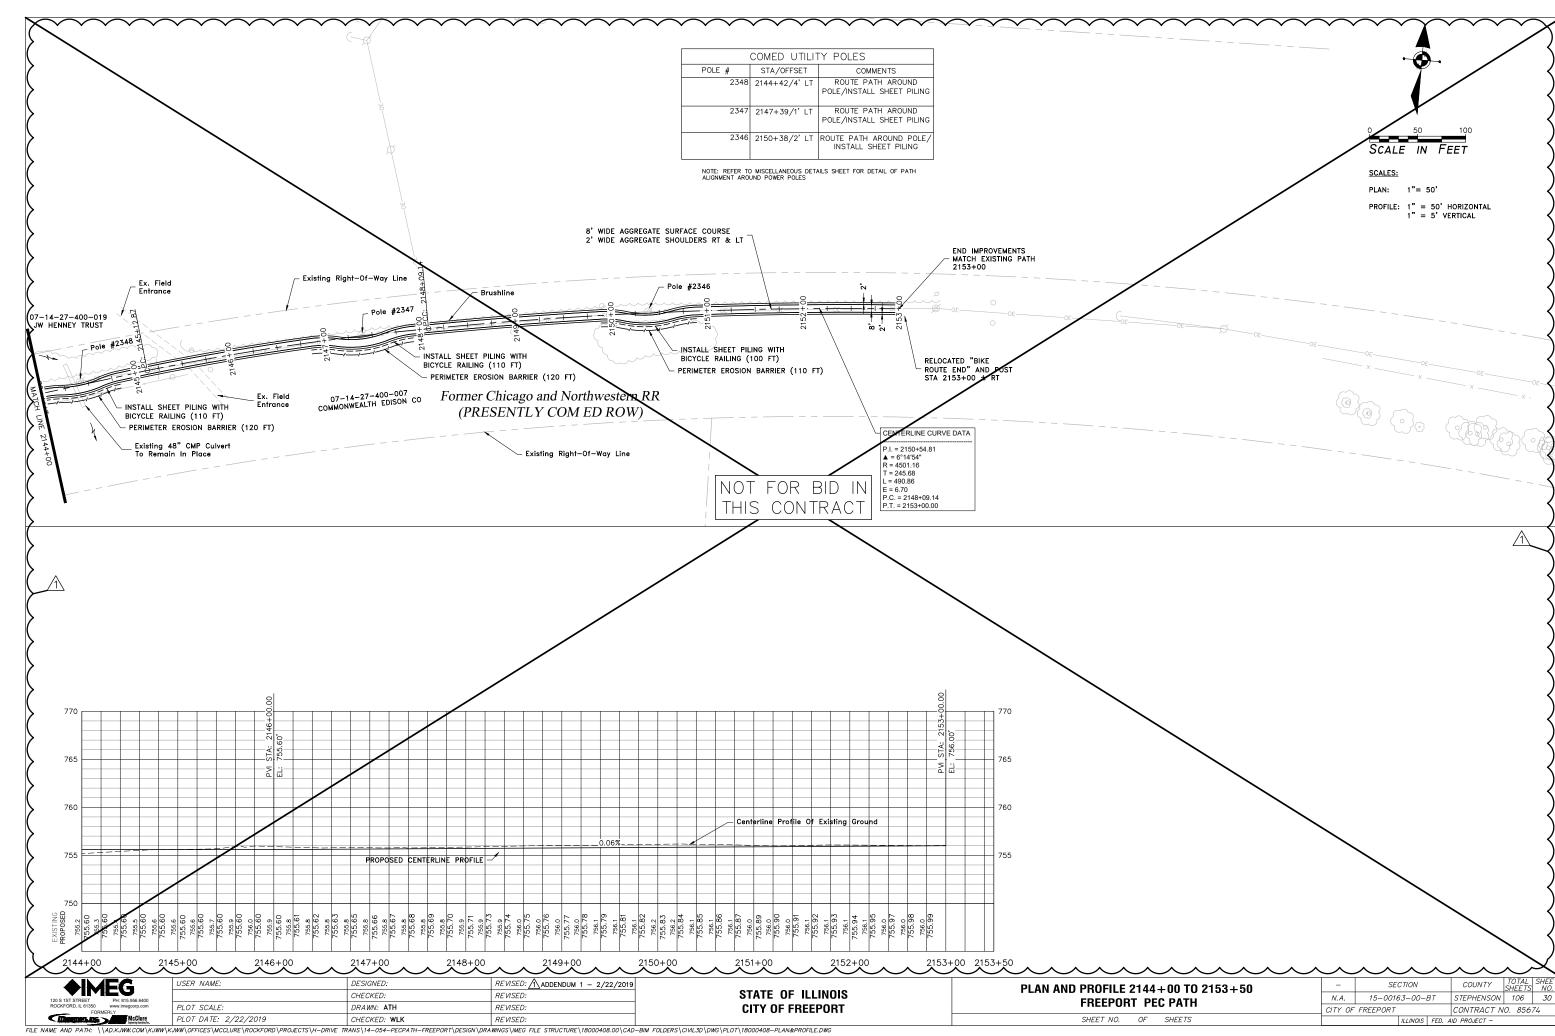

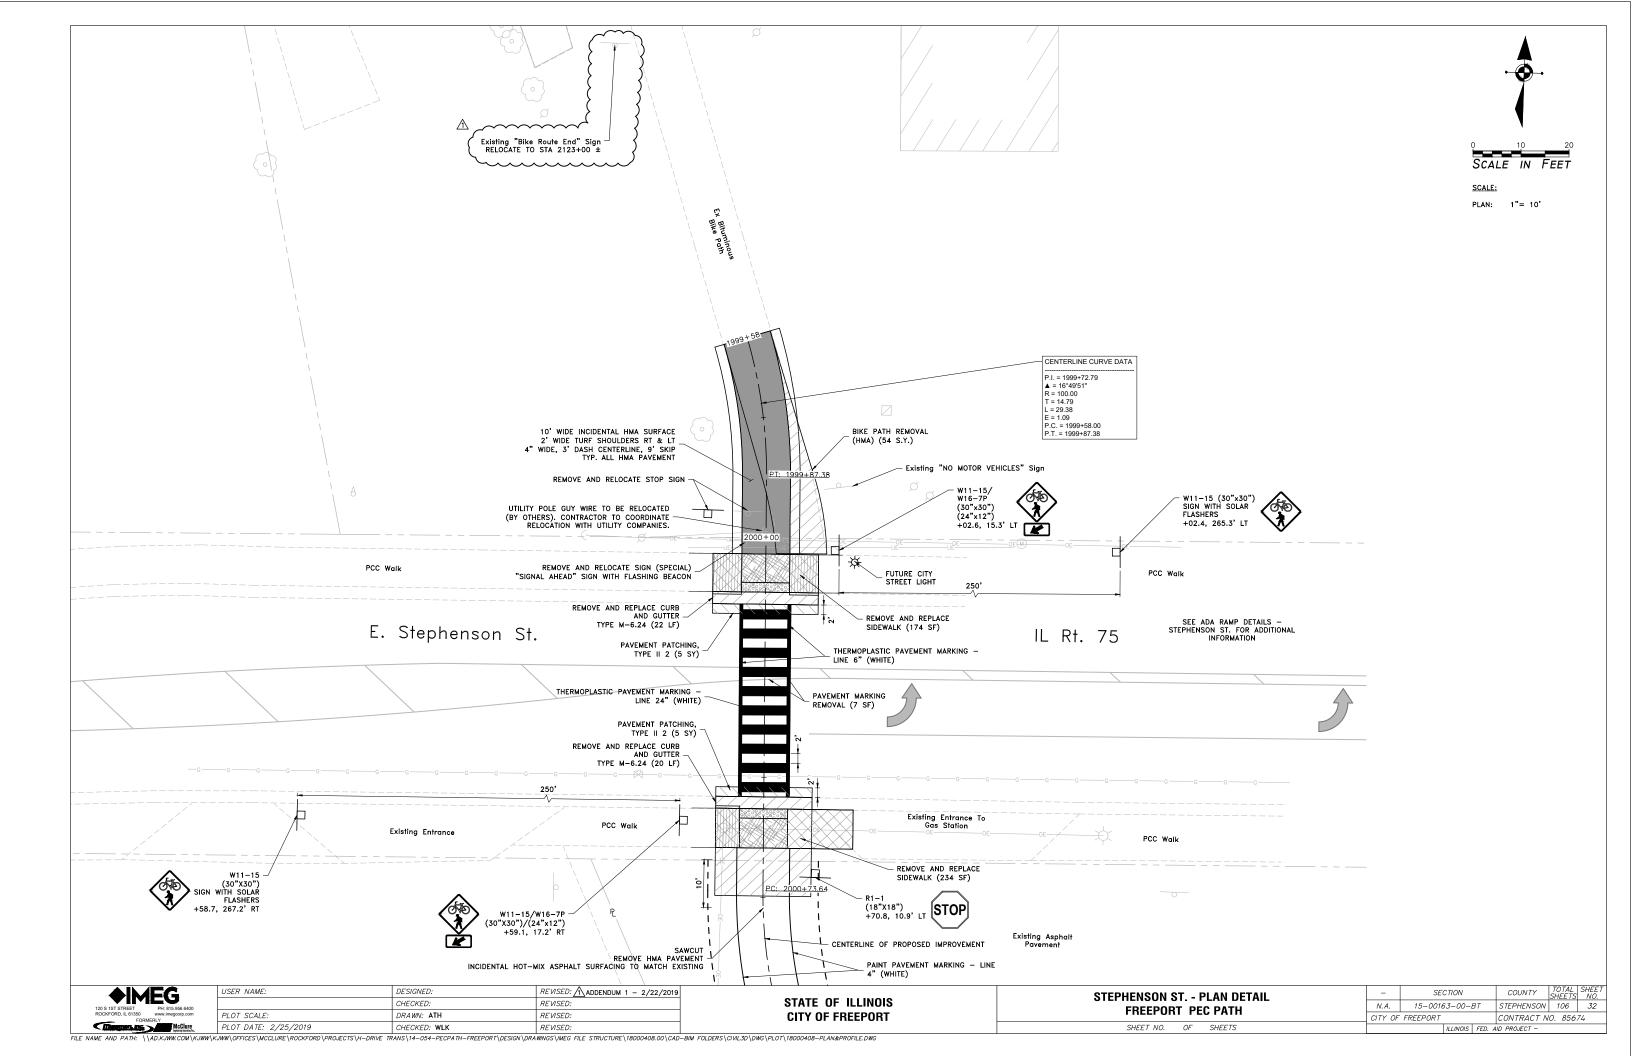

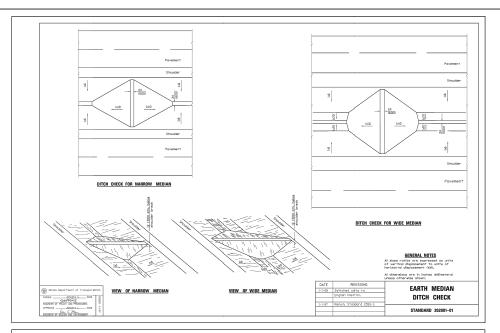

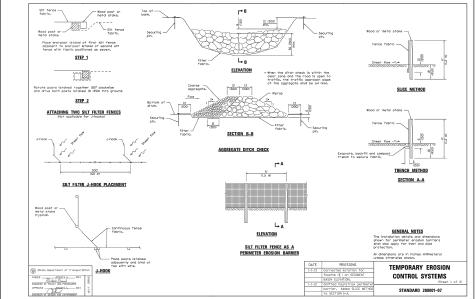

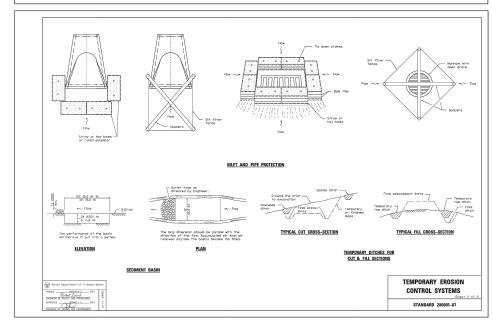

TOPSOIL / SEEDING

- 1. DISTURBED AREAS ARE LOCATIONS WHERE THE CONTRACTOR'S OPERATIONS HAVE DAMAGED EXISTING GROUND COVER AND/OR TOPSOIL OUTSIDE OF THE LIMITS OF CONSTRUCTION AS SHOWN IN THE PLANS. SEEDING OF THESE DISTURBED AREAS IS INCLUDED IN ALL THE OTHER PROJECT PAY ITEMS AND NO ADDITIONAL COMPENSATION IS ALLOWED.
- 2. THE FINAL TOP 4 INCHES OF SOIL IN ANY AREA MUST BE A COHESIVE SOIL CAPABLE OF SUPPORTING VEGETATION.
- 3. FERTILIZER SHALL BE APPLIED AT A RATE OF 180 LB/AC TO ALL DISTURBED AREAS AND INCORPORATED INTO THE SEEDBED PRIOR TO SOWING THE SEED.
- 4. THE CONTRACTOR SHALL SEED ALL AREAS WITHIN THE LIMITS OF CONSTRUCTION WITH SEEDING, CLASS 1 OR CLASS 4, WHERE INDICATED, IN ACCORDANCE WITH IDOT STANDARD SPECIFICATIONS OR AS APPROVED BY THE ENGINEER.

MAINTENANCE NOTES

ALL BMP MEASURES STATED ON THIS STORM WATER POLLUTION PREVENTION MAP AND PLAN SHALL BE MAINTAINED IN FULLY FUNCTIONAL CONDITION UNTIL NO LONGER REQUIRED FOR A COMPLETED PHASE OF WORK OR FINAL STABILIZATION OF THE ROADWAY PROJECT. ALL EROSION AND SEDIMENTATION CONTROL MEASURES SHALL BE CHECKED AND ENTERED INTO AN INSPECTION RECORD LOG BY A QUALIFIED PERSON AT LEAST ONCE EVERY SEVEN (7) CALENDAR DAYS AND WITHIN 24 HOURS OF THE END OF A 0.5" RAINFALL EVENT, AND CLEANED AND REPAIRED IN ACCORDANCE WITH THE FOLLOWING.

- 1. INLET PROTECTION DEVICES AND BARRIERS SHALL BE REPAIRED OR REPLACED IF THEY SHOW SIGNS OF UNDERMINING, OR DETERIORATION.
- 2. ALL SEEDED AREAS SHALL BE CHECKED REGULARLY TO SEE THAT A GOOD STAND IS ACHIEVED AND MAINTAINED. AREAS SHOULD BE FERTILIZED, WATERED, MULCHED AND RESEEDED AS NEEDED.
- 3. SILT FENCES SHALL BE REPAIRED TO THEIR ORIGINAL CONDITIONS IF DAMAGED. SEDIMENT SHALL BE REMOVED FROM THE SILT FENCES WHEN IT REACHES ONE—HALF THE HEIGHT OF THE SILT
- 4. THE CONSTRUCTION AREA ACCESSES SHALL BE MAINTAINED IN A CONDITION WHICH WILL PREVENT TRACKING OR FLOW OF MUD ONTO PAVED ROAD SURFACES OR OUTSIDE WORK AREA. THIS MAY REQUIRE PERIODIC ROAD SWEEPING.

STORMWATER POLLUTION PREVENTION

- 1. THE STORMWATER POLLUTION PREVENTION PLAN IS COMPRISED OF THE PLAN DRAWING MAPS, SWPPP PLAN NARRATIVE SPECIFICATIONS, THE PERMIT AND ALL SUBSEQUENT REPORTS AND
- 2. ALL CONTRACTORS AND SUBCONTRACTORS INVOLVED WITH STORM WATER POLLUTION PREVENTION SHALL OBTAIN A COPY OF THE STORM WATER POLLUTION PREVENTION PLAN, ILLINOIS EPA NPDES GENERAL PERMIT AND BECOME FAMILIAR WITH THEIR CONTENTS.
- 3. CONTRACTOR SHALL IMPLEMENT BEST MANAGEMENT PRACTICES (BMP) AS REQUIRED BY THE SWPPP. ADDITIONAL BEST MANAGEMENT PRACTICES SHALL BE IMPLEMENTED AS DICTATED BY CONDITIONS AT NO ADDITIONAL COST TO OWNER THROUGHOUT ALL PHASES OF CONSTRUCTION.
- 4. BEST MANAGEMENT PRACTICES (BMP'S) AND CONTROLS SHALL CONFORM TO FEDERAL, STATE, OR LOCAL REQUIREMENTS OR MANUAL OF PRACTICE, AS APPLICABLE. CONTRACTOR SHALL IMPLEMENT ADDITIONAL CONTROLS AS DIRECTED BY PERMITTING AGENCY OR OWNER.
- 5. GENERAL CONTRACTOR SHALL DENOTE ON PLAN THE TEMPORARY PARKING AND STORAGE AREA WHICH SHALL ALSO BE USED AS THE EQUIPMENT MAINTENANCE AND CLEANING AREA.
- ALL WASH WATER (CONCRETE TRUCKS, VEHICLE CLEANING, EQUIPMENT CLEANING, ETC.) SHALL BE DETAINED AND PROPERLY TREATED OR DISPOSED.
- 7. QUALIFIED PERSONNEL SHALL INSPECT DISTURBED AREAS OF THE CONSTRUCTION SITE WHICH HAVE NOT YET BEEN FINALLY STABILIZED, STRUCTURAL CONTROL MEASURES, AND LOCATIONS WHERE VEHICLES AND EQUIPMENT ENTER AND EXIT THE SITE. SUCH INSPECTIONS SHALL BE CONDUCTED AT LEAST ONCE EVERY SEVEN (7) CALENDAR DAYS AND WITHOU 24 HOURS OF THE END OF A STORM THAT IS 0.5 INCHES OR GREATER OR EQUIVALENT SNOWFALL.
- 8. SUFFICIENT OIL AND GREASE ABSORBING MATERIALS AND OIL CONTAINMENT FLOATING BOOMS SHALL BE MAINTAINED ON SITE OR READILY AVAILABLE TO CONTAIN AND CLEAN-UP FUEL OR CHEMICAL SPILLS AND LEAKS.
- 9. TEMPORARY SEEDING THIS ITEM WILL BE APPLIED TO ALL BARE AREAS EVERY SEVEN DAYS TO MINIMIZE THE AMOUNT OF EXPOSED SURFACE AREAS. EARTH STOCKPILES SHALL BE TEMPORARILY SEEDED IF THEY ARE TO REMAIN UNUSED FOR MORE THAN 14 DAYS. WITHIN THE CONSTRUCTION LIMITS, AREAS WHICH MAY BE SUSCEPTIBLE TO EROSION AS DETERMINED BY THE ENGINEER SHALL REMAIN UNDISTURBED UNTIL FULL SCALE CONSTRUCTION IS UNDERWAY TO PREVENT UNNECESSARY SOIL EROSION. BARE AND SPARSELY VEGETATED GROUND IN HIGHLY ERODIBLE AREAS AS DETERMINED BY THE ENGINEER SHALL BE TEMPORARILY SEEDED AT THE BEGINNING OF CONSTRUCTION WHERE NO CONSTRUCTION WHERE AND CONSTRUCTION WHERE AND CONSTRUCTION WHERE AND SPARSELY SEEDED AT THE BEGINNING OF CONSTRUCTION WHERE NO CONSTRUCTION ACTIVITIES ARE EXPECTED WITHIN ?
- 10. DISTURBED PORTIONS OF THE SITE WHERE CONSTRUCTION ACTIVITY HAS PERMANENTLY STOPPED SHALL BE PERMANENTLY SEEDED. THESE AREAS SHALL BE SEEDED NO LATER THAN 7 DAYS AFTER THE LAST CONSTRUCTION ACTIVITY OCCURRING IN THESE AREAS.
- 11. ALL MATERIALS SPILLED, DROPPED, WASHED, OR TRACKED FROM VEHICLES ONTO ROADWAY OR INTO STORM DRAINS MUST BE REMOVED IMMEDIATELY.
- 12. CONTRACTORS OR SUBCONTRACTORS WILL BE RESPONSIBLE FOR REMOVING SEDIMENT THAT MAY HAVE COLLECTED IN THE STORM SEWER DRAINAGE SYSTEMS IN CONJUNCTION WITH THE STABILIZATION OF THE SITE.
- 13. SLOPES SHALL BE LEFT IN A ROUGHENED CONDITION DURING THE GRADING PHASE TO REDUCE RUNOFF VELOCITIES AND EROSION.
- 14. DUE TO THE GRADE CHANGES DURING THE DEVELOPMENT OF THE PROJECT, THE CONTRACTORS SHALL BE RESPONSIBLE FOR ADJUSTING THE EROSION CONTROL MEASURES (SILT FENCES, DITCH CHECKS, ETC.) TO PREVENT EROSION.
- 15. ALL CONSTRUCTION SHALL BE STABILIZED AT THE END OF EACH WORKING DAY. THIS INCLUDES BACKFILLING OF TRENCHES FOR UTILITY CONSTRUCTION AND PLACEMENT OF GRAVEL OR HMA PAVING FOR ROAD CONSTRUCTION
- 16. INLET PROTECTION MUST BE PROVIDED AND MAINTAINED FOR ALL PROPOSED INLETS UNTIL FINAL GRADES HAVE BEEN ESTABLISHED.
- 17. THE EROSION CONTROL MEASURES INDICATED ON THE DRAWING MAPS ARE THE MINIMUM
- 18. TEMPORARY SLOPES AND GROUND SHALL BE MAINTAINED IN ROUGHENED STATE AS A BMP TO DISCOURAGE RILL EROSION.

COUNTY

STEPHENSON 106 36

CONTRACT NO. 85674

SITE LOCATION MAP (NOT TO SCALE)




McClure

USER NAME:	DESIGNED:	REVISED: 1 - 2/22/2019
	CHECKED:	REVISED:
PLOT SCALE:	DRAWN: ATH	REVISED:
DLOT DATE: 2 /22 /2010	CUECKED. WILK	DEVICED.

STATE OF ILLINOIS **CITY OF FREEPORT**

SECTION STORM WATER POLLUTION PREVENTION PLAN N.A. 15-00163-00-BT FREEPORT PEC PATH CITY OF FREEPORT SHEET NO. OF SHEETS

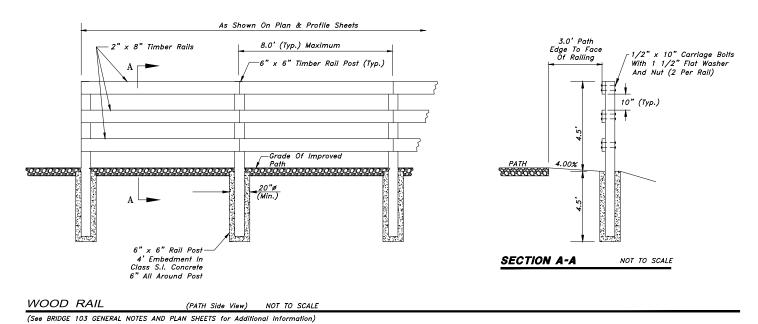

PECATONICA PRAIRIE

EXISTING BITUMINOUS CONCRETE
OR SEAL COAT ROADWAY / STREET

6" MIN.

SAWCUT

MULTI-USE PATH

SAWCUT


SAWCUT


SAWCUT

NOT TO SCALE

HMA OR AGG

(300 BRIDGE 103 GENERAL NOTES AND FLAN SHEETS FOR Additional Information)

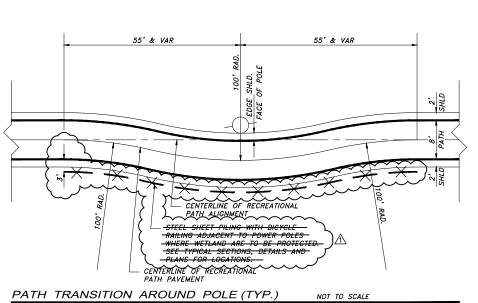

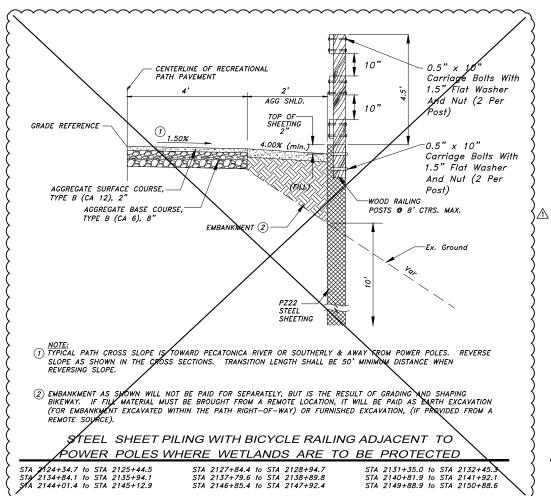

NOTE:
AGGREGATE BASE COURSE TYPE B, 2" WILL NOT BE PAID FOR SEPARATELY, BUT SHALL BE CONSIDERED INCLUDED IN THE CONTRACT UNIT PRICE FOR PORTLAND CEMENT CONCRETE SIDEWALK - 5 INCH.

SEE ADA DETAILS FOR ADDITIONAL INFORMATION.

FOR THE SIDEWALK UNDER THE HANCOCK BRIDGE, SEE <u>CONCRETE PAYED SECTION UNDER HANCOCK AVE. BRIDGE</u> TYPICAL SECTION

PORTLAND CEMENT CONCRETE SIDEWALK - 5 INCH

NOT TO SCALE

♦I M	EG
120 S 1ST STREET ROCKFORD, IL 61350	PH: 815.956.6400 www.imegcorp.com
FORM	McClure

USER NAME:	DESIGNED:	REVISED: ADDENDUM 1 - 2/22/2019
	CHECKED:	REVISED:
PLOT SCALE:	DRAWN: ATH	REVISED:
PLOT DATE: 2/25/2019	CHECKED: WLK	REVISED:

STATE OF ILLINOIS CITY OF FREEPORT

<u>EARTHWORK SCHEDULE</u>

			TH WOR					EARTH EXCAVATION	FURNISHED EXCAVATION
	20200100	20400800							
		Areas Feet)		Sum of E	Cummulative Total (Cu. Yards)				
Station	Cut	Fill	Distance	Cut	Fill	(Cu. Y Cut	Fill	Cut	Fill
1999+58.00	8.3	0.1	Distance	Cut	1 111	Cut	1	Cut	7 111
2000+00.00	13.4	0.0	42	21.7	0.1	16.9	0.1	16.9	0.1
	•	•	ON E. ST	EPHENS	ON STRE	ET & EX	ISTING	PARKING LO	
2002+50.00	8.1	0.0						16.9	0.1
2003+00.00	8.0	0.0	50	16.1	0.0	14.9	0.0	31.8	0.1
2003+50.00	7.8	0.1	50	15.8	0.1	14.6	0.1	46.4	0.2
2004+00.00	7.8	0.0	50	15.7	0.1	14.5	0.1	61.0	0.3
2004+50.00	8.8	0.0	50	16.7	0.0	15.5	0.0		0.3
2005+00.00			50	14.9	0.3	13.8	0.3	76.4	
2005+50.00	6.1	0.3	50	13.1	0.4	12.1	0.4	90.2	0.5
2006+00.00	7.0	0.1	50	14.0	0.1	13.0	0.1	102.3	0.9
2006+50.00	7.0	0.0	50	8.9	1.9	8.2	1.8	115.3	1.0
2007+00.00	1.9	1.9	50	72.7	1.9	67.3	1.8	123.5	2.8
2007+50.00	70.8	0.0	50	239.8	0.7	222.0	0.6	190.9	4.5
2008+00.00	169.0	0.7	50	229.2	1.1	212.2	1.0	412.9	5.2
2008+50.00	60.2	0.4	50	69.4	0.5	64.3	0.5	625.1	6.2
2008+30.00	9.2	0.1	50	14.3	1.0	13.2	0.9	689.4	6.7
2009+50.00	5.1	0.9	50	18.8	0.9	17.4	0.8	702.6	7.6
	13.7	0.0	50	23.6	0.0	21.9	0.0	720.0	8.4
2010+00.00	9.9	0.0	50	16.3	0.1	15.1	0.1	741.9	8.4
2010+50.00	6.4	0.1	50	12.1	0.4	11.2	0.4	757.0	8.5
2011+00.00	5.7	0.3	50	12.9	0.3	11.9	0.3	768.2	8.9
2011+50.00	7.2	0.0	50	12.8	0.2	11.9	0.2	780.1	9.2
2012+00.00	5.6	0.2	50	12.4	0.7	11.5	0.6	792.0	9.3
2012+50.00	6.8	0.5	50	15.7	0.6	14.5	0.6	803.5	10.0
2013+00.00	8.9	0.1	50	19.1	0.1	17.7	0.1	818.0	10.5
2013+50.00	10.2	0.0	50	16.8	0.1	15.6	0.1	835.7	10.6
2014+00.00	6.6	0.1	50	12.8	0.1	11.9	0.3	851.2	10.7
2014+50.00	6.2	0.2	50	12.8	0.3	11.9	0.3	863.1	11.0
2015+00.00	6.6	0.2	50					874.9	11.4
2015+50.00	5.8	0.5		12.4	0.7	11.5	0.6	886.4	12.0
2016+00.00	30.2	0.0	50	36.0	0.5	33.3	0.5	919.7	12.5
2016+50.00	44.3	0.0	50	74.5	0.0	69.0	0.0	988.7	12.5
2017+00.00	75.1	0.0	50	119.4	0.0	110.6	0.0	1,099.3	12.5
2017+50.00	70.3	1.5	50	145.4	1.5	134.6	1.4	1,233.9	13.9
2018+00.00	0.0	40.0	50	70.3	41.5	65.1	38.4	1,299.0	52.3
2018+50.00	0.0	41.0	50	0.0	81.0	0.0	75.0	1,299.0	127.3
2019+00.00	29.9	0.0	50	29.9	41.0	27.7	38.0	1,326.7	165.3
2019+50.00	68.5	0.4	50	98.4	0.4	91.1	0.4	1,417.8	165.6
2020+00.00	57.8	0.0	50	126.3	0.4	116.9	0.4	1,534.7	166.0
2020+50.00	24.0	4.4	50	81.8	4.4	75.7	4.1	1,610.5	170.1
2021+00.00	20.1	3.1	50	44.1	7.5	40.8	6.9	1,651.3	177.0
2021+50.00	11.1	4.7	50	31.2	7.8	28.9	7.2	1,680.2	184.2
2022+00.00	10.3	0.0	50	21.4	4.7	19.8	4.4	1,700.0	188.6
2022+50.00	7.2	2.8	50	17.5	2.8	16.2	2.6	1,716.2	191.2
2023+00.00	39.3	0.0	50	46.5	2.8	43.1	2.6	1,759.3	193.8
2023+50.00	88.5	0.0	50	127.8	0.0	118.3	0.0	1,739.3	193.8
2024+00.00	98.2		50	186.7	0.0	172.9	0.0		
2024+50.00		0.0	50	182.3	0.0	168.8	0.0	2,050.5	193.8
	84.1	0.0	50	159.6	0.0	147.8	0.0	2,219.3	193.8
2025+00.00	75.5	0.0						2,367.1	193.8

		FAD	TH WOD	L TADI E				EARTH EXCAVATION	FURNISHED EXCAVATION
		EAR	RTH WOR	K TABLE				20200100	20400800
		Areas Feet)			nd Areas Feet)		Totals ⁄ards)	Cummulativ Yar	e Total (Cu. ds)
Station	Cut	Fill	Distance	Cut	Fill	Cut	Fill	Cut	Fill
2026+00.00	5.0	0.2	50	42.1	0.2	39.0	0.2	2,510.3	194.0
2026+50.00	7.4	0.0	50	12.4	0.2	11.5	0.2	2,521.8	194.2
2027+00.00	7.4	0.0	50	14.8	0.0	13.7	0.0	2,535.5	194.2
2027+50.00	3.5	1.9	50	10.9	1.9	10.1	1.8	2,545.6	195.9
2028+00.00	5.5	0.4	50	9.0	2.3	8.3	2.1	2,553.9	198.0
2028+50.00	6.8	0.1	50	12.3	0.5	11.4	0.5	2,565.3	198.5
'		•	STATION	OMISSI	ON E. AL	BUM ST	REET		
2039+50.00	4.3	1.1						2,565.3	198.5
2040+00.00	5.1	0.4	50	9.4	1.5	8.7	1.4	2,574.0	199.9
2040+50.00	5.2	0.1	50	10.3	0.5	9.5	0.5	2,583.5	200.4
2041+00.00	16.8	18.9	50	22.0	19.0	20.4	17.6	2,603.9	217.9
2041+50.00	51.8	0.0	50	68.6	18.9	63.5	17.5		
2042+00.00			50	61.9	0.6	57.3	0.6	2,667.4	235.4
2042+50.00	10.1	0.6	50	17.2	4.6	15.9	4.3	2,724.7	236.0
2043+00.00	7.1	4.0	50	16.0	7.0	14.8	6.5	2,740.7	240.3
2043+50.00	8.9	3.0	50	19.3	4.4	17.9	4.1	2,755.5	246.7
2044+00.00	10.4	1.4	50	22.2	1.4	20.6	1.3	2,773.4	250.8
2044+50.00	11.8	0.0	50	20.2	0.1	18.7	0.1	2,793.9	252.1
2045+00.00	8.4	0.1	50	14.1	0.2	13.1	0.2	2,812.6	252.2
	5.7	0.1	50	13.8	0.1	12.8	0.1	2,825.7	252.4
2045+50.00	8.1	0.0	50	19.2	0.0	17.8	0.0	2,838.5	252.5
2046+00.00	11.1	0.0	50	19.4	1.9	18.0	1.8	2,856.2	252.5
2046+50.00	8.3	1.9	50	13.7	7.6	12.7	7.0	2,874.2	254.2
2047+00.00	5.4	5.7	50	10.1	9.9	9.4	9.2	2,886.9	261.3
2047+50.00	4.7	4.2	50	10.1	5.2	9.8	4.8	2,896.2	270.4
2048+00.00	5.9	1.0	50	9.8	2.6	9.0	2.4	2,906.0	275.3
2048+50.00	3.9	1.6	50	6.0	3.3	5.6	3.1	2,915.1	277.7
2049+00.00	2.1	1.7					2.5	2,920.7	280.7
2049+50.00	3.8	1.0	50	5.9	2.7	5.5		2,926.1	283.2
2050+00.00	5.5	1.2	50	9.3	2.2	8.6	2.0	2,934.7	285.3
2050+50.00	5.5	0.3	50	11.0	1.5	10.2	1.4	2,944.9	286.7
2051+00.00	4.2	1.3	50	9.7	1.6	9.0	1.5	2,953.9	288.1
2051+50.00	5.3	1.8	50	9.5	3.1	8.8	2.9	2,962.7	291.0
2052+00.00	6.1	1.3	50	11.4	3.1	10.6	2.9	2,973.3	293.9
2052+50.00	6.1	3.4	50	12.2	4.7	11.3	4.4	2,984.6	298.2
2053+00.00	8.3	1.1	50	14.4	4.5	13.3	4.2	2,997.9	302.4
2053+50.00	8.7	0.6	50	17.0	1.7	15.7	1.6	3,013.6	304.0
2054+00.00	9.2	0.3	50	17.9	0.9	16.6	0.8	3,030.2	304.8
2054+50.00	10.3	0.1	50	19.5	0.4	18.1	0.4	3,048.3	305.2
2055+00.00	10.3	0.0	50	20.6	0.1	19.1	0.1	3,067.3	305.3
2055+50.00	11.6	0.0	50	21.9	0.0	20.3	0.0	3,087.6	305.3
2056+00.00	11.7	3.3	50	23.3	3.3	21.6	3.1	3,109.2	308.3
2056+50.00	6.8	12.4	50	18.5	15.7	17.1	14.5	3,126.3	322.9
2057+00.00	4.8	10.5	50	11.6	22.9	10.7	21.2	3,137.1	344.1
2057+50.00	4.8	6.5	50	9.6	17.0	8.9	15.7	3,146.0	359.8
2058+00.00			50	9.5	7.1	8.8	6.6		
2058+50.00	4.7	0.6	50	4.7	66.8	4.4	61.9	3,154.7	366.4
2059+00.00	0.0	66.2	50	0.0	223.6	0.0	207.0	3,159.1	428.2
2059+50.00	0.0	157.4	50	0.0	157.4	0.0	145.7	3,159.1	635.3
	0.0	0.0	50	0.0	0.0	0.0	0.0	3,159.1	781.0

		FAF	RTH WOR	K TABI F	<u>:</u>			EARTH EXCAVATION	FURNISHED EXCAVATION
		LΛΙ	** OK		-			20200100	20400800
		Areas Feet)		Sum of End Areas Sec. Totals (Sq. Feet) (Cu. Yards)			Cummulative Total (C Yards)		
Station	Cut	Fill	Distance	Cut	Fill	Cut	Fill	Cut	Fill
2060+50.00	0.0	94.7	50	0.0	94.7	0.0	87.7	3,159.1	868.7
2061+00.00	0.0	56.4	50	0.0	151.1	0.0	139.9	3,159.1	1,008.6
2061+50.00	0.0	30.8	50	0.0	87.2	0.0	80.7	3,159.1	1,089.3
2062+00.00	0.1	32.4	50	0.1	63.2	0.1	58.5	3,159.2	1,147.9
2062+50.00	9.7	0.0	50	9.8	32.4	9.1	30.0	3,168.3	1,177.9
2063+00.00	8.0	7.4	50	17.7	7.4	16.4	6.9	3,184.7	1,184.7
2063+50.00	7.9	7.2	50	15.9	14.6	14.7	13.5	3,199.4	1,198.2
2064+00.00	8.0	6.6	50	15.9	13.8	14.7	12.8	3,214.1	1,211.0
2064+50.00	8.5	3.3	50	16.5	9.9	15.3	9.2	3,229.4	1,220.2
2065+00.00	10.0	1.4	50	18.5	4.7	17.1	4.4	3,246.5	1,224.5
2065+50.00	13.3	1.9	50	23.3	3.3	21.6	3.1	3,268.1	1,227.6
2066+00.00	15.5	0.0	50	28.8	1.9	26.7	1.8	3,294.7	1,229.3
2066+50.00	15.5	0.0	50	31.0	0.0	28.7	0.0	3,323.5	1,229.3
2067+00.00	13.2	0.1	50	28.7	0.1	26.6	0.1	3,350.0	1,229.3
2067+50.00			50	23.0	1.4	21.3	1.3		
2068+00.00	9.8	1.3	50	19.1	1.3	17.7	1.2	3,371.3	1,230.7
2068+50.00	9.3	0.0	50	24.2	0.1	22.4	0.1	3,389.0	1,231.9
2069+00.00	14.9	0.1	50	24.8	0.2	23.0	0.2	3,411.4	1,232.0
2069+50.00	9.9	0.1	50	19.1	0.1	17.7	0.1	3,434.4	1,232.2
2070+00.00	9.2	0.0	50	19.5	0.0	18.1	0.0	3,452.1	1,232.3
2070+50.00	10.3	0.0	50	22.0	0.0	20.4	0.0	3,470.1	1,232.3
2071+00.00	11.7	0.0	50	24.1	0.0	22.3	0.0	3,490.5	1,232.3
2071+50.00	12.4	0.0	50	24.3	0.0	22.5	0.0	3,512.8	1,232.3
2071+30.00	11.9	0.0	50	23.2	0.0	21.5	0.0	3,535.3	1,232.3
2072+50.00	11.3	0.0	50	21.8	0.0	20.2	0.0	3,556.8	1,232.3
2072+30.00	10.5	0.0	50	20.3	0.0	18.8	0.0	3,577.0	1,232.3
	9.8	0.0	50	19.1	0.0	17.7	0.0	3,595.8	1,232.3
2073+50.00	9.3	0.0	50	19.1	0.1	17.7	0.1	3,613.5	1,232.3
2074+00.00	9.8	0.1	50	22.0	0.2	20.4	0.2	3,631.1	1,232.4
2074+50.00	12.2	0.1	50	27.8	0.1	25.7	0.1	3,651.5	1,232.6
2075+00.00	15.6	0.0	50	31.7	0.0	29.4	0.0	3,677.2	1,232.7
2075+50.00	16.1	0.0	50	32.6	0.0	30.2	0.0	3,706.6	1,232.7
2076+00.00	16.5	0.0	50	33.0	0.0	30.6	0.0	3,736.8	1,232.7
2076+50.00	16.5	0.0						3,767.3	1,232.7
2077+00.00	15.9	0.0	50	32.4	0.0	30.0	0.0	3,797.3	1,232.7
2077+50.00	13.3	0.0	50	29.2	0.0	27.0	0.0	3,824.4	1,232.7
2078+00.00	11.9	0.0	50	25.2	0.0	23.3	0.0	3,847.7	1,232.7
2078+50.00	11.4	0.0	50	23.3	0.0	21.6	0.0	3,869.3	1,232.7
2079+00.00	11.0	0.0	50	22.4	0.0	20.7	0.0	3,890.0	1,232.7
2079+50.00	10.4	0.0	50	21.4	0.0	19.8	0.0	3,909.8	1,232.7
2080+00.00	7.9	0.1	50	18.3	0.1	16.9	0.1	3,926.8	1,232.8
2080+50.00	5.8	0.5	50	13.7	0.6	12.7	0.6	3,939.5	1,233.3
2081+00.00	0.0	0.0	50	5.8	0.5	5.4	0.5	3,944.8	1,233.8
2081+50.00	4.2	2.0	50	4.2	2.0	3.9	1.9	3,948.7	1,235.6
2082+00.00	2.4	4.2	50	6.6	6.2	6.1	5.7	3,954.8	1,241.4
2082+50.00	1.5	4.4	50	3.9	8.6	3.6	8.0	3,958.5	1,249.3
2083+00.00	1.4	6.2	50	2.9	10.6	2.7	9.8	3,961.1	1,259.2
2083+50.00	1.8	3.4	50	3.2	9.6	3.0	8.9	3,964.1	1,268.0
2084+00.00	2.5	1.9	50	4.3	5.3	4.0	4.9	3,968.1	1,272.9



USER NAME:
DESIGNED:
REVISED: ⚠ ADDENDUM 1 - 2/22/2019

CHECKED:
REVISED:

PLOT SCALE:
DRAWN: ATH
REVISED:

PLOT DATE: 2/25/2019
CHECKED: WLK
REVISED:

STATE OF ILLINOIS CITY OF FREEPORT

EARTHWORK SCHEDULE FREEPORT PEC PATH

SHEET NO. OF SHEETS

- SECTION COUNTY TOTAL SHEETS NO.

N.A. 15-00163-00-BT STEPHENSON 106 43

CITY OF FREEPORT CONTRACT NO. 85674

EARTHWORK SCHEDULE

		FAF	OTH MOD	IZ TADI F	-			EARTH EXCAVATION	FURNISHED EXCAVATION
		EAR	RTH WOR	KIABLE				20200100	20400800
		Areas Feet)		Sum of End Areas (Sq. Feet)			Totals Yards)	Cummulative Total (Cu. Yards)	
Station	Cut	Fill	Distance	Cut	Fill	Cut	Fill	Cut	Fill
2084+50.00	4.1	0.5	50	6.6	2.4	6.1	2.2	3,974.2	1,275.2
2085+00.00	5.3	1.1	50	9.4	1.6	8.7	1.5	3,982.9	1,276.7
2085+50.00	6.7	0.9	50	12.0	2.0	11.1	1.9	3,994.0	1,278.5
2086+00.00	5.3	1.5	50	12.0	2.4	11.1	2.2	4,005.1	1,280.7
2086+50.00	2.1	2.9	50	7.4	4.4	6.9	4.1		
2087+00.00			50	3.4	19.6	3.1	18.1	4,012.0	1,284.8
2087+50.00	1.3	16.7	50	5.5	33.6	5.1	31.1	4,015.1	1,302.9
2088+00.00	4.2	16.9	50	11.5	230.0	10.6	213.0	4,020.2	1,334.1
2088+50.00	7.3	213.1	50	12.7	213.2	11.8	197.4	4,030.9	1,547.0
2089+00.00	5.4	0.1	50	9.1	0.6	8.4	0.6	4,042.6	1,744.4
2089+50.00	3.7	0.5	50	7.3	0.9	6.8	0.8	4,051.0	1,745.0
2090+00.00	3.6	0.4	50	7.4	0.9	6.9	0.8	4,057.8	1,745.8
	3.8	0.5	50	8.6	0.8	8.0	0.7	4,064.7	1,746.7
2090+50.00	4.8	0.3	50	10.5	1.5	9.7	1.4	4,072.6	1,747.4
2091+00.00	5.7	1.2	50	10.7	3.5	9.9	3.2	4,082.3	1,748.8
2091+50.00	5.0	2.3	50	6.0	11.5	5.6	10.6	4,092.2	1,752.0
2092+00.00	1.0	9.2	50				9.7	4,097.8	1,762.7
2092+50.00	0.8	1.3		1.8	10.5	1.7		4,099.5	1,772.4
2093+00.00	2.2	0.8	50	3.0	2.1	2.8	1.9	4,102.2	1,774.3
2093+50.00	3.2	0.3	50	5.4	1.1	5.0	1.0	4,107.2	1,775.4
2094+00.00	4.0	0.2	50	7.2	0.5	6.7	0.5	4,113.9	1,775.8
2094+50.00	4.7	0.2	50	8.7	0.4	8.1	0.4	4,122.0	1,776.2
2095+00.00	5.1	1.5	50	9.8	1.7	9.1	1.6	4,131.0	1,777.8
2095+50.00	6.7	0.0	50	11.8	1.5	10.9	1.4	4,142.0	1,779.2
2096+00.00	8.4	0.0	50	15.1	0.0	14.0	0.0	4,156.0	1,779.2
2096+50.00	7.2	0.0	50	15.6	0.0	14.4	0.0	4,170.4	1,779.2
2097+00.00	7.2	0.0	50	14.2	0.0	13.1	0.0	4,183.5	1,779.2
2097+50.00			50	14.1	0.0	13.1	0.0		
2098+00.00	7.1	0.0	50	14.4	0.0	13.3	0.0	4,196.6	1,779.2
2098+50.00	7.3	0.0	50	14.7	0.0	13.6	0.0	4,209.9	1,779.2
2099+00.00	7.4	0.0	50	15.0	0.0	13.9	0.0	4,223.5	1,779.2
2099+50.00	7.6	0.0	50	13.4	0.1	12.4	0.1	4,237.4	1,779.2
2100+00.00	5.8	0.1	50	10.8	0.7	10.0	0.6	4,249.8	1,779.2
	5.0	0.6	50	9.7	1.4	9.0	1.3	4,259.8	1,779.9
2100+50.00	4.7	0.8	50	9.4	1.6	8.7	1.5	4,268.8	1,781.2
2101+00.00	4.7	0.8	50	10.2	2.1	9.4	1.9	4,277.5	1,782.7
2101+50.00	5.5	1.3	50	11.7	1.4	10.8	1.3	4,287.0	1,784.6
2102+00.00	6.2	0.1	50	11.9	0.3	11.0	0.3	4,297.8	1,785.9
2102+50.00	5.7	0.2						4,308.8	1,786.2
2103+00.00	4.8	0.2	50	10.5	0.4	9.7	0.4	4,318.5	1,786.6
2103+50.00	4.7	0.3	50	9.5	0.5	8.8	0.5	4,327.3	1,787.0
2104+00.00	4.4	0.5	50	9.1	0.8	8.4	0.7	4,335.8	1,787.8
2104+50.00	2.9	1.3	50	7.3	1.8	6.8	1.7	4,342.5	1,789.4
2105+00.00	1.0	2.6	50	3.9	3.9	3.6	3.6	4,346.1	1,793.0
2105+50.00	0.8	2.8	50	1.8	5.4	1.7	5.0	4,347.8	1,798.0
2106+00.00	0.7	2.7	50	1.5	5.5	1.4	5.1	4,349.2	1,803.1
2106+50.00	1.3	2.1	50	2.0	4.8	1.9	4.4	4,351.0	1,807.6
2107+00.00	2.1	1.6	50	3.4	3.7	3.1	3.4	4,354.2	1,811.0
2107+50.00	5.8	0.4	50	7.9	2.0	7.3	1.9	4,361.5	1,812.9
2108+00.00	3.3	0.4	50	9.1	1.1	8.4	1.0	4,361.3	1,813.9

		EAR	RTH WOR	K TABLE				EARTH EXCAVATION	FURNISHED EXCAVATION
								20200100	20400800
		Areas Feet)			nd Areas Feet)		Totals (ards)	Cummulative Total (Cu. Yards)	
Station	Cut	Fill	Distance	Cut	Fill	Cut	Fill	Cut	Fill
2108+50.00	0.6	4.1	50	3.9	4.8	3.6	4.4	4,373.5	1,818.3
2109+00.00	1.5	2.4	50	2.1	6.5	1.9	6.0	4,375.5	1,824.3
2109+50.00	2.7	2.3	50	4.2	4.7	3.9	4.4	4,379.4	1,828.7
2110+00.00	5.4	0.6	50	8.1	2.9	7.5	2.7	4,386.9	1,831.4
2110+50.00	6.4	0.2	50	11.8	0.8	10.9	0.7	4,397.8	1,832.1
2111+00.00	9.3	10.1	50	15.7	10.3	14.5	9.5	4,412.3	1,841.7
2111+50.00	1.5	36.0	50	10.8	46.1	10.0	42.7	4,422.3	1,884.3
2112+00.00	0.3	12.8	50	1.8	48.8	1.7	45.2	4,424.0	1,929.5
2112+50.00	12.6	0.5	50	12.9	13.3	11.9	12.3	4,436.0	1,941.8
2113+00.00	40.3	0.0	50	52.9	0.5	49.0	0.5	4,484.9	1,942.3
2113+50.00	21.0	2.4	50	61.3	2.4	56.8	2.2	4,541.7	1,944.5
2114+00.00	18.3	2.1	50	39.3	4.5	36.4	4.2	4,578.1	1,948.7
2114+50.00	20.8	0.1	50	39.1	2.2	36.2	2.0	4,614.3	1,950.7
2115+00.00	16.1	0.3	50	36.9	0.4	34.2	0.4	4,648.5	1,951.1
2115+50.00	22.2	0.7	50	38.3	1.0	35.5	0.9	4,683.9	1,952.0
2116+00.00	37.9	0.4	50	60.1	1.1	55.6	1.0	4,739.6	1,953.0
2116+50.00	4.3	0.6	50	42.2	1.0	39.1	0.9	4,778.6	1,954.0
2117+00.00	3.9	0.2	50	8.2	0.8	7.6	0.7	4,786.2	1,954.7
2117+50.00	5.7	0.1	50	9.6	0.3	8.9	0.3	4,795.1	1,955.0
2118+00.00	7.2	0.0	50	12.9	0.1	11.9	0.1	4,807.1	1,955.1
2118+50.00	3.6	3.2	50	10.8	3.2	10.0	3.0		
2119+00.00	4.0	0.6	50	7.6	3.8	7.0	3.5	4,817.1 4,824.1	1,958.0 1,961.6
2119+50.00	3.8	1.8	50	7.8	2.4	7.2	2.2	4,824.1	1,963.8
2120+00.00	8.2		50	12.0	1.9	11.1	1.8		
2120+50.00	6.4	0.1	50	14.6	0.2	13.5	0.2	4,842.4 4,856.0	1,965.5
2121+00.00	14.8	0.1	50	21.2	0.2	19.6	0.2		1,965.7
2121+50.00	13.7	0.0	50	28.5	0.1	26.4	0.1	4,875.6	1,965.9
2122+00.00	4.3		50	18.0	2.8	16.7	2.6	4,902.0	1,966.0
2122+50.00		2.8	50	10.5	2.9	9.7	2.7	4,918.6	1,968.6
2123+00.00	6.2 10.9	0.1	50	17.1	0.3	15.8	0.3	4,928.4	1,971.3
	10.9	0.2	20200100		/CA\/ATTO	LTOTAL)	4,944.2	1,971.6
			20200100 -			,		,	1.071.6
		202	100800 FUR	INTOHED EX	KCAVATION	I I U I AL (ou. Yards)		1,971.6

	EG
120 S 1ST STREET	PH: 815.956.6400
ROCKFORD, IL 61350	www.imegcorp.com
FORM	MERLY
Missman, inc.	McClure

USER NAME:	DESIGNED:	REVISED: 1 ADDENDUM 1 - 2/22/2019
	CHECKED:	REVISED:
PLOT SCALE:	DRAWN: ATH	REVISED:
PLOT DATE: 2/25/2019	CHECKED: WIK	REVISED:

STATE OF ILLINOIS CITY OF FREEPORT

EARTHWORK SCHEDULE (2)
FREEPORT PEC PATH

SHEET NO. OF SHEETS

- SECTION COUNTY TOTAL SHEETS NO.

N.A. 15-00163-00-BT STEPHENSON 106 44

CITY OF FREEPORT CONTRACT NO. 85674

HORIZONTAL VERTICAL SCALES: 1" = 5' H 1" = 5' N OFF = 29.50 ELEV = 754.44 "(TYP) AROUND POLE INFORMATION AROUND POLE INFORMATION OFF = 6.62 ELEV = 764.01 OFF = 6.17 ELEV = 764.30 764.45 764.8 764.8 764.17 764.4 764.4 763.89 764.0 764.0 RANSITION ADDITIONAL TRANSITION ADDITIONAL OFF = 7.56 ELEV = 763.91 "PATH AIL FOR ; , SEE "P,
DETAIL $\exists \forall$ SEE DET COUNTY TOTAL SHEETS NO.

STEPHENSON 106 89 USER NAME: DESIGNED: REVISED: 1 ADDENDUM 1 - 2/22/2019 SECTION CROSS SECTIONS 2123+00-2125+00 STATE OF ILLINOIS CHECKED: REVISED: N.A. 15-00163-00-BT FREEPORT PEC PATH PLOT SCALE: **CITY OF FREEPORT** DRAWN: ATH REVISED: CITY OF FREEPORT CONTRACT NO. 85674 SHEET NO. 45 OF 57 SHEETS

ILLINOIS FED. AID PROJECT -

PLOT DATE: 2/22/2019 CHECKED: WLK REVISED:

