


LOC # TS # INTERSECTION

1	TS 65	I 94/EDENS EXPY/ESTES @ IL 50/CICERO AVE
2	TS 5835	TOUHY AVE @ KOSTNER AVE
3	TS 5825	TOUHY AVE @ CRAWFORD AVE
4	TS 5477	MCCORMICK BLVD @ NORTHEAST PKWY
5	-	NOT USED
6	TS 5047	US 41/LINCOLN @ FIRE STATION EXIT
7	<del>TS 1010</del>	<del>CRAWFORD AVE @ DEVON AVE</del> <span style="border: 1px solid black; border-radius: 50%; padding: 2px;">REMOVED</span>
8	TS 2625	IL 50/CICERO AVE @ TOUHY AVE
9	TS 2605	IL 50/CICERO AVE @ PRATT AVE
10	TS 2590	IL 50/CICERO AVE @ DEVON AVE
11	TS 20395	MCCORMICK BLVD @ LINCOLNWOOD TOWN CENTER
12	TS 20345	TOUHY AVE @ LINCOLNWOOD TOWN CENTER
13	TS 20341	TOUHY AVE @ LAWDALE AVE
14	TS 1617	IL 72/TOUHY AVE @ KILBOURNE AVE
15	TS 1610	US 41/LINCOLN @ PRATT
16	TS 1545	US 41/LINCOLN @ KOSTNER
17	TS 1505	US 41/LINCOLN @ DEVON AVE
18	<del>TS 1600</del>	<del>US 41/LINCOLN HWY @ CRAWFORD AVE</del> <span style="border: 1px solid black; border-radius: 50%; padding: 2px;">REMOVED</span>
19	TS 12090	TOUHY AVE @ BARCLAY PL/HYATT DR
20	TS 11185	DEVON AVE @ KENTON AVE/LEMONT
21	TS 2435	IL 43/WAUKEGAN RD @ WINNETKA RD
22	TS 2406	IL 43/WAUKEGAN RD @ TECHN Y RD/FOUNDERS DR
23	TS 14485	WINNETKA RD @ HIBBARD
24	TS 14467	WILLOW RD @ LAGOON DR
25	TS 9255	TOUHY AVE @ WASHINGTON ST
26	TS 9250	US 14/NORTHWEST HWY @ PROSPECT AVE
27	TS 9247	US 14/NORTHWEST HWY @ SUMMIT
28	TS 9245	COURTLAND/TALCOTT AVE @ DEVON AVE
29	TS 9240	BUSSE HWY @ <span style="border: 1px solid black; border-radius: 50%; padding: 2px;">TOUHY AVE</span>
30	TS 9235	BUSSE HWY @ <span style="border: 1px solid black; border-radius: 50%; padding: 2px;">GREENWOOD AVE</span>
31	TS 9230	TOUHY AVE @ WESTERN AVE
32	TS 9222	TOUHY AVE @ SUMMIT
33	TS 9220	NORTHWEST HWY @ WASHINGTON ST
34	TS 9215	NORTHWEST HWY @ MEACHAM AVE
35	TS 9210	GREENWOOD @ TOUHY
36	TS 9205	GREENWOOD AVE @ TALCOTT AVE
37	TS 9190	IL 171/CUMBERLAND AVE @ TOUHY AVE
38	TS 9185	CUMBERLAND AVE @ TALCOTT AVE
39	TS 9180	CUMBERLAND AVE @ GRANVILLE
40	TS 5830	TOUHY AVE @ DEE RD
41	TS 5815	TALCOTT AVE @ TOUHY AVE
42	TS 5810	DEE RD @ TALCOTT AVE
43	TS 5535	OAKTON ST @ FLORENCE
44	TS 5510	NORTHWEST HWY @ POTTER RD
45	TS 5505	NORTHWEST HWY @ OAKTON ST
46	TS 4955	CUMBERLAND AVE @ DEVON AVE
47	TS 4260	CANFIELD @ TALCOTT AVE
48	TS 4255	CANFIELD @ DEVON AVE
49	TS 4245	BUSSE RD @ POTTER RD
50	TS 4146	BALLARD RD @ NESSET RD
51	TS 4145	BALLARD RD @ DEE RD
52	TS 4125	ALGONQUIN RD @ OAKTON ST
53	TS 3300	IL 72/HIGGINS RD @ CANFIELD RD
54	TS 3280	BUSSE HWY @ OAKTON ST
55	TS 22150	DEVON AVE @ GREENWOOD AVE
56	TS 1305	US 14/CALDWELL AVE @ TOUHY AVE
57	TS 1275	US 14/DEMPSTER ST @ POTTER RD
58	TS 1240	US 14/DEMPSTER ST @ LUTHER LN
59	TS 1210	US 14/DEMPSTER ST @ GREENWOOD AVE
60	TS 1205	US 14/DEMPSTER ST @ DEE RD
61	TS 11695	US 14/ NORTHWEST HWY @ ELM ST
62	TS 5950	WOLF RD @ WILLOW/OLD WILLOW RD
63	TS 5944	WOLF RD @ EDWARD RD
64	TS 419	US 12/RAND RD @ OLIVE
65	TS 3540	IL 83/ELMHURST RD @ WILLOW RD
66	TS 3485	IL 83/ELMHURST RD @ PALATINE RD
67	TS 1745	US 45-IL 21/MILWAUKEE AVE @ PALATINE SOUTH RAMP
68	TS 1740	US 45-IL 21/MILWAUKEE AVE @ PALATINE NORTH RAMP

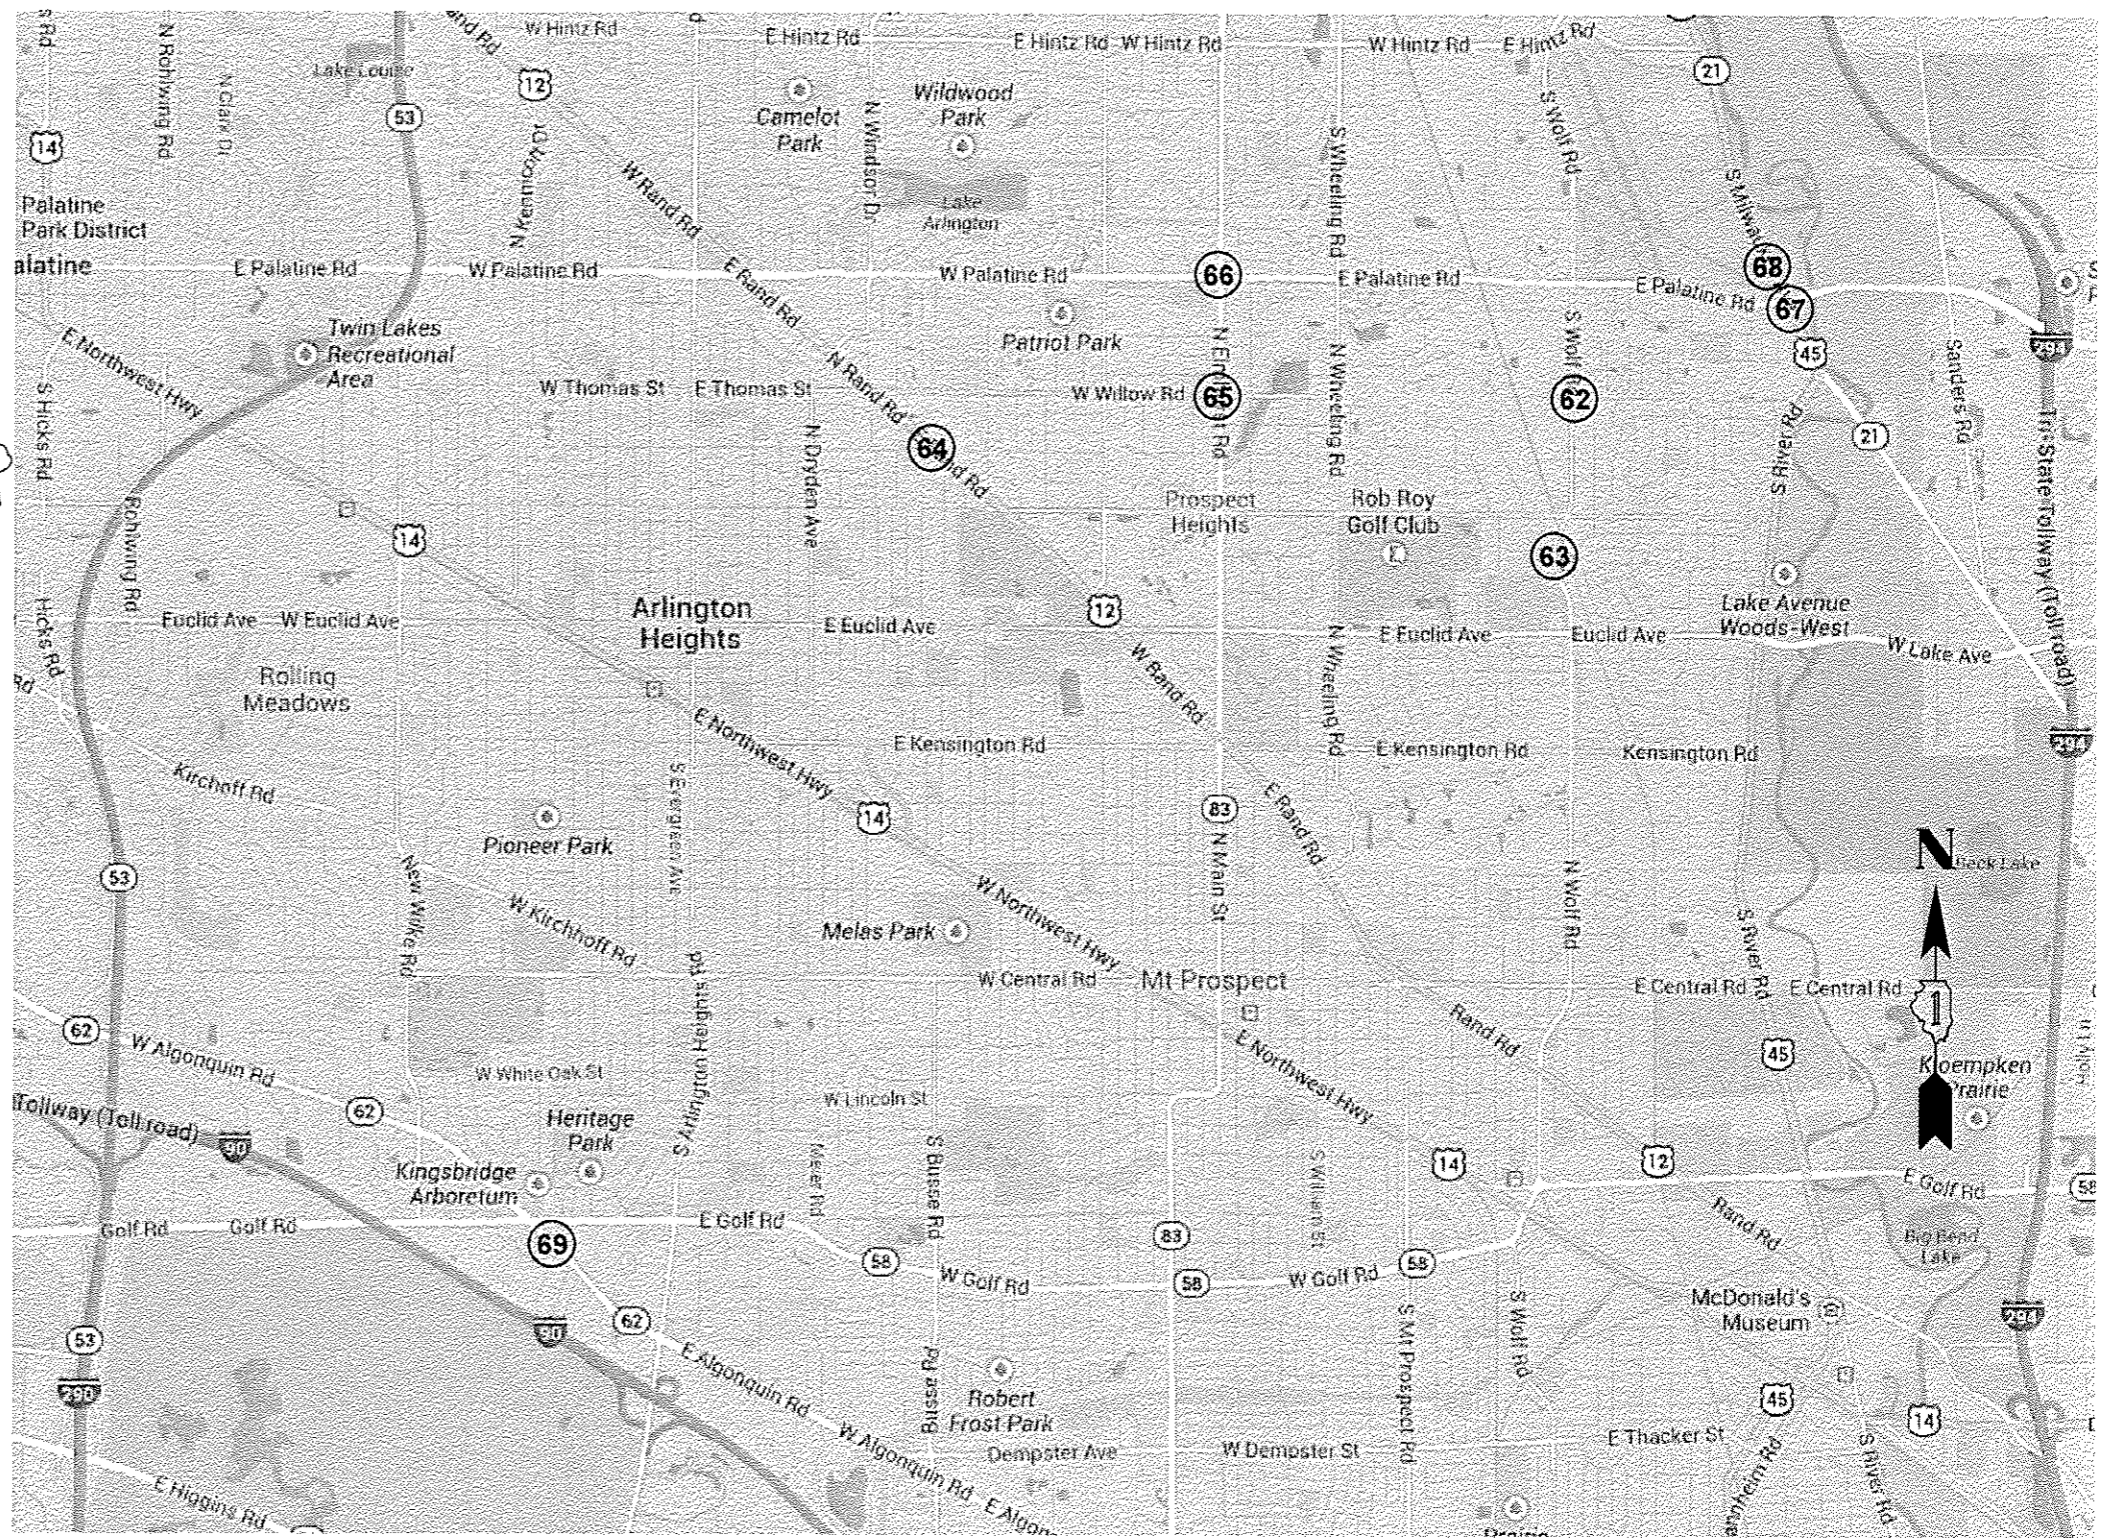

FILE NAME :  
D:\60X82-sh1-lacnep3.dgn  
Default

USER NAME : SJohnson  
DESIGNED - WBL  
DRAWN - WBL  
CHECKED - BKS  
DATE -

REVISIONS:  
REVISED - BKS 5-12-2014  
REVISED -  
REVISED -  
REVISED -

STATE OF ILLINOIS  
DEPARTMENT OF TRANSPORTATION

LOCATION MAP

SCALE: SHEET OF SHEETS STA. TO STA.

F.A. RTE.	SECTION	COUNTY	TOTAL SHEETS	SHEET NO.
	2014-007TS	COOK	88	5
CONTRACT NO. 60X82				
ILLINOIS FED. AID PROJECT				