

## INDEX OF SHEETS

1	COVER SHEET
2	INDEX, HIGHWAY STANDARDS & GENERAL NOTES
3 - 5	SUMMARY OF QUANTITIES
6-7	SCHEDULE OF QUANTITIES
8-9	TYPICAL SECTIONS
10	ALIGNMENT, BENCHMARKS AND TIES
11	REMOVAL AND EROSION CONTROL PLAN
12	ROADWAY PLAN AND PROFILE
13	TRAFFIC CONTROL GENERAL NOTES/SEQUENCE OF CONSTRUCTION
14	TRAFFIC CONTROL TYPICAL SECTIONS
15-18	TRAFFIC CONTROL PLAN
19	PAVEMENT MARKING PLANS
20-30	STRUCTURAL PLANS
31	PAVEMENT TRANSITION DETAILS
32	BUTT JOINT AND HMA TAPER DETAILS (BD-32)
33	TRAFFIC CONTROL AND PROTECTION FOR SIDE ROADS, INTERSECTIONS AND DRIVEWAYS (TC-10)
34	TYPICAL APPLICATIONS RAISED REFLECTIVE PAVEMENT MARKERS (SNOW-PLOW RESISTANT) (TC-11)
35	DISTRICT ONE TYPICAL PAVEMENT MARKINGS (TC-13)
36	TRAFFIC CONTROL AND PROTECTION AT TURN BAYS (TC-14)
37	SHORT TERM PAVEMENT MARKING LETTER AND SYMBOL (TC-16)
38	ARTERIAL ROAD INFORMATION SIGN (TC-22)
39	DRIVEWAY ENTRANCE SIGNING (TC-26)

## HIGHWAY STANDARDS

000001-08	STANDARD SYMBOLS, ABBREVIATIONS AND PATTERNS
001006	DECIMAL OF AN INCH AND OF A FOOT
442201-03	CLASS C AND D PATCHES
482011-03	HMA SHLD. STRIPS/SHLDS. WITH RESURFACING OR WIDENING AND RESURFACING PROJECTS
515001-04	NAME PLATE FOR BRIDGES
630001-12	STEEL PLATE BEAM GUARDRAIL
630301-09	SHOULDER WIDENING FOR TYPE 1 (SPECIAL) GUARDRAIL TERMINALS
631011-10	TRAFFIC BARRIER TERMINAL, TYPE 2
701101-05	OFF-ROAD OPERATIONS, MULTILANE, 15" TO 24" FROM PAVEMENT EDGE
701427-05	LANE CLOSURE, MULTILANE INTERMITTENT OR MOVING OPER., FOR SPEED ≤ 40 MPH
701606-10	URBAN LANE CLOSURE, MULTILANE 2W WITH MOUNTABLE MEDIAN
701701-10	URBAN LANE CLOSURE, MULTILANE INTERSECTION
701901-08	TRAFFIC CONTROL DEVICES
704001-08	TEMPORARY CONCRETE BARRIER
725001-01	OBJECT AND TERMINAL MARKERS
780001-05	TYPICAL PAVEMENT MARKINGS
782006-01	GUARDRAIL AND BARRIER BARRIER WALL REFLECTOR MOUNTING DETAILS

## GENERAL NOTES

1. THE CONTRACTOR SHALL CALL "J.U.L.I.E" AT (800) 892-0123 OR 811 AT LEAST 48 HOURS PRIOR TO EXCAVATION TO DETERMINE WHICH BURIED ELECTRIC, TELEPHONE, AND GAS UTILITIES ARE IN THE AREA.
2. THE CONTRACTOR SHALL COORDINATE CONSTRUCTION ACTIVITIES WITH AFFECTED UTILITY COMPANIES THE CITY OF WHEATON.
3. THE CONTRACTOR SHALL NOT SET UP A YARD OR FIELD OFFICE ON STATE PROPERTY WITHOUT WRITTEN PERMISSION FROM THE DEPARTMENT.
4. THE CONTRACTOR SHALL CONTRACT THE DISTRICT ONE TRAFFIC CONTROL SUPERVISOR KALPANA KANNAN-HOSADURGA, AT KALPANA.KANNAN-HOSADURGA@ILLINOIS.GOV A MINIMUM OF 72 HOURS IN ADVANCE OF BEGINNING ANY WORK.
5. THE ENGINEER SHALL CONTACT THE WALTER CZARNY TRAFFIC FIELD AREA ENGINEER VIA EMAIL, AT WALTER.CZARNY@ILLINOIS.GOV A MINIMUM OF TWO (2) WEEKS PRIOR TO THE PLACEMENT OF PAVEMENT MARKINGS  
  
DO NOT SCALE PLANS FOR CONSTRUCTION DIMENSIONS.
- 6.
7. WHEN MILLED PAVEMENT IS OPEN TO TRAFFIC, THE MAXIMUM GRADE DIFFERENTIAL BETWEEN PASSES OF THE MILLING MACHINE SHALL NOT EXCEED 1½ INCHES. A MAXIMUM GRADE DIFFERENTIAL OF 3 INCHES MAY BE ALLOWED IF THE EDGE OF THE MILLING IS SLOPED AT A MINIMUM OF 1:3 (V:H).
8. THE CONTRACTOR SHALL USE CARE NEAR ANY AND ALL EXISTING ITEMS THAT WILL NOT BE REMOVED. ANY DAMAGE DONE TO EXISTING ITEMS BY THE CONTRACTOR SHALL BE REPAIRED OR REPLACED TO THE SATISFACTION OF THE ENGINEER AT THE CONTRACTOR'S OWN EXPENSE.
9. THE CONTRACTOR SHALL BE REQUIRED TO PROVIDE ACCESS TO ABUTTING PROPERTIES AT ALL TIMES DURING THE CONSTRUCTION OF THE PROJECT.  
  
THE LOCATION OF THE EXISTING DRAINAGE STRUCTURES, STORM SEWERS, WATER MANS, SANITARY SEWERS, AND ANY OTHER PUBLIC OR PRIVATE UTILITIES SHOWN ON THE PLANS IS APPROXIMATE AND THEIR EXACT LOCATION IS TO BE DETERMINED IN THE FIELD BY THE CONTRACTOR.
- 10.
11. THE CONTRACTOR SHALL BE RESPONSIBLE FOR THE PROTECTION OF ALL UNDERGROUND AND SURFACE UTILITIES EVEN THOUGH THEY MIGHT BE SHOWN IN THE PLANS. ANY UTILITY PROPERTY DAMAGED DURING CONSTRUCTION SHALL BE REPAIRED OR REPLACED TO THE SATISFACTION OF THE ENGINEER.
12. ANY LOOSE MATERIAL DEPOSITED IN THE FLOW LINE OF DRAINAGE STRUCTURES WHICH OBSTRUCTS THE NATURAL FLOW OF WATER SHALL BE REMOVED AT THE CLOSE OF EACH WORKING DAY. PRIOR TO ACCEPTANCE OF THE IMPROVEMENT, ALL DRAINAGE STRUCTURES SHALL BE FREE OF DIRT AND DEBRIS. THIS WORK WILL NOT BE PAID FOR SEPARATELY, BUT SHALL BE CONSIDERED AS INCLUDED IN THE UNIT BID PRICES OF THE CONTRACT.
13. IT SHALL BE THE CONTRACTORS RESPONSIBILITY TO VERIFY ALL DIMENSIONS AND CONDITIONS EXISTING IN THE FIELD PRIOR TO CONSTRUCTION AND ORDERING MATERIALS.
14. ALL PAVEMENT MARKINGS SHALL BE PLACED THROUGHOUT THE IMPROVEMENT ACCORDING TO THE DISTRICT 1 PAVEMENT MARKINGS STANDARD DETAILS.
15. ALL DAMAGE TO EXISTING PAVEMENT MARKINGS OR RAISED REFLECTIVE PAVEMENT MARKERS OUTSIDE THE REMOVAL LINE SHOWN ON THE PLANS SHALL BE REPLACED AT NO ADDITIONAL COST TO THE DEPARTMENT.
16. ANY REFERENCE TO A STANDARD IN THESE PLANS SHALL BE INTERPRETED TO MEAN THE EDITION AS INDICATED BY THE SUB NUMBER SHOWN IN THE LIST OF STANDARDS OR THE COPY INCLUDED IN THESE PLANS.
17. THE SUBGRADE STABILITY SHALL BE VERIFIED BY PROOF ROLLING WITH A FULL LOADED TANDEM AXLE TRUCK.
18. ANY AGGREGATE SUBGRADE IMPROVEMENT CONTAMINATED AND/OR DAMAGED BY THE CONTRACTORS VEHICLES AND/OR EQUIPMENT IS TO BE REMOVED AND REPLACED AS DIRECTED BY THE ENGINEER AT THE CONTRACTOR'S EXPENSE.
19. THE CONTRACTOR MUST VERIFY THE EXISTING SUBBASE AND PAVEMENT DEPTH IF APPLICABLE.
20. THE THICKNESS OF HMA SHOWN ON THE PLANS IS THE NOMINAL THICKNESS. DEVIATIONS FROM THE NOMINAL THICKNESS WILL BE PERMITTED WHEN SUCH DEVIATIONS OCCUR DUE TO IRREGULARITIES IN THE EXISTING SURFACE OR BASE ON WHICH THE HMA IS PLACED.
21. BEFORE BEGINNING ANY WORK, THE CONTRACTOR SHALL RETAIN AND RECORD FOR FUTURE REFERENCE, ALL EXISTING PAVEMENT MARKING LINES AND RAISED REFLECTIVE PAVEMENT MARKERS THAT CONFLICT WITH TEMPORARY MARKINGS, IN ORDER THAT THESE LOCATIONS CAN BE RE-ESTABLISHED FOR PROPOSED STRIPING AT THE COMPLETION OF THIS CONTRACT. EXACT LOCATIONS OF ALL PROPOSED PAVEMENT MARKINGS SHALL BE DIRECTED BY THE RESIDENT ENGINEER.

22. GEOTECHNICAL FABRIC FOR GROUND STABILIZATION AND/OR AGGREGATE SUBGRADE IMPROVEMENT (CU YD) HAVE BEEN PROVIDED FOR USE AT THE LOCATIONS INDICATED FOR SOILS THAT TEND TO BE UNSTABLE AND/OR UNSUITABLE. THE ACTUAL NEED FOR REMOVAL AND REPLACEMENT WITH ABOVE ITEM WILL BE DETERMINED IN THE FIELD AT THE TIME OF CONSTRUCTION BY THE GEOTECHNICAL ENGINEER. ALL POTENTIALLY UNSTABLE SOILS SHOULD BE TESTED WITH A STATIC OR DYNAMIC CONE PENETROMETER AND TREATED IN ACCORDANCE WITH ARTICLE 301.04 OF THE SSRBC AND IDOT SUBGRADE STABILITY MANUAL. IF UNSTABLE AND/OR UNSUITABLE SOILS ARE NOT ENCOUNTERED, THEN THE QUANTITY SHALL BE DEDUCTED AND NO ADDITIONAL COMPENSATION WILL BE DUE TO THE CONTRACTOR.

23. THE CONTRACTOR'S ATTENTION IS CALLED TO THE FACT THAT THE PRESERVATION OF EXISTING TREES IS OF UTMOST IMPORTANCE TO THE VILLAGE OF WHEATON. EXISTING VEGETATED AREAS (TREES, SHRUBS, VEGETATIVE BUFFERS, TURF AREAS, ETC.) WHERE DISTURBANCE IS NOT OCCURRING (INCLUDING AREAS OUTSIDE THE PROJECT LIMITS) SHALL NOT BE DISTURBED TO ENSURE THAT EXISTING VEGETATION IS PRESERVED TO MINIMIZE SOIL EROSION AND TO ELIMINATE SOIL COMPACTION. NO MATERIALS ARE TO BE STORED OR VEHICLES DRIVEN OR PARKED WITHIN THESE UNDISTURBED AREAS AT ANY TIME.

24. PHOSPHORUS FERTILIZER HAS BEEN INTENTIONALLY OMITTED FROM THE CONTRACT DUE TO THE PROXIMITY TO THE EXISTING CREEK. A PHOSPHORUS-FREE FERTILIZER SHALL BE USED (MIDDLE NUMBER SHOULD EQUAL 0).

MODEL: \\MODELS\FILES  
FILE NUMBER: 3115



USER NAME = \$USERS	DESIGNED - KE	REVISED -  5/23/2023
	DRAWN - KE	REVISED -
PLOT SCALE = \$SCALES	CHECKED - TC	REVISED -
PLOT DATE = \$DATES	DATE - 03/22/2023	REVISED -

**STATE OF ILLINOIS  
DEPARTMENT OF TRANSPORTATION**

**IL 38 OVER WINFIELD CREEK  
INDEX, HIGHWAY STANDARDS & GENERAL NOTES**

SCALE: NONE SHEET OF SHEETS STA. TO STA.

F.A.P. RTE.	SECTION	COUNTY	TOTAL SHEETS	SHEET NO.
347	FAP 0347 22 BJ2	DUPAGE	39	2
			CONTRACT NO. 62T16	
		ILLINOIS	FED. AID PROJECT	

**REVISED SHEET 5/26/2023**

CODE NO.	ITEM	UNIT	TOTAL QUANTITY	CONSTRUCTION CODE			
				NHPP 80% FED 20% STATE	NHPP 80% FED 20% STATE		
				ROADWAY 0005	BRIDGE 0047		
				URBAN	5.N.022-2009		
20200100	EARTH EXCAVATION	CU YD	98	98	0		
21001000	GEOTECHNICAL FABRIC FOR GROUND STABILIZATION	SQ YD	694	694	0		
21101615	TOPSOIL FURNISH AND PLACE, 4"	SQ YD	38	38	0		
25000210	SEEDING, CLASS 2A	ACRE	0.25	0.25	0		
25000400	NITROGEN FERTILIZER NUTRIENT	POUND	23	23	0		
25000600	POTASSIUM FERTILIZER NUTRIENT	POUND	23	23	0		
25100630	EROSION CONTROL BLANKET	SQ YD	38	38	0		
28000305	TEMPORARY DITCH CHECKS	FOOT	300	300	0		
28000400	PERIMETER EROSION BARRIER	FOOT	542	542	0		
28000500	INLET AND PIPE PROTECTION	EACH	4	4	0		
28000510	INLET FILTERS	EACH	2	2	0		
35101800	AGGREGATE BASE COURSE, TYPE B 6"	SQ YD	53	53	0		
35501308	HOT-MIX ASPHALT BASE COURSE, 6"	SQ YD	53	53	0		
35501329	HOT-MIX ASPHALT BASE COURSE, 11 1/4"	SQ YD	52	52	0		

\*SPECIALTY ITEM

CODE NO.	ITEM	UNIT	TOTAL QUANTITY	CONSTRUCTION CODE			
				NHPP 80% FED 20% STATE	NHPP 80% FED 20% STATE		
				ROADWAY 0005	BRIDGE 0047		
				URBAN	5.N.022-2009		
40600290	BITUMINOUS MATERIALS (TACK COAT)	POUND	370 <del>3,312</del>	370 <del>3,312</del>	0		
40600982	HOT-MIX ASPHALT SURFACE REMOVAL - BUTT JOINT	SQ YD	400	400	0		
40603085	HOT-MIX ASPHALT BINDER COURSE, IL-19.0, N70	TON	90	90	0		
40604060	HOT-MIX ASPHALT SURFACE COURSE, IL-9.5, MIX "D", N50	TON	5.9	5.9	0		
40604062	HOT-MIX ASPHALT SURFACE COURSE, IL-9.5, MIX "D", N70	TON	60	60	0		
44000100	PAVEMENT REMOVAL	SQ YD	173	173	0		
48102100	AGGREGATE WEDGE SHOULDER, TYPE B	TON	4	4	0		
48203029	HOT-MIX ASPHALT SHOULDERS, 8"	SQ YD	172	172	0		
50300225	CONCRETE STRUCTURES	CU YD	48	0	48		
50300260	BRIDGE DECK GROOVING	SQ YD	659	0	659		
50300300	PROTECTIVE COAT	SQ YD	659	0	659		
50301350	CONCRETE SUPERSTRUCTURE (APPROACH SLAB)	CU YD	213	0	213		
50800205	REINFORCEMENT BARS, EPOXY COATED	POUND	72,091	0	72,091		
* 50901050	STEEL RAILING, TYPE SM	FOOT	155	0	155		

\*SPECIALTY ITEM

MODEL: \$MODELNAME\$  
FILE NAME: \$FILE\$



USER NAME = \$USERS\$	DESIGNED - KE	REVISED -
	DRAWN - KE	REVISED -
PLOT SCALE = \$SCALE\$	CHECKED - TC	REVISED -
PLOT DATE = \$DATE\$	DATE - 03/22/2023	REVISED -

STATE OF ILLINOIS  
DEPARTMENT OF TRANSPORTATION

IL 38 OVER WINFIELD CREEK  
SUMMARY OF QUANTITIES

SCALE: NONE SHEET OF SHEETS STA. TO STA.

F.A.P. RTE.	SECTION	COUNTY	TOTAL SHEETS	SHEET NO.
347	FAP 0347 22 BJ2		39	3
			CONTRACT NO. 62T16	
ILLINOIS FED. AID PROJECT				

REVISOR: [Symbol] REVISED SHEET 5/26/2023

20200100					
EARTH EXCAVATION					
ALIGNMENT	STATION FROM	OFFSET	STATION TO	OFFSET	CU YD
IL-38 ROAD	2+56.87	44.00,LT	2+92.87	44.00,LT	12
IL-38 ROAD	2+56.87	44.00,RT	2+92.50	44.00,RT	18
IL-38 ROAD	3+70.37	39.00,LT	4+02.91	42.73,LT	11
IL-38 ROAD	4+30.18	39.00,LT	4+47.81	39.00,LT	4
IL-38 ROAD	3+70.86	39.00,RT	4+47.37	39.00,RT	32
IL-38 ROAD	3+96.54	28.00,RT	4+36.53	28.00,RT	21
TOTAL					98

21101615					
TOPSOIL FURNISH AND PLACE, 4"					
ALIGNMENT	STATION FROM	OFFSET	STATION TO	OFFSET	SQ YD
IL-38 ROAD	3+40.86	39.26,RT	4+47.37	39.00,RT	38
TOTAL					38

25000210					
SEEDING, CLASS 2A					
ALIGNMENT	STATION FROM	OFFSET	STATION TO	OFFSET	ACRE
IL-38 ROAD	3+40.86	39.26,RT	4+47.37	39.00,RT	0.25
TOTAL					0.25

25000400					
NITROGEN FERTILIZER NUTRIENT					
ALIGNMENT	STATION FROM	OFFSET	STATION TO	OFFSET	POUND
IL-38 ROAD	3+40.86	39.26,RT	4+47.37	39.00,RT	23
TOTAL					23

25000600					
POTASSIUM FERTILIZER NUTRIENT					
ALIGNMENT	STATION FROM	OFFSET	STATION TO	OFFSET	POUND
IL-38 ROAD	3+40.86	39.26,RT	4+47.37	39.00,RT	23
TOTAL					23

25100630					
EROSION CONTROL BLANKET					
ALIGNMENT	STATION FROM	OFFSET	STATION TO	OFFSET	SQ YD
IL-38 ROAD	3+40.86	39.26,RT	4+47.37	39.00,RT	38
TOTAL					38

28000400					
PERIMETER EROSION BARRIER					
ALIGNMENT	STATION FROM	OFFSET	STATION TO	OFFSET	FOOT
IL-38 ROAD	1+03.27	42.38,RT	3+16.40	44.00,RT	212
IL-38 ROAD	2+42.11	45.42,LT	3+20.65	39.68,LT	80
IL-38 ROAD	3+42.62	39.98,LT	4+05.85	48.42,LT	66
IL-38 ROAD	4+28.21	45.59,LT	4+52.63	44.09,LT	24
IL-38 ROAD	3+44.65	42.84,RT	5+04.32	43.39,RT	160
TOTAL					542

28000500			
INLET AND PIPE PROTECTION			
ALIGNMENT	STATION	OFFSET	EACH
IL-38 ROAD	2+03.35	36.72,LT	1
IL-38 ROAD	2+96.43	41.46,RT	1
IL-38 ROAD	4+35.81	39.41,LT	1
IL-38 ROAD	5+32.36	39.33,RT	1
TOTAL			4

28000510			
INLET FILTERS			
ALIGNMENT	STATION	OFFSET	EACH
IL-38 ROAD	5+35.65	28.94,RT	1
IL-38 ROAD	5+33.67	29.71,LT	1
TOTAL			2

28000305			
TEMPORARY DITCH CHECKS			
ALIGNMENT	STATION	OFFSET	FOOT
IL-38 ROAD	2+91.11	41.91, RT	100
IL-38 ROAD	5+36.17	39.26, RT	100
IL-38 ROAD	4+57.19	37.87, LT	100
TOTAL			300

35501329					
HOT-MIX ASPHALT BASE COURSE, 11 1/4"					
ALIGNMENT	STATION FROM	OFFSET	STATION TO	OFFSET	SQ YD
IL-38 ROAD	2+89.60	38.68,LT	2+92.60	38.56,LT	26
IL-38 ROAD	3+70.83	43.33,RT	3+73.83	43.39,RT	26
TOTAL					52

40600290					
BITUMINOUS MATERIALS (TACK COAT)					
ALIGNMENT	STATION FROM	OFFSET	STATION TO	OFFSET	POUND
IL-38 ROAD	2+56.87	28.00,RT	2+92.60	28.00,RT	102
IL-38 ROAD	3+70.72	28.00,RT	4+47.37	28.00,RT	9
IL-38 ROAD	2+56.87	36.00,RT	2+92.60	36.00,RT	9
IL-38 ROAD	2+56.87	36.00,LT	2+92.60	36.00,LT	216
IL-38 ROAD	3+70.72	36.00,RT	4+47.37	36.00,RT	19
IL-38 ROAD	3+70.72	36.00,LT	4+47.37	36.00,LT	15
TOTAL					370

40603085					
HOT-MIX ASPHALT BINDER COURSE, IL-19.0, N70					
ALIGNMENT	STATION FROM	OFFSET	STATION TO	OFFSET	TON
IL-38 ROAD	2+56.87	28.00,RT	2+92.60	28.00,RT	29
IL-38 ROAD	3+70.72	28.00,RT	4+47.37	28.00,RT	61
TOTAL					90

40604062					
HOT-MIX ASPHALT SURFACE COURSE, IL-9.5, MIX "D", N70					
ALIGNMENT	STATION FROM	OFFSET	STATION TO	OFFSET	TON
IL-38 ROAD	2+56.87	28.00,RT	2+92.60	28.00,RT	19
IL-38 ROAD	3+70.72	28.00,RT	4+47.37	28.00,RT	41
TOTAL					60

48102100					
AGGREGATE WEDGE SHOULDER, TYPE B					
ALIGNMENT	STATION FROM	OFFSET	STATION TO	OFFSET	TON
IL-38 ROAD	2+56.87	39.00,LT	2+92.87	39.00,LT	0.7
IL-38 ROAD	2+56.87	39.00,RT	2+92.50	39.00,RT	0.7
IL-38 ROAD	3+70.37	39.00,LT	4+02.91	39.00,LT	0.7
IL-38 ROAD	4+30.18	39.00,LT	4+47.81	39.00,LT	0.3
IL-38 ROAD	3+70.86	39.00,RT	4+47.37	39.00,RT	1.5
TOTAL					4.0

48203029					
HOT-MIX ASPHALT SHOULDERS, 8"					
ALIGNMENT	STATION FROM	OFFSET	STATION TO	OFFSET	SQ YD
IL-38 ROAD	2+56.87	36.00,LT	2+92.87	36.00,LT	33
IL-38 ROAD	2+56.87	36.00,RT	2+92.50	36.00,RT	32
IL-38 ROAD	3+70.37	36.00,LT	4+02.91	36.00,LT	26
IL-38 ROAD	4+30.18	36.00,LT	4+47.81	36.00,LT	12
IL-38 ROAD	3+70.86	36.00,RT	4+47.37	36.00,RT	69
TOTAL					172

63000001					
STEEL PLATE BEAM GUARDRAIL, TYPE A, 6 FOOT POSTS					
ALIGNMENT	STATION FROM	OFFSET	STATION TO	OFFSET	FOOT
IL-38 ROAD	2+58.23	38.61,LT	3+07.87	38.25,LT	50
IL-38 ROAD	3+55.37	38.25,LT	4+03.77	46.46,LT	50
IL-38 ROAD	1+32.51	36.73,RT	3+07.87	28.00,RT	175
IL-38 ROAD	3+55.37	38.25,RT	4+80.21	37.42,RT	125
TOTAL					400

63100045					
TRAFFIC BARRIER TERMINAL, TYPE 2					
ALIGNMENT	STATION FROM	OFFSET	STATION TO	OFFSET	EACH
IL-38 ROAD	2+47.61	38.68,LT	2+60.11	38.56,LT	1
IL-38 ROAD	4+91.82	43.33,RT	5+04.32	43.39,RT	1
TOTAL					2

63100169					
TRAFFIC BARRIER TERMINAL, TYPE 1 (SPECIAL) FLARED					
ALIGNMENT	STATION FROM	OFFSET	STATION TO	OFFSET	EACH
IL-38 ROAD	0+92.57	40.41, RT	1+05.07	38.39, RT	1
TOTAL					1

X2020110					
GRADING AND SHAPING SHOULDERS					
ALIGNMENT	STATION FROM	OFFSET	STATION TO	OFFSET	UNIT
IL-38 ROAD	2+56.87	39.00,LT	2+92.87	39.00,LT	0.36
IL-38 ROAD	2+56.87	39.00,RT	2+92.50	39.00,RT	0.36
IL-38 ROAD	3+70.37	39.00,LT	4+02.91	39.00,LT	0.39
IL-38 ROAD	4+30.18	39.00,LT	4+47.81	39.00,LT	0.17
IL-38 ROAD	3+70.86	39.00,RT	4+47.37	39.00,RT	0.77
TOTAL					2

DRIVEWAYS							
ALIGNMENT	STATION FROM	OFFSET	STATION TO	OFFSET	HOT-MIX ASPHALT SURFACE COURSE, MIX "D", IL-9.5, N50, 2"	HOT-MIX ASPHALT BASE COURSE, 6"	AGGREGATE BASE COURSE, TYPE B, 6"
					TON	SQ YD	SQ YD
IL-38 ROAD	3+96.54	28.00, LT	4+36.53	28.00, LT	6	53	53
TOTAL					6	53	53

MODEL: SMOBELNAMES  
FILE NAME: STILES



USER NAME = \$USERS	DESIGNED - MM	REVISED - 5/23/2023
PLOT SCALE = \$SCALES	CHECKED - TC	REVISED -
PLOT DATE = \$DATES	DATE - 03/22/2023	REVISED -

STATE OF ILLINOIS  
DEPARTMENT OF TRANSPORTATION

IL 38 OVER WINFIELD CREEK  
SCHEDULE OF QUANTITIES

SCALE: NONE SHEET 1 OF 2 SHEETS STA. TO STA.

F.A.P. RTE. 347	SECTION FAP 0347 22 BJ2	COUNTY DUPAGE	TOTAL SHEETS 39	SHEET NO. 6
CONTRACT NO. 62T16				
ILLINOIS FED. AID PROJECT				

REVISED SHEET 5/26/2023

**LEGEND – EXISTING:**


- ① EXISTING P.C.C. PAVEMENT COURSE, 7" (+/-)
- ② EXISTING HMA SURFACE COURSE, 7.75" (+/-)
- ③ EXISTING AGGREGATE SHOULDER
- ④ EXISTING HMA SHOULDER
- ⑤ EXISTING APPROACH FOOTING

**LEGEND – REMOVAL**

- HOT-MIX ASPHALT SURFACE REMOVAL, VARIABLE DEPTH
- P.C.C. PAVEMENT REMOVAL
- PAVED SHOULDER REMOVAL
- PAVED SUBBASE REMOVAL
- GUARDRAIL REMOVAL


**LEGEND – PROPOSED:**

- ⑦ HOT-MIX ASPHALT SURFACE COURSE, MIX "D", IL-9.5, N70, 1-1/2"
- ⑧ HOT-MIX ASPHALT BINDER COURSE, IL-19.0, N70, 2-1/4"
- ⑨ HOT-MIX ASPHALT SHOULDERS, 8"
- ⑩ AGGREGATE WEDGE SHOULDER, TYPE B
- ⑪ STEEL PLATE BEAM GUARDRAIL, TYPE A
- ⑫ TOPSOIL EXCAVATION AND PLACEMENT
- ⑬ BRIDGE DECK LATEX CONCRETE OVERLAY, 2 1/2"
- ⑭ BRIDGE DECK SCARIFICATION, 3/4", TYP.
- ⑮ DECK SLAB REPAIR (FULL DEPTH, TYPE II), TYP.
- ⑯ STEEL RAILING, TYPE SM
- ⑰ HOT-MIX ASPHALT BASE COURSE, 11-1/4"
- ⑱ APPROACH FOOTING, 10"

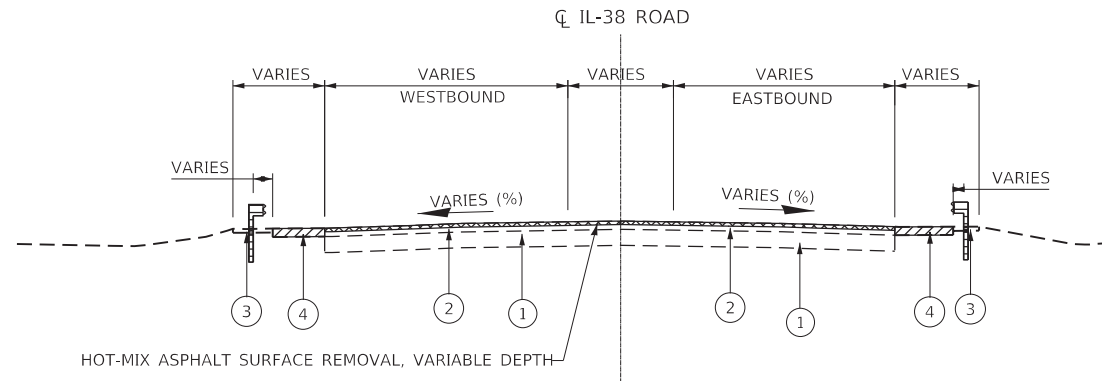


**EXISTING TYPICAL SECTION**

STA 3+73.37 TO STA 4+47.37  
(LOOKING WEST)

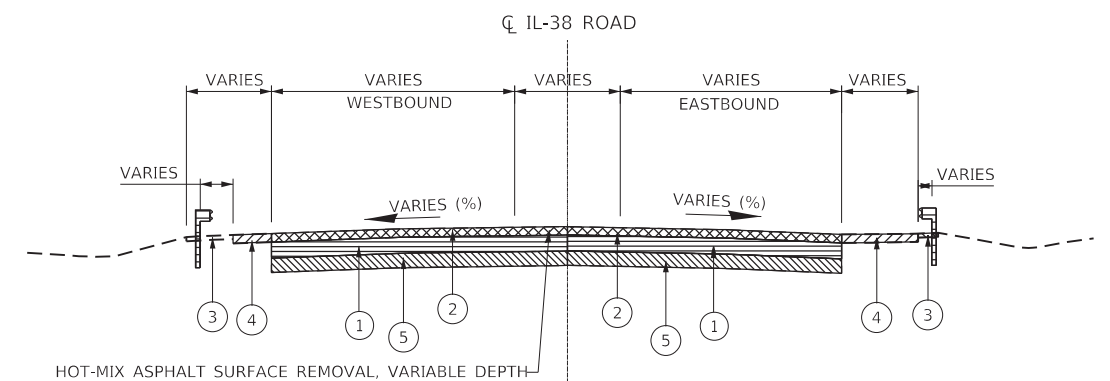


**EXISTING TYPICAL SECTION**

STA 2+89.87 TO STA 2+92.87  
AND  
STA 3+70.37 TO STA 3+73.37

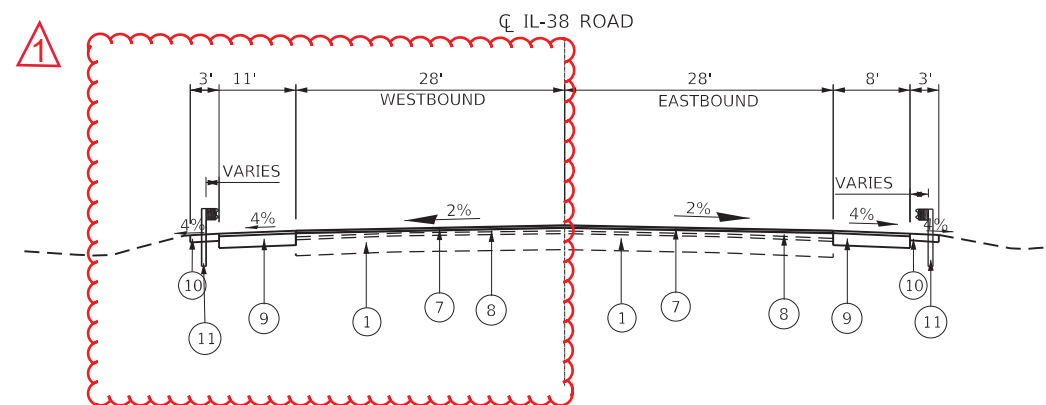

**PROPOSED TYPICAL SECTION**

STA 3+73.37 TO STA 4+47.37  
(LOOKING WEST)

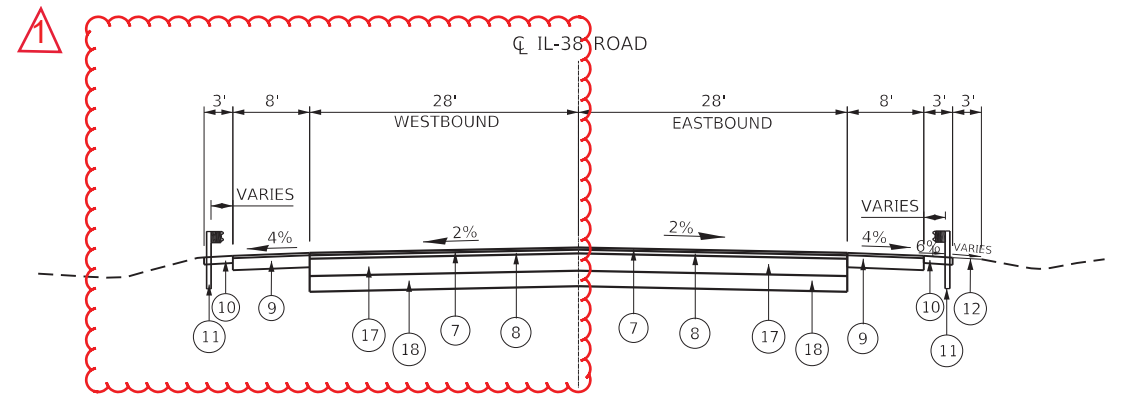

**PROPOSED TYPICAL SECTION**

STA 2+89.87 TO STA 2+92.87  
AND  
STA 3+70.37 TO STA 3+73.37

OPERATIONS	PAVEMENT MIXTURE REQUIREMENTS FOR IL-38 ROAD	PERCENTAIR VOIDS @ Ndes	QMP
RESURFACING	HOT-MIX ASPHALT SURFACE COURSE, MIX "D", IL-9.5, N70, 1-1/2"	4% @ 70 Gyr.	QC/QA
	HOT-MIX ASPHALT BINDER COURSE, IL-19.0, N70, 2-1/4"	4% @ 70 Gyr.	QC/QA
HMA SHOULDER 8"	HOT-MIX ASPHALT SURFACE COURSE, MIX "D", IL-9.5, N70, 1-1/2"	4% @ 70 Gyr.	QC/QA
	HOT-MIX ASPHALT BINDER COURSE, IL-19.0, N70, 6-1/2"	4% @ 70 Gyr.	QC/QA
DRIVEWAYS	HOT-MIX ASPHALT SURFACE COURSE, MIX "D", IL-9.5, N50, 2"	4% @ 50 Gyr.	QC/QA
	HOT-MIX ASPHALT BASE COURSE, 6"(HMA BINDER, IL-19)	4% @ 50 Gyr.	QC/QA
PAVEMENT RECONSTRUCTION	HOT-MIX ASPHALT SURFACE COURSE, MIX "D", IL-9.5, N70, 1-1/2"	4% @ 70 Gyr.	QC/QA
	HOT-MIX ASPHALT BINDER COURSE, IL-19.0, N70, 2-1/4"	4% @ 70 Gyr.	QC/QA
	HOT-MIX ASPHALT BASE COURSE, 11-1/4" (HMA BINDER, IL-19, N70)	4% @ 70 Gyr.	QC/QA

QMP Designations: Quality Control/Quality Assurance (QC/QA); Quality Control for Performance (QCP); Pay for Performance (PFP)

- THE UNIT WEIGHT USED TO CALCULATE ALL HMA SURFACE MIXTURE QUANTITIES IS 112 LBS/SQ YD/IN.

- THE "AC TYPE" FOR POLYMERIZED HMA MIXES SHALL BE "SBS/SBR PG 76 -22" AND FOR NON- OLYMERIZED HMA THE "AC TYPE" SHALL BE "PG 64 -22" UNLESS MODIFIED BY RECLAIMED MATERIALS SPECIFICATIONS.

**1** REVISED SHEET 5/26/2023

MODEL: Default  
FILE: \\hpc\p\hamre\ch-us-cms-ppl\kentley.com\WOOD-US-IDOT\Documents\Project IDOT 3202211754 - IDOT District 1\Various\CAD\_Sheets\Work Order 1609160630-ht-sys\pca12.dgn




USER NAME = majid.mastali	DESIGNED - MM	REVISED - <b>1</b> 5/23/2023
	DRAWN - MM	REVISED -
PLOT SCALE = 20.0000 ' / in.	CHECKED - TC	REVISED -
PLOT DATE = 5/25/2023	DATE - 03/22/2023	REVISED -

**STATE OF ILLINOIS  
DEPARTMENT OF TRANSPORTATION**

**IL 38 OVER WINFIELD CREEK  
TYPICAL SECTIONS**


SCALE: NONE SHEET 2 OF 2 SHEETS STA. 3+70.37 TO STA. 4+47.37

F.A.P. RTE.	SECTION	COUNTY	TOTAL SHEETS	SHEET NO.
347	FAP 0347 22 BJ2	DUPAGE	39	9
CONTRACT NO. 62T16				
ILLINOIS		FED. AID PROJECT		

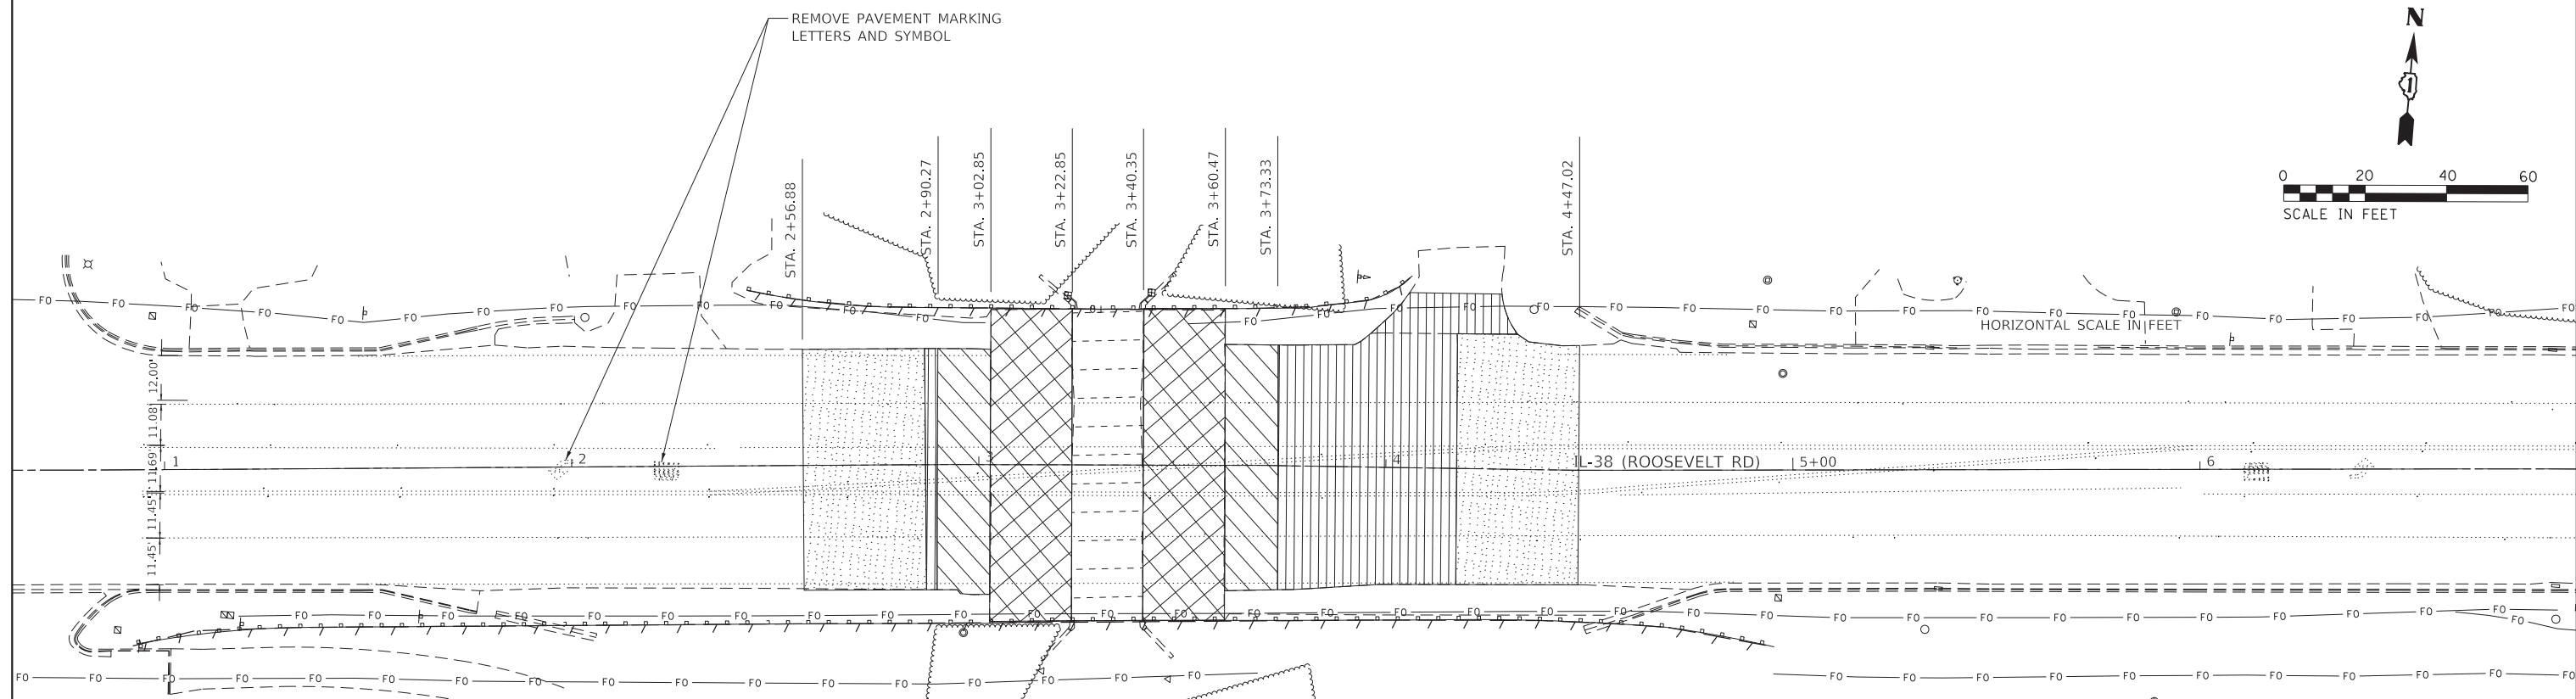

**REMOVAL LEGEND:**

- HOT-MIX ASPHALT SURFACE REMOVAL & BUTT JOINT
- APPROACH SLAB REMOVAL
- PAVEMENT REMOVAL
- HOT-MIX ASPHALT SURFACE REMOVAL VARIABLE DEPTH
- BRIDGE DECK SCARIFICATION
- GUARDRAIL REMOVAL

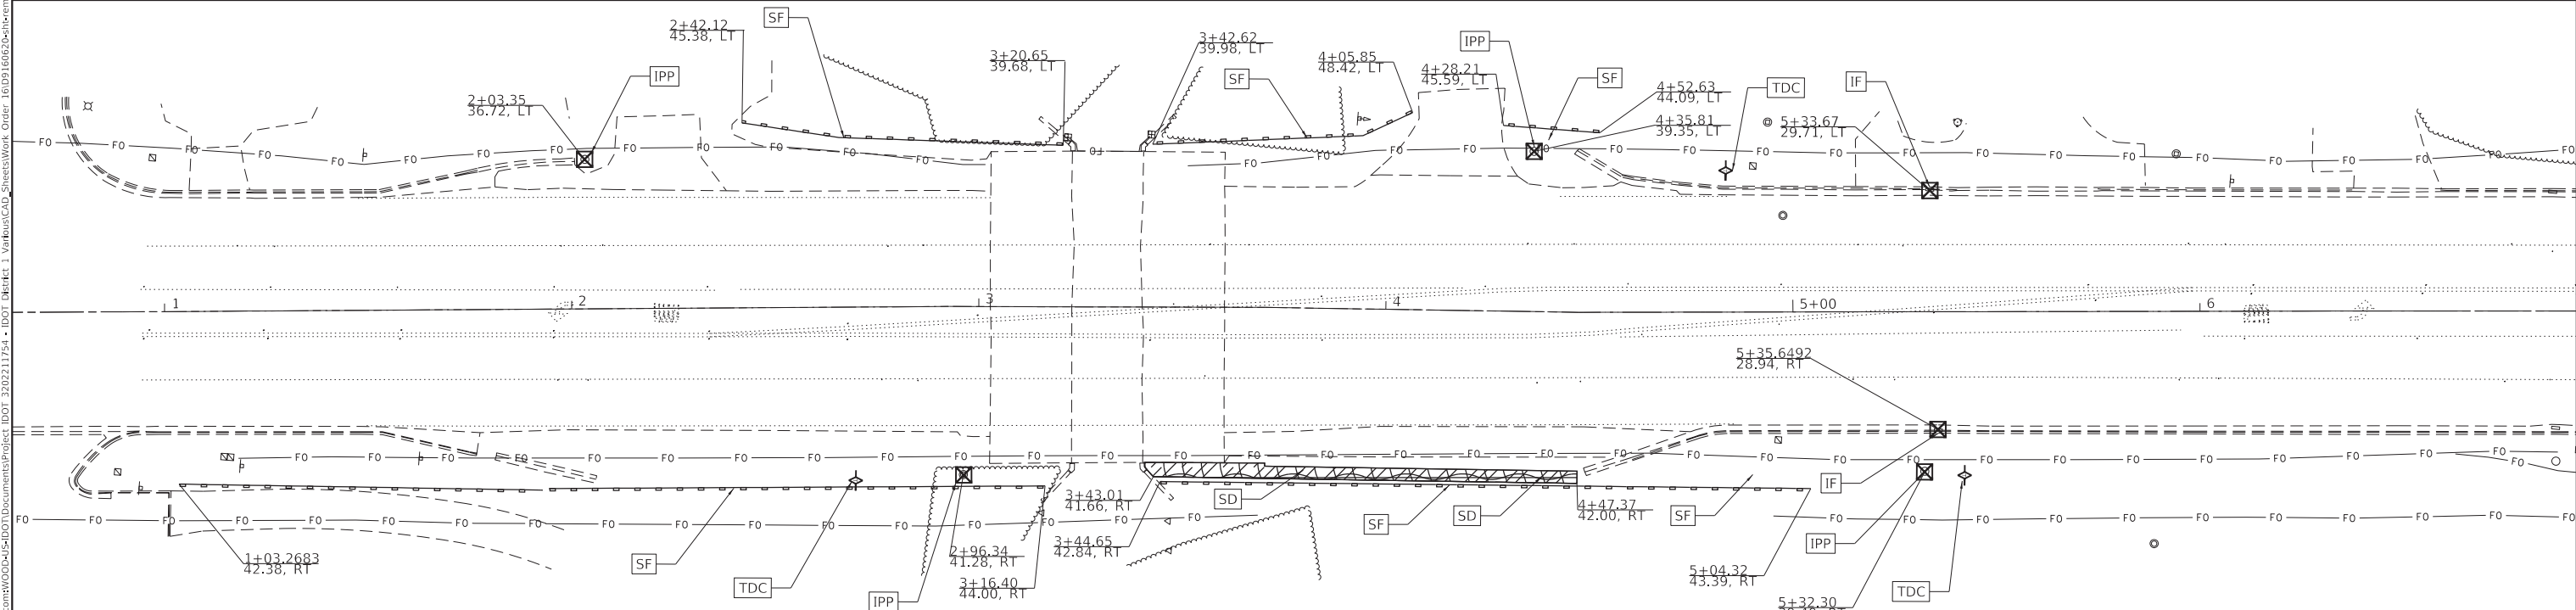

**EROSION CONTROL LEGEND**

- SF - PERIMETER EROSION BARRIER
- TDC - TEMPORARY DITCH CHECKS
- IF - INLET FILTERS
- IPP - INLET AND PIPE PROTECTION
- SD - SEEDING, CLASS 2A TOPSOIL FURNISH AND PLACE, 4" NITROGEN FERTILIZER NUTRIENT POTASSIUM FERTILIZER NUTRIENT EROSION CONTROL BLANKET

**REVISED SHEET 5/26/2023**



USER NAME - majid.mastal	DESIGNED - MM	REVISED -  5/23/2023
DRAWN - MM	CHECKED - TC	REVISED -
PLOT SCALE - 20.0000' / in.	DATE - 03/22/2023	REVISED -
PLOT DATE - 5/23/2023		

**STATE OF ILLINOIS  
DEPARTMENT OF TRANSPORTATION**

<b>IL 38 OVER WINFIELD CREEK REMOVAL AND EROSION CONTROL PLAN</b>	
SCALE: 1"=20'	SHEET 1 OF 1 SHEETS STA. TO STA.




F.A.P. RTE. 347	SECTION FAP 0347 22 BJ2	COUNTY DUPAGE	TOTAL SHEETS 39	SHEET NO. 11
CONTRACT NO. 62T16				
ILLINOIS FED. AID PROJECT				

MODEL: D:\inf\1... FILE: M:\MFC... \wsp\lanect\eruc-comp\wcbentley.com\W0004\JSD\DOT\Documents\Project\_IDOT\_3202211754 - IDOT Dbr\ref. 1\_Veribus\CAD\_Sheets\Work\_Order\_1609160620-eruc-renovat

PLAN	SURVEYED	DATE
	PLOTTED	BY
	GRADES CHECKED	
	STRUCTURE NOTATIONS OK'D	
	NOTE BOOK NO.	
	CADD FILE NAME	

PROFILE	SURVEYED	DATE
	PLOTTED	BY
	GRADES CHECKED	
	STRUCTURE NOTATIONS OK'D	
	NOTE BOOK NO.	
	CADD FILE NAME	

MODEL: Default  
 FILE NAME: p:\work\mech\user\mpe\p\by\com\w00545454\DOT\Documents\Project ID: 320231754 - IDOT Definit 1\WinfieldCAD\_Sheets\Work Order 1009160623\winfield\_profile.dgn

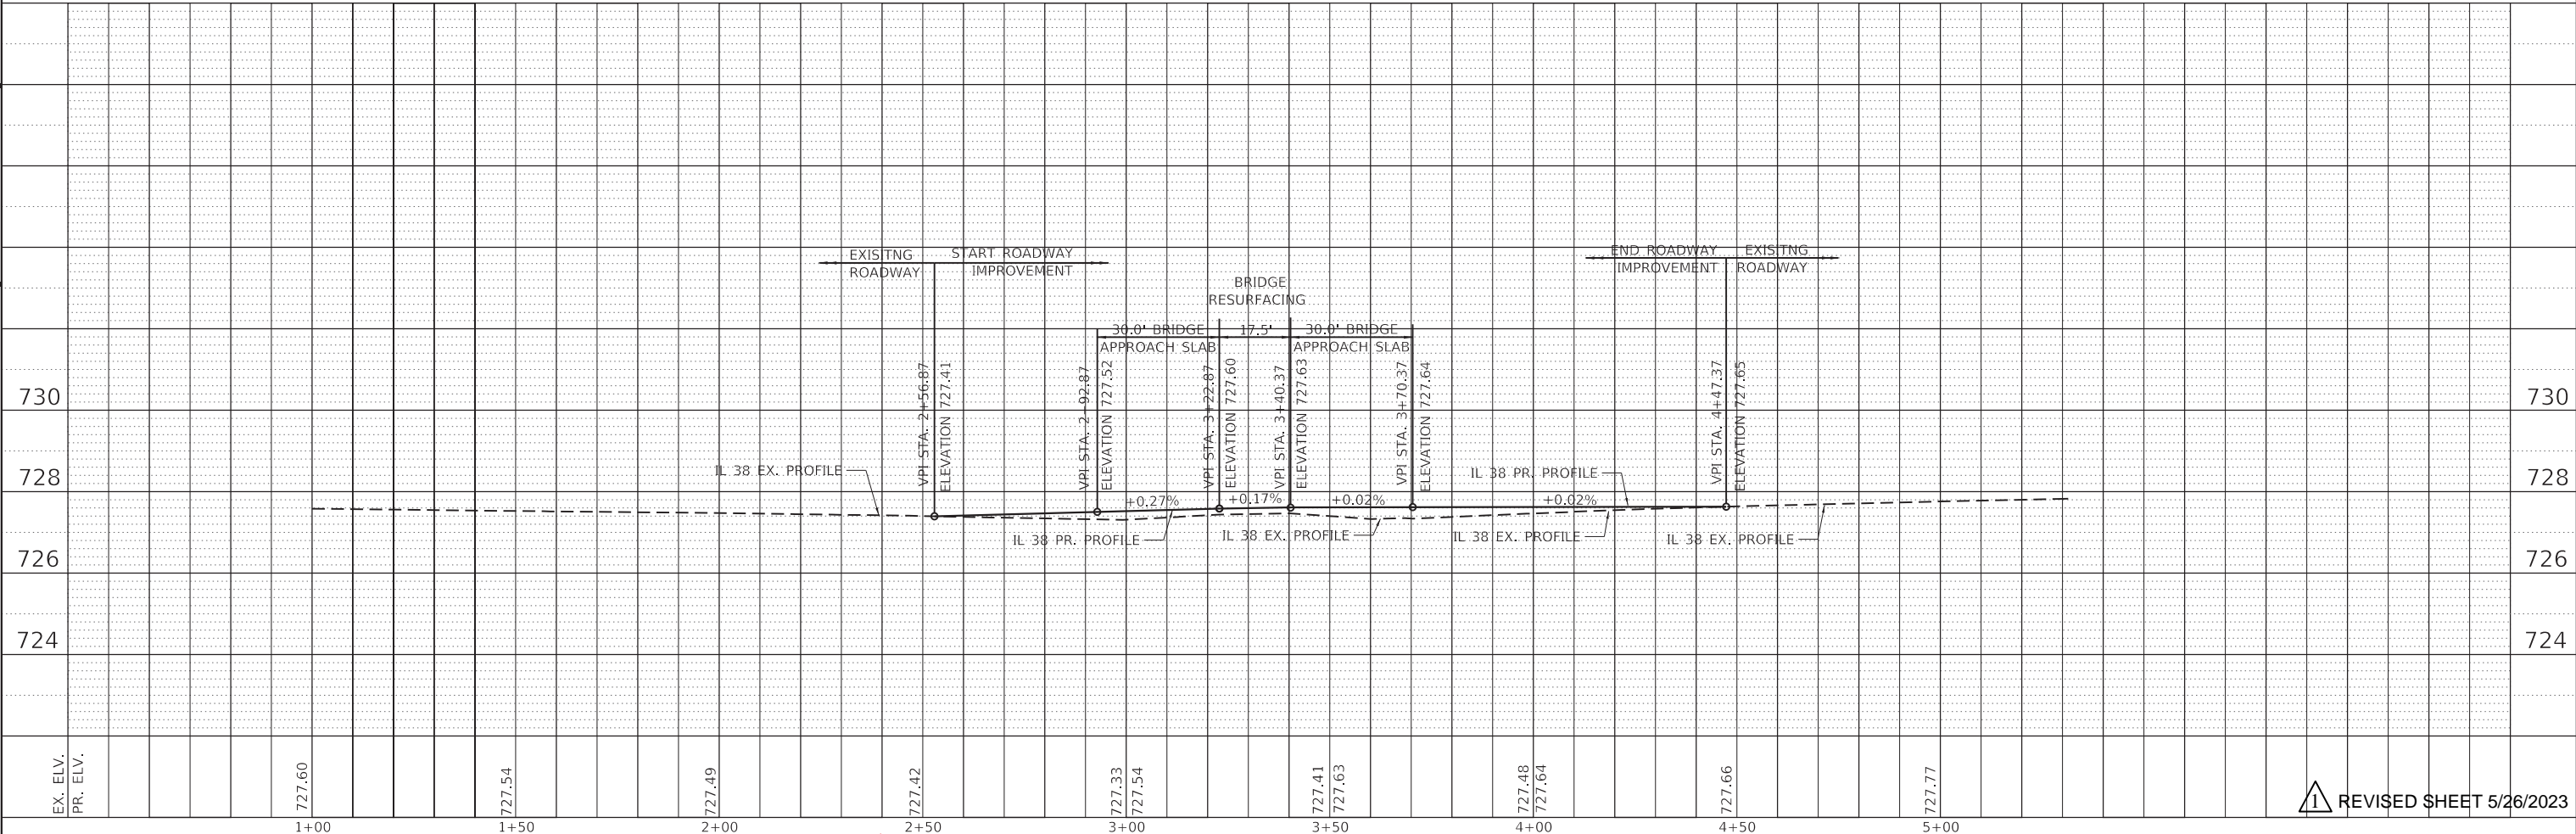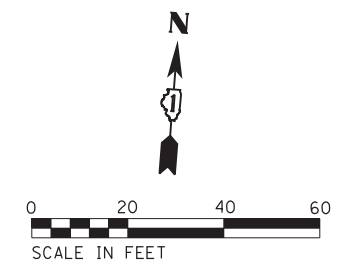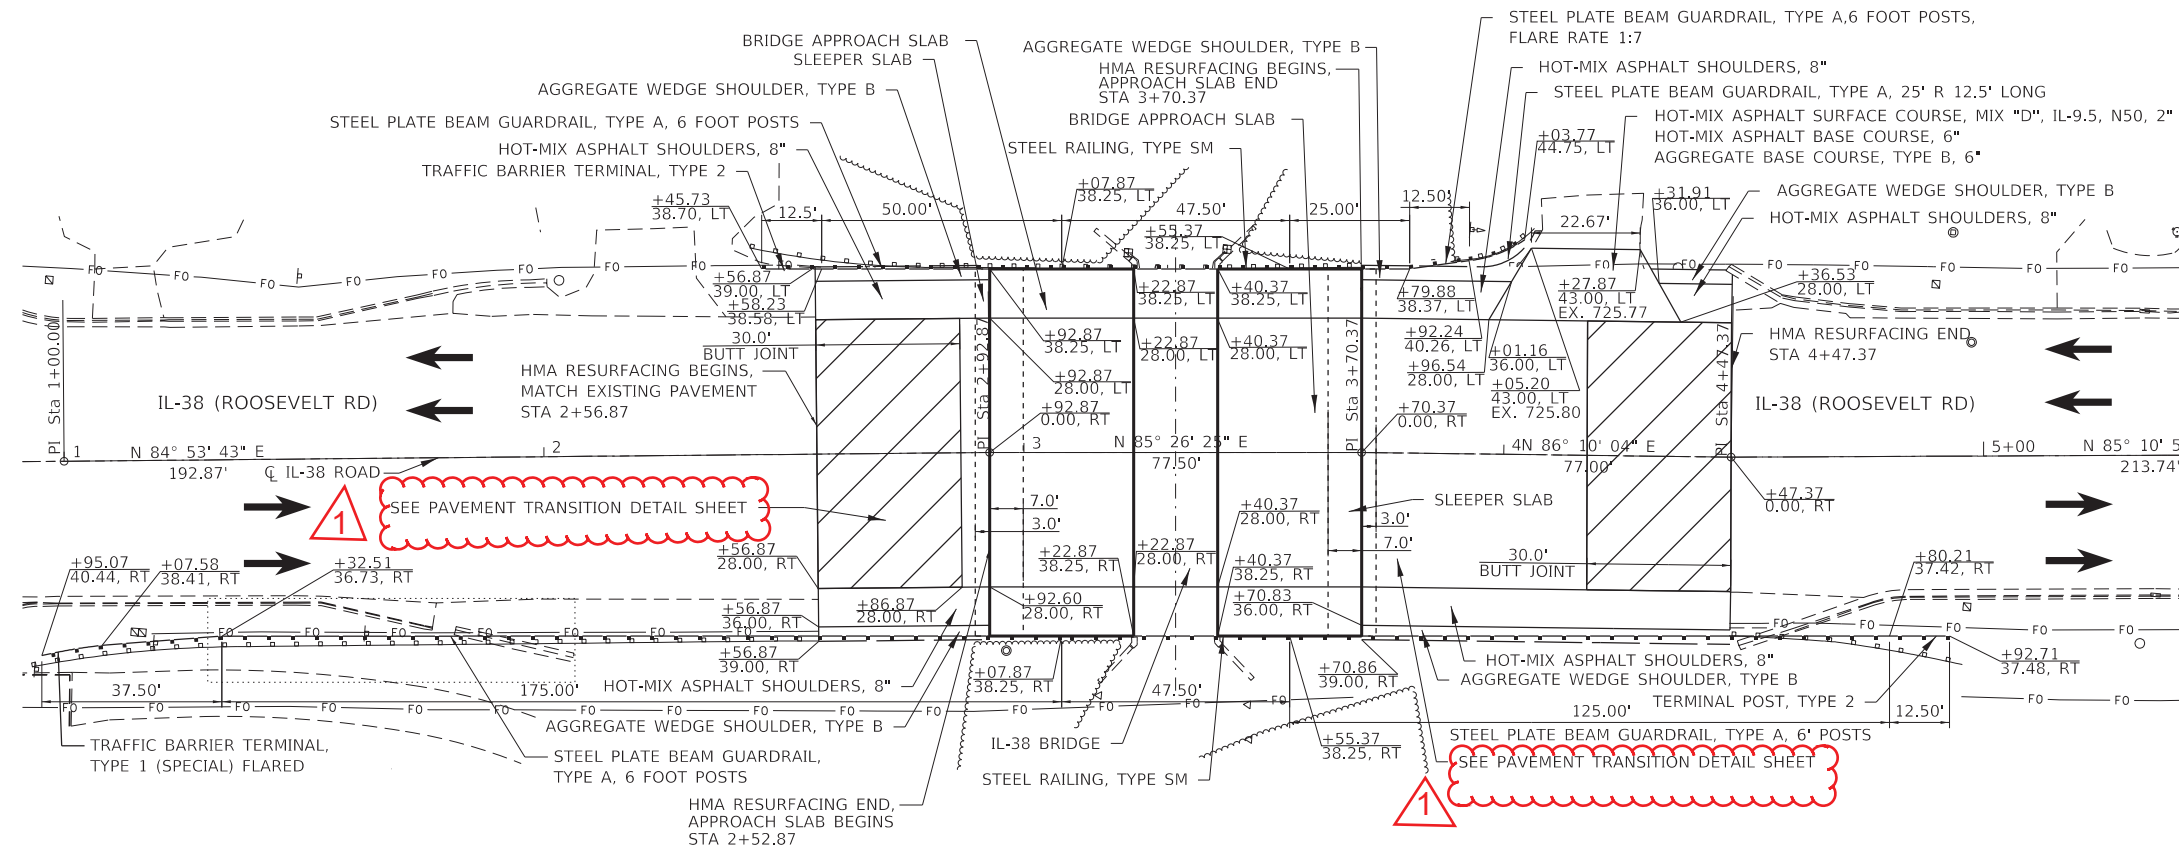

REVISÉ SHEET 5/26/2023



USER NAME	majid.mastaf	DESIGNED	MM	REVISED	5/23/2023
DRAWN	MM	CHECKED	TC	REVISED	
PLOT SCALE	20.0000' / 1" =	DATE	3/22/2022	REVISED	
PLOT DATE	5/23/2023				

STATE OF ILLINOIS  
 DEPARTMENT OF TRANSPORTATION

IL 38 OVER WINFIELD CREEK  
 ROADWAY PLAN AND PROFILE


SCALE: 1" = 20' SHEET 1 OF 1 SHEETS STA. TO STA.

F.A.P. RTE.	SECTION	COUNTY	TOTAL SHEETS	SHEET NO.
347	FAP 0347 22 BJ2	DUPAGE	38	12
CONTRACT NO. 62T16				
ILLINOIS FED. AID PROJECT				

Benchmark: BM1-Square cut in top of abutment in Southeast part of bridge over Winfield Creek. Elevation 727.08

Existing Structure: Structure No. 022-2009 was originally constructed in 1980 as a single span structure. In 1992 the structure was widened to the current width. The structure consists of a single span measuring 17'-6" from back-to-back abutments with an out-to-out width of 76'-6". The bridge carries two eastbound and two westbound lanes for IL-38 along with a shoulder in each direction and a median. The superstructure consists of a concrete deck slab that varies from 12" to 16" deep. The substructure consists of closed abutments on spread footings.

Traffic to be maintained utilizing staged construction.

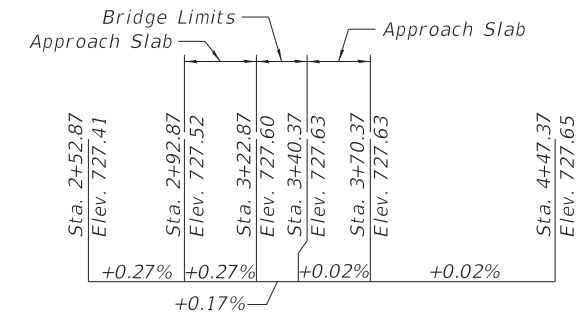

PROFILE GRADE

**INDEX OF SHEETS**

- S-1. GP&E
- S-2. General Notes and BOM
- S-3. Stage Construction Details
- S-4. Temporary Support System
- S-5. Abutment and Wingwall Repairs
- S-6. Deck Repair Plan
- S-7. Optional Deck Repair Details
- S-8. Approach Slab Removal
- S-9. Bridge Approach Slab Details
- S-10. Bridge Approach Slab Details
- S-11. Bridge Railings

**DESIGN STRESSES**

FIELD UNITS

- $f'c = 3,500$  psi (Existing)
- $f'c = 4,000$  psi (Superstructure)
- $f_y = 60,000$  psi (Reinforcement)
- $f_y = 50,000$  psi (M270 Grade 50)

**DESIGN SPECIFICATIONS**

2002 AASHTO Standard Specifications, 17th Edition


**LOADING HS 20-44**

No future wearing surface allowed.



3/22/2023

WILLIAM P. MALINOWSKI Date  
 Illinois Registered Engineer No. 081-006059  
 Registration Expires Nov. 30, 2024

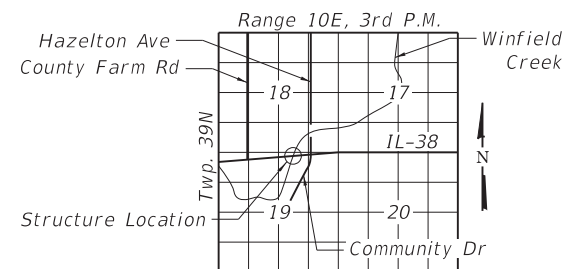


LOCATION SKETCH


**GENERAL PLAN AND ELEVATION**  
**IL RTE. 38 OVER WINFIELD CREEK**  
**F.A.P. RTE. 347 SEC. FAP 0347 22 BJ2**

**DUPAGE COUNTY**  
**STATION 3+31.62**  
**S.N. 022-2009**

REVISD SHEET 5/26/2023

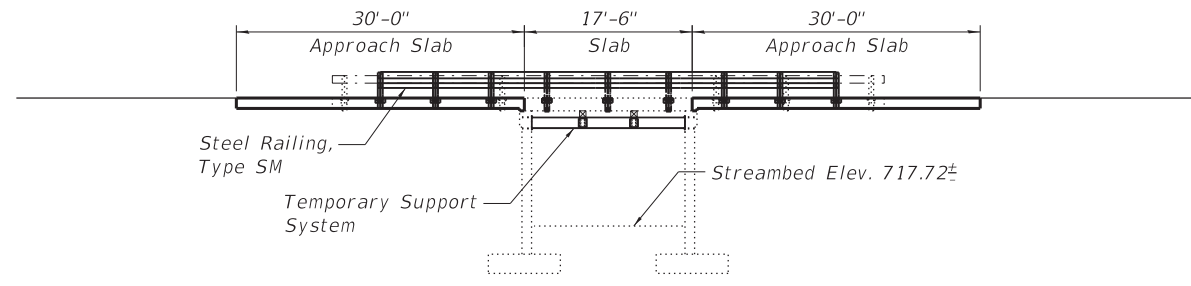

ELEVATION

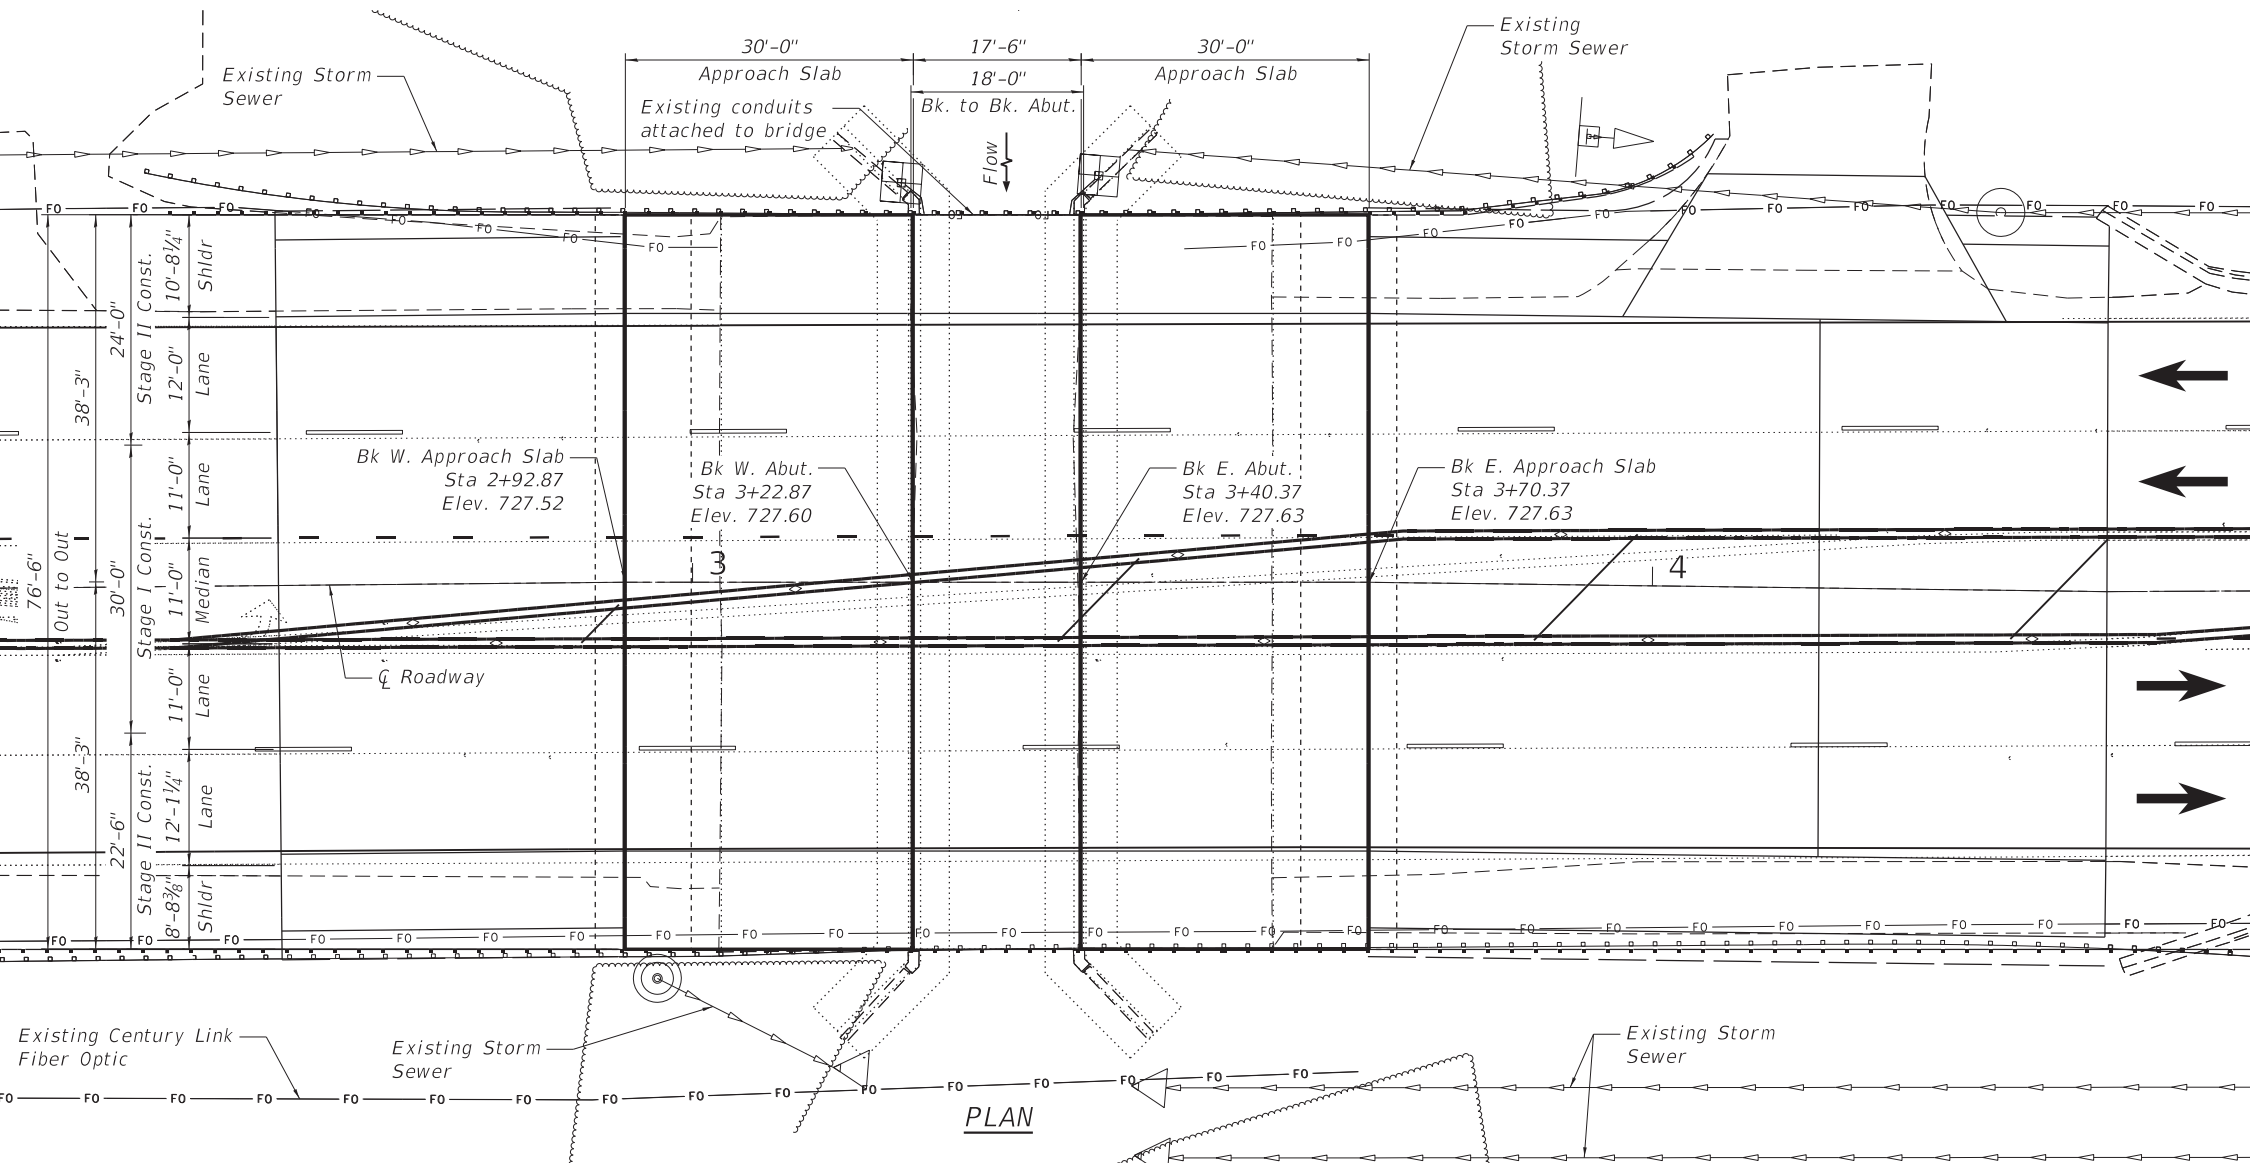

PLAN

MODEL: Default  
 FILE NAME: pw:\amec\fw-us-mm-pw.bentley.com\WOOD-US-IDOT\Documents\Project IDOT 3202211754 - IDOT District 1 Various\CAD\_Sheets\Work Order 16\16160620-sht-GP&E.dgn  
 5/23/2023 2:22:16 PM




USER NAME =	DESIGNED - BJD	REVISED - <span style="color: red;">▲</span> 5/24/2023
CHECKED - RAO	REVISIONS -	
PLOT SCALE =	DRAWN - GM	REVISIONS -
PLOT DATE =	CHECKED - MGH	REVISIONS -

**STATE OF ILLINOIS**  
**DEPARTMENT OF TRANSPORTATION**


**IL 38 OVER WINFIELD CREEK**  
**GENERAL PLAN AND ELEVATION**

SHEET S-1 OF S-11 SHEETS

F.A.P. RTE.	SECTION	COUNTY	TOTAL SHEETS	SHEET NO.
347	FAP 0347 22 BJ2	DUPAGE	39	20
CONTRACT NO. 62T16				
		ILLINOIS FED. AID PROJECT		

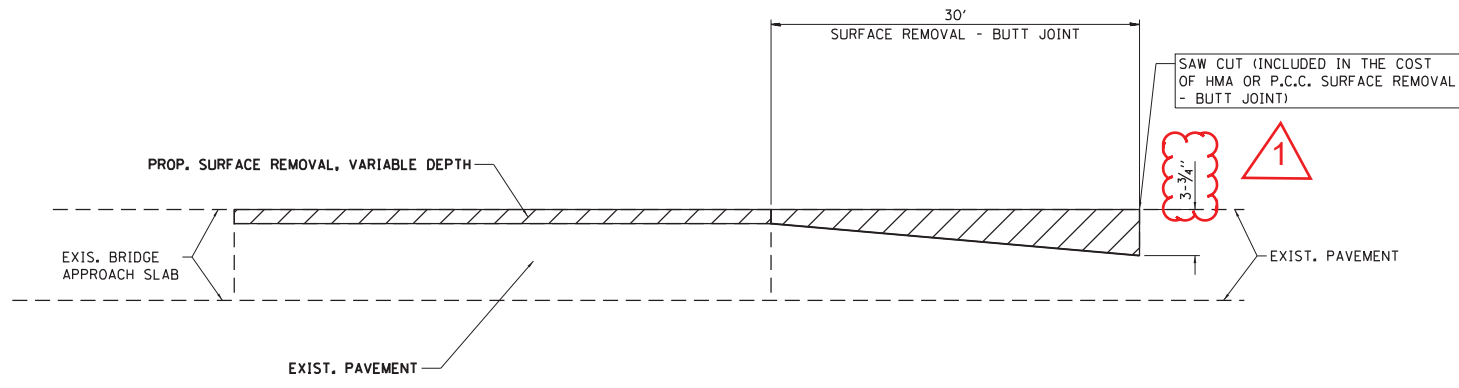

BUTT JOINT DETAIL

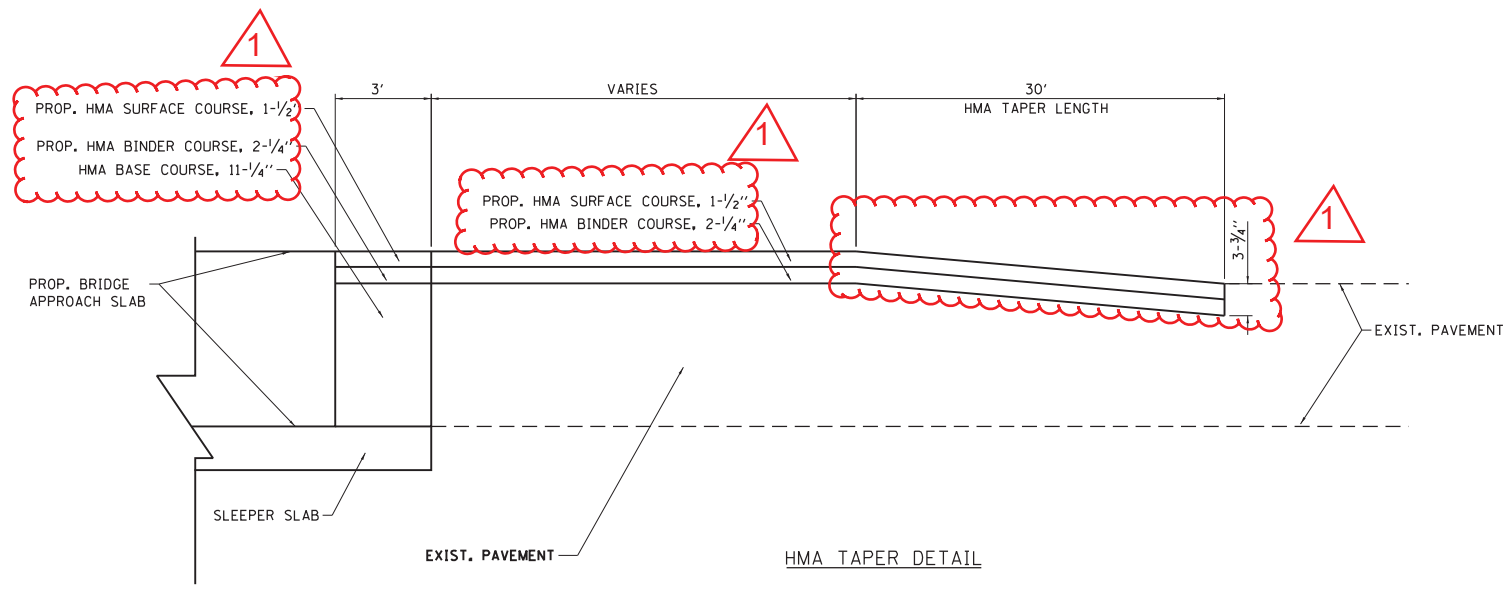

PAVEMENT TRANSITION DETAIL

MODEL: Default  
 FILE: \\bentley.com\W00000000\US\DOT\Documents\Project IDOT 3202211754 - IDOT -Bentley 1 - Various\CAD\_Sheets\Work Order 1600916662\ch1-Trans\HMA\_Detail.dgn



USER NAME	mmajd.mast@il	DESIGNED	- MM	REVISED	-  5/23/2023
DRAWN	- MM	CHECKED	- TC	REVISED	-
PLOT SCALE	20.0000 * / in.	DATE	- 03/22/2023	REVISED	-
PLOT DATE	5/23/2023				

STATE OF ILLINOIS  
DEPARTMENT OF TRANSPORTATION

IL 38 OVER WINFIELD CREEK  
PAVEMENT TRANSITION DETAIL

SCALE: NONE SHEET 1 OF 1 SHEETS STA. - TO STA. -

F.A.P. RTE.	SECTION	COUNTY	TOTAL SHEETS	SHEET NO.
347	FAP 0347 22 BJ2	DUPAGE	39	31
CONTRACT NO. 62T16				
ILLINOIS FED. AID PROJECT				

REVISED SHEET 5/26/2023