

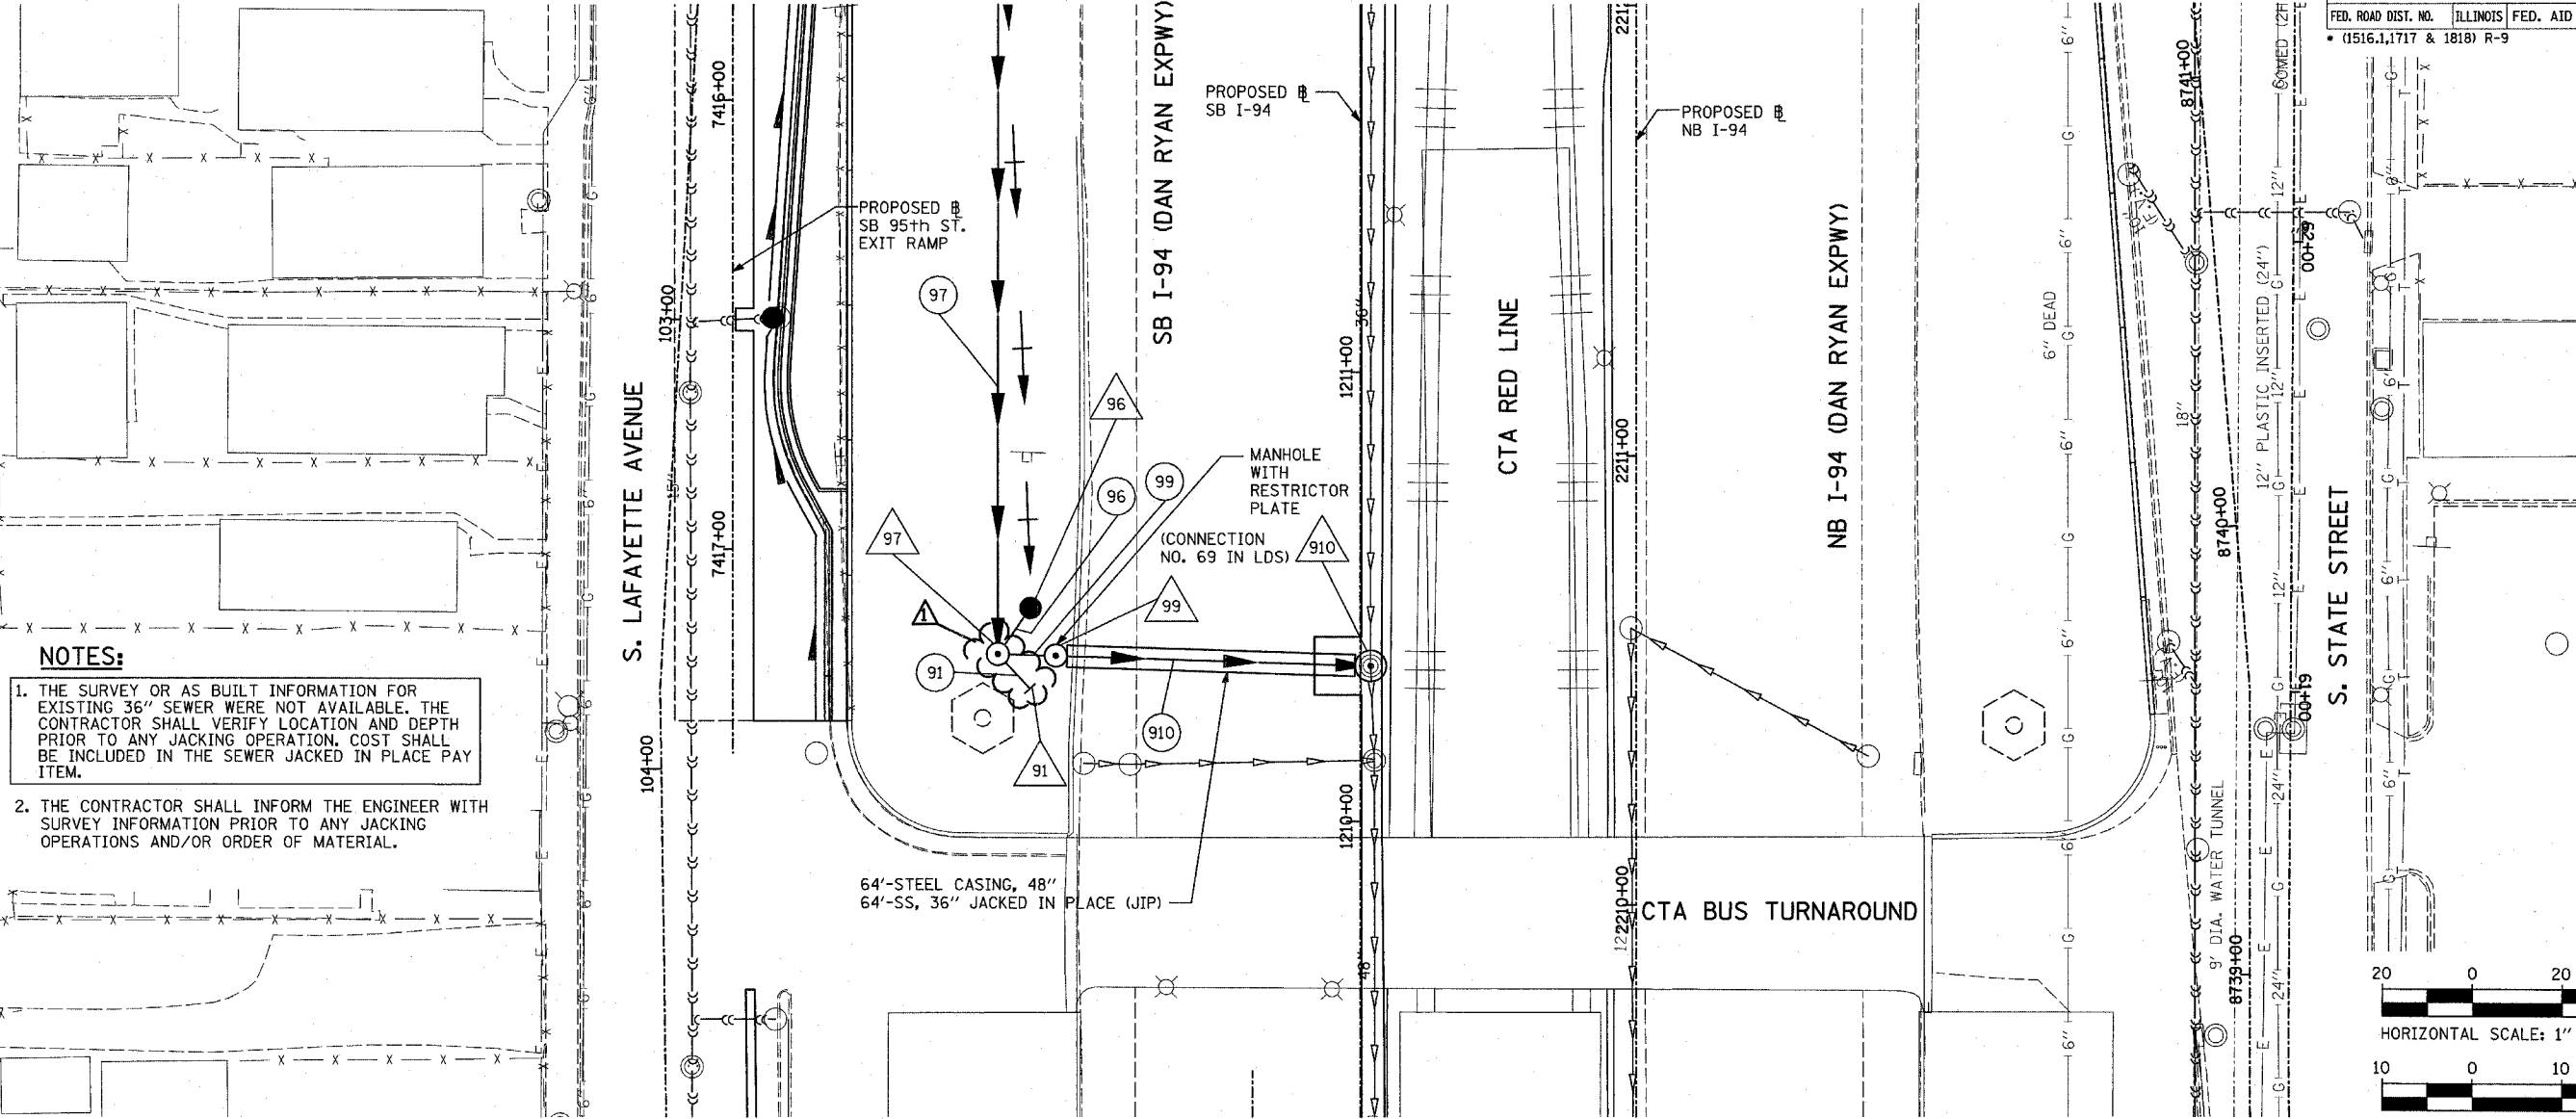


F.A.I. RTE.	SECTION	COUNTY	TOTAL SHEETS	SHEET NO.
94	*	COOK	907	213A
STA. 1200+00.00		TO STA. 1365+00		
FED. ROAD DIST. NO.	ILLINOIS	FED. AID PROJECT		
(1516.1, 1717 & 1818) R-9		62695		

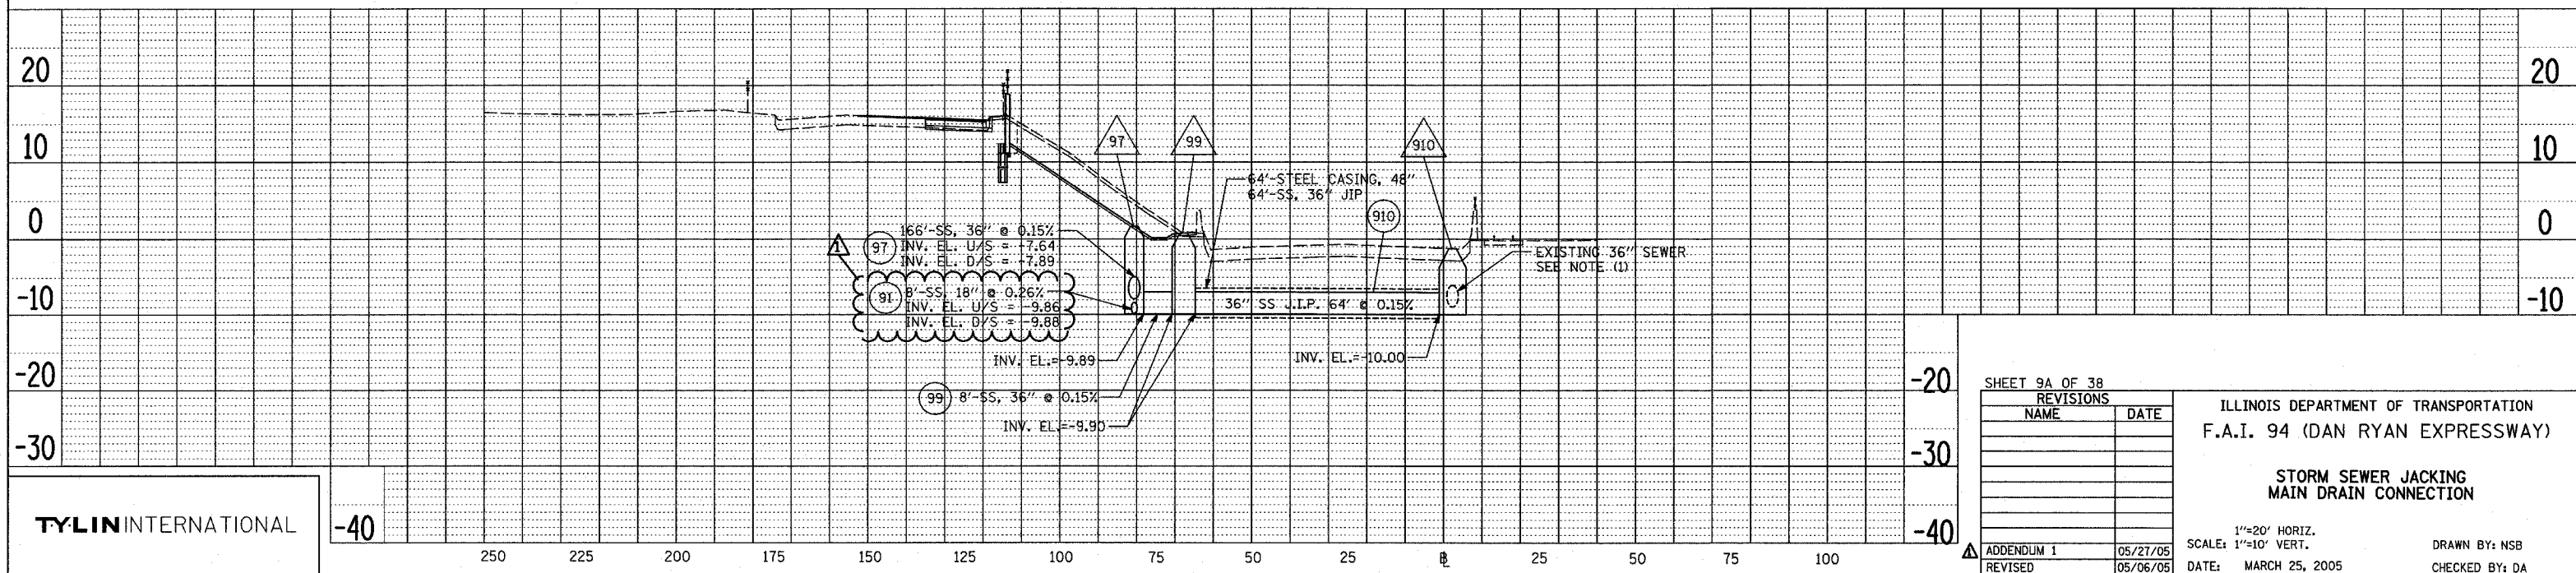

NOTES:

1. THE SURVEY OR AS BUILT INFORMATION FOR EXISTING 36" SEWER WERE NOT AVAILABLE. THE CONTRACTOR SHALL VERIFY LOCATION AND DEPTH PRIOR TO ANY JACKING OPERATION. COST SHALL BE INCLUDED IN THE SEWER JACKED IN PLACE PAY ITEM.
2. THE CONTRACTOR SHALL INFORM THE ENGINEER WITH SURVEY INFORMATION PRIOR TO ANY JACKING OPERATIONS AND/OR ORDER OF MATERIAL.

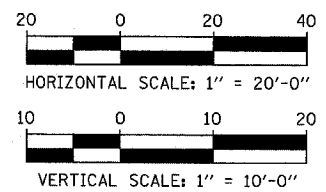

SHEET 9A OF 38

REVISIONS	
NAME	DATE

ADDENDUM 1 REVISIONS

REVISIONS	DATE

ILLINOIS DEPARTMENT OF TRANSPORTATION
 F.A.I. 94 (DAN RYAN EXPRESSWAY)

**STORM SEWER JACKING
 MAIN DRAIN CONNECTION**

SCALE: 1"=20' HORIZ.
 1"=10' VERT.

DATE: MARCH 25, 2005

DRAWN BY: NSB
 CHECKED BY: DA

PLAN	BY	DATE
REVISIONS		
CHECKED		
APPROVED		
NO. _____		

PROFILE	BY	DATE
REVISIONS		
CHECKED		
APPROVED		
NO. _____		

TYLIN INTERNATIONAL

1516.1, 1717 & 1818 R-9