| | | | T | 90% FEDERAL 10% STATE |
|----------|--|-------------|----------|--------------------------|--------------------------|--------------------------|--------------------------|--------------------------|--------------------------|
| CODE | ITEM | UNIT | TOTAL | BRIDGE 0047 | BRIDGE 0047 | BRIDGE 0047 | BRIDGE 0047 | BRIDGE 0047 | RESURF 0005 |
| NO. | 1.1 - 1.101 | J ONT I | QUANTITY | | S. N. 082-0141 | | S. N. 082-0253 | | URBAN |
| | | \triangle | | ········· | | | | | |
| Z0001905 | STRUCTURAL STEEL REPAIR | POUND | 8110 | 1820 | 5860 | 430 | | | |
| | | | 200000 | | | | | | |
| Z0010605 | CLEANING DRAINAGE SYSTEM | L SUM | 1 | | 0.43 | 0. 45 | 0.06 | 0.06 | |
| Z0012754 | STRUCTURAL REPAIR OF CONCRETE (DEPTH EQUAL TO OR LESS THAN 5 INCHES) | SQ FT | 3801 | | 3010 | | | 791 | |
| | | | | | | | | | |
| Z0012755 | STRUCTURAL REPAIR OF CONCRETE (DEPTH GREATER THAN 5 INCHES) | SQ FT | 125 | | 100 | | | 25 | |
| Z0016001 | DECK SLAB REPAIR (FULL DEPTH, TYPE I) | SQ YD | 186 | | 103 | 60 | | 23 | |
| | | | | | | | | | |
| Z0016200 | DECK SLAB REPAIR (PARTIAL) | SQ YD | 2774 | | 1601 | 849 | | 324 | |
| Z0021908 | SILICONE JOINT SEALER, 2" | FOOT | 175 | | 175 | | | | |
| Z0021912 | SILICONE JOINT SEALER, 2.5" | FOOT | 38 | | 38 | | | | |
| | | | | | | | | | |
| Z0021916 | SILICONE JOINT SEALER, 3" | FOOT | 37 | | 37 | | | | |
| Z0033700 | LONGITUDINAL JOINT SEALANT | FOOT | 1132 | | | | | | 1132 |
| | | | | | | | | | |
| Z0041895 | POLYMER CONCRETE | CU FT | 18 | | 18 | | | | |
| Z0048665 | RAILROAD PROTECTIVE LIABILITY INSURANCE | L SUM | 1 | 0. 2 | 0. 2 | 0. 2 | 0. 2 | 0. 2 | |
| | | | | | | | | | |
| Z0049790 | RELOCATING NAME PLATES | EACH | 2 | | 1 | | | 1 | |
| Z0073200 | TEMPORARY SHORING AND CRIBBING | EACH | 2 | | 2 | | | | |
| | | | | | | | | | |
| • 501 | I ECIALTY ITEM | 1 | ı | l | I | I | I | | ↑ REV 10-25- |

SPECIALTY ITEM

<u>1</u> REV. 10-25-2018

| TATATA, NA | USER NAME = Jd | DESIGNED | - | JKD | KENIZED - |
|--------------------------|-----------------------------|----------|---|-----------|-----------|
| EFK•Moen | | DRAWN | - | SJF | REVISED - |
| | PLOT SCALE = 20.000 ' / in. | CHECKED | - | SLD | REVISED - |
| Civil Engineering Design | PLOT DATE = 10/1/2018 | DATE | - | 9/28/2018 | REVISED - |

| | F.A. RII | | | | | | | F.A.I. RTE. | SECTION | COUNTY | TOTAL SHEETS | SHEET NO. | |
|---|-----------------------|-------|---|----|---|--------|------|----------------------|-----------|------------------|-----------------|--------------|-------|
| ı | SUMMARY OF QUANTITIES | | | | | | 70 | 82-3HVB-2R-(2,1)-1-2 | ST. CLAIR | 238 | 9 | | |
| ļ | | | | | | | | | | | CONTRACT | NO. | 76945 |
| ı | SCALE: N/A | SHEET | 6 | OF | 6 | SHEETS | STA. | TO STA. | | [ILLINOIS FED. A | D PROJECT | | |

CONSTRUCTION CODE

GENERAL NOTES

- 1. Dimensions and details relative to the existing structure have been taken from existing plans and are subject to nominal construction variations. It shall be the Contractor's responsibility to field verify such dimensions and details and make necessary approved adjustments prior to construction or ordering materials. Such variation shall not be cause for additional compensation for a change in the scope of work, however, the Contractor will be paid for the quantity actually furnished at the unit price bid for the work.
- All structural steel shall be AASHTO M-270 Grade 36, unless noted otherwise.
- No field welding is permitted except as specified in the contract documents.
- 4. Fasteners shall be ASTM A325, Type I, mechanically galvanized bolts. Bolts shall be $\frac{7}{6}$ in. diameter and placed in $\frac{15}{16}$ in. diameter holes unless noted otherwise.
- 5. The existing structural steel coating contains lead. The Contractor shall take appropriate precautions to deal with the presence of lead on this project.
- Existing structural steel that will be in contact with new structural steel shall be cleaned and painted prior to erection as required by the Special Provision, "Cleaning and Painting Contact Surface Areas of Existing Steel Structures".

- 7. All new structural steel shall be shop painted with inorganic zinc rich primer per AASHTO M300, Type 1. Cost included with Structural Steel Repair. All faying surfaces of bolted connections must meet the requirements for a class A surface as defined by AASHTO.
- 8. Reinforcing bars designated (E) shall be epoxy-coated.
 Damage to the epoxy coating during handling, placement,
 etc., shall be repaired according to the Special Provision
 "Field Coating Reinforcing Bars".
- All accessories including bolsters, chairs, tie wire, etc., used to tie or support the epoxy-coated bars shall be epoxy coated.
- 10. The Contractor shall make allowance for the deflection of forms, shrinkage and settlement of false work, in addition to allowance for dead load deflection.
- 11. Design and construction of form work shall be the responsibility of the Contractor and shall be performed in accordance with ACI 347 and the Standard Specification.
- 12. Joint openings shall be adjusted according to Article 520.04 of the Standard Specification when closure concrete is placed at an ambient temperature other than 50°F.


INDEX OF SHEETS

- 1. General Plan
- 2. General Data and Framing Plan
- B. Expansion Joint Removal Detail
- 4. Expansion Joint Replacement Detail
- 5. Preformed Joint Strip Seal
- 6. Bearing Stiffener Repair Details
- 7. Bearing Stiffener Repair Details
- 8. Bar Splicer Assembly and Mechanical Splicer Details

TOTAL BILL OF MATERIAL


| ITEM | UNIT | SUPER | SUB | TOTAL |
|----------------------------------|---------|-----------|------------|---------------|
| Concrete Removal | Cu. Yd. | 20.9 | 0.0 | 20.9 |
| Concrete Superstructure | Cu. Yd. | 20.9 | 0.0 | 20.9 |
| Reinforcement Bars, Epoxy Coated | Pound | 3310 | 0 | 3310 |
| Bar Splicers | Each | 84 | 0 | 84 |
| Preformed Joint Strip Seal | Foot | <u>89</u> | . <u> </u> | . <u>89</u> . |
| Structural Steel Repair | Pound | 1820 | 0 | 1820 l |
| | | | . — . — | |
| | | | | |


 Λ

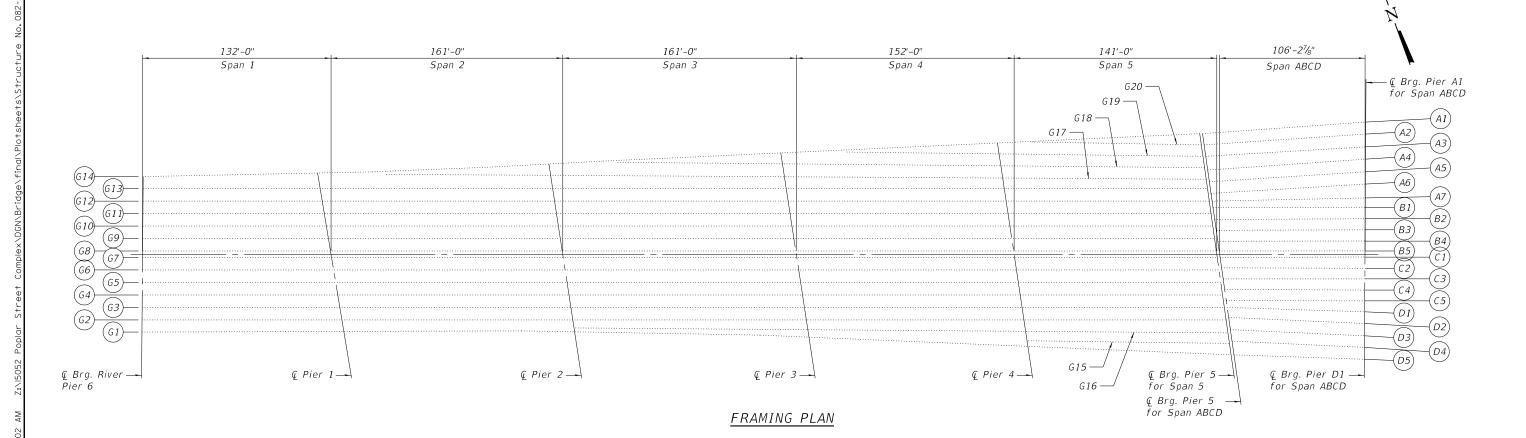


| W/IF | ENGINEERS ARCHITECTS | USE |
|--------|--|------|
| ** J.L | MATERIAL SCIENTISTS | |
| / | Wiss, Janney, Eistner Associates, Inc. | |
| | 330 Pfingsten Road Northbrook, Illinois 60062 | PLC |
| | 847 272 7400 tel 847 291 9595 fax | PI (|

| USER NAME = acb | DESIGNED | - | ARB | REVISED | - | 10/23/2018 RW |
|-----------------------------|----------|---|-----------|---------|---|---------------|
| | CHECKED | - | RW | REVISED | - | |
| PLOT SCALE = 0.1667 ' / in. | DRAWN | - | ACB | REVISED | - | |
| PLOT DATE = 10/23/2018 | DATE | - | 9/28/2018 | REVISED | - | |
| | | | | | | |

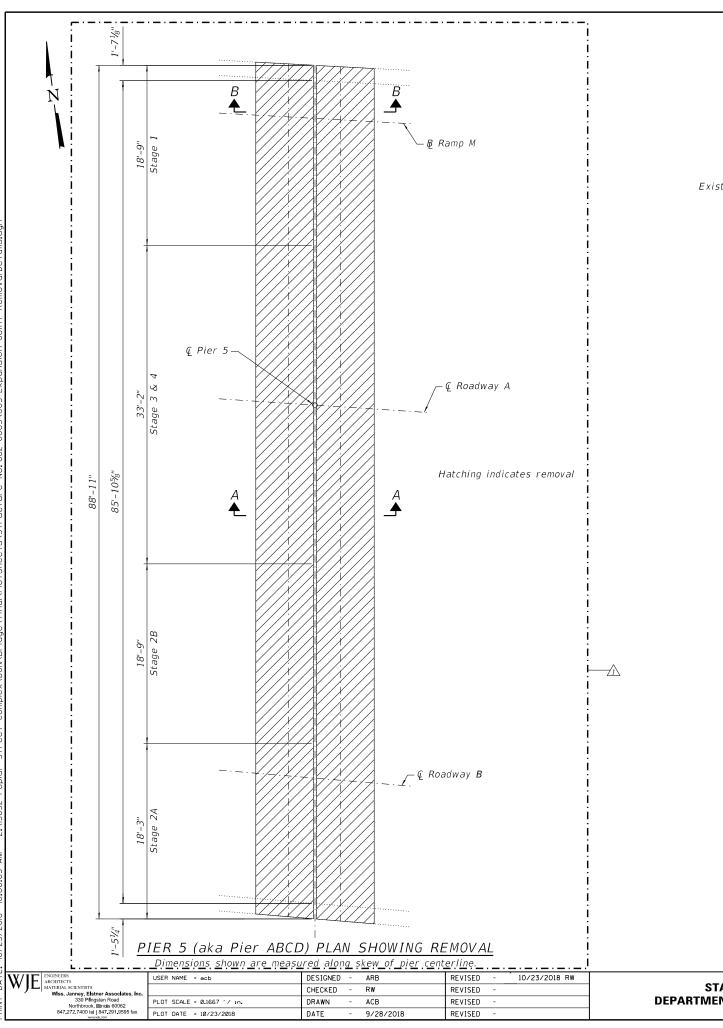

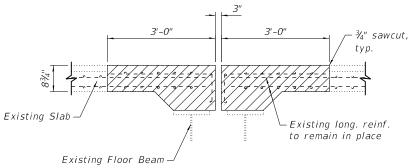

SECTION A-A

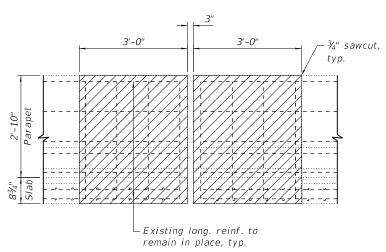

<u>VIEW B-B</u> (Showing Reinforcement)

Votes:

Saw cut perimeter of repair area as shown. Extreme caution shall be exercised while removing concrete adjacent to beams. Any damage to beams shall be repaired at the Contractor's expense.

Removal of existing expansion joint and stay-in-place metal pans shall be included in the cost of Concrete Removal.

Contractor shall take precautions during removal of southern parapet to prevent debris from entering Westbound lanes.

The Contractor shall ensure that construction activities are in compliance with the Railroad General Notes shown on Sheet 2 of the Roadway Plans.

Concrete removal calculations account for staged construction and include a quantity associated with removal of a small portion of the prior stage to facilitate the work.

BILL OF MATERIAL


| ITEM | UNIT | QUANTITY |
|------------------|---------|----------|
| Concrete Removal | Cu. Yd. | 20.9 |

/ REV. 10-25-2018


STATE OF ILLINOIS
DEPARTMENT OF TRANSPORTATION

EXPANSION JOINT REMOVAL DETAILS
S.N. 082-0005

SHEET NO. 3 OF 8 SHEETS

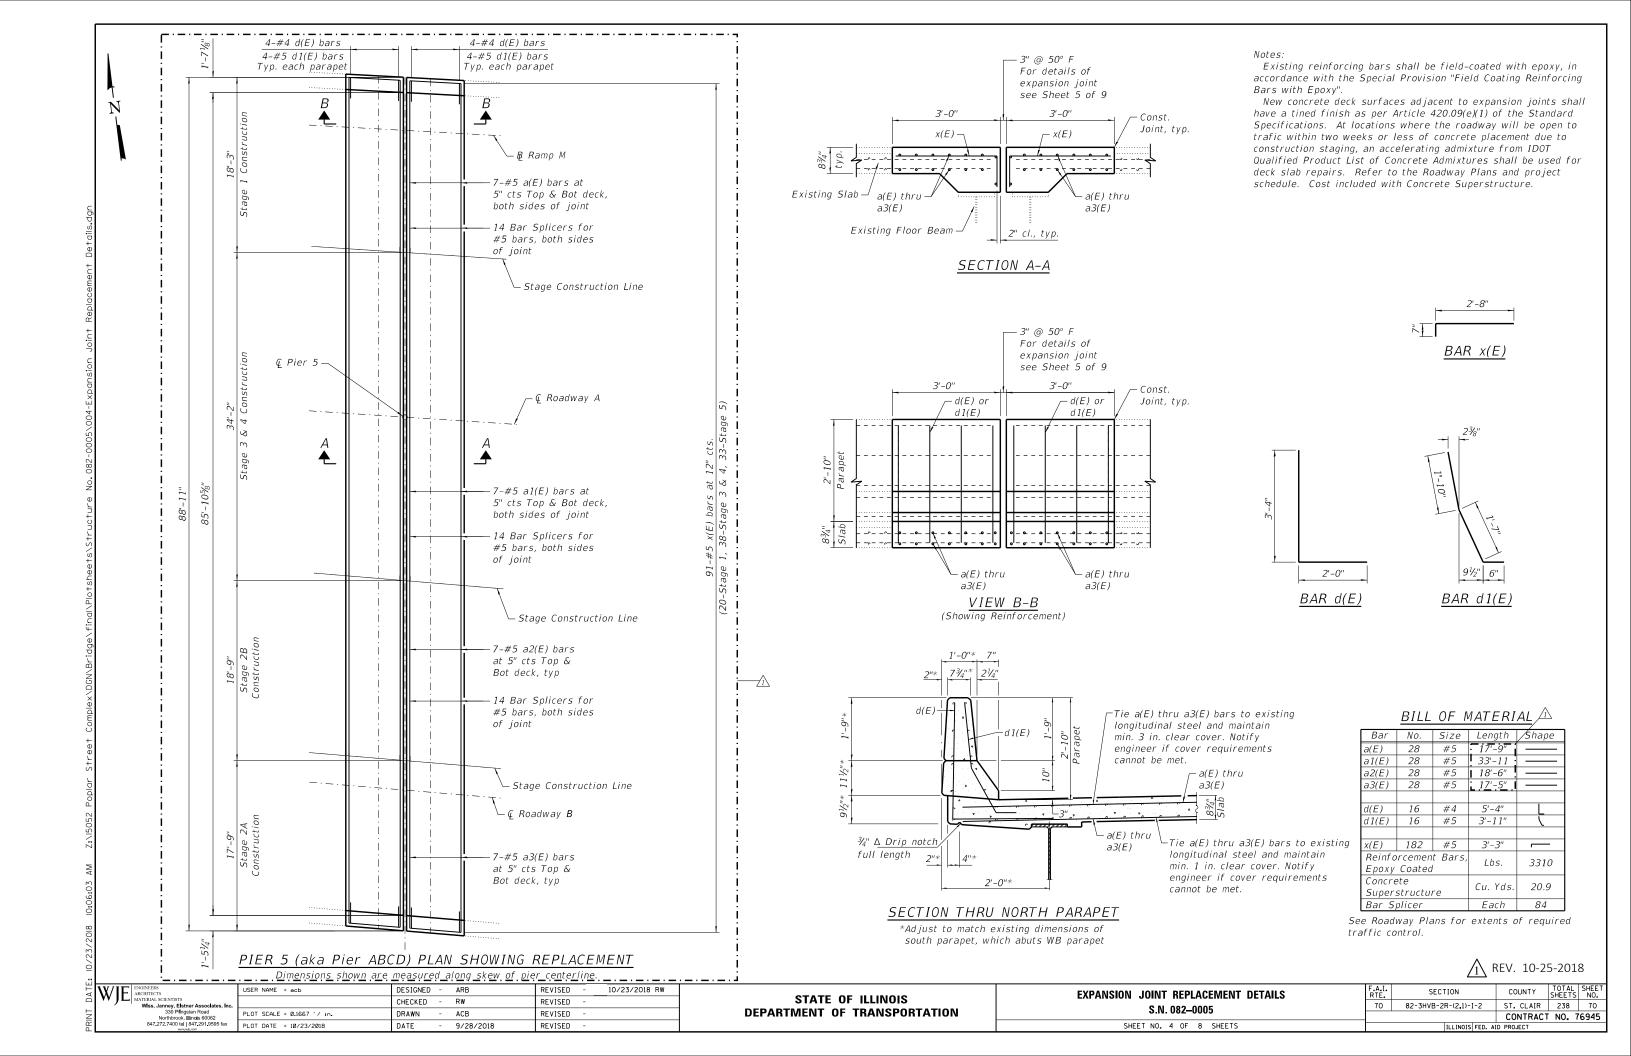


RETROFIT PLATE TABLE

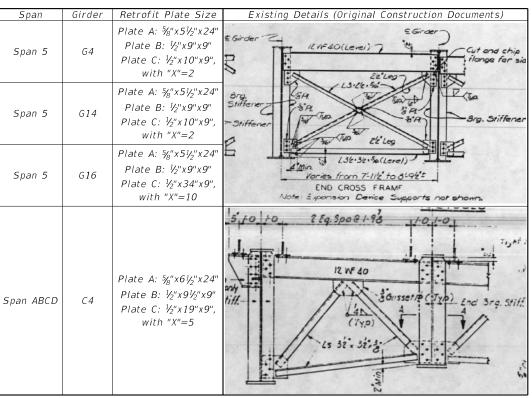

Remove existing 1/2"φ bolts from cross frame connection and match drill new retrofit plate to existing holes. Reattach cross frame connection using new $\frac{7}{8}$ ϕ bolts.

In Span 5, install one new % % bolt centered between bottom flange and lowest bolt in cross frame connection plate. This note is not applicable to Span ABCD.

Remove existing jacking stiffeners at G16 to accommodate Plate C installation. Adjust bolt spacing in Plate C to align with existing jacking stiffener holes. After Plate C has been installed, reinstall jacking stiffeners using 11 new %" diameter bolts and $\frac{1}{2}$ " fill plates.

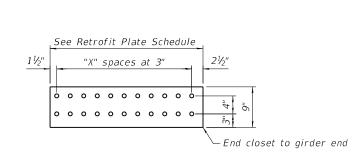

DETAILING FOR PLATE C

plate width/2

Apply approved silicone to top of all plates. Cost

is included in Structural

Grind inside corner of web

END VIEW reinforcement plates to clear weld, typ.

Steel Repair, typ.

-Existing Bearing-

After installing bolts

Note 1 and 2, install

See Note

See Note 2

required to meet

3 additional bolts, equally spaced here

Stiffener

- Plate A

- Plate B

BEARING STIFFENER REPAIR AT PIER 5 (aka PIER ABCD)

99°28'30" at C4, G4, and G16

90°00'00" at G14

Bevel Plate B to fit

prior to welding, typ.

snug with Plate A

Existing jacking —

Plate C -

99°28'30" at C4, G4, and G16


SECTION A-A

96°21'53" at G14

-Note 3

ELEVATION

stiffener

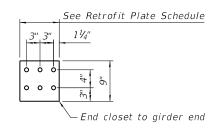

DETAILING FOR PLATE B

*Match drill holes in Plate B after beveling to fit snug with Plate A.

BILL OF MATERIAL

| Item | Unit | Total |
|-------------------------|-------|-------|
| Structural Steel Repair | Pound | 590 |
| | | |

Tighten bolts before installing fillet welds.


∕\ REV. 10-25-2018



USER NAME = acb DESIGNED -ARB REVISED 10/23/2018 RW CHECKED -RW REVISED ACB REVISED PLOT DATE = 10/24/2018 DATE REVISED 9/28/2018

STATE OF ILLINOIS DEPARTMENT OF TRANSPORTATION **BEARING STIFFENER REPAIR DETAILS** S.N. 082-0005 SHEET NO. 6 OF 8 SHEETS


SECTION 82-3HVB-2R-(2,1)-I-2 ST. CLAIR 238 72 CONTRACT NO. 76945

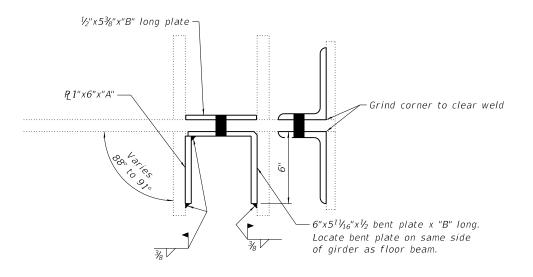

RETROFIT DIMENSIONS

| - | | | |
|---|--------|-------------|-------|
| | | | |
| | Girder | "A" | "B" |
| | A1 | 91/8" | 3'-0" |
| | A7 | 91/8" | 3'-0" |
| | B1 | 10½" | 2'-6" |
| | B5 | 10½" | 2'-6" |
| | C 1 | 10½" | 2'-6" |
| | C5 | 10½" | 2'-6" |
| | D1 | 8¾" | 3'-0" |
| | D5 | <i>8¾</i> " | 3'-0" |

SECTION A-A

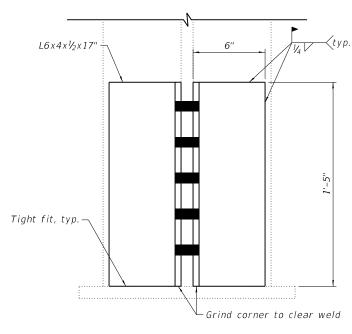

SECTION B-B

BILL OF MATERIAL

| Item | Unit | Total |
|-------------------------|-------|-------|
| Structural Steel Repair | Pound | 1230 |
| | | |

Note:

Tighten bolts before installing fillet welds.

<u>1</u> REV. 10-25-2018



| USER NAME = acb | DESIGNED | - | ARB | REVISED | - | 10/23/2018 RW |
|-----------------------------|----------|---|-----------|---------|---|---------------|
| | CHECKED | - | RW | REVISED | - | |
| PLOT SCALE = 0.1667 ' / in. | DRAWN | - | ACB | REVISED | - | |
| PLOT DATE = 10/23/2018 | DATE | - | 9/28/2018 | REVISED | - | |
| | | | | | | |

| 70 | 82-3HVB-2R-(2,1)-I-2 | ST. CLAIR CONTRACT | 238 NO 7 | 7 |
|----|----------------------|---------------------|-------------|-----|
| | ILLINOIS FED. AI | | NU. I | 694 |

- 2. All structural steel shall be AASHTO M-270 Grade 36, unless noted otherwise.
- No field welding is permitted except as specified in the contract documents.
- 4. Fasteners shall be ASTM A325, Type I, mechanically galvanized bolts. Bolts shall be 3/4 in. diameter and placed in 13/16 in. diameter holes unless noted otherwise.
- 5. The existing structural steel coating contains lead. The Contractor shall take appropriate precautions to deal with the presence of lead on this project.
- 6. Existing structural steel that will be in contact with new structural steel shall be cleaned and painted prior to erection as required by the Special Provision, "Cleaning and Painting Contact Surface Areas of Existing Steel Structures".
- 7. All new structural steel shall be shop painted with inorganic zinc rich primer per AASHTO M300, Type 1. Cost included with Structural Steel Repair or Furnishing and Erecting Structural Steel. All faying surfaces of bolted connections must meet the requirements for a class A surface as defined by AASHTO.
- 8. Reinforcing bars designated (E) shall be epoxy-coated. Damage to the epoxy coating during handling, placement, etc., shall be repaired according to the Special Provision "Field Coating Reinforcing Bars".
- 9. All accessories including bolsters, chairs, tie wire, etc., used to tie or support the epoxy-coated bars shall be epoxy coated.
- 10. The Contractor shall make allowance for the deflection of forms, shrinkage and settlement of false work, in addition to allowance for dead load deflection.
- 11. Design and construction of form work shall be the responsibility of the Contractor and shall be performed in accordance with ACI 347 and the Standard Specification.
- 12. Joint openings shall be adjusted according to Article 520.04 of the Standard Specification when closure concrete is placed at an ambient temperature other than 50°F.
- 13. All post tensioning will conform to ASTM A416 Grade 270.

CONCRETE REPAIR NOTES

- 1. Concrete deck and substructure repair areas as shown in the drawings for SN 082-0141 are estimated based on inspection data from February, 2016 with deck repair areas updated in March, 2018.
- It is expected that actual repair areas may be different in shape, size, and location than shown on the drawings. The exact locations shall be determined by the Engineer. The Engineer shall show actual repair areas and their dimensions on as-built plans.
- 3. For full depth deck repairs at joints, saw cut perimeter of repair area and remove concrete on each side of joint, as required for each joint location. Extreme caution shall be exercised while removing concrete adjacent to beams. Any damage to beams shall be repaired at the Contractor's expense. Removal of existing expansion joint and stay-in-place metal pans shall be included in the cost of Concrete Removal.
- . The Contractor shall ensure the construction activities are in compliance with the Railroad General Notes shown on Sheet 2 of the Roadway Plans. In particular, all work at or near Pier A21 shall strictly comply with the Union Pacific Railroad General Notes listed on Sheet 3, including compliance with the approved rubble management plan, as prepared and submitted by the Contractor, for any full depth deck cuts and/or concrete removal that is within 25 feet (horizontal) from the track centerline. No removal or cuts can proceed until the rubble plan has been approved by Union Pacific Railroad.
- 5. Existing reinforcing bars shall be field-coated with epoxy, in accordance with the Special Provision "Field Coating Reinforcing Bars with Epoxy".
- New concrete deck surfaces adjacent to expansion joints and at horizontal surface patches shall have a tined finish as per Article 420.09(e)(1) of the Standard Specifications. Cost included with Deck Slab Repair or Concrete Superstructure.
- At locations where the roadway will be open to traffic within two weeks or less of concrete placement due to construction staging, an accelerating admixture from the IDOT Qualified Product List of Concrete Admixtures shall be used for concrete superstructure and deck slab repairs. Refer to the Roadway Plans and project schedule.
- . A quantity of 100 square feet of Structural Repair of Concrete (depth greater than 5 inches) is included in the total bill of materials to account for some repair areas shown on the plans extending deeper than 5 inches. This quantity applies to vertical repairs to substructure elements.
- O. A quantity of 103 square yards of Deck Slab Repair (Full Depth Type I) is included in the total bill of materials to account for some repair areas shown on the plans extending through the full deck depth. Actual depth of repairs to be verified by the Engineer.
- 10. Use of shotcrete is not permitted.

INDEX OF SHEETS

| 1 | General | Plan | |
|---|---------|------|--|
| 2 | Canaral | Data | |

| _ | uener ar | Data | | | | | | |
|---|----------|------|-----|-----------|--------|----|--------|------|
| 3 | General | Plan | and | Elevation | (Spans | Α1 | thru A | 47) |
| 4 | General | Plan | and | Elevation | (Spans | A8 | thru A | 414) |

General Plan and Elevation (Spans A15 thru A20)
 General Plan and Elevation (Spans A21 thru A24)
 General Plan and Elevation (Spans A25 thru A28)

8 General Plan and Elevation (Spans A29 thru A34)
9 General Plan and Elevation (Spans A35 thru A40)

10 General Plan and Elevation (Spans A41 thru A45) 11 Deck Patching Repairs (Spans A1 thru A4)

12 Deck Patching Repairs (Spans A5 thru A9)

13 Deck Patching Repairs (Spans A10 thru A13) 14 Deck Patching Repairs (Spans A14 thru A17)

Deck Patching Repairs (Spans A118 thru A21)
 Deck Patching Repairs (Spans A22 thru A25)

17 Deck Patching Repairs (Spans A26 & A27) 18 Deck Patching Repairs (Spans A28 thru A31) 19 Deck Patching Repairs (Spans A32 thru A35)

20 Deck Patching Repairs (Spans A36 thru A39) 21 Deck Patching Repairs (Spans A40 thru A43)

22 Deck Patching Repairs (Spans A44 & A45) 23 Expansion Joint Removal Details

24 Expansion Joint Removal Details

25 Expansion Joint Replacement Details (Pier A1) 26 Expansion Joint Replacement Details (Pier A1) 27 Expansion Joint Replacement Details (Pier A5)

Expansion Joint Replacement Details (Pier A5)
Expansion Joint Replacement Details (Pier A8)
Expansion Joint Replacement Details (Pier A11)

31 Expansion Joint Replacement Details (Pier Al2) 32 Expansion Joint Replacement Details (Pier Al5)

Expansion Joint Replacement Details (Pier A18)
 Expansion Joint Replacement Details (Pier A21)
 Expansion Joint Replacement Details (Pier A25)

36 Expansion Joint Replacement Details (Pier A35) 37 Expansion Joint Replacement Details (Pier A35)

38 Preformed Joint Strip Seal

39 Finger Plate Replacement Details (Pier A1)

40 Finger Plate Replacement Details (Pier A1) 41 Finger Plate Replacement Details (Pier A1)

41 Finger Plate Replacement Details (Pier AI) 42 Finger Plate Replacement Details (Pier AI)

43 Finger Plate Replacement Details (Pier A25) 44 Finger Plate Replacement Details (Pier A25)

Finger Plate Replacement Details (Pier A25)
Silicone Joint Seal Replacement Details

47 Special Drainage Details

48 Girder Flange Repair

49 Floor Beam Repair

50 Bearing Stiffener Repair

51 Bearing Stiffener Repair

52 Bearing Details 53 Bearing Details

53 Bearing Det 54 Pier A1

55 Pier A5

66 Pier A8

57 Pier All

58 Pier A12

59 Pier A15 60 Pier A18

61 Pier A21

62 Pier A24 63 Pier A25

64 Pier A29

65 Pier A30 66 Pier A34

7 Pier A35

68 Pier A36 69 Pier A38

70 Pier A41

71 Pier A43

72 Pier A44 73 Pier A45

4 Slopewall Removal Details

75 Concrete Repair Details

76 Cable Tensioned Strands and Crack Arrest Hole Details

77 Shim Stack Retainer Details

78 Bar Splicer Assembly and Mechanical Splicer Details

TOTAL BILL OF MATERIAL

| | <i>''</i> | - / · | | |
|--|-----------|------------------|-----------|--------|
| ITEM | UNIT | SUPER | SUB | TOTAL |
| Stone Riprap, Class A3 | Sq. Yd. | 0 | 474 | 474 |
| Concrete Removal | Cu. Yd. | 124.0 | 7.0 | 131.0 |
| Slope Wall Removal | Sq. Yd. | 0 | 474 | 474 |
| Protective Shield | Sq. Yd. | 815 | 0 | 815 |
| Concrete Superstructure | Cu. Yd. | 123.3 | 0 | 123.3 |
| Reinforcement Bars, Epoxy Coated | Pound | 20,000 | 0 | 20,000 |
| Bar Splicers | Each | 44 | 0 | 44 |
| Preformed Joint Strip Seal | Foot | 374 | 0 | 374 |
| Finger Plate Expansion Joint, 3" | Foot | 53 | 0 | 53 |
| Finger Plate Expansion Joint, 4" | Foot | 33 | 0 | 33 |
| Fabric Reinforced Elastomeric Trough | Foot | 226 | 0 | 226 |
| Elastomeric Bearing Assembly, Type I | Each | 0 | 3 | 3 |
| Epoxy Crack Injection | Foot | 0 | 146 | 146 |
| Anchor Bolts, 1" | Each | 4 | 0 | 4 |
| Bolt Replacement | Each | 5 | 0 | 5 |
| Galvanic Anode | Each | 0 | 2992 | 2992 |
| Fiber Wrap | Sq. Ft. | 0 | 120 | 120 |
| Column Tensioned Strands | Each | 0 | 75 | 75 |
| Jack and Remove Existing Bearings | Each | 0 | | 3 |
| Structural Steel Repair | Pound | I 5860 | 0 | 5860 |
| Structural Repair of Concrete | Sg. Ft. | 0 | 3010 | 3010 |
| (depth equal to or less than 5 inches) | 34. Ft. | 0 | 3010 | 3010 |
| Structural Repair of Concrete | Sq. Ft. | 0 | 100 | 100 |
| (depth greater than 5 inches) | , | 0 | 100 | 100 |
| Deck Slab Repair (Full Depth, Type I) | Sq. Yd. | 103 | 0 | 103 |
| Deck Slab Repair (Partial) | Sq. Yd. | 1601 | 0 | 1601 |
| Silicone Joint Sealer, 2" | Foot | 175 | 0 | 175 |
| Silicone Joint Sealer, 2.5" | Foot | 38 | 0 | 38 |
| Silicone Joint Sealer, 3" | Foot | 37 | 0 | 37 |
| Polymer Concrete | Cu. Ft. | 18 | 0 | 18 |
| Relocating Name Plates | Each | 1 | 0 | 1 |
| Crack Arrest Holes | Each | 4 | 0 | 4 |
| Temporary Shoring and Cribbing | Each | 0 | 2 | 2 |
| | | | | |
| See Sheet 79 of 90 for the Total Bill of | Material | for all w | iork rela | tina |

See Sheet 79 of 90 for the Total Bill of Material for all work relating to sign trusses.

INDEX OF SHEETS (Continued)

- 79 Overhead Sign Structures General Plan & Elevation Aluminum Truss & Steel Supports
- O Overhead Sign Structures Aluminum Truss Details for Truss Types I-A, II-A and III-A
- 81 Overhead Sign Structures Aluminum Truss Details for Truss Types I-A, II-A and III-A

? Overhead Sign Structure Damping Device

3 Overhead Sign Structures Support Frame for Type I-A Aluminum Truss

84 Overhead Sign Structures Support Frame Details - Aluminum Truss 85 Overhead Sign Structures Aluminum Walkway Details

86 Overhead Sign Structures Aluminum Walkway Details

87 Overhead Sign Structures Aluminum Handrail Details

38 Overhead Sign Structures Slab Removal/Replacement Details

89 Special Sign Details


90 Location of Signs on Overhead Truss

<u>N</u> REV. 10-25-2018

ST. CLAIR 238 76


CONTRACT NO. 76945

COUNTY

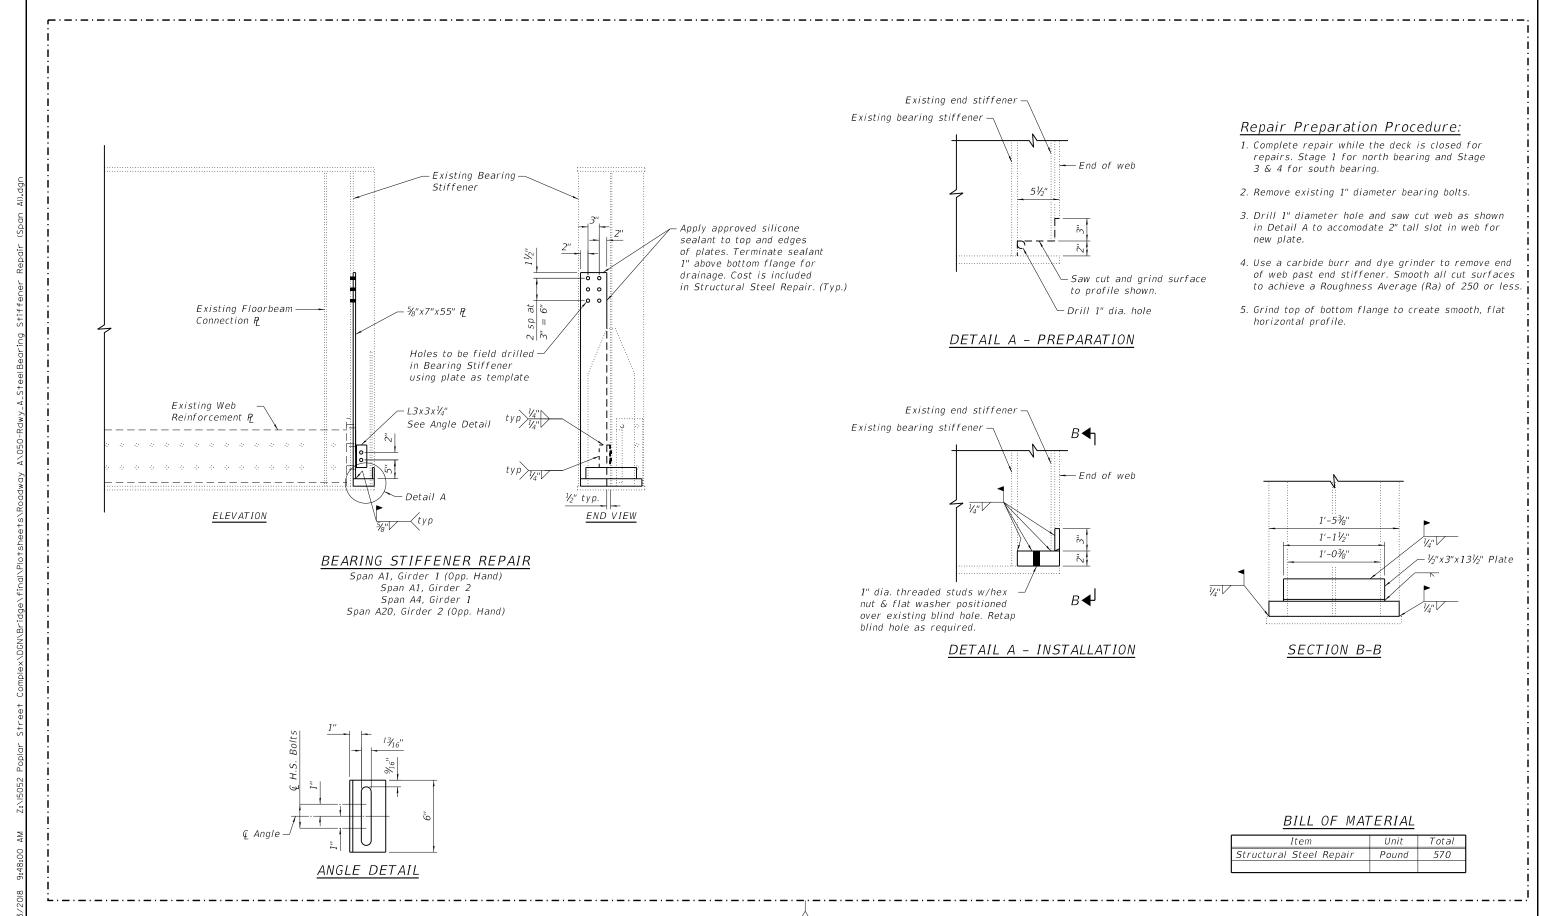


/\ REV. 10-25-2018


USER NAME = acb DESIGNED - ARB REVISED 10/23/2018 RW **BEARING STIFFENER REPAIR** STATE OF ILLINOIS CHECKED - RW REVISED S.N. 082-0141 **DEPARTMENT OF TRANSPORTATION** DRAWN ACB REVISED CONTRACT NO. 76945 PLOT DATE = 10/23/2018 DATE REVISED SHEET NO. 50 OF 90 SHEETS 09/28/2018

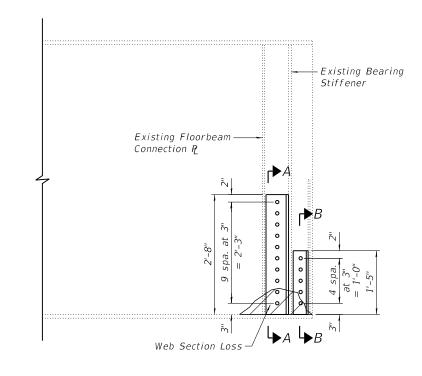

BEARING STIFFENER REPAIR

Span A37, Girder 1 Span A37, Girder 2 Span A41, Girder 1

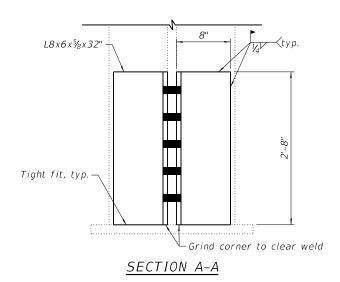

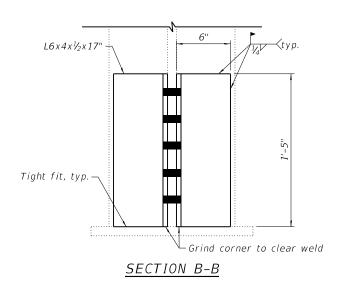

BILL OF MATERIAL

| Item | Unit | Total |
|-------------------------|-------|-------|
| Structural Steel Repair | Pound | 640 |
| | | |

Notes:

If the elastomeric trough at Pier A38 is removed to facilitate installation of the bearing stiffener repairs at this location, it shall be replaced in the manner shown on Sheet 47 of 90 upon completion of the bearing stiffener repairs.

REV. 10-25-2018

| VIF ENGINEERS ARCHITECTS | USE |
|--|------|
| V L MATERIAL SCIENTISTS | |
| Wiss, Janney, Eistner Associates, Inc. | |
| 330 Pfingsten Road | PI N |
| Northbrook, Illinois 60062 | 1.20 |
| 847,272,7400 tel 847,291,9595 fax | PLO |

| USER NAME = acb | DESIGNED | - | ARB | REVISED | - | 10/23/2018 RW |
|-----------------------------|----------|---|------------|---------|---|---------------|
| | CHECKED | - | RW | REVISED | - | |
| PLOT SCALE = 0.1667 ' / in. | DRAWN | - | ACB | REVISED | - | |
| PLOT DATE = 10/23/2018 | DATE | - | 09/28/2018 | REVISED | - | |
| | | | | | | |

- 3. Actual repair areas may be different in shape, size, and location than shown on the drawings. The exact locations shall be determined by the Engineer. The Engineer shall show actual repair areas and their dimensions on as-built plans.
- 4. Only partial depth repairs are anticipated. However, nominal full depth repair quantities have been included for use in the event that removal operations extend to the bottom mat of reinforcement.
- 5. A quantity of 60 square yards of Deck Slab Repair (Full Depth Type I) is included in the total bill of materials to account for some repair areas shown on the plans extending through the full deck depth. Actual depth of repairs to be verified by the Engineer.
- 6. At locations where the roadway will be open to traffic within two weeks or less of the concrete placement due to construction staging, an accelerating admixture from the IDOT Qualified Product List of Concrete Admixtures shall be used for concrete superstructure and deck slab repairs. Refer to the Roadway Plans and project schedule.
- 7. Existing reinforcing bars shall be field-coated with epoxy, in accordance with the Special Provision "Field Coating Reinforcing Bars".
- 8. Reinforcing bars designated (E) shall be epoxy-coated. Damage to the epoxy coating during handling, placement, etc., shall be repaired according to the Special Provision "Field Coating Reinforcing Bars".
- 9. All accessories including bolsters, chairs, tie wire, etc., used to tie or support the epoxy-coated bars shall be epoxy coated.
- 10. New concrete deck surfaces shall have a tined finish as per Article 420.09(e)(1) of the Standard Specifications. Cost included with Deck Slab Repair.
- 11. All structural steel shall be AASHTO M-270 Grade 36, unless noted otherwise.
- 12. No field welding is permitted except as specified in the contract documents.
- 13. Fasteners shall be ASTM A325, Type I, mechanically galvanized bolts. Bolts shall be 3/4 in. diameter and placed in 13/16 in. diameter holes unless noted otherwise.
- 14. The existing structural steel coating contains lead. The Contractor shall take appropriate precautions to deal with the presence of lead on this project.
- 15. Existing structural steel that will be in contact with new structural steel shall be cleaned and painted prior to erection as required by the Special Provision, "Cleaning and Painting Contact Surface Areas of Existing Steel Structures".
- 16. All new structural steel shall be shop painted with inorganic zinc rich primer per AASHTO M300, Type 1. Cost included with Structural Steel Repair.

INDEX OF SHEETS


- 1 General Plan
- General Data
- General Plan and Elevation (Spans D1 thru D9) General Plan and Elevation (Spans D10 thru D17)
- 5 Conoral Plan and Elevation (Spans D10 thru D17
- 5 General Plan and Elevation (Spans D18 thru D25)
- General Plan and Elevation (Spans D26 thru D32)
 General Plan and Elevation (Spans D33 thru D39)
- General Plan and Elevation (Spans D40 thru D45)
- 9 Deck Patching Repairs (Spans D1 thru D4)
- 10 Deck Patching Repairs (Spans D5 thru D9)
- 11 Deck Patching Repairs (Spans D10 thru D13)
- 12 Deck Patching Repairs (Spans D14 thru D17)
- 13 Deck Patching Repairs (Spans D18 thru D21)
- 14 Deck Patching Repairs (Spans D22 thru D25)
- 15 Deck Patching Repairs (Spans D26 & D27)
- Deck Patching Repairs (Spans D28 thru D31)
 Deck Patching Repairs (Spans D32 thru D35)
- 8 Deck Patching Repairs (Spans D36 thru D39)
- 19 Deck Patching Repairs (Spans D40 thru D43)
- 20 Deck Patching Repairs (Spans D44 & D45)
- 21 Bearing Stiffener Repair22 Concrete Repair Details
- 23 Cable Protection Details

TOTAL BILL OF MATERIAL

| ITEM | UNIT | SUPER | SUB | TOTAL |
|---------------------------------------|---------|-----------------|-------|---------------|
| Structural Steel Repair | Pound | 430 | 0 | 430 |
| Deck Slab Repair (Full Depth, Type I) | Sq. Yd. | <u>- 60 · -</u> | ·-o-· | <u> 60 – </u> |
| Deck Slab Repair (Partial) | Sq. Yd. | 849 | 0 | 849 |
| Cable Protection | Each | 2 | 0 | 2 |
| | | | | |
| | | | | |

<u>∕</u>1 REV. 10-25-2018

| USER NAME = acb | DESIGNED | - | ARB/SMG | REVISED | - | 10/23/2018 RW |
|----------------------------|----------|---|------------|---------|---|---------------|
| | CHECKED | - | RW | REVISED | - | |
| PLOT SCALE = 0.1667 '/ in. | DRAWN | - | ACB | REVISED | - | |
| PLOT DATE = 10/23/2018 | DATE | - | 09/28/2018 | REVISED | - | |

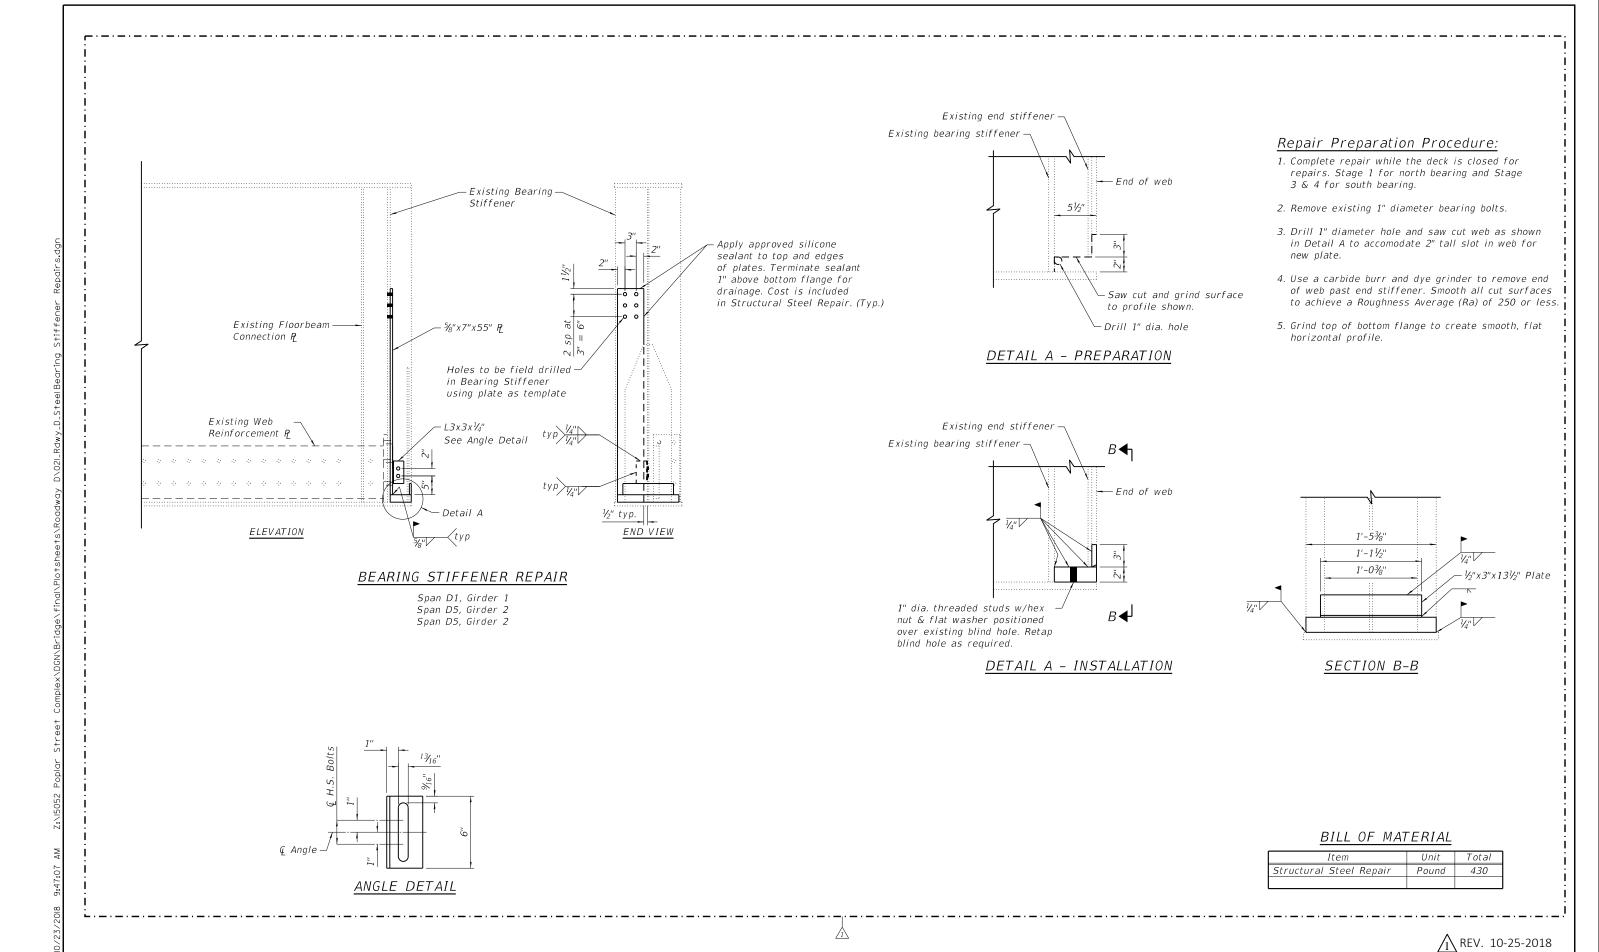

USER NAME = acb DESIGNED - ARB/SMG REVISED 10/23/2018 RW **BEARING STIFFENER REPAIR** STATE OF ILLINOIS CHECKED -RW REVISED S.N. 082-0144 **DEPARTMENT OF TRANSPORTATION** DRAWN ACB REVISED CONTRACT NO. 76945 PLOT DATE = 10/23/2018 DATE 09/28/2018 REVISED SHEET NO. 21 OF 23 SHEETS