F.A.P. RTE.	SECTION	COUNTY	TOTAL SHEETS	SHEET NO.
64	3308-2	DU PAGE	16	209
STA.		TO STA.		
FED. ROAD DIST. NO.		ILLINOIS	FED. AID PROJECT	

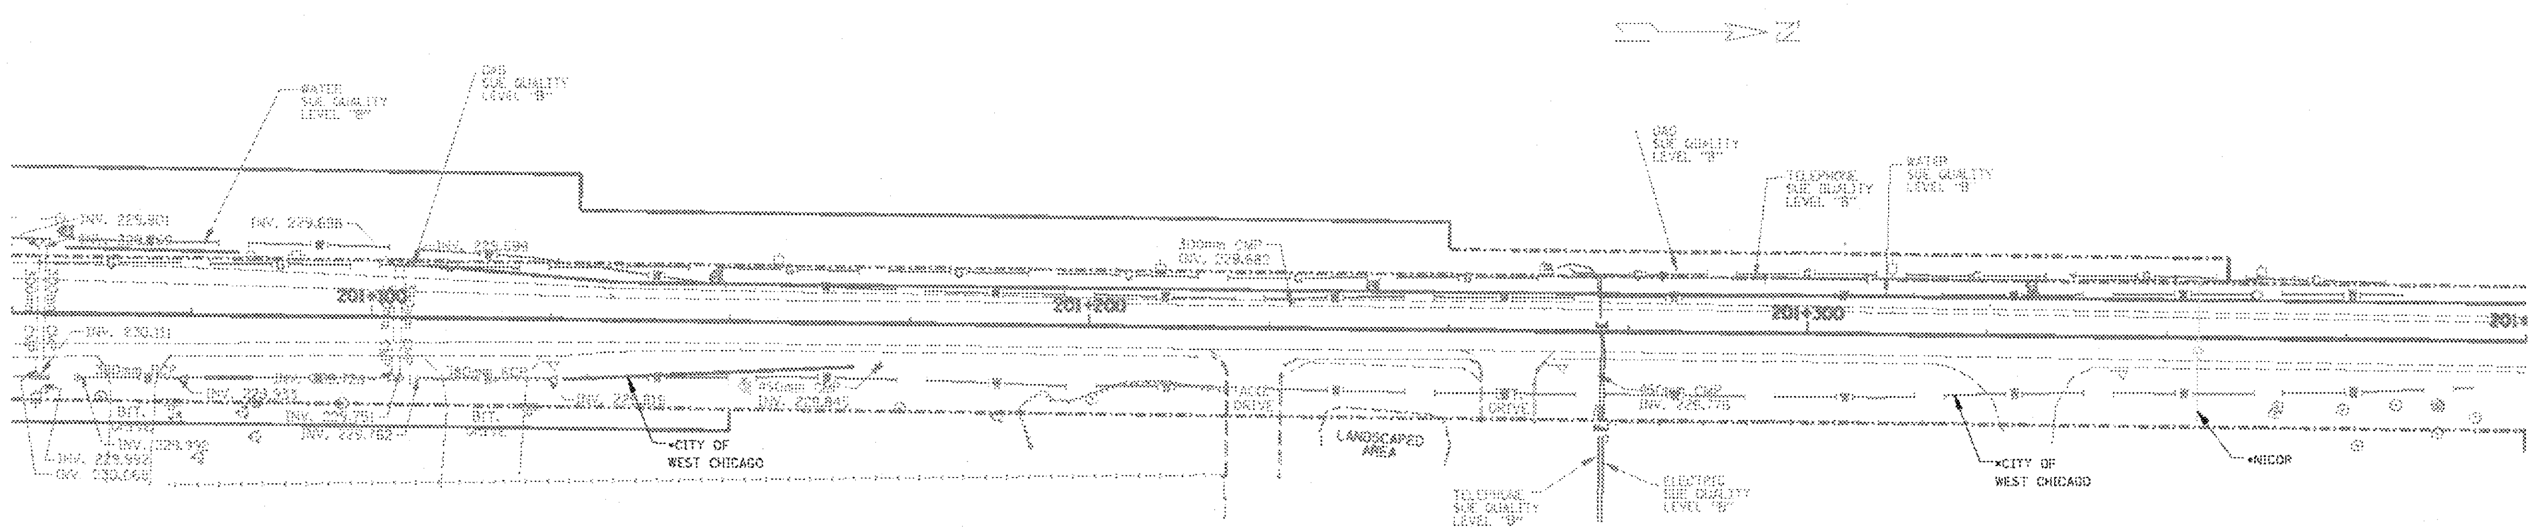

——A——A——	OVERHEAD
——T——T——	TELEPHONE
——W—— ——W	WATER
——G—— ——G	GAS
——CTV——CTV——CTV	CABLE TELEVISION
——FO——FO——FO	FIBER OPTIC
——E——E——	ELECTRIC

CARDNO TBE AND IDOT REQUESTED UTILITY AS-BUILTS FROM THE CITY OF WEST CHICAGO BUT HAVE NOT RECEIVED THEM AS OF 11/05/10.

TBE GROUP, INC.
CIVIL ENGINEERING * TRANSPORTATION * ENVIRONMENTAL * PLANNING * UTILITY ENGINEERING/LOCATING
SOUTHERN REGION: FL,GA,SC,NC
NORTHERN REGION: IL,IN,MI,OH,MD,NJ,NY PA,VA,CANADA
WESTERN REGION: AZ,NV,NM,TX,CA,OR,UT,WA

WO : IL09500128 & IL09500135 & IL09510410
SUE Quality Level "A" : Test Holes
SUE Quality Level "B" : Designating

205 W. WACKER DRIVE
SUITE 1020
CHICAGO, IL 60606
(312) 704-1970

Utilities shown on these plans as depicted in the legend have been investigated by TBE Group, Inc in accordance with SUE Industry Standards. All other information shown has been provided to TBE Group, Inc by others. Additional utilities labeled with utility owner investigated by TBE 8/18/10 - 11/05/10 depicted by *.

REVISIONS	
NAME	DATE
NEW UTILITIES IN COLOR	11/05/10

ILLINOIS DEPARTMENT OF TRANSPORTATION

IL RTE 64 (NORTH AVE.)
WEST OF IL RT 59 TO KAUTZ RD.

SCALE : 1:500 — DRAWN BY - JAC
DATE - SQL "B" 7/5/02 — CHECKED BY - RLC