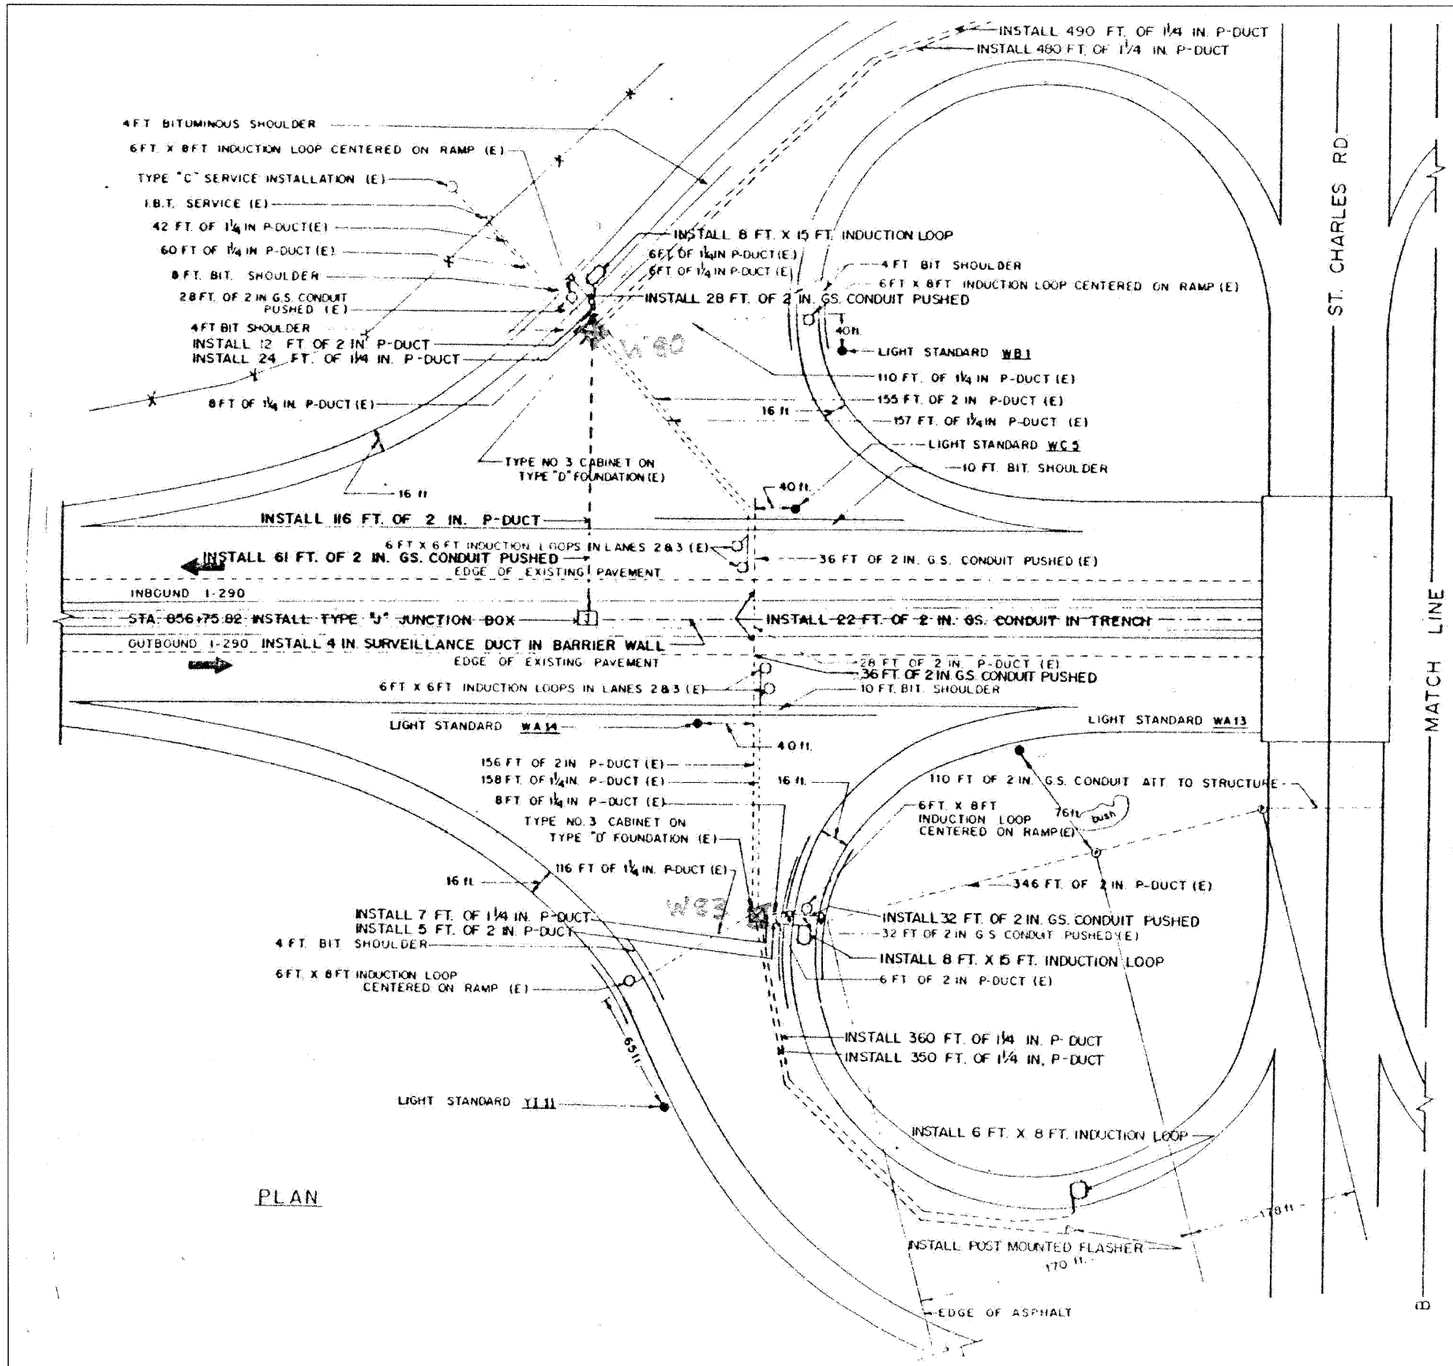

PLAN

SUMMARY OF QUANTITIES (THIS SHEET)		
DESCRIPTION	UNIT	QUANTITY
ELECTRIC CABLE IN CONDUIT, LEAD-IN, NO. 18 4/C, TWISTED, SHIELDED	LF	682
INDUCTION LOOP	LF	170

NOTE:

IDOT RECORD PLANS PROVIDED FOR INFORMATIONAL PURPOSES ONLY. THE CONTRACTOR IS RESPONSIBLE FOR VERIFYING THE LOCATION AND EXTENT OF WORK ASSOCIATED WITH REPLACEMENT OF INDUCTION LOOPS, LEAD-IN CABLE AND RELATED WORK. LOOP AND LEAD-IN CABLE QUANTITIES BASED ON INTERCHANGE RAMP RESURFACING. EXISTING MAINLINE SURVEILLANCE LOOPS TO REMAIN UNLESS IMPACTED BY PATCHING OPERATIONS.

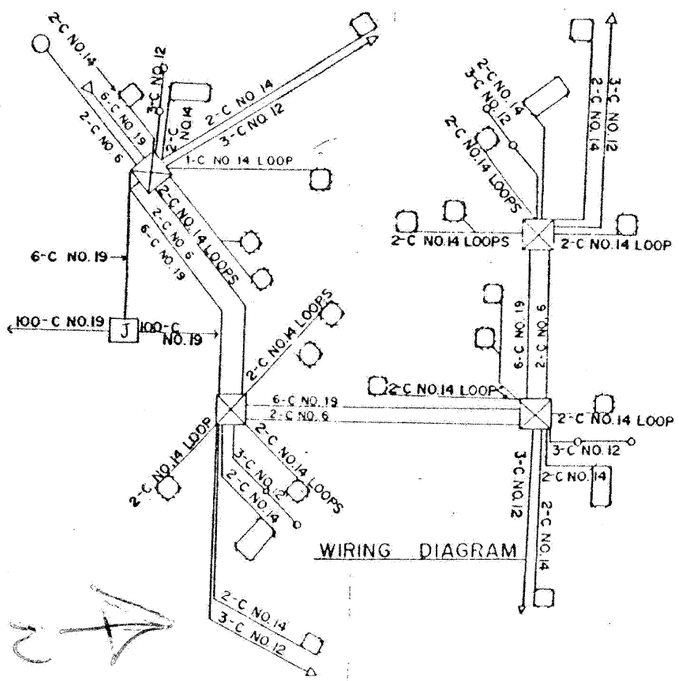

WIRING DIAGRAM

FILE NAME =	DESIGNED - GHT	REVISED -	benesch	STATE OF ILLINOIS DEPARTMENT OF TRANSPORTATION	TRAFFIC SURVEILLANCE LOOP ST CHARLES RD INSTALLATION (1 OF 2)	F.A.I. RTE.	SECTION	COUNTY	TOTAL SHEETS	SHEET NO.
...\Signals\prpln_ABC_C4_ts_24.dgn	DRAWN - TMB	REVISED -				290	2009-099BR	COOK/DUPAGE	309	271
USER NAME = jmajewski	CHECKED - MPM	REVISED -						CONTRACT NO. 60157		
PLOT DATE = 1/13/2009	DATE - 10/16/09	REVISED -			SCALE: N.T.S. SHEET NO. 2 OF 10 SHEETS STA. TO STA.	FED. ROAD DIST. NO.	ILLINOIS	FED. AID PROJECT		