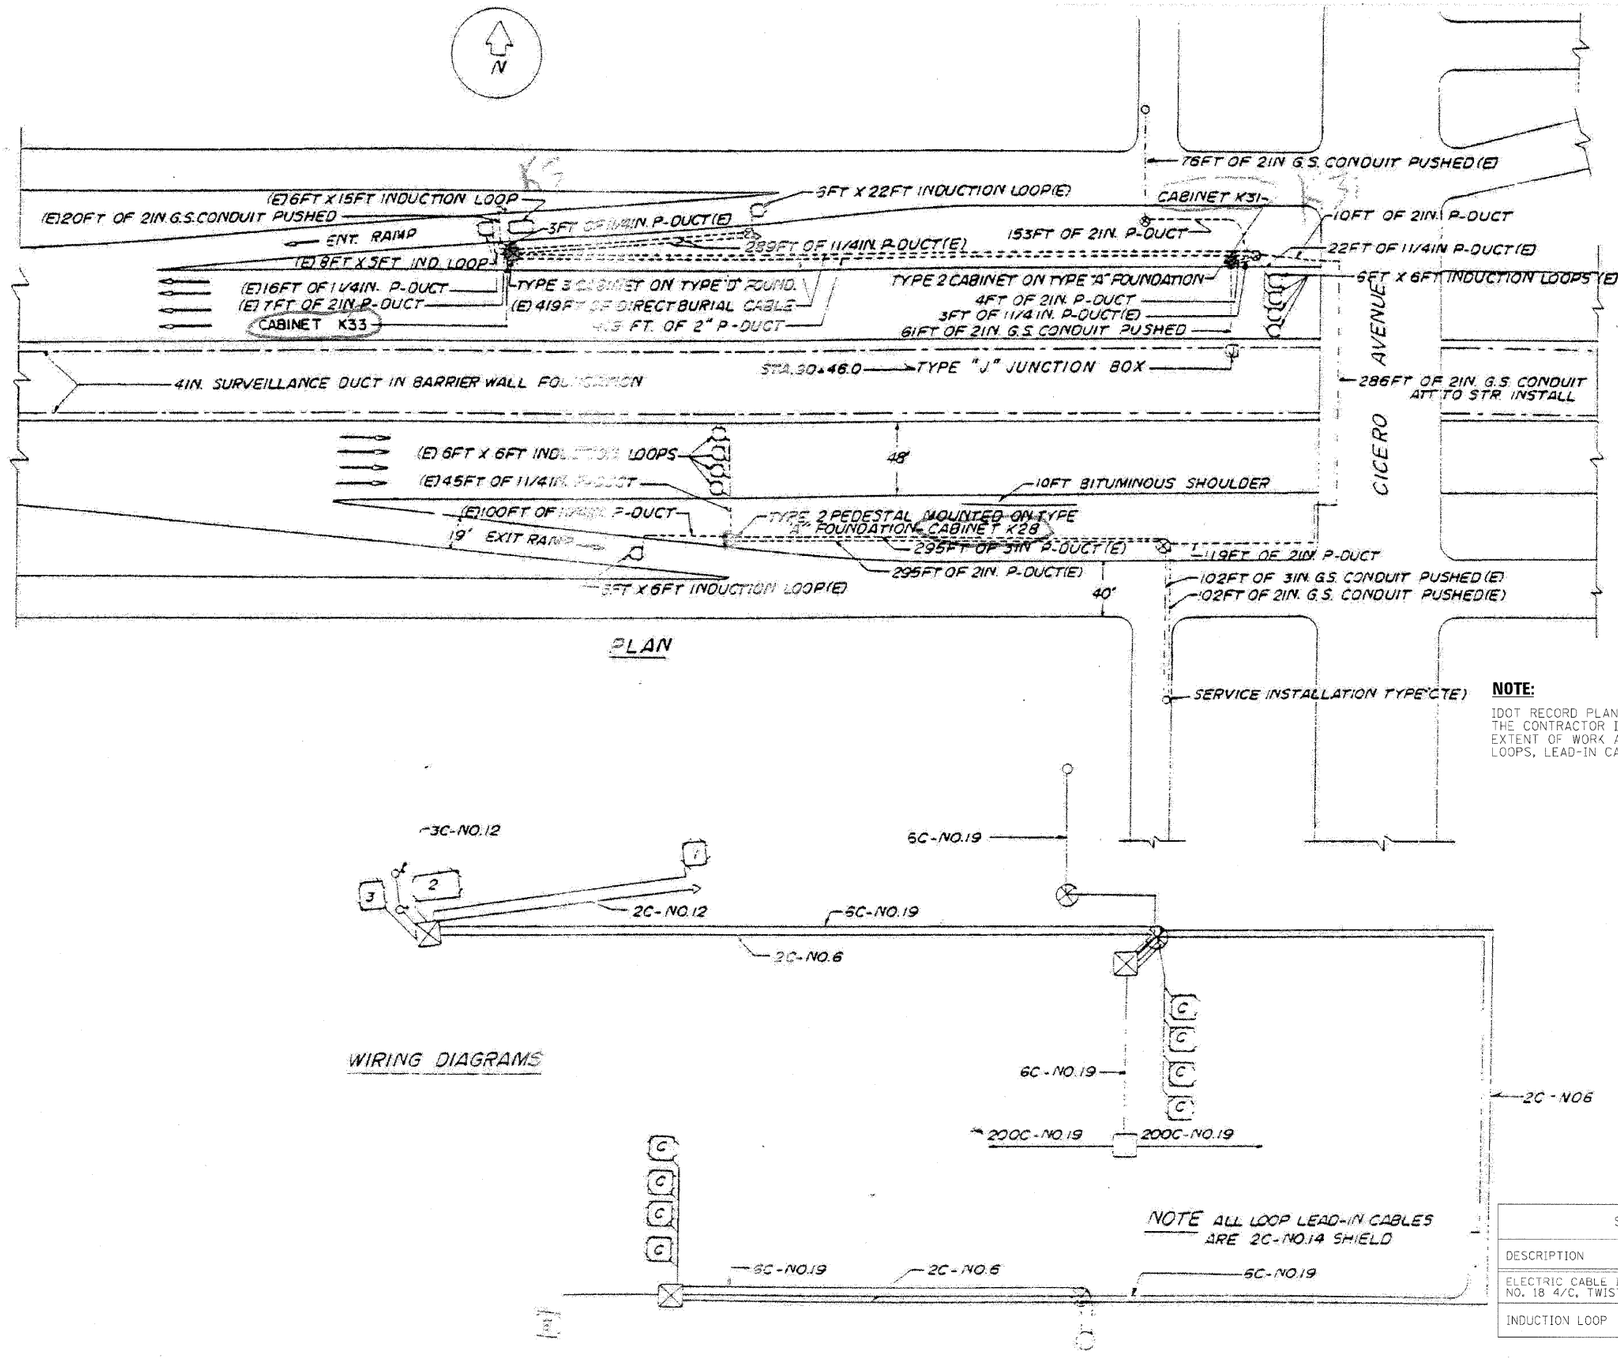

NOTE:

IDOT RECORD PLANS PROVIDED FOR INFORMATIONAL PURPOSES ONLY. THE CONTRACTOR IS RESPONSIBLE FOR VERIFYING THE LOCATION AND EXTENT OF WORK ASSOCIATED WITH REPLACEMENT OF INDUCTION LOOPS, LEAD-IN CABLE AND RELATED WORK.

NOTE ALL LOOP LEAD-IN CABLES ARE 2C-NO.14 SHIELD

LEGEND
- CABINET
- INDUCTION LOOP
- HANDHOLE
- SERVICE INSTALLATION
- METERING SIGNAL
- FLASHER
- DUCT
- CONDUIT
- DIRECT BURIAL CABLE
- (E) EXISTING
- (R) REMOVE EXISTING FACILITIES
- (A) ABANDON FACILITIES

OUTBOUND S23

SUMMARY OF QUANTITIES (THIS SHEET)		
DESCRIPTION	UNIT	QUANTITY
ELECTRIC CABLE IN CONDUIT, LEAD-IN, NO. 18 4/C, TWISTED, SHIELDED	LF	676
INDUCTION LOOP	LF	525

FILE NAME = ...\Signals\prpln_ABC_C3_ts_16.dgn	DESIGNED - GHT	REVISED -
	DRAWN - DMS	REVISED -
USER NAME = jmajewski	CHECKED - MPM	REVISED -
PLOT DATE = 1/25/2010	DATE - 1/25/10	REVISED -

benesch

STATE OF ILLINOIS
DEPARTMENT OF TRANSPORTATION

TRAFFIC SURVEILLANCE
CICERO AVE INSTALLATION

SCALE: N.T.S. | SHEET NO. 5 OF 7 SHEETS | STA. | TO STA.

F.A.I. RTE.	SECTION	COUNTY	TOTAL SHEETS	SHEET NO.
290	(2727, ETC., 3131)RS-7	COOK	216	179
		CONTRACT NO. 60G53		
FED. ROAD DIST. NO.	ILLINOIS	FED. AID PROJECT		