STATE OF ILLINOIS
DEPARTMENT OF PUBLIC WORKS & BUILDINGS
DIVISION OF HIGHWAYS

EXISTING SN. 053-0050 AS-BUILT PLANS-FOR INFORMATION ONLY-STRUCTURE TO BE REMOVED

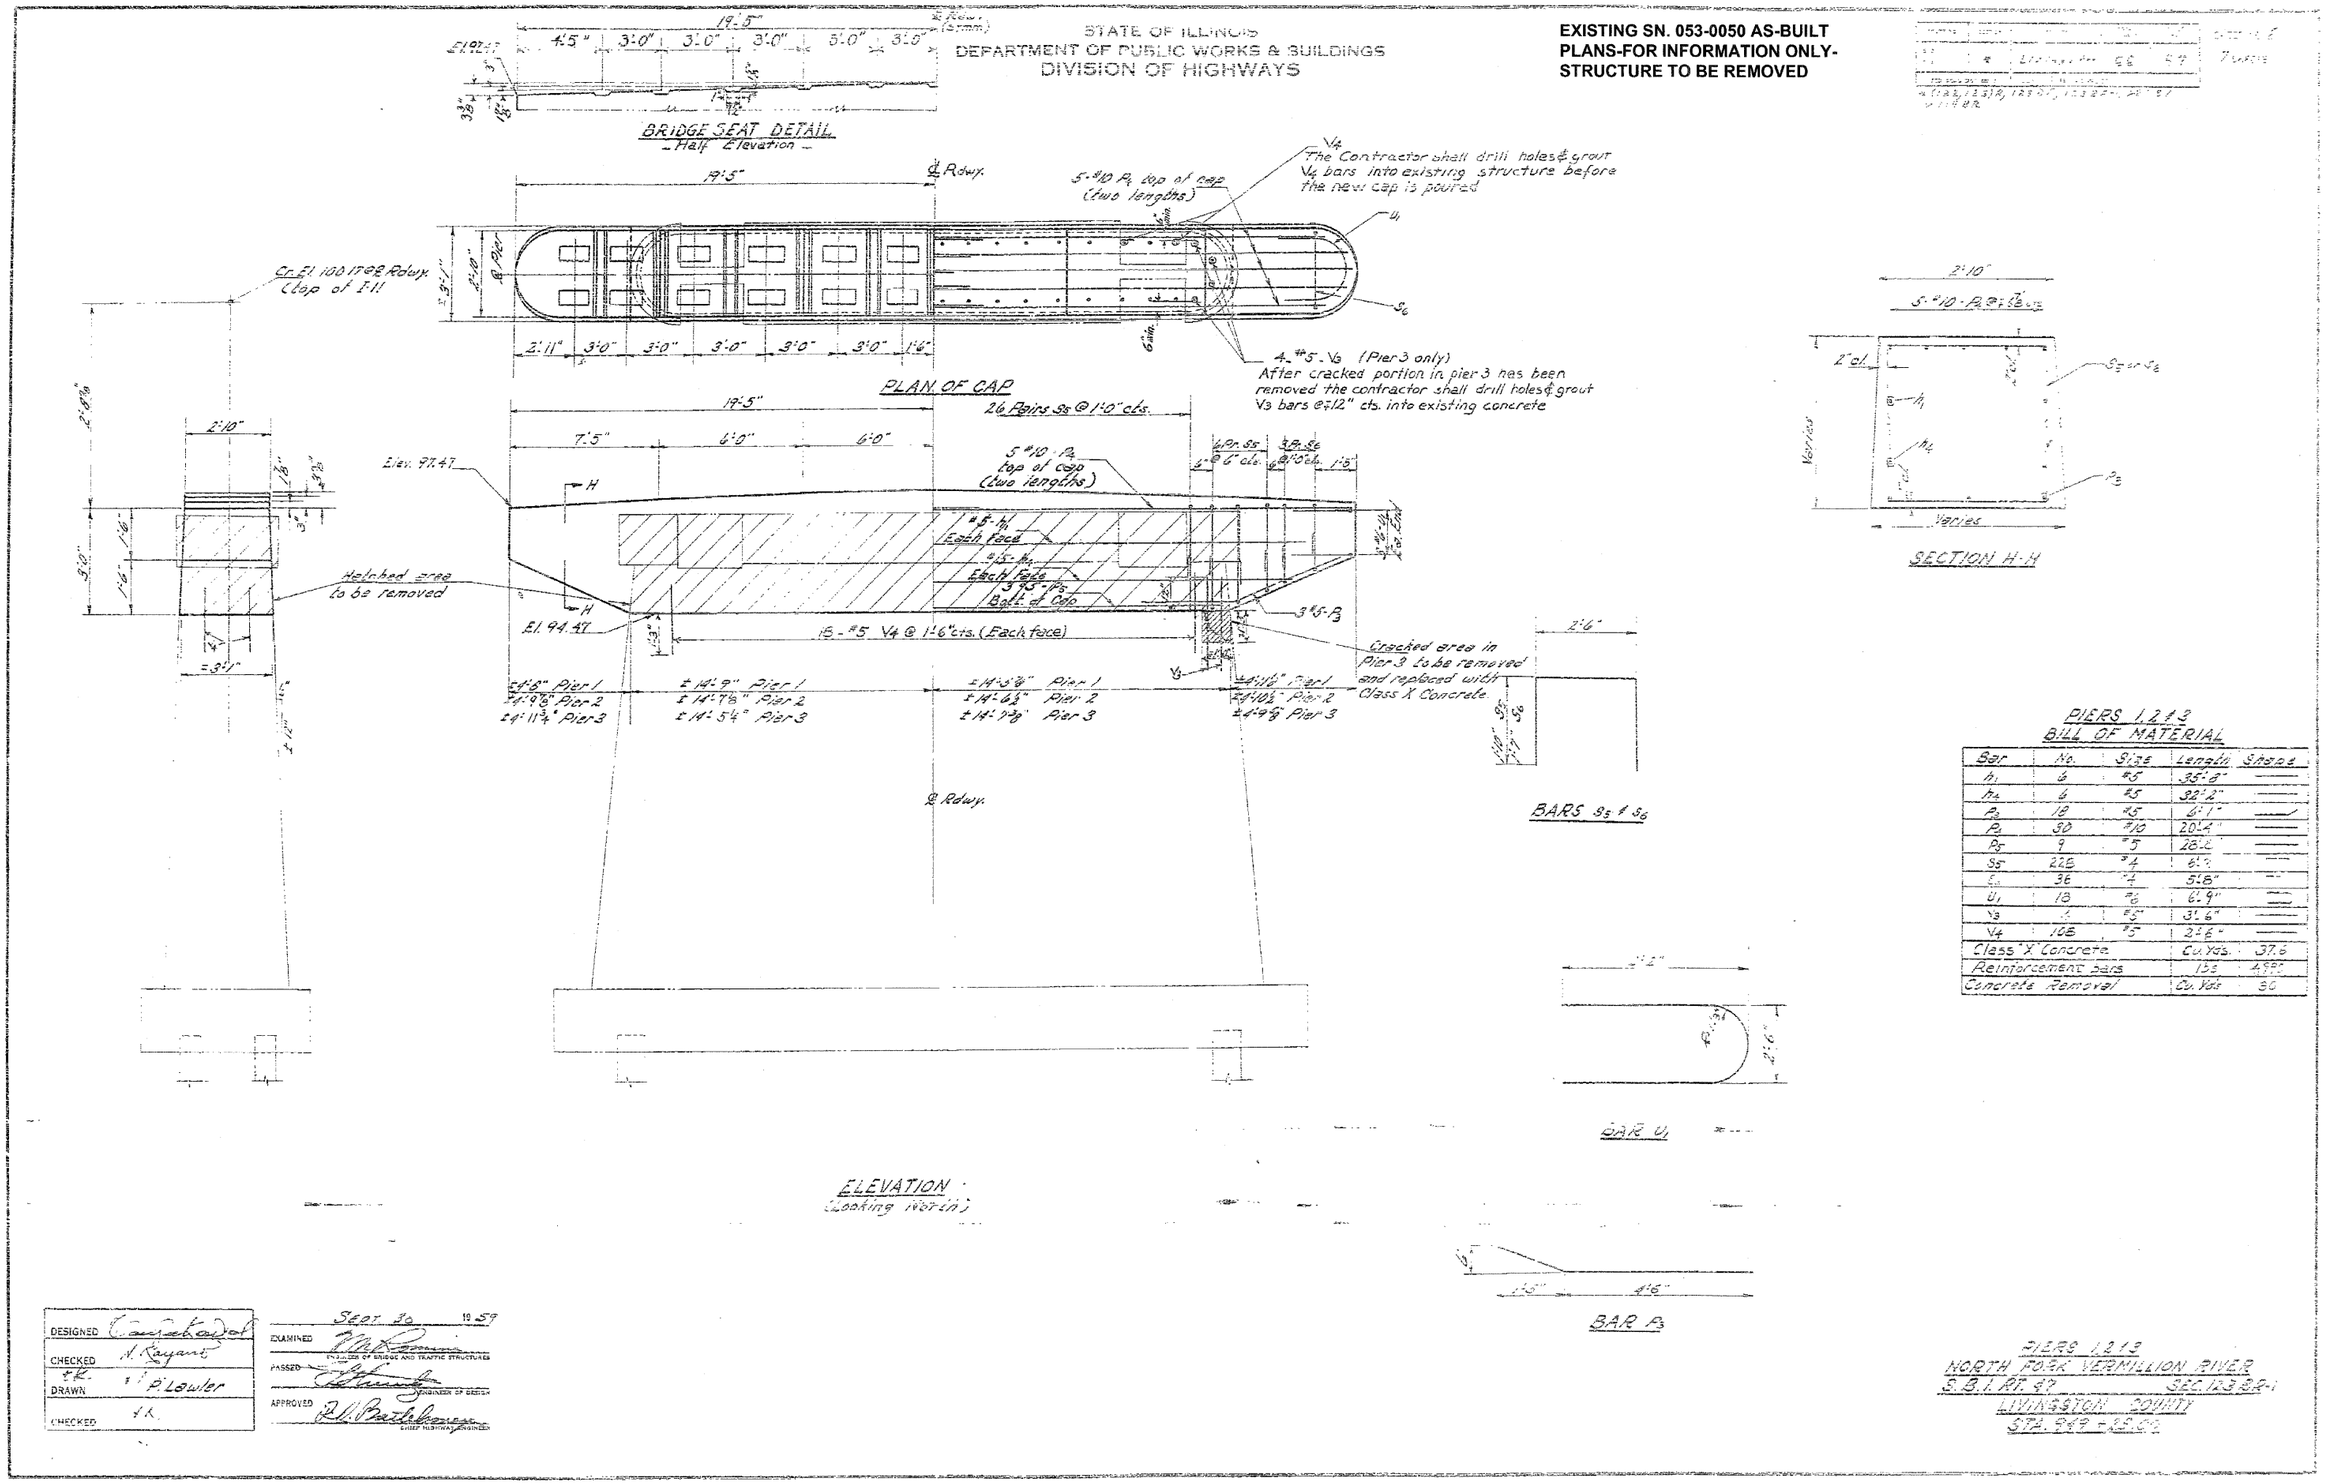

Bar	No.	Size	Length	Shape
h_1	6	#5	35'-8"	
h_4	6	#5	32'-2"	
P_3	18	#5	6'-1"	
P_4	30	#10	20'-4"	
P_5	9	#5	28'-2"	
S_5	228	#4	6'-[illegible]	
S_6	36	#4	5'-8"	
U_1	18	#6	6'-9"	
V_3	[illegible]	#5	3'-6"	
V_4	108	#5	2'-6"	
Class "X" Concrete			Cu. Yds.	37.6
Reinforcement bars			lbs	4990
Concrete Removal			Cu. Yds.	30

DESIGNED	[signature]
CHECKED	N. Rayant
DRAWN	P. Lawler
CHECKED	[signature]

Sept. 30 1959

EXAMINED [signature] ENGINEER OF BRIDGE AND TRAFFIC STRUCTURES

PASSED [signature] ENGINEER OF DESIGN

APPROVED [signature] CHIEF HIGHWAY ENGINEER

PIERS 1,2 & 3
NORTH FORK VERMILLION RIVER
S.B.I. RT. 47 SEC. 123 BR-1
LIVINGSTON COUNTY
STA. 949+25.00